
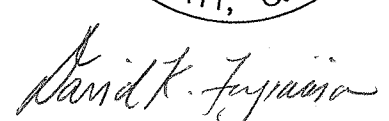


INDEX TO DRAWINGS					FED. ROAD DIST. NO.	STATE	FED. AID PROJ. NO.	FISCAL YEAR	SHEET NO.	TOTAL SHEETS
					HAWAII	HAW.	ER-12(1)R	2001	10	77
SHEET NO.	DESCRIPTION	SHEET NO.	DESCRIPTION	SHEET NO.	DESCRIPTION					
S0.1	INDEX TO DRAWINGS	S4.15	DECK JOINT DETAILS	S9.1	TOPPING REINFORCING PLAN					
S0.2	ESTIMATED QUANTITIES	S4.16	END POST DETAILS	S9.1A	SECTIONS AND DETAILS					
S0.3	BRIDGE GENERAL NOTES			S9.1B	TOPPING PLAN					
S0.4	SYMBOLS AND ABBREVIATIONS			S9.1C	TOPPING PLAN					
		S5.1	PLAN AND SECTION - PIER 1							
		S5.2	PLAN AND SECTION - PIER 2							
S1.1	FOUNDATION LAYOUT PLAN AND DECK LAYOUT PLAN	S5.3	PLAN AND SECTION - PIER 3							
S1.2	LONGITUDINAL SECTION	S5.4	PLAN AND SECTION - PIER 4	S10.1	RAILING SECTION AND DETAILS					
S1.3	BRIDGE ELEVATIONS	S5.5	PLAN AND SECTION - PIER 5	S10.2	METAL BIKEWAY AND INTERMEDIATE RAILING ON CONCRETE RAILING DETAILS					
		S5.6	PLAN AND SECTION - PIER 6							
		S5.7	STRUCTURAL EXCAVATION AND BACKFILL PAY LIMITS AT PIERS	S10.3	RAILING SECTION AND DETAILS					
S2.1	NORMAL DECK SECTION AT PIER									
S2.1A	SECTION - PIER 1 AND 2									
S2.1B	SECTION - PIER 3 THRU 6	S6.1	TYPICAL PIER ELEVATION AND DETAILS	S11.1	CONSTRUCTION SEQUENCE					
S2.2	TYPICAL SECTIONS	S6.2	PIER SECTION							
S2.3	TYPICAL PIER NOSING DETAIL	S6.3	TYPICAL FOOTING REINFORCING PLAN							
		S6.4	TYPICAL PIER DETAILS AND SECTIONS RAILING DETAILS							
S3.1	TOP OF DECK ELEVATION	S6.4A	TYPICAL PIER DETAILS AND SECTIONS							
S3.2	TOP OF PIER ELEVATION AND CAMBER DIAGRAMS	S6.4B	TYPICAL PIER DETAILS AND SECTIONS							
S4.1	ABUTMENT NO. 1 AND NO. 2 SEAT PLAN	S7.1	PRECAST PLANK SECTION AND DETAILS	<div><div><div><div><div>STEWART N. WILLIAMS</div><div>LICENSED PROFESSIONAL ENGINEER</div><div>NO. 3908-S</div><div>HAWAII, U.S.A.</div></div><div></div><div>THIS WORK WAS PREPARED BY ME OR UNDER MY SUPERVISION.</div></div><div><div><div>DAVID K. FUJIMURA</div><div>LICENSED PROFESSIONAL ENGINEER</div><div>NO. 8104-S</div><div>HAWAII, U.S.A.</div></div><div></div><div>THIS WORK WAS PREPARED BY ME OR UNDER MY SUPERVISION.</div></div></div><div><div>02-15-07</div><div>As Built - Added Note</div></div><div><div>DATE</div><div>REVISION</div></div><div><div>STATE OF HAWAII</div><div>DEPARTMENT OF TRANSPORTATION</div><div>HIGHWAYS DIVISION</div><div>INDEX TO DRAWINGS</div><div>MAMALAHOA HIGHWAY</div><div>REPLACEMENT OF</div><div>KEAIIWA STREAM BRIDGE</div><div>Federal-Aid Project No. ER-12(1)R</div><div>Scale: As Shown</div><div>Date: January 2001</div><div>SHEET No. 50.1 OF 50 SHEETS</div></div></div>						
S4.2	ABUTMENT NO. 1 ELEVATION, PLAN SECTIONS	S7.2	PRECAST PLANK SECTION AND DETAILS							
S4.3	ABUTMENT NO. 2 ELEVATION, PLAN SECTIONS									
S4.4	ABUTMENT FOOTING REINFORCING DETAILS									
S4.5	ABUTMENT FOOTING REINFORCING	S8.1	SECTIONS AND DETAILS							
S4.6	ABUTMENT SECTIONS AND DETAILS									
S4.7	ABUTMENT SECTIONS									
S4.8	EXCAVATION AND BACKFILL LIMITS									
S4.9	WINGWALL NO. 1 ELEVATION AND DETAILS									
S4.10	WINGWALL NO. 2 ELEVATION AND DETAILS									
S4.11	WINGWALL NO. 3 ELEVATION AND DETAILS									
S4.12	WINGWALL NO. 4 ELEVATION AND DETAILS									
S4.13	WINGWALL AND SITEWALL DETAILS									
S4.14	APPROACH SLAB DETAILS									

ORIGINAL PLAN	SURVEY PLOTTED BY	DATE
NOTE BOOK	DRAWN BY	10/12/2000
	DESIGNED BY	
	QUANTITIES BY	
	CHECKED BY	

FED. ROAD DIST. NO.	STATE	FED. AID PROJ. NO.	FISCAL YEAR	SHEET NO.	TOTAL SHEETS
HAWAII	HAW.	ER-12(1)R	2001	12	77

BRIDGE GENERAL NOTES

1. General Specifications: Hawaii Department of Transportation, Standard Specifications for Road and Bridge Construction, 1994, together with Special Provisions prepared for this contract.
2. Design Specifications: AASHTO 1998 LRFD Bridge Design Specifications (Second Edition) and its subsequent interim specifications with interim supplements and modifications by the Highways Division, Department of Transportation, State of Hawaii.
3. Loads:
- (A) Dead Load: An allowance of 25 PSF for future wearing surface of asphalt concrete has been provided in the design.
- (B) Live Load: AASHTO HL-93 Truck Loading
- (C) Seismic Loads: Acceleration coefficient - 0.8
Seismic Performance Zone - 4
Importance Category - Essential
4. Materials:
- (A) All concrete strengths shall be as noted below:
- | Item No. | Structural Parts | Classes of Concrete | Specified Compressive Strength, f'c (28 Days) |
|----------|--|---------------------|---|
| (1) | Pre-stressed planks | - | 7000 PSI |
| (2) | Abutment footings, Pier, Pier Footings | - | 5000 PSI |
| (3) | Abutment walls
Retaining walls
including foundations | - | 5000 PSI |
| (4) | Rails | - | 4000 PSI |
| (5) | Bridge deck | - | 5000 PSI w/ Tetragard |
| (6) | Approach Slab | - | 4000 PSI |
| (7) | Except as noted
otherwise all others | A | 3000 PSI |


All concrete with the exception of Class A and Class D concrete shall have a maximum W/C Ratio of 0.45. The W/C Ratio for Class A and Class D concrete shall follow the standard specifications.

- (B) All reinforcing steel shall be ASTM A 615 Grade 60 unless otherwise noted.
- (C) Reinforcing steel shall be ASTM A 706 where welded connections are required.
- (D) All structural steel shall be ASTM A 36 hot dip galvanized after fabrication, unless otherwise noted.
- (E) All anchor bolts, washers and nuts shall be ASTM A 307 hot dip galvanized after fabrication, unless otherwise specified.
- (F) For materials of prestressed concrete planks see applicable prestressed concrete notes.
- (G) Concrete for bridge deck shall have a maximum size aggregate of 3/8 of an inch and shall use a hi-range water reducer.
5. Reinforcement:
- (A) The minimum covering measured from the surface of the concrete to the face of any reinforcing bars shall be as follows, except as otherwise shown:
- (1) Deck slabs
- A. Top bars = 2"
- B. Bottom bars = 1 1/2" except as otherwise noted.
- (2) For prestressed concrete planks see prestressed concrete plank details.
- (3) Abutments and retaining walls = 2"
- (4) Piers = 3" to ties

- (5) Approach slab bottom bars = 3"
- All others unless otherwise noted = 2" Clear
- (6) Concrete cast against and permanently exposed to earth = 3"
- (7) All others unless otherwise noted = 2".
- (B) Reinforcing bars shall be detailed in accordance with the latest edition of the A.C.I. Detailing Manual unless otherwise noted.
- (C) Minimum clear spacing between parallel bars shall be 1 1/2 times the diameter of bars (for non bundled bars). In no case shall the clear distance between the bars be less than 1 1/2 times the maximum size of the coarse aggregate.
- (D) All dimensions relating to reinforcing bars are to centers of bars unless otherwise noted.
- (E) Reinforcing bars shall be securely tied at all intersections and lap splices except where the spacing of intersections is less than one foot in each direction, in which case alternate intersections shall be tied.
- (F) Vertical wall bars shall be arranged in such a manner as to avoid interference with plank and topping bars above as directed by the Engineer.
6. Plank Bearings:
- (A) Plank concrete seats receiving elastomeric pads shall be poured monolithically with supporting structure. Top of concrete seat receiving elastomeric bearing pads shall be finished with a steel trowel to a smooth level surface to the elevation shown on the plans. Grind down high spots as needed to provide an even bearing surface to 1/16"± tolerance.
- (B) Elastomeric pads: To prevent displacement, the bottom of bridge bearing pads shall be secured to the concrete seats with adhesives approved by the Engineer.
7. Construction Notes:
- (A) See Standard Specifications and Special Provisions.
- (B) In general, top of concrete deck slab shall be constructed to follow the roadway vertical and horizontal curves and superelevations.
- (C) Except as otherwise noted, all vertical dimensions are measured plumb.
- (D) The Contractor shall verify all site conditions and not rely upon these plans for stream location, etc. Conditions may differ from those shown.
- (E) The Contractor shall verify the location of all utility lines and notify the respective owners before commencing with excavation, and any temporary piling or sheeting.
- (F) For concrete finish see Standard Specifications and Special Provisions.
- (G) Construction joints may be relocated or additional ones added subject to the approval of the Engineer.
- (H) Unless otherwise noted, all exposed concrete edges shall be chamfered 3/4" x 3/4".
8. General:
- (A) All items noted incidental will not be paid for separately.
- (B) Standard detail drawings refer to all structures in general, except for modifications as may be required for special conditions. For such modifications refer to the corresponding detailed drawings.
9. Foundation:
- (A) For boring logs and other geotechnical information, see foundation report by Geolabs, Inc. and Sheets G1 through G6.
- (B) General:
- (1) Many footings are located in or near the Stream.
- Construction at these locations may be complicated by the presence of water and cobbles or boulders. Additionally, the stream is subject to flash flooding. Shoring of the excavation may be required for the construction of these footings.


- (2) Concrete footings from the previous bridge that was demolished may complicate excavation. If required excavation of the concrete footings which includes removal of the reinforcing steel shall be considered incidental to Section 206 - Excavation and Backfill for Conduits and Structures of the Specifications.
- (3) The pay limits for excavation for the Bridge, shown on sheets no. S4.8 and S5.7 should not be considered as indicative of actual excavation requirements.
- (4) Prior to structure excavation at Abutment No. 1, provide soldier piling and lagging at the existing power pole shown on sheet S4.4.
- (C) Design Soil / Rock Parameters:
- (1) Bearing pressure on basalt rock
- A. Extreme event limit state = 60 ksf
- B. Strength limit state = 36 ksf
- C. Service limit state = 20 ksf
- (2) Passive resistance of intact rock
- A. Extreme event limit state = 35 ksf (rectangular distribution)
- B. Strength limit state = 17.5 ksf (rectangular distribution)
- (3) Coefficient of friction of basalt rock
- A. Extreme event limit state = 0.75
- B. Strength limit state = 0.64
- (4) Side shear between concrete and intact basalt rock
- A. Extreme event limit state = 2 ksf
- (5) Static lateral earth pressure
- A. Active condition, level backfill = 35 pcf
- B. Active condition, 2H : 1V backfill = 50 pcf
- C. At-rest condition, level backfill = 50 pcf
- D. At-rest condition, 2H : 1V backfill = 65 pcf
- (6) Dynamic lateral earth pressure
- A. Level backfill = 74H psf (rectangular distribution) (for abutment walls)
- B. Level backfill = 36H psf (rectangular distribution) (for wingwalls and site retaining walls)
- (D) Blasting will not be allowed on this project.
10. Reference Drawings:
- (A) For construction sequence, see Sheet S-11.1.

GEOLABS, INC.
2006 KALIHU STREET
HONOLULU, HAWAII 96819

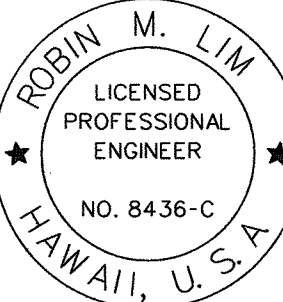


THIS WORK WAS PREPARED BY
ME OR UNDER MY SUPERVISION.

SIGNATURE DATE

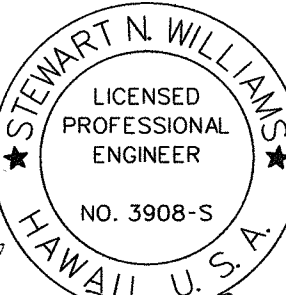

THIS WORK WAS PREPARED BY
ME OR UNDER MY SUPERVISION.

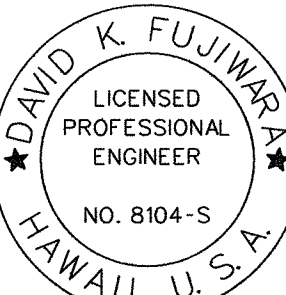

THIS WORK WAS PREPARED BY
ME OR UNDER MY SUPERVISION.

LEGEND FOR AS-BUILT POSTINGS	
	Squiggly line for as-built deletion
	Double line for as-built deletion
Roadway	Text for as-built posting

02-15-07	As Built - Added Note
DATE	REVISION

STATE OF HAWAII DEPARTMENT OF TRANSPORTATION HIGHWAYS DIVISION	
BRIDGE GENERAL NOTES	
MAMALAHOA HIGHWAY REPLACEMENT OF KEATWA STREAM BRIDGE Federal-Aid Project No. ER-12(1)R	
Scale: As Shown	Date: January 2001
SHEET No. 50.3 OF 50 SHEETS	


AS-BUILT

FED. ROAD DIST. NO.	STATE	FED. AID PROJ. NO.	FISCAL YEAR	SHEET NO.	TOTAL SHEETS
HAWAII	HAW.	ER-12(1)R	2001	13	77


SYMBOLS AND ABBREVIATIONS

@	At	f'c	Specified compressive strength (28 days)	OC, oc	On center
≥	Greater than	FA	Force account		
		FF	Front face		
		Fin.	Finish		
		Ft.	Foot, feet	P(e)	Effective Prestress Force
Abut.	Abutment	Ftg.	Footing	Psf.	Pounds per square foot
Alt.	Alternate			Psi.	Pounds per square inch
Approx.	Approximate				
Az.	Azimuth				
		Galv.	Galvanize		
		Gr., grd.	Ground, grade	R	Radius
Bal.	Balance			Rdwy.	Roadway
Beg.	Begin			Ref.	Reference
Bet.	Between			Reinf.	Reinforcement
Bm.	Beam	H, h	Height	Req., Req'd.	Required
Bot.	Bottom	Horiz.	Horizontal	Ret.	Retaining
Brg.	Bearing	HS	High strength		
		Hwy.	Highway		
				Sect.	Section
				SF	Square foot
CL	Center line			Sht.	Sheet
CIP	Cast in place	Int.	Interior	Spcg.	Spacing
Cl., clr.	Clear	Inv.	Invert	Spcs.	Spaces
CLSM	Controlled Low Strength Material			Sta.	Station
Conc.	Concrete			Std.	Standard
Col.	Column			Stirr.	Stirrup
Cont.	Continue			Str.	Stream
Corresp.	Corresponding	Jt.	Joint	Struct.	Structure
CRM	Concrete Rubble Masonry			Symm.	Symmetrical
CY	Cubic yards				
Det.	Detail	L	Length	Transv.	Transverse
Dim.	Dimension	Lbs.	Pounds	Typ.	Typical
		LF	Linear foot		
		Longit.	Longitudinal		
		LS	Lump sum		
Ea.	Each			Vert.	Vertical
EF	Each face				
El., elev.	Elevation				
Eq.	Equal, equally	Max.	Maximum		
EW	Each way	Min.	Minimum		
Exc.	Excavation			W/C	Water/Cement Ratio
Exist.	Existing			WW	Wingwall
Exp.	Expansion				
		No., #	Number		

ORIGINAL PLAN	SURVEY PLOTTED BY _____ DATE _____
	DRAWN BY JST _____ " _____
	TRACED BY _____ " _____
NOTE BOOK	DESIGNED BY KSF _____
	QUANTITIES BY _____
	CHECKED BY _____
No. _____	

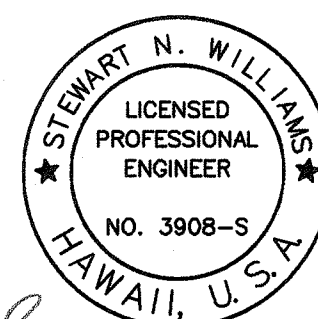

THIS WORK WAS PREPARED BY
ME OR UNDER MY SUPERVISION.

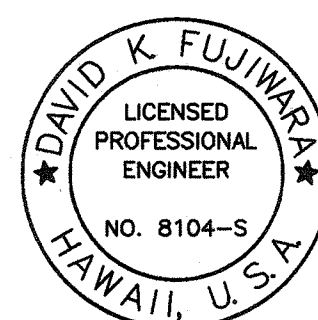

THIS WORK WAS PREPARED BY
ME OR UNDER MY SUPERVISION.

STATE OF HAWAII
DEPARTMENT OF TRANSPORTATION
HIGHWAYS DIVISION


SYMBOLS AND ABBREVIATIONS

MAMALAHOA HIGHWAY
REPLACEMENT OF
KEAIIWA STREAM BRIDGE
Federal Aid Project No. ER-12(1)R

Scale: As Shown Date: January 2001

SHEET No. S0.4 OF 50 SHEETS

FED. ROAD DIST. NO.	STATE	FED. AID PROJ. NO.	FISCAL YEAR	SHEET NO.	TOTAL SHEETS
HAWAII	HAW.	ER-12(1)R	2001	14	77

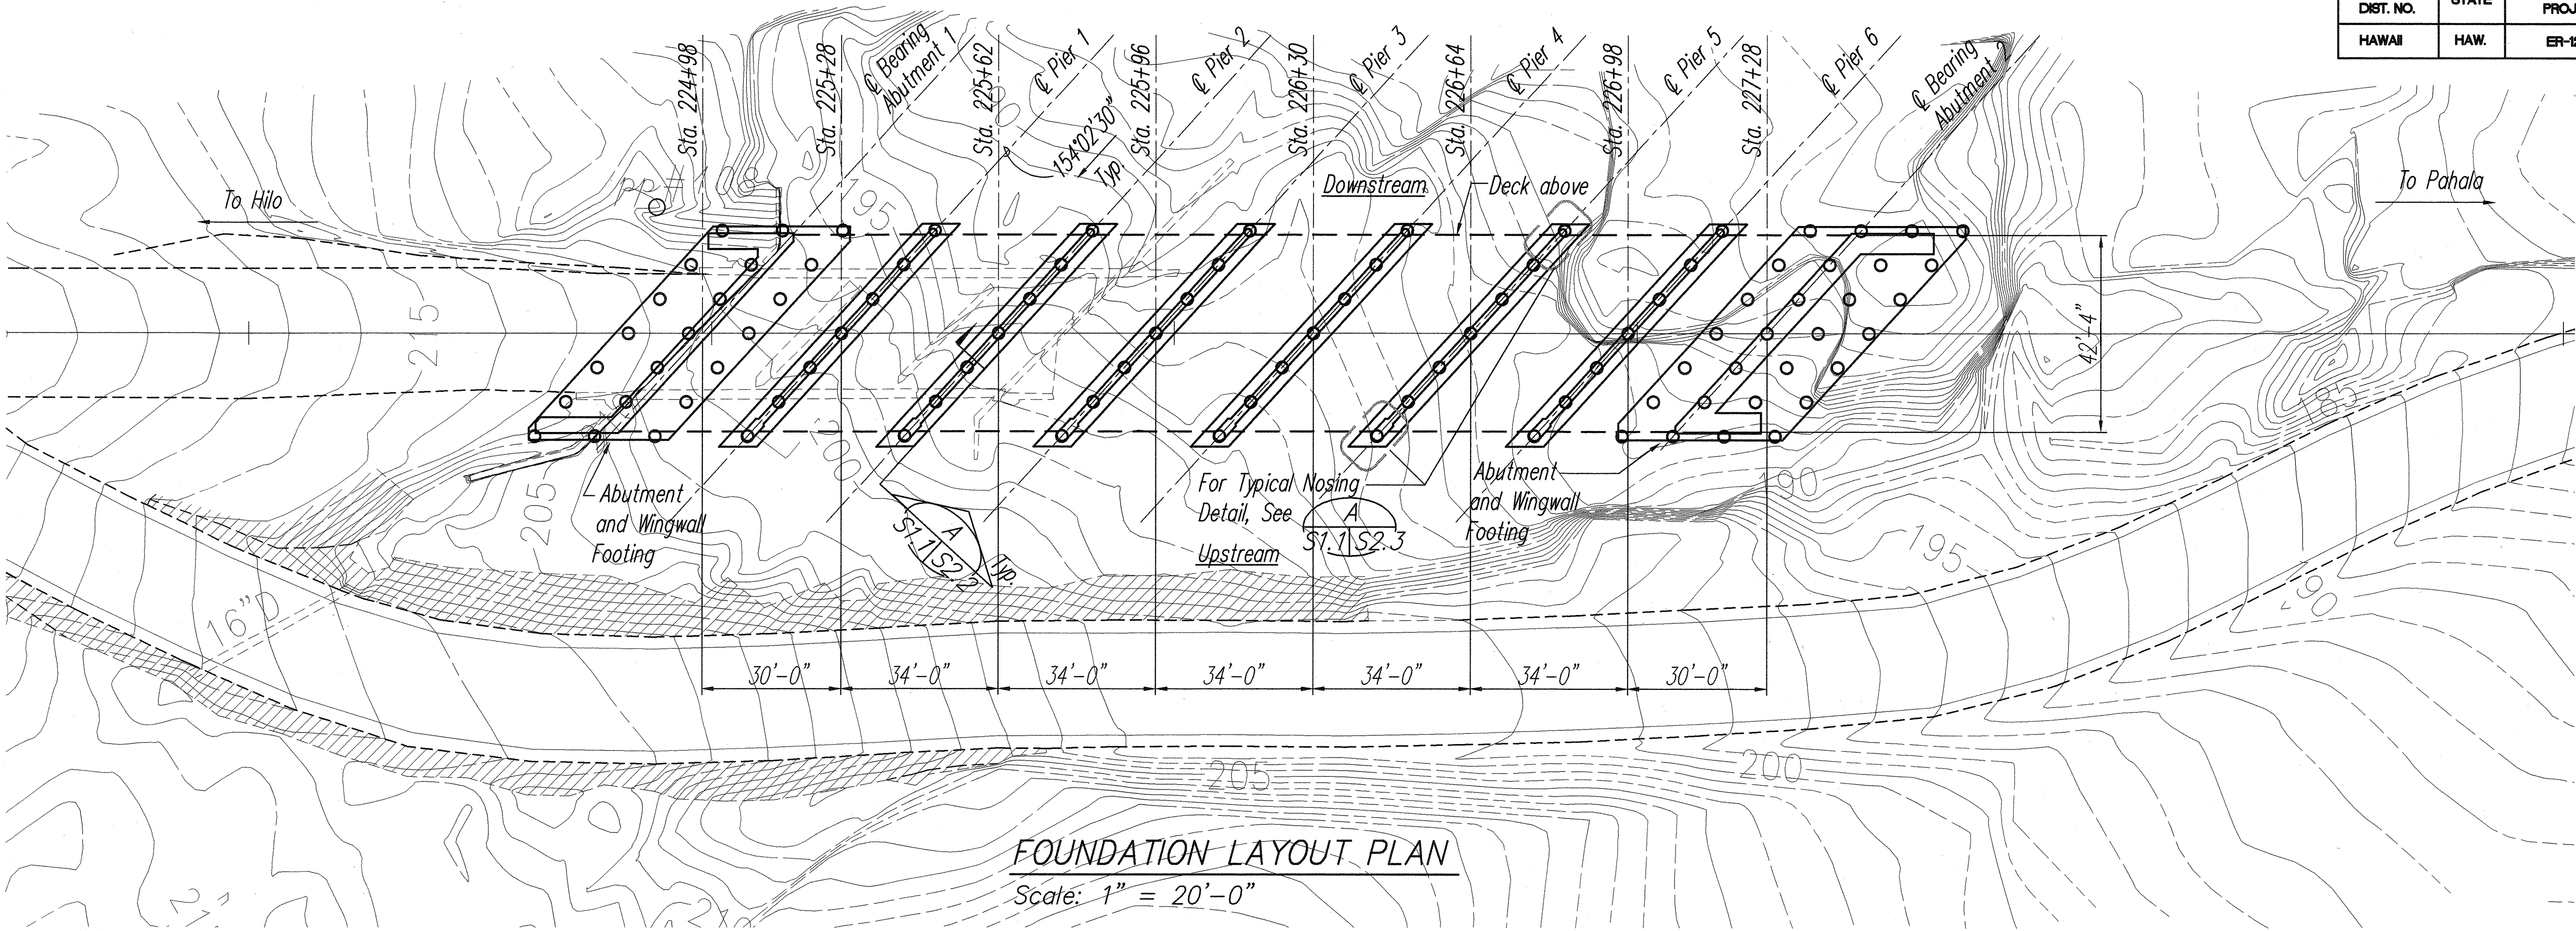


FOUNDATION LAYOUT PLAN

Scale: 1" = 20'-0"

LEGEND:


- PROBE HOLE LOCATION
See Special Provision Section 660.

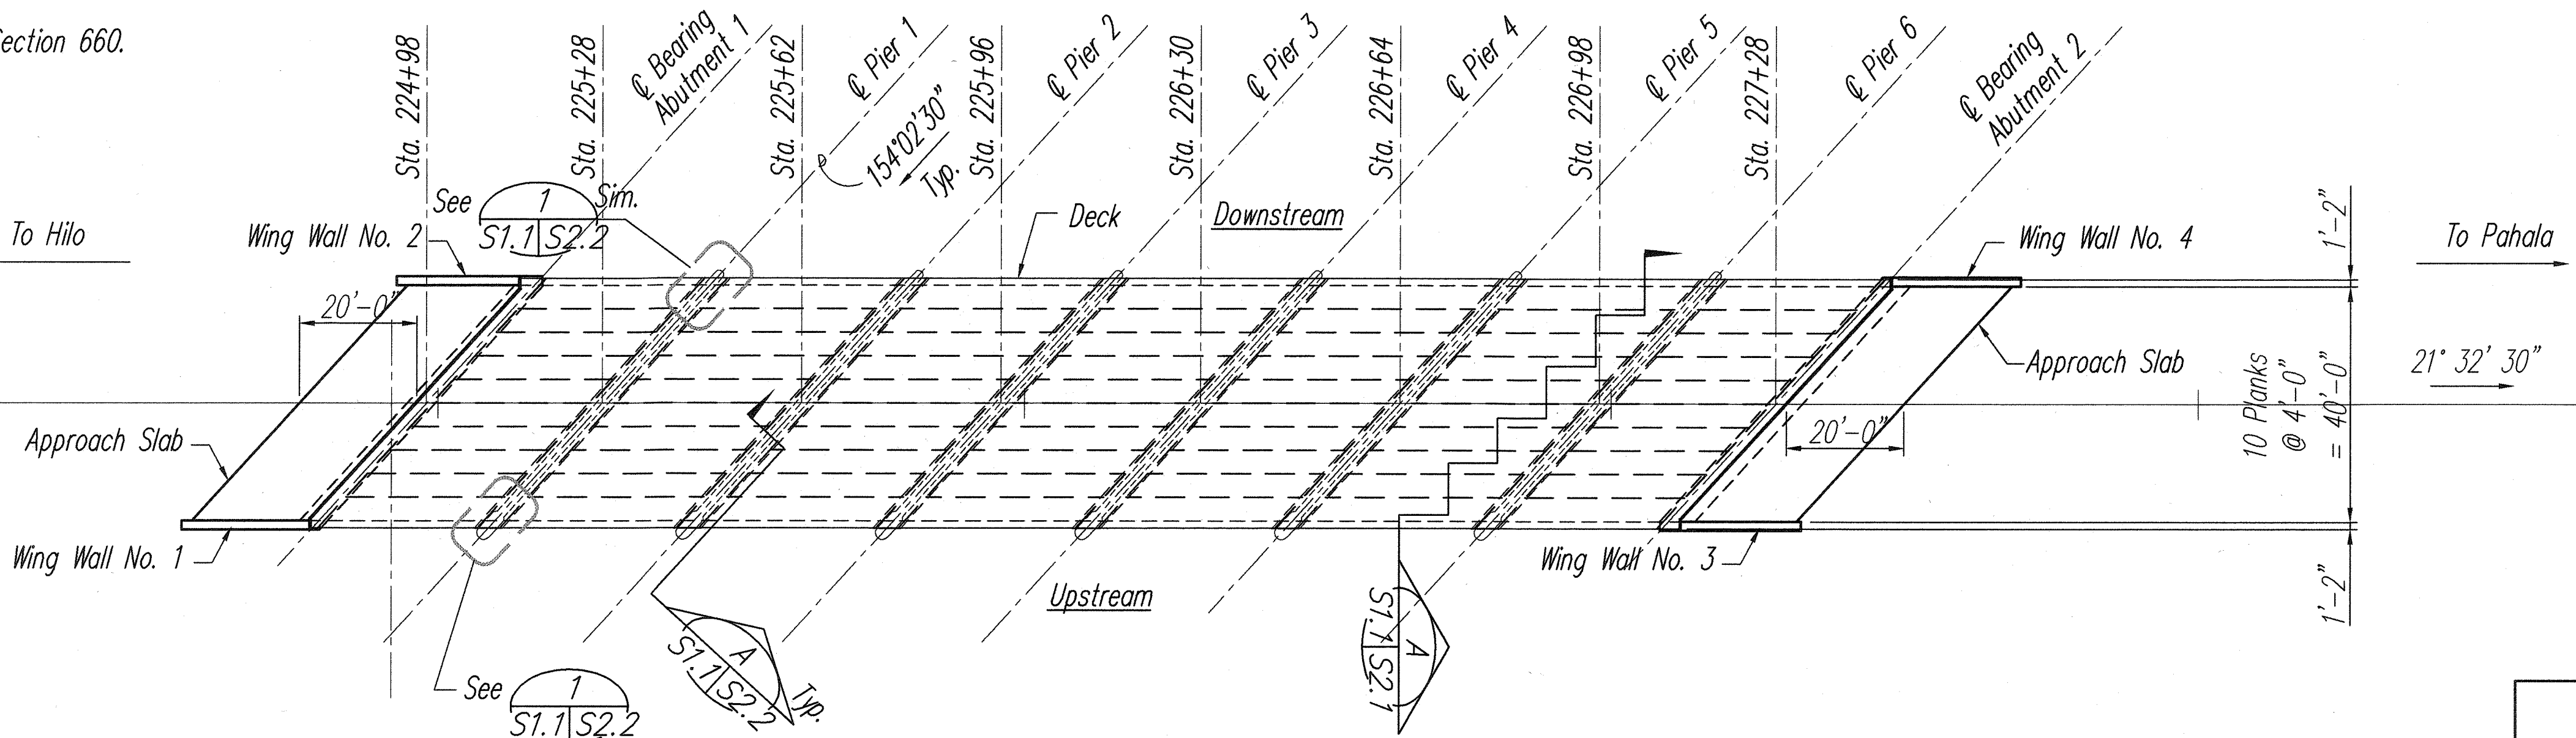


DECK LAYOUT PLAN

Scale: 1" = 20'-0"

ORIGINAL PLAN	SURVEY PLANNED BY	DATE
NOTE BOOK	DRAWN BY	DEC 2000
No.	DESIGNED BY	
	QUANTITIES BY	
	CHECKED BY	

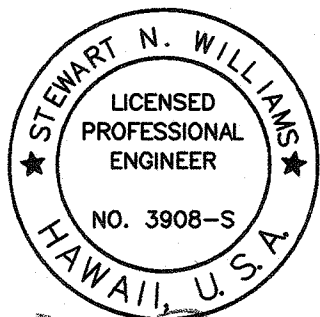


THIS WORK WAS PREPARED BY
ME OR UNDER MY SUPERVISION.

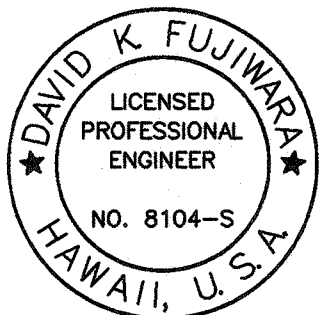

THIS WORK WAS PREPARED BY
ME OR UNDER MY SUPERVISION.

GEOLABS, INC.
2006 KALIHI STREET
HONOLULU, HAWAII 96819

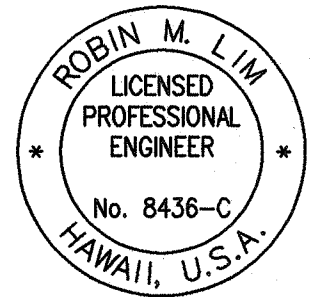


THIS WORK WAS PREPARED BY
ME OR UNDER MY SUPERVISION.

STATE OF HAWAII
DEPARTMENT OF TRANSPORTATION
HIGHWAYS DIVISION
FOUNDATION LAYOUT PLAN
AND DECK LAYOUT PLAN
MAMALAHOA HIGHWAY
REPLACEMENT OF
KEAIWA STREAM BRIDGE
Federal Aid Project No. ER-12(1)R
Scale: As Shown Date: January 2001

SHEET No. S1.1 OF 50 SHEETS

FED. ROAD DIST. NO.	STATE	FED. AID PROJ. NO.	FISCAL YEAR	SHEET NO.	TOTAL SHEETS
HAWAII	HAW.	ER-12(1)R	2001	15	77

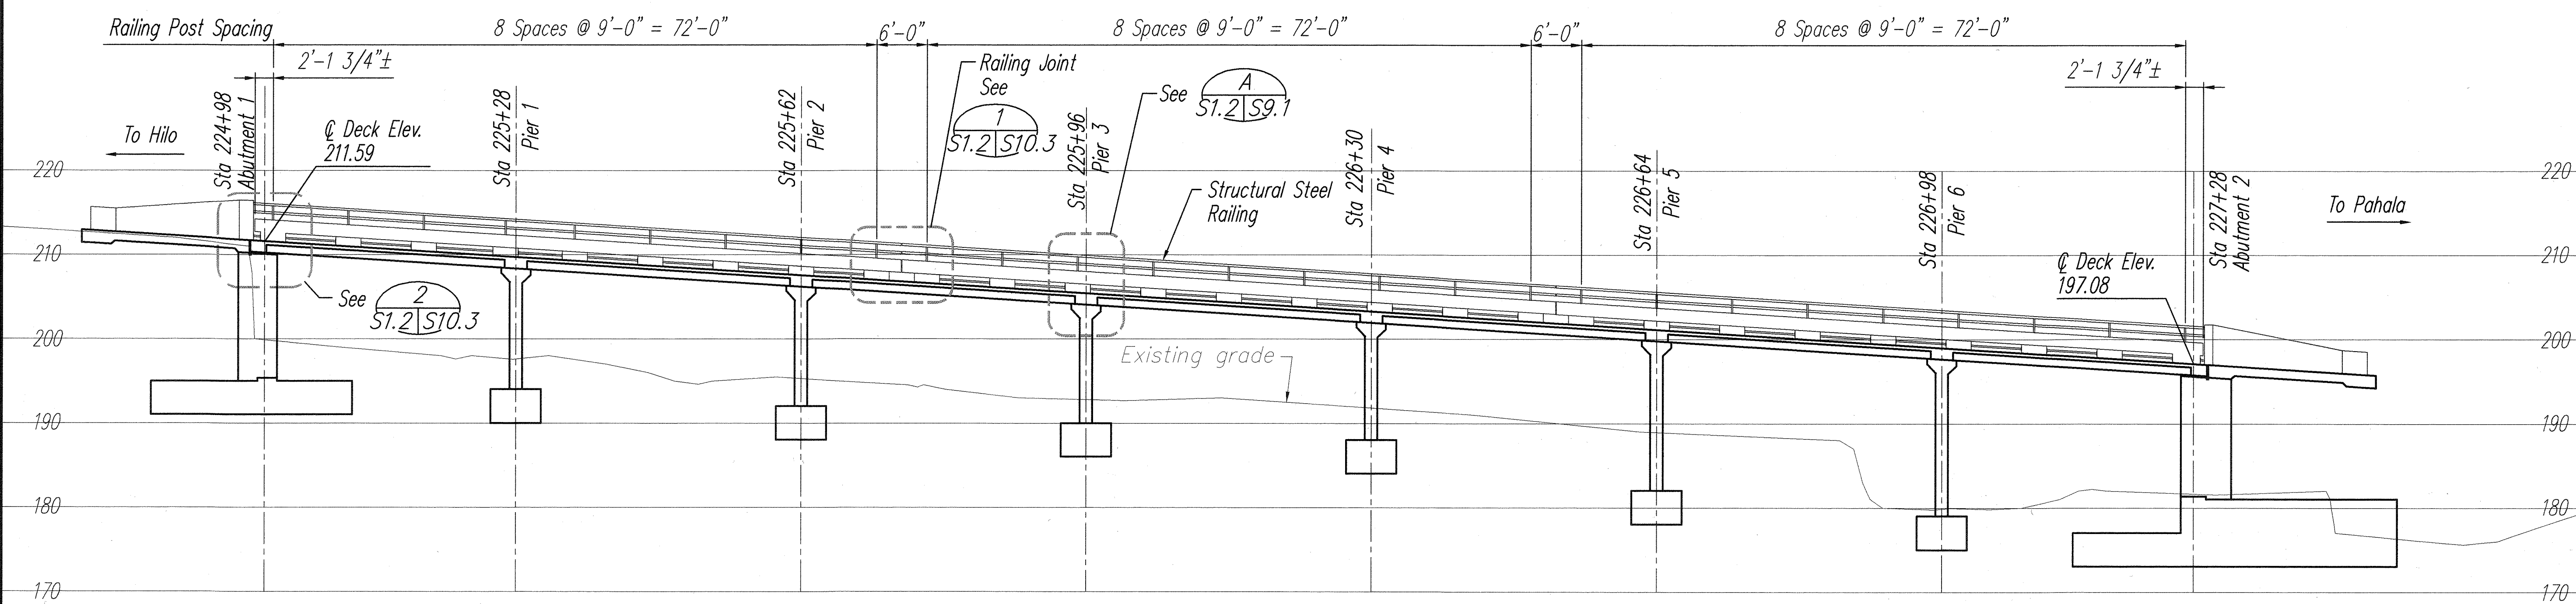


LONGITUDINAL SECTION ALONG CENTERLINE ROAD
Scale: 1" = 10'-0"

STEWARD N. WILLIAMS
LICENSED PROFESSIONAL ENGINEER
NO. 3908-S
HAWAII, U.S.A.
Steward N. Williams
THIS WORK WAS PREPARED BY ME OR UNDER MY SUPERVISION.

DAVID K. FUJIMURA
LICENSED PROFESSIONAL ENGINEER
NO. 8104-S
HAWAII, U.S.A.
David K. Fujimura
THIS WORK WAS PREPARED BY ME OR UNDER MY SUPERVISION.

ORIGINAL PLAN	SURVEY PLOTTED BY	DATE
NOTE BOOK	DRAWN BY VSI	"
No.	DESIGNED BY KSF	"
	QUANTITIES BY	"
	CHECKED BY	"


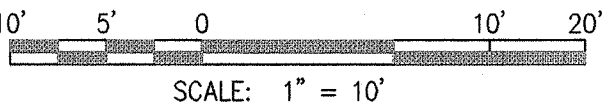


STATE OF HAWAII
DEPARTMENT OF TRANSPORTATION
HIGHWAYS DIVISION

LONGITUDINAL SECTION

MAMALAHOA HIGHWAY
REPLACEMENT OF
KEAIWA STREAM BRIDGE
Federal Aid Project No. ER-12(1)R
Scale: As Shown Date: January 2001
SHEET No. S1.2 OF 50 SHEETS

FED. ROAD DIST. NO.	STATE	FED. AID PROJ. NO.	FISCAL YEAR	SHEET NO.	TOTAL SHEETS
HAWAII	HAW.	ER-12(1)R	2001	16	77

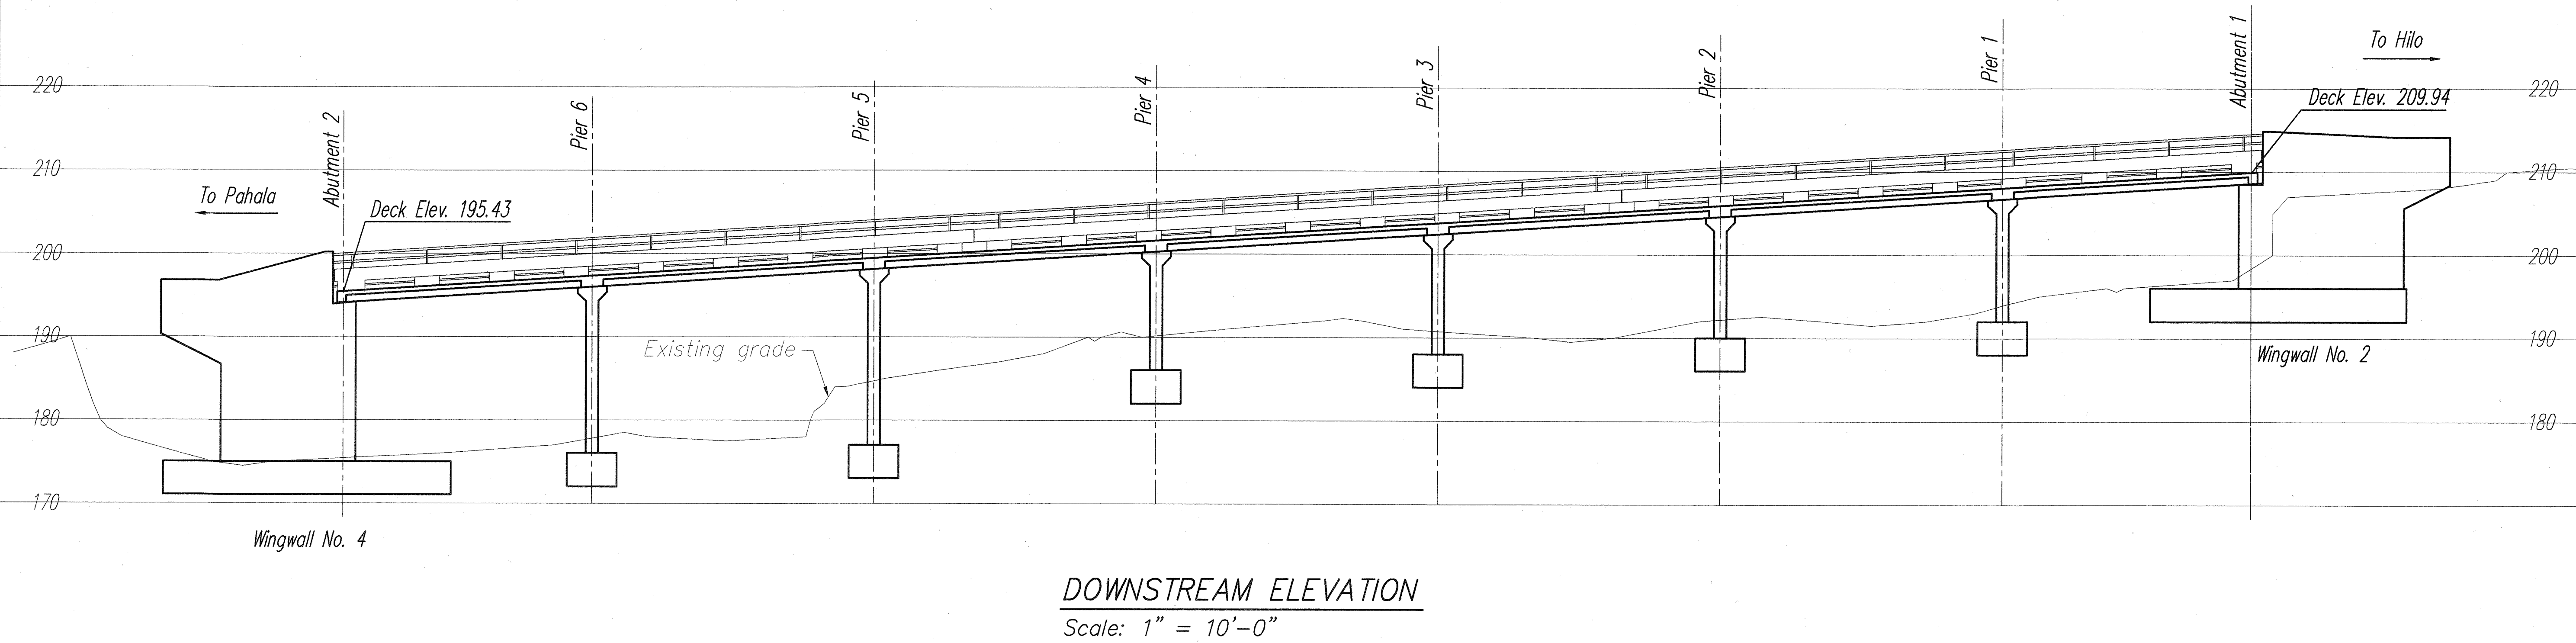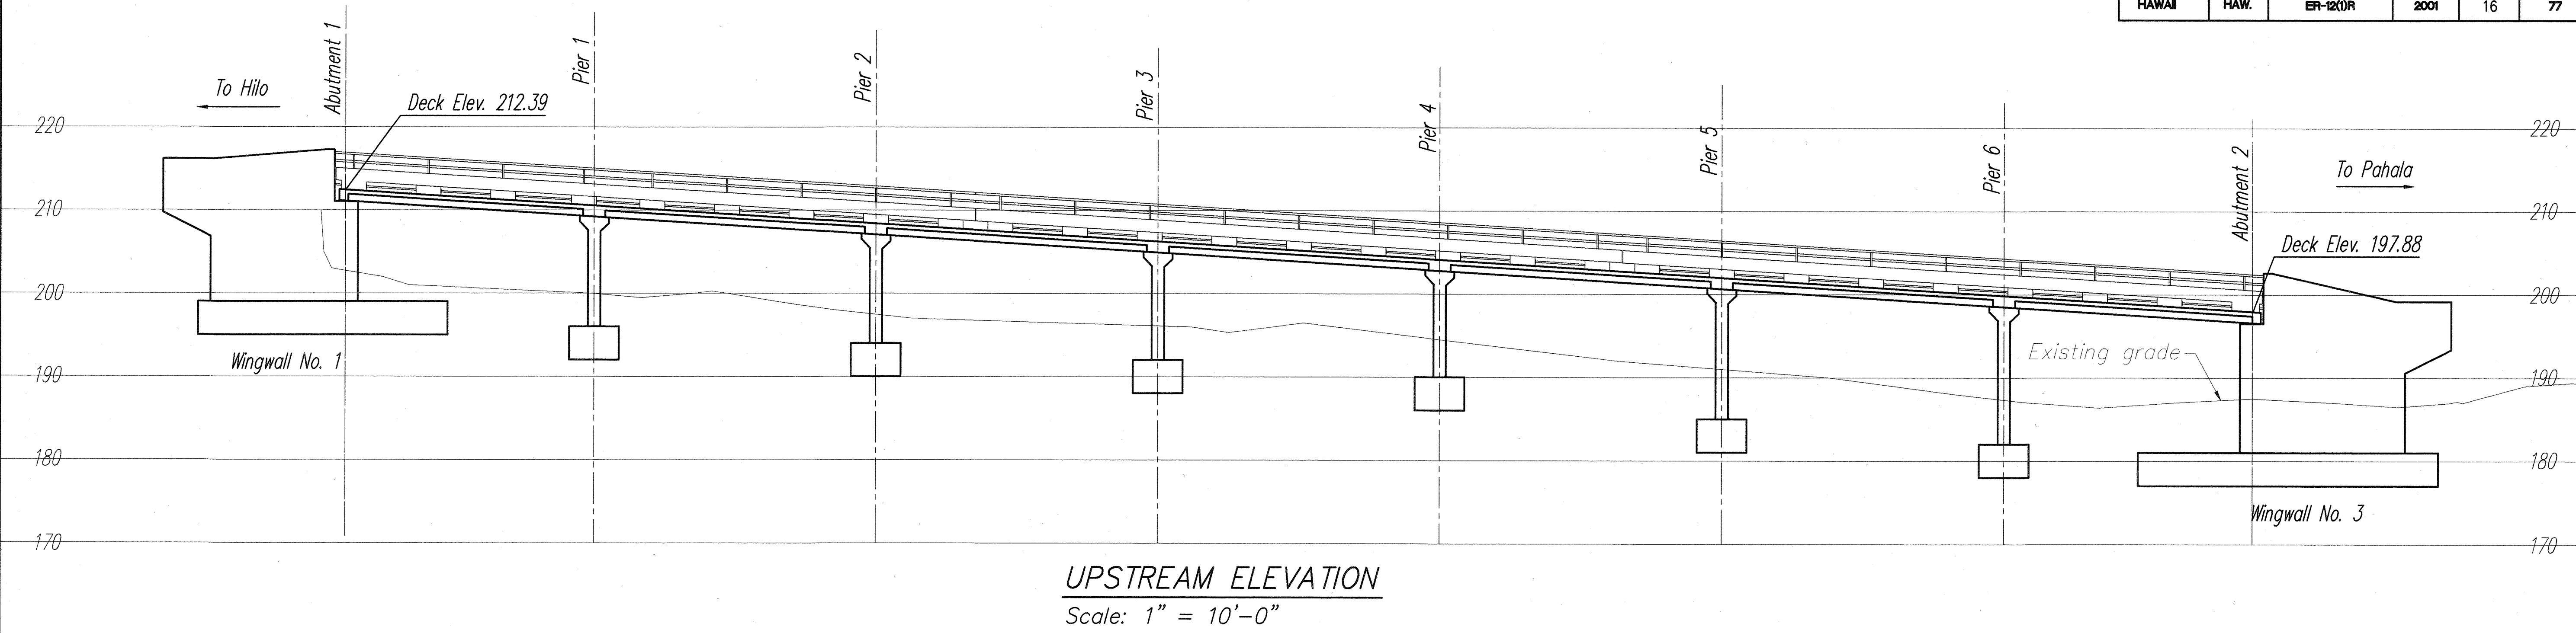


ORIGINAL PLAN	SURVEY PLOTTED BY	DATE
DESIGNED BY KSE	DESIGNED BY KSE	DEC 2000
QUANTITIES BY	QUANTITIES BY	
CHECKED BY	CHECKED BY	
No.		

STEWART N. WILLIAMS
LICENSED PROFESSIONAL ENGINEER
NO. 3908-S
HAWAII, U.S.A.

Stewart N. Williams
THIS WORK WAS PREPARED BY ME OR UNDER MY SUPERVISION.

DAVID K. FUJIWARA
LICENSED PROFESSIONAL ENGINEER
NO. 8104-S
HAWAII, U.S.A.

David K. Fujiwara
THIS WORK WAS PREPARED BY ME OR UNDER MY SUPERVISION.

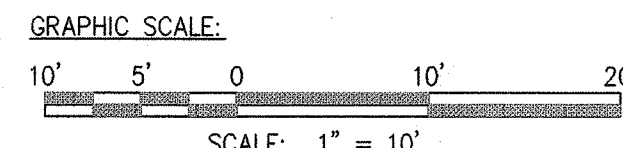

STATE OF HAWAII
DEPARTMENT OF TRANSPORTATION
HIGHWAYS DIVISION

BRIDGE ELEVATIONS


**MAMALAHOA HIGHWAY
REPLACEMENT OF
KEAIIA STREAM BRIDGE**

Federal Aid Project No. ER-12(1)R

Scale: As Shown Date: January 2001

SHEET No. S1.3 OF 50 SHEETS

FED. ROAD DIST. NO.	STATE	FED. AID PROJ. NO.	FISCAL YEAR	SHEET NO.	TOTAL SHEETS
HAWAII	HAW.	ER-12(1)R	2001	17 S-1	77

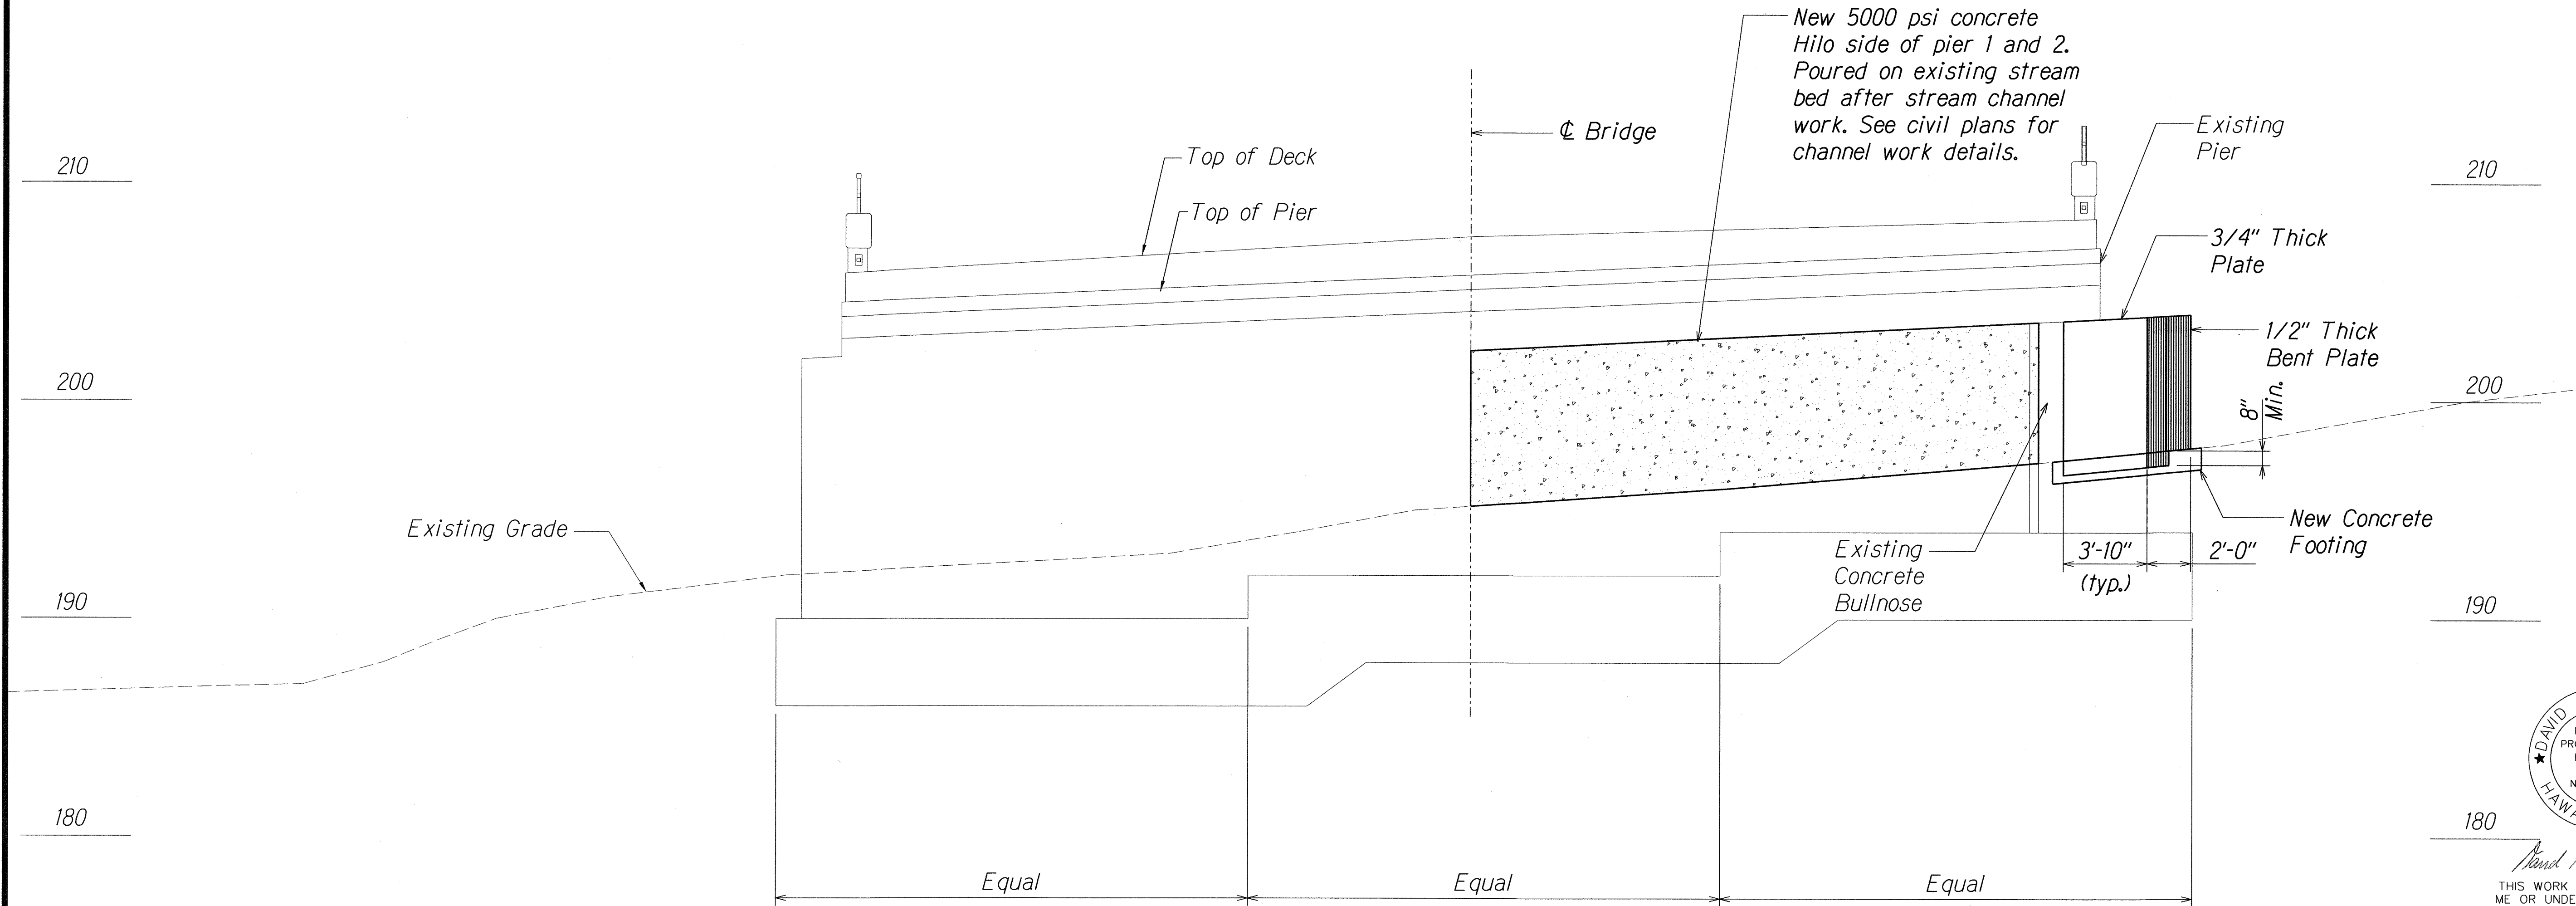

ORIGINAL PLAN	SURVEY PLOTTED BY	DATE
	DRAWN BY	DATE
	DESIGNED BY	DATE
	CHECKED BY	DATE
NOTE BOOK	DESIGNED BY	DATE
	CHECKED BY	DATE
	DATE	DATE
	DATE	DATE

SECTION - PIER 1 AND 2 1
 SCALE: 1/4" = 1'-0" S2JA S2JA

02-15-07	C.O. - New Sheet
DATE	REVISION

STATE OF HAWAII
DEPARTMENT OF TRANSPORTATION
HIGHWAYS DIVISION

SECTION - PIER 1 AND 2


MAMALAHOA HIGHWAY
REPLACEMENT OF
KEATWA STREAM BRIDGE
Federal Aid Project No. ER-12(1)R

Scale: As Shown Date: January 2001

SHEET No. S2JA OF 50 SHEETS

THIS WORK WAS PREPARED BY
 ME OR UNDER MY SUPERVISION.

FED. ROAD DIST. NO.	STATE	FED. AID PROJ. NO.	FISCAL YEAR	SHEET NO.	TOTAL SHEETS
HAWAII	HAW.	ER-12(1)R	2001	17 S-2	77

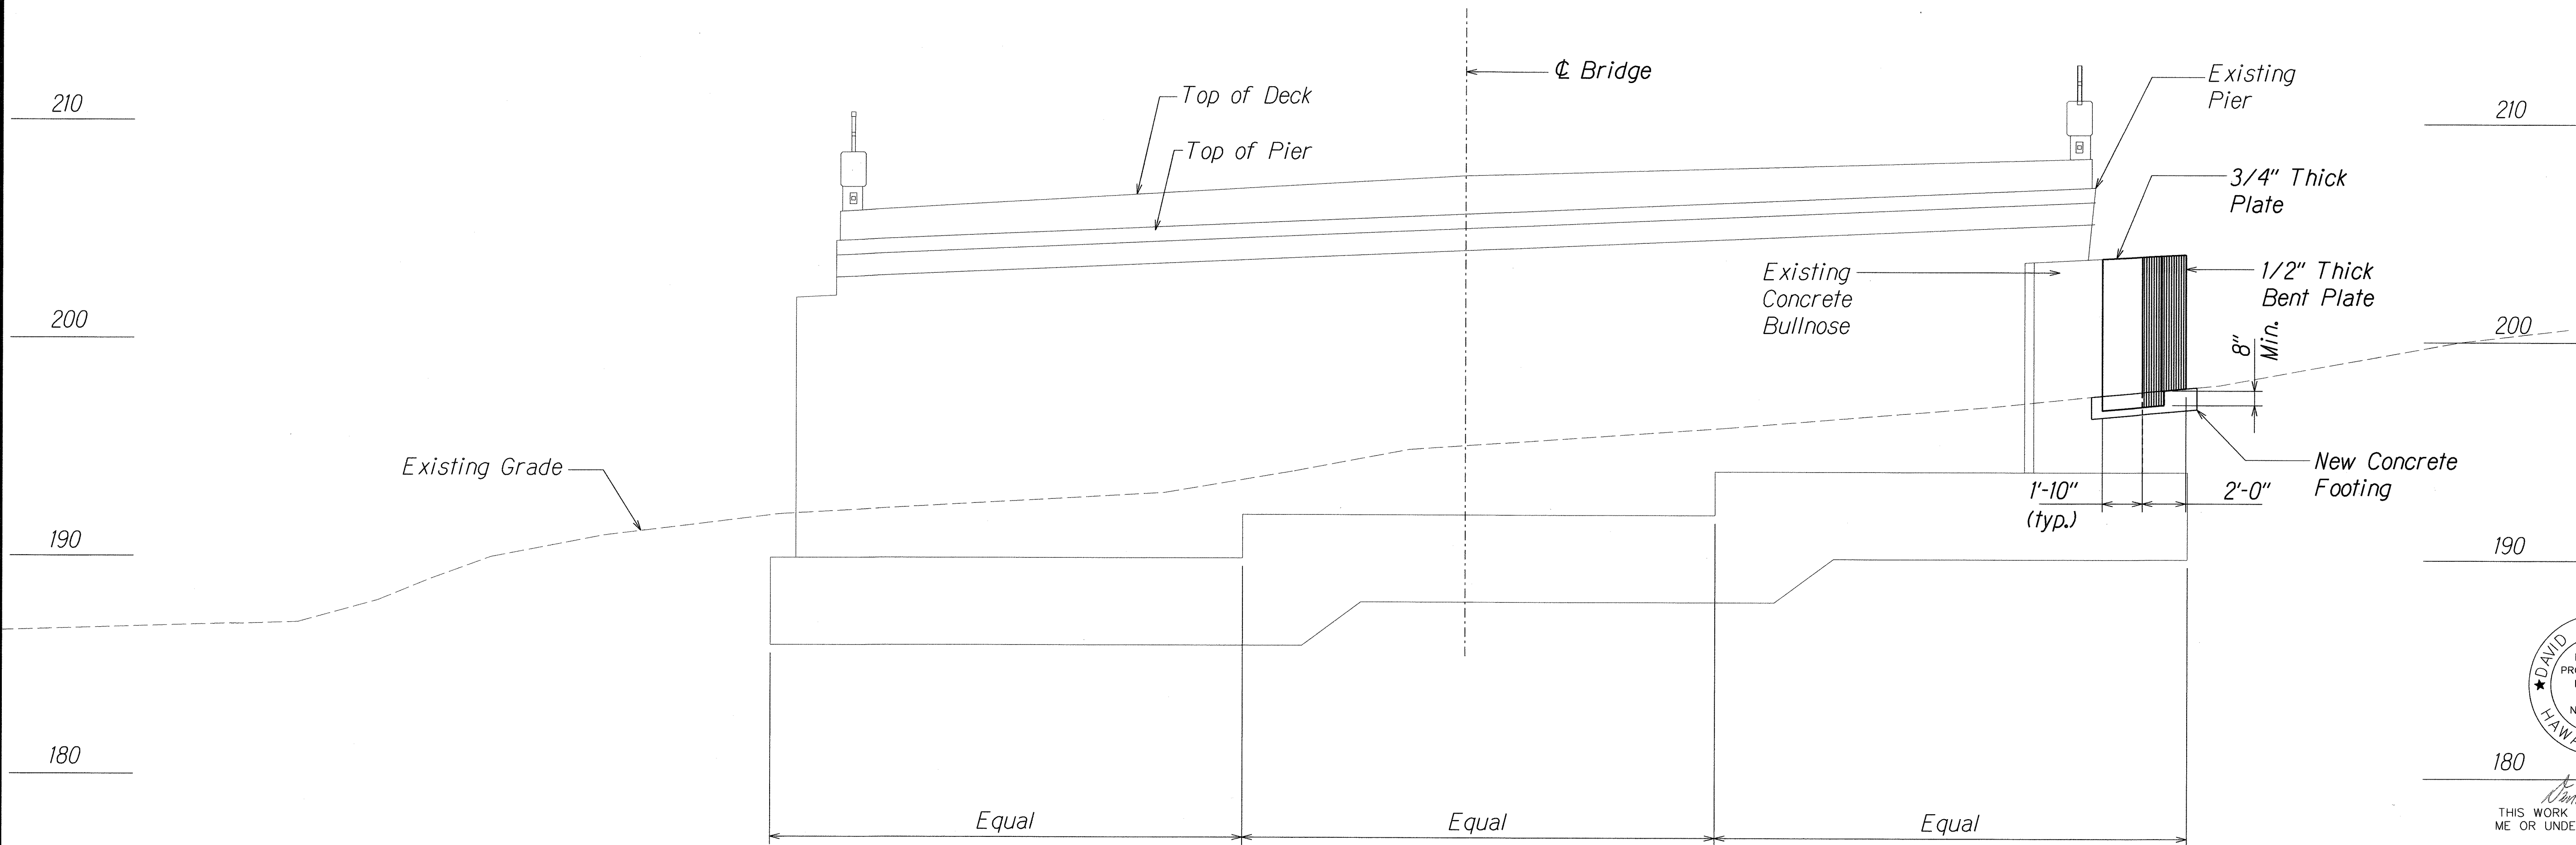

SURVEY PLOTTED BY	DATE
DRAWN BY	1/27
CHECKED BY	KSF
NOTED BY	KSF
QUANTITIES BY	
CHECKED BY	
ORIGINAL PLAN	
NOTE BOOK	
NO. 521B (1)R	

SECTION - PIER 3 THRU 6 ¹
SCALE: 1/4" = 1'-0" S21B S21B


02-15-07	C.O. - New Sheet
DATE	REVISION

STATE OF HAWAII
DEPARTMENT OF TRANSPORTATION
HIGHWAYS DIVISION

SECTION - PIER 3 THRU 6
MAMALAHOA HIGHWAY
REPLACEMENT OF
KEAIWA STREAM BRIDGE
Federal-Aid Project No. ER-12(1)R


Scale: As Shown Date: January 2001

SHEET No. S21B OF 50 SHEETS

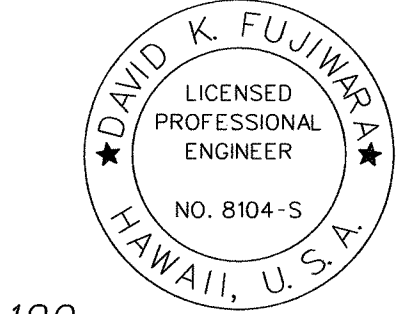


THIS WORK WAS PREPARED BY
ME OR UNDER MY SUPERVISION.

FED. ROAD DIST. NO.	STATE	FED. AID PROJ. NO.	FISCAL YEAR	SHEET NO.	TOTAL SHEETS
HAWAII	HAW.	ER-12(1)R	2001	18	77

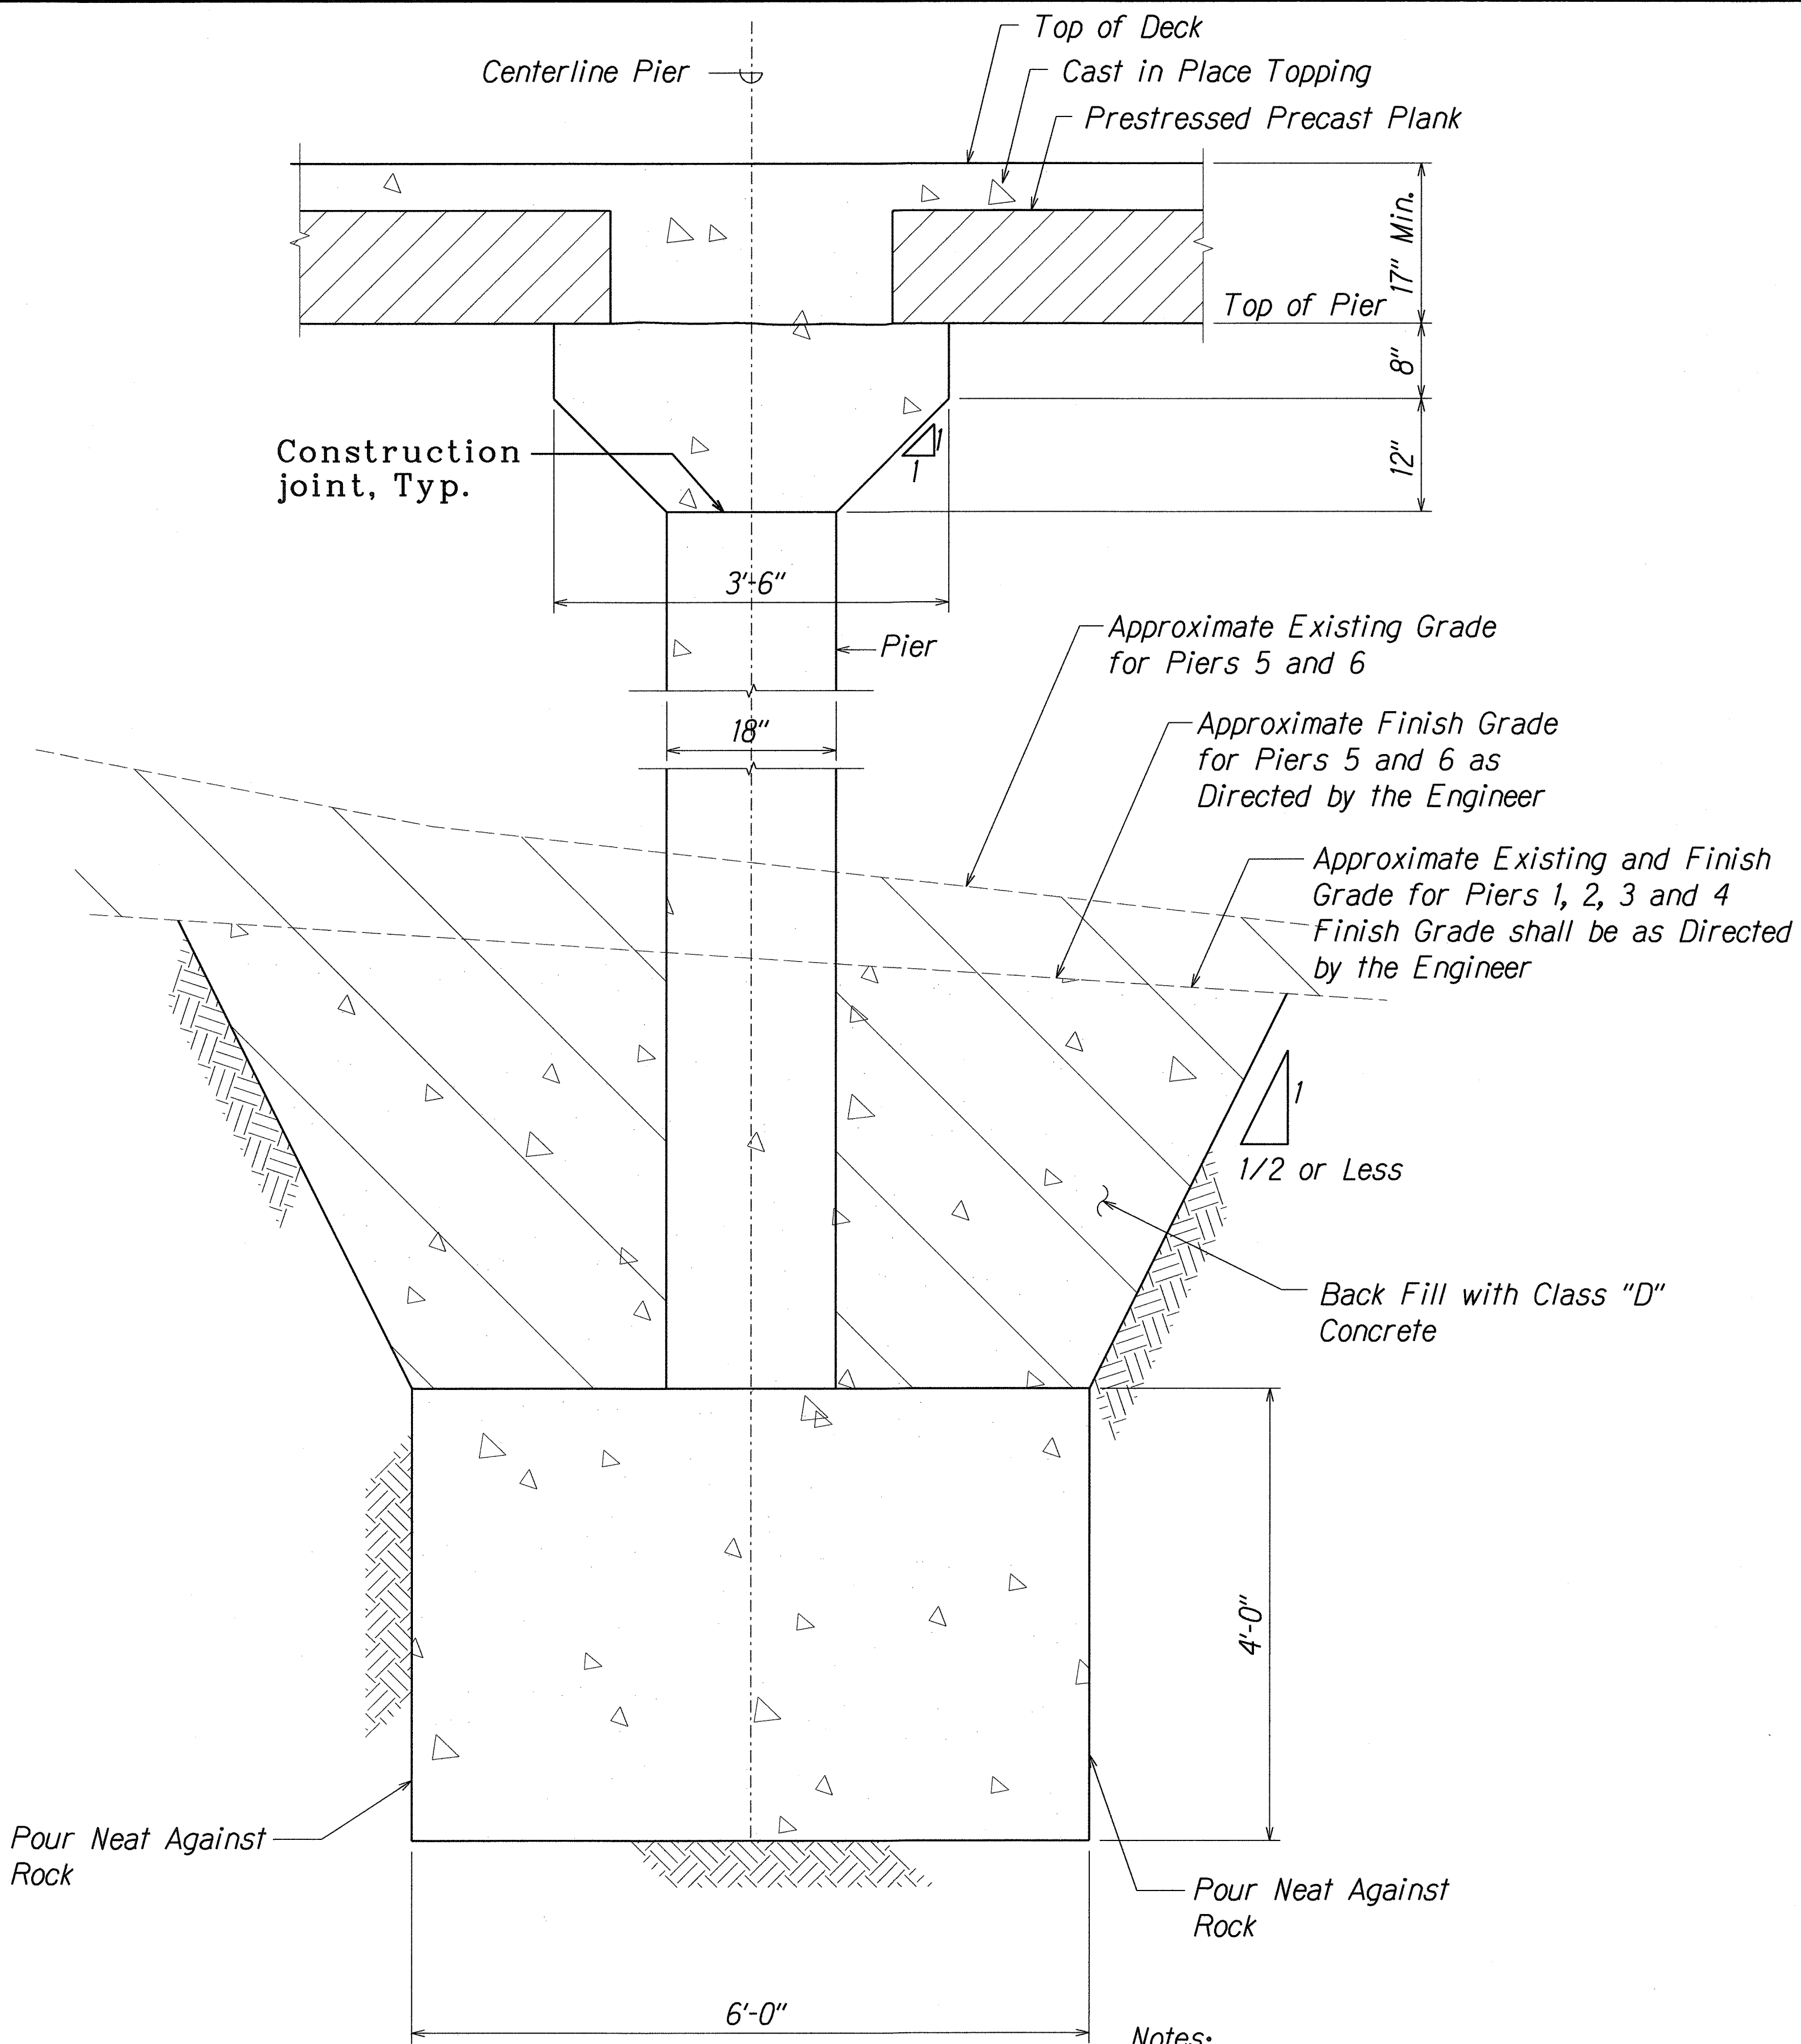


SECTION A
Scale: 1" = 1'-0"


- Notes:**
1. For Structural Excavation and Backfill Pay Limits, see Sheet S5.7
 2. Finish Grade for All Piers shall be As Directed by the Engineer.

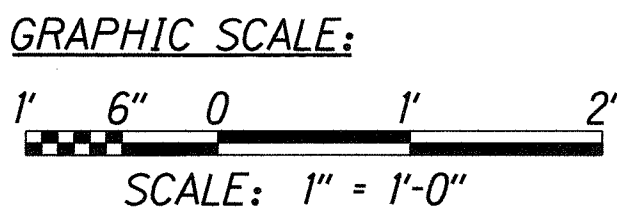


B
S2.2 | S2.2

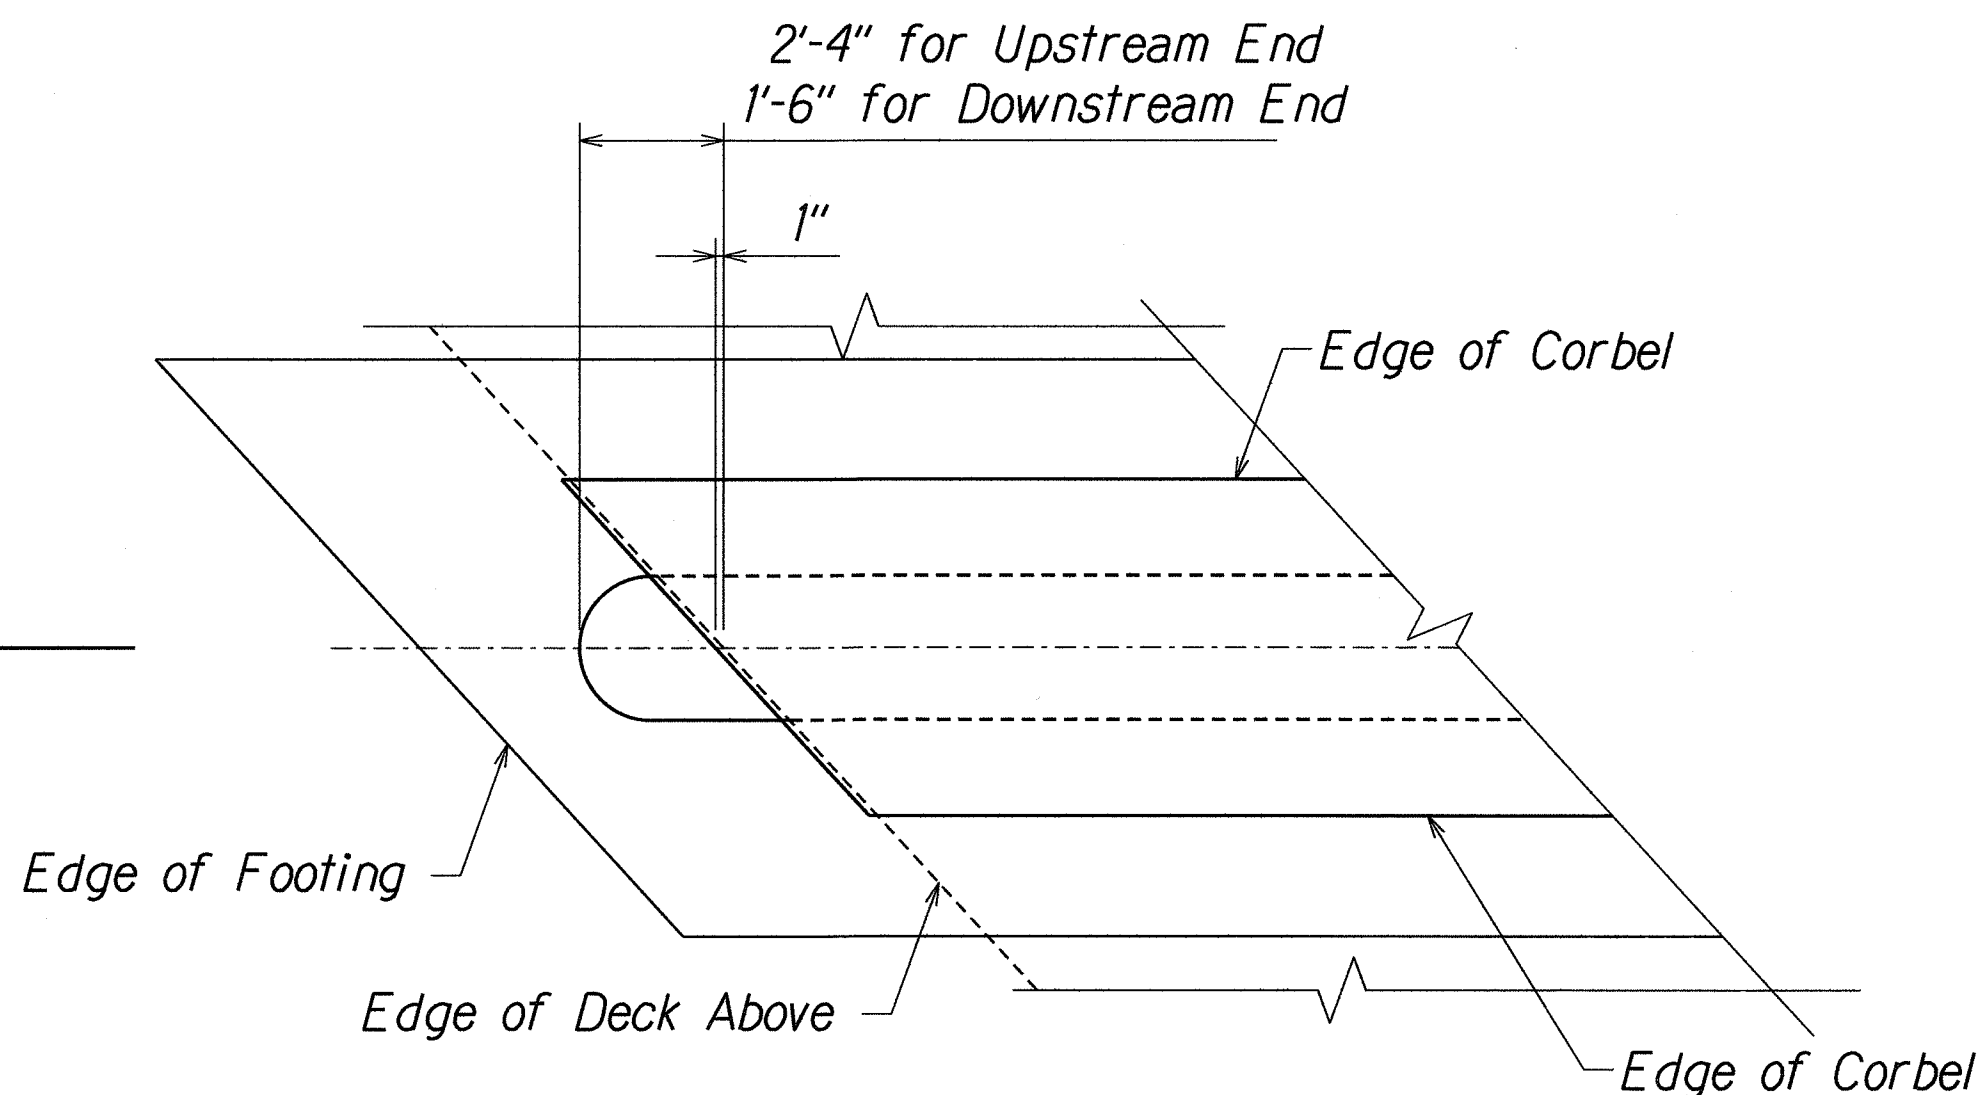

CORBEL DETAIL 1
Scale: 1/2" = 1'-0"

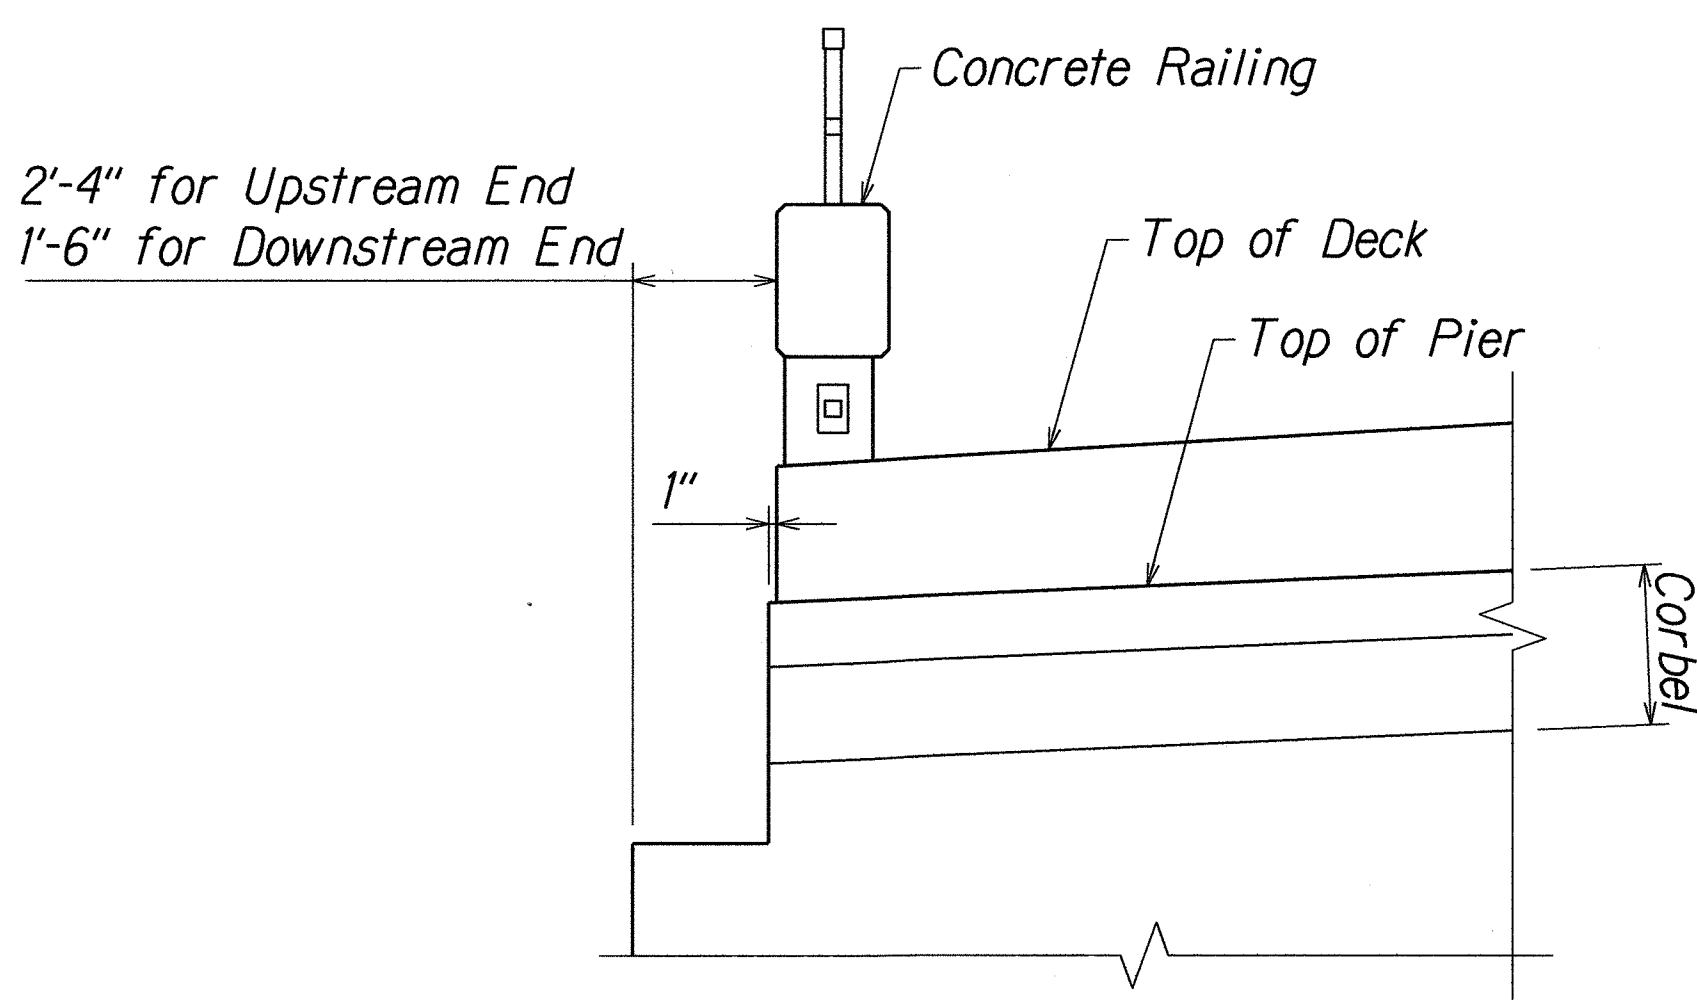

SECTION B
S2.2 | S2.2

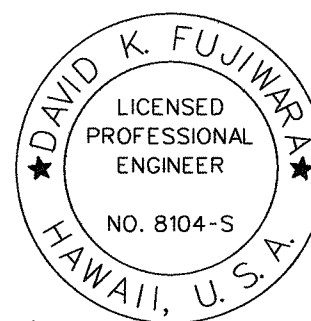

David K. Fujiwara
THIS WORK WAS PREPARED BY ME OR UNDER MY SUPERVISION.


LEGEND FOR AS-BUILT POSTINGS	
	Squiggly line for as-built deletion
	Double line for as-built deletion
Roadway	Text for as-built posting

02-15-07	As Built - Revised Detail
DATE	REVISION

STATE OF HAWAII DEPARTMENT OF TRANSPORTATION HIGHWAYS DIVISION	
TYPICAL SECTIONS	
MAMALAHOA HIGHWAY REPLACEMENT OF KEAIIA STREAM BRIDGE Federal-Aid Project No. ER-12(1)R	
Scale: As Shown	Date: January 2001
SHEET No. S2.2 OF 50 SHEETS	

AS-BUILT

FED. ROAD DIST. NO.	STATE	FED. AID PROJ. NO.	FISCAL YEAR	SHEET NO.	TOTAL SHEETS
HAWAII	HAW.	ER-12(1)R	2001	19	77

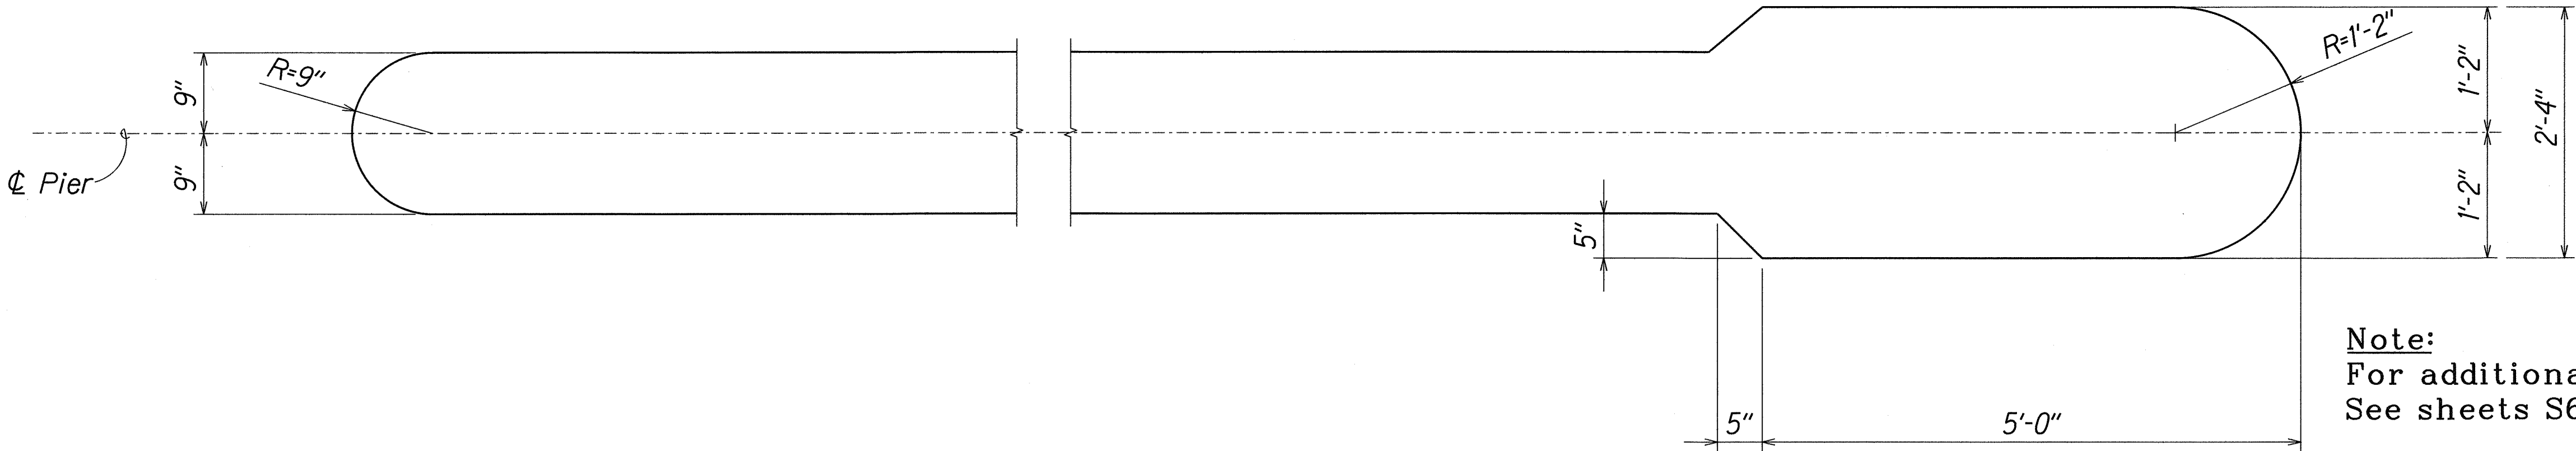


DOWNSTREAM NOSING DETAIL

UPSTREAM BUMPER NOSING DETAIL


TYPICAL NOSING PLAN A
Scale: 1" = 1'-0" SIJ S2.3

ORIGINAL PLAN	SURVEY PLOTTED BY	DATE
NOTE BOOK	DRAWN BY	NOV/2000
	TRACED BY	
	DESIGNED BY	
	QUANTITIES BY	
	CHECKED BY	

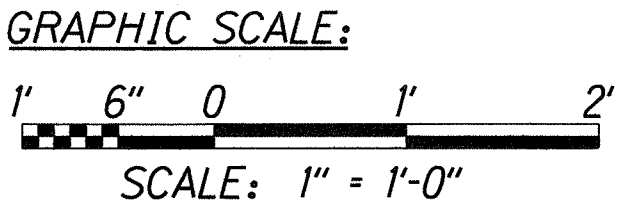

LEGEND FOR AS-BUILT POSTINGS	
	Squiggly line for as-built deletion
	Double line for as-built deletion
Roadway	Text for as-built posting

02-15-07	As Built - Revised Detail
DATE	REVISION

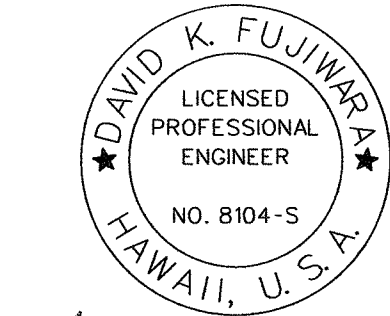

THIS WORK WAS PREPARED BY ME OR UNDER MY SUPERVISION.

STATE OF HAWAII
DEPARTMENT OF TRANSPORTATION
HIGHWAYS DIVISION

TYPICAL PIER NOSING DETAIL

MAMALAHOA HIGHWAY
REPLACEMENT OF
KEAUA STREAM BRIDGE
Federal-Aid Project No. ER-12(1)R



Scale: As Shown Date: January 2001

SHEET No. S2.3 OF 50 SHEETS


FED. ROAD DIST. NO.	STATE	FED. AID PROJ. NO.	FISCAL YEAR	SHEET NO.	TOTAL SHEETS
HAWAII	HAW.	ER-12(1)R	2001	20	77

LEGEND:

209.90 Top of Deck Elevation
PP1 Precast Plank Type

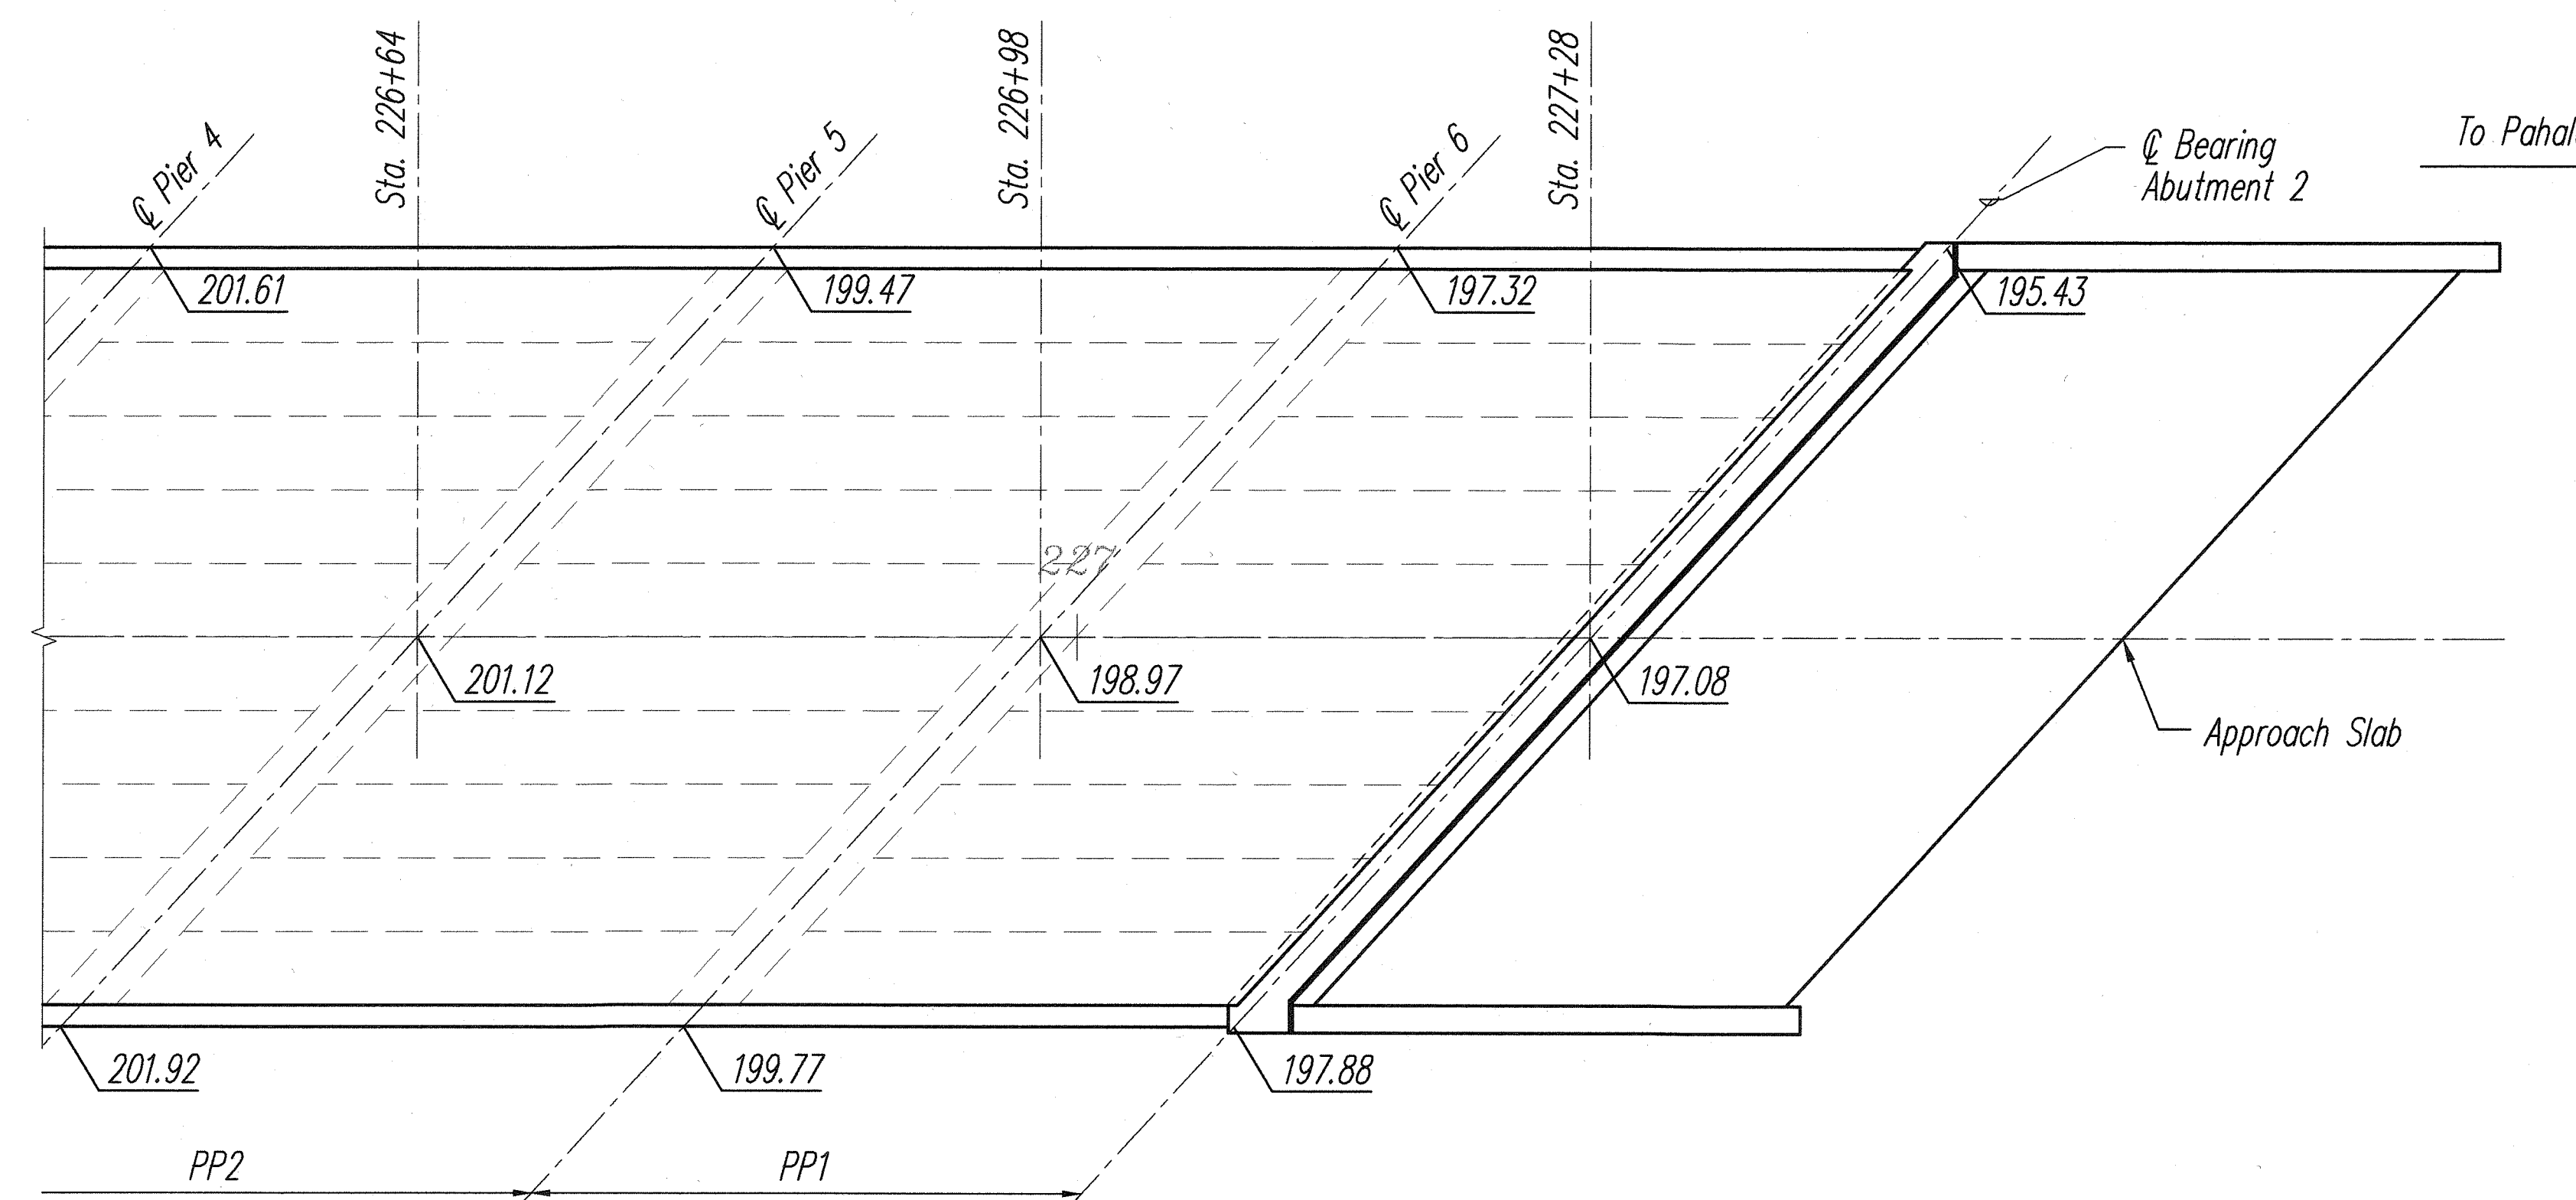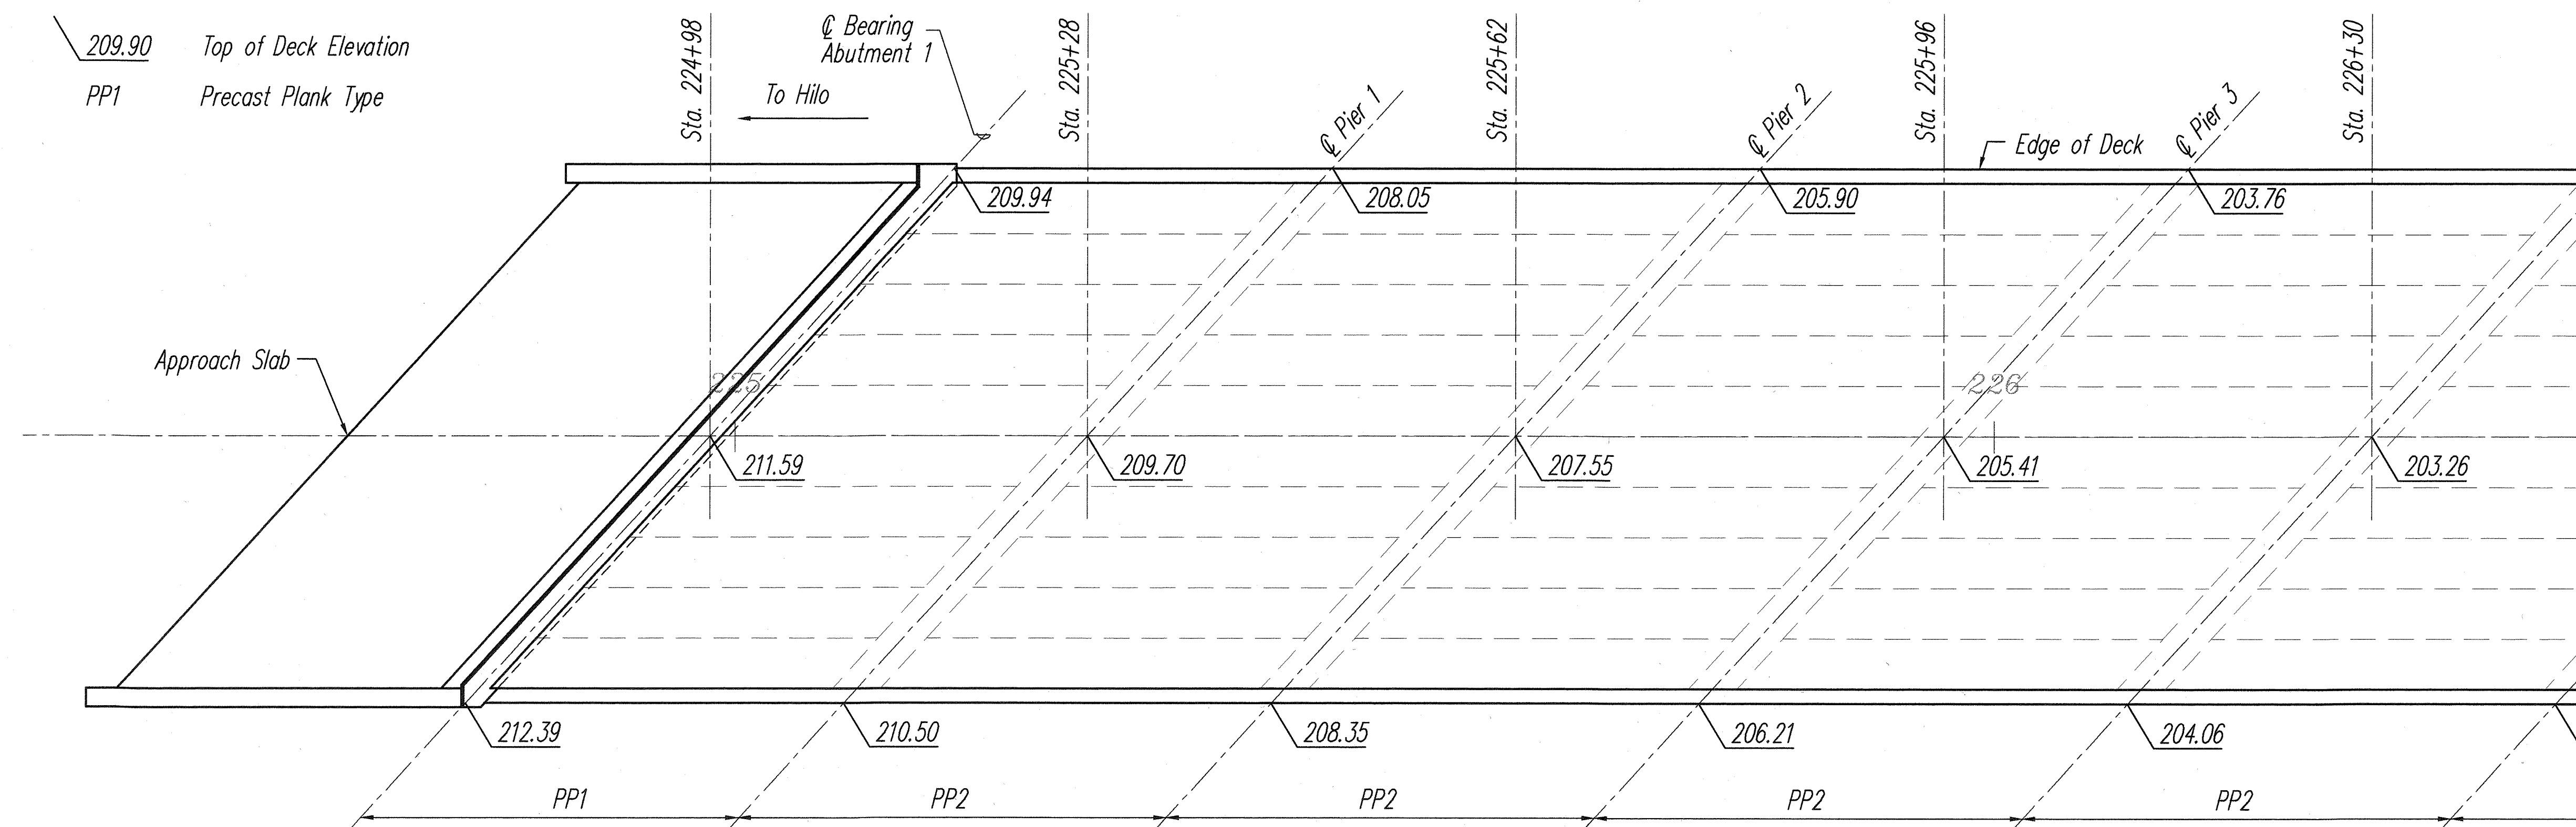

TOP OF DECK ELEVATION PLAN
Scale: 1/8" = 1'-0"

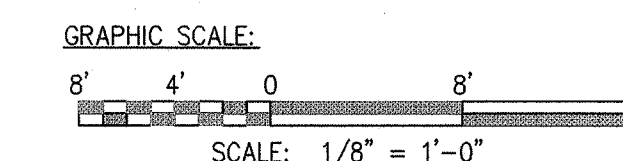

ORIGINAL PLAN	DATE
SURVEY PLANNED BY	NOV/2000
DRAWN BY	
TRACED BY	
DESIGNED BY	
QUANTITIES BY	
CHECKED BY	
No.	



David K. Fujiwara

THIS WORK WAS PREPARED BY
ME OR UNDER MY SUPERVISION.


STATE OF HAWAII
DEPARTMENT OF TRANSPORTATION
HIGHWAYS DIVISION

TOP OF DECK ELEVATION

MAMALAHOA HIGHWAY
REPLACEMENT OF
KEAIWA STREAM BRIDGE
Federal Aid Project No. ER-12(1)R
Scale: As Shown Date: January 2001

SHEET No. S3.1 OF 50 SHEETS

FED. ROAD DIST. NO.	STATE	FED. AID PROJ. NO.	FISCAL YEAR	SHEET NO.	TOTAL SHEETS
HAWAII	HAW.	ER-12(1)R	2001	21	77

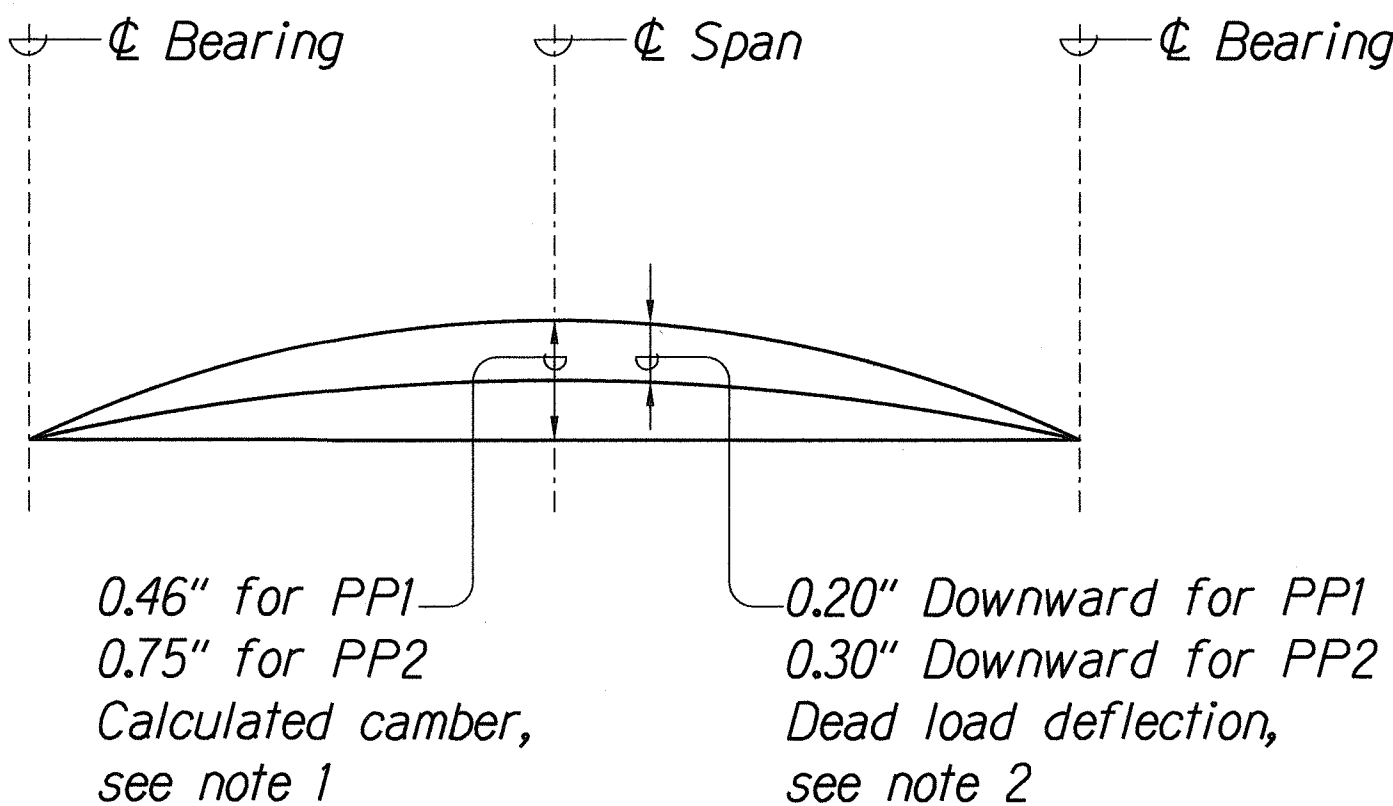


CAMBER AND DEFLECTION NOTES:

- The calculated camber includes the effect of the prestress force and the weight of the girder after removal from the bed. Positive values shown for calculated camber indicate a net upward deflection. The calculated camber value has been multiplied by creep factors to approximate the effect of camber growth and concrete creep. The actual camber shall not exceed the calculated camber by more than 1/2".
- The dead load deflection for the weight of the topping.
- All cambers and deflections are in inches.

GIRDER CAMBER DIAGRAM
Not to Scale 1
S3.2 | S3.2

LOCATION	ELEVATION "A"	ELEVATION "B"
ABUT. NO.		
1	208.38	210.83
2	193.87	196.32
PIER NO.		
1	206.55	209.00
2	204.40	206.85
3	202.26	204.71
4	200.11	202.56
5	197.97	200.42
6	195.82	198.27

DOWNSTREAM


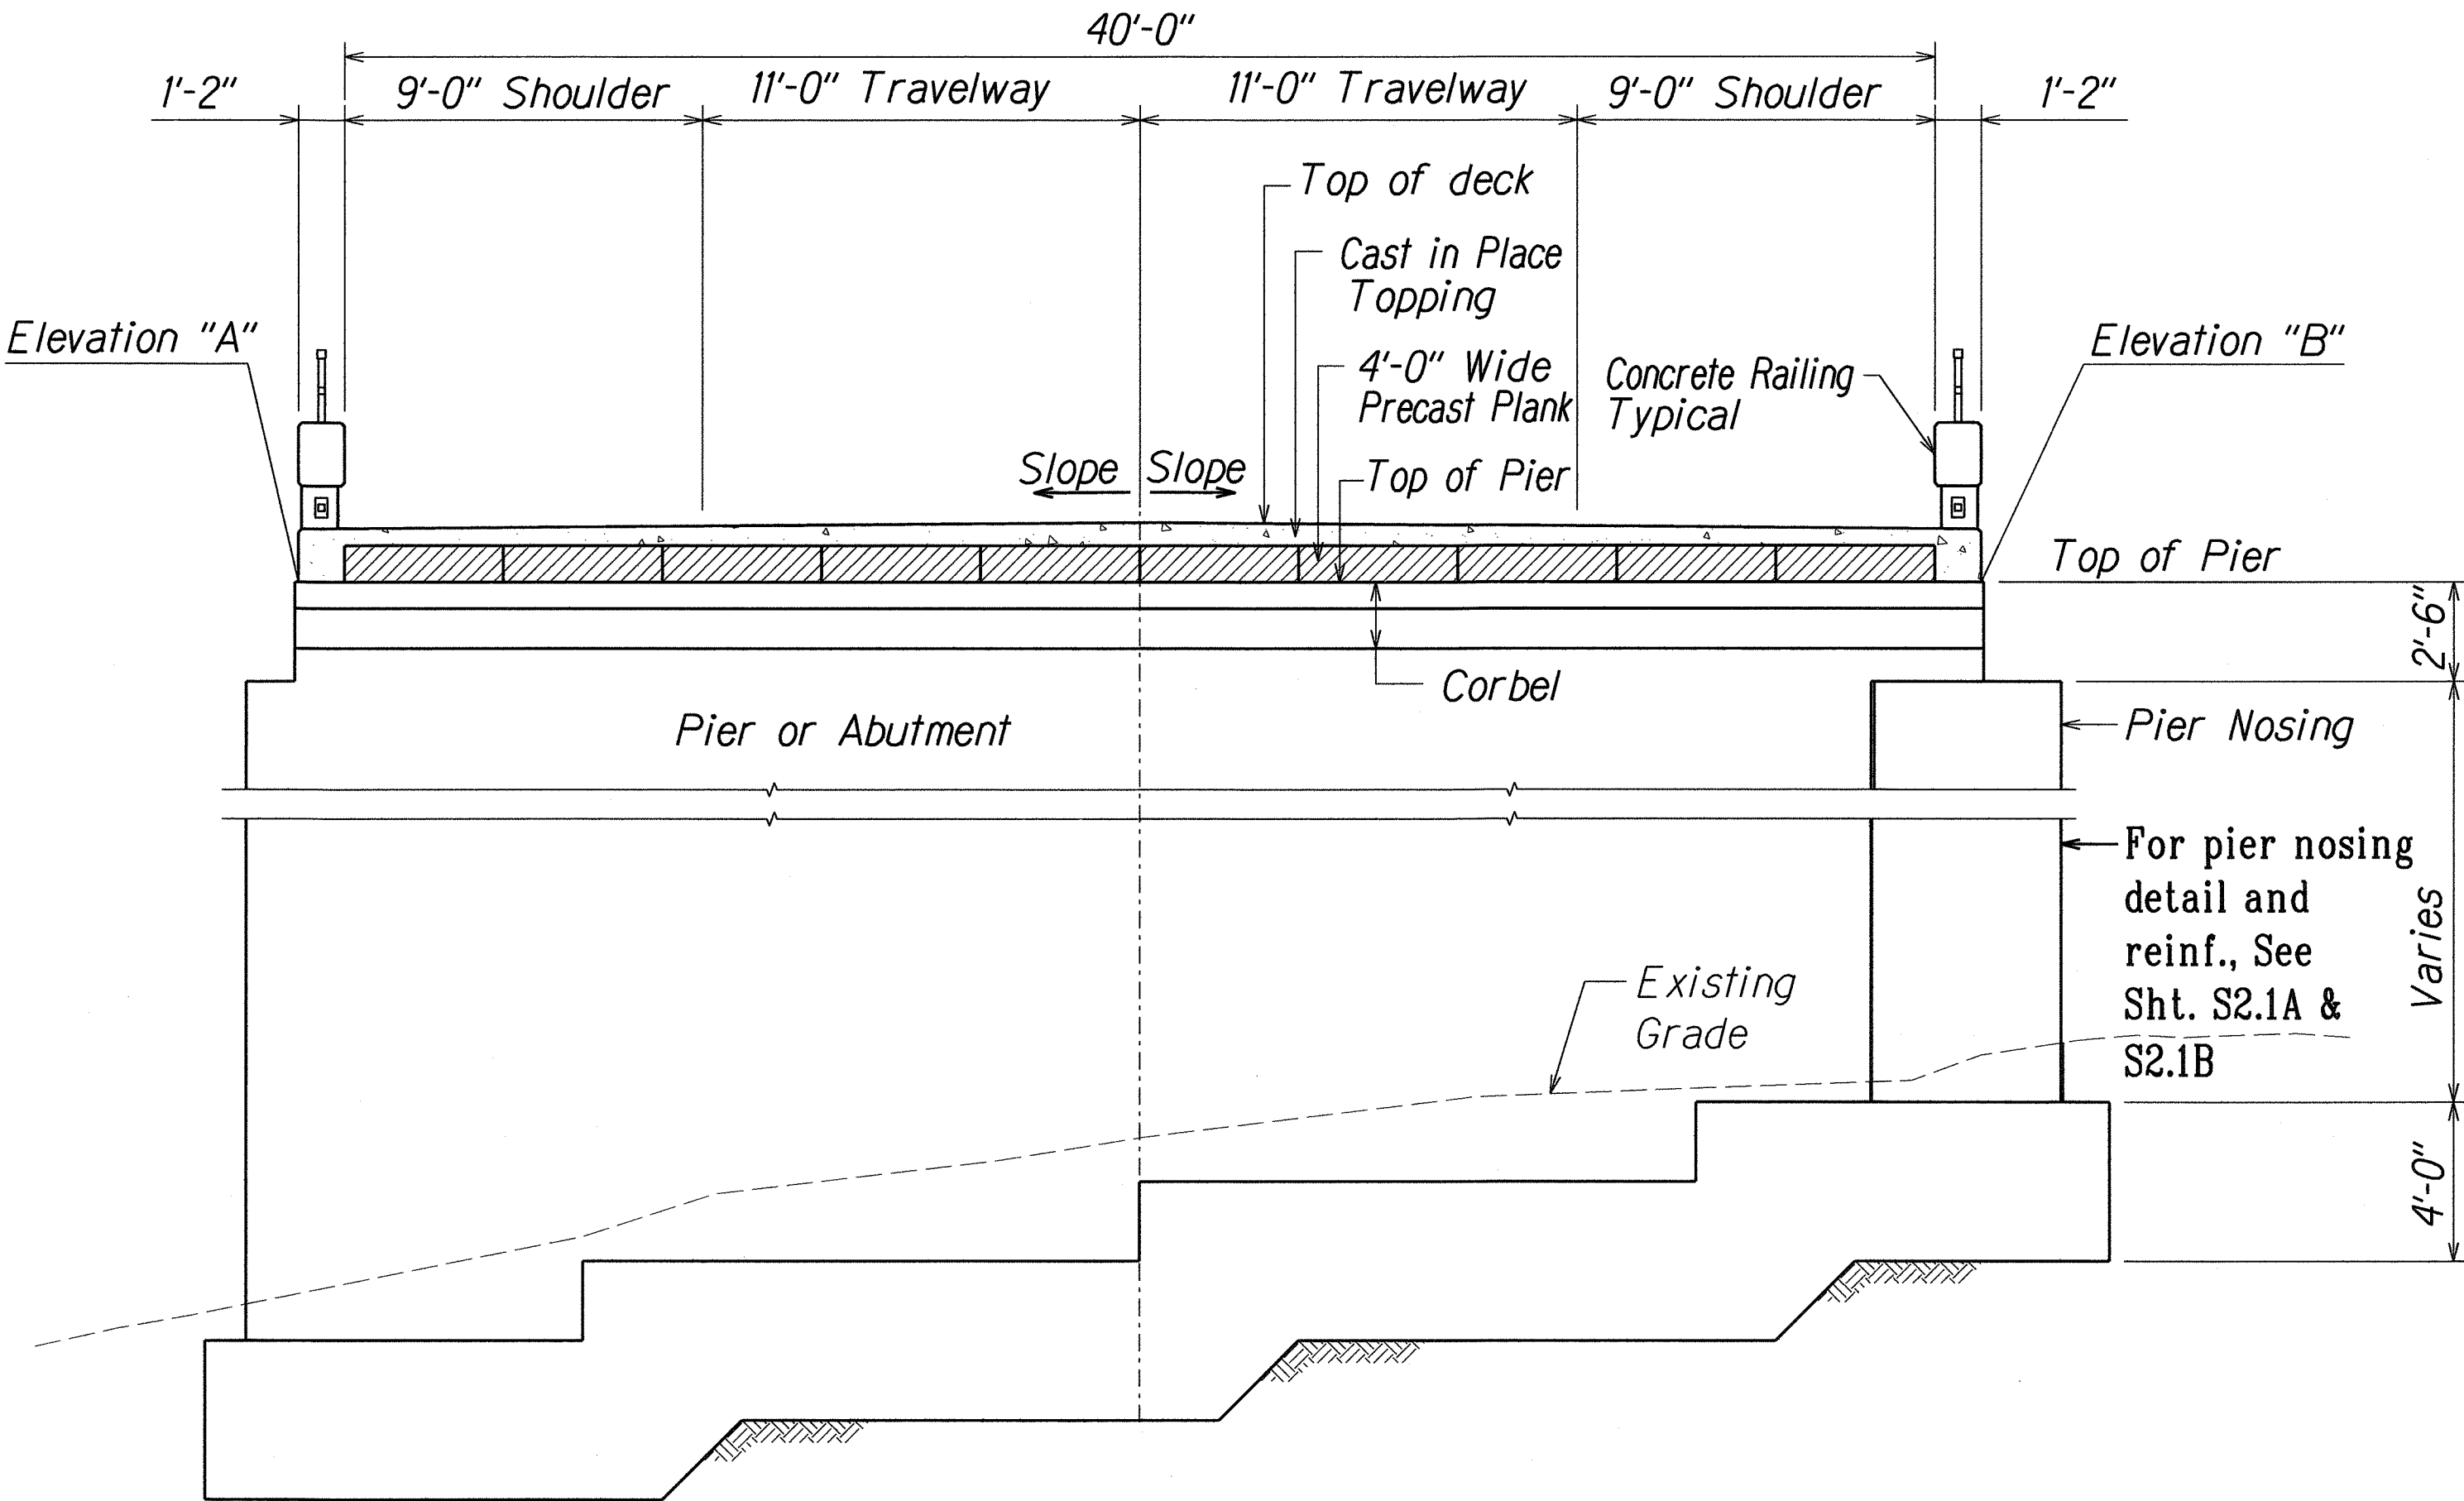


NOTES:

- Top of pier and abutment slopes shall be constant from Elevation "A" to Elevation "B".
- Top of pier and abutments also slope parallel with the bridge and shall have a constant slope of 6.31% in that direction. The higher elevation is on the Hilo side.
- Elevations "A" and "B" accounts for camber
- Elevations are at centerline pier and centerline bearing at abutments.
- Abutment elevations account for the bearing pad thickness.

NORMAL DECK SECTION AT PIER
Scale: 1/4" = 1'-0" A
S3.2 | S3.2

LEGEND FOR AS-BUILT POSTINGS	
	Squiggly line for as-built deletion
	Double line for as-built deletion
Roadway	Text for as-built posting

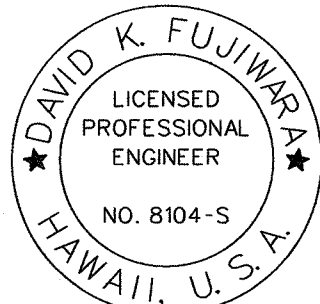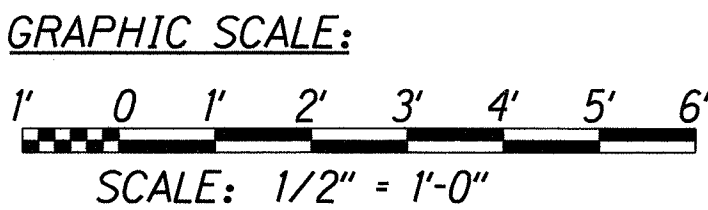


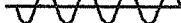

THIS WORK WAS PREPARED BY ME OR UNDER MY SUPERVISION.

AS-BUILT




STATE OF HAWAII DEPARTMENT OF TRANSPORTATION HIGHWAYS DIVISION	
TOP OF PIER ELEVATIONS AND CAMBER DIAGRAM	
MAMALAOA HIGHWAY REPLACEMENT OF KEATWA STREAM BRIDGE Federal Aid Project No. ER-12(1)R	
Scale: As Shown	Date: January 2001
SHEET No. S3.2 OF 50 SHEETS	

NOTES:

1. For Wing Wall Elevations, See Shts. S4.9 thru S4.13.
2. For Wing Wall and Abutment Footing Dimensions and Reinforcing, See Shts. S4.4 and S4.5.
3. For Bridge Rail, End Post and Metal Guard Rail Connection Details, See Sheet S4.16 and S8.1.
4. "Q Brg. Abut. No. 1" and "Q Brg. Abut. No. 2" are given as References for Grading and Layout. Centerlines of 1" Dia. Threaded Rods and Elastomeric Bearing Pads are Off-set from these and are shown on Details 1 and 2 on this Sheet. See also Sheet S8.1.

<u>LEGEND FOR</u>	
<u>AS-BUILT POSTINGS</u>	
	Squiggly line for as-built deletion
	Double line for as-built deletion
	Text for as-built posting

01-30-01	1 Added 1"x1" Notches @ End Posts
DATE	DESCRIPTION
<p>STATE OF HAWAII DEPARTMENT OF TRANSPORTATION HIGHWAYS DIVISION</p> <p><u>ABUTMENT NO.1</u> <u>and NO.2 SEAT PLAN</u> <u>MAMALAHOA HIGHWAY</u> <u>REPLACEMENT OF</u> <u>KEAIIA STREAM BRIDGE</u> <u>Federal Aid Project No. ER-12(1)R</u></p> <p>Scale: As Noted Date: January 2001</p>	
SHEET No. 54.1 OF 50 SHEETS	

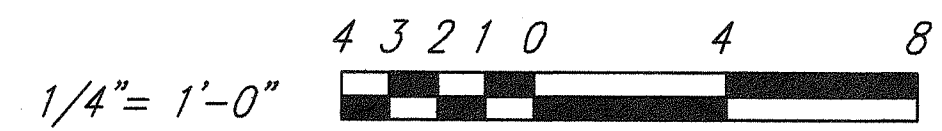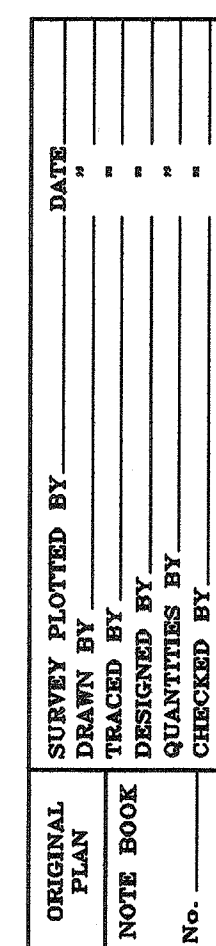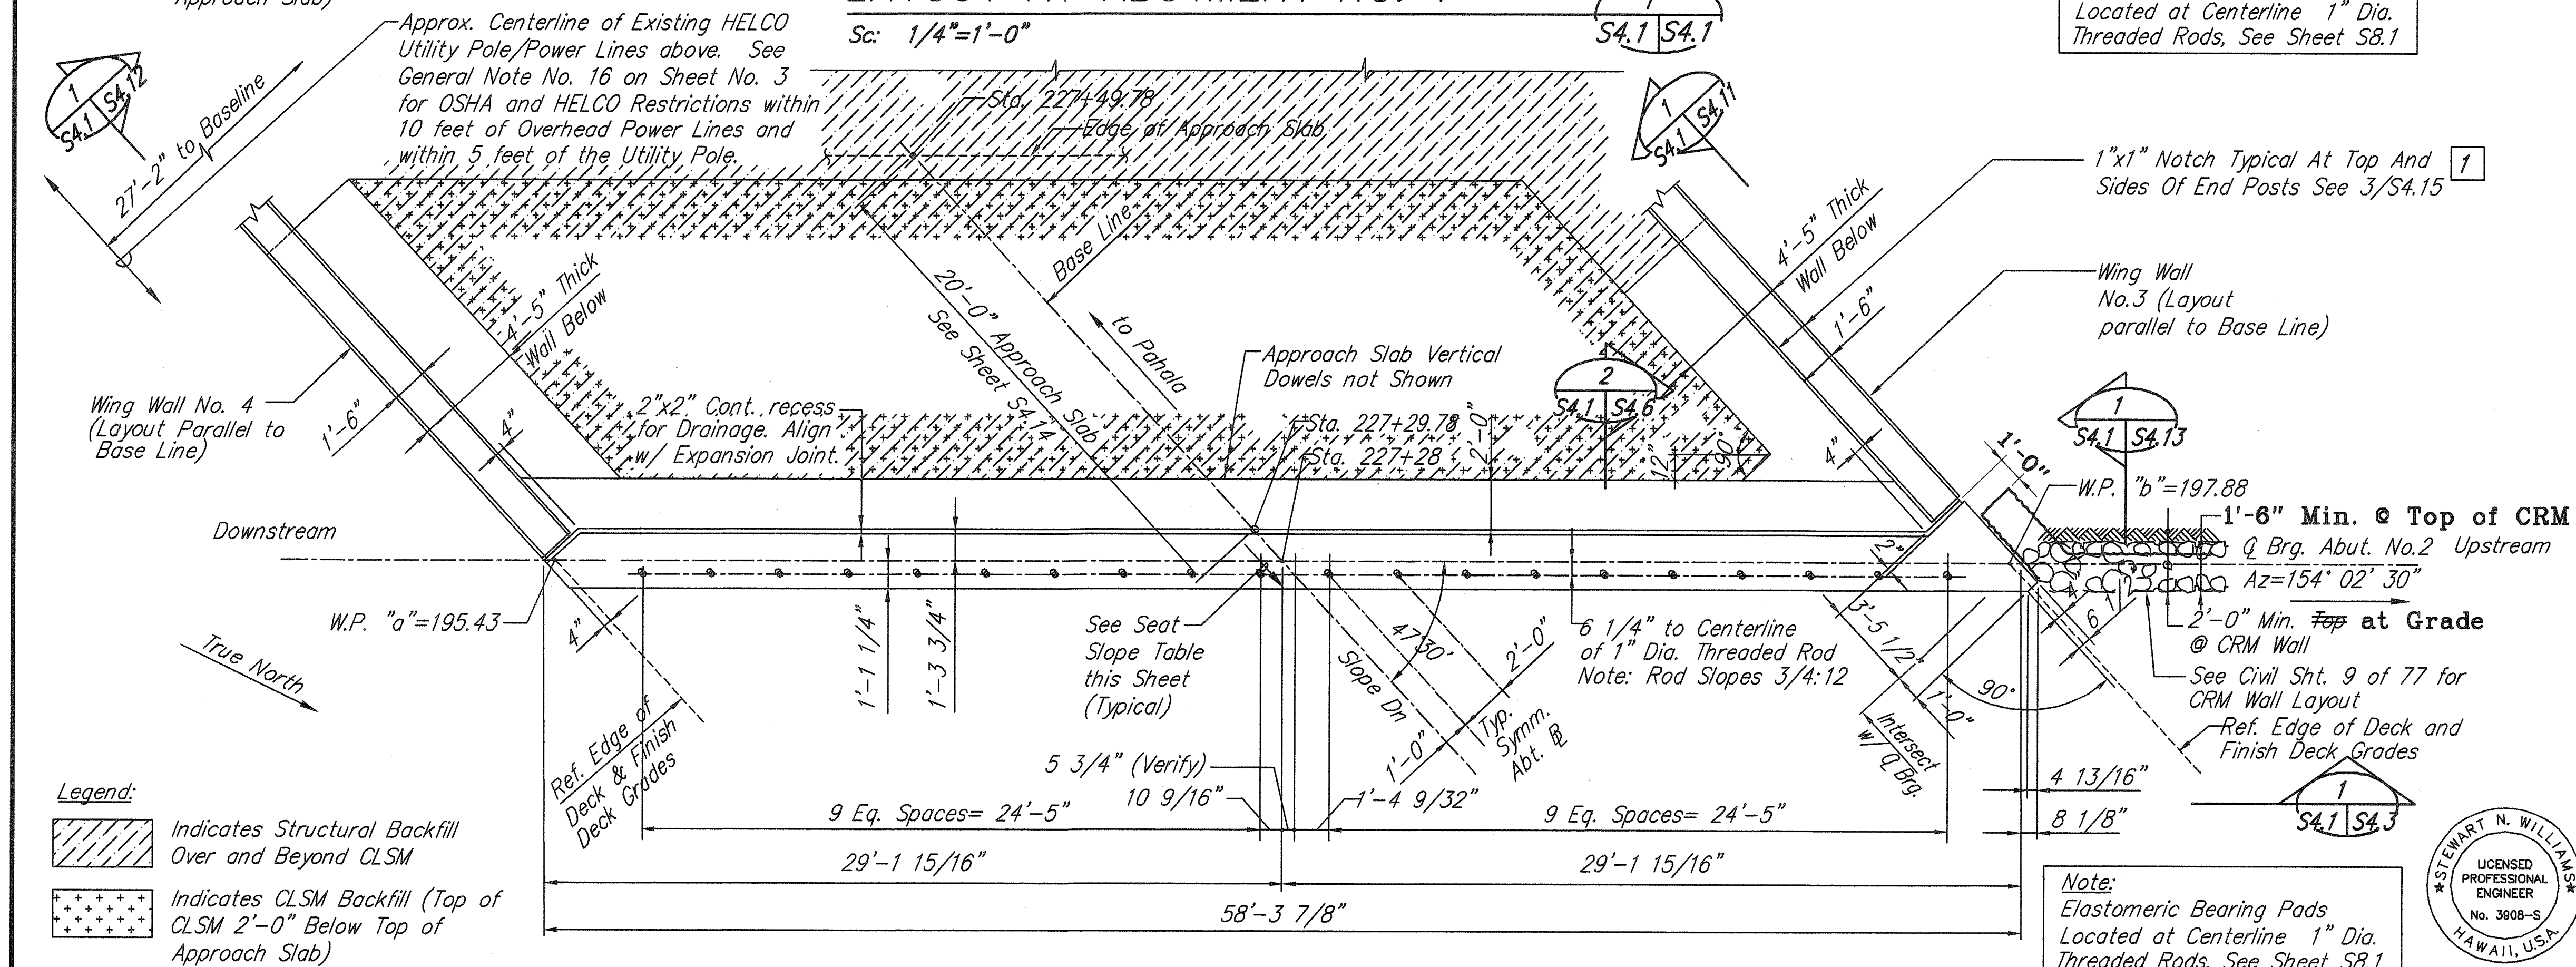


AS-BUILT


FED. ROAD DIST. NO.	STATE	FED. AID PROJ. NO.	FISCAL YEAR	SHEET NO.	TOTAL SHEETS
HAWAII	HAW.	ER-12 (1)R	2001	23	77

Notes:


1. Refer to S1.1 for Probe Hole Locations.
2. Refer to S4.8 for Excavation and Backfill Limits.
3. Abutment Walls Shall Be 2 Pours Minimum - Separated 3 Days Minimum. Horizontal Reinforcing Shall be Continuous Through The Joint. Provide a 2" X 1'-4" Wide Vertical Key Centered On The Wall Width. Apply Approved Bonding Agent In Accordance with Manufacturers Recommendations Prior To Adjacent Pours.

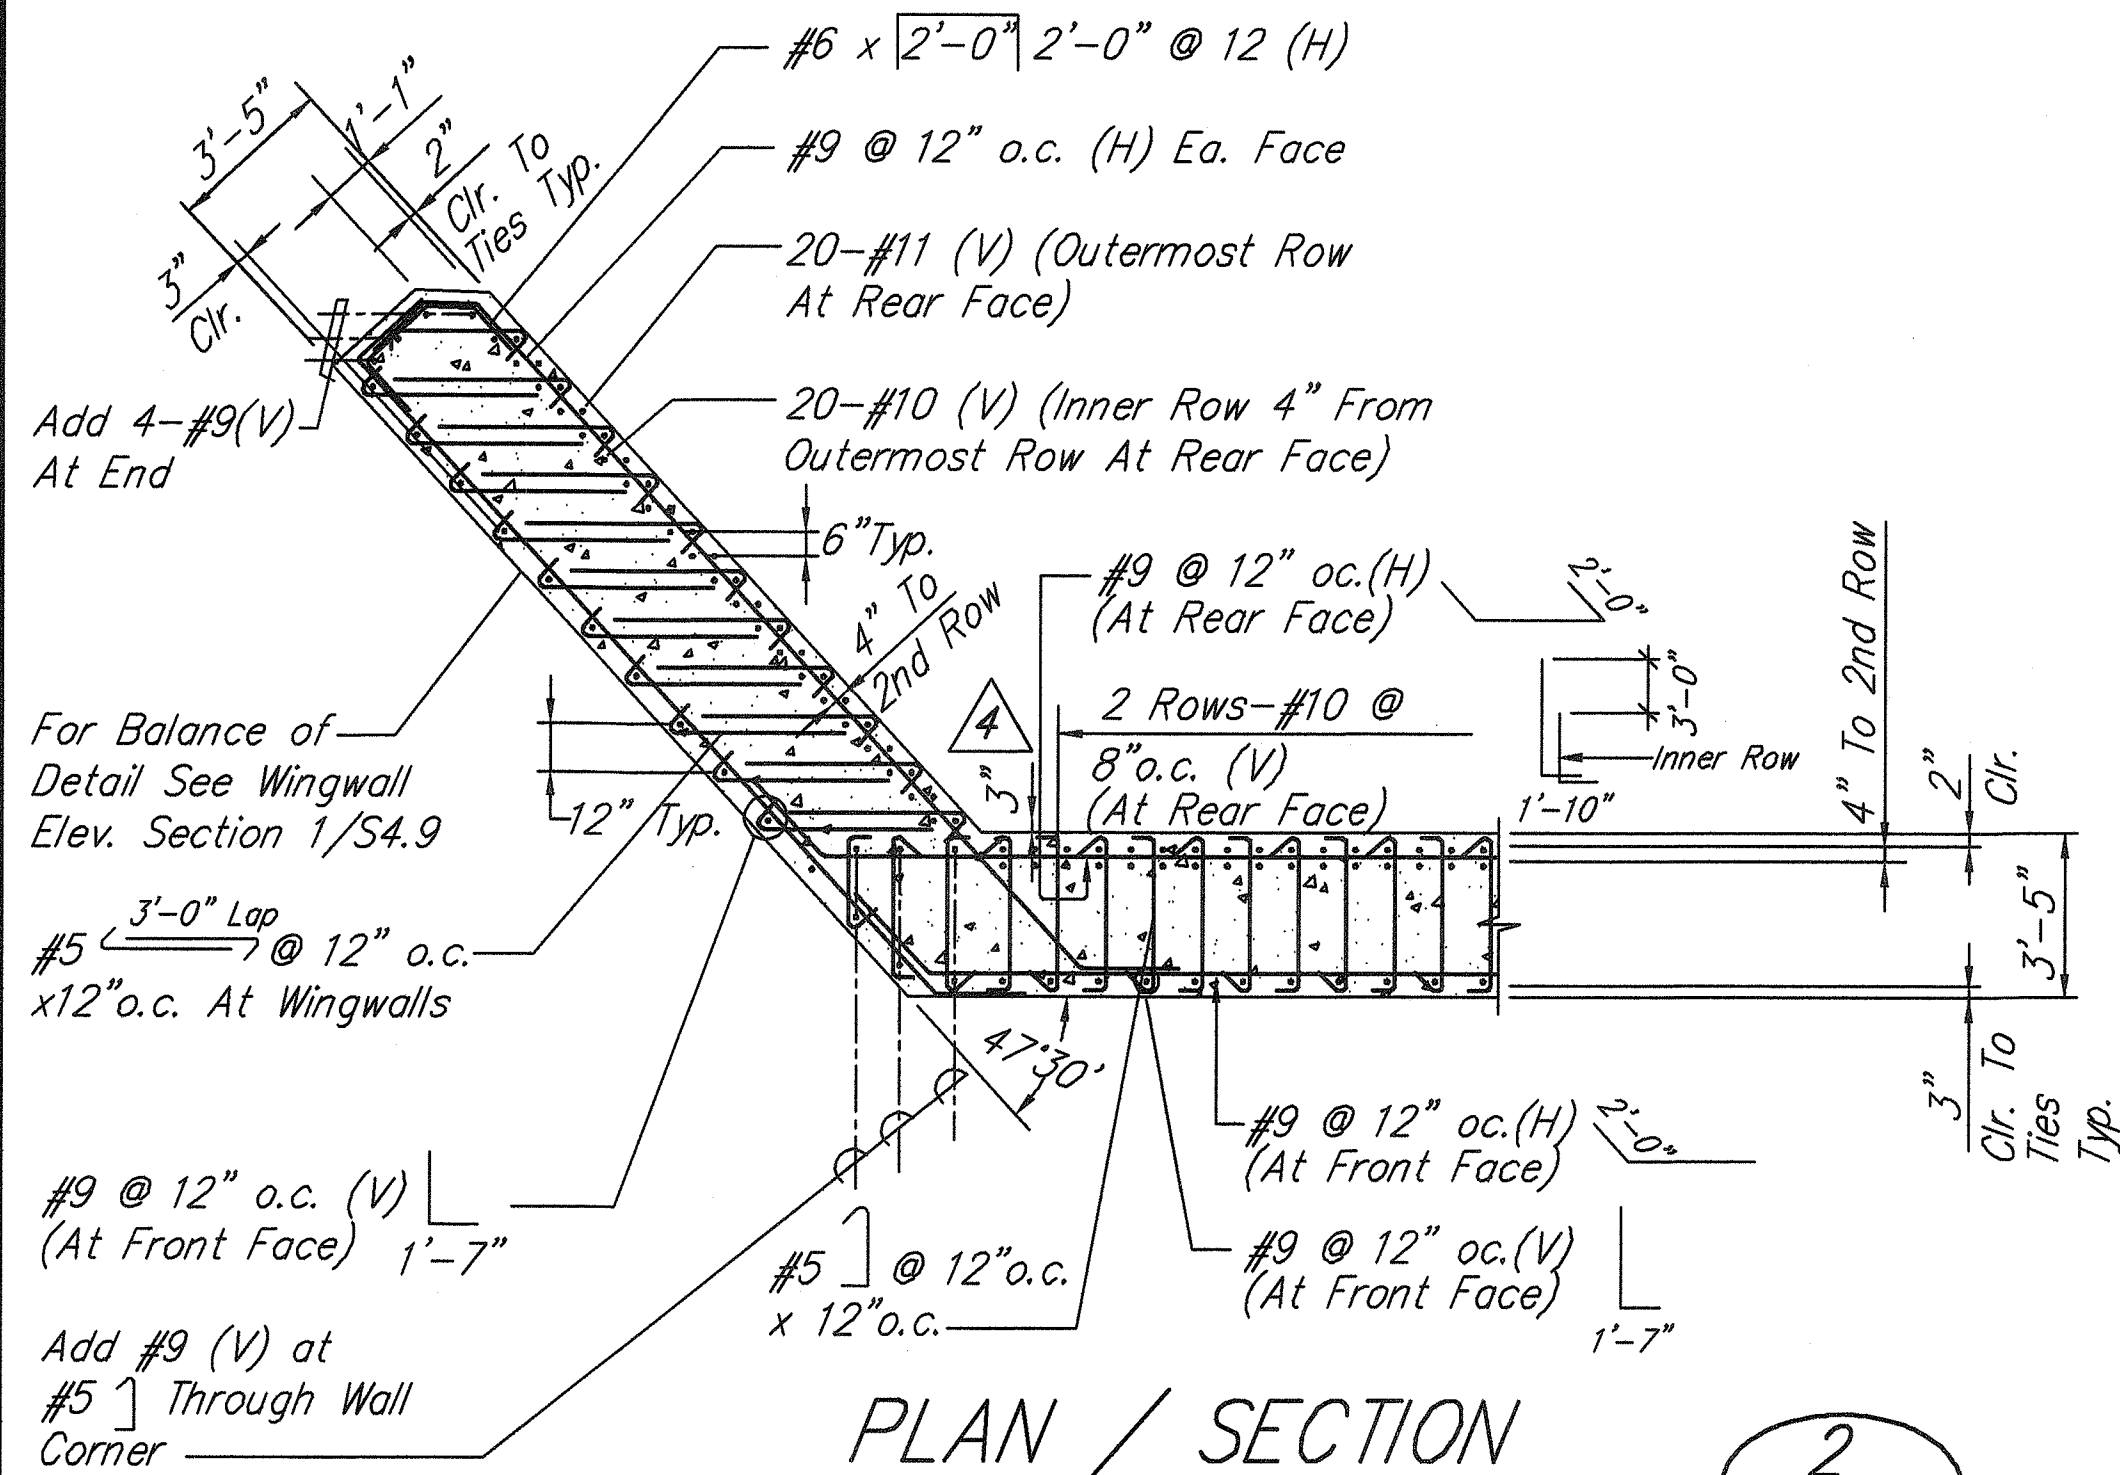

PLAN / SECTION 2
Sc: 1/4" = 1'-0"

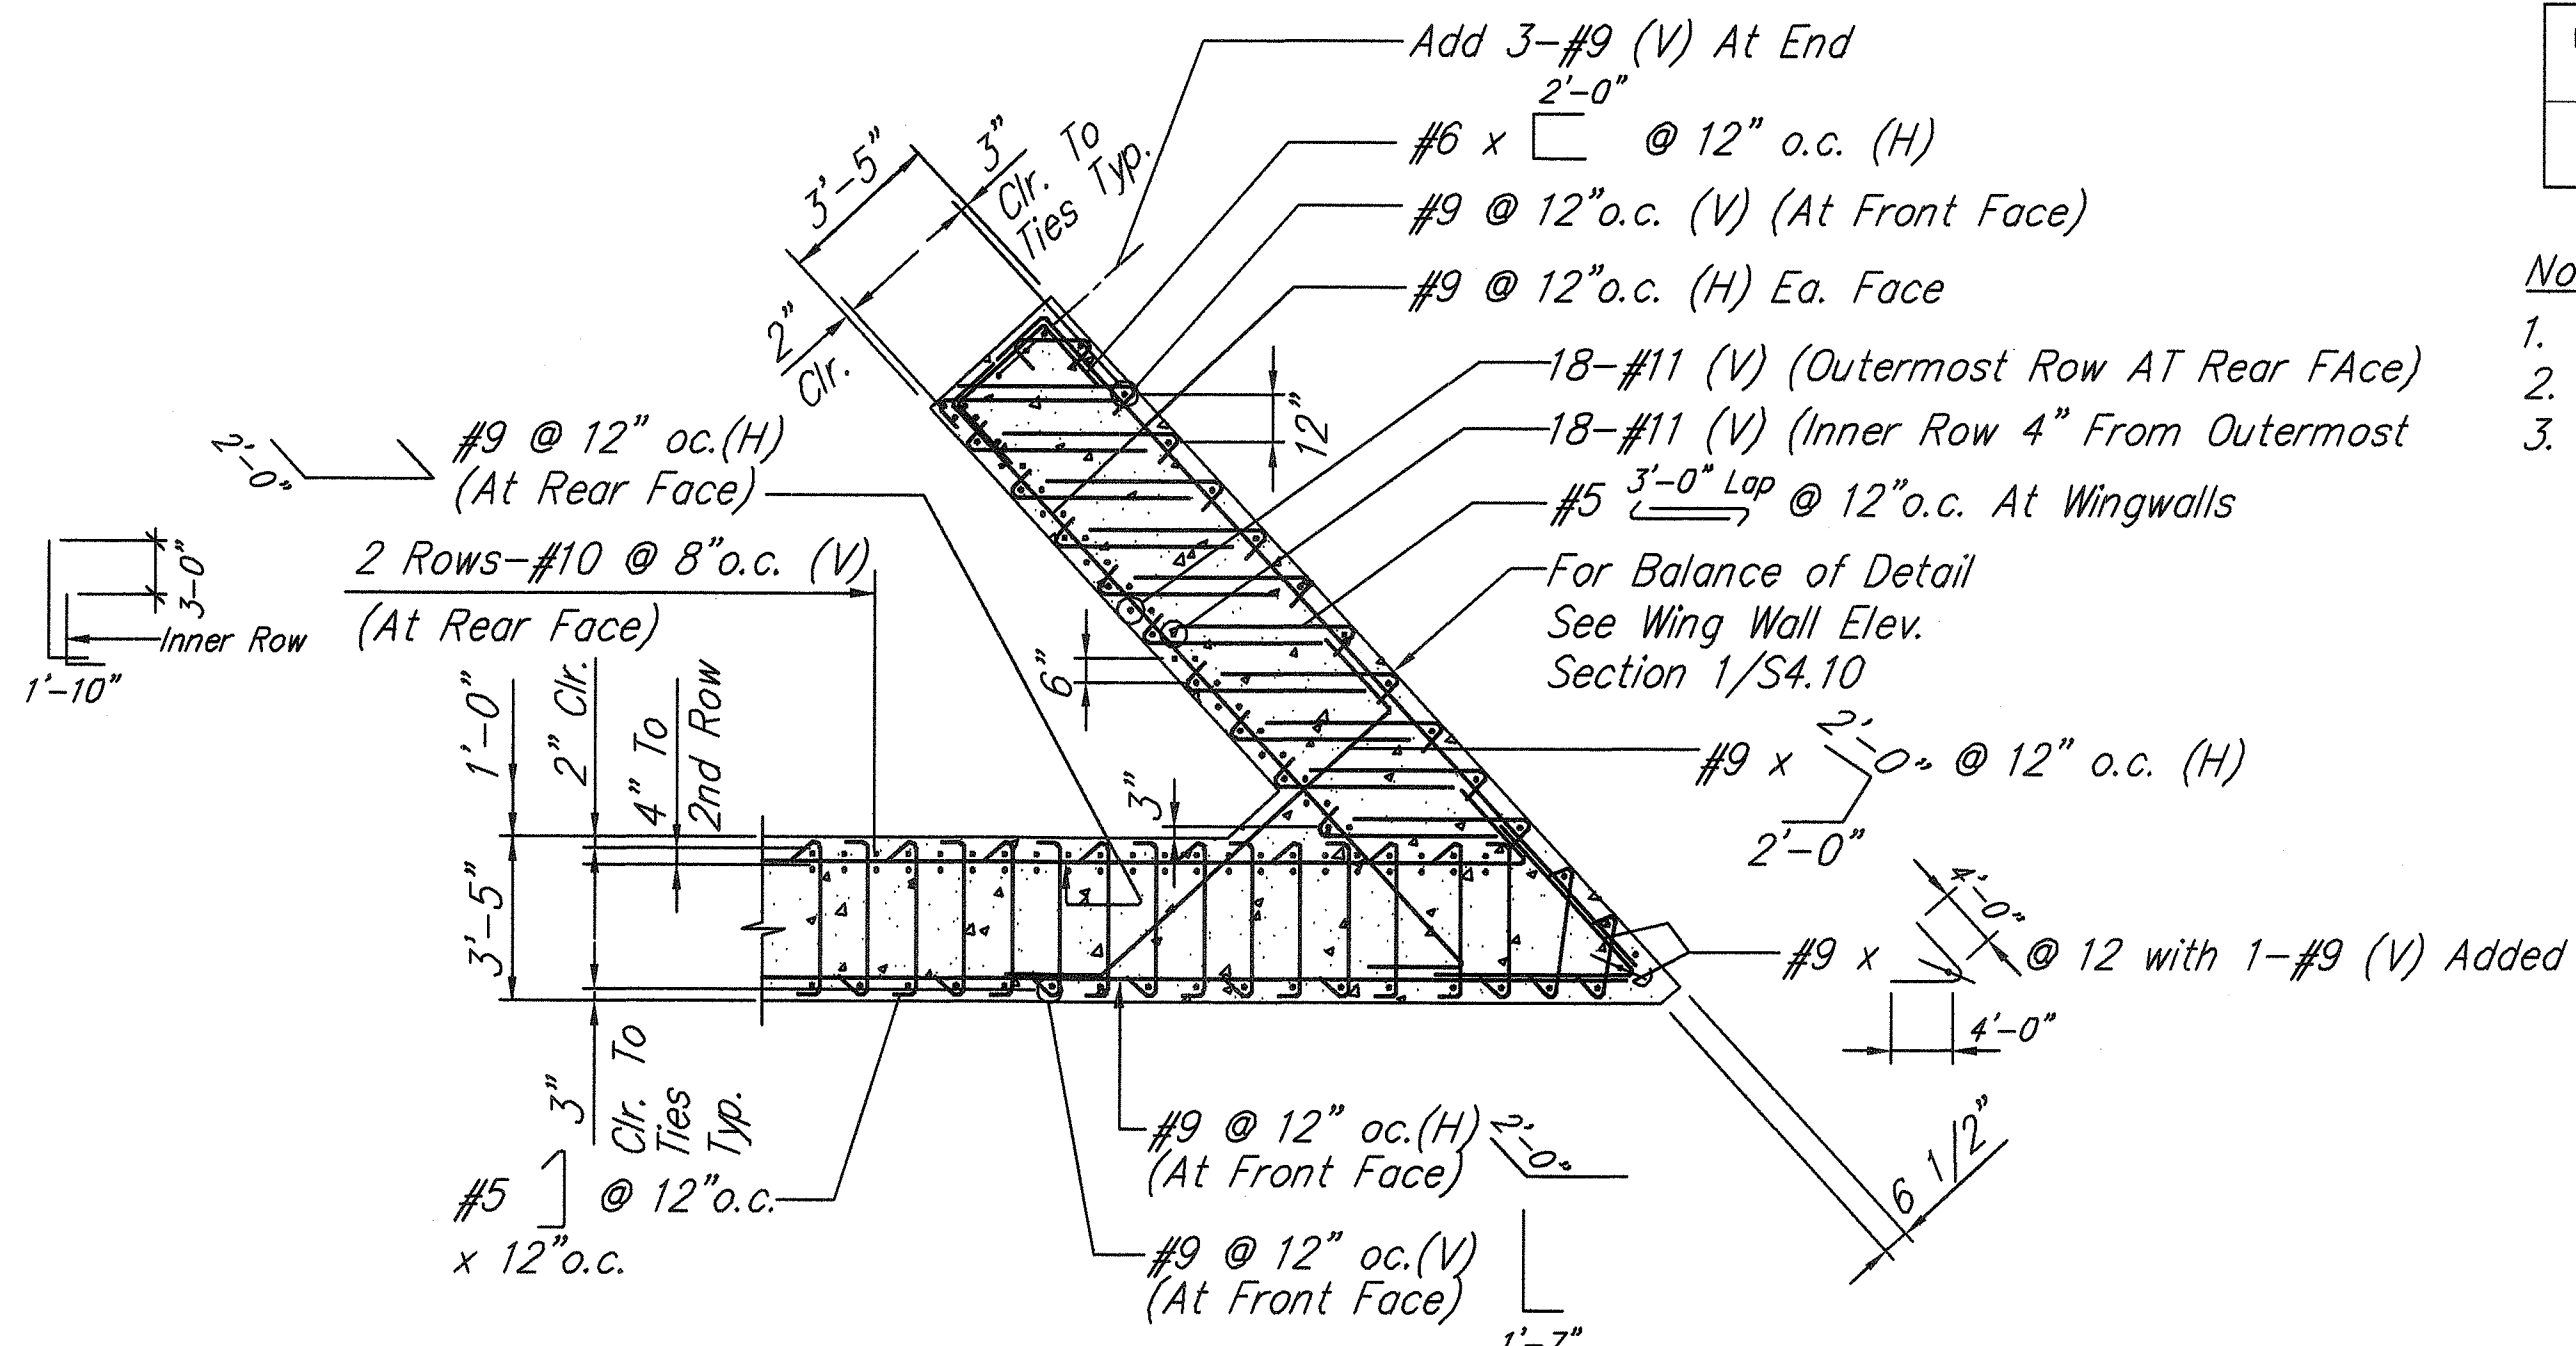

PLAN / SECTION 3
Sc: 1/4" = 1'-0"

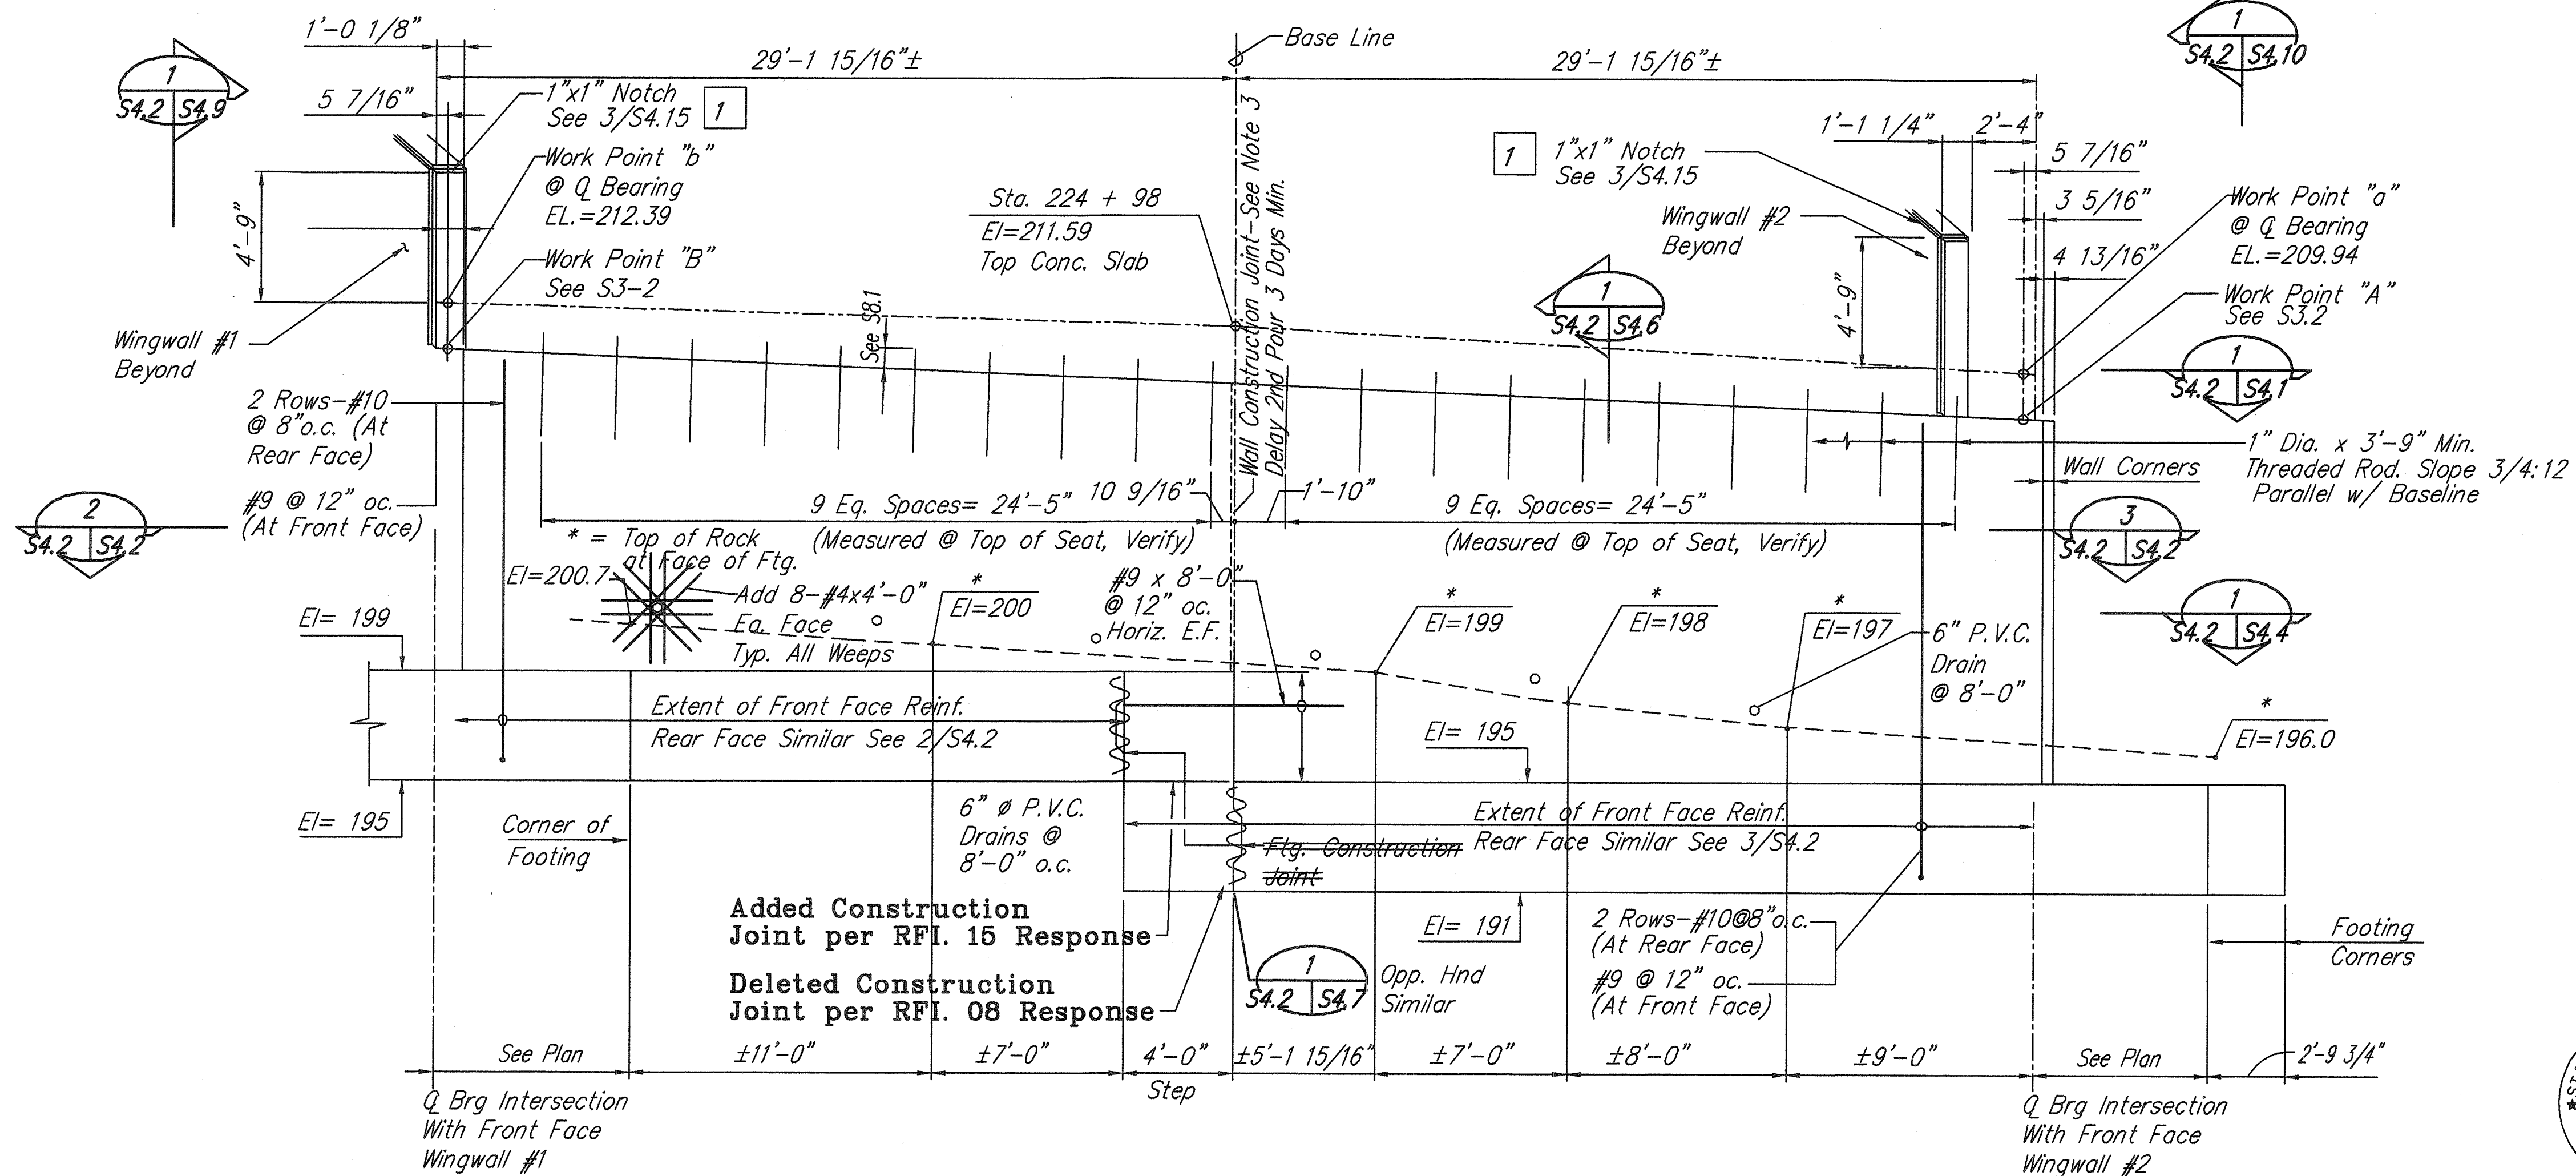

ELEVATION / ABUTMENT NO. 1 (EXPANSION END)
Sc: 1/4" = 1'-0"

LEGEND FOR AS-BUILT POSTINGS	
	Squiggly line for as-built deletion
	Double line for as-built deletion
	Text for as-built posting

01-30-01 1 Added 1"x1" Notch Reference

DATE DESCRIPTION

STATE OF HAWAII
DEPARTMENT OF TRANSPORTATION
HIGHWAYS DIVISION

ABUTMENT NO.1 ELEVATION,

PLAN SECTIONS

MAMALAHOA HIGHWAY

REPLACEMENT OF


KEAIIA STREAM BRIDGE

Federal Aid Project No. ER-12(1)R

Scale: As Noted


Date: January 2001

SHEET No. S4.2 OF 50 SHEETS

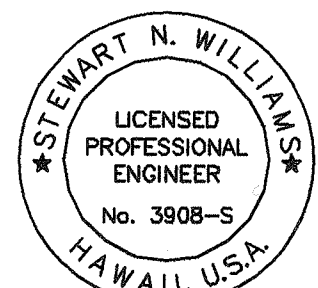


THIS WORK WAS PREPARED BY ME OR UNDER MY SUPERVISION.



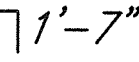
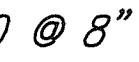
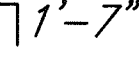
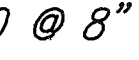
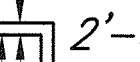
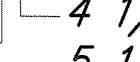
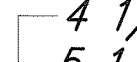
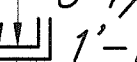
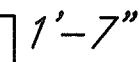
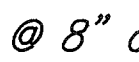
Stewart N. Williams
Mitsunaga & Associates, Inc.

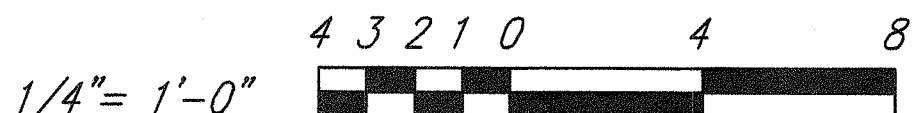


AS-BUILT

FED. ROAD DIST. NO.	STATE	FED. AID PROJ. NO.	FISCAL YEAR	SHEET NO.	TOTAL SHEETS
HAWAII	HAW.	ER-12 (1) R	2001	25	77

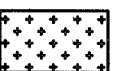- NOTES:
- For Wing Wall Elevations, See Shts. S4.9 thru S4.12.
 - For Bridge Rail, End Post and Metal Guard Rail Connection Details, See Sheet S4.16 and S8.1.
 - See S1.1 For Probe Hole Locations
 - See S4.8 For Excavation And Backfill Limits.
 - See S4.2 For Wall Reinf. Sizes & Layouts
 -  Indicates CLSM Backfill
 - T.O.F. = Top of Footing
B.O.F. = Bottom of Footing

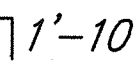ABUTMENT NO.1 FOOTING REINFORCING		
MARK	TOP REINF.	BOTTOM REINF.
A	#10 @ 8" o.c.  1'-10"	#10 @ 8" o.c.  1'-10"
B	#9 @ 12" o.c.  1'-7"	#10 @ 8" o.c.  1'-10"
C	#9 @ 12" o.c.  1'-7"	#10 @ 8" o.c.  1'-10"
D	Not Used	Not Used
E	Not Used	Not Used
F	#11 @ 6"  2'-0" #10 @ 6" o.c.  5 1/2 min. 5 1/2 max.	#10 @ 12" o.c.  4 1/2 min. 5 1/2 max. #10 @ 6"  1'-10"
G	#9 @ 12" o.c.  1'-7"	#9 @ 8" o.c.  1'-7"

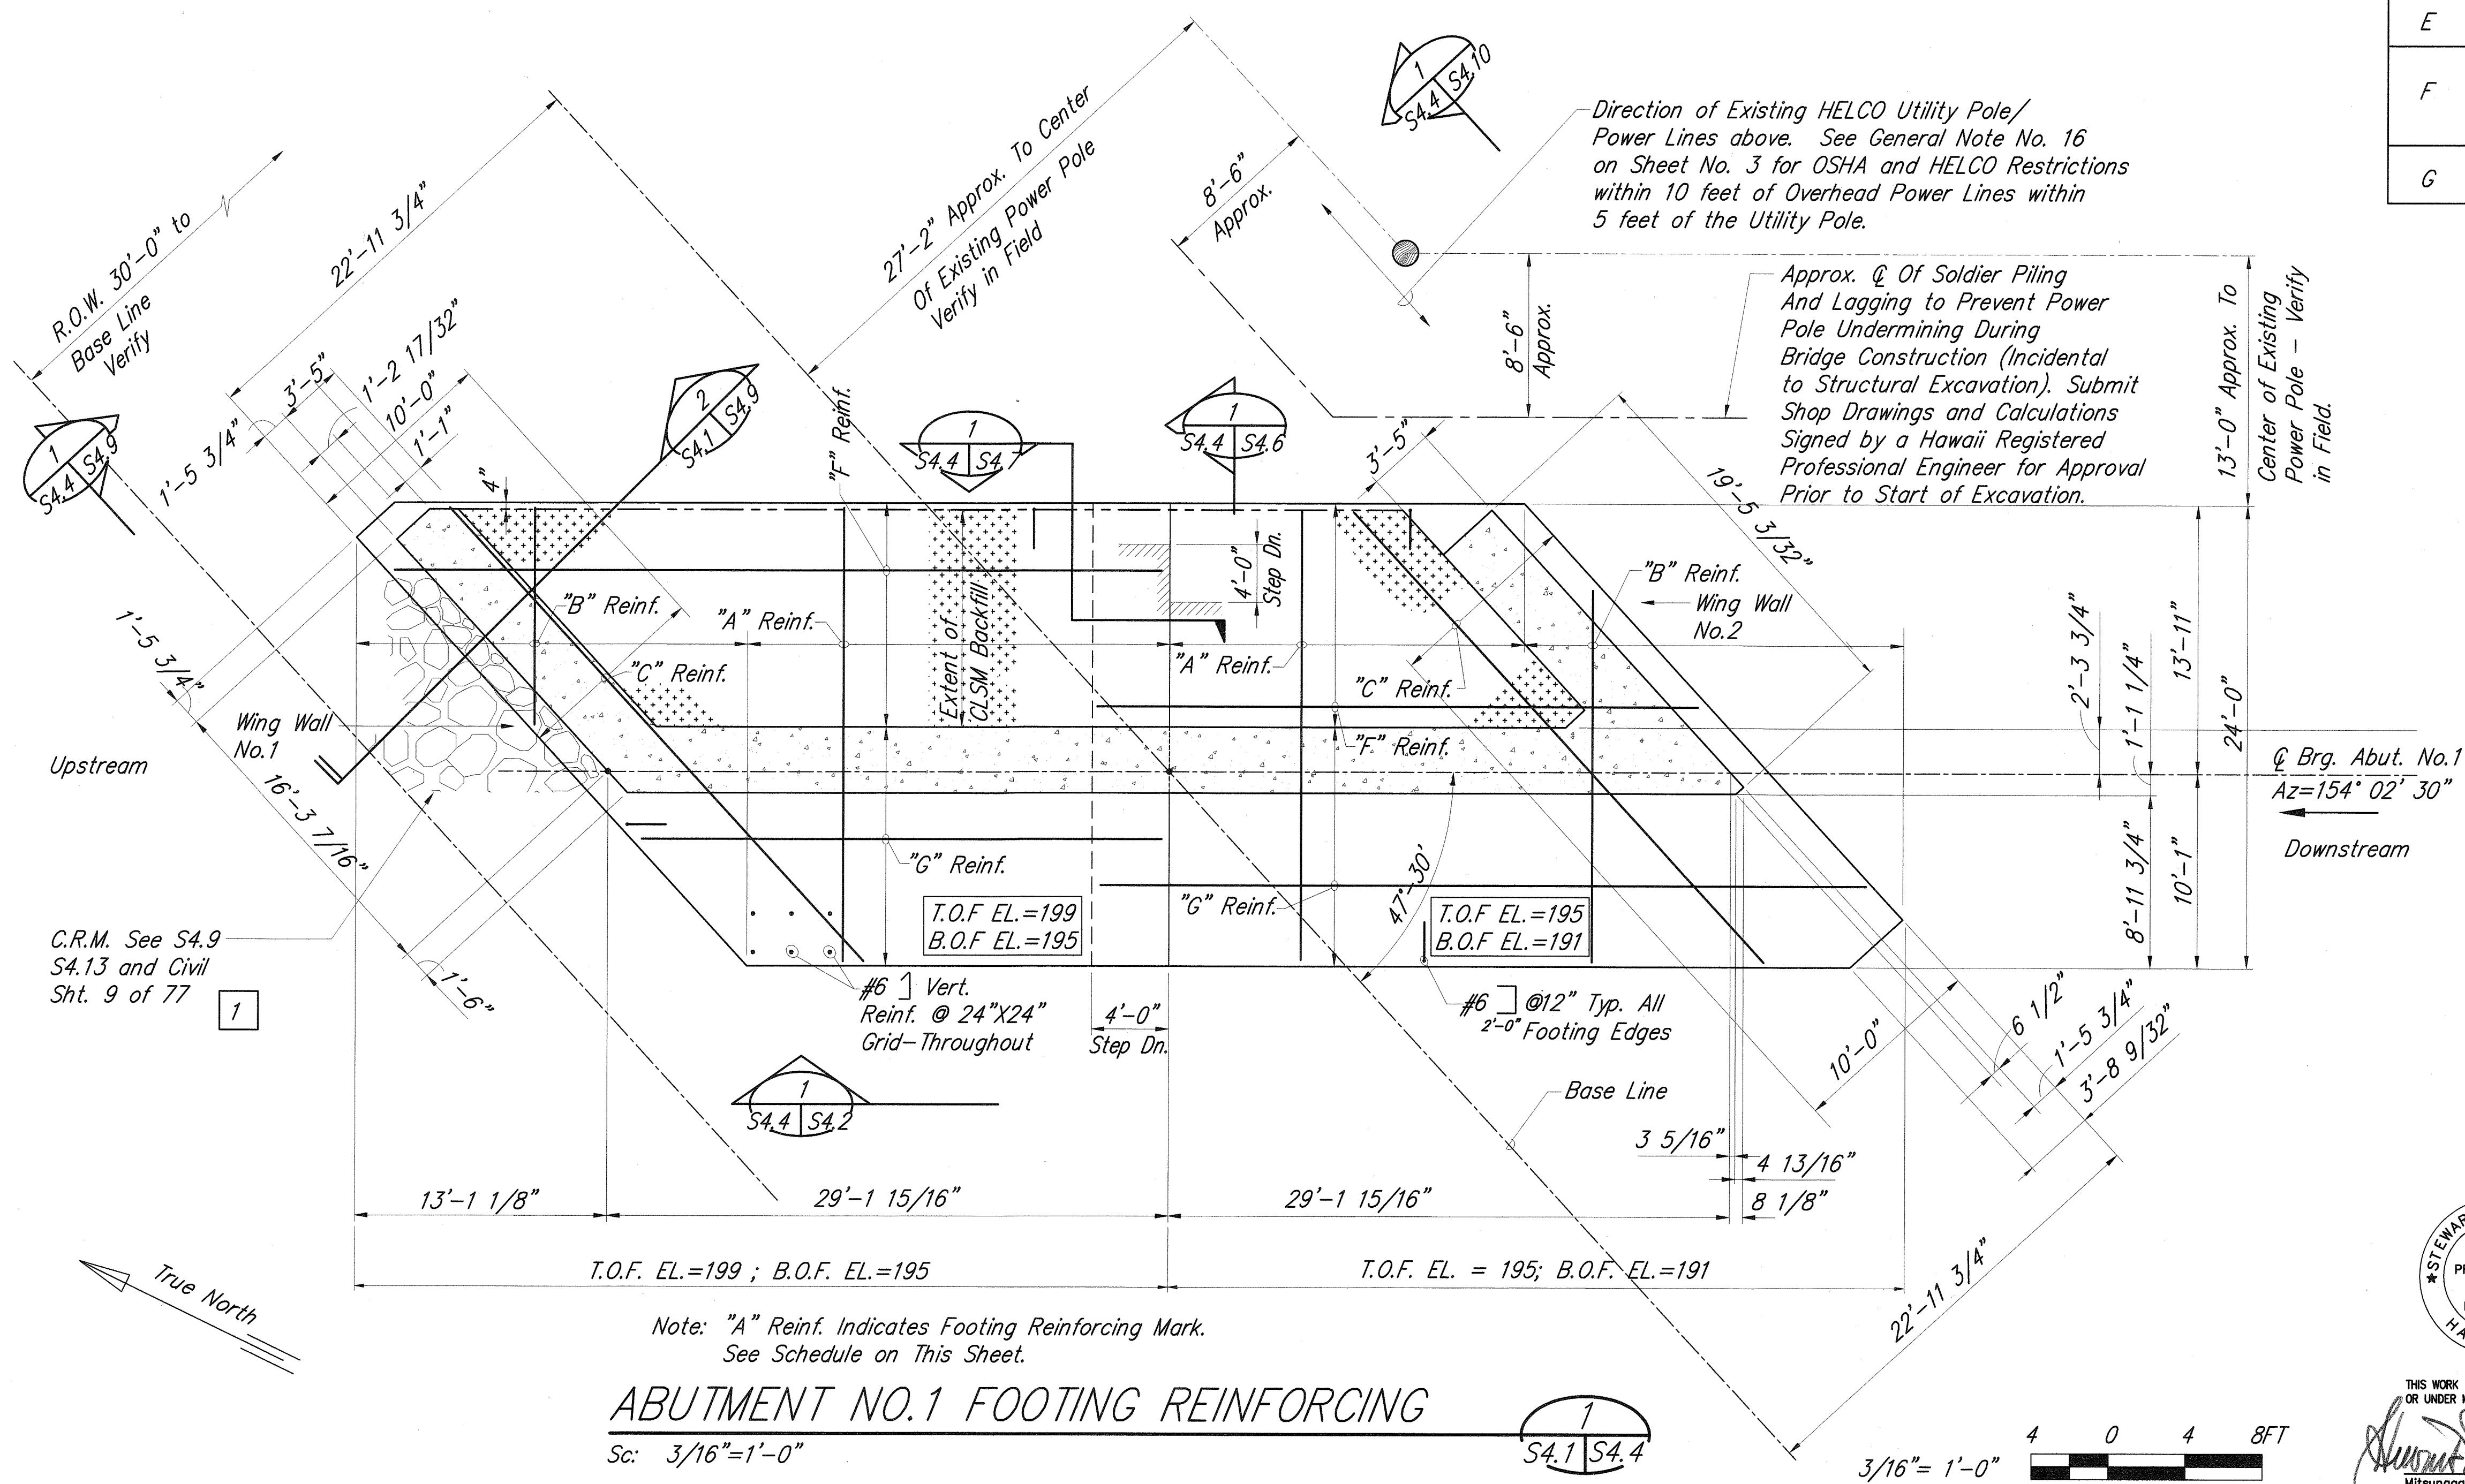

DATE
SURVEY PLOTTED BY
PLAN
DRAWN BY
TRACED BY
DESIGNED BY
QUANTITIES BY
CHECKED BY
NO.


01-30-01

1

Revised Sheet Reference

DATE	DESCRIPTION
STATE OF HAWAII DEPARTMENT OF TRANSPORTATION HIGHWAYS DIVISION ABUTMENT FOOTING REINFORCING DETAILS MAMALAHOA HIGHWAY REPLACEMENT OF KEAIIWA STREAM BRIDGE Federal Aid Project No. ER-12(1)R	
Scale: As Noted	January 2001

SHEET No. S4.4 OF 50 SHEETS

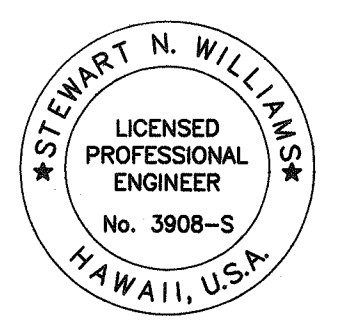


THIS WORK WAS PREPARED BY ME
OR UNDER MY SUPERVISION.
Stewart N. Williams
Mitsunaga & Associates, Inc.

FED. ROAD DIST. NO.	STATE	FED. AID PROJ. NO.	FISCAL YEAR	SHEET NO.	TOTAL SHEETS
HAWAII	HAW.	ER-12 (1) R	2001	26	77

ABUTMENT NO.2 FOOTING REINFORCING		
MARK	TOP REINF.	BOTTOM REINF.
A thru G	Not Used	Not Used
H	#10 @ 8" o.c.	#10 @ 16" o.c.
I	#10 @ 8" o.c.	#10 @ 16" o.c.
J	#10 @ 12" o.c.	#11 @ 8" o.c.
K	#10 @ 8" o.c. #10 @ 8" o.c. At T.O.F. EL.=181. Length is from Front Face Abutment Wall to Heel	Not Used
L	#11 @ 6" o.c. T.O.F. EL.=177	#11 @ 12" o.c. #11 @ 6" o.c.
M	#11 @ 6" o.c. #11 @ 6" o.c. #11 @ 6" o.c.	#11 @ 12" o.c. #11 @ 6" o.c.
N	#10 @ 12" o.c.	#10 @ 8" o.c.

- NOTES:
- For Wing Wall Elevations, See Shts. S4.9 thru S4.12.
 - For Bridge Rail, End Post and Metal Guard Rail Connection Details, See Sheet S4.16 and S10.1.
 - See S1.1 For Probe Hole Locations
 - See S4.8 For Excavation And Backfill Limits.
 - See Sheet S4.3 for Wall Reinf., Sizes, & Layouts.
 - Indicates CLSM Backfill
 - T.O.F.= Top of Footing; B.O.F.= Bottom of Footing.

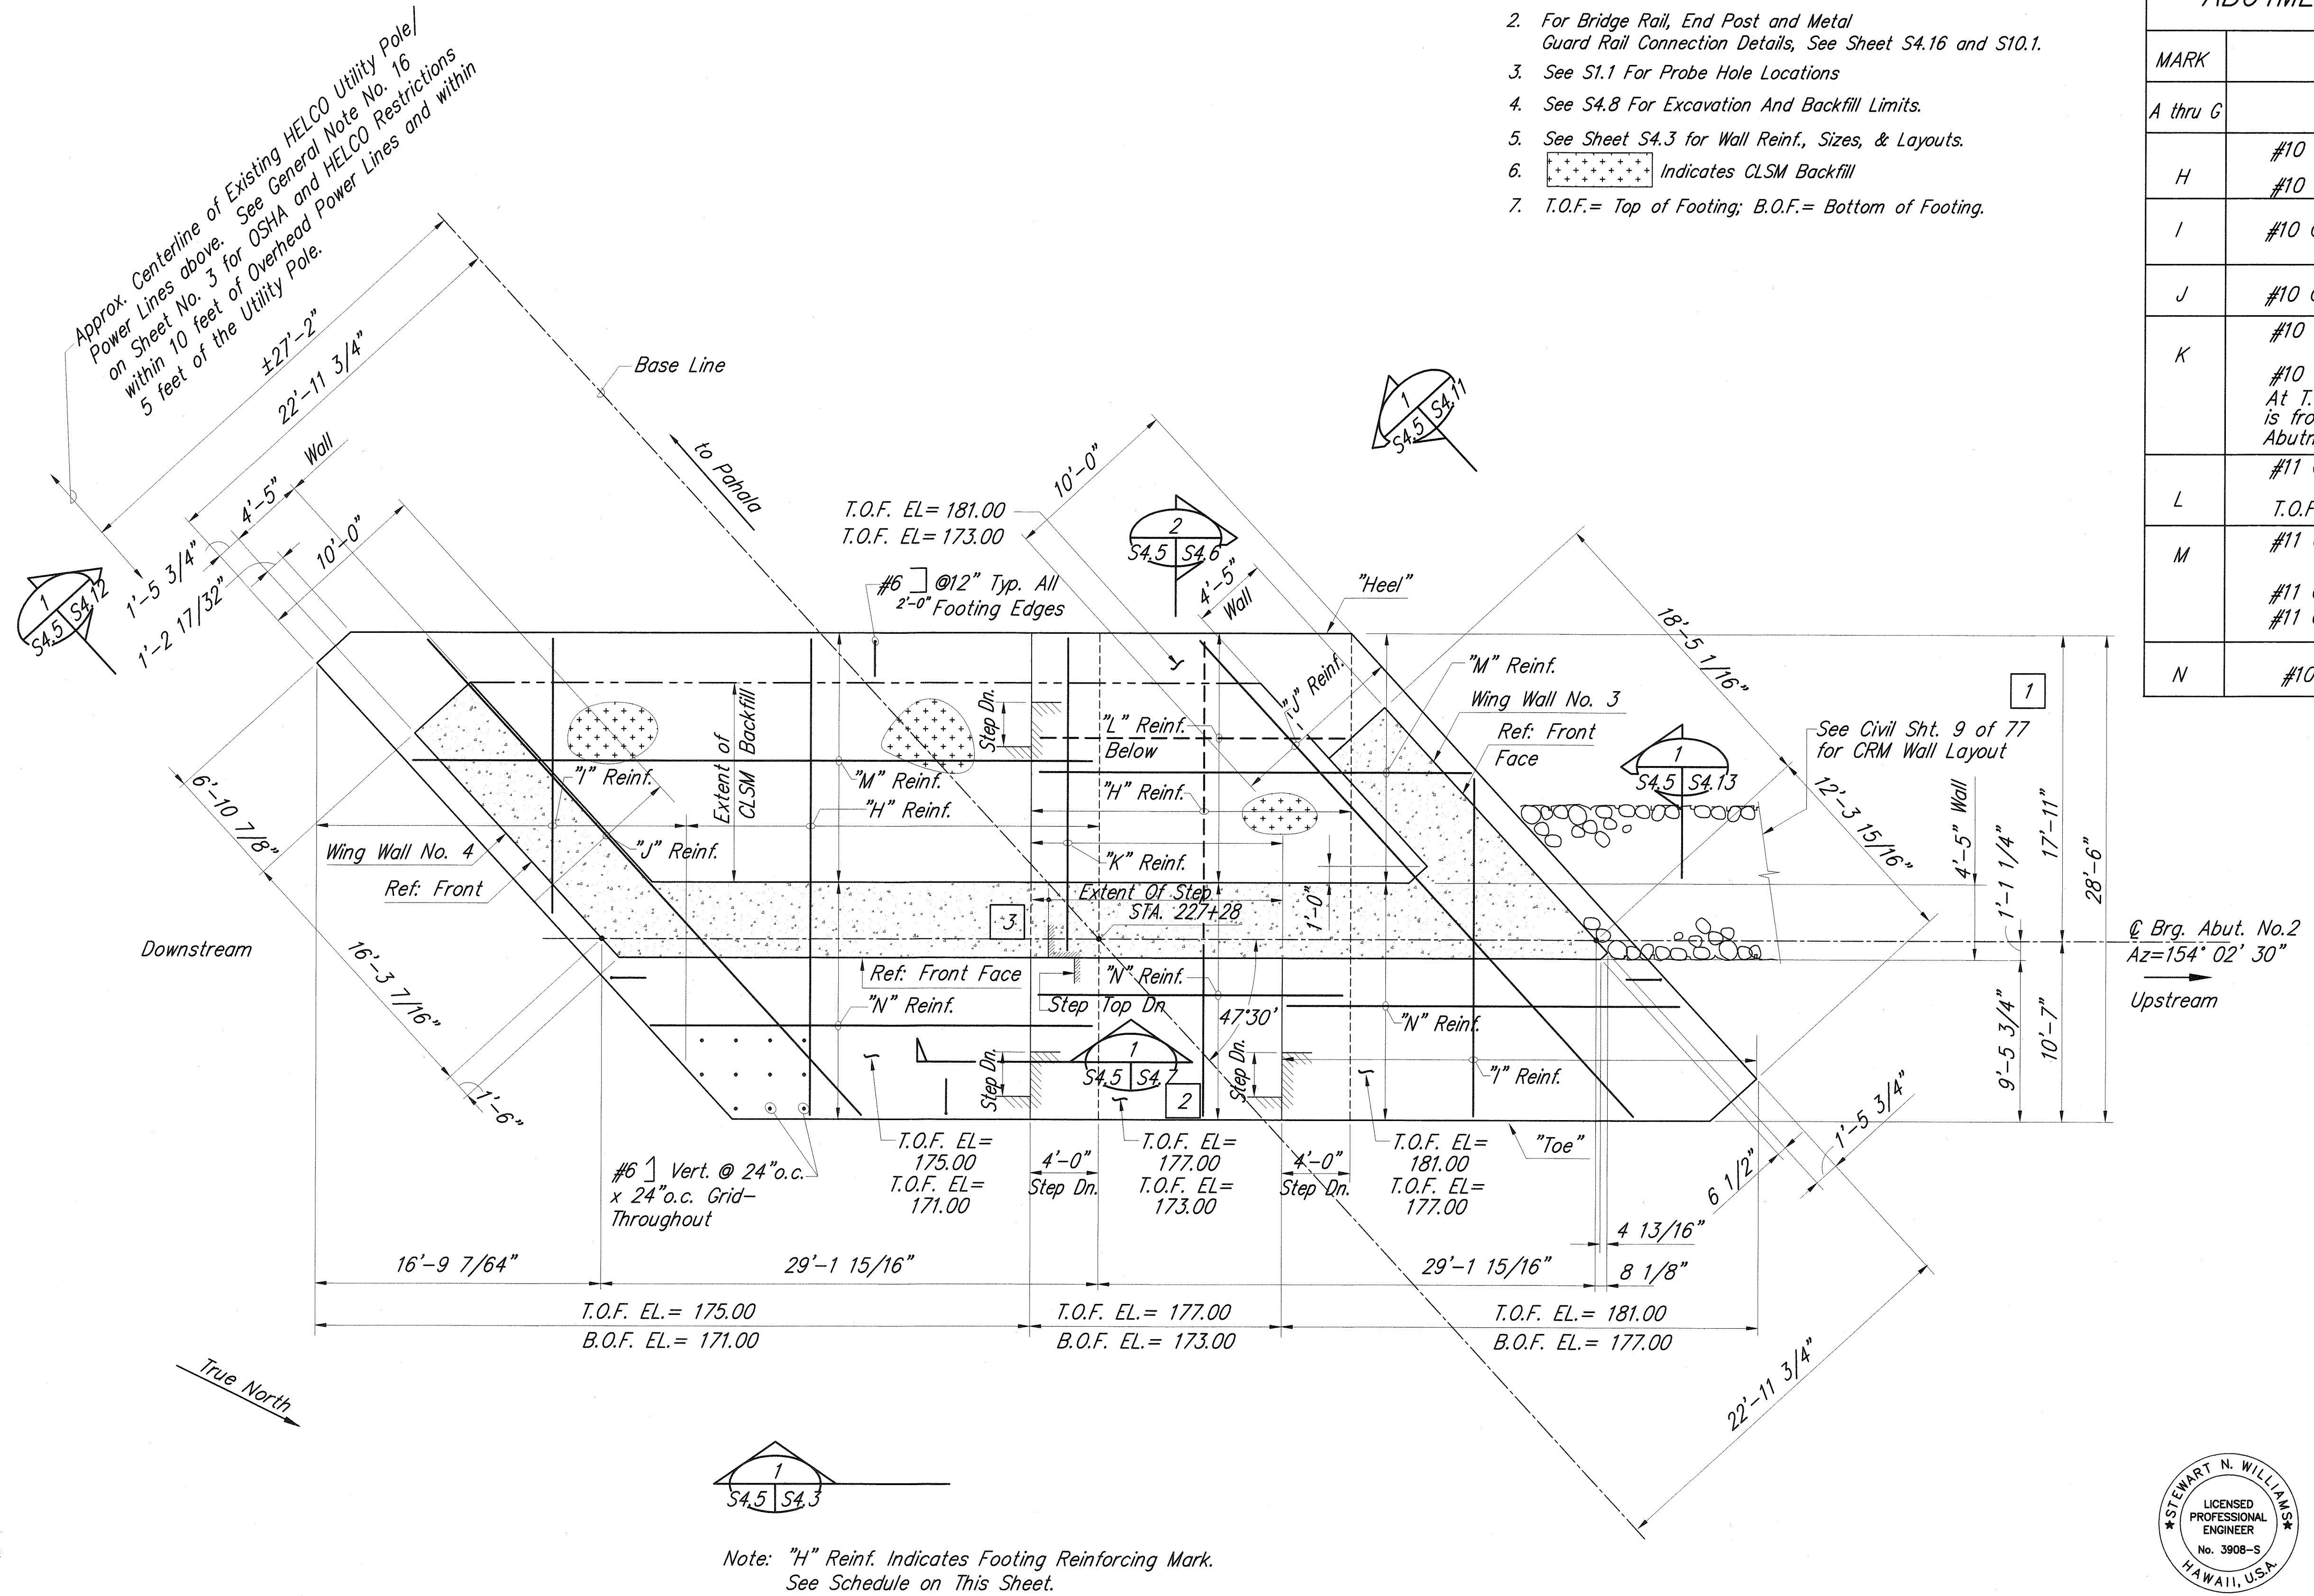

01-30-01	3	Clarified Top Of Footing Step
01-30-01	2	Added Section Mark 1/S4.7
01-30-01	1	Revised Sheet Reference
DATE	DESCRIPTION	

STATE OF HAWAII
DEPARTMENT OF TRANSPORTATION
HIGHWAYS DIVISION

**ABUTMENT FOOTING
REINFORCING DETAILS**

**MAMALAHOA HIGHWAY
REPLACEMENT OF
KEAIIWA STREAM BRIDGE**

Federal Aid Project No. ER-12(1)R

Scale: As Noted January 2001

SHEET No. S4.5 OF 50 SHEETS

DATE	_____
SURVEY PLOTTED BY	_____
DRAWN BY	_____
TRACED BY	_____
DESIGNED BY	_____
QUANTITIES BY	_____
CHECKED BY	_____
ORIGINAL PLAN	_____
NOTE BOOK	_____
No.	_____

ABUTMENT NO.2 FOOTING REINFORCING

Sc: 3/16"=1'-0"

3/16"= 1'-0"

4 0 4 8FT


THIS WORK WAS PREPARED BY ME OR UNDER MY SUPERVISION.

Stewart N. Williams


Stewart N. Williams
LICENSED PROFESSIONAL ENGINEER
No. 3908-S
HAWAII, U.S.A.

Mitsunaga & Associates, Inc.

FED. ROAD DIST. NO.	STATE	FED. AID PROJ. NO.	FISCAL YEAR	SHEET NO.	TOTAL SHEETS
HAWAII	HAW.	ER-12 (1)R	2001	27	77

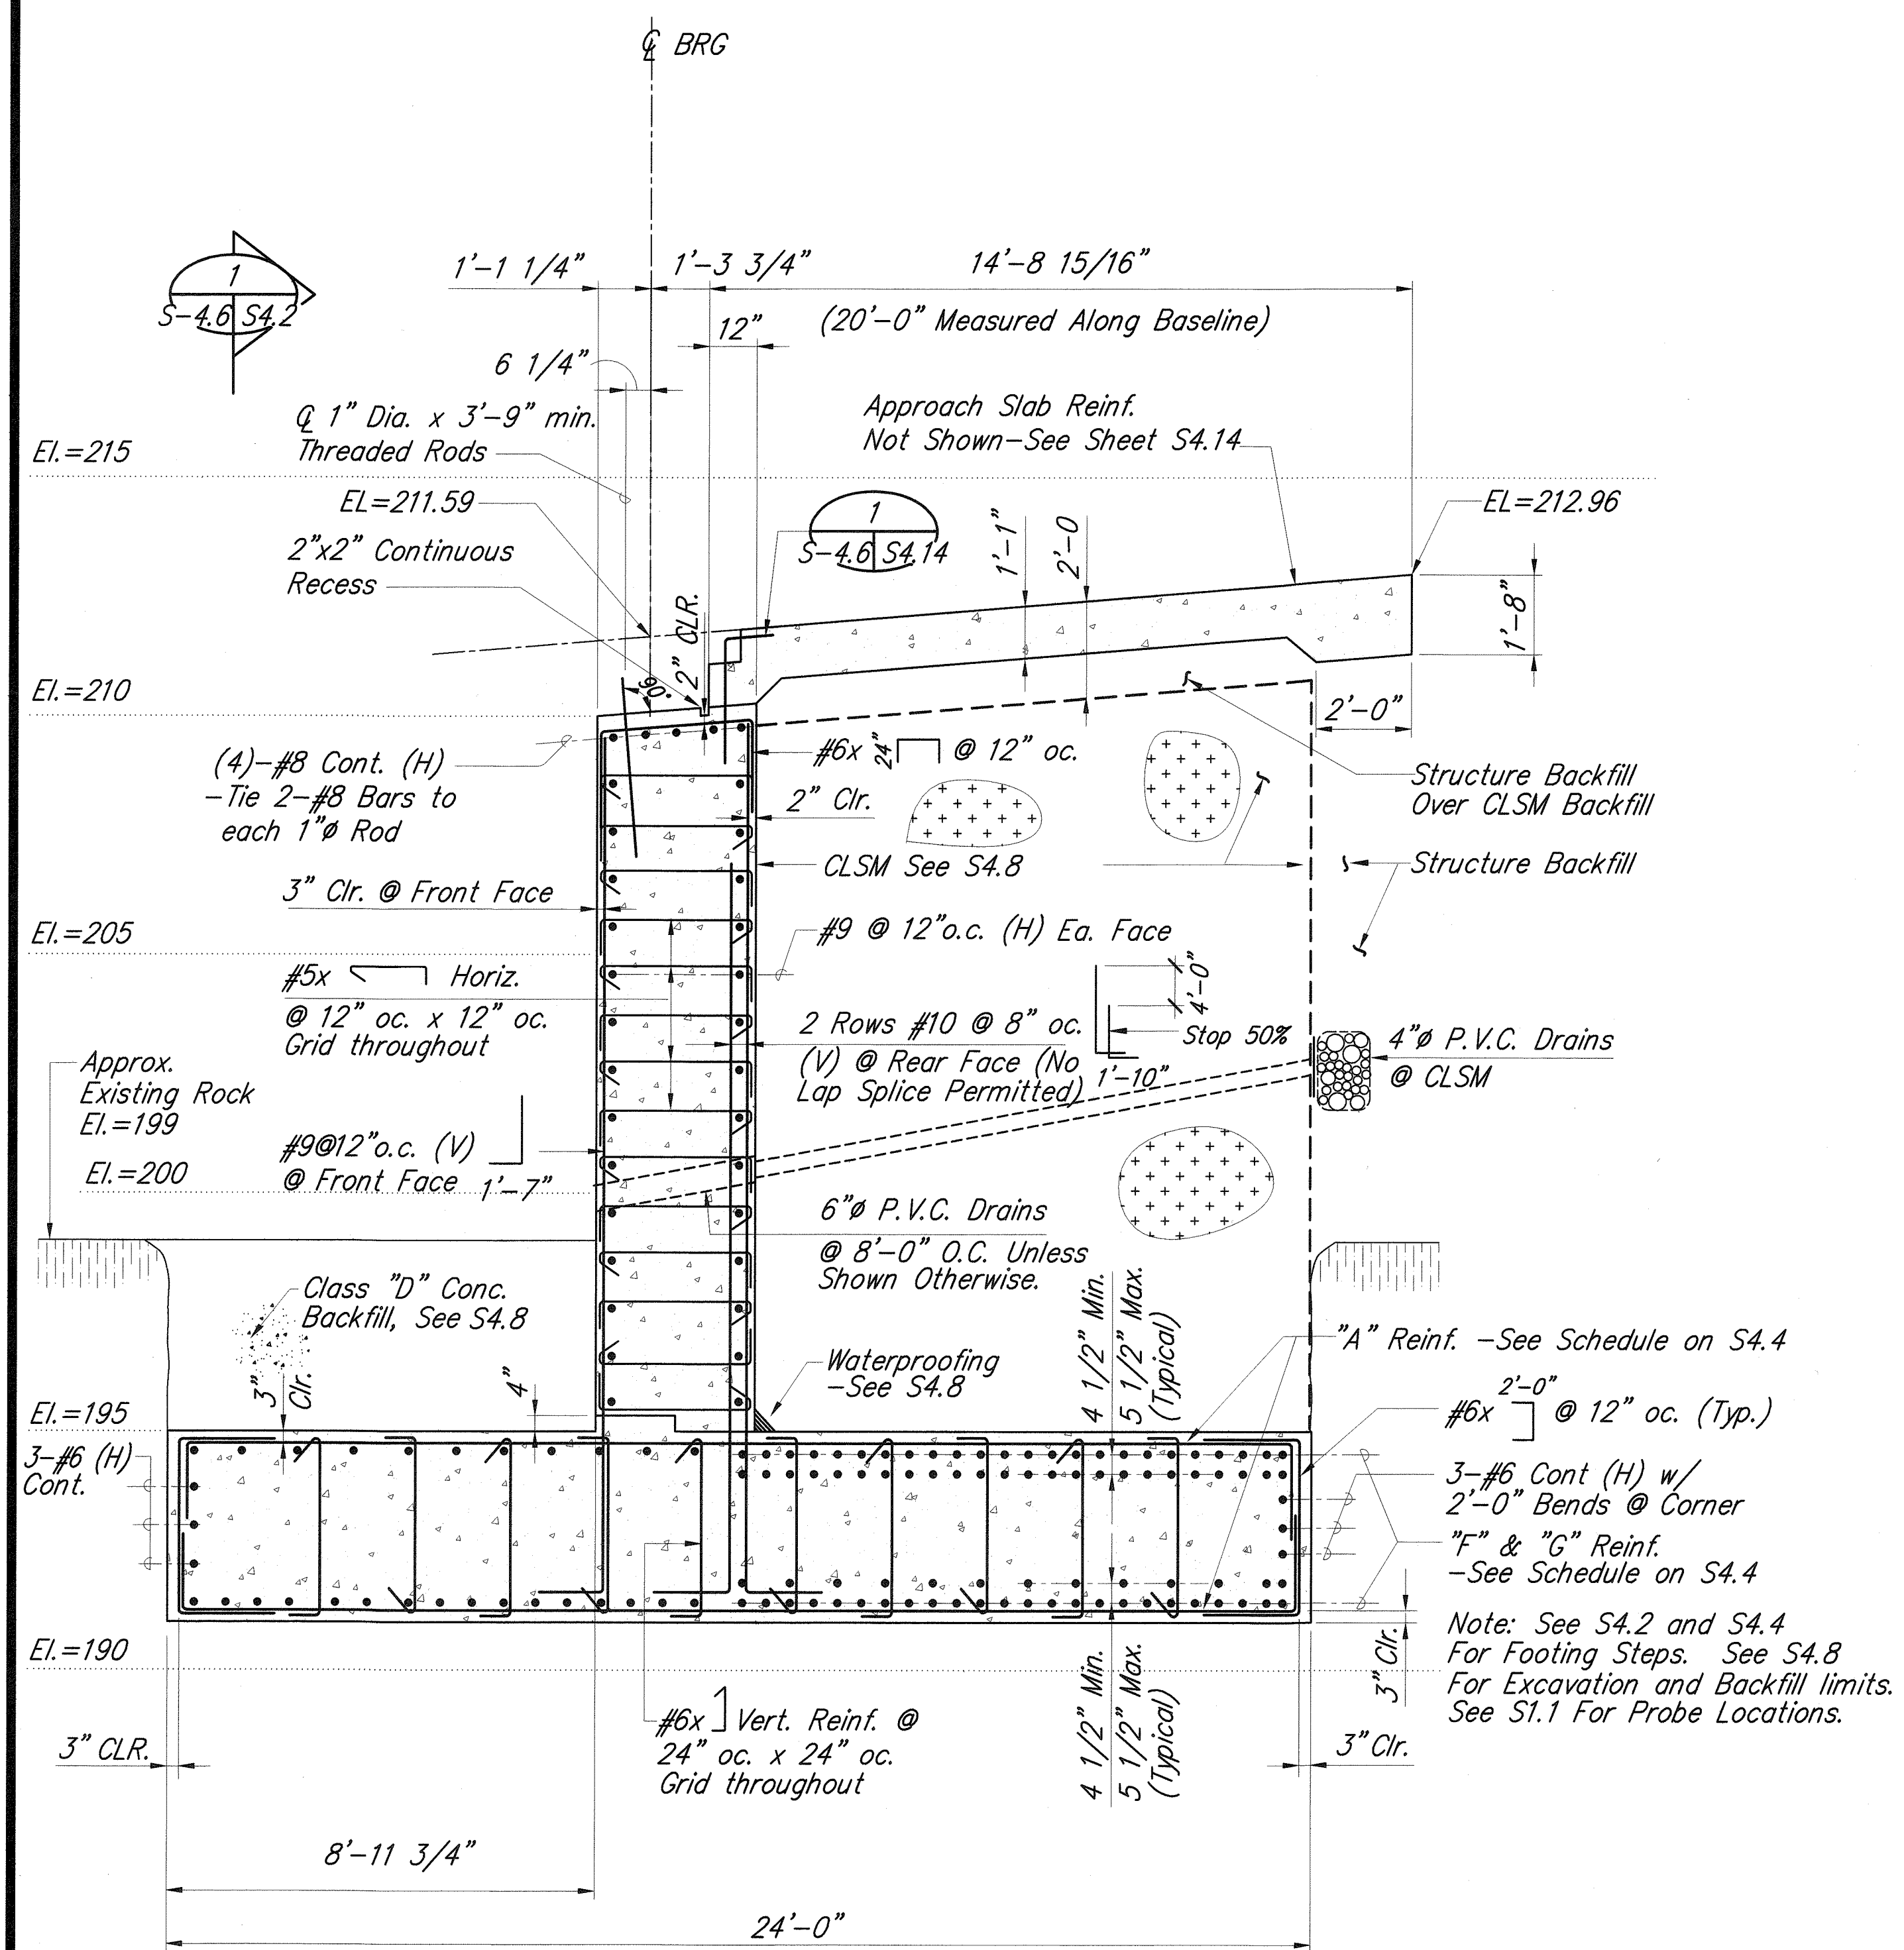


SECTION AT ABUTMENT NO. 1
PERPENDICULAR TO C BRG S4.1,S4.3,S4.4,S4.6 S4.6
SC: 3/8" = 1'-0"

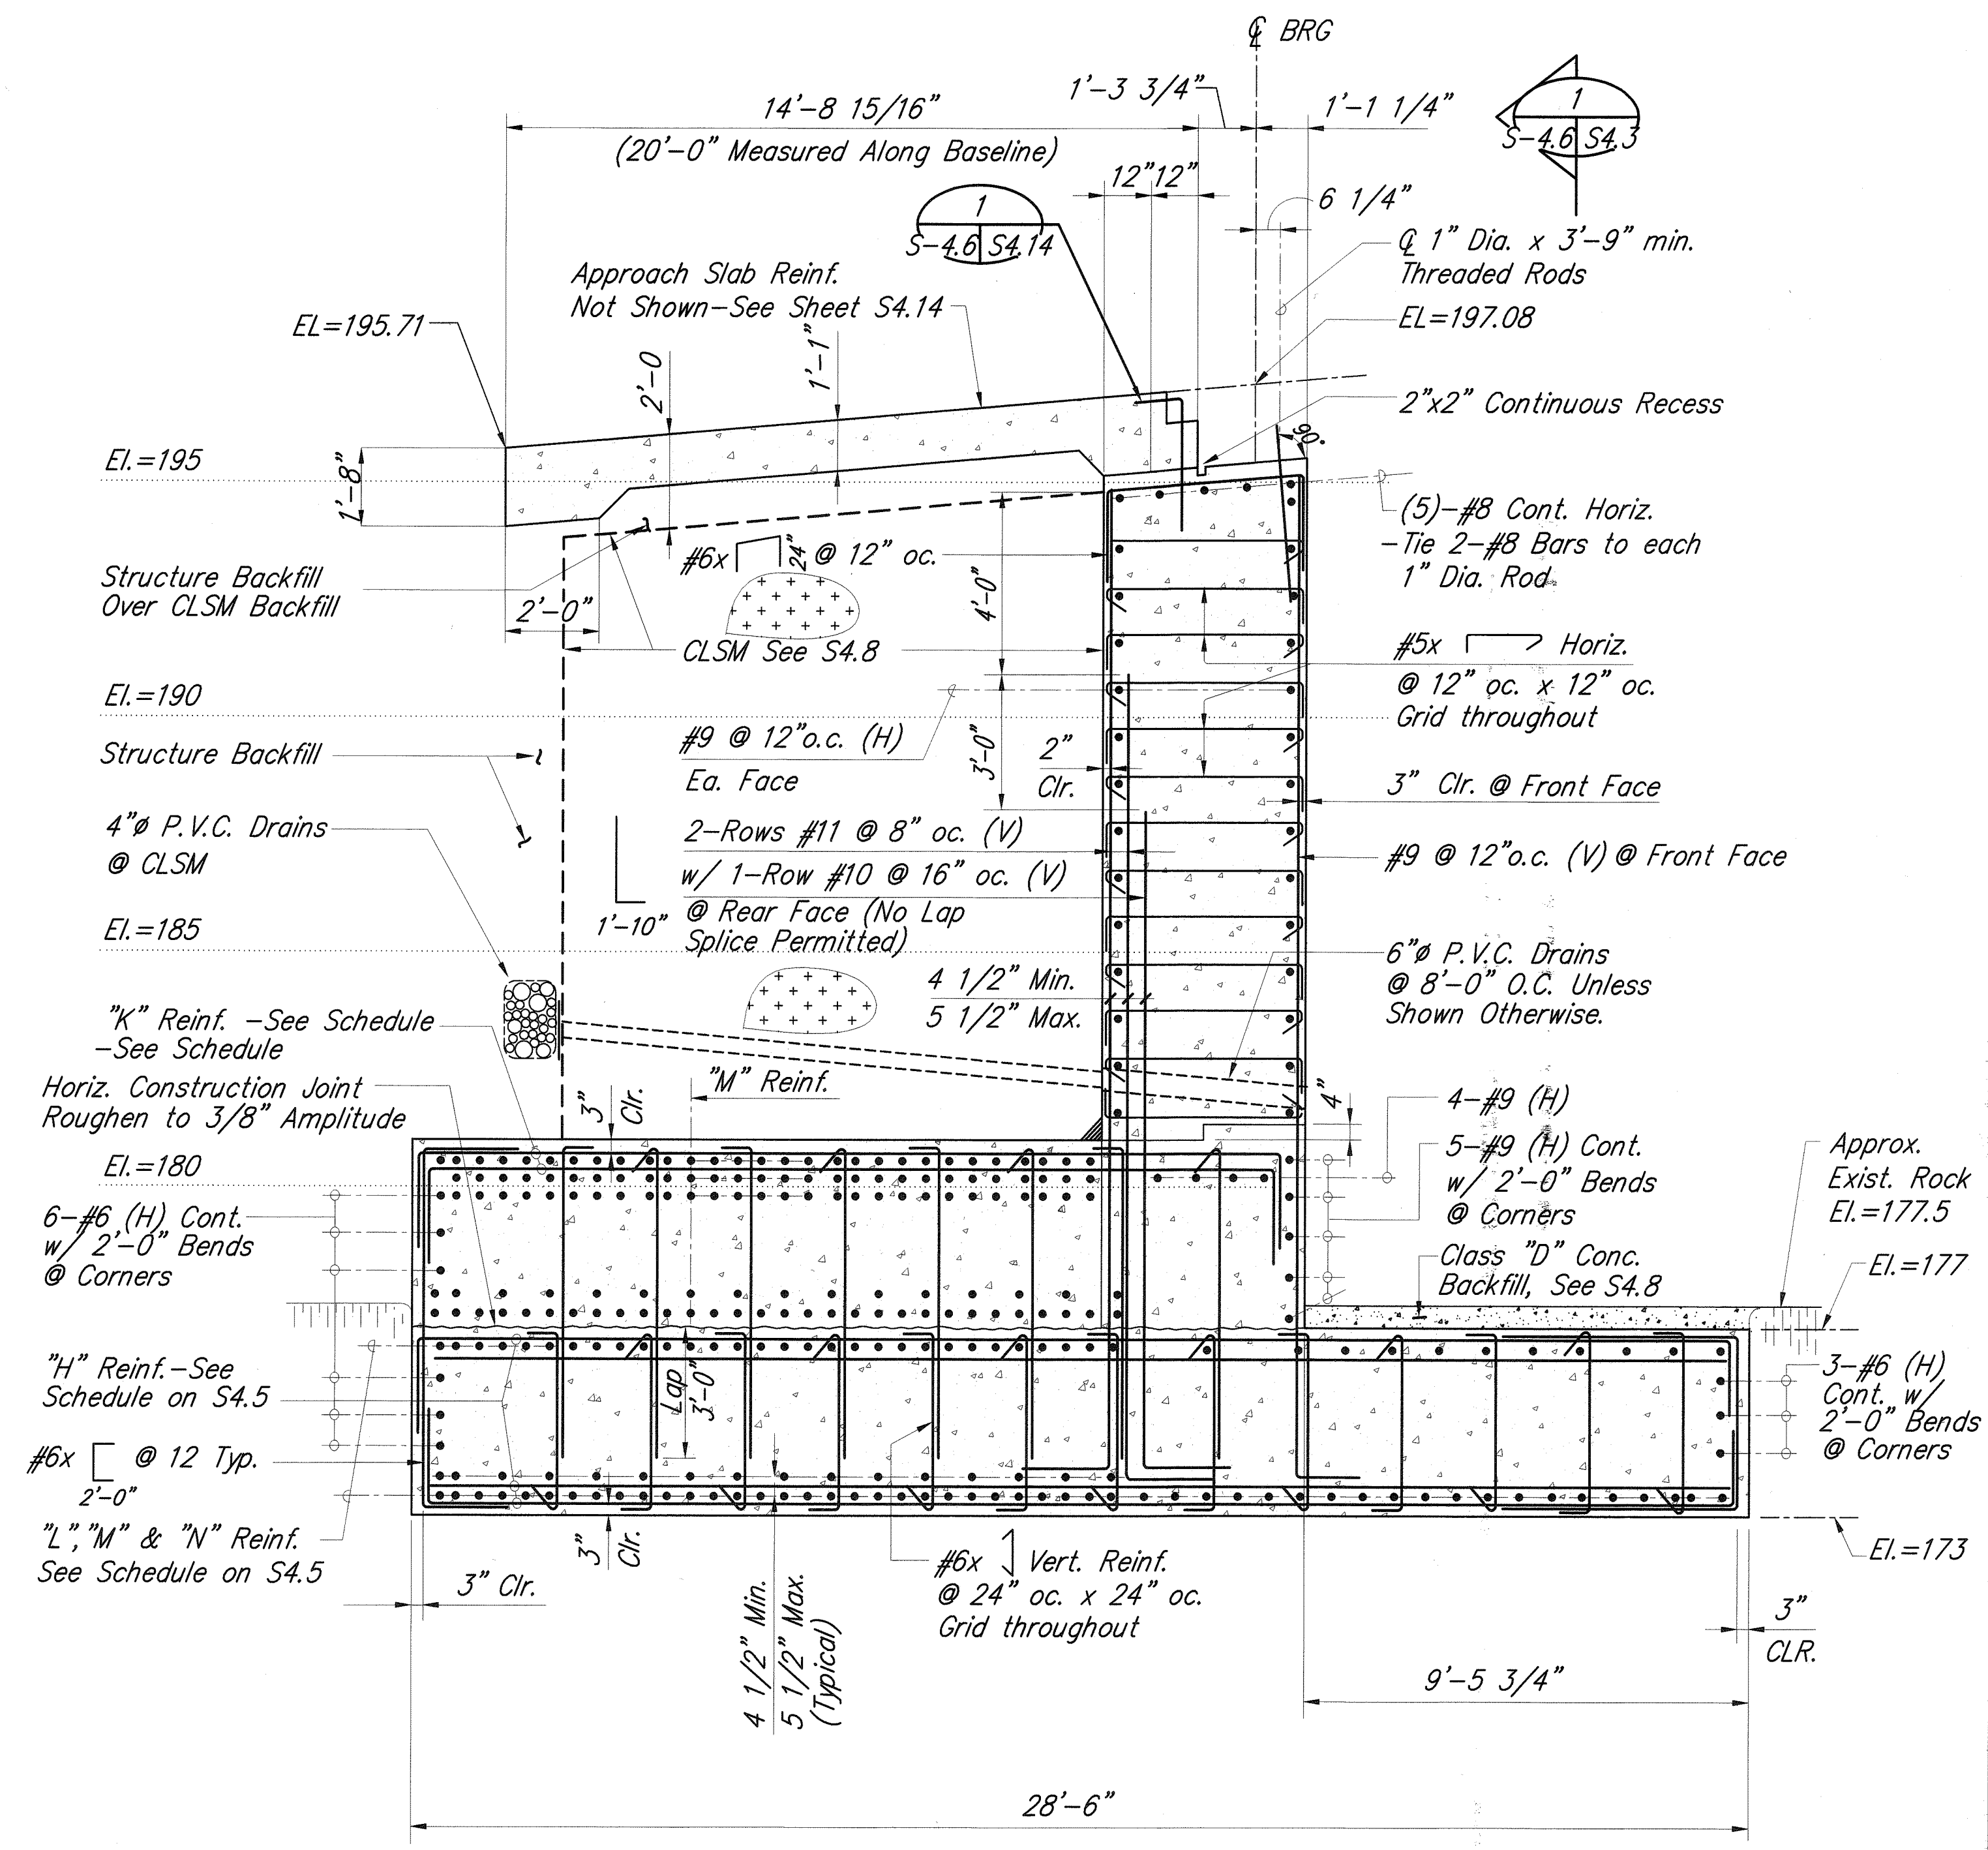

SECTION AT ABUTMENT NO. 2
PERPENDICULAR TO C BRG S4.1,S4.3,S4.5,S4.6 S4.6
SC: 3/8" = 1'-0"

DATE	_____
SURVEY PLOTTED BY	_____
DRAWN BY	_____
DESIGNED BY	_____
QUANTITIES BY	_____
CHECKED BY	_____
ORIGINAL PLAN	_____
NOTE BOOK	_____
No.	_____

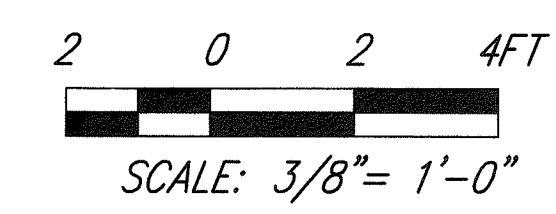

STEWART N. WILLIAMS
LICENSED PROFESSIONAL ENGINEER
No. 3908-S
HAWAII, U.S.A.

THIS WORK WAS PREPARED BY ME
OR UNDER MY SUPERVISION.

Stewart N. Williams
Mitsunaga & Associates, Inc.

STATE OF HAWAII
DEPARTMENT OF TRANSPORTATION
HIGHWAYS DIVISION

**ABUTMENT SECTIONS
and DETAILS**


**MAMALAHOA HIGHWAY
REPLACEMENT OF
KEAIIWA STREAM BRIDGE**

Federal Aid Project No. ER-12(1)R

Scale: As Noted Date: January 2001


SHEET No. S4.6 OF 50 SHEETS

FED. ROAD DIST. NO.	STATE	FED. AID PROJ. NO.	FISCAL YEAR	SHEET NO.	TOTAL SHEETS
HAWAII	HAW.	ER-12 (1)R	2001	29	77

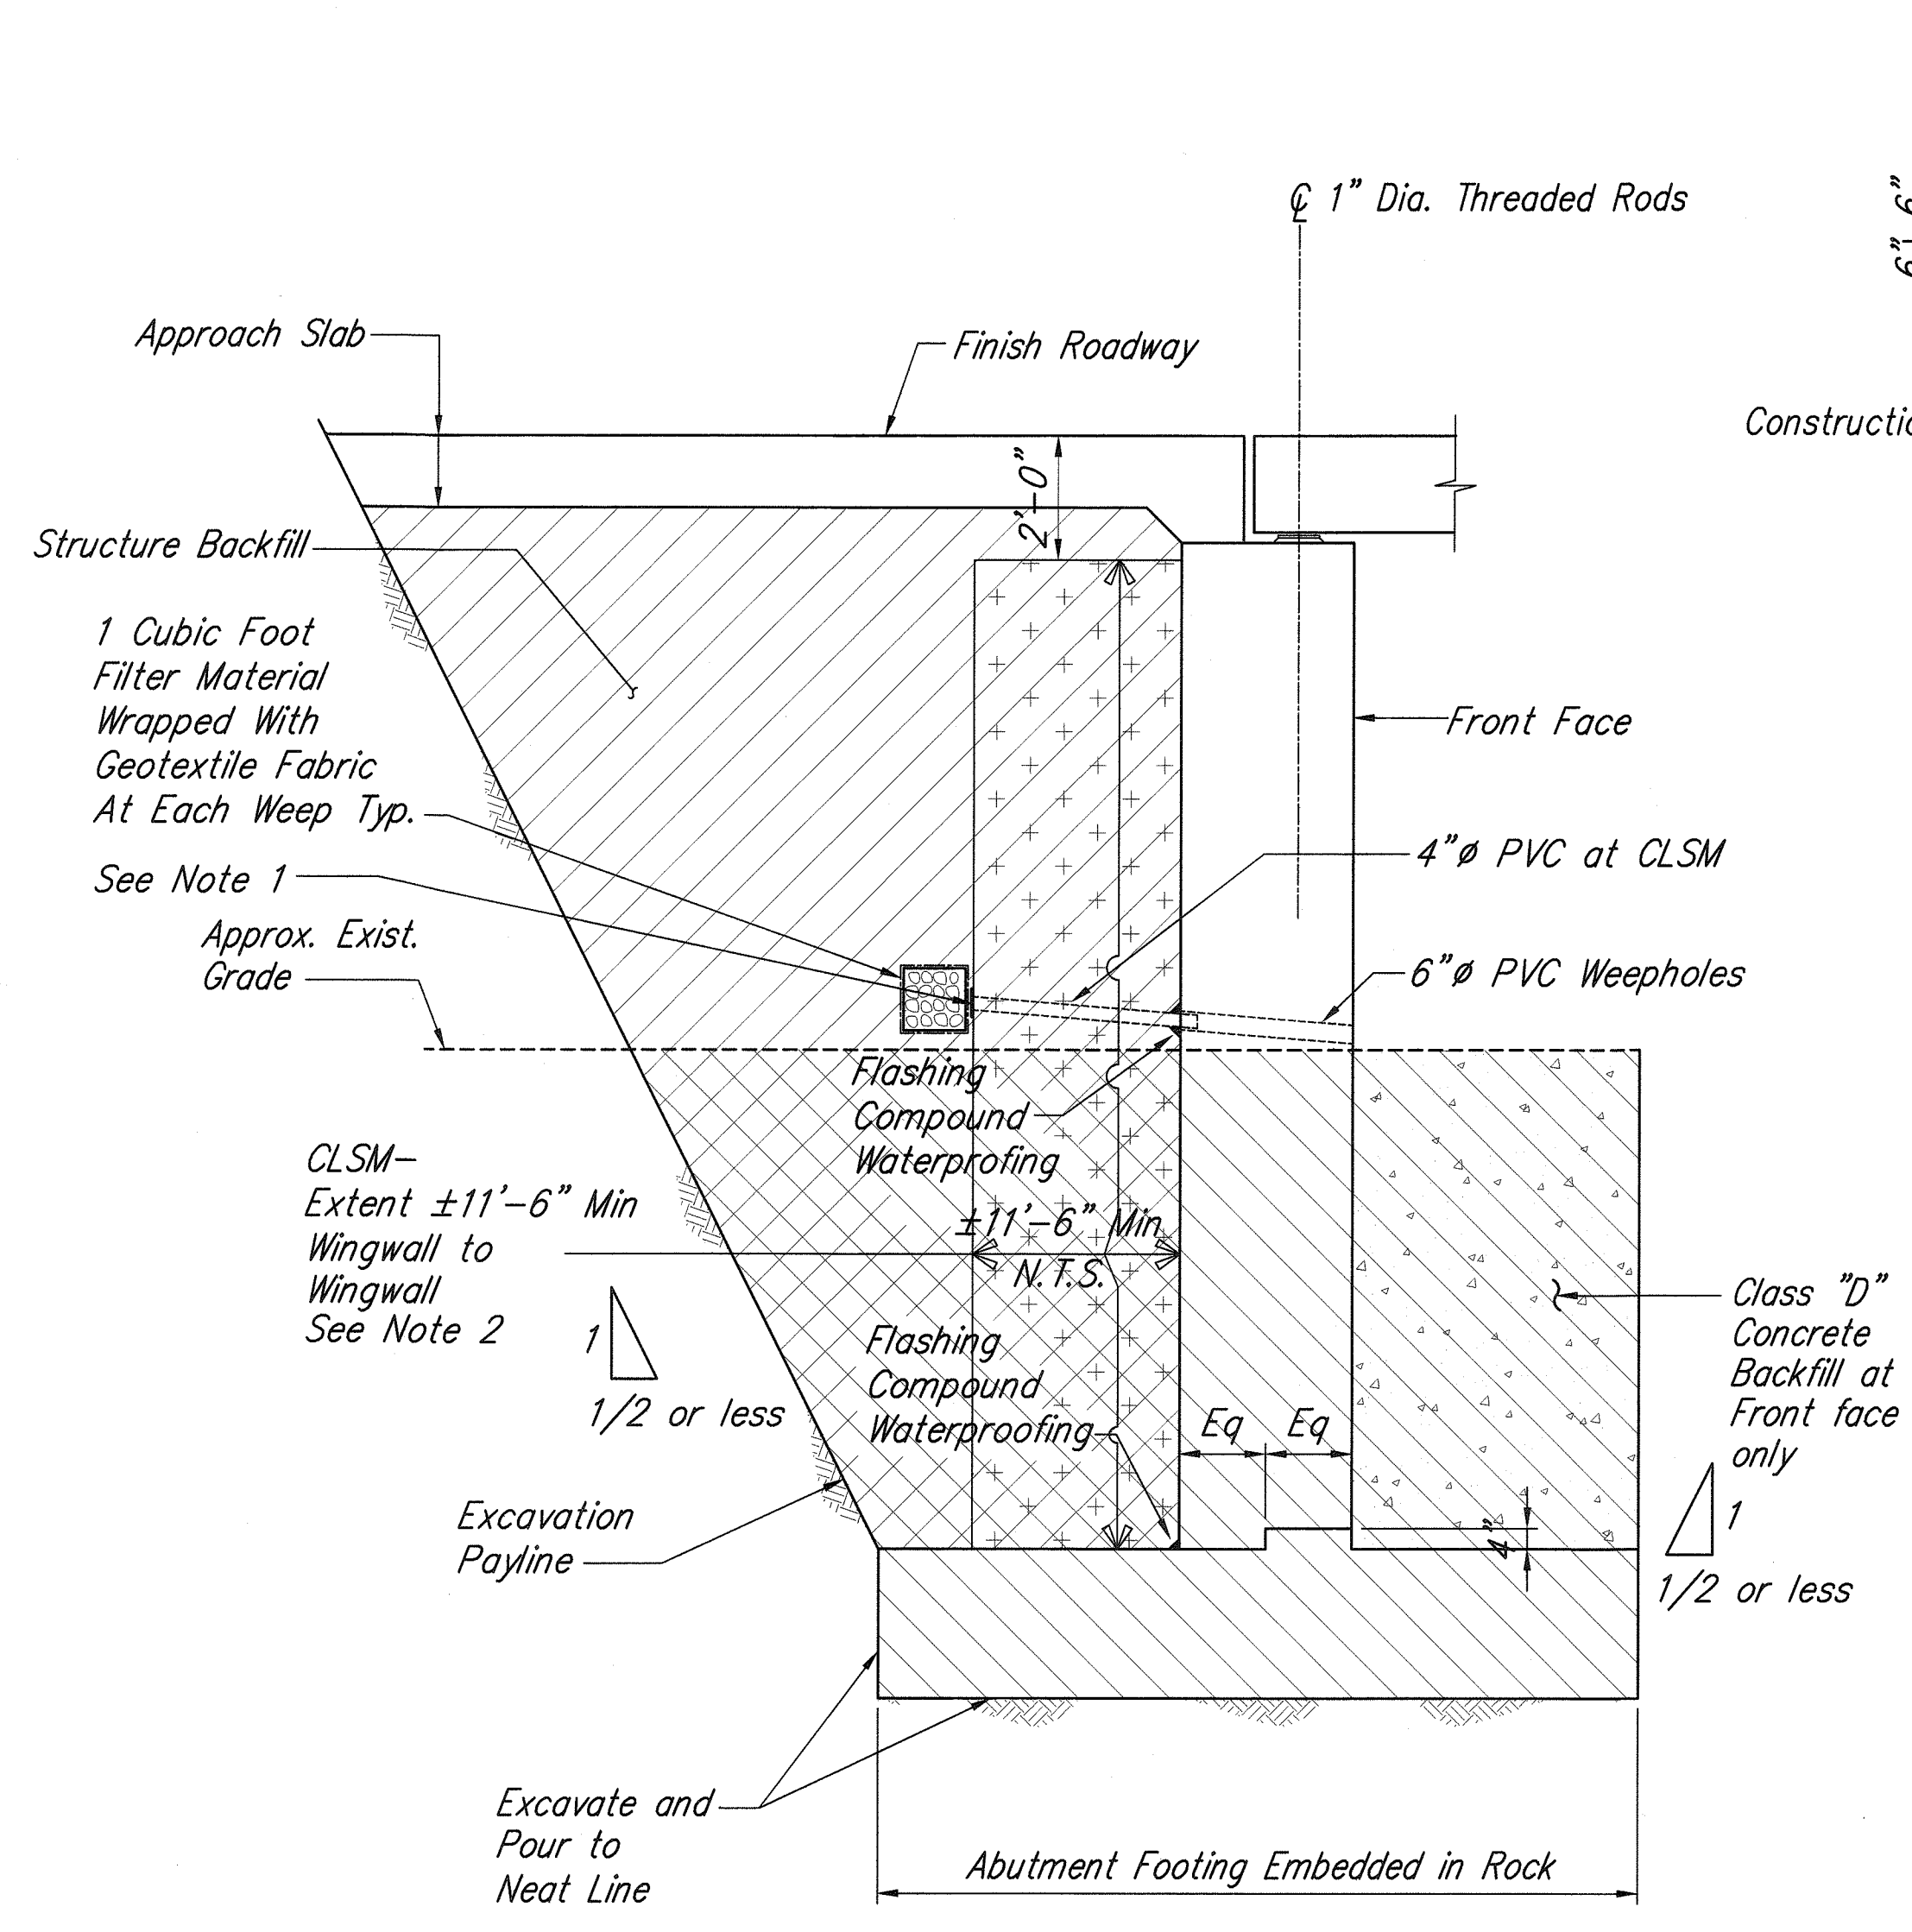


- Note:**
1. Provide 6" square aluminum or galvanized steel wire, 1/4" mesh hardware cloth (minimum wire diameter 0.025"). Anchor firmly to backface.
 2. CLSM Shall Be Formed and Placed At 4'-0" Maximum Lifts. CLSM Lifts Shall Be Placed No Less Than 24 Hours After The Completion of the Previous CLSM Lift. Roughen CLSM Surfaces to 1/4" Minimum Roughness.

ABUTMENT EXCAVATION
and BACKFILL PAYLIMITS
Scale: 3/8" = 1'-0"

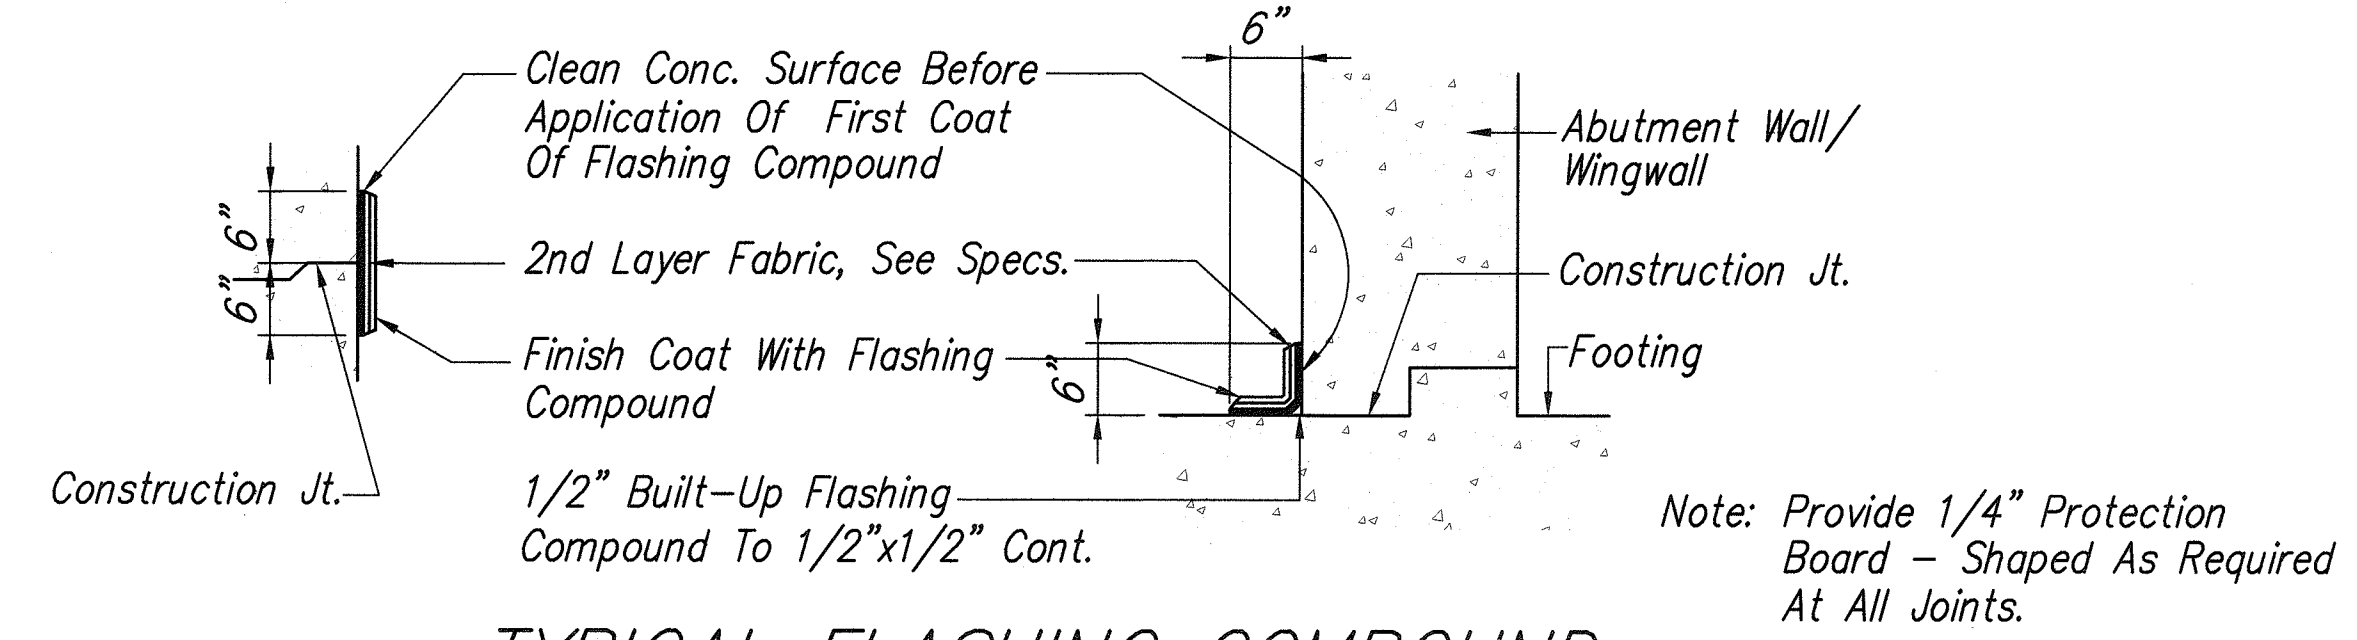

TYPICAL FLASHING COMPOUND
WATERPROOFING DETAIL
N.T.S.

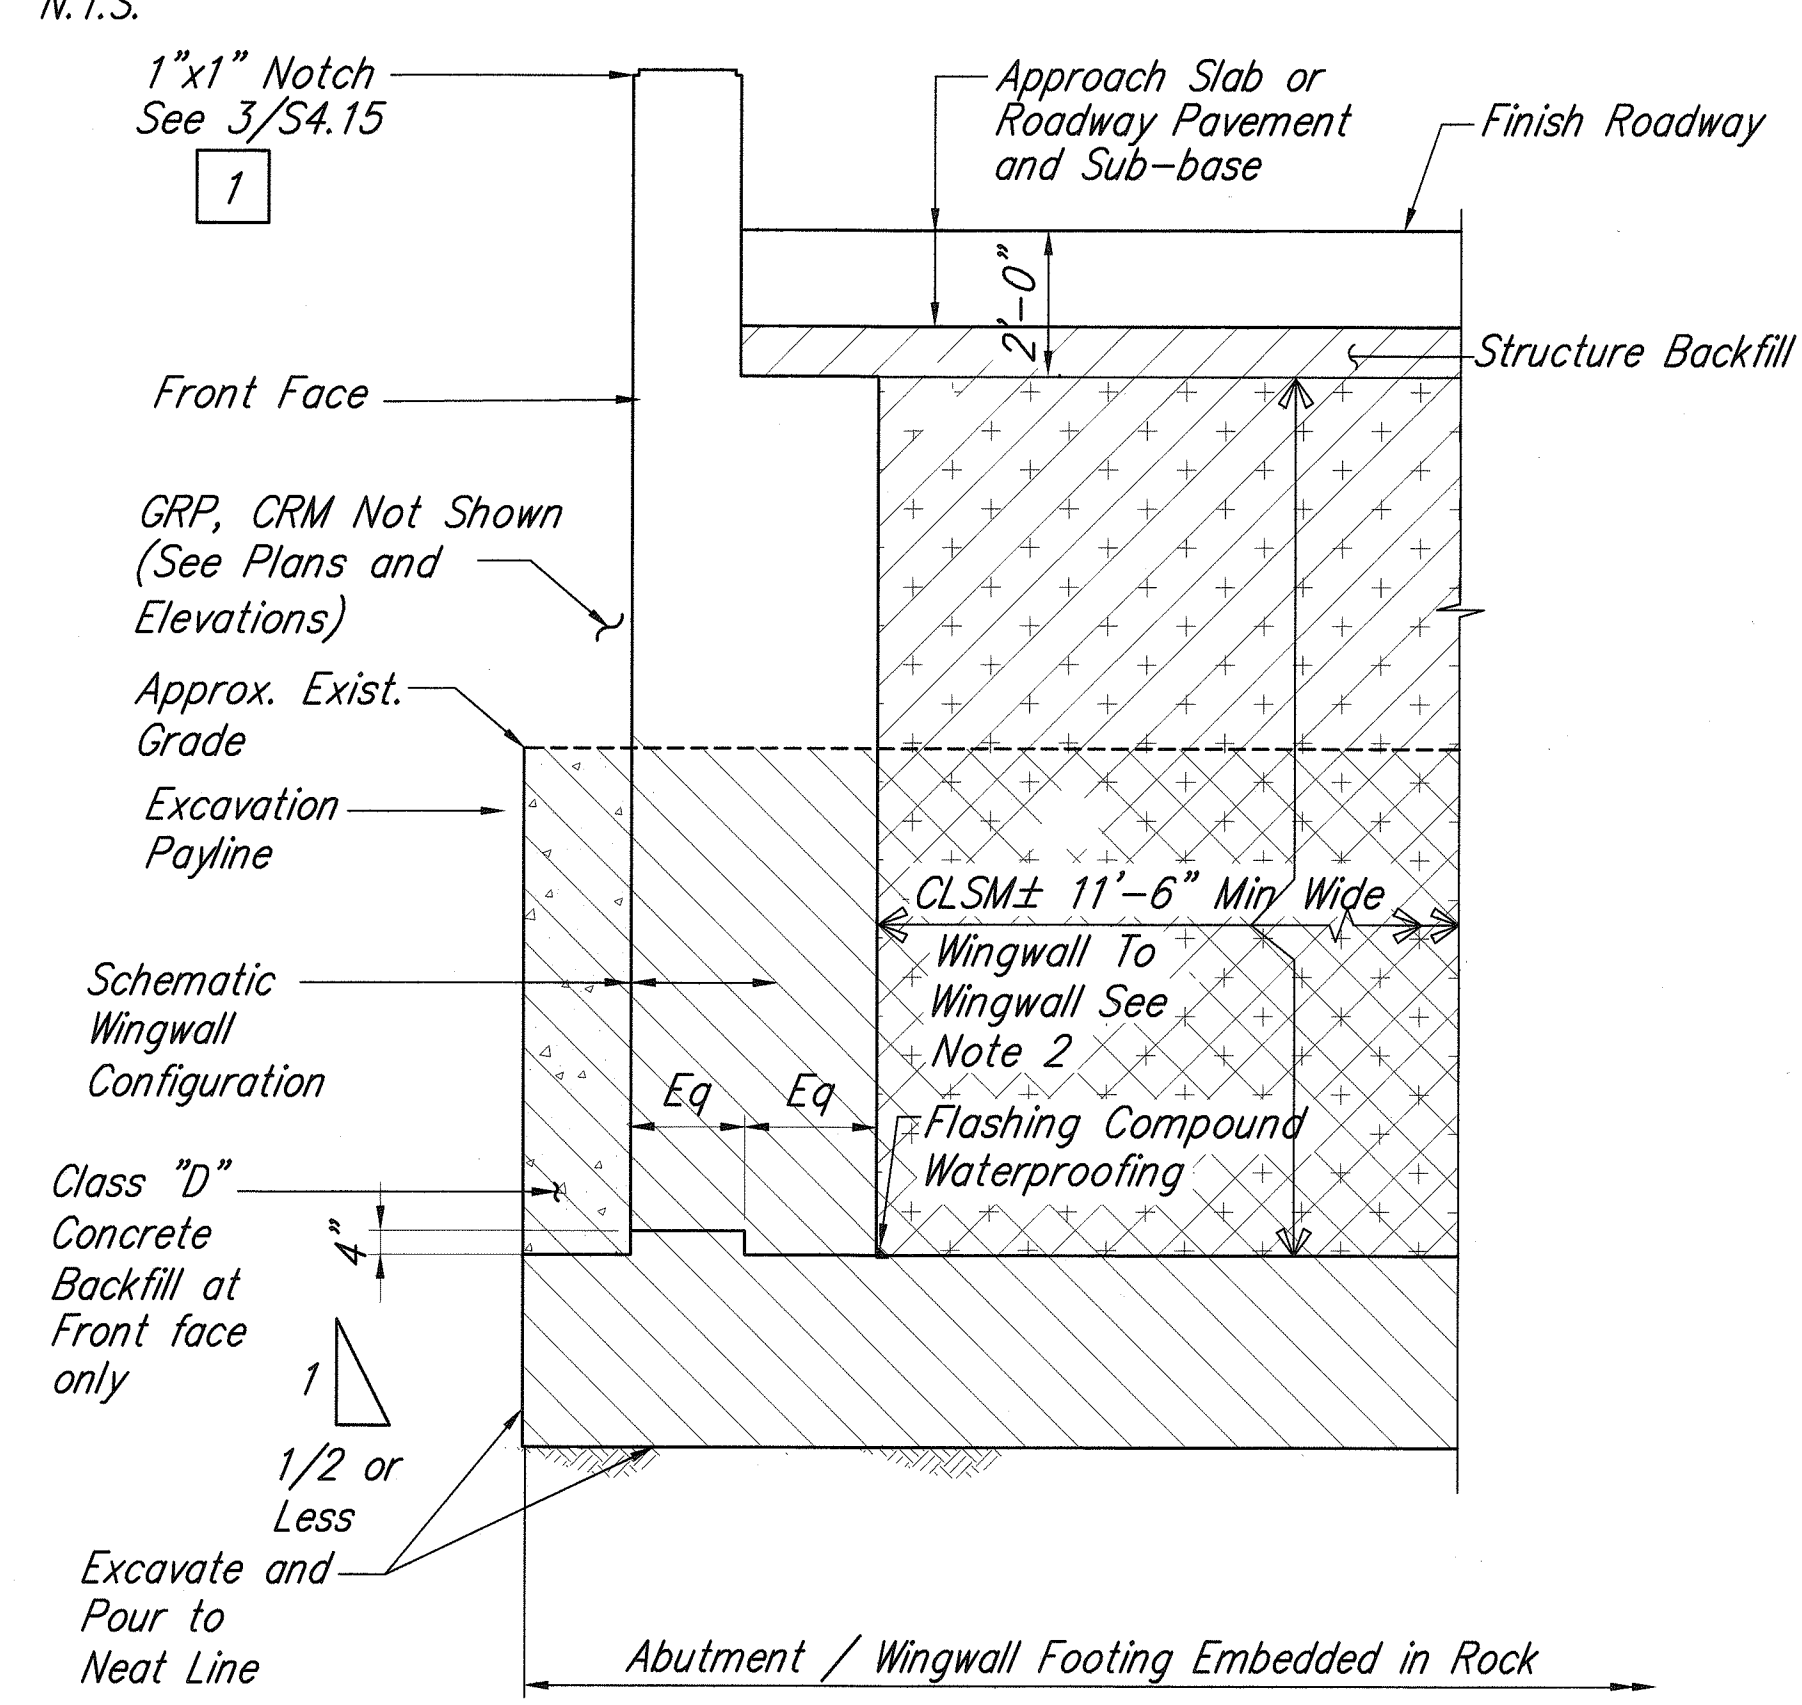


- Note:**
1. Provide 6" square aluminum or galvanized steel wire, 1/4" mesh hardware cloth (minimum wire diameter 0.025"). Anchor firmly to backface.
 2. CLSM Shall Be Formed and Placed At 4'-0" Maximum Lifts. CLSM Lifts Shall Be Placed No Less Than 24 Hours After The Completion of the Previous CLSM Lift. Roughen CLSM Surfaces to 1/4" Minimum Roughness.

WINGWALL EXCAVATION
and BACKFILL PAYLIMITS
Scale: 3/8" = 1'-0"



- Legend:**
- Structure Excavation
 - Structure Backfill
 - Class "D" Concrete Backfill
 - CLSM Backfill
- Note:**
1. Excavations for footings in Basalt Rock formation (including fractured rock and clinker materials) shall be kept to near-vertical (0.5H:1V) or steeper. Inadvertent over-excavations by the Contractor shall be cleaned of loose and fractured rock to expose intact rock. Concrete for the final footing shall be poured in contact with the sides of the excavation for the full for the full designed footing thickness. The resulting void space above the top of the footing shall be backfilled with Class D concrete where indicated. Backfilling the inadvertent over-excavations with footing concrete or Class D concrete will not be measured and paid for separately.
 2. All footing excavations shall be cleaned of loose materials and highly fractured rock to the satisfaction of the Engineer.
 3. The Engineer may direct the Contractor to over-excavate below the bottom of footing elevation and to the sides of the edges of the footing excavations. The additional over-excavation of the footing excavations, as directed by the Engineer, will be measured and paid for as structure excavation as indicated in the specifications.
 4. The additional over-excavation as directed by the Engineer, below the bottom of footing elevation shall be backfilled with Class D concrete. This item will be measured and paid for as Structure Backfill for Abutments and Wingwalls (Class D concrete).
 5. Geotextile and 4" PVC shall be incidental to Structural backfill.

SURVEY PLOTTED BY	DATE
DRAWN BY	
DESIGNED BY	
QUANTITIES BY	
CHECKED BY	
ORIGINAL PLAN	
NOTE BOOK	
No.	

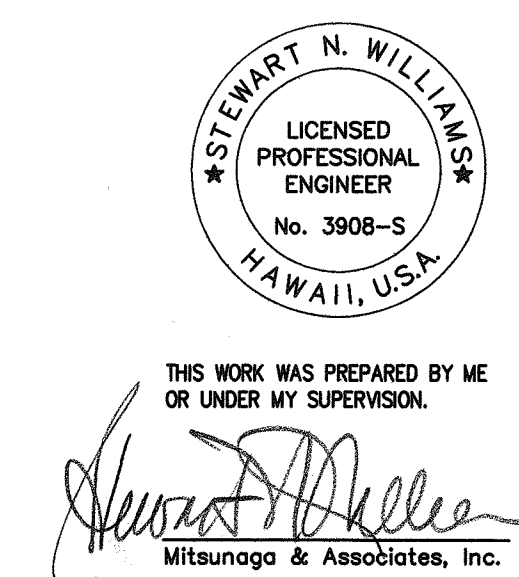

01-30-01	1	Added 1"x1" Notch Reference
DATE	DESCRIPTION	
STATE OF HAWAII DEPARTMENT OF TRANSPORTATION HIGHWAYS DIVISION EXCAVATION and BACKFILL LIMITS MAMALAHOA HIGHWAY REPLACEMENT OF KEAIWA STREAM BRIDGE Federal Aid Project No. ER-12(1)R		
Scale: As Noted	Date: January 2001	
SHEET No. S4.8 OF 50 SHEETS		

FED. ROAD DIST. NO.	STATE	FED. AID PROJ. NO.	FISCAL YEAR	SHEET NO.	TOTAL SHEETS
HAWAII	HAW.	ER-12(1)R	2001	30	77

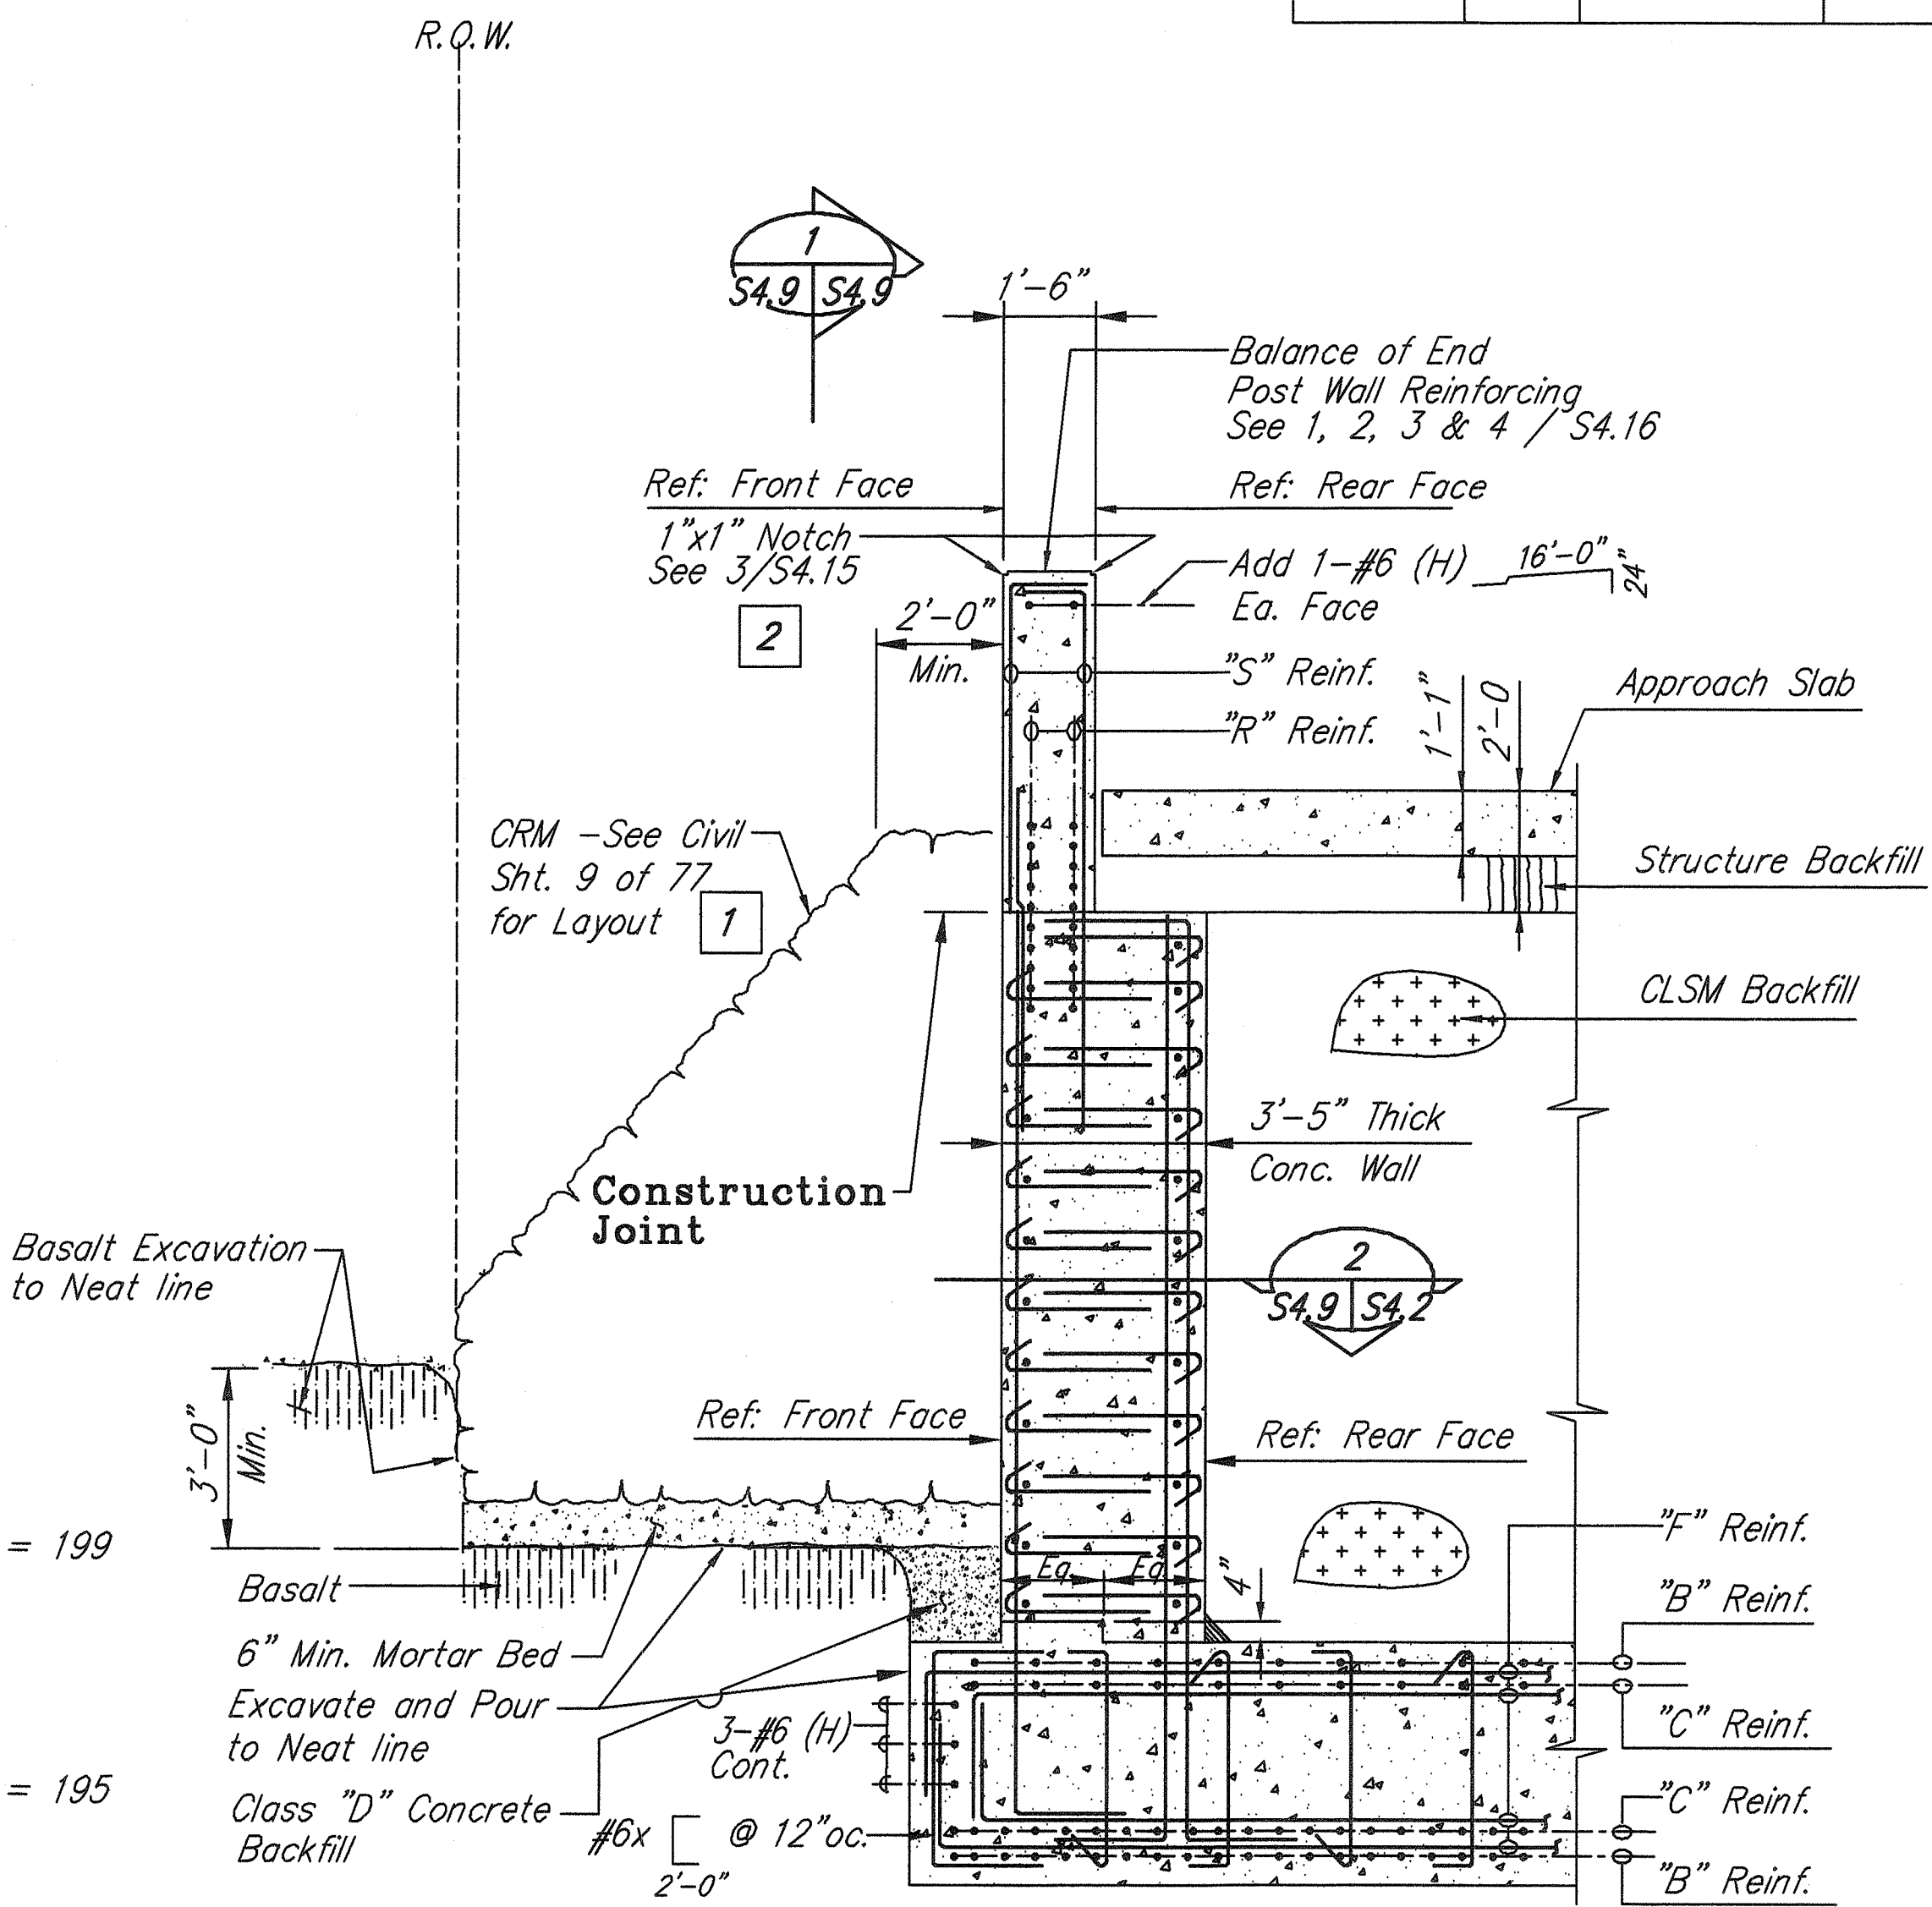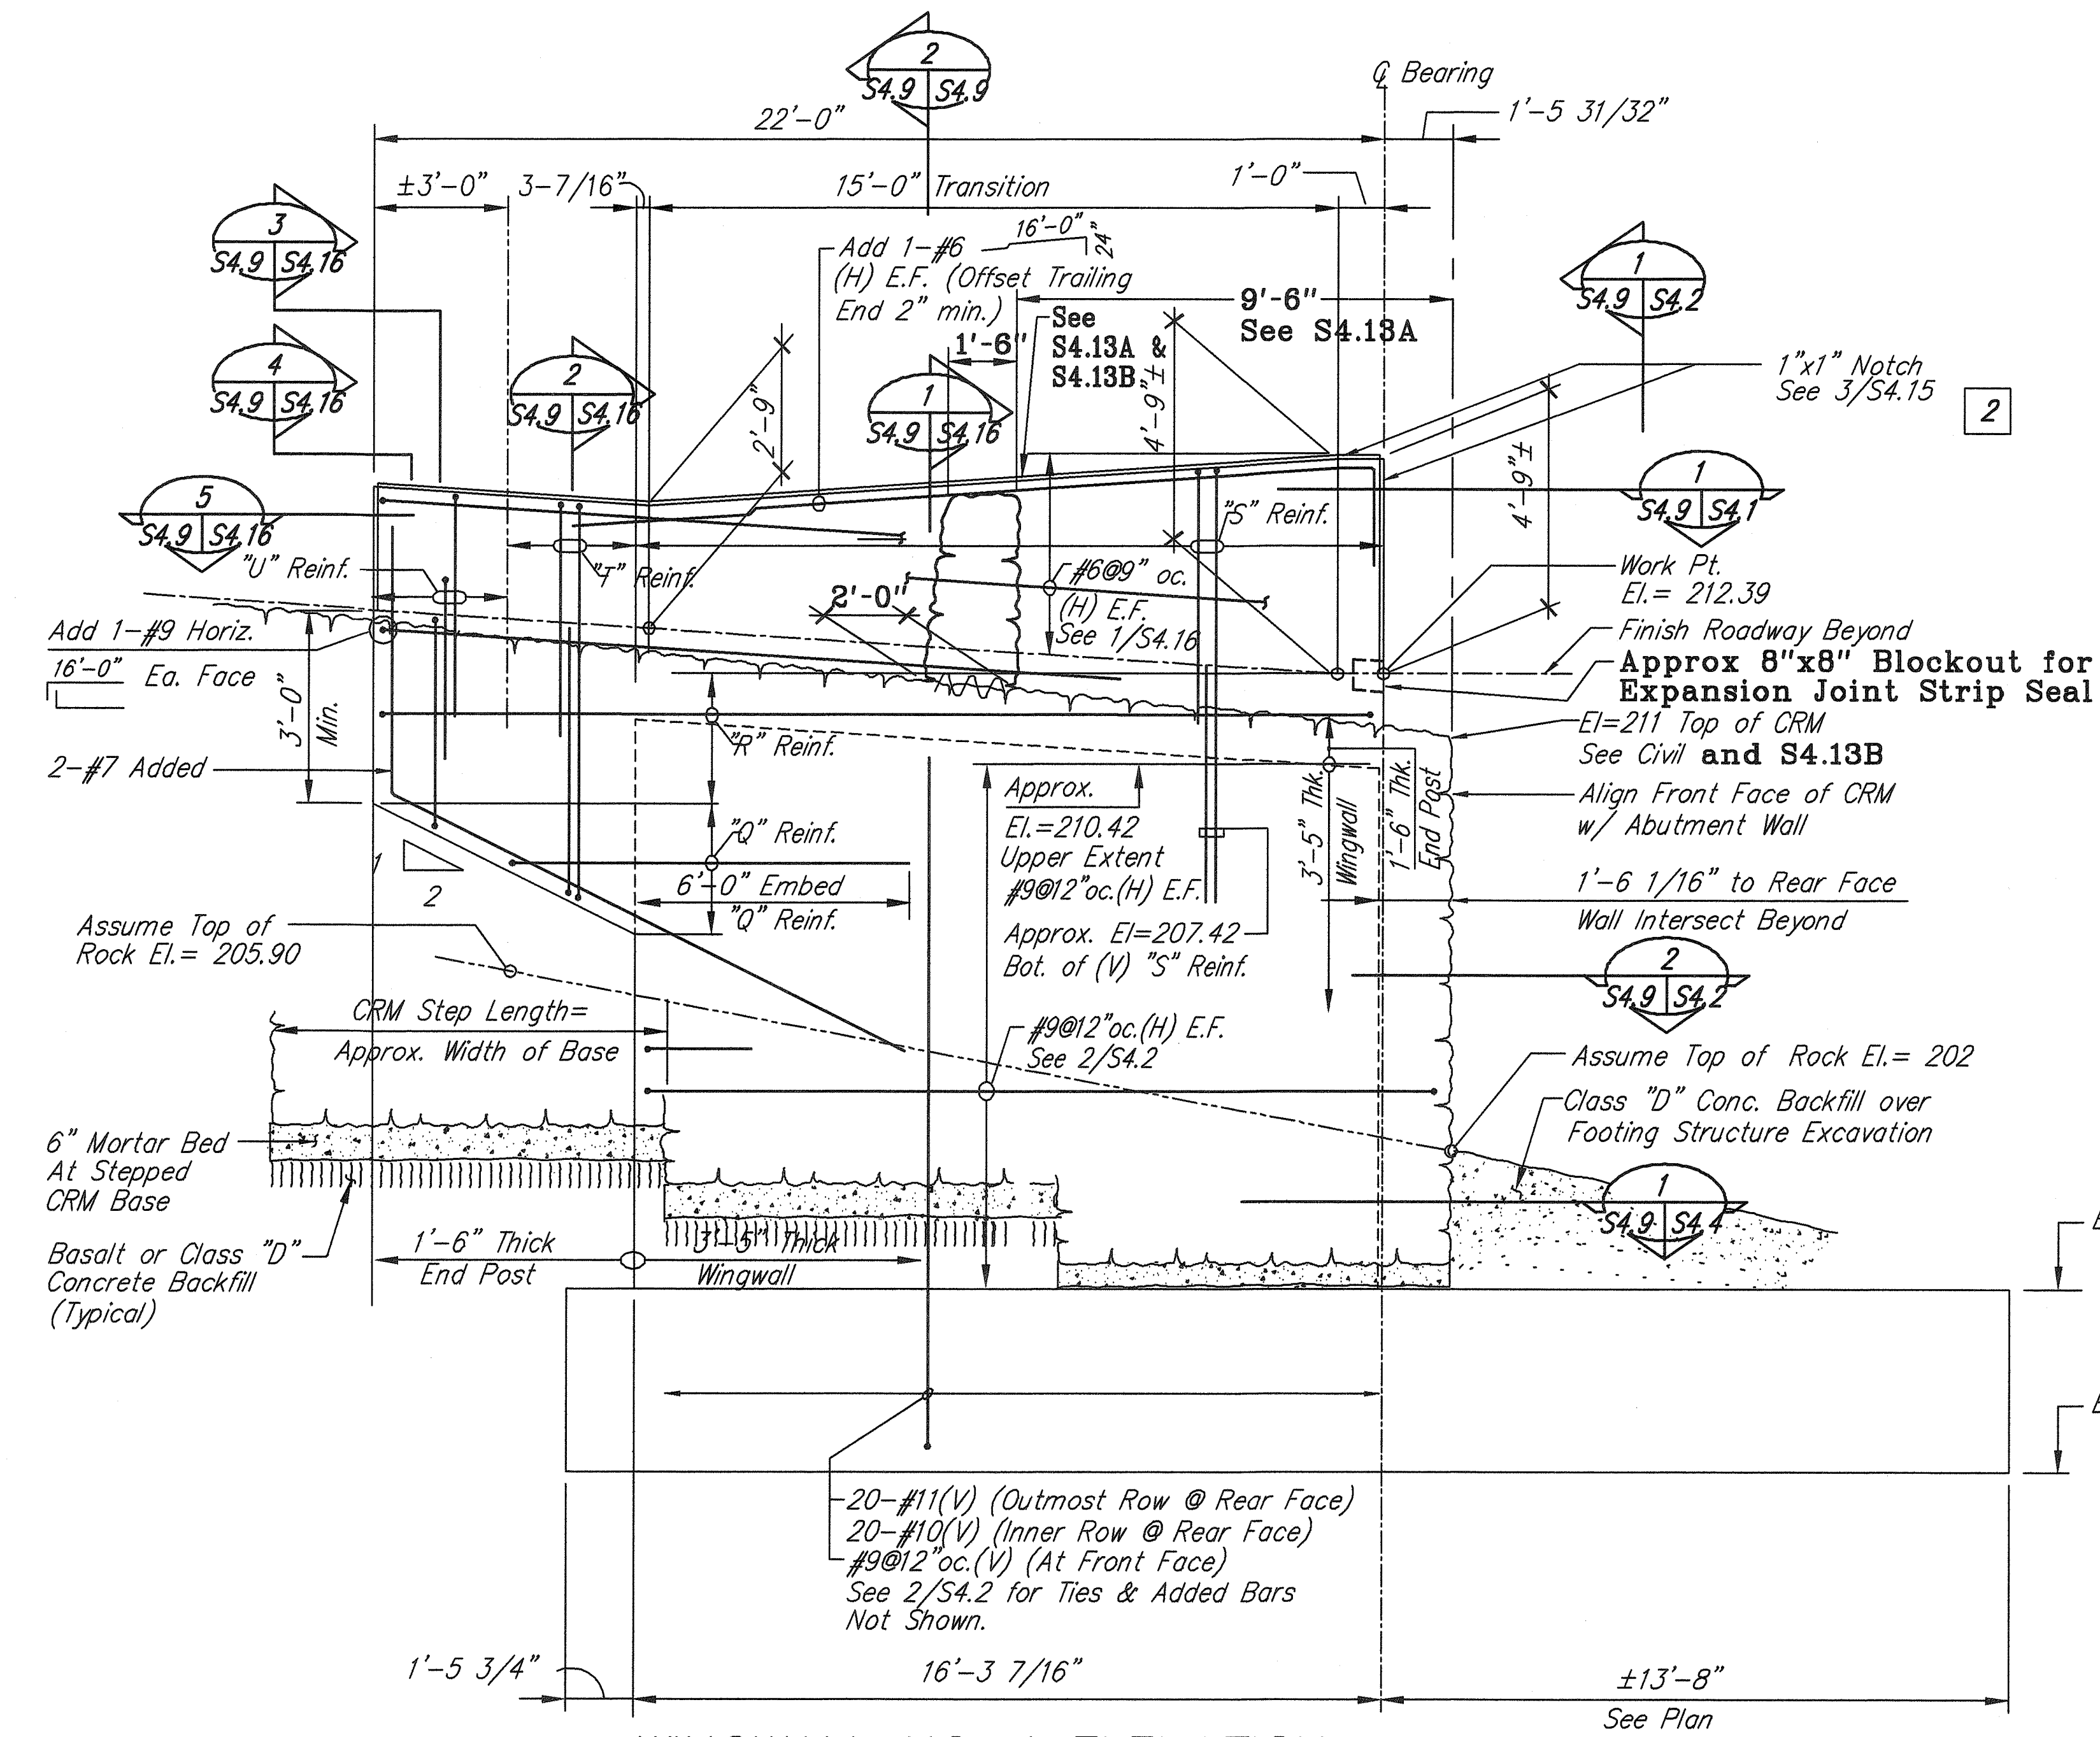

WINGWALL NO. 1 / END POST REINFORCING					
MARK	FRONT FACE REINFORCING	REAR FACE REINFORCING	MARK	FRONT FACE REINFORCING	REAR FACE REINFORCING
A thru P	Not Used	Not Used	T	#4 @ 6" o.c. (V) #5 @ 6" o.c. (V)	#6 @ 6" o.c. (V)
Q	#9 @ 6" o.c. (H)	#9 @ 6" o.c. (H)	U	Same as "T"	#6 @ 6" o.c. (V) #6 @ 6" o.c. (V) #6 @ 6" o.c. (V)
R	#9 @ 4" o.c. (H)	#9 @ 4" o.c. (H)	V thru Z	Not Used	Not Used
S	#4 @ 12" o.c. (V) #6 @ 6" o.c. (V)	#6 @ 6" o.c. (V)			

LEGEND FOR AS-BUILT POSTINGS


Squiggly line for as-built deletion
 Double line for as-built deletion
 Text for as-built posting

01-30-01	2	Added 1"x1" Notch References
01-30-01	1	Revised Sheet Reference

STATE OF HAWAII
 DEPARTMENT OF TRANSPORTATION
 HIGHWAYS DIVISION
WINGWALL NO.1
ELEVATION and DETAILS
MAMALAHOA HIGHWAY
REPLACEMENT OF
KEAIIWA STREAM BRIDGE
 Federal Aid Project No. ER-12(1)R
 Scale: As Noted Date: January 2001


STEWART N. WILLIAMS
 LICENSED PROFESSIONAL ENGINEER
 No. 3908-S
 HAWAII, U.S.A.

THIS WORK WAS PREPARED BY ME OR UNDER MY SUPERVISION.
 Mitsunaga & Associates, Inc.

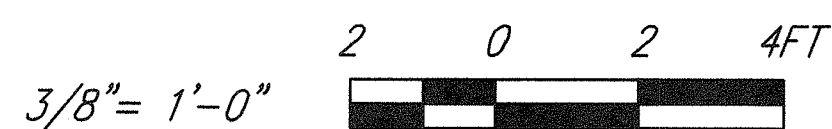

AS-BUILT


FED. ROAD DIST. NO.	STATE	FED. AID PROJ. NO.	FISCAL YEAR	SHEET NO.	TOTAL SHEETS
HAWAII	HAW.	ER-12 (1)R	2001	31	77

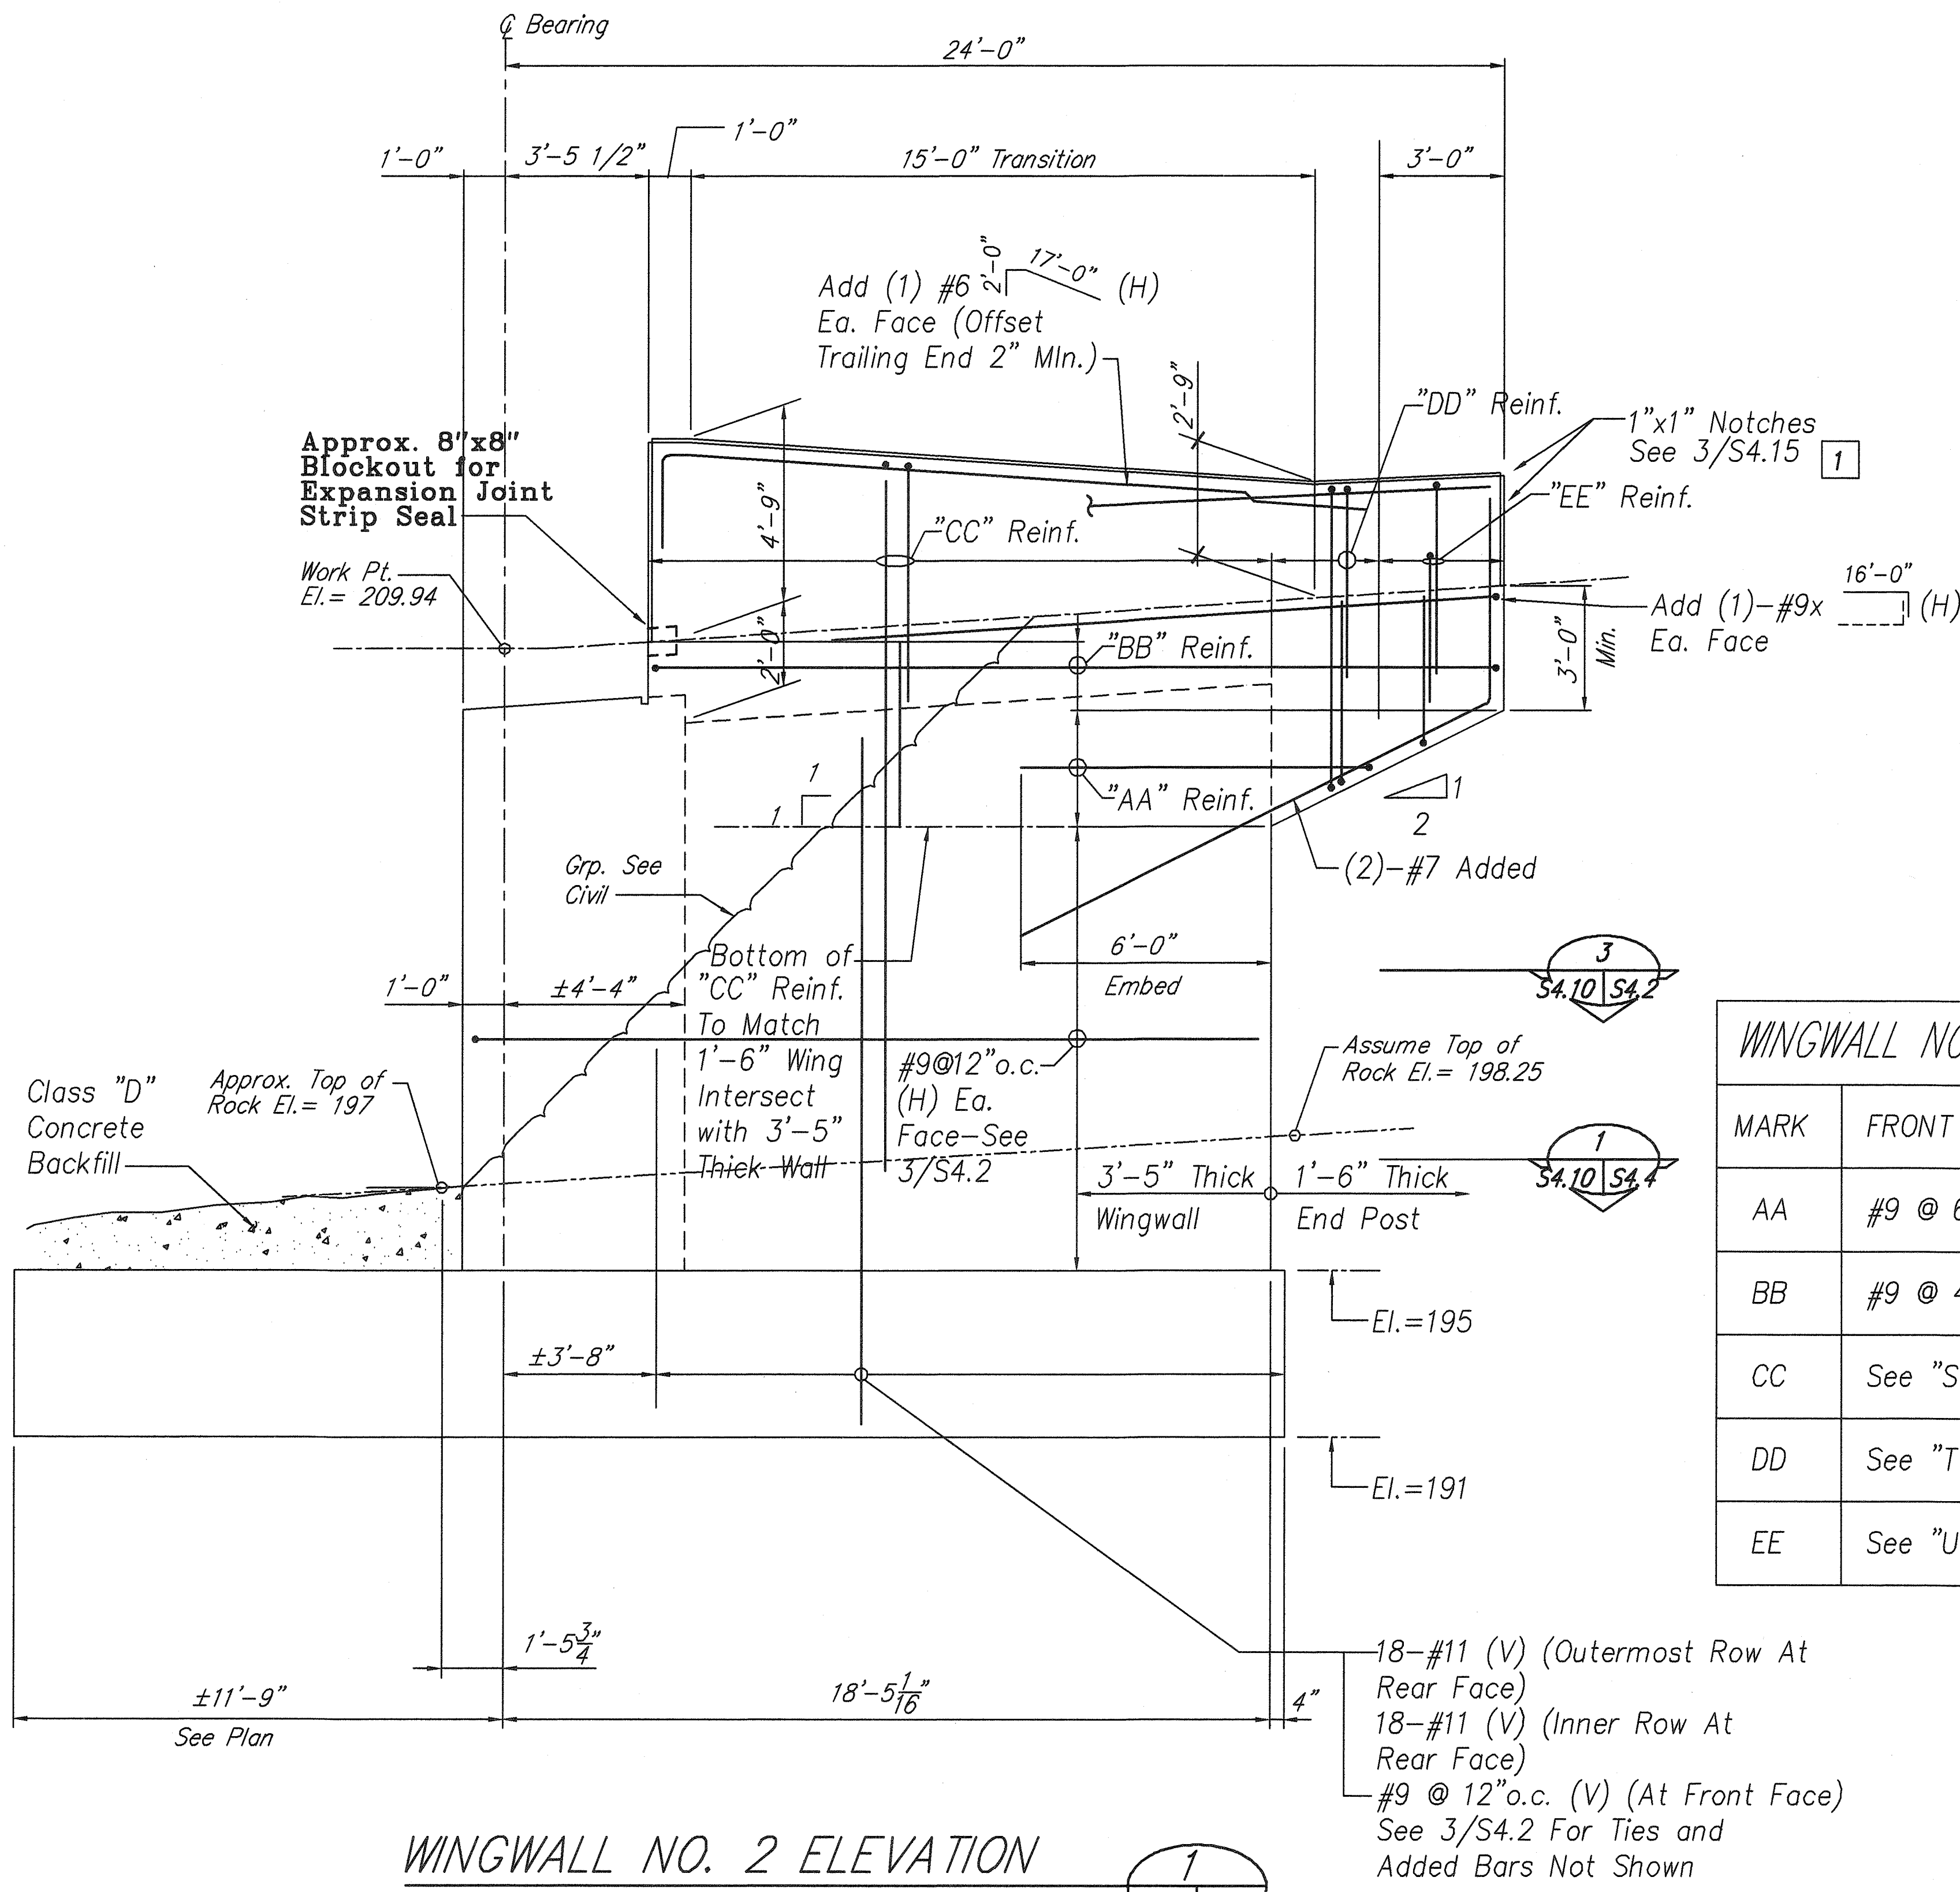

WINGWALL NO. 2 /END POST REINFORCING		
MARK	FRONT FACE REINF.	REAR FACE REINF.
AA	#9 @ 6"o.c. (H)	#10 @ 4"o.c. (H)
BB	#9 @ 4"o.c. (H)	#10 @ 4"o.c. (H)
CC	See "S" At S4.9	See "S" At S4.9
DD	See "T" At S4.9	See "T" At S4.9
EE	See "U" At S4.9	See "U" At S4.9

LEGEND FOR AS-BUILT POSTINGS	
	Squiggly line for as-built deletion
	Double line for as-built deletion
Roadway	Text for as-built posting

WINGWALL NO. 2 ELEVATION
 Sc: 3/8"= 1'-0" 1 S4.1 S4.10

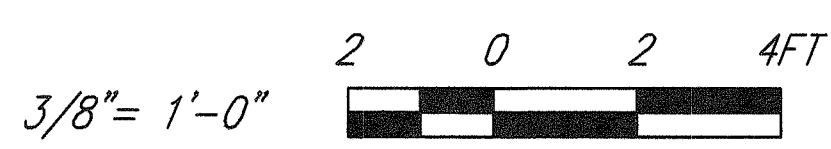

STEWART N. WILLIAMS
 LICENSED PROFESSIONAL ENGINEER
 No. 3908-S
 HAWAII, U.S.A.

THIS WORK WAS PREPARED BY ME OR UNDER MY SUPERVISION.
Stewart N. Williams
 Mitsunaga & Associates, Inc.

01-30-01	1 Added 1"x1" Notch Reference
DATE	DESCRIPTION

STATE OF HAWAII
 DEPARTMENT OF TRANSPORTATION
 HIGHWAYS DIVISION


WINGWALL NO.2 ELEVATION
 and DETAILS

MAMALAHOA HIGHWAY
 REPLACEMENT OF
 KEAIIA STREAM BRIDGE
 Federal Aid Project No. ER-12(1)R

Scale: As Noted Date: January 2001

SHEET No. S4.10 OF 50 SHEETS

FED. ROAD DIST. NO.	STATE	FED. AID PROJ. NO.	FISCAL YEAR	SHEET NO.	TOTAL SHEETS
HAWAII	HAW.	ER-12 (1)R	2001	32	77

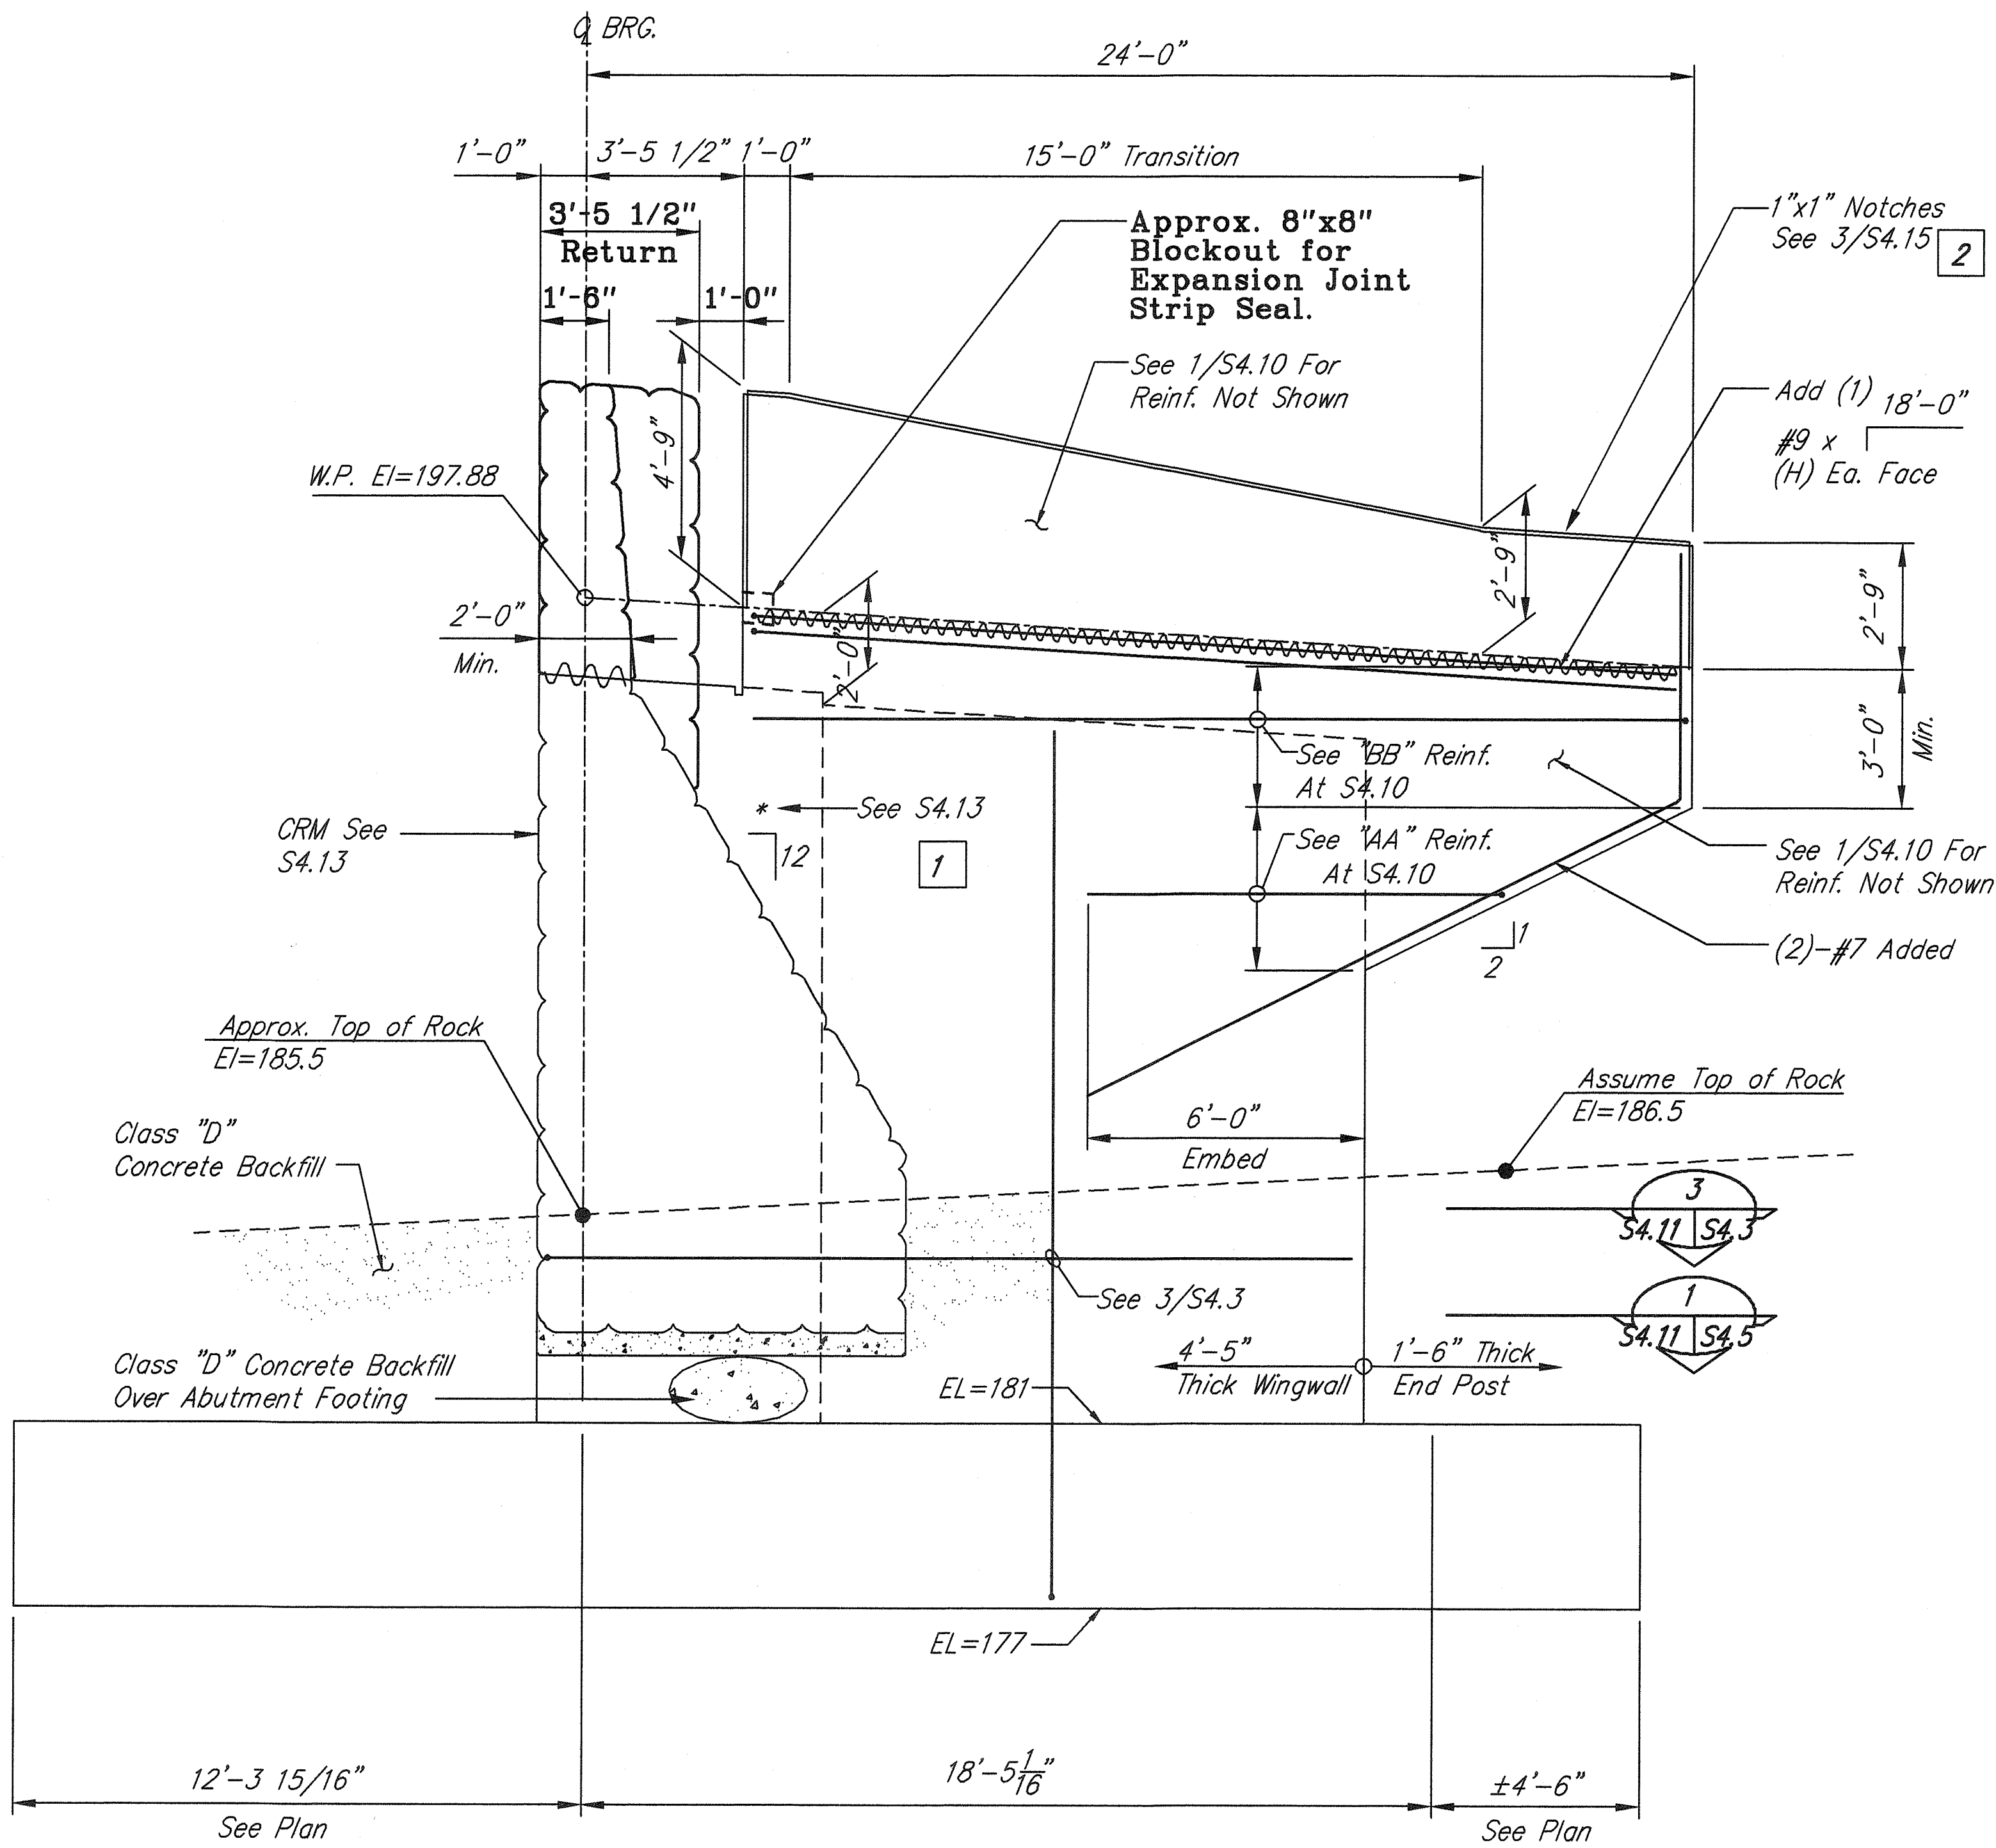


**LEGEND FOR
AS-BUILT POSTINGS**


	Squiggly line for as-built deletion
	Double line for as-built deletion
Roadway	Text for as-built posting

01-30-01	2	Added 1"x1" Notch Reference
01-30-01	1	Coordinate CRM Slope Reference

DATE	DESCRIPTION
STATE OF HAWAII DEPARTMENT OF TRANSPORTATION HIGHWAYS DIVISION WINGWALL NO.3 ELEVATION and DETAILS MAMALAHOA HIGHWAY REPLACEMENT OF KEAIIWA STREAM BRIDGE Federal Aid Project No. ER-12(1)R Scale: As Noted Date: January 2001 SHEET No. S4.11 OF 50 SHEETS	

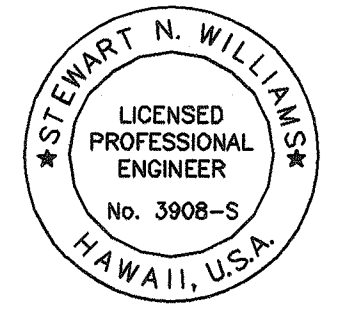


THIS WORK WAS PREPARED BY ME
OR UNDER MY SUPERVISION.
Stewart N. Williams
Mitsunaga & Associates, Inc.

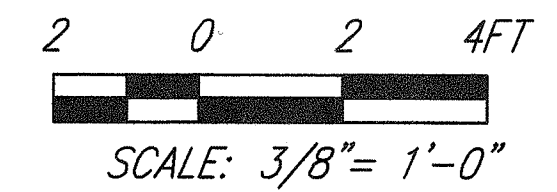

WINGWALL NO.3 ELEVATION
Sc: 3/8" = 1'-0" 1 S4.1 S4.11

AS-BUILT

FED. ROAD DIST. NO.	STATE	FED. AID PROJ. NO.	FISCAL YEAR	SHEET NO.	TOTAL SHEETS
HAWAII	HAW.	ER-12 (1)R	2001	34	77

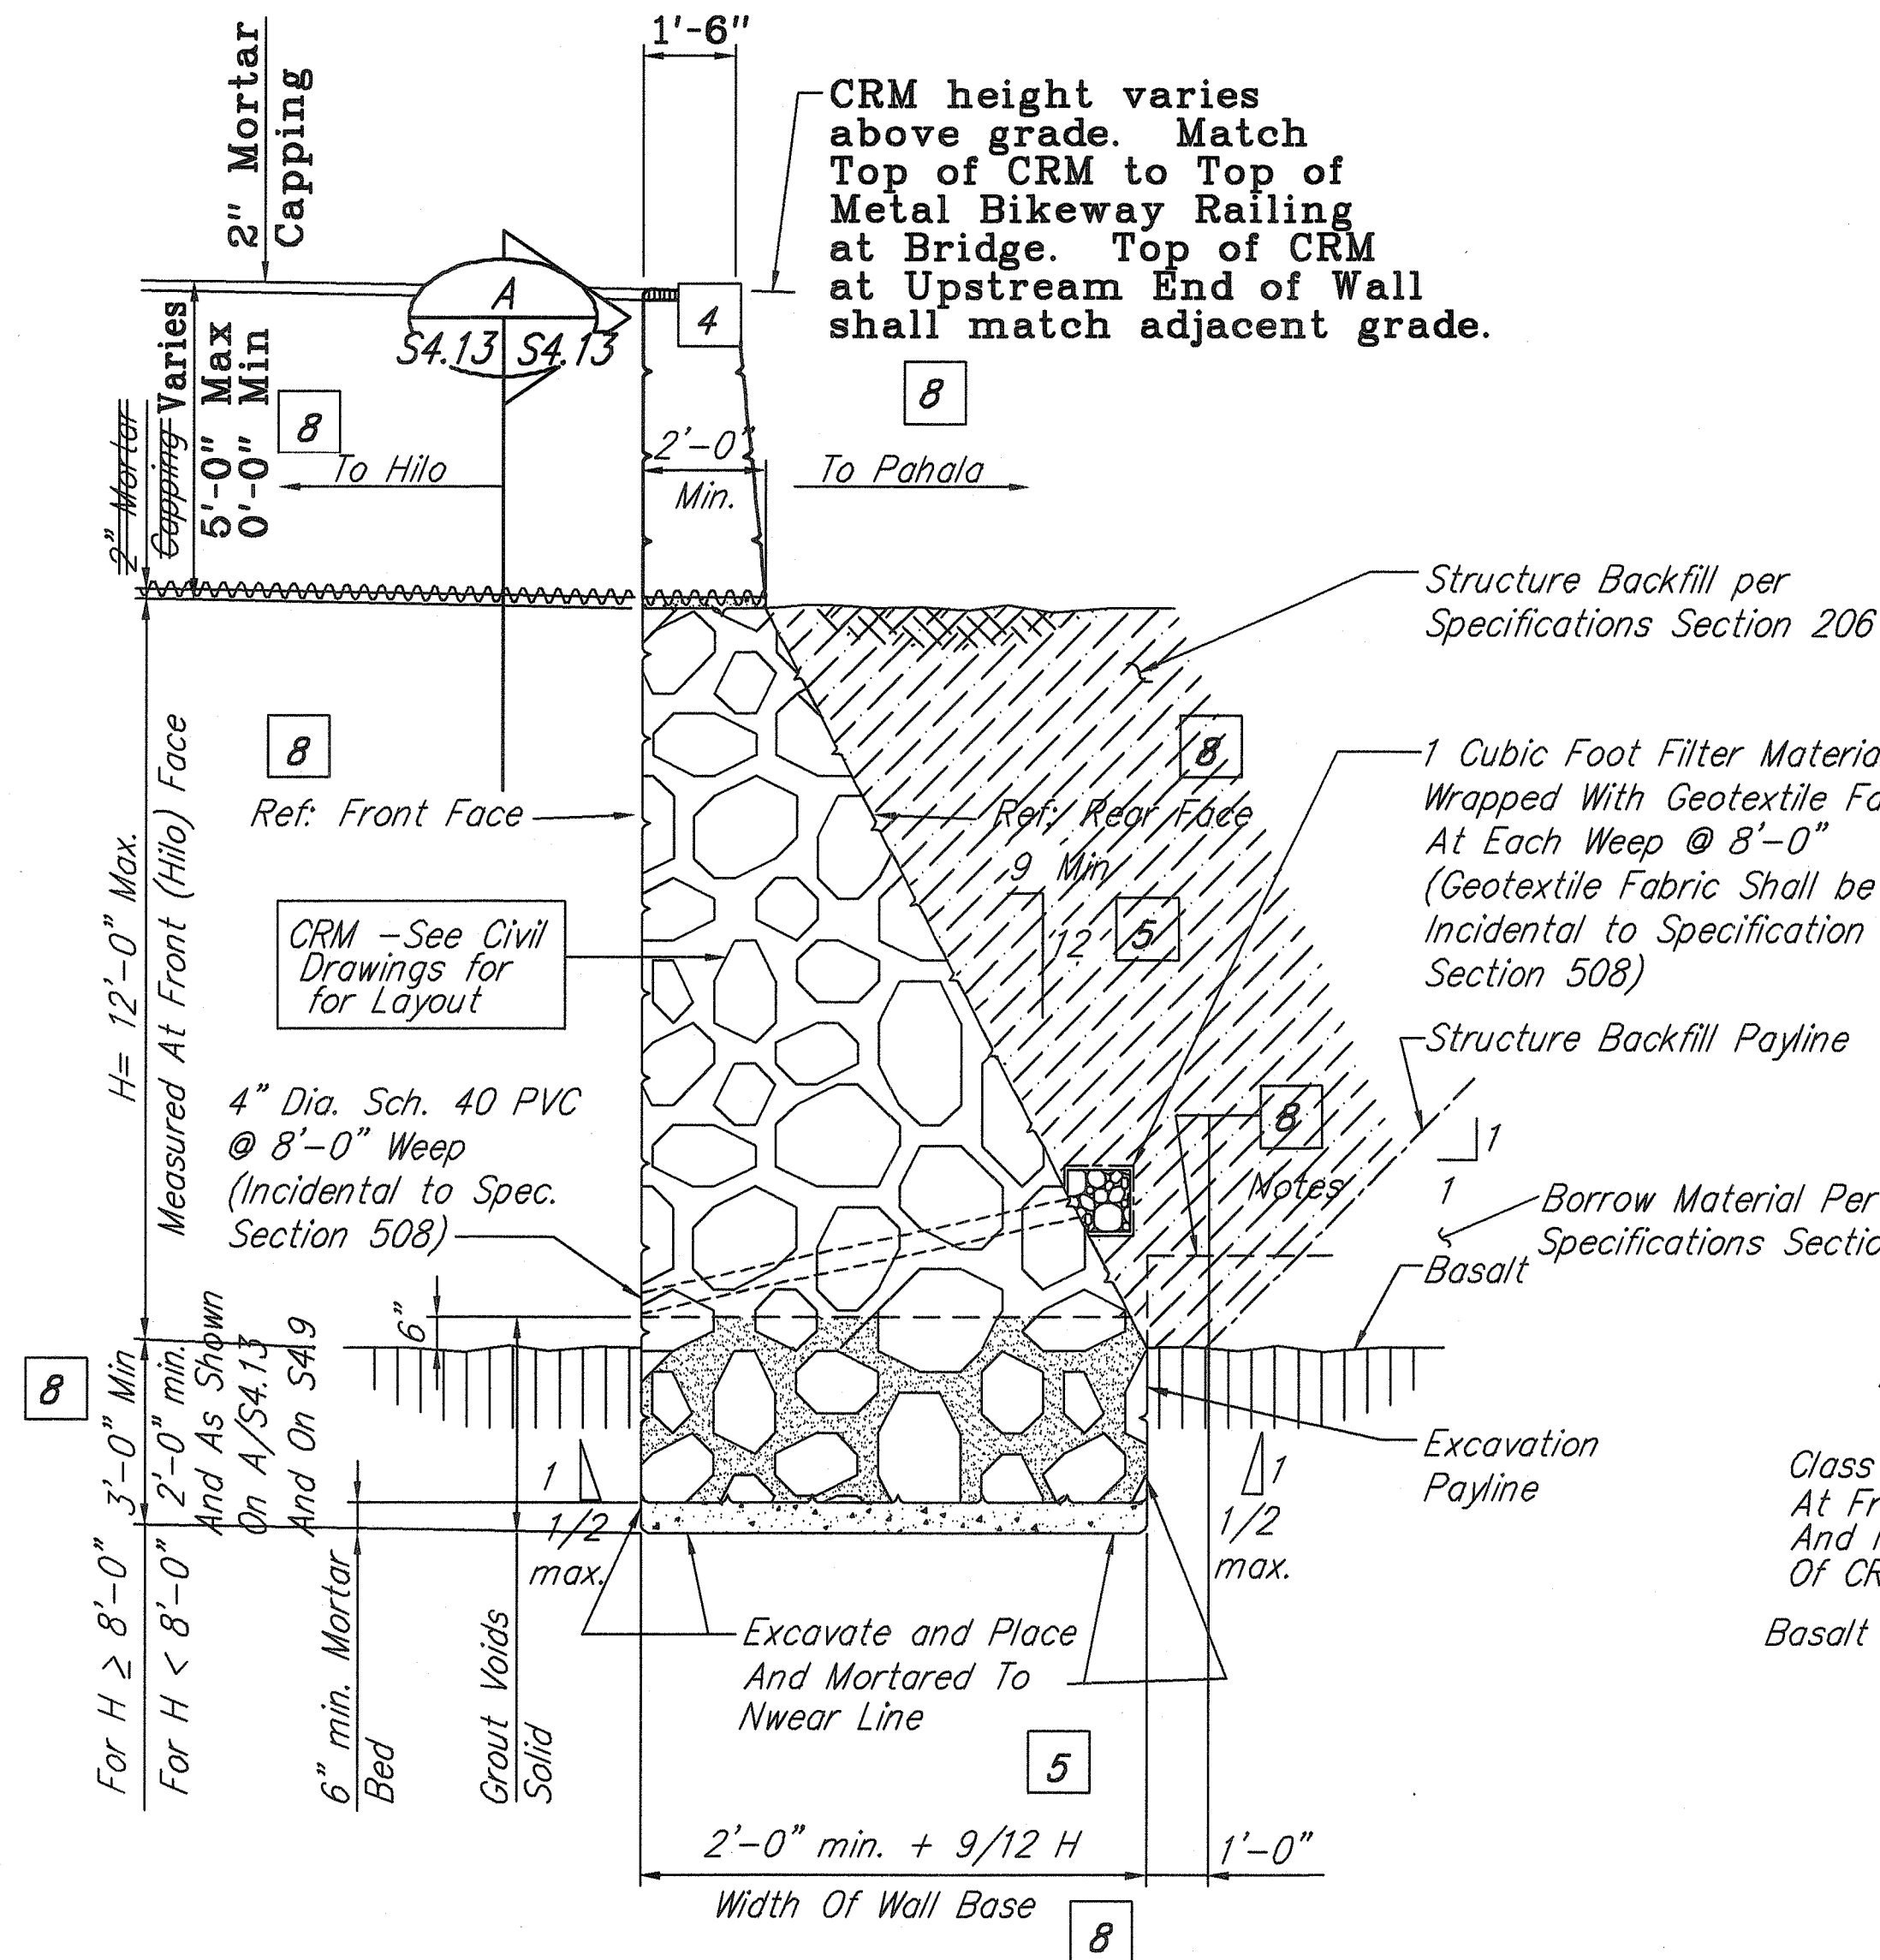

SITEWALL SECTION

Scale: 3/8" = 1'-0"

Notes:


- Indicates Zone of CRM With All Beds, Joints and Voids Filled Solid With Portland Cement Mortar To The Basalt Excavation Faces
- See Civil Sht. 9 of 77 For CRM Wall Layout.
- See S4.9 For CRM Sitewall Configuration At Wingwall No.1.
- The CRM Wall Base Shall Be Level And Embedded In Basalt 2'-0" min. (For H<8'-0") And 3'-0" min. (For H>8'-0"). The Wall Base Shall Be Stepped At Intervals Approximately Equal To The Width Of The Wall Base And As Indicated At S4.9 And A/S4.13. Steps Shall Be Adjusted To Step 4'-0" Maximum.
- At CRM Sitewall At Abutment NO.2 (See A/S4.13), The Rear (Pahala) Face Top Of Basalt Elevation Is Expected To Be Greater Than That At The Front (Hilo) Face.

LEGEND FOR AS-BUILT POSTINGS



	Squiggly line for as-built deletion
	Double line for as-built deletion
	Text for as-built posting

SITEWALL ELEVATION AT ABUTMENT NO.2

Scale: Horizontal 3/32" = 1'-0"
Vertical 3/16" = 1'-0"

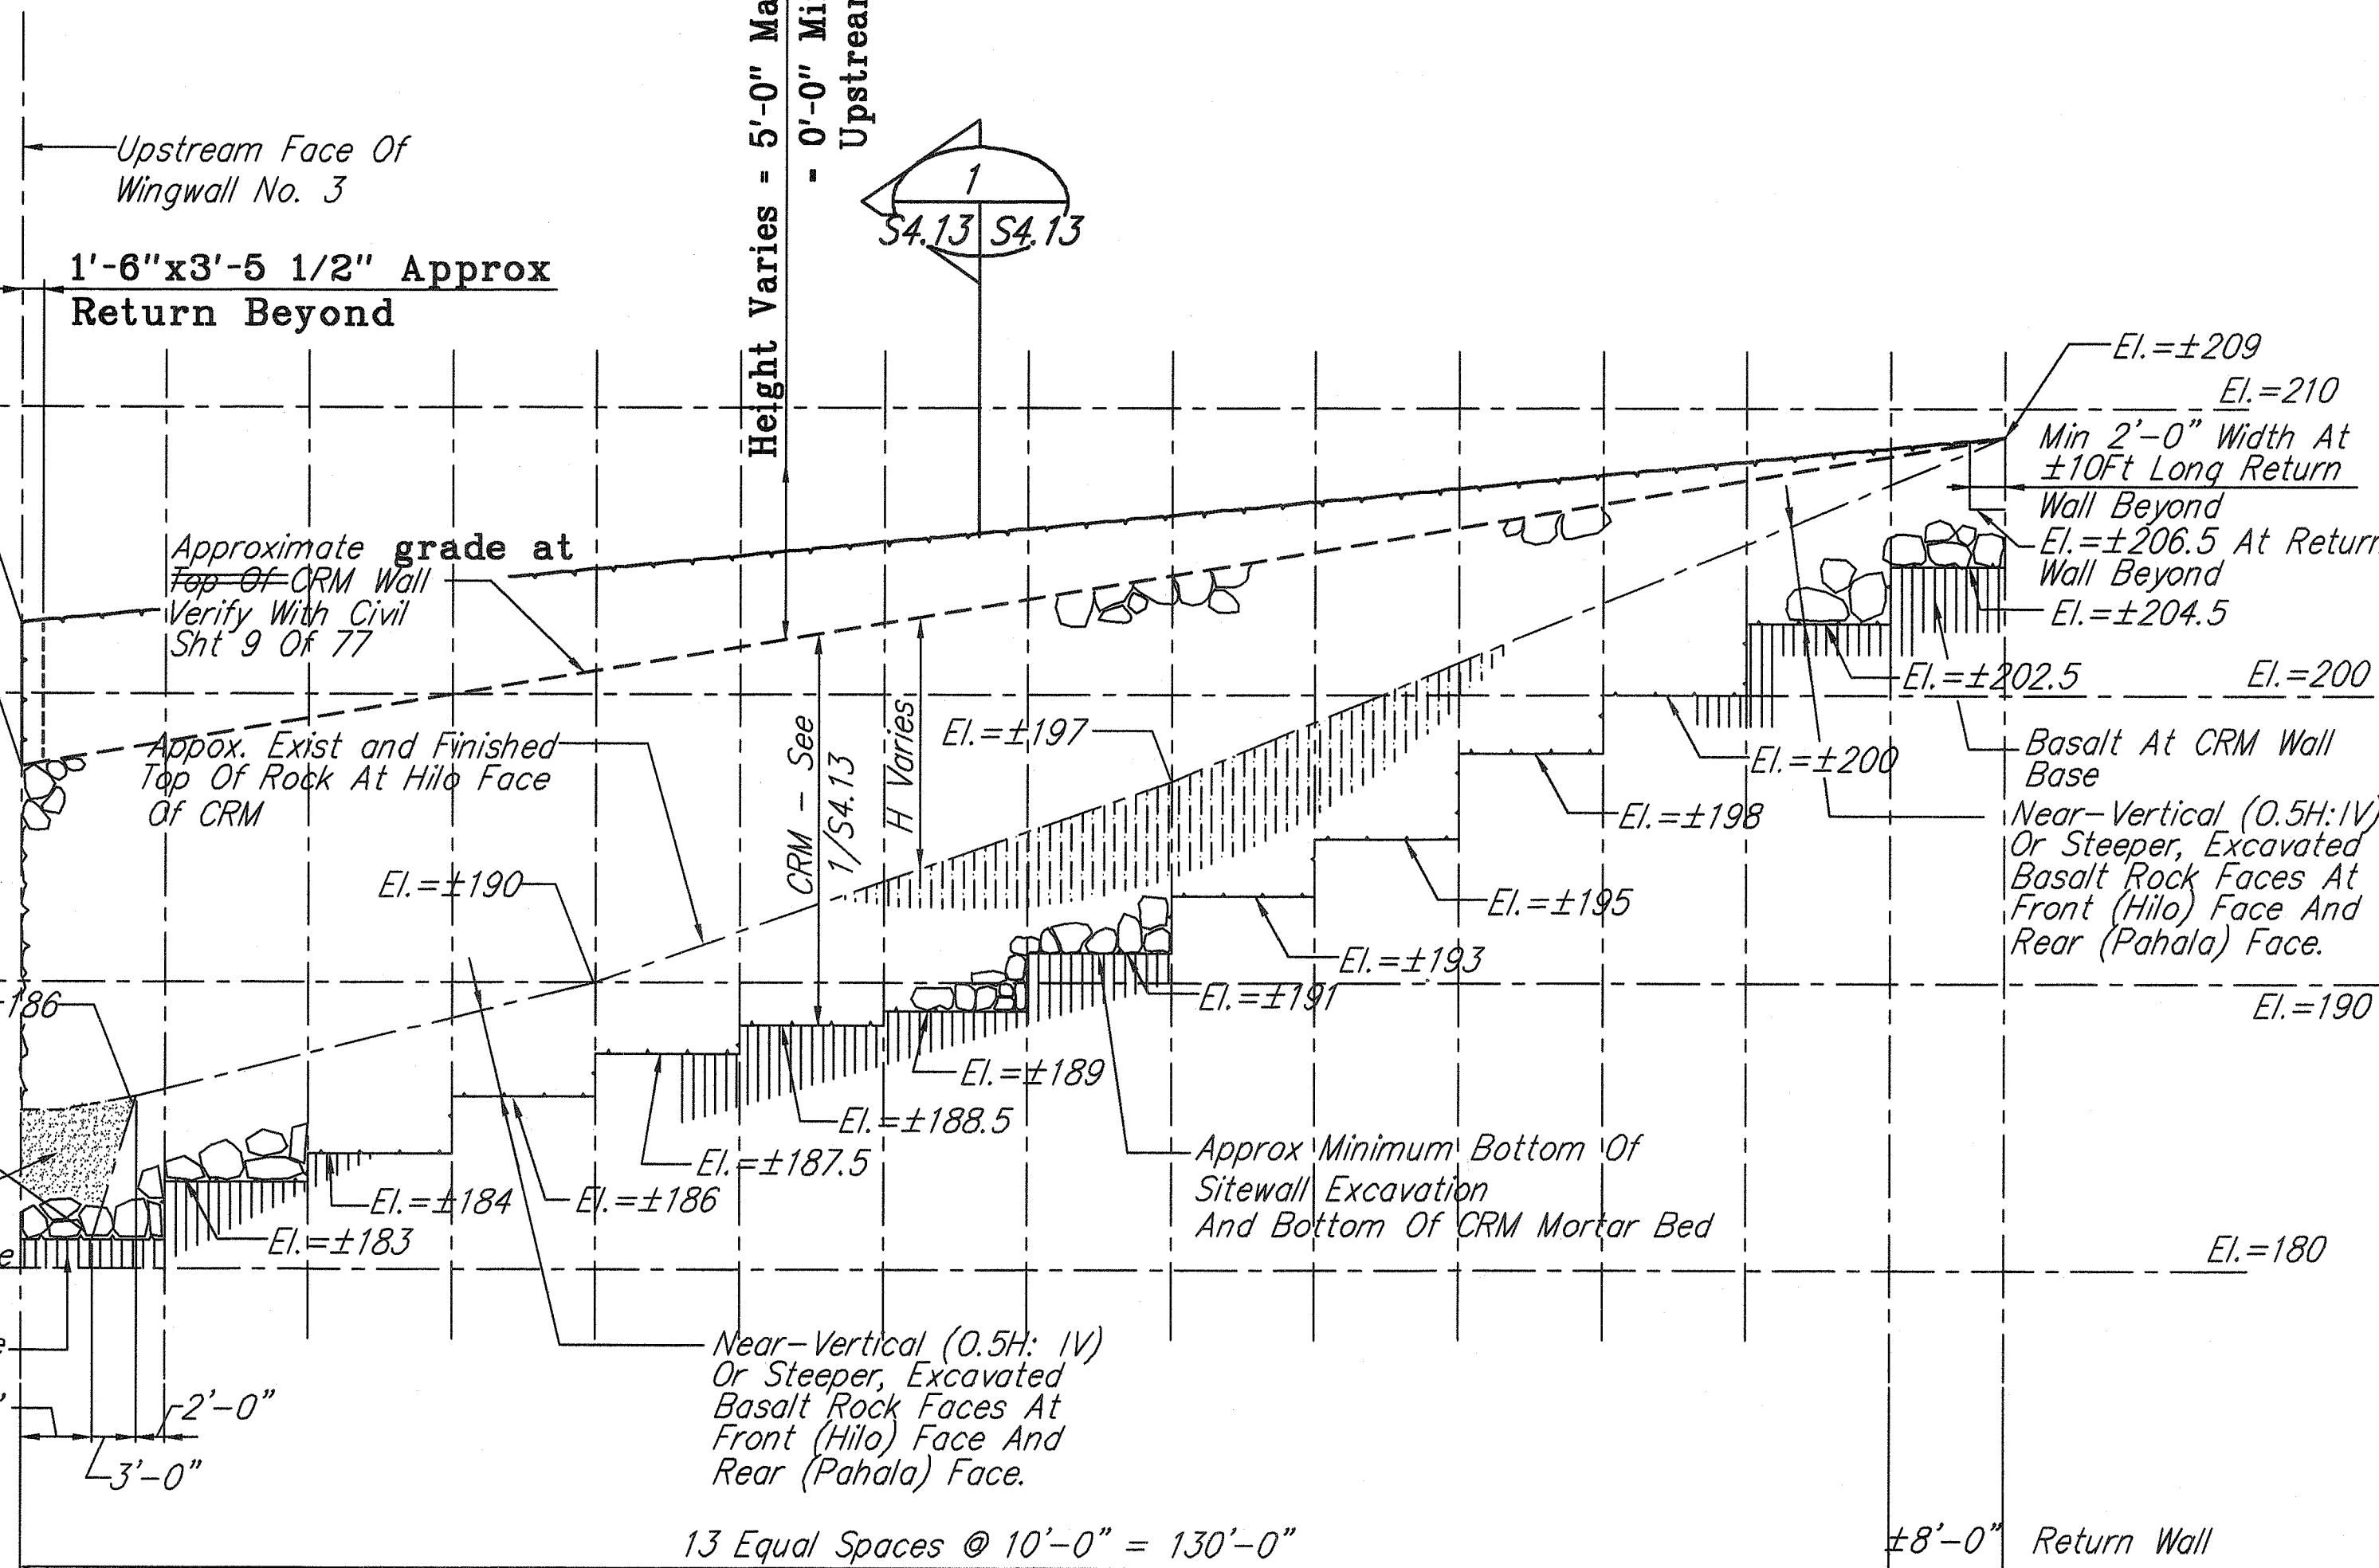

- Note:
- Sitewall Shall Be Embedded In Basalt.
 - Assumed Basalt (Top Of Rock) Configuration Is Based Upon The Owner's Topographic Survey Made Prior To Detour Road Construction.
 - Weeps Not Shown - See 1/S4.13
 - Construction Sequence - See Specifications, Special Provisions, Civil Sheet 9 To 77, Stage 9 Notes At S11.1 And Embankment BMP Sheet 77 Of 77.

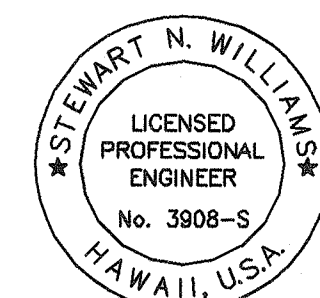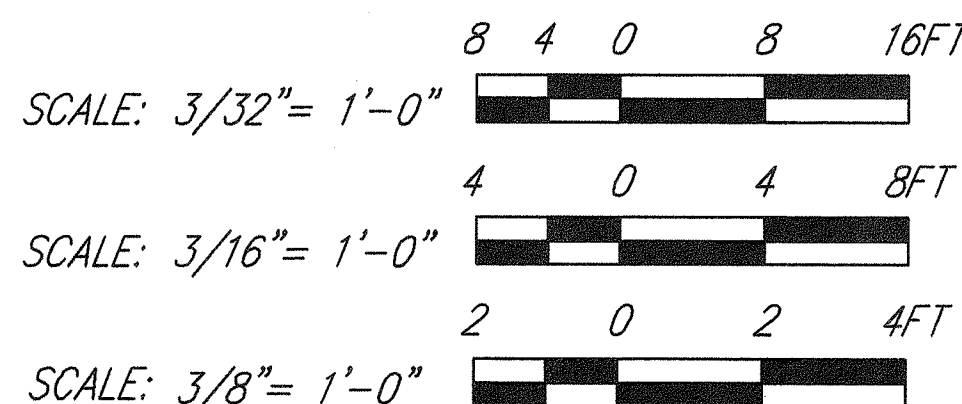

THIS WORK WAS PREPARED BY ME OR UNDER MY SUPERVISION.
Mitsunaga & Associates, Inc.

DATE	DESCRIPTION
01-30-01	Added reference Notes @ 1/S4.13
01-30-01	Revised Sheet Reference
01-30-01	Added Detail A/S4.13
01-30-01	Revised CRM Slope At 1/S4.13
01-30-01	Added Detail Mark A/S4.13 At Detail 1/S4.13
01-30-01	Clarified Note 1 At Detail 1/S4.13
01-30-01	Revised Maximum Step @ Note 4 At Detail 1/S4.13
01-30-01	Added Note Re: Borrow At 1/S4.13

STATE OF HAWAII
DEPARTMENT OF TRANSPORTATION
HIGHWAYS DIVISION


WINGWALL and SITEWALL DETAILS

MAMALAHOA HIGHWAY
REPLACEMENT OF
KEAIIWA STREAM BRIDGE
Federal Aid Project No. ER-12(1)R
Scale: As Noted Date: January 2001


SHEET No. S4.13 OF 50 SHEETS

AS-BUILT


FED. ROAD DIST. NO.	STATE	FED. AID PROJ. NO.	FISCAL YEAR	SHEET NO.	TOTAL SHEETS
HAWAII	HAW.	ER-12 (1)R	2001	35	77

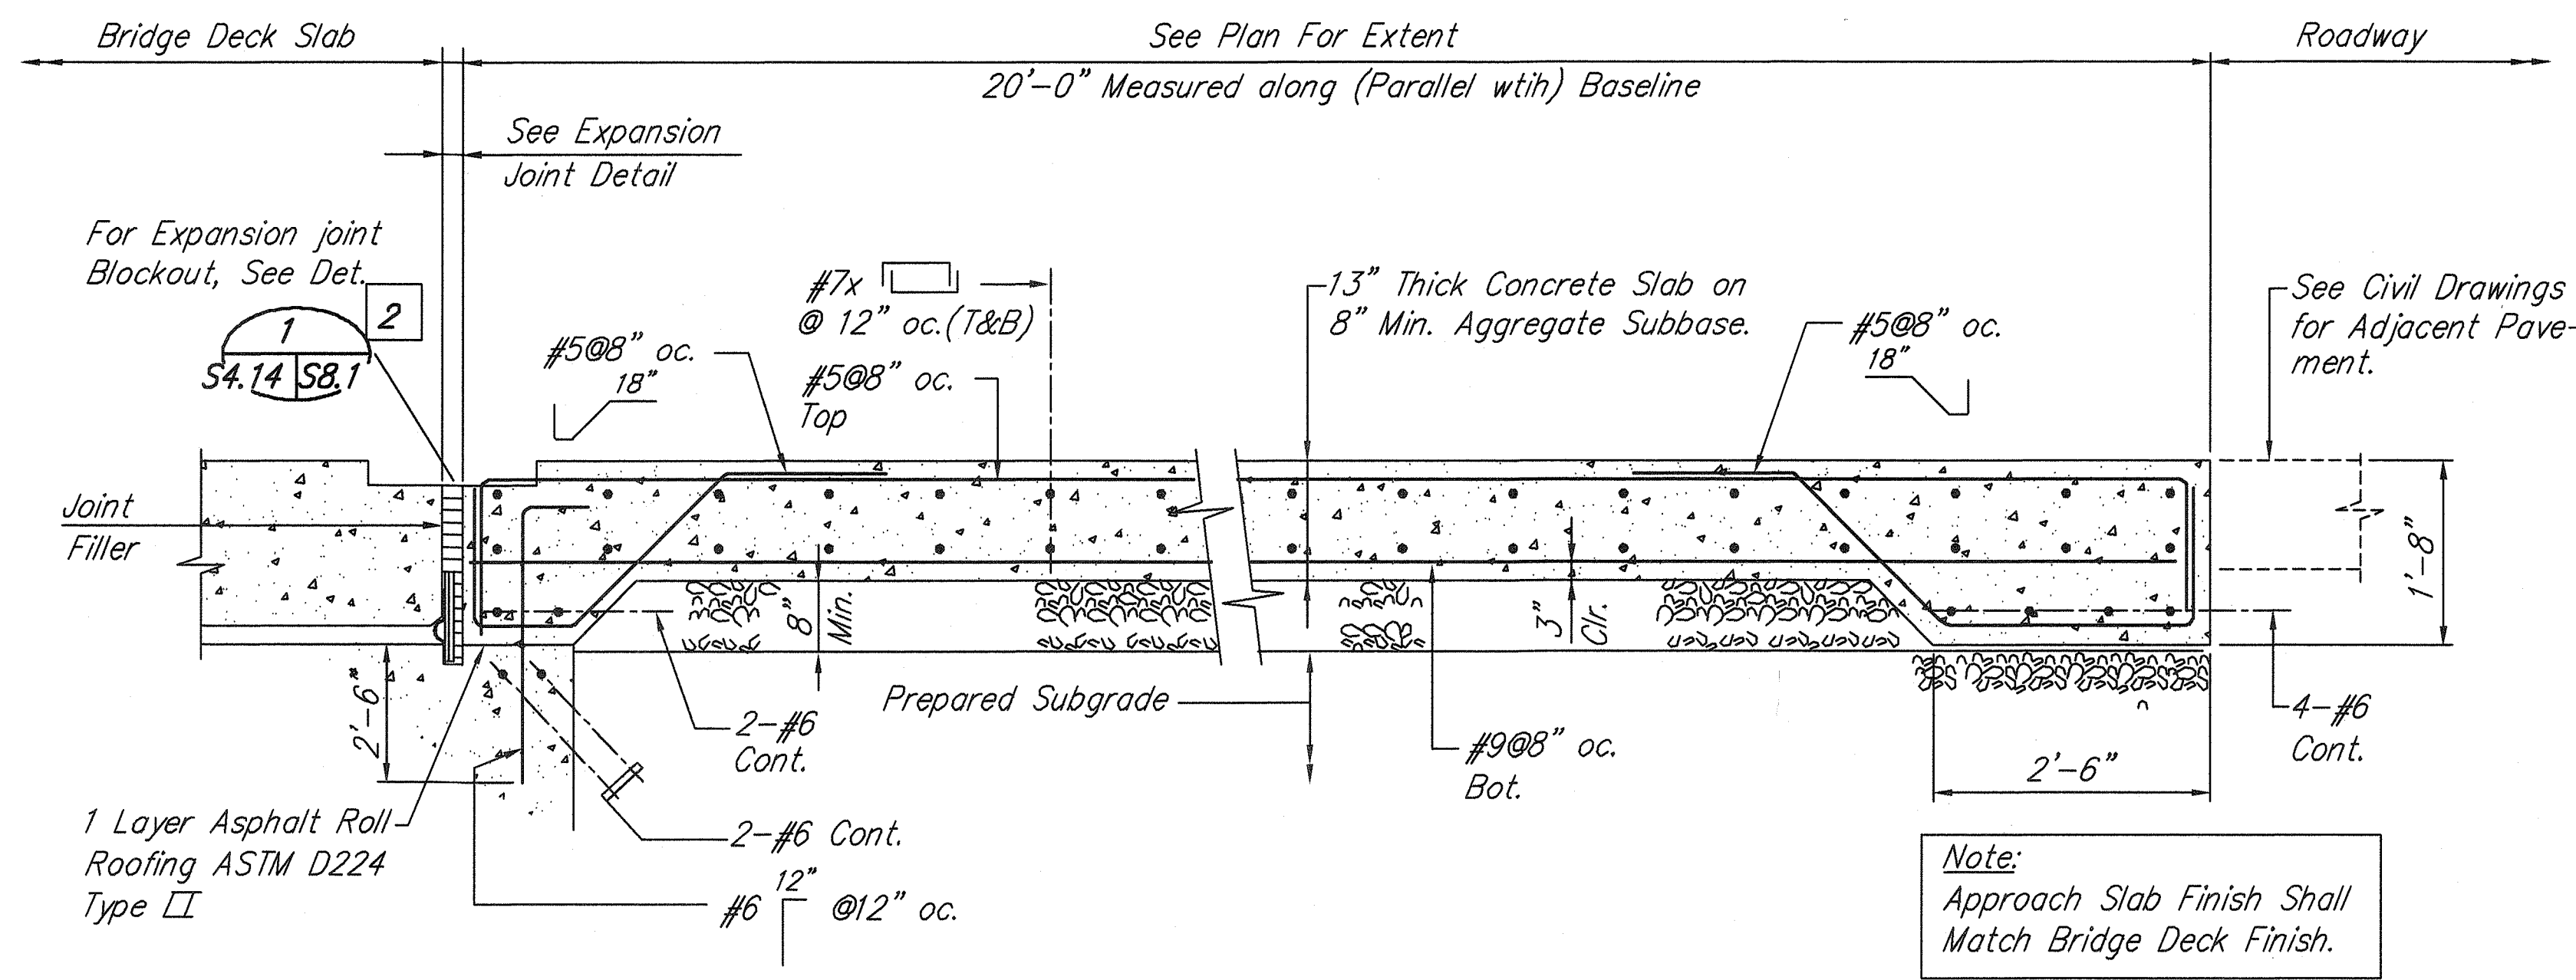

TYPICAL APPROACH SLAB DETAIL
 Sc: 3/4" = 1'-0" S4.14 S4.14

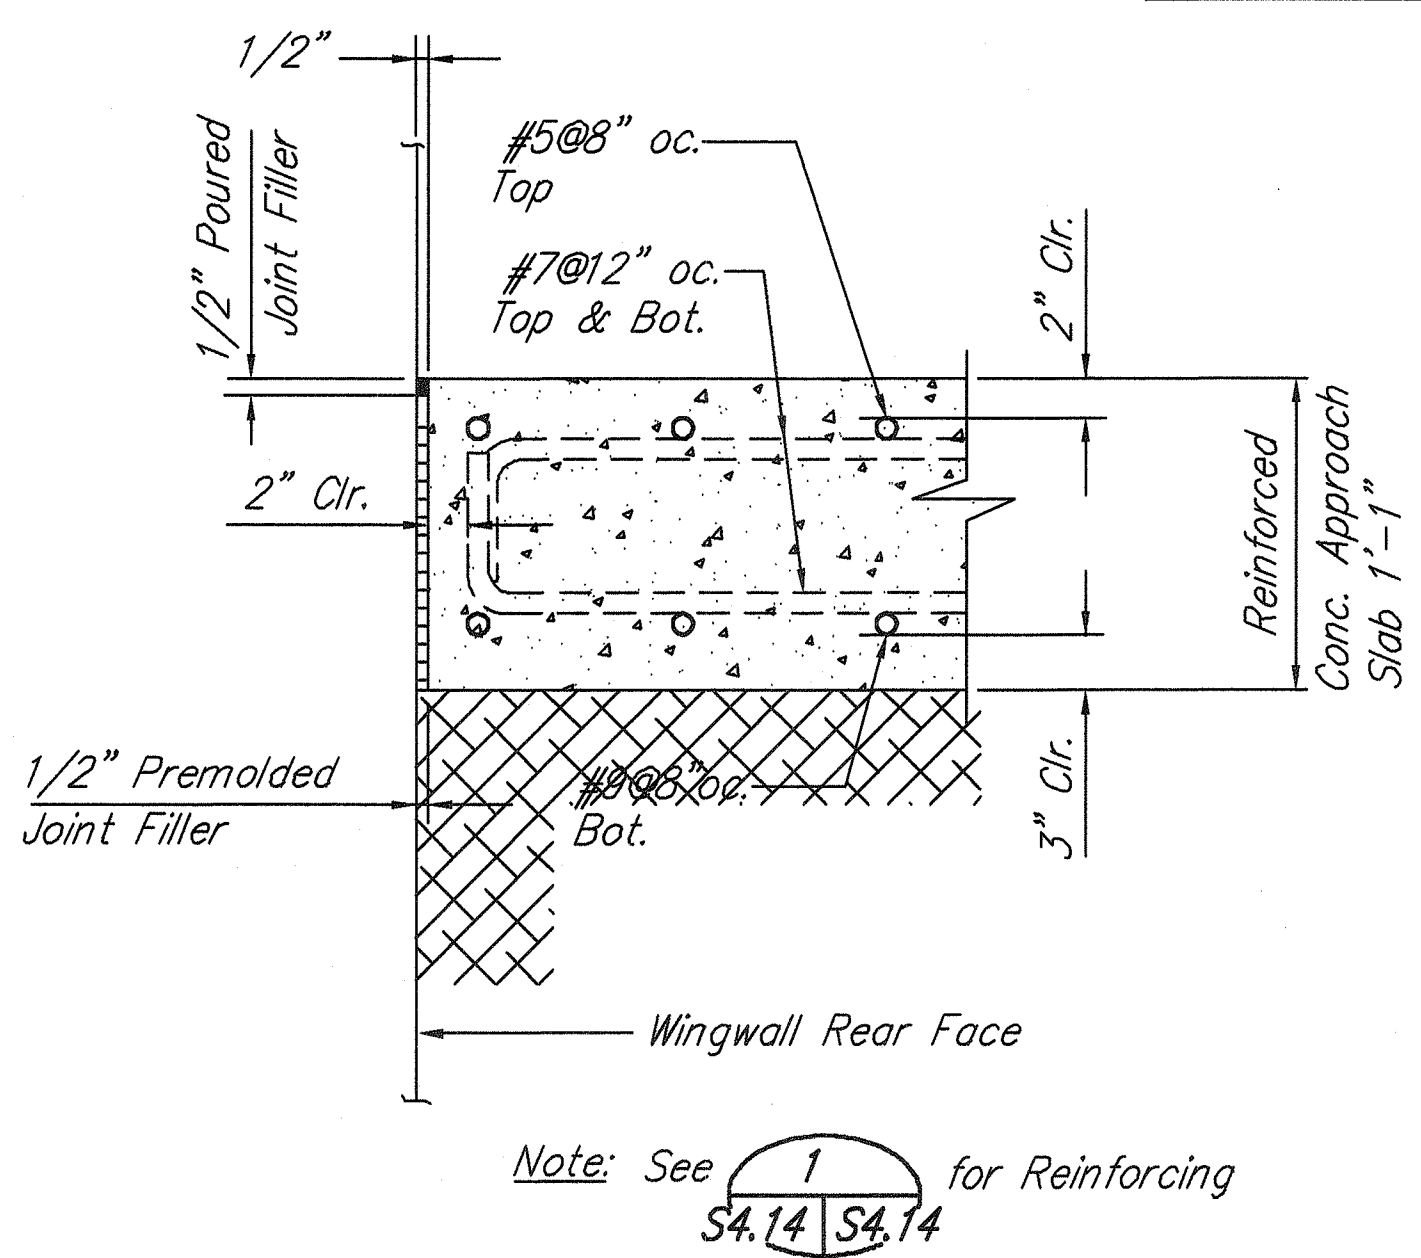


TYPICAL JOINT DETAIL
 AT CONCRETE RAIL
 Not to Scale S4.14 S4.14

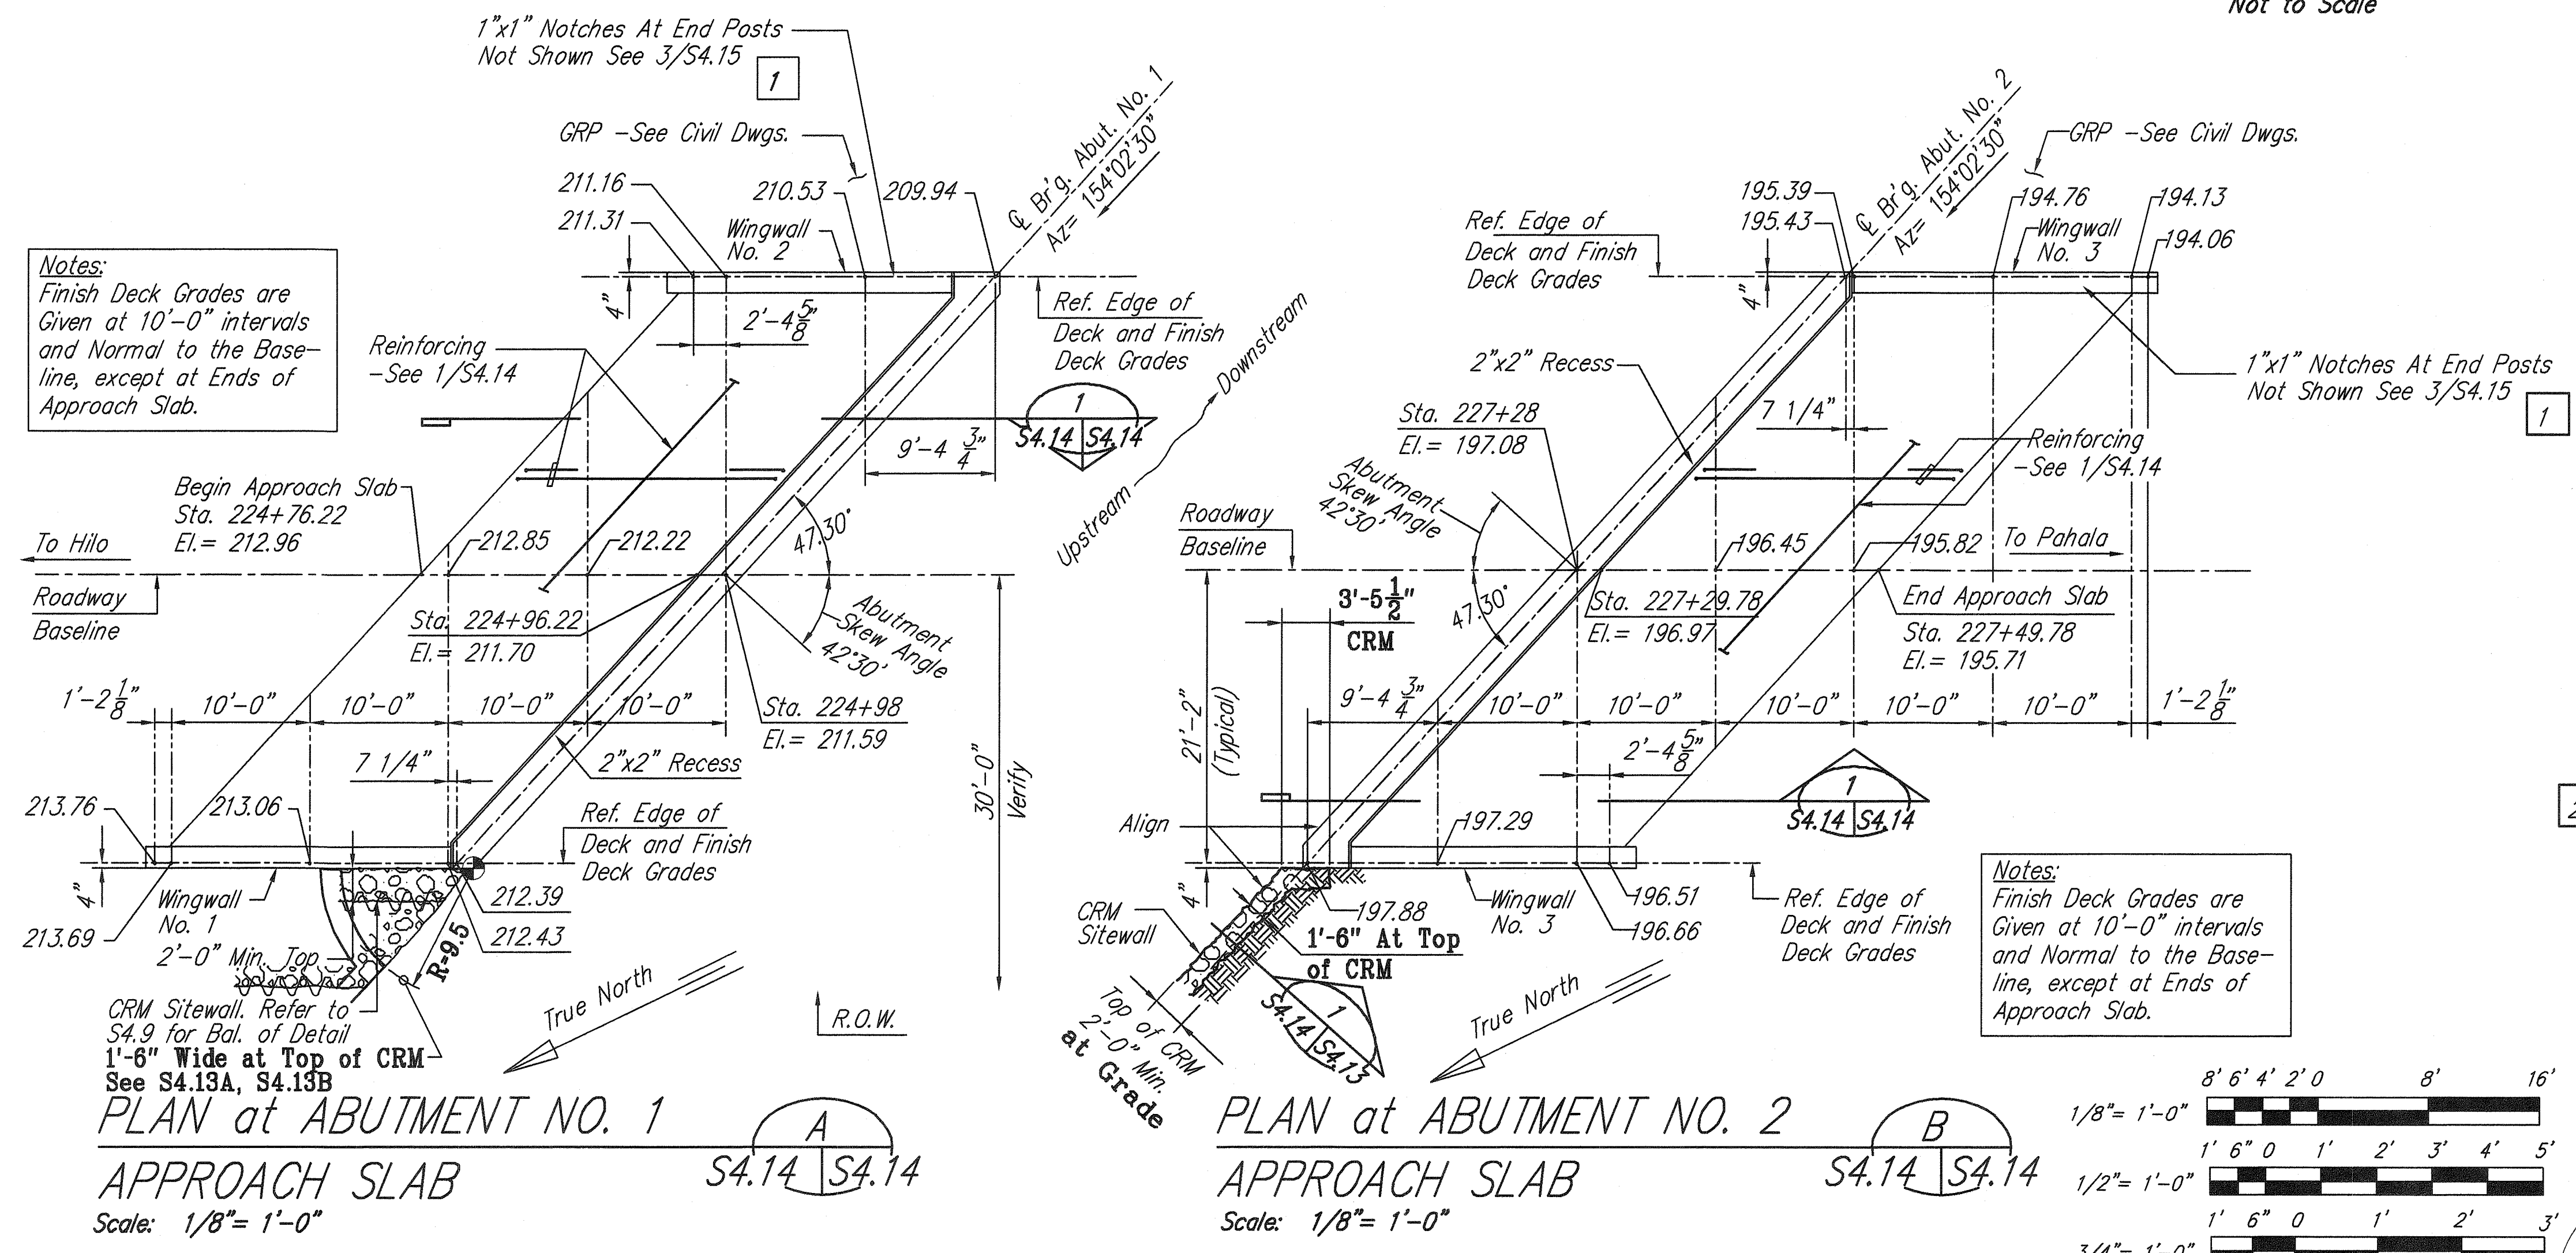

LEGEND FOR AS-BUILT POSTINGS


	Squiggly line for as-built deletion
	Double line for as-built deletion
	Text for as-built posting

DATE	_____
SURVEY PLOTTED BY	_____
DRAWN BY	_____
DESIGNED BY	_____
NOTED BY	_____
CHECKED BY	_____
ORIGINAL PLAN	_____
NOTE BOOK	_____
NO.	_____

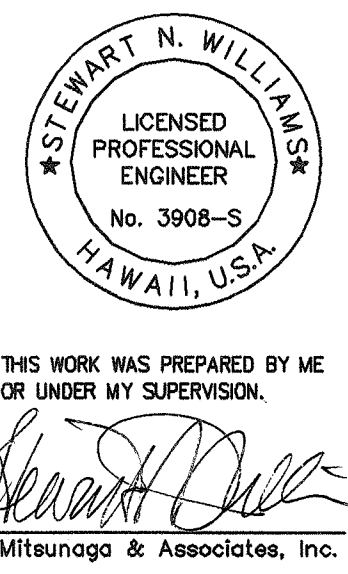


01-30-01	2	Clarified Expansion Joint Reference At 1/S4.14
01-30-01	1	Added 1"x1" Notch Reference
DATE	DESCRIPTION	
STATE OF HAWAII DEPARTMENT OF TRANSPORTATION HIGHWAYS DIVISION		
APPROACH SLAB DETAILS		
MAMALAHOA HIGHWAY REPLACEMENT OF KEAIIWA STREAM BRIDGE Federal Aid Project No. ER-12(1)R Scale: As Noted Date: January 2001		
SHEET No. S4.14 OF 50 SHEETS		


FED. ROAD DIST. NO.	STATE	FED. AID PROJ. NO.	FISCAL YEAR	SHEET NO.	TOTAL SHEETS
HAWAII	HAW.	ER-12 (1)R	2001	36	77

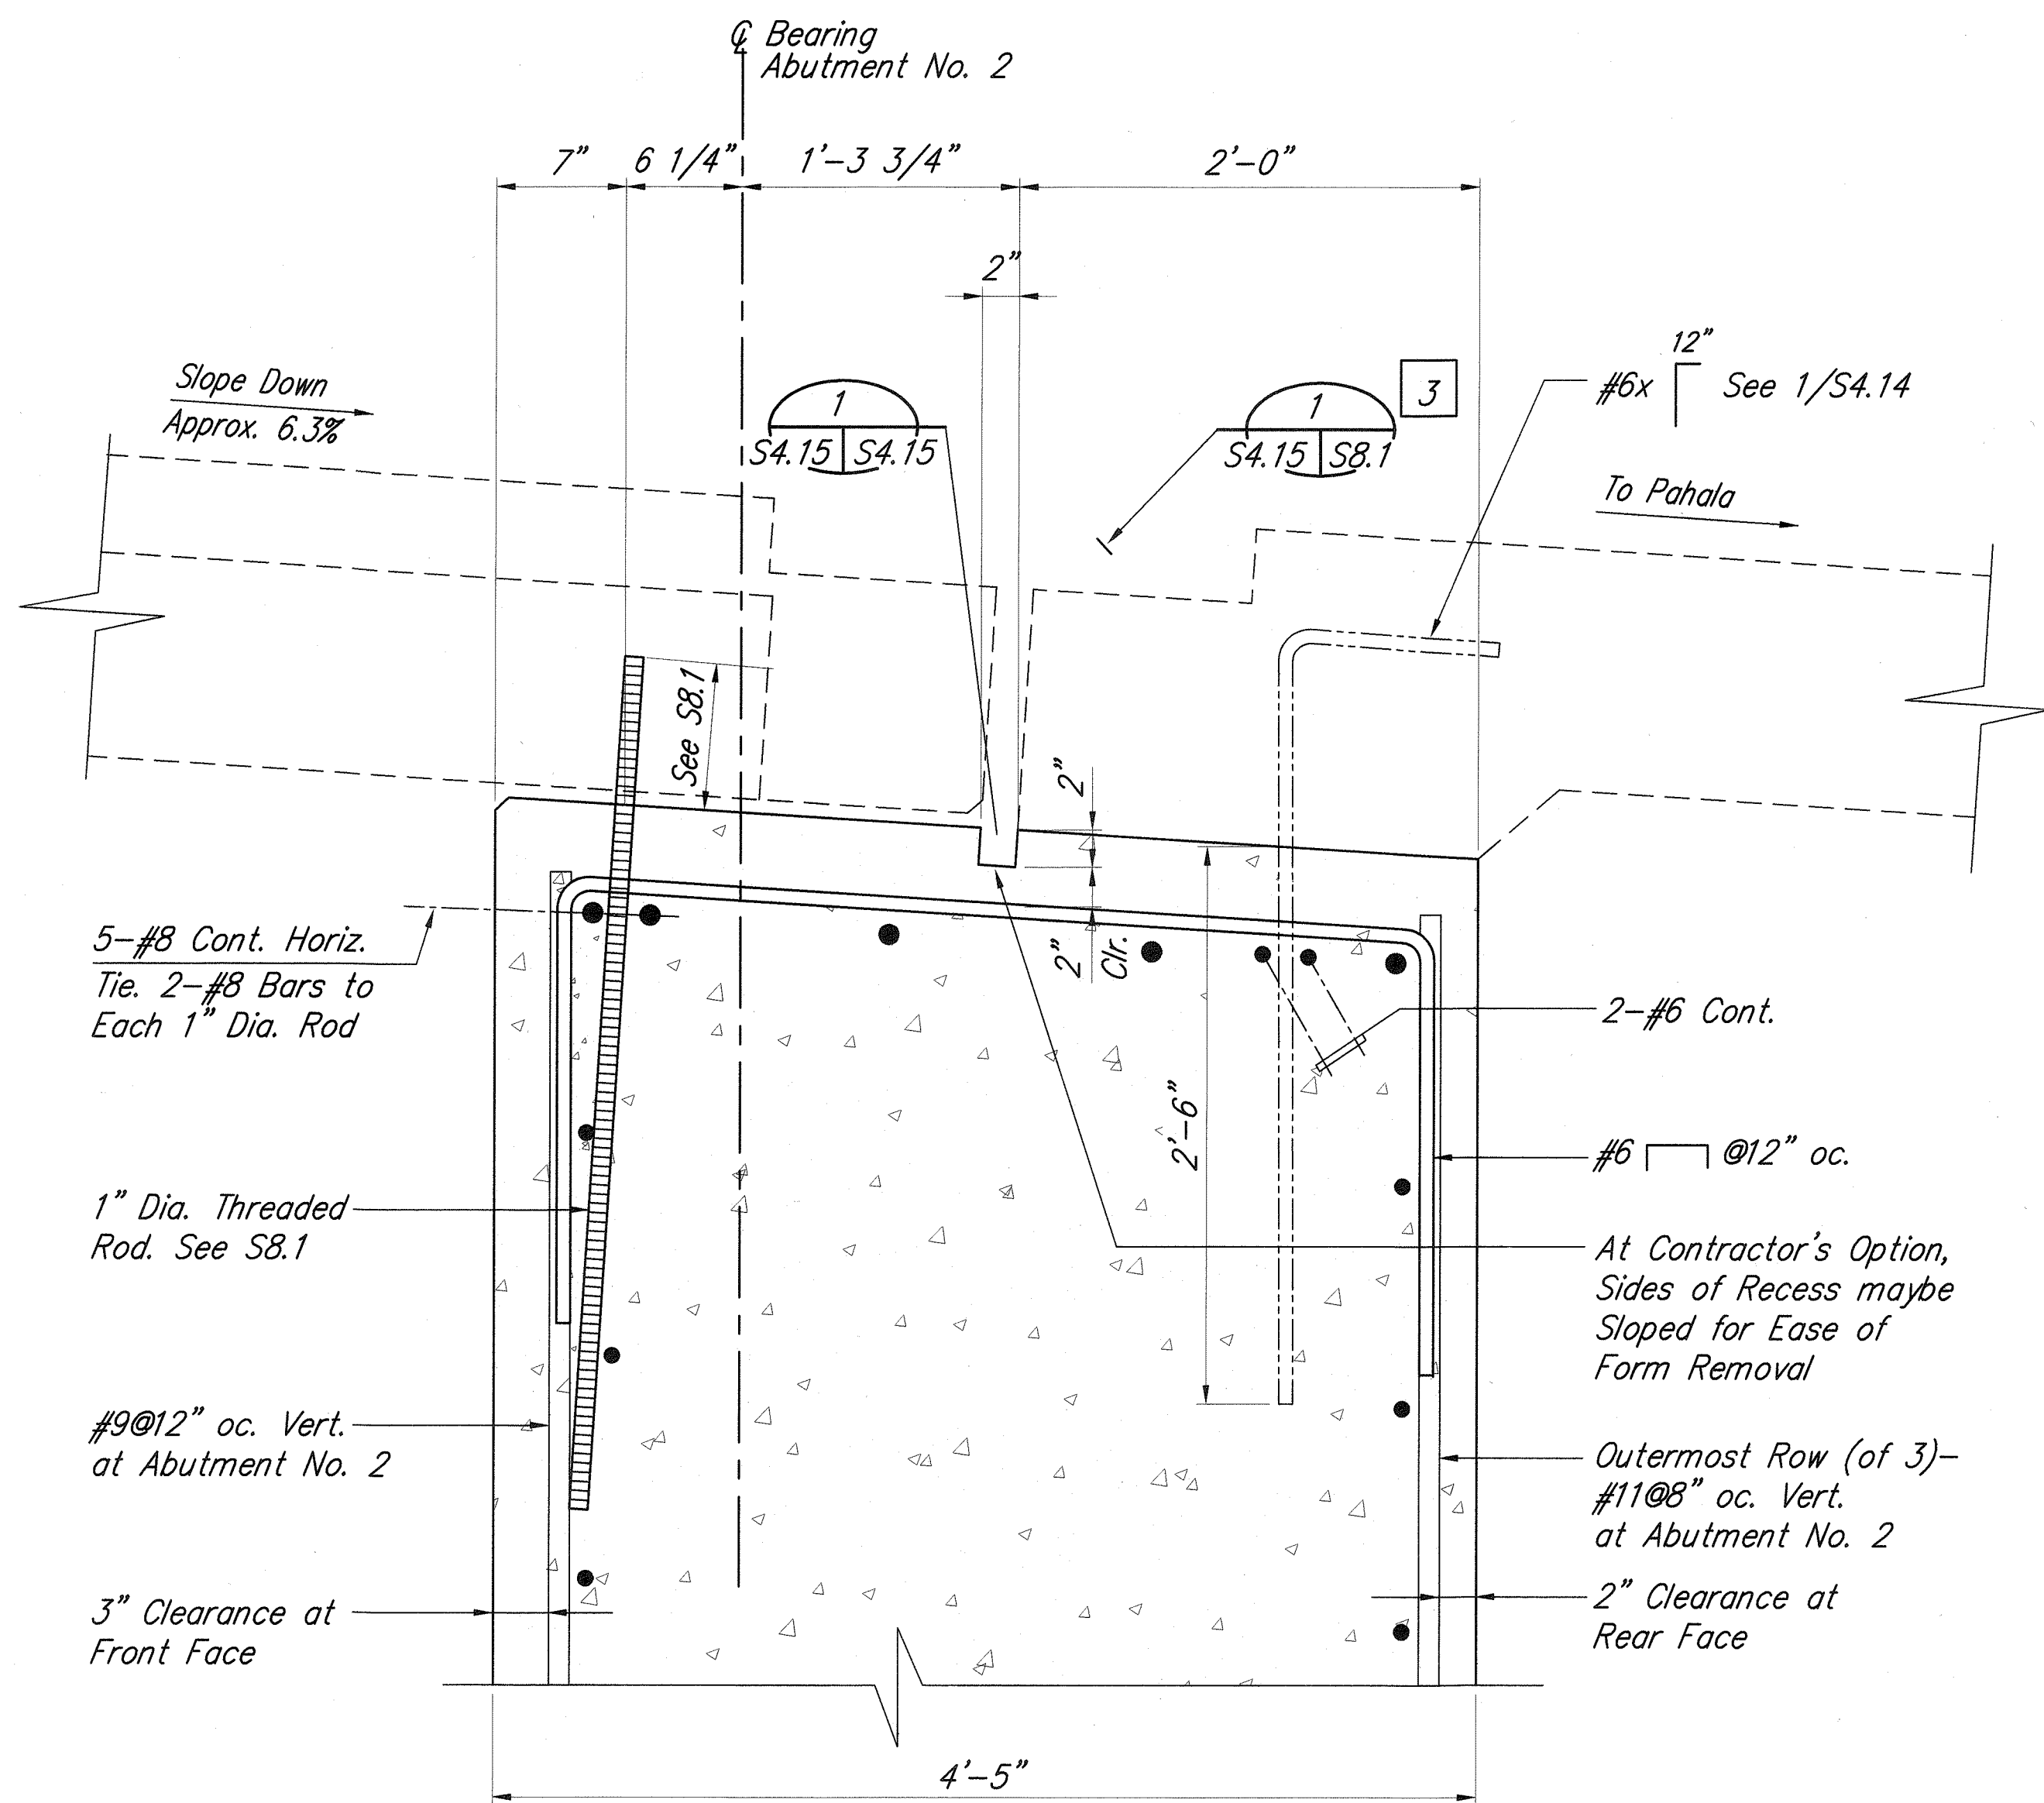

ABUTMENT NO. 2 SECTION
AT 2"x2" CONT. RECESS Sc: 1 1/2"=1'-0" S4.15 S4.15 S4.14

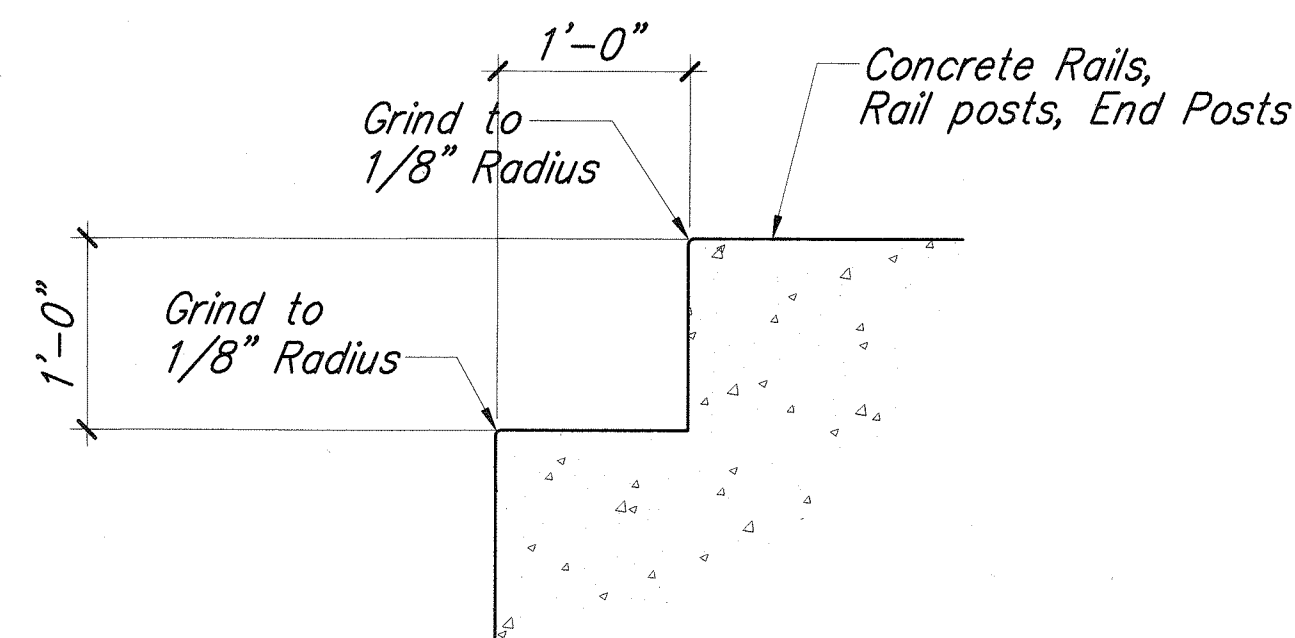



1"x1" NOTCH DETAIL
Full Size S4.15 S4.15

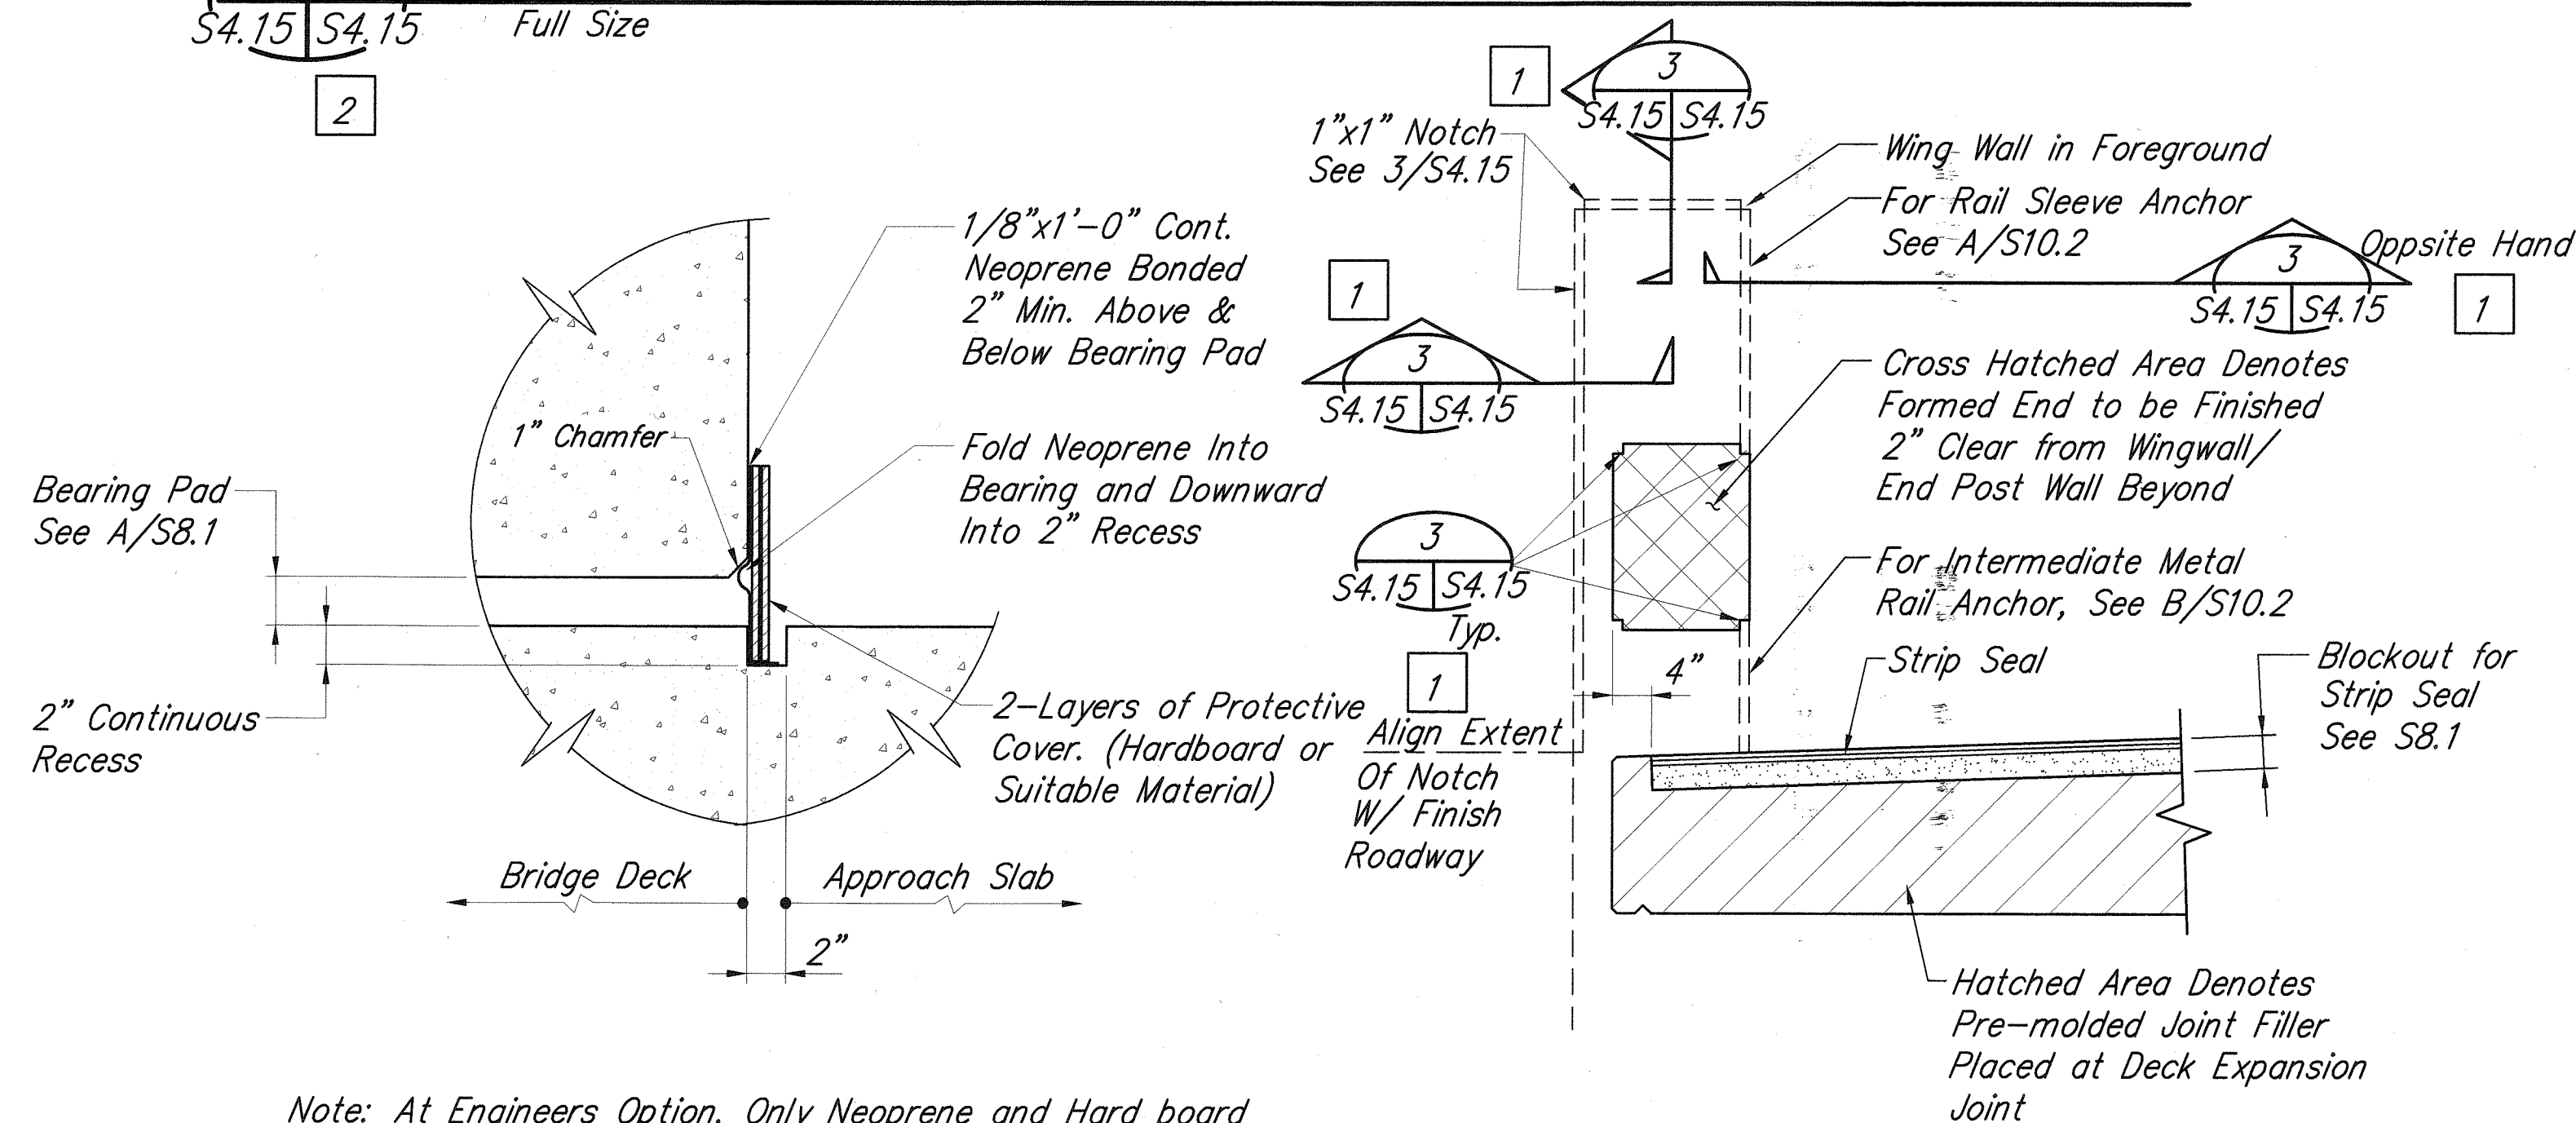

TYP. WATERPROOFING STRIP DETAIL Sc: 1 1/2"=1'-0" S4.15 S4.15

TYP. EXPANSION JOINT DETAIL AT RAILS Sc: 3/4"=1'-0" S4.15 S4.15

DATE	_____
SURVEY PLOTTED BY	_____
DRAWN BY	_____
DESIGNED BY	_____
QUANTITIES BY	_____
CHECKED BY	_____
ORIGINAL PLAN	_____
NOTE BOOK	_____
No.	_____


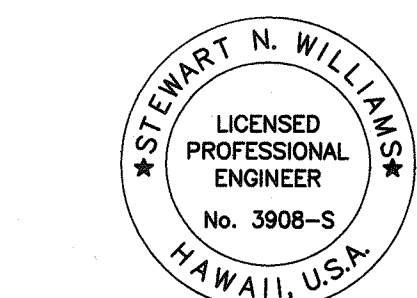
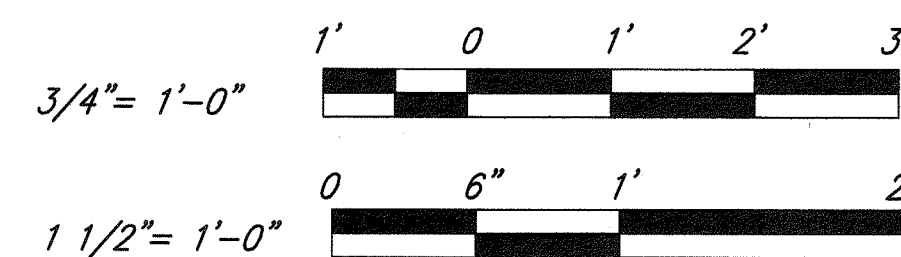


THIS WORK WAS PREPARED BY ME
OR UNDER MY SUPERVISION
Stewart N. Williams
Mitsunaga & Associates, Inc.

01-30-01	3	Coordinated Reference Detail At Detail A/S4.15
01-30-01	2	Added 1"x1" Notch Detail 3/S4.15
01-30-01	1	Added 1"x1" Notch At Rail End Post At Detail 2/S4.15

DATE	DESCRIPTION
STATE OF HAWAII DEPARTMENT OF TRANSPORTATION HIGHWAYS DIVISION	
DECK JOINT DETAILS	
MAMALAHOA HIGHWAY REPLACEMENT OF KEAIIWA STREAM BRIDGE Federal Aid Project No. ER-12(1)R	
Scale: As Noted	Date: January 2001
SHEET No. S4.15 OF 50 SHEETS	

FED. ROAD DIST. NO.	STATE	FED. AID PROJ. NO.	FISCAL YEAR	SHEET NO.	TOTAL SHEETS
HAWAII	HAW.	ER-12 (1)R	2001	37	77

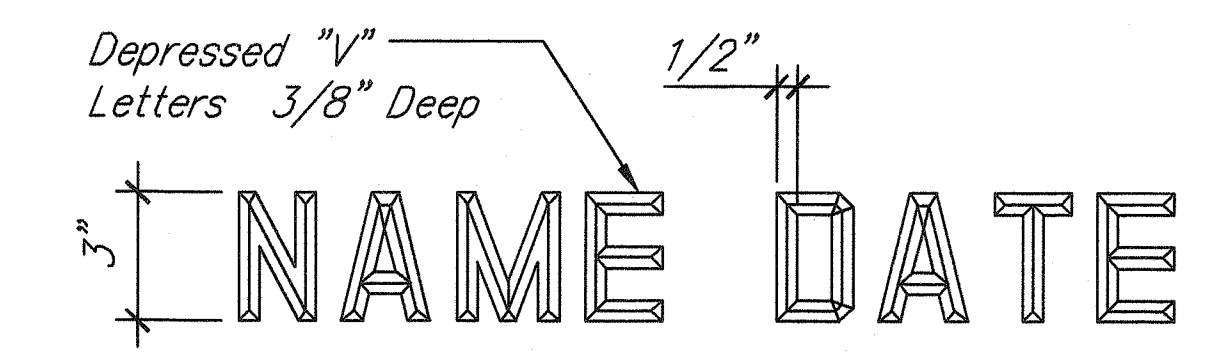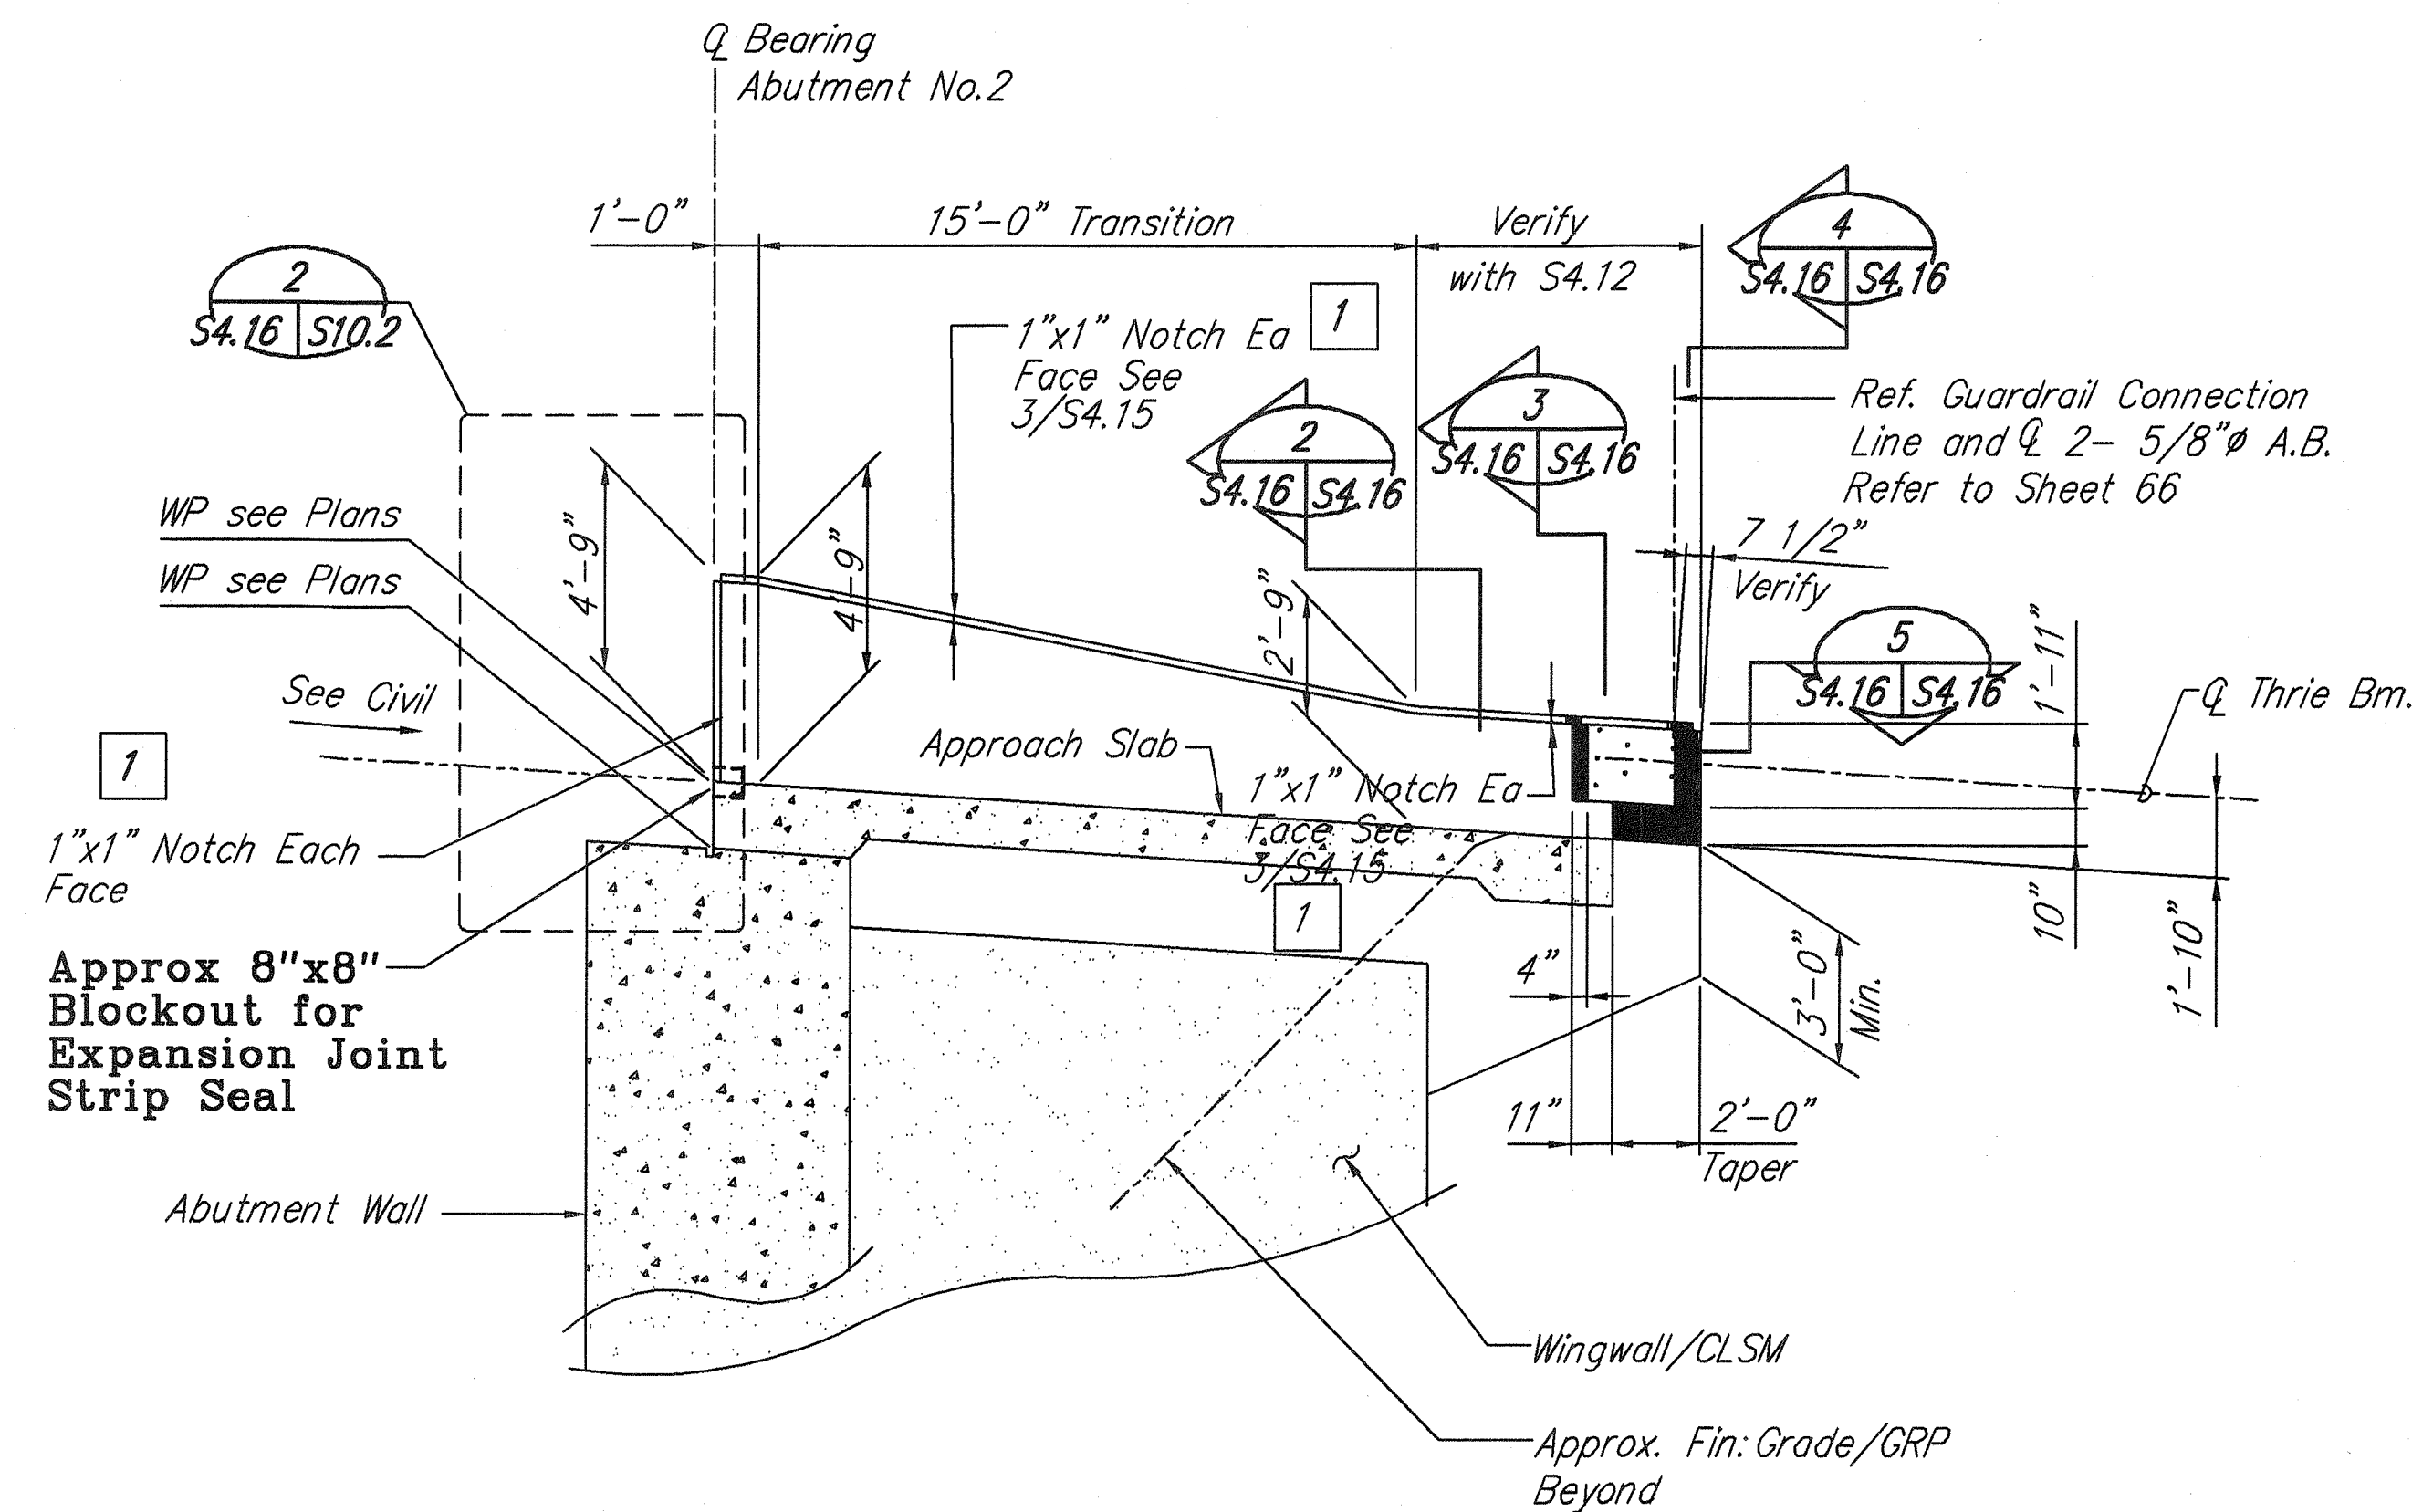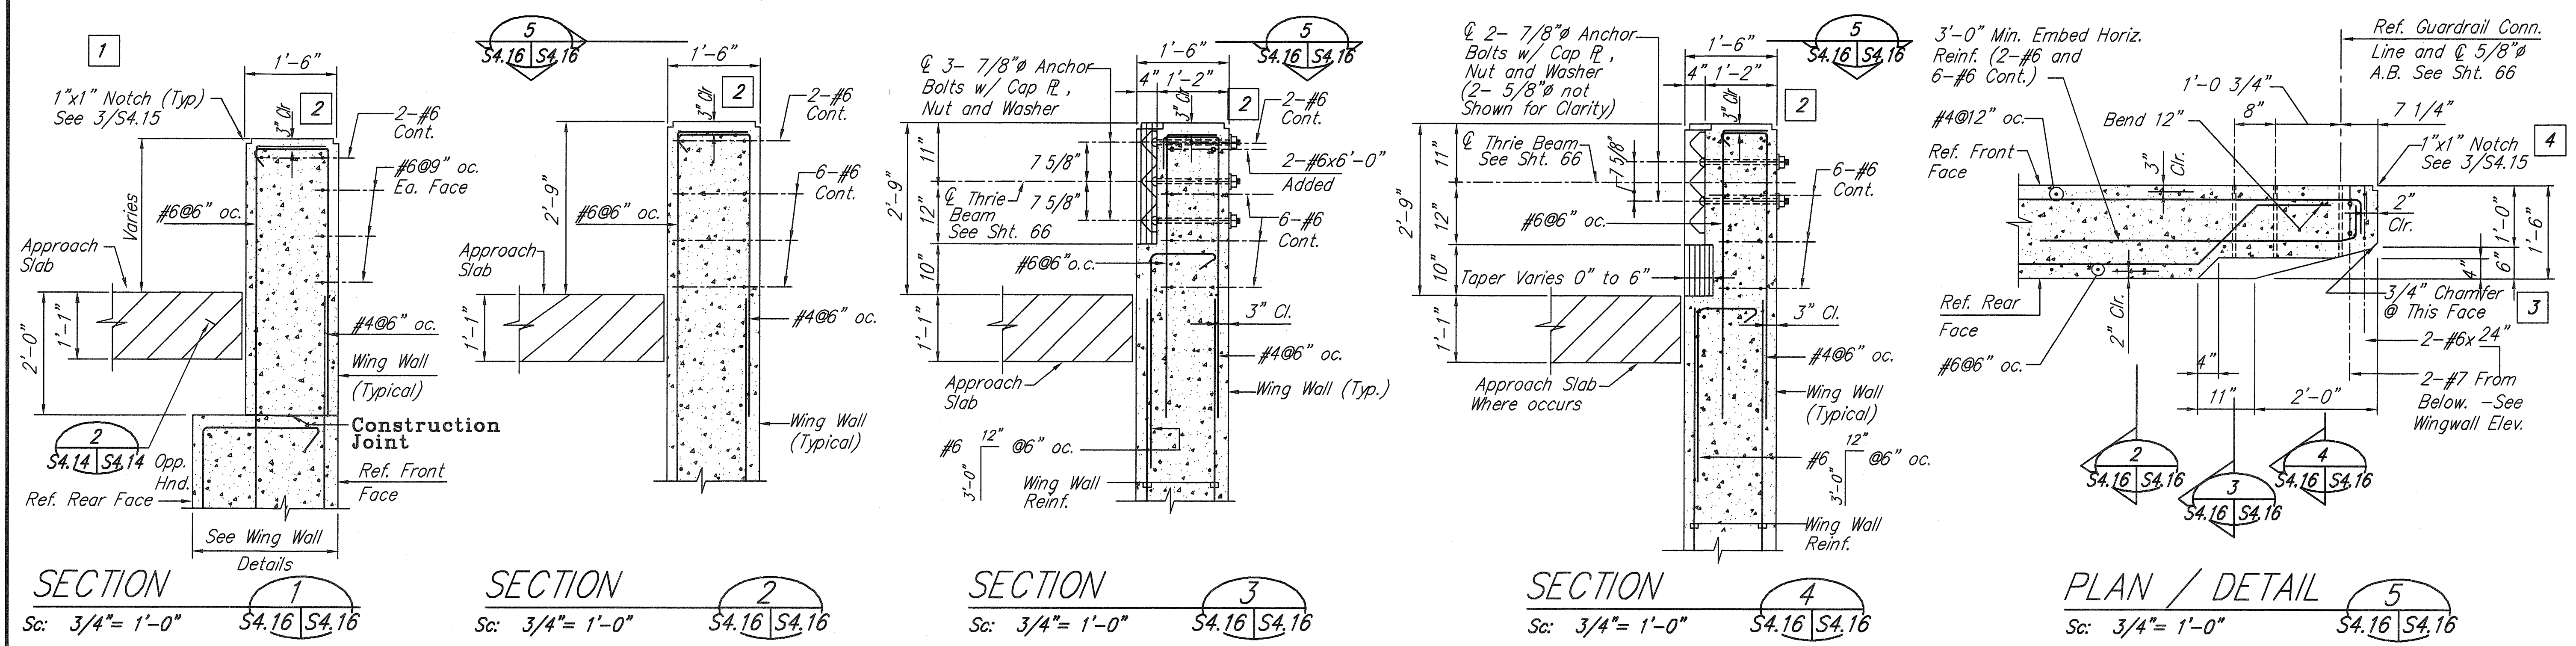



- BRIDGE IDENTIFICATION DETAIL**
Not to Scale
- NOTES:**
- Unless otherwise Directed by The Engineer, The Bridge Name and Date built shall be placed at the "Trailing" End Post on each side of the roadway.
 - Exact details and spacing of letter and figures and location shall be as directed by the Engineer. Gothic letters and figures approximating dimensions shown will be acceptable if approved by the Engineer.

LEGEND FOR AS-BUILT POSTINGS	
	Squiggly line for as-built deletion
	Double line for as-built deletion
	Text for as-built posting

DATE	DESCRIPTION
01-30-01	Added 1'x1" Notch Note At 5/S4.16
01-30-01	Added 3/4" Chamfer Note At Thrie Beam Face At 5/S4.16
01-30-01	Increased Reinforcing Cover At 1'x1" Notched Faces
01-30-01	Added 1'x1" Notch At End Post Detail A/S4.16

STATE OF HAWAII DEPARTMENT OF TRANSPORTATION HIGHWAYS DIVISION	
END POST DETAILS	
MAMALAHOA HIGHWAY REPLACEMENT OF KEAWA STREAM BRIDGE Federal Aid Project No. ER-12(1)R Scale: As Noted Date: January 2001	
SHEET No. S4.16 OF 50 SHEETS	

DATE	_____
SURVEY PLOTTED BY	_____
DRAWN BY	_____
DESIGNED BY	_____
NOTED BY	_____
CHECKED BY	_____
ORIGINAL PLAN	_____
NOTE BOOK	_____
No.	_____

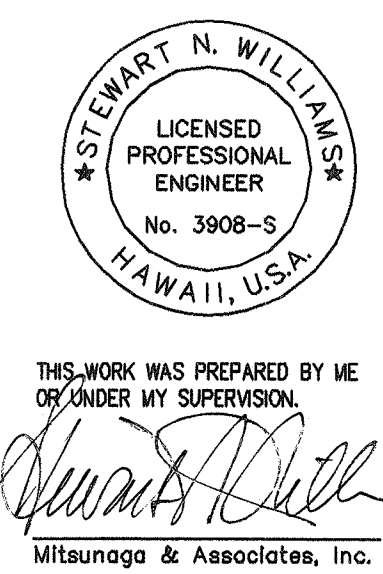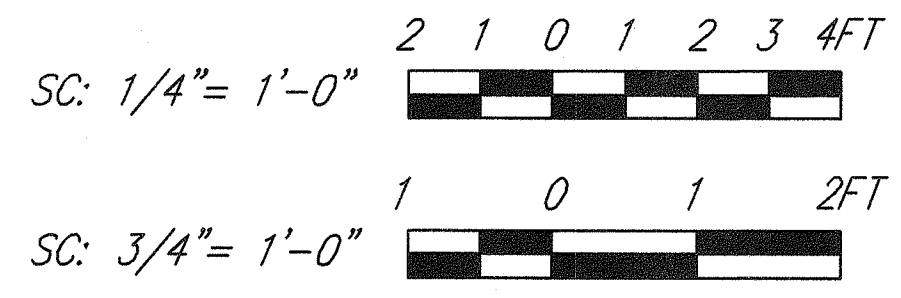

FED. ROAD DIST. NO.	STATE	FED. AID PROJ. NO.	FISCAL YEAR	SHEET NO.	TOTAL SHEETS
HAWAII	HAW.	ER-12(1)R	2001	38	77

Notes:

- All Dimensions (*) Typical to All Piers Unless Otherwise Noted.
- Notes Designated by (**) Show Spacing for Corbel Reinforcing and Rebar Orientation, and Applies to all Piers. For Sections and Details Showing Reinforcing, See S6.* Series.
- For Structural Excavation and Backfill Pay Limits at Piers, See Sheet S5.7.

DOWNSTREAM

UPSTREAM

PLAN - STA 225+28 PIER 1

Scale: 1/4" = 1'-0"

210

200

190

180

170

Existing Grade

EL. 192.0

EL. 194.0

EL. 196.0

For pier nosing detail and reinf. See Sht. S2.1A

EQUAL

EQUAL

EQUAL

SECTION - STA. 225+28 PIER 1

Scale: 1/4" = 1'-0"

A
S5.1 S5.1

GRAPHIC SCALE:

4' 2' 0' 4' 8'

SCALE: 1/4" = 1'-0"

LEGEND FOR AS-BUILT POSTINGS

- Squiggly line for as-built deletion
- Double line for as-built deletion
- Roadway Text for as-built posting

02-15-07	As Built - Revised Detail
DATE	REVISION

STATE OF HAWAII
DEPARTMENT OF TRANSPORTATION
HIGHWAYS DIVISION

PLAN AND SECTION - PIER 1


MAMALAHOA HIGHWAY
REPLACEMENT OF
KEAIIA STREAM BRIDGE
Federal-Aid Project No. ER-12(1)R

Scale: As Shown Date: January 2001


SHEET No. S5.1 OF 50 SHEETS

AS-BUILT

FED. ROAD DIST. NO.	STATE	FED. AID PROJ. NO.	FISCAL YEAR	SHEET NO.	TOTAL SHEETS
HAWAII	HAW.	ER-12(1)R	2001	40	77


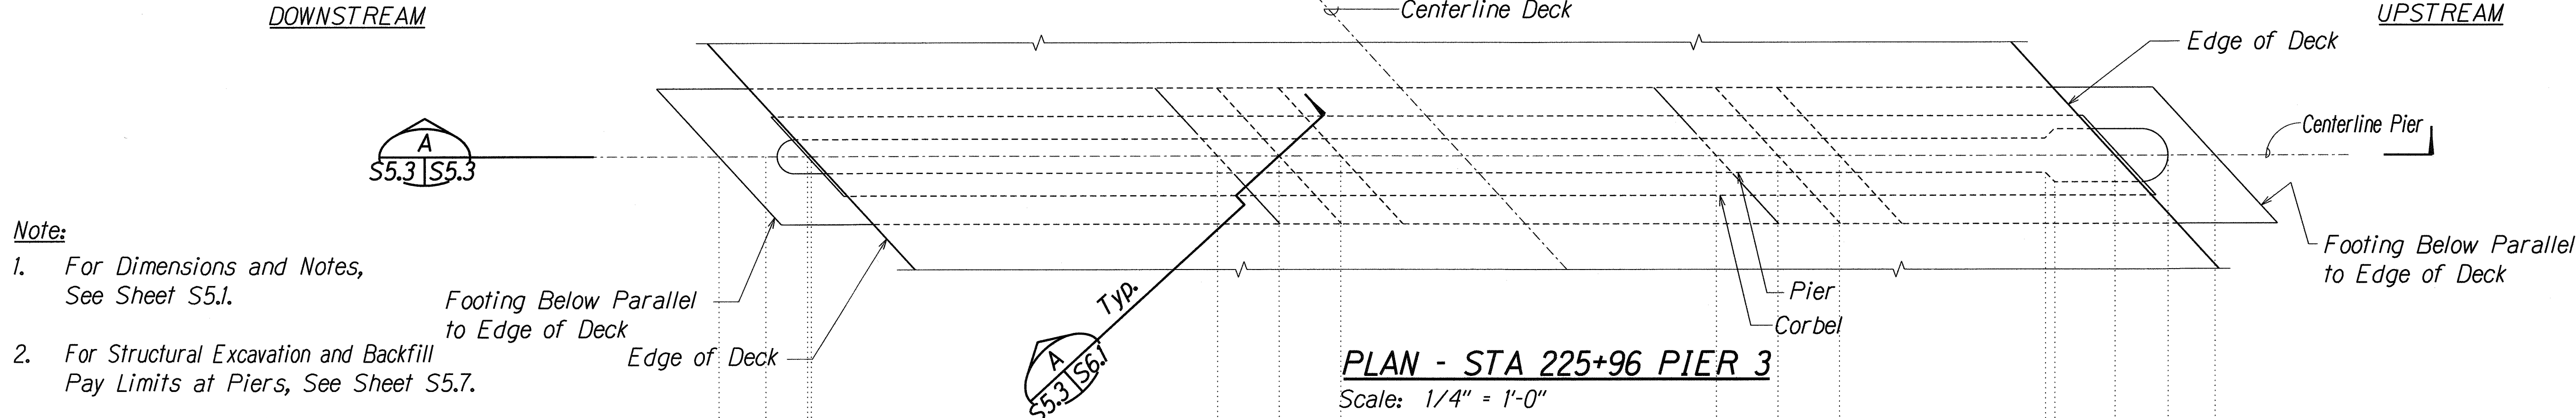


- Note:**
1. For Dimensions and Notes, See Sheet S5.1.
 2. For Structural Excavation and Backfill Pay Limits at Piers, See Sheet S5.7.

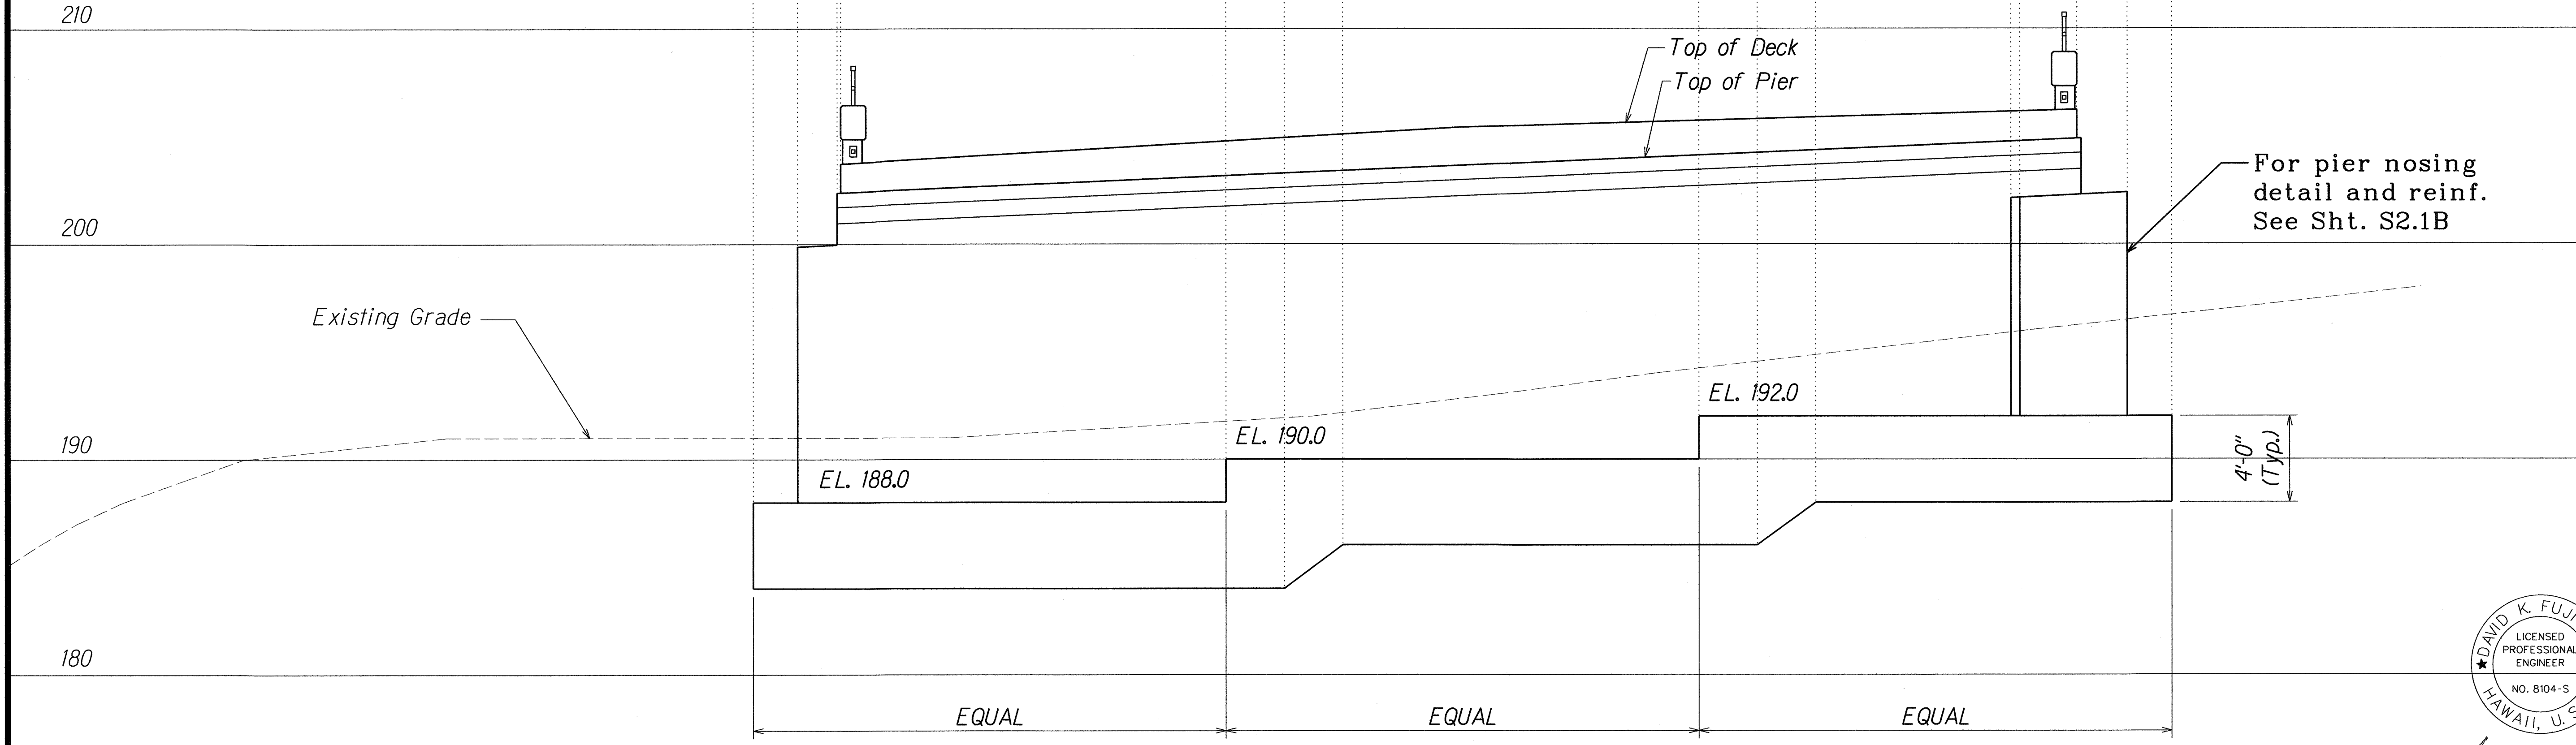

ORIGINAL PLAN	SURVEY PLOTTED BY	DATE
NOTE BOOK	DRAWN BY	10/1/2000
	DESIGNED BY	
	QUANTITIES BY	
	CHECKED BY	

LEGEND FOR AS-BUILT POSTINGS	
	Squiggly line for as-built deletion
	Double line for as-built deletion
Roadway	Text for as-built posting

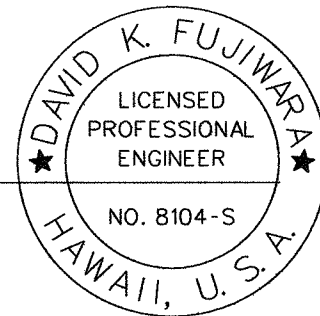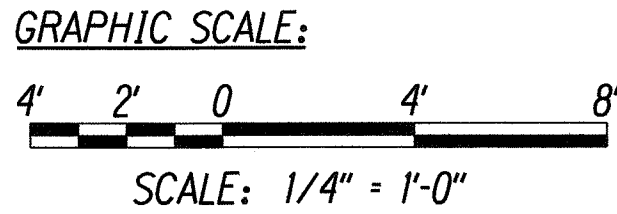

THIS WORK WAS PREPARED BY ME OR UNDER MY SUPERVISION.


STATE OF HAWAII
DEPARTMENT OF TRANSPORTATION
HIGHWAYS DIVISION

PLAN AND SECTION - PIER 3

MAMALAHOA HIGHWAY
REPLACEMENT OF
KEATWA STREAM BRIDGE
Federal-Aid Project No. ER-12(1)R
Scale: As Shown Date: January 2001
SHEET No. S5.3 OF 50 SHEETS

AS-BUILT

FED. ROAD DIST. NO.	STATE	FED. AID PROJ. NO.	FISCAL YEAR	SHEET NO.	TOTAL SHEETS
HAWAII	HAW.	ER-12(1)R	2001	41	77

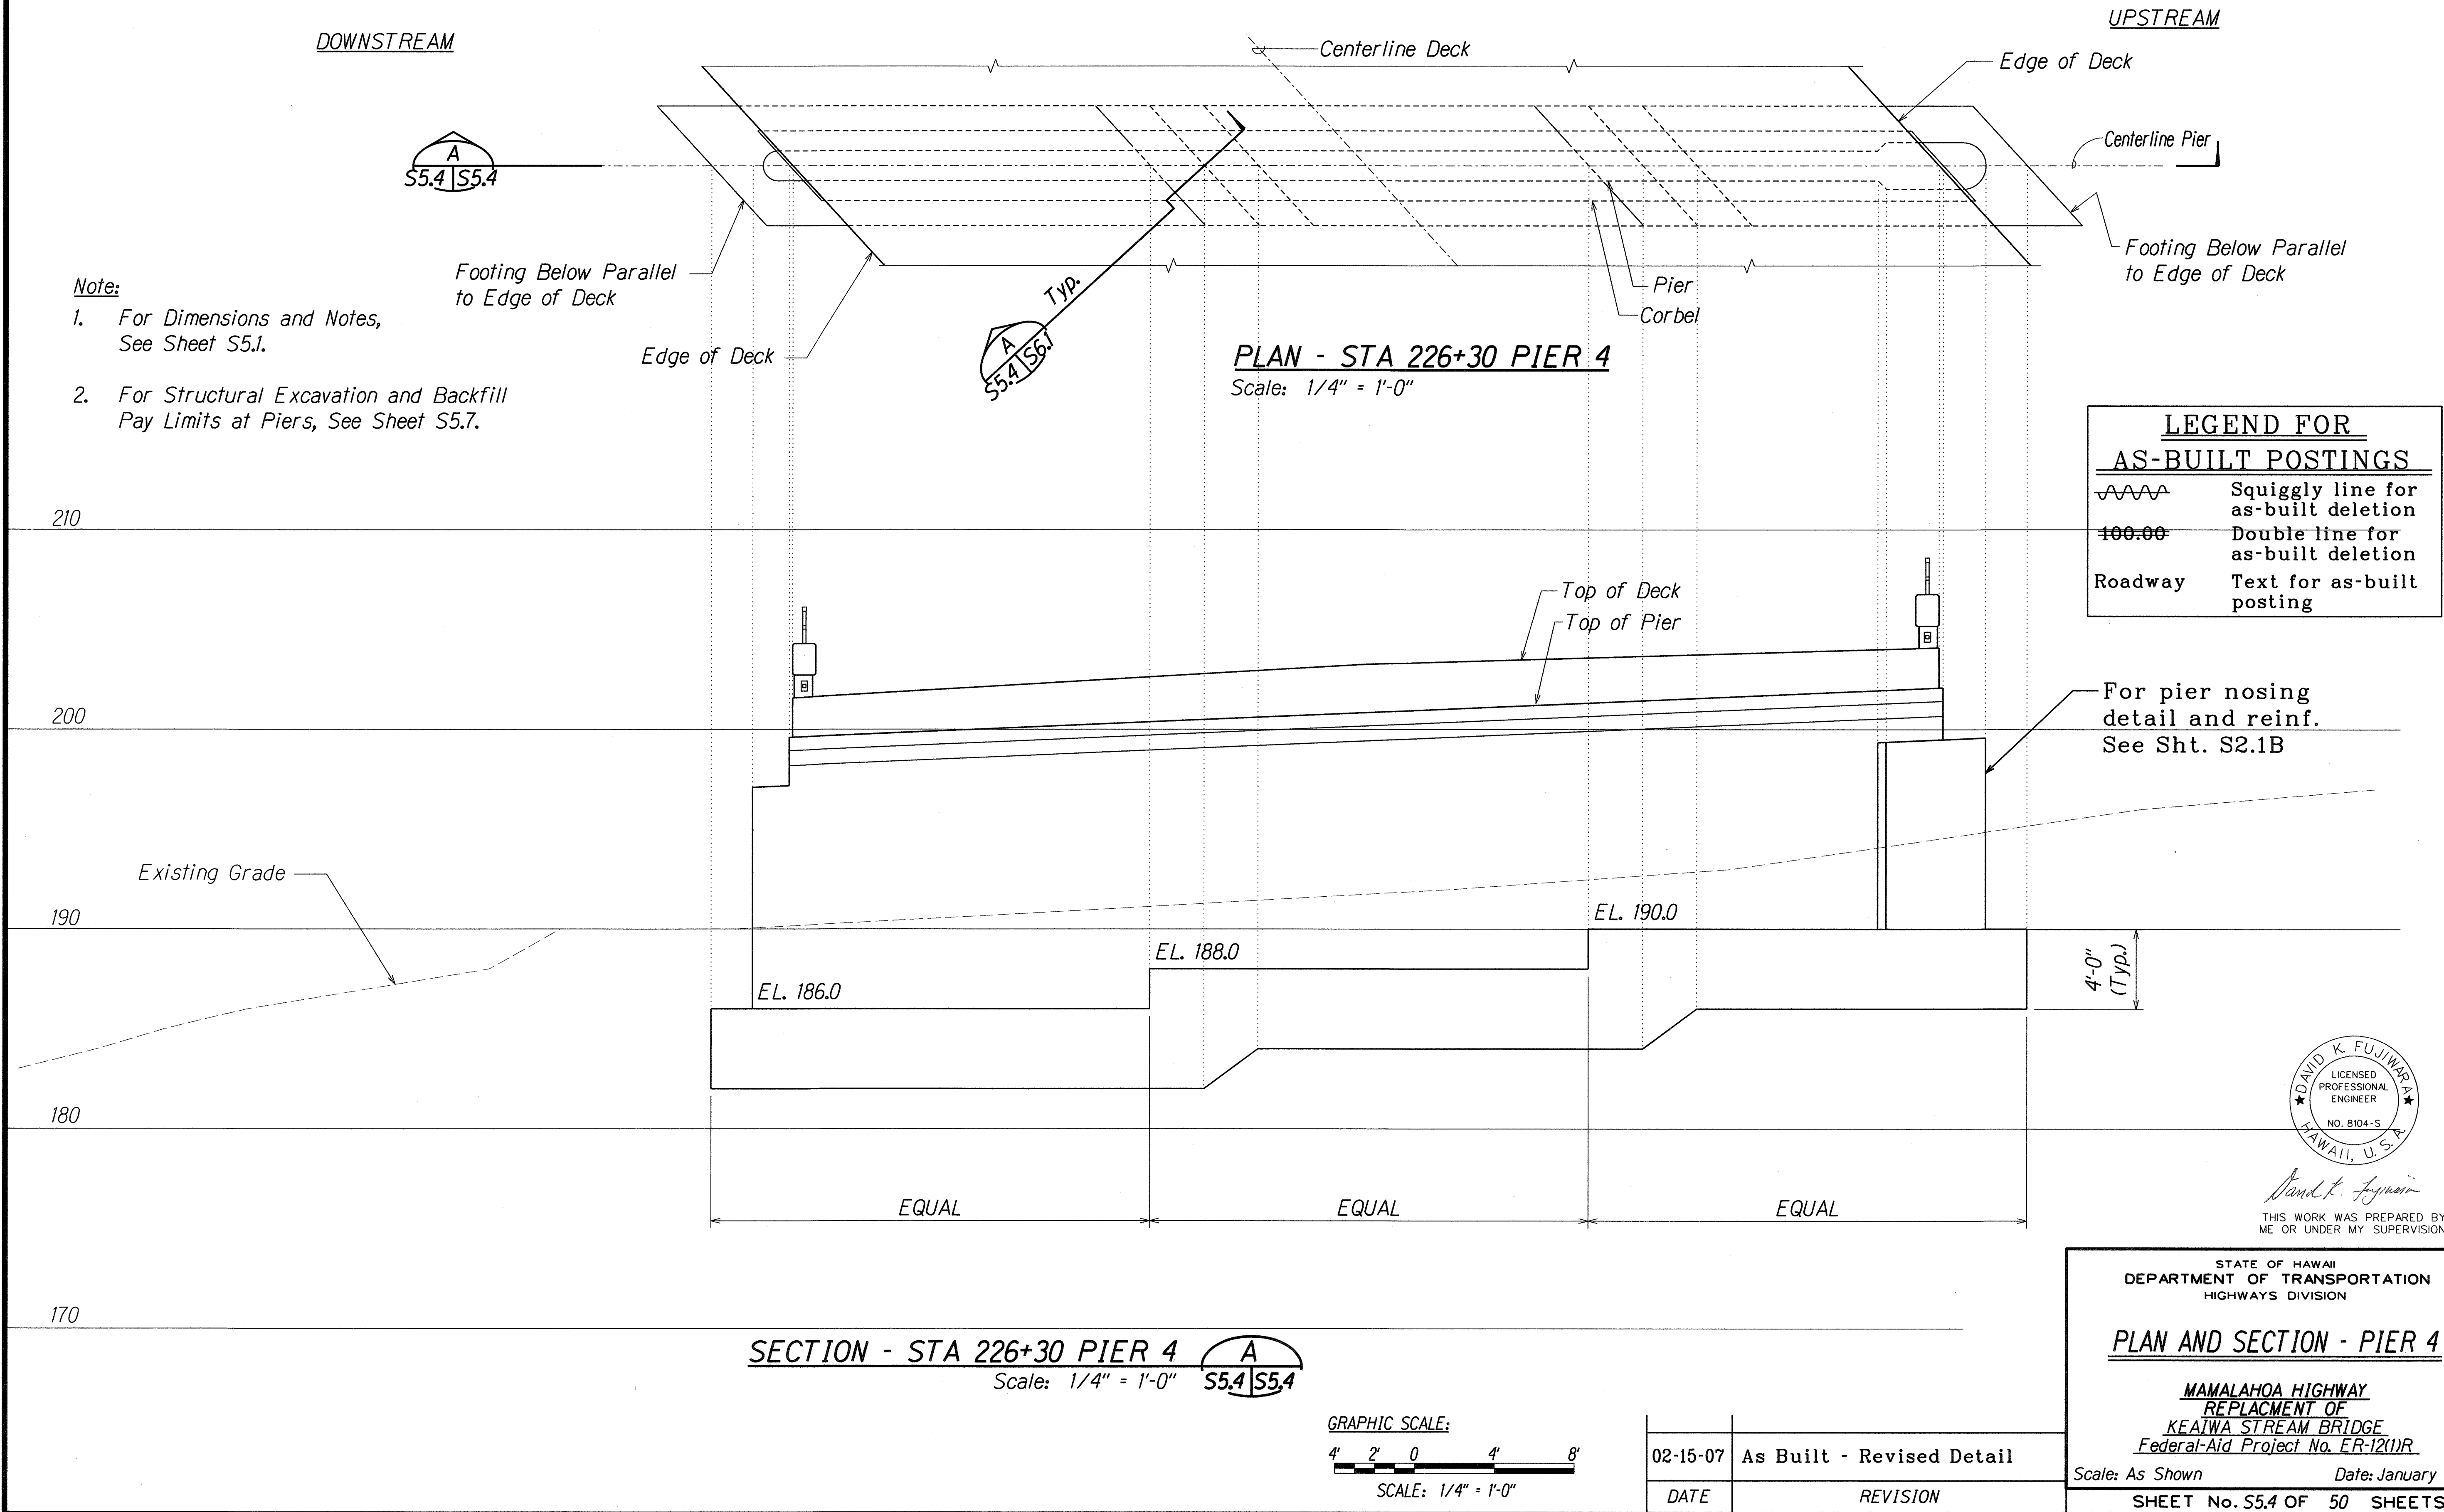

ORIGINAL PLAN	SURVEY PLOTTED BY	DATE
NOTE BOOK	DRAWN BY	10/1/2000
	TRACED BY	
	DESIGNED BY	
	CHECKED BY	
	IN CHARGE	

FED. ROAD DIST. NO.	STATE	FED. AID PROJ. NO.	FISCAL YEAR	SHEET NO.	TOTAL SHEETS
HAWAII	HAW.	ER-12(1)R	2001	42	77

DOWNSTREAM

UPSTREAM

Notes:

- For Dimensions and Notes, See Sheet S5.1.
- For Structural Excavation and Backfill Pay Limits at Piers, See Sheet S5.7.

A
S5.5 | S5.5

Footing Below Parallel
to Edge of Deck

Edge of Deck

Typ.

A
S5.5 | S5.5

PLAN - STA 226+64 PIER 5

Scale: 1/4" = 1'-0"

Centerline Deck

Edge of Deck


Centerline Pier

Footing Below Parallel
to Edge of Deck


Pier

Corbel

LEGEND FOR
AS-BUILT POSTINGS

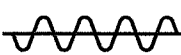

Squiggly line for
as-built deletion

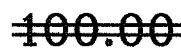

Double line for
as-built deletion

Roadway

Text for as-built
posting

For pier nosing
detail and reinf.
See Sht. S2.1B

210

200

190

Existing Grade

180

170

EL. 185.0

EL. 182.0

EL. 179.0

EL. 177.0

4'-0"
(Typ.)

12'-0"

12'-0"

12'-6"

SECTION - STA 226+64 PIER 5

Scale: 1/4" = 1'-0"

A
S5.5 | S5.5

GRAPHIC SCALE:

4' 2' 0' 4' 8'

SCALE: 1/4" = 1'-0"

02-15-07 As Built - Revised Detail

12-20-00 1 Modified Note.

12-20-00 2 Added Notes.

12-20-00 3 Modified Drawn Dimensions of
Steps. Added Section Mark.

12-20-00 4 Modified Footing Elevations and
Drawn Dimensions of Steps.

DATE

REVISION

STATE OF HAWAII
DEPARTMENT OF TRANSPORTATION
HIGHWAYS DIVISION

PLAN AND SECTION - PIER 5

MAMALAHOA HIGHWAY
REPLACEMENT OF
KEATWA STREAM BRIDGE
Federal-Aid Project No. ER-12(1)R

Scale: As Shown

Date: January 2001

SHEET No. S5.5 OF 50 SHEETS

AS-BUILT

FED. ROAD DIST. NO.	STATE	FED. AID PROJ. NO.	FISCAL YEAR	SHEET NO.	TOTAL SHEETS
HAWAII	HAW.	ER-12(1)R	2001	43	77

Notes:

- For Dimensions and Notes, See Sheet S5.1.
- For Structural Excavation and Backfill Pay Limits at Piers, See Sheet S5.7.

A
S5.6 | S5.6

Footing Below Parallel
to Edge of Deck

Edge of Deck

Centerline Deck

Edge of Deck

Centerline Pier

Footing Below Parallel
to Edge of Deck

Pier
Corbel

Typ.
A
S5.6 | S5.6

PLAN - STA 226+98 PIER 6
Scale: 1/4" = 1'-0"

210

200

190

180

170

Existing Grade

Top of Deck
Top of Pier

For pier nosing
detail and reinf.
See Sht. S2.1B

El. 182.0

El. 179.0

El. 176.0

4'-0"
(Typ.)



32'-0"

8'-0"

SECTION - STA 226+98 PIER 6
Scale: 1/4" = 1'-0"

A
S5.6 | S5.6


LEGEND FOR
AS-BUILT POSTINGS

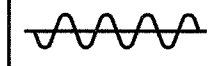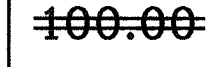	Squiggly line for as-built deletion
	Double line for as-built deletion
Roadway	Text for as-built posting

GRAPHIC SCALE:



SCALE: 1/4" = 1'-0"

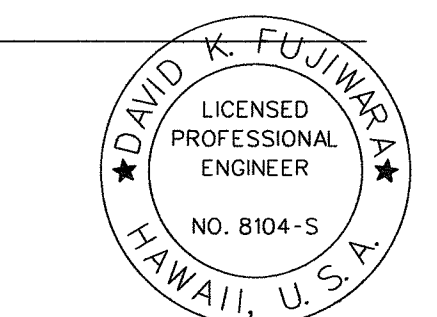

THIS WORK WAS PREPARED BY
ME OR UNDER MY SUPERVISION.

STATE OF HAWAII
DEPARTMENT OF TRANSPORTATION
HIGHWAYS DIVISION

PLAN AND SECTION - PIER 6

MAMALAHOA HIGHWAY
REPLACEMENT OF
KEATWA STREAM BRIDGE
Federal-Aid Project No. ER-12(1)R


Scale: As Shown Date: January 2001

SHEET No. S5.6 OF 50 SHEETS

AS-BUILT

ORIGINAL PLAN	SURVEY PLOTTED BY	DATE
NOTE BOOK	DRAWN BY	10/2/2001
	DESIGNED BY	
	CHECKED BY	

FED. ROAD DIST. NO.	STATE	FED. AID PROJ. NO.	FISCAL YEAR	SHEET NO.	TOTAL SHEETS
HAWAII	HAW.	ER-12(1)R	2001	44	77

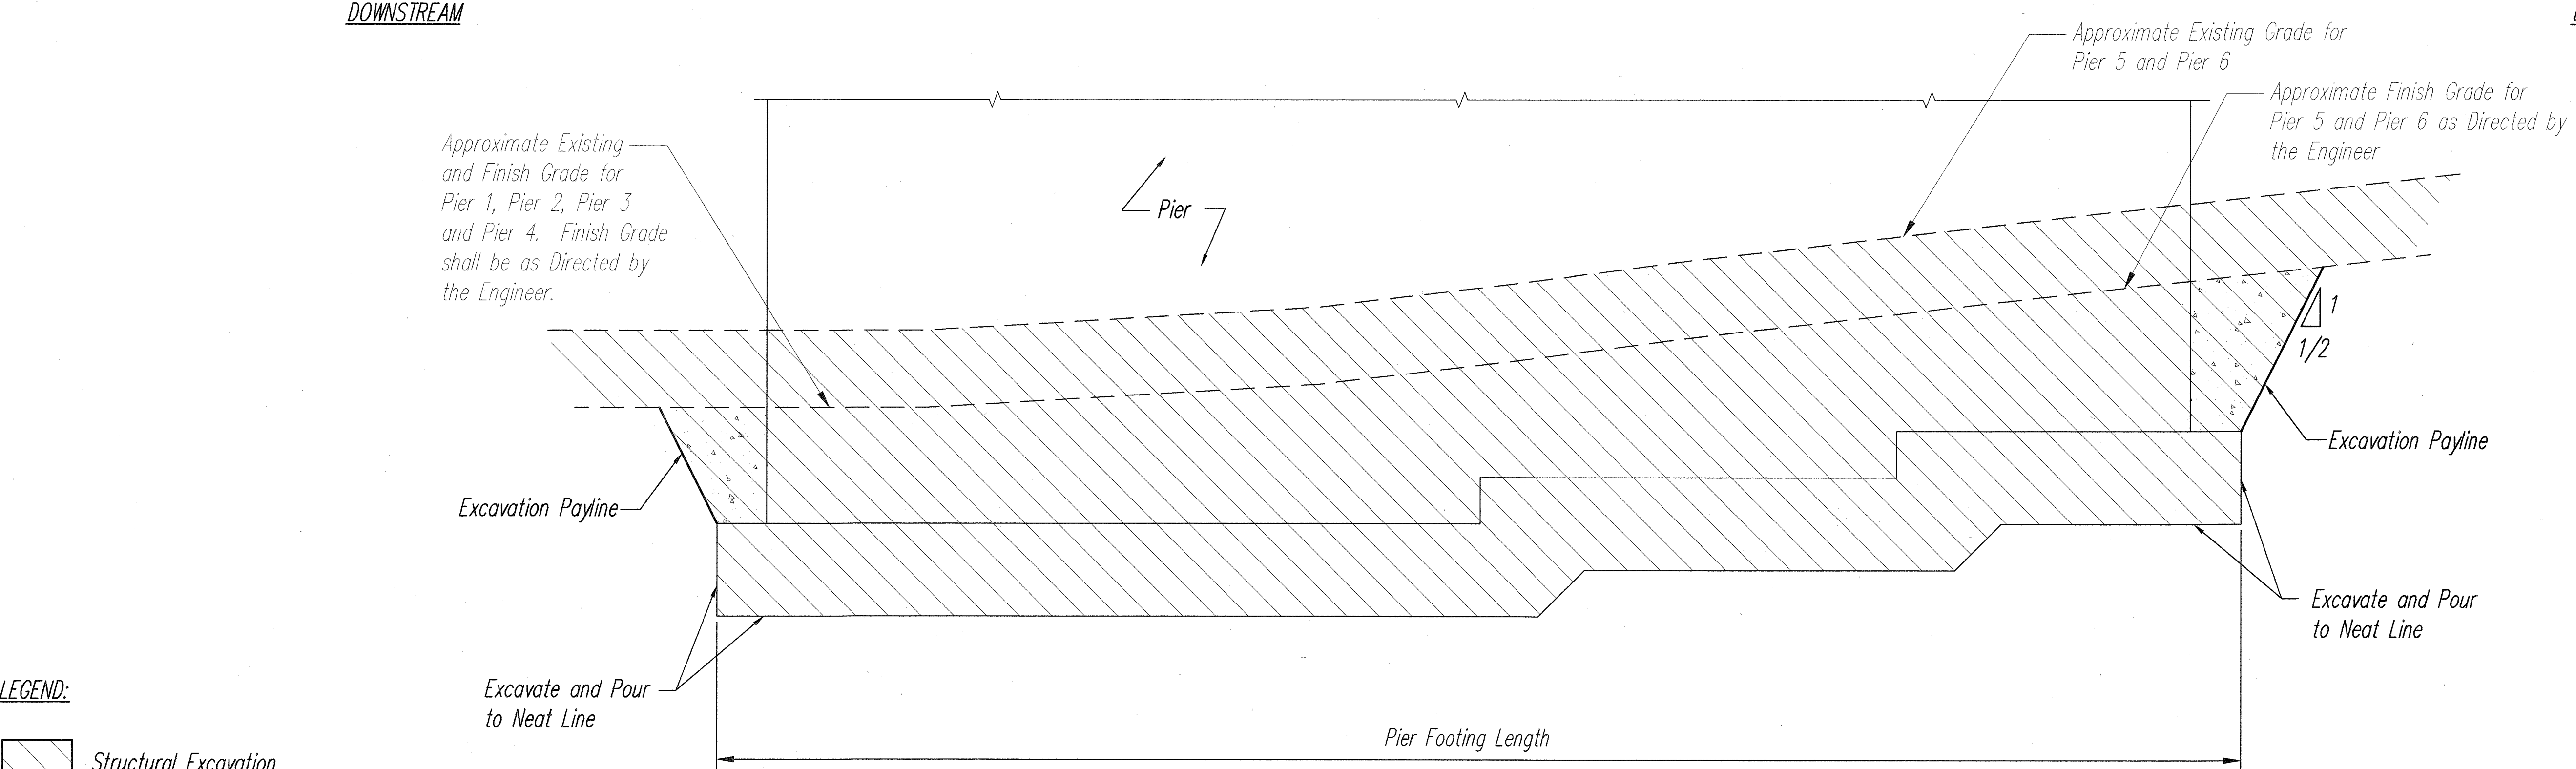

LEGEND:

Structural Excavation

Class "D" Concrete Backfill

EXCAVATION PAYLIMITS A


Scale: 1/4" = 1'-0" S5.7/S5.7

NOTES:

- Excavations for footings in basalt rock formation (including fractured rock and clinker materials) shall be kept to near-vertical (0.5H:1V or steeper). Inadvertent over-excavations by the Contractor shall be cleaned of loose and fractured rock to expose intact rock. Concrete for the final footing shall be poured in contact with the sides of the excavation for the full designed footing thickness. The resulting void space above the top of footing shall be backfilled with Class D concrete. Backfilling the inadvertent over-excavations with footing concrete or Class D concrete will not be measured and paid for separately.
- All footing excavations shall be cleaned of loose materials and highly fractured rock to the satisfaction of the Engineer.
- The Engineer may direct the Contractor to over-excavate below the bottom of footing elevation and to the sides of the edges of the footing excavation. The additional over-excavation of the footing excavations, as directed by the Engineer, will be measured and paid for as structure excavation as indicated in the specifications.
- The additional over-excavation as directed by the Engineer below the bottom of footing elevation shall be back-filled with Class D concrete. This item will be measured and paid for as Structure Backfill for Pier Footing (Class D concrete). Concrete for the final footing may be poured at least 3 days after the Class D concrete backfill pour.


1

2

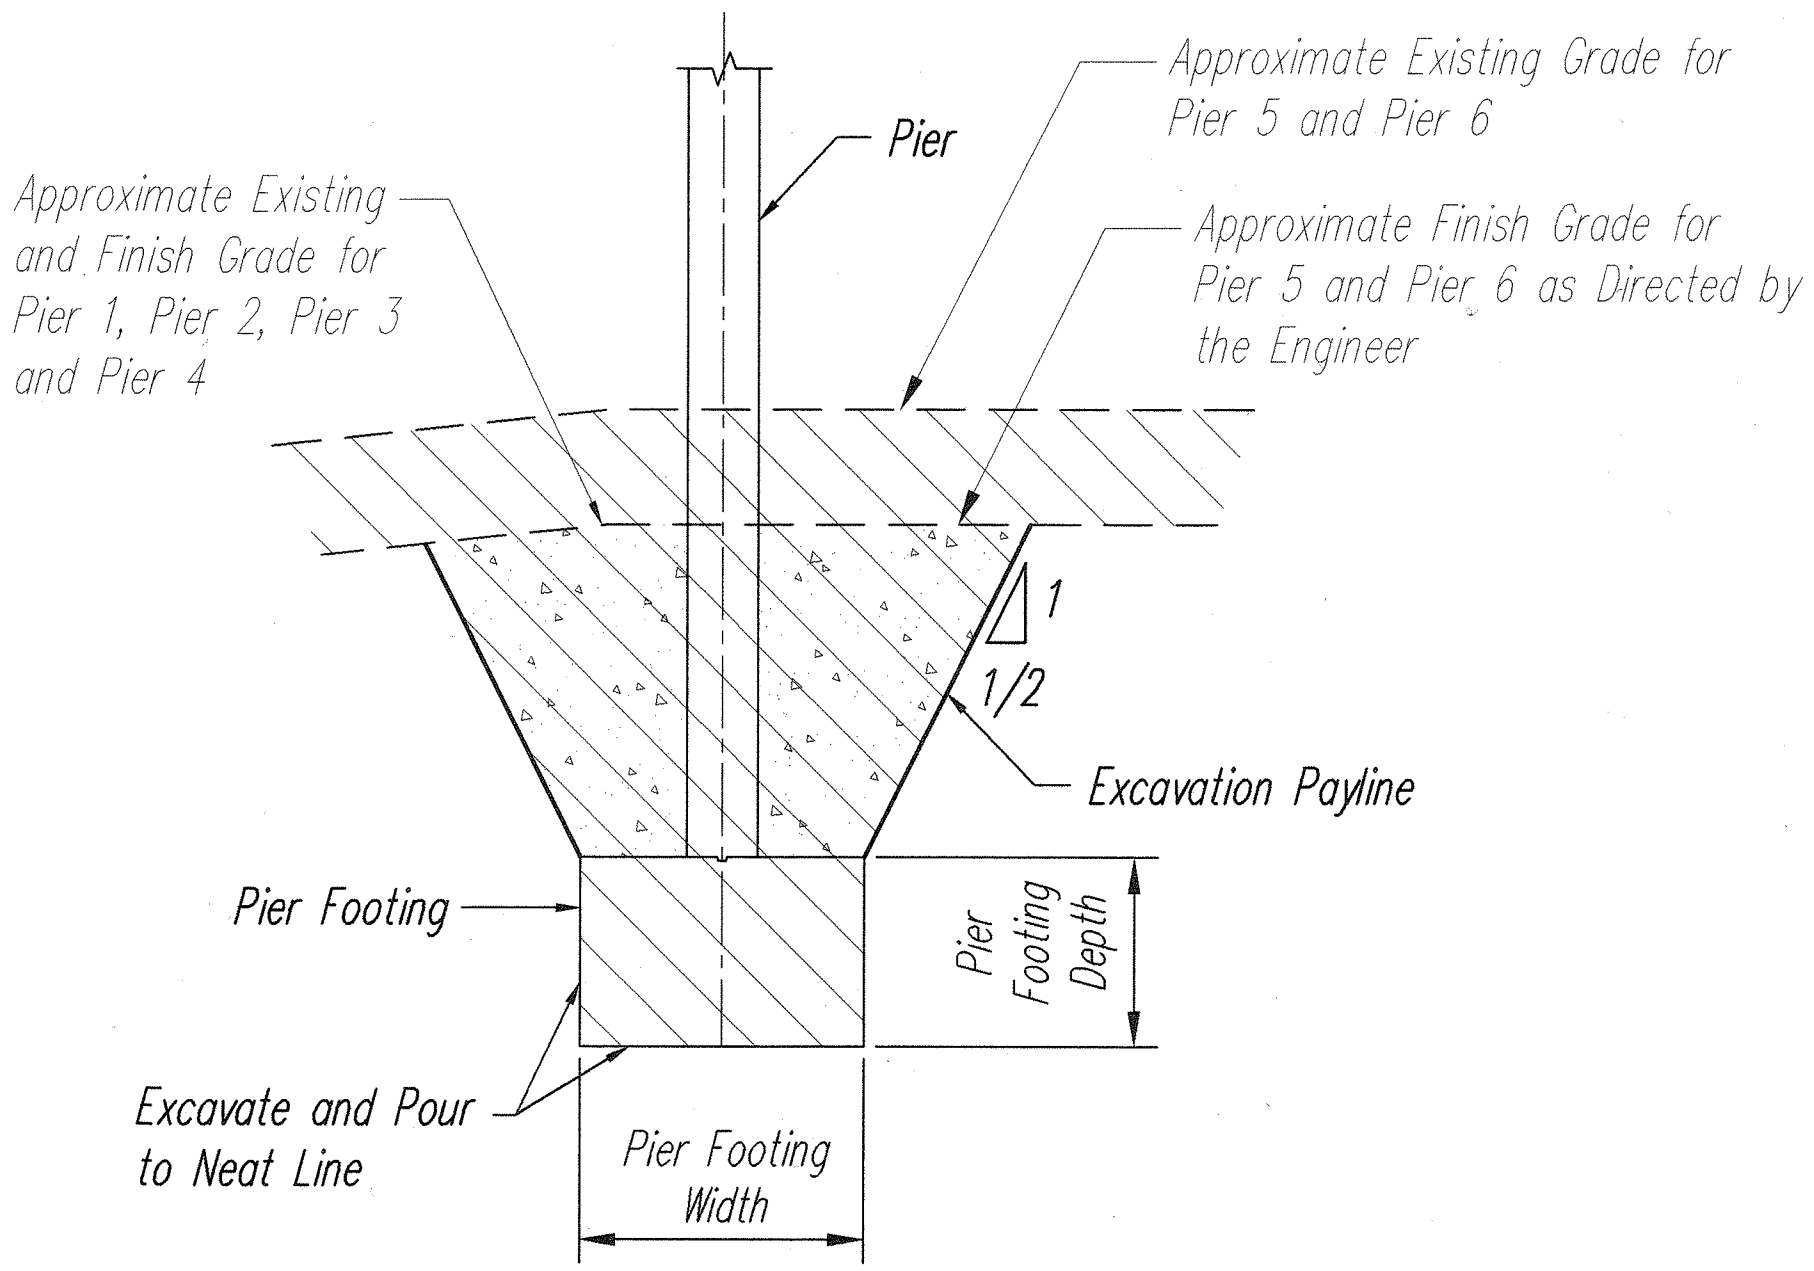


SECTION - EXCAVATION PAYLIMITS B

Scale: 1/4" = 1'-0" S5.7/S5.7

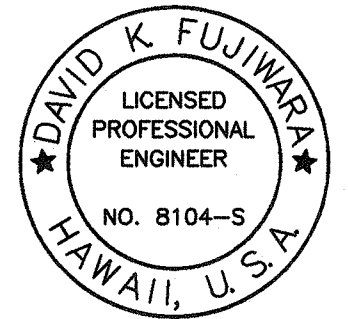


THIS WORK WAS PREPARED BY ME OR UNDER MY SUPERVISION.

01-29-01	<div>1</div>	Change in the Notes
01-29-01	<div>2</div>	Added Note
DATE	DESCRIPTION	
STATE OF HAWAII DEPARTMENT OF TRANSPORTATION HIGHWAYS DIVISION <u>STRUCTURAL EXCAVATION AND</u> <u>BACKFILL PAY LIMITS AT PIERS</u> <u>MAMALAHOA HIGHWAY</u> <u>REPLACEMENT OF</u> <u>KEAIWA STREAM BRIDGE</u> <u>Federal Aid Project No. ER-12(1)R</u> Scale: As Shown Date: January 2001		
SHEET No. S5.7 OF 50 SHEETS		

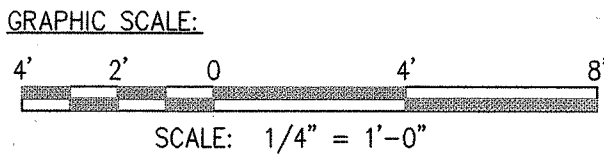


ORIGINAL PLAN	SURVEY PLOTTED BY	DATE
NOTE BOOK	DRAWN BY VSI	NOV2000
	TRACED BY	
	DESIGNED BY KSE	
	QUANTITIES BY	
	CHECKED BY	
No.		

FED. ROAD DIST. NO.	STATE	FED. AID PROJ. NO.	FISCAL YEAR	SHEET NO.	TOTAL SHEETS
HAWAII	HAW.	ER-12(1)R	2001	45	77


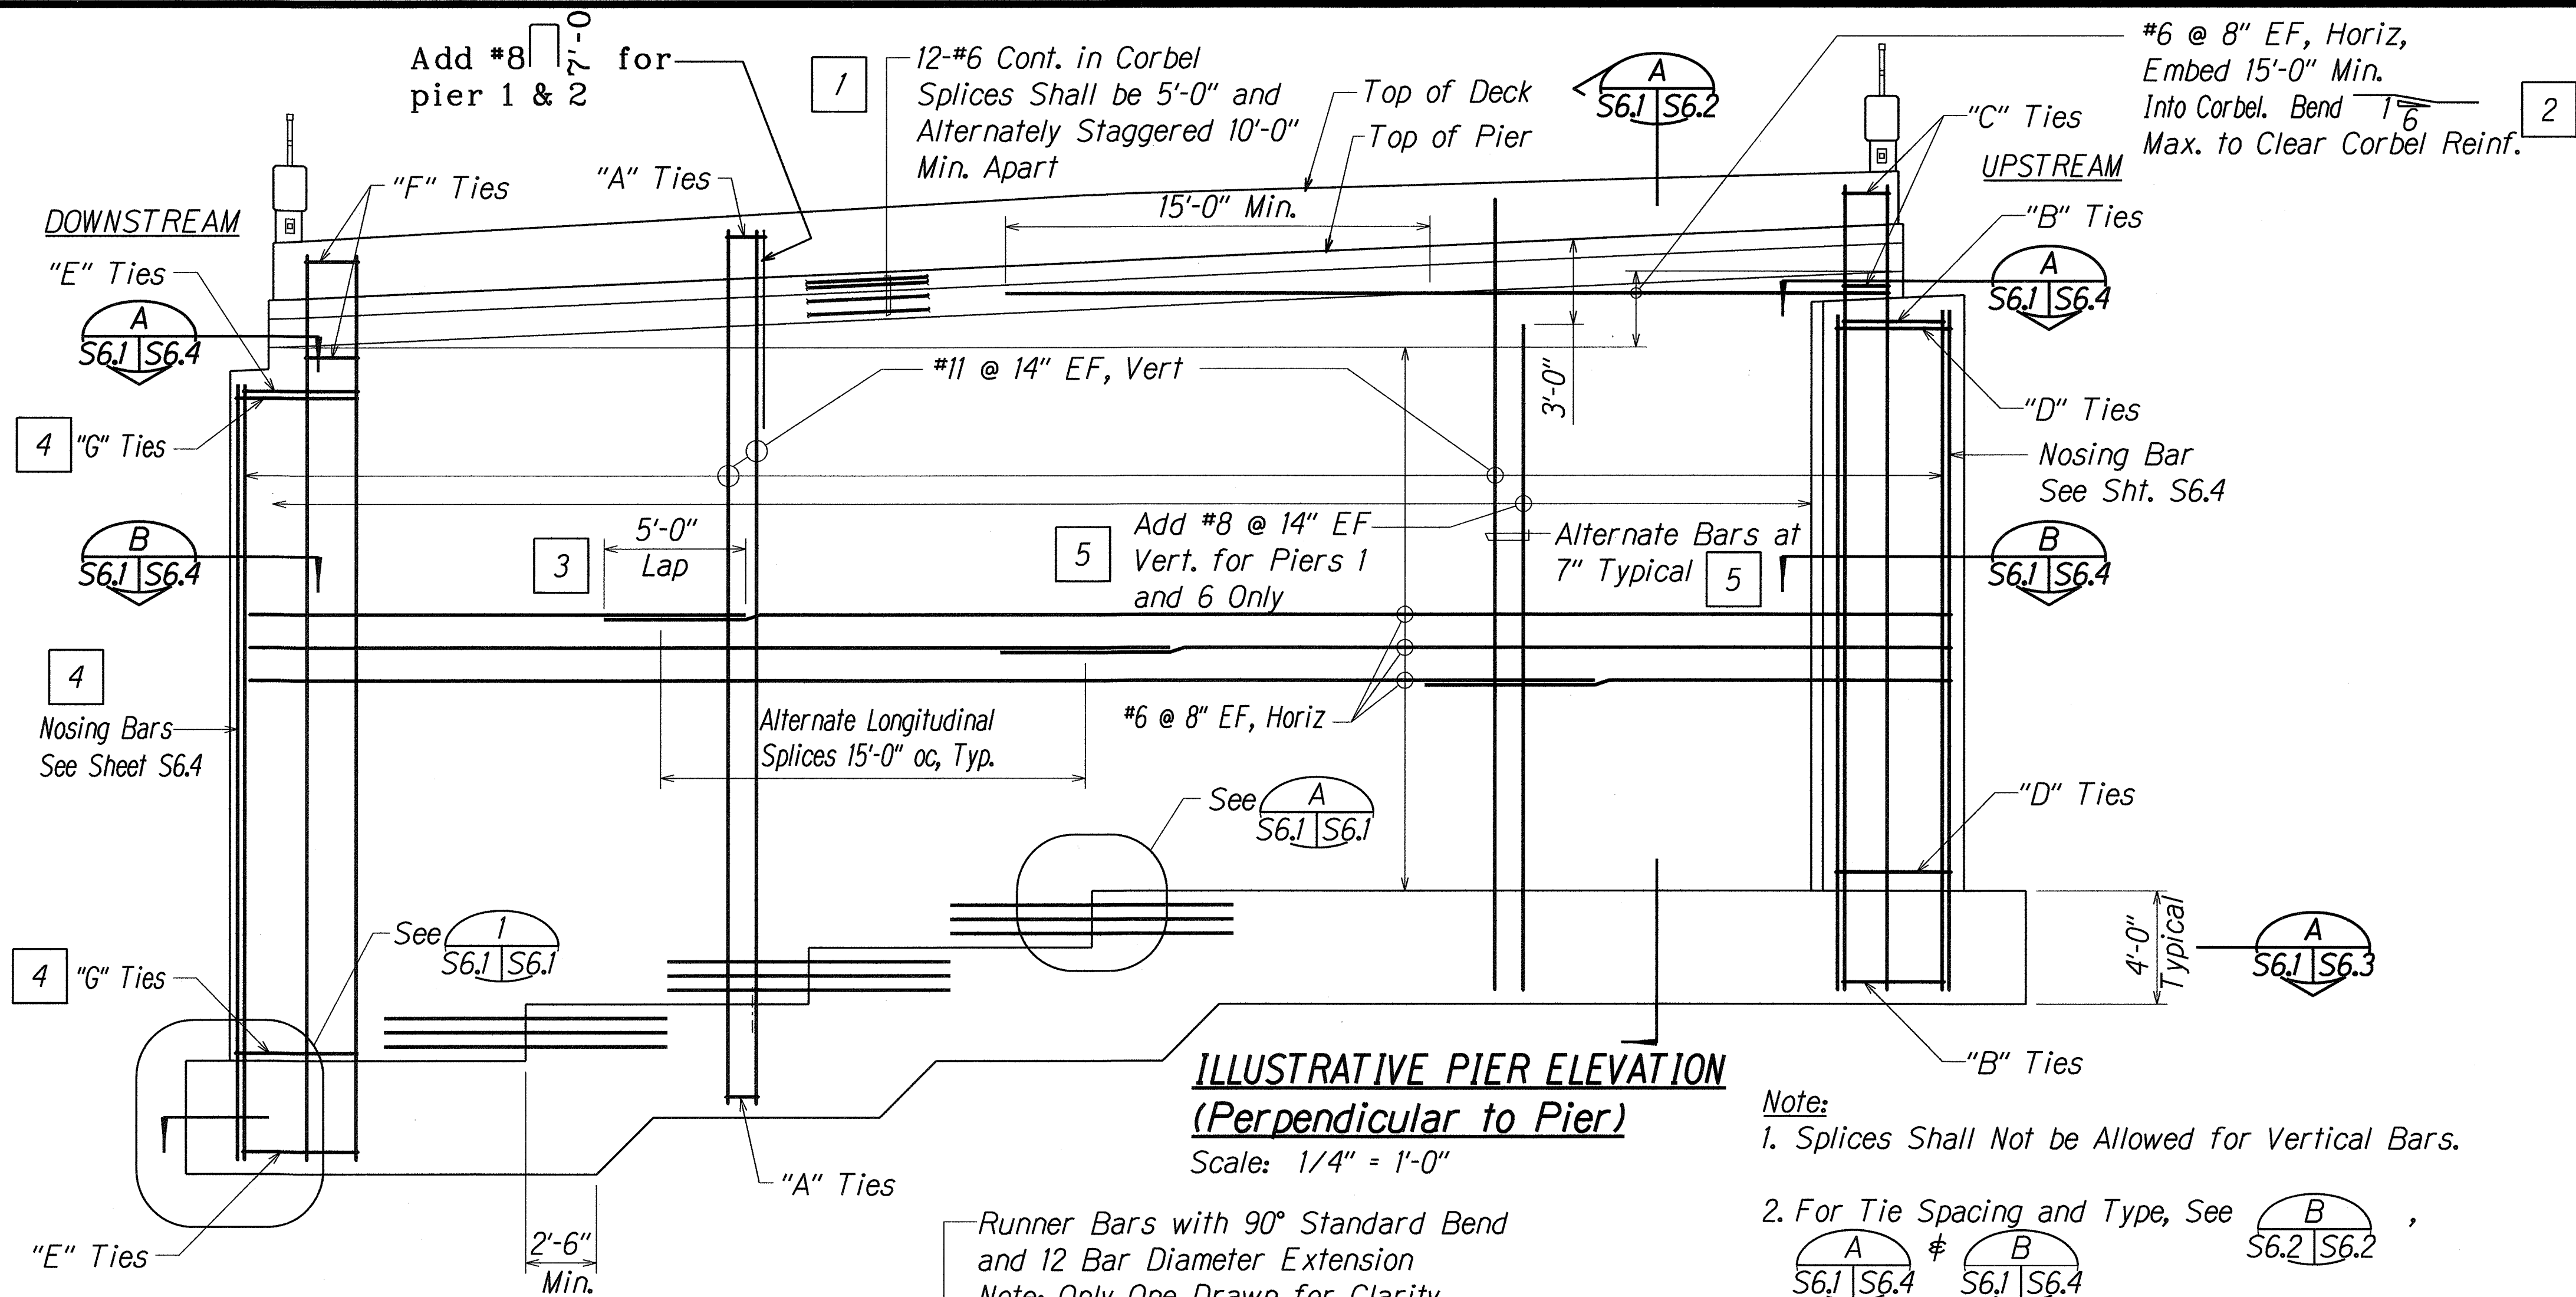


LEGEND FOR AS-BUILT POSTINGS

	Squiggly line for as-built deletion
	Double line for as-built deletion
Roadway	Text for as-built posting

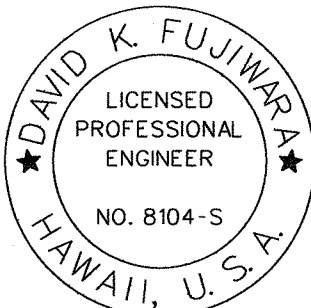

David K. Fujiwara
THIS WORK WAS PREPARED BY ME OR UNDER MY SUPERVISION.

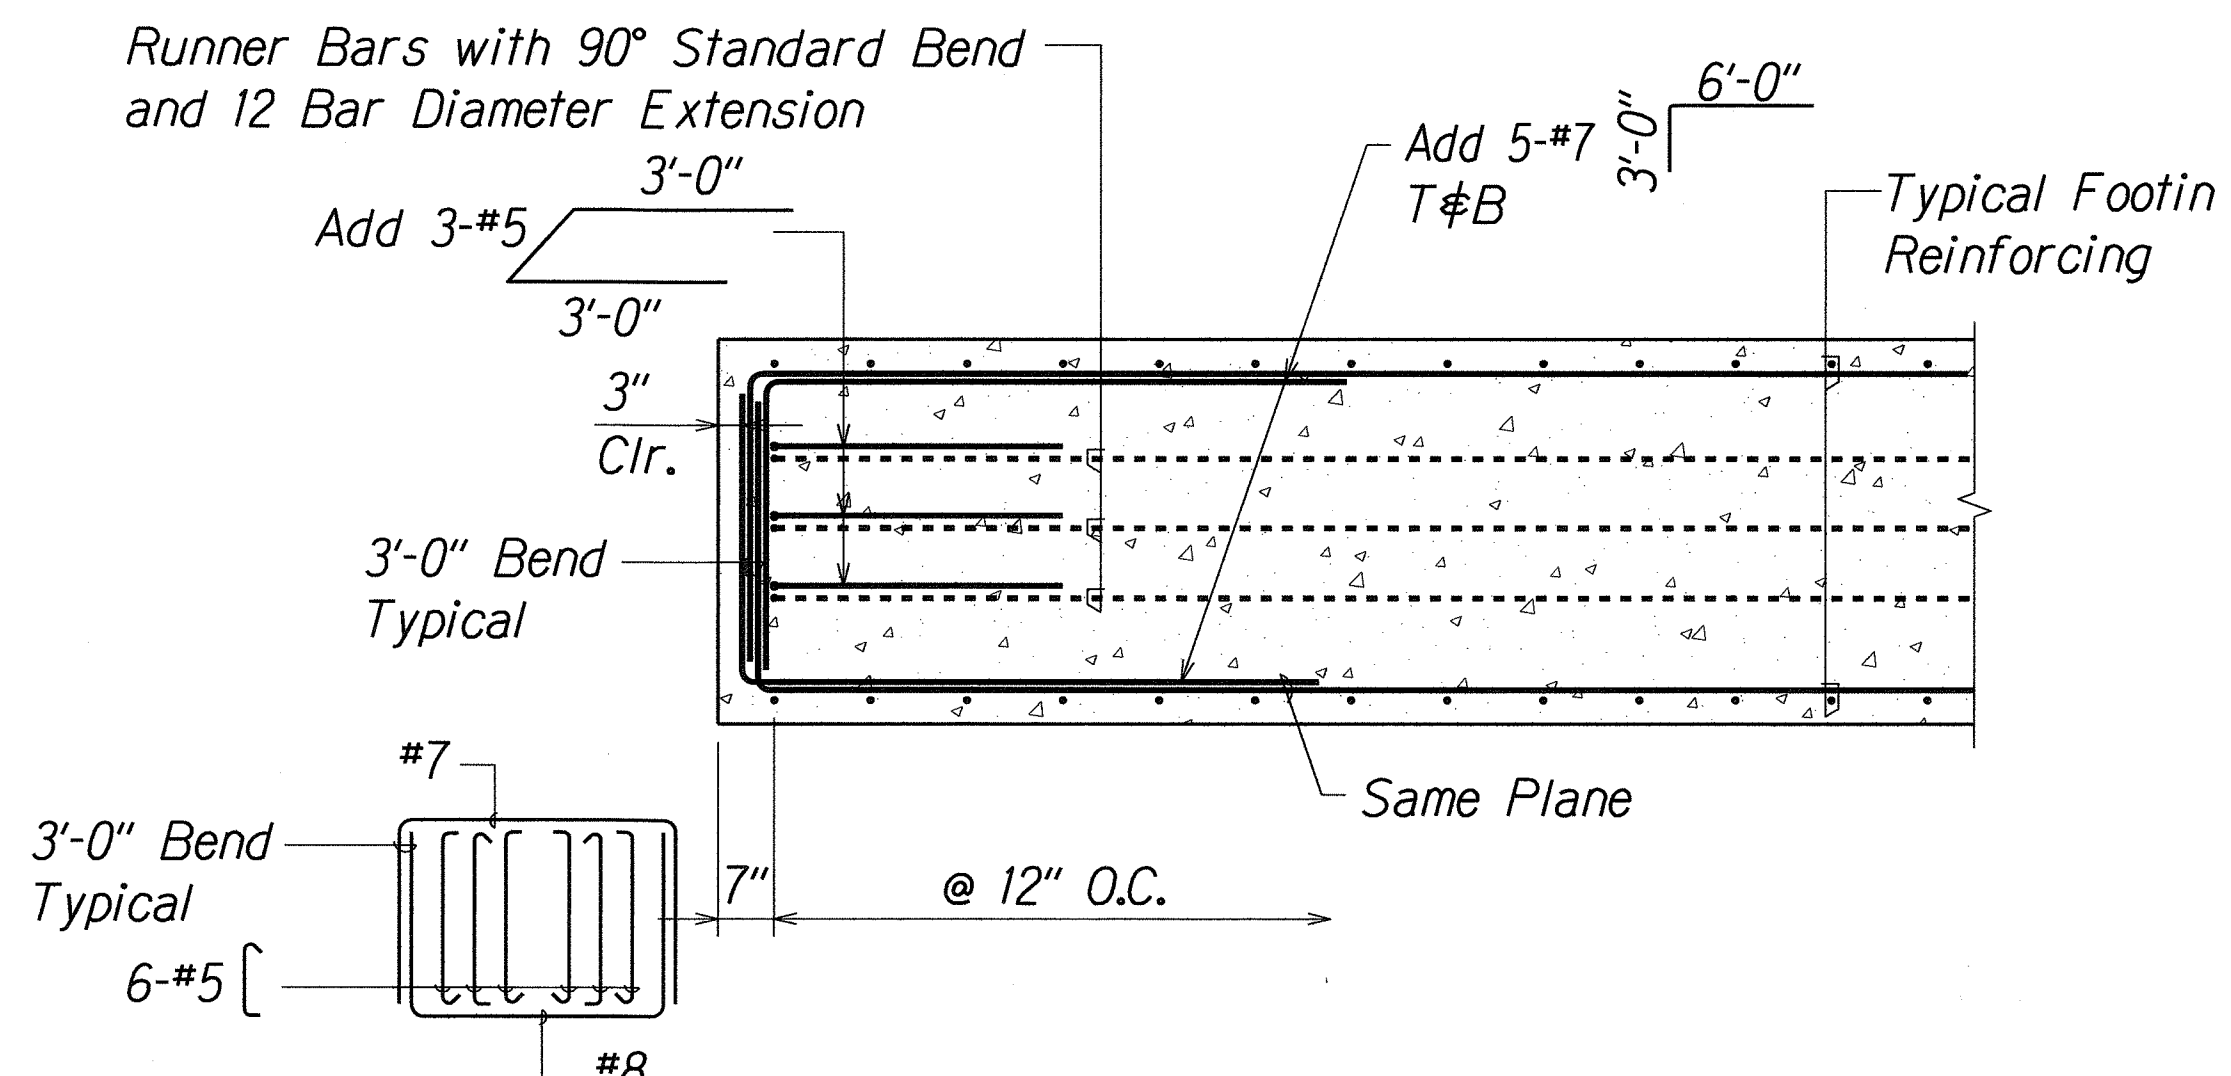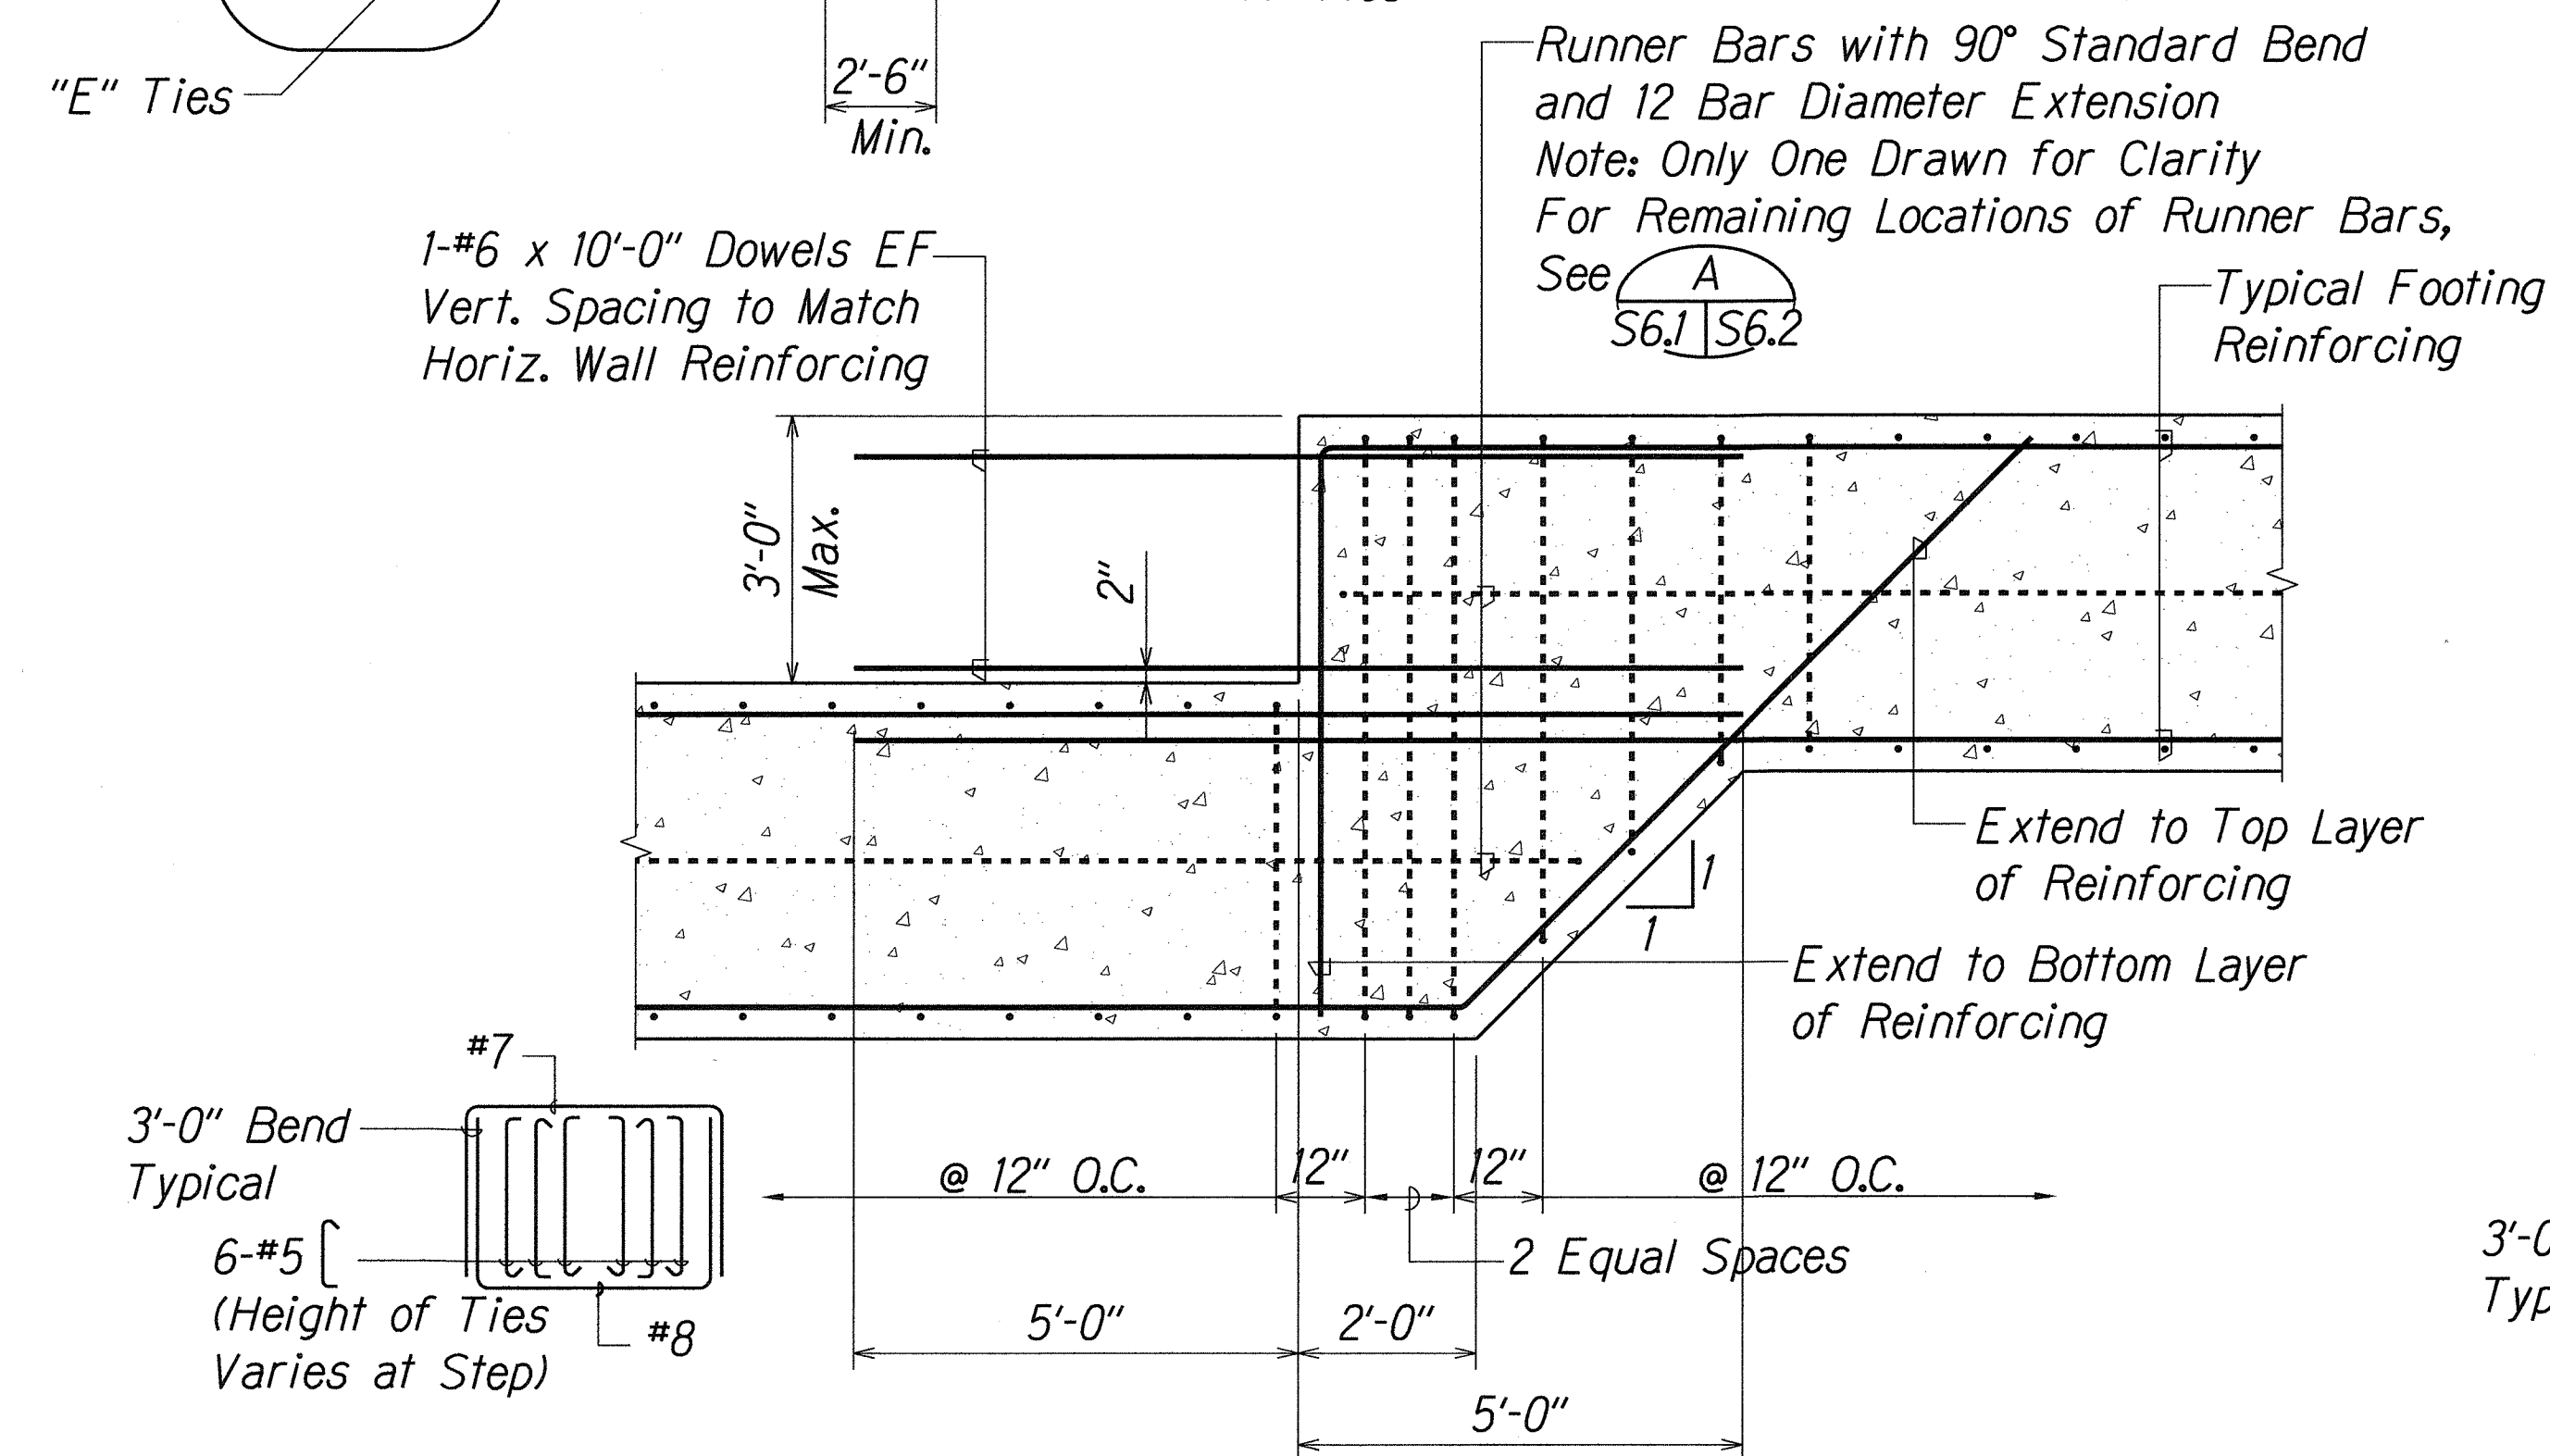

SECTION - TYPICAL STEP DETAIL
Scale: 1/2" = 1'-0"
S5.1, S5.2, S5.3, S5.4, S5.5, S5.6

TYPICAL END CONDITION
Scale: 1/2" = 1'-0"

DATE	REVISION
02-15-07	As Built - Revised Detail
01-29-01	1 Modified Cont. Reinf. in Corbel
01-29-01	2 Clarified Horiz. Reinf.
01-29-01	3 Changed Lap Length
01-29-01	4 Added "G" Ties and Nosing Bars at Downstream End
01-29-01	5 Added Vert. Reinf. for Piers 1 and 6 Only

DATE	REVISION
02-15-07	As Built - Revised Detail
01-29-01	1 Modified Cont. Reinf. in Corbel
01-29-01	2 Clarified Horiz. Reinf.
01-29-01	3 Changed Lap Length
01-29-01	4 Added "G" Ties and Nosing Bars at Downstream End
01-29-01	5 Added Vert. Reinf. for Piers 1 and 6 Only

STATE OF HAWAII
DEPARTMENT OF TRANSPORTATION
HIGHWAYS DIVISION





TYPICAL PIER ELEVATION AND DETAILS

MAMALAHOA HIGHWAY
REPLACEMENT OF
KEATWA STREAM BRIDGE
Federal-Aid Project No. ER-12(1)R


Scale: As Shown Date: January 2001

SHEET No. S6.1 OF 50 SHEETS

FED. ROAD DIST. NO.	STATE	FED. AID PROJ. NO.	FISCAL YEAR	SHEET NO.	TOTAL SHEETS
HAWAII	HAW.	ER-12(1)R	2001	47	77

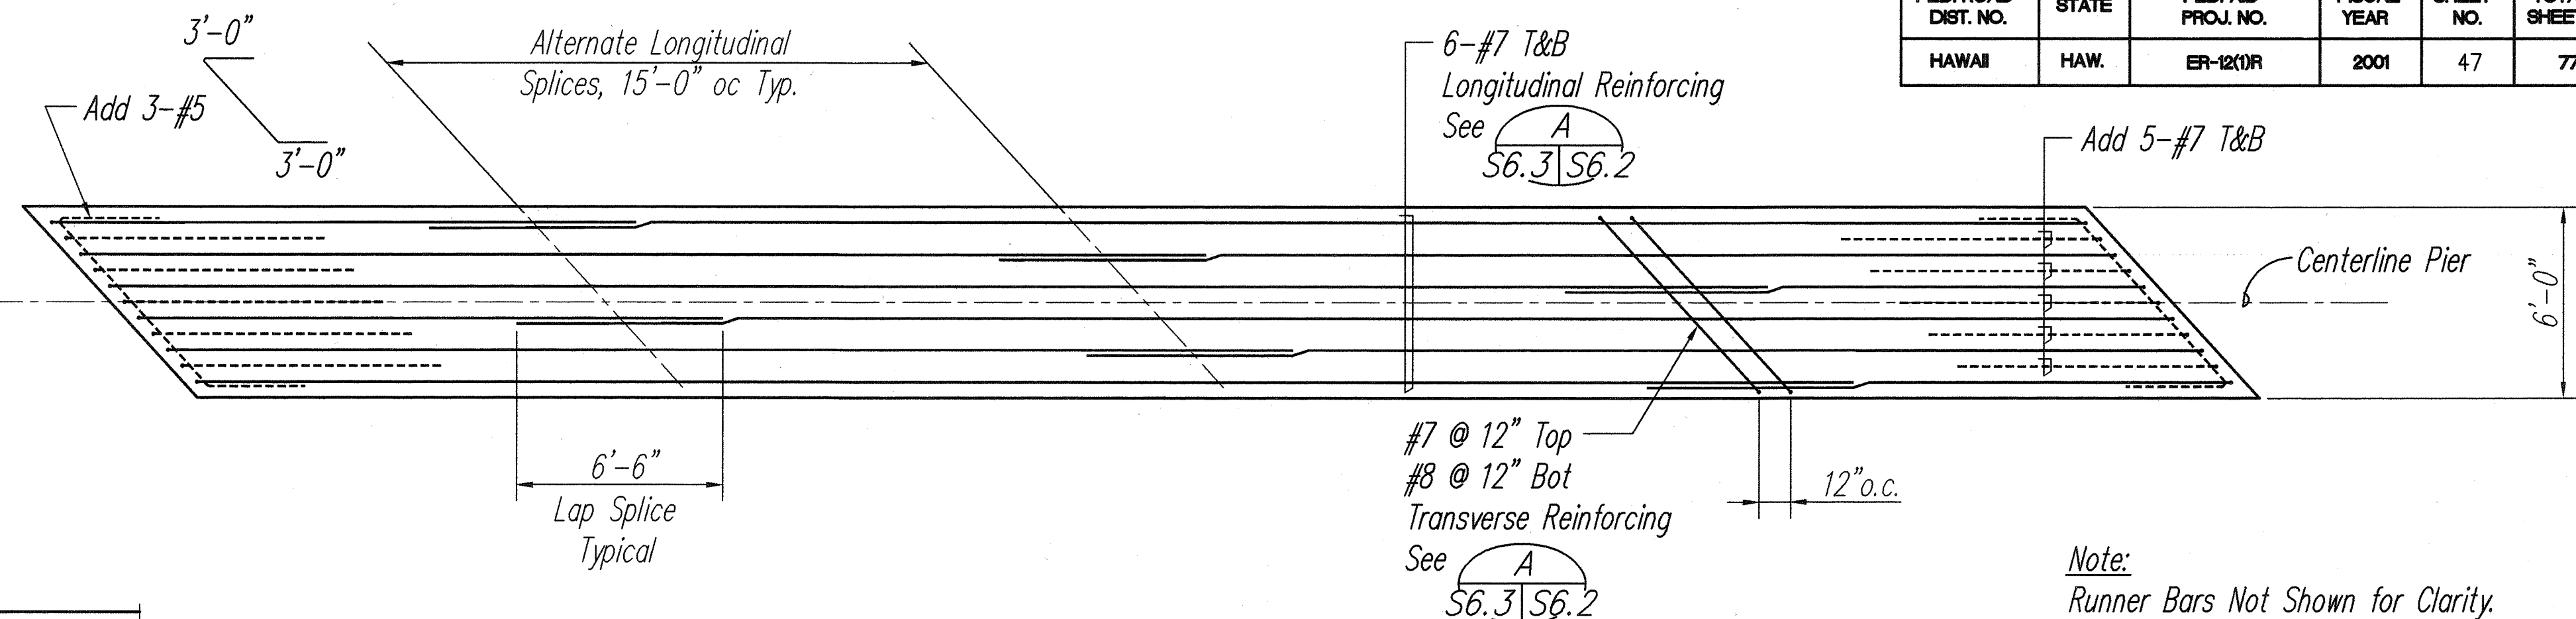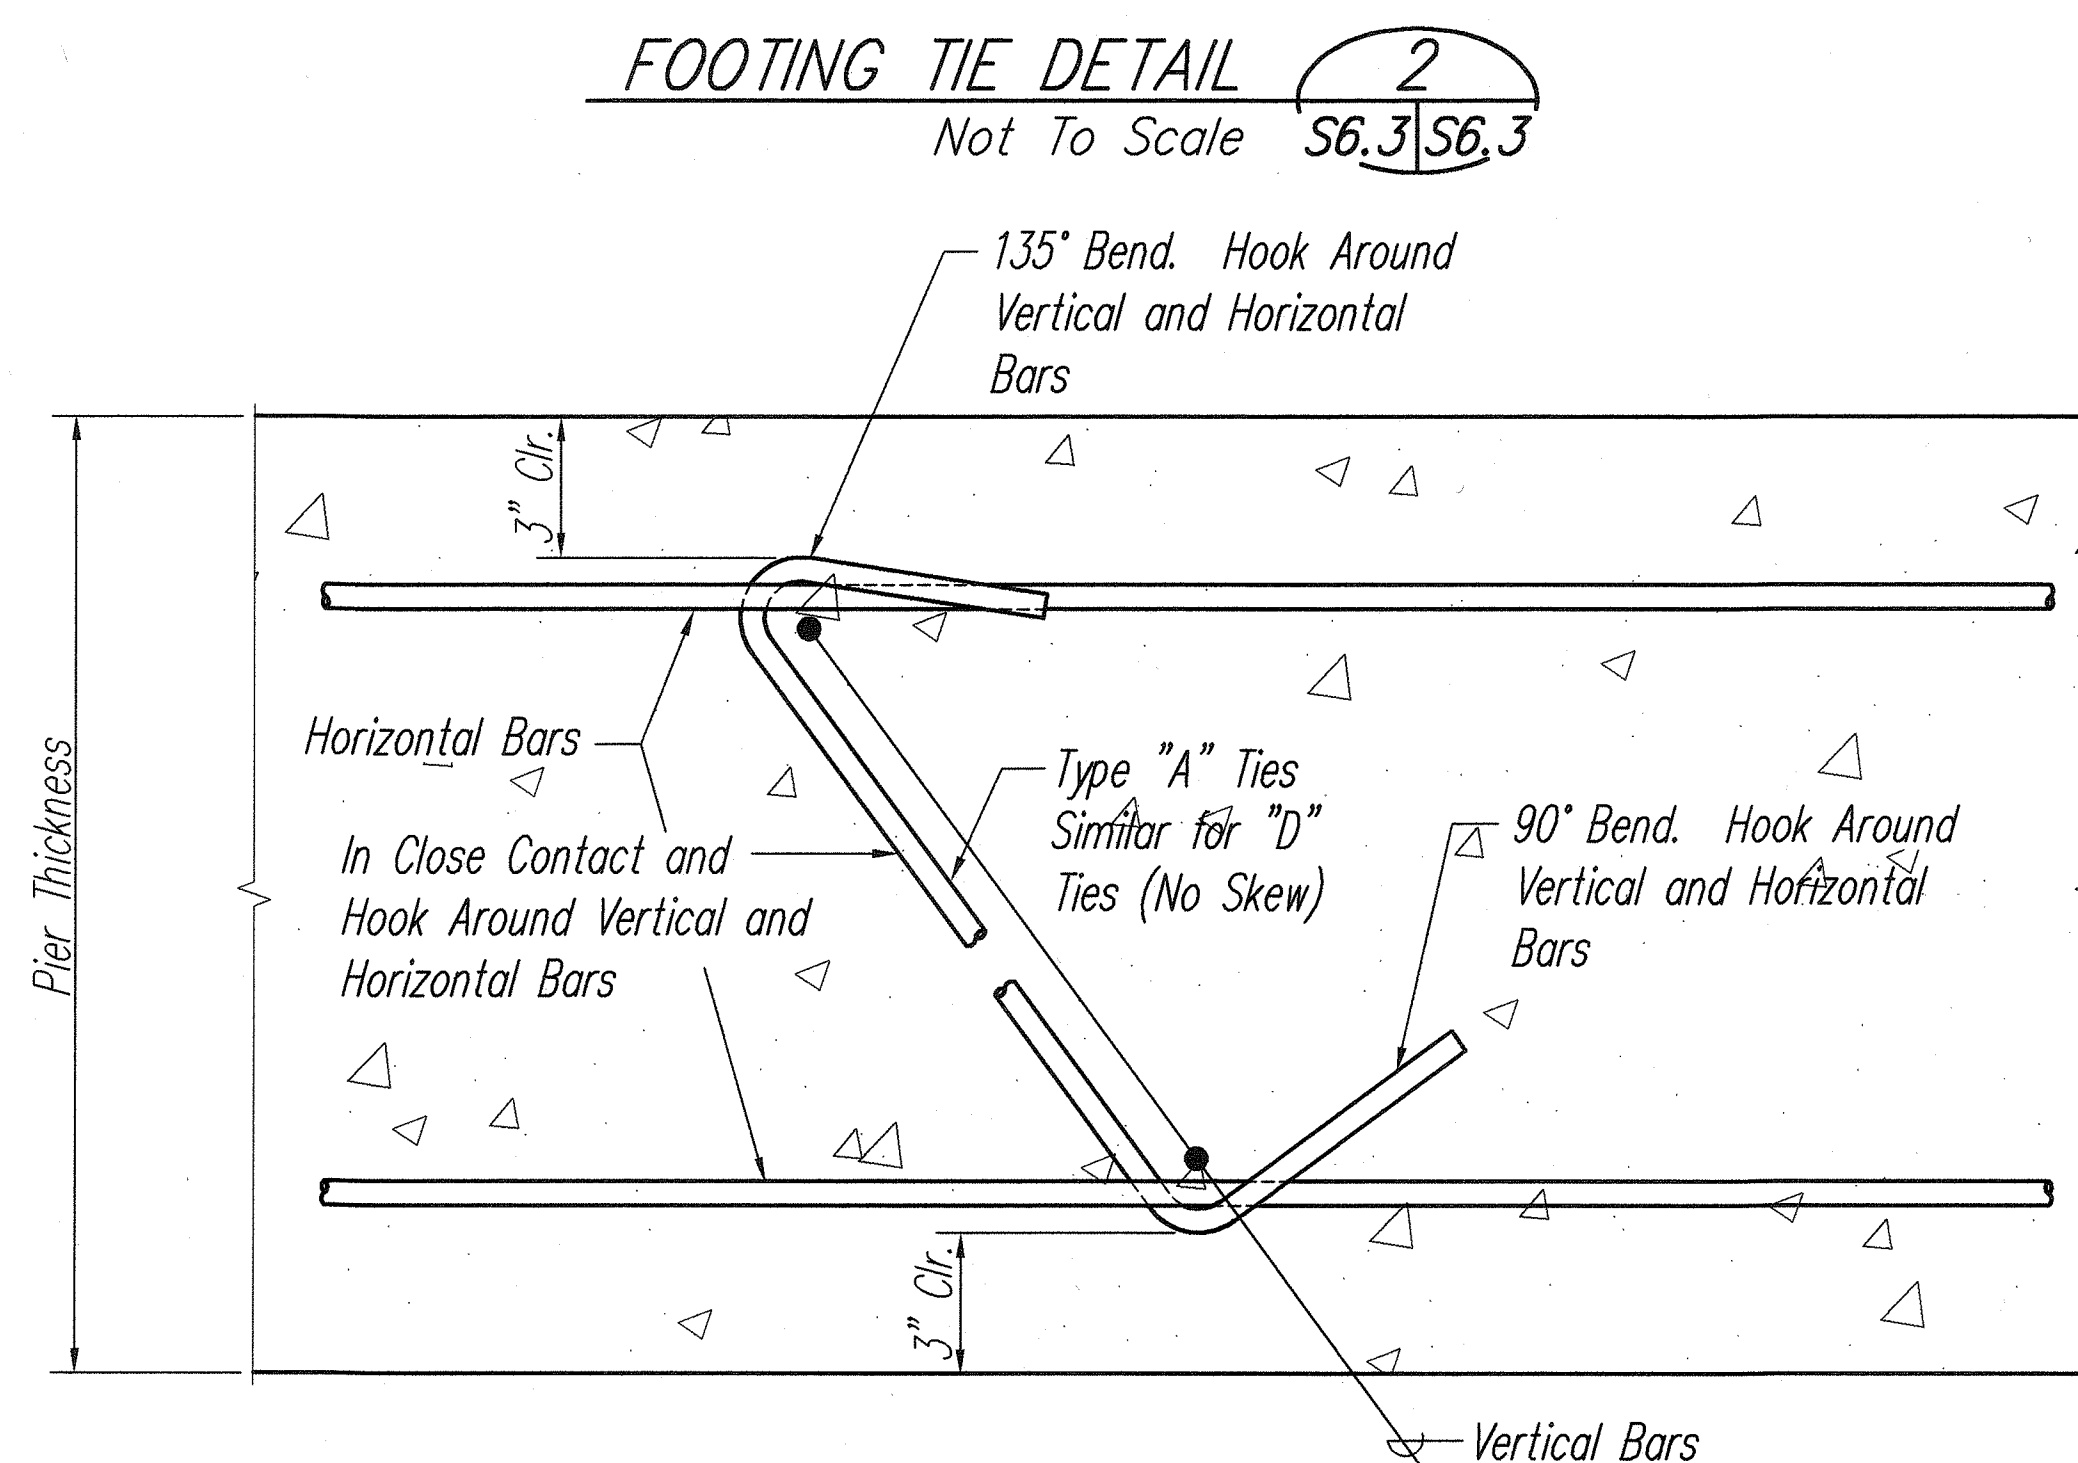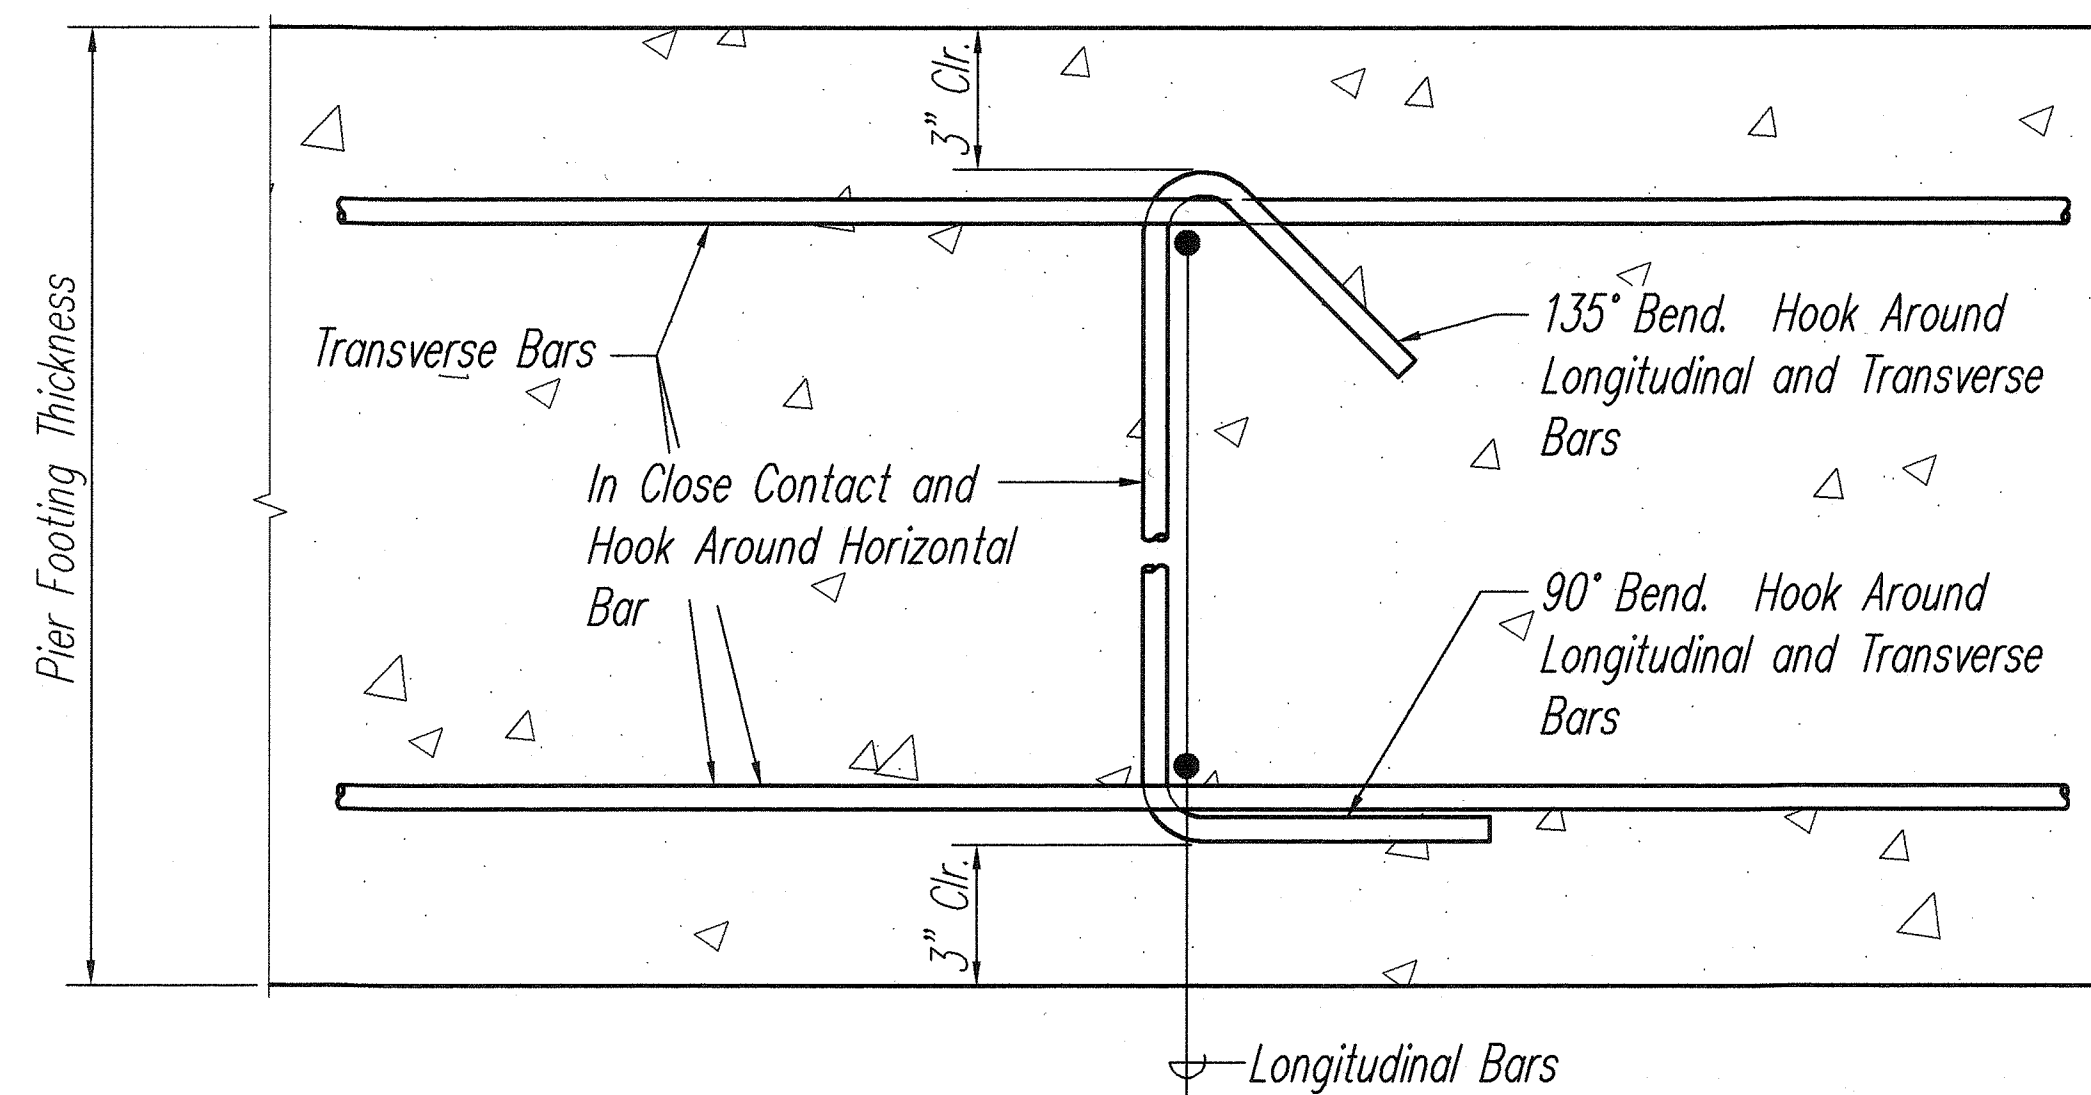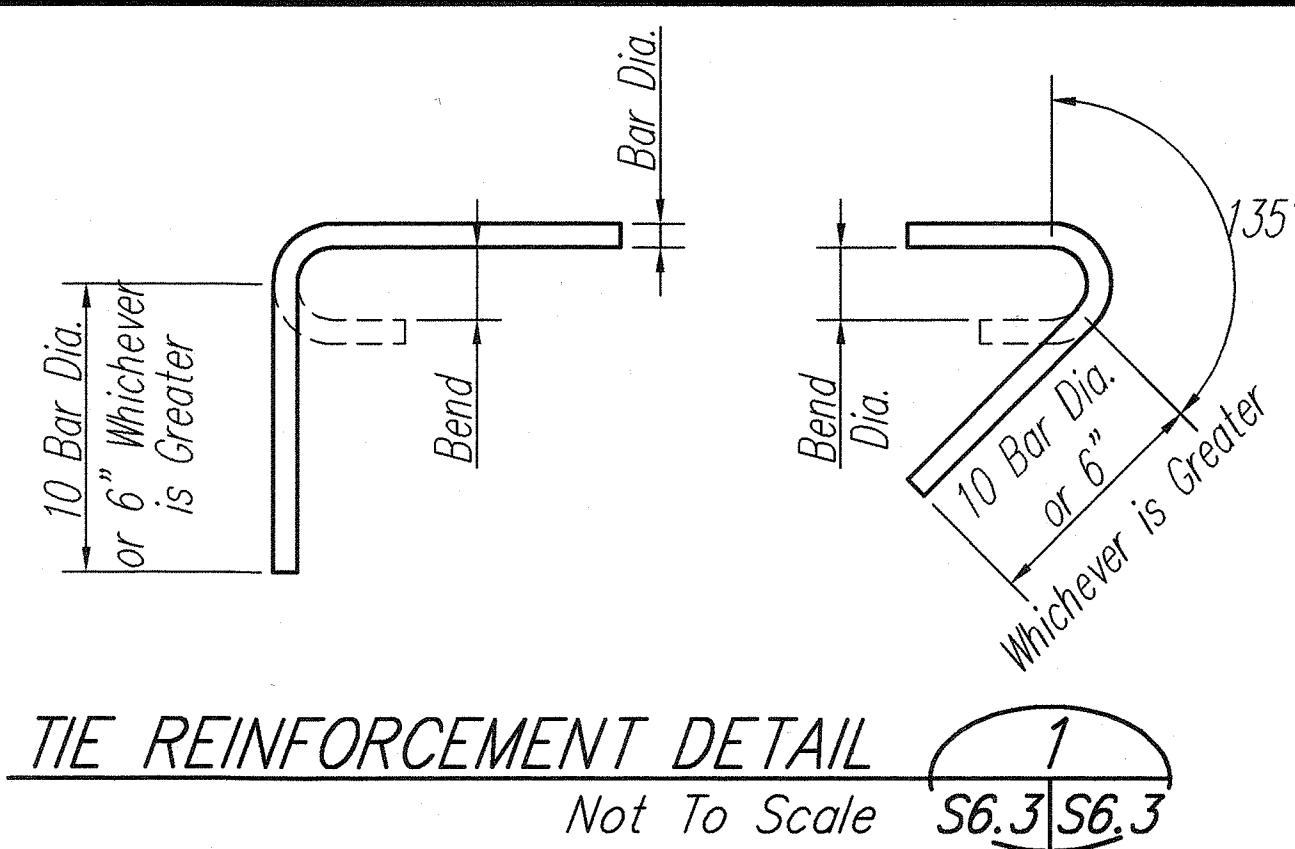

Note:
Runner Bars Not Shown for Clarity.

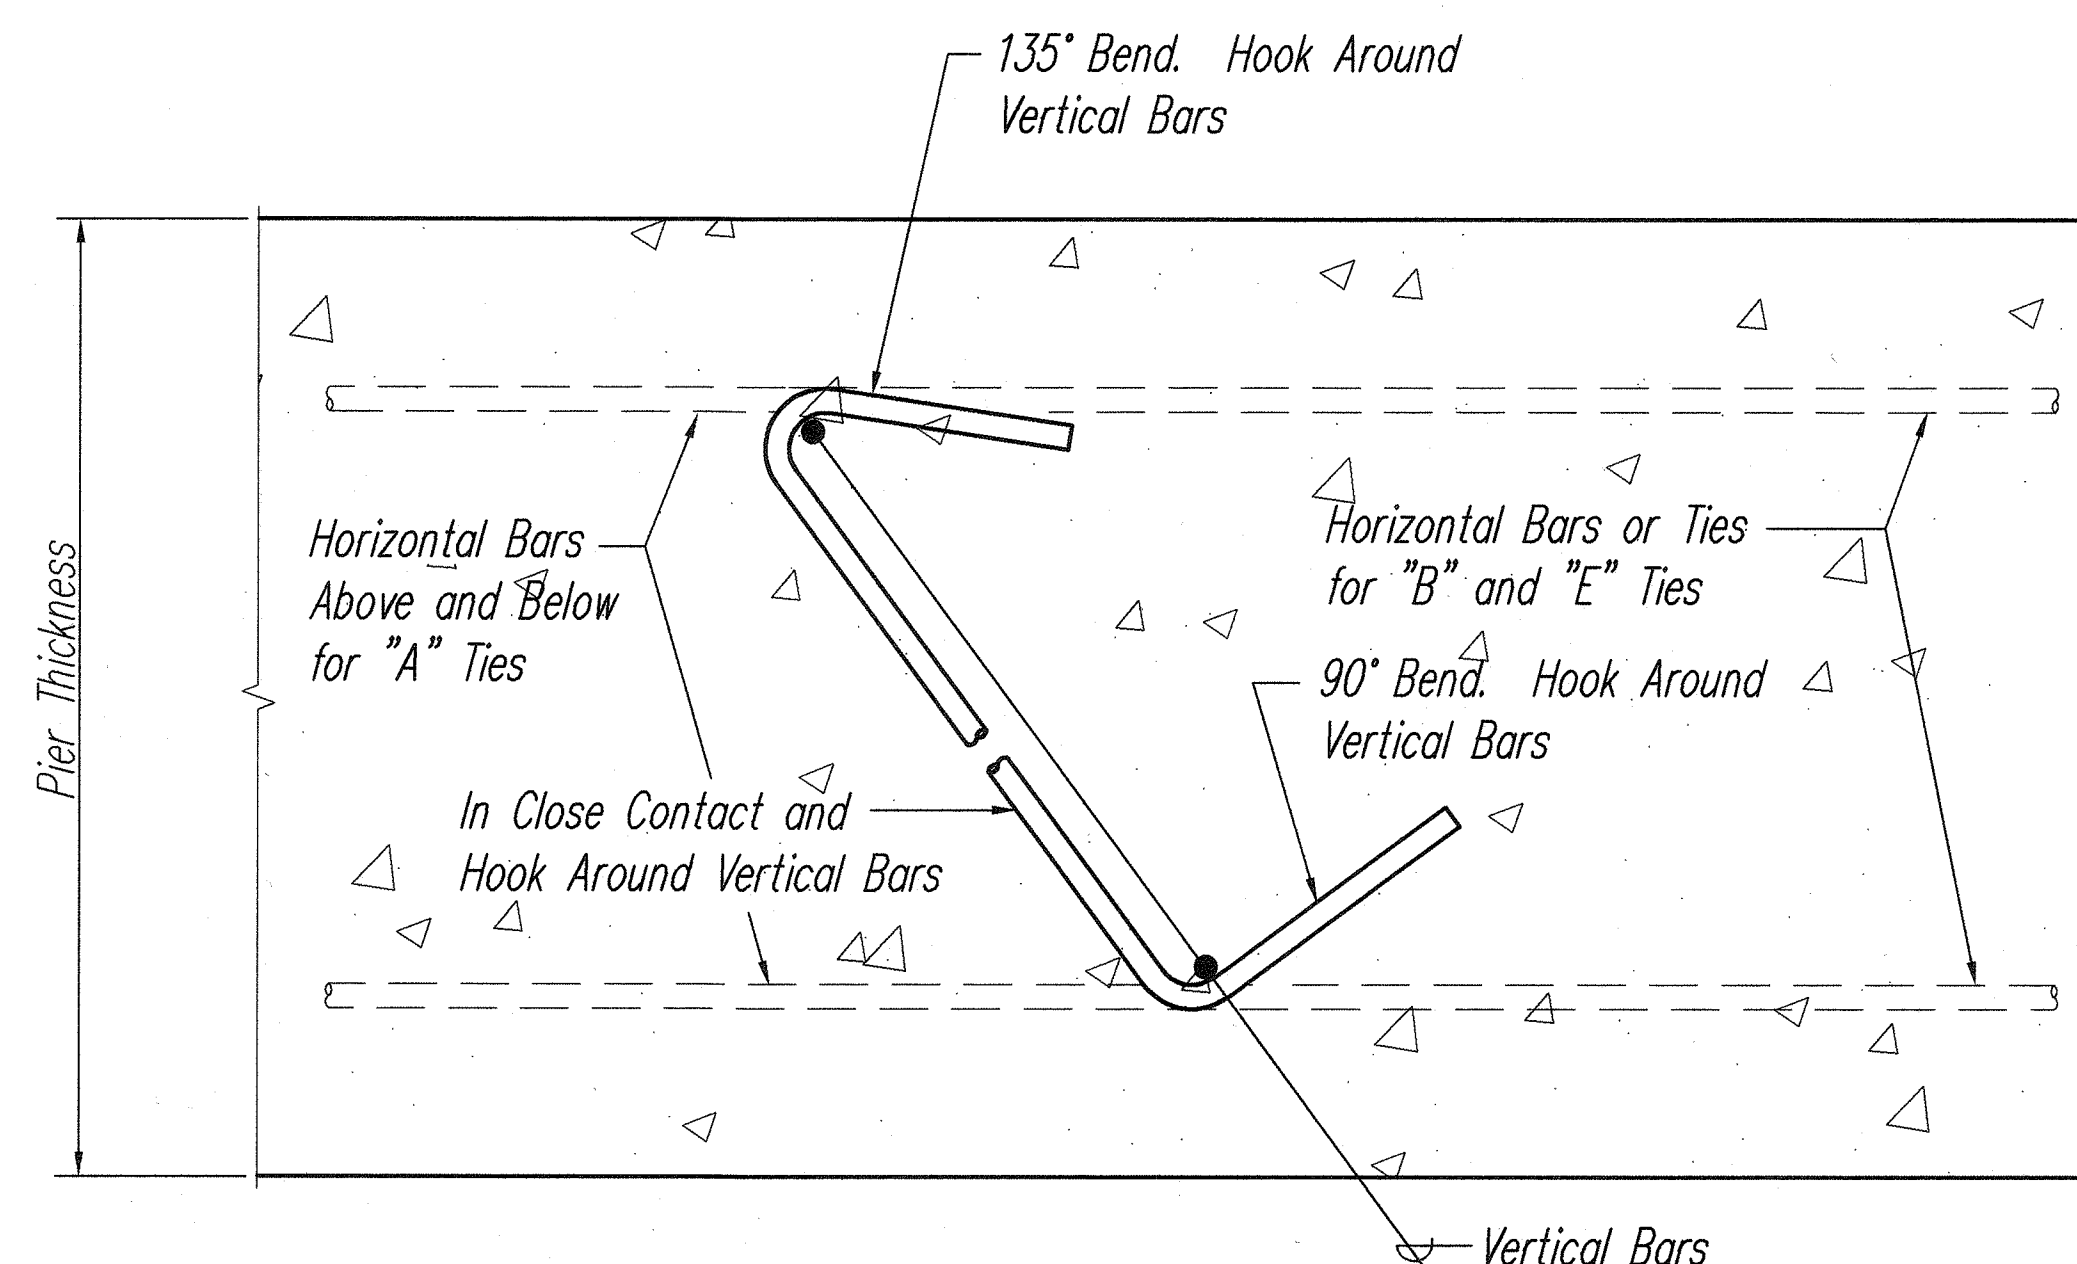

ORIGINAL PLAN	SURVEY PLOTTED BY	DATE
NOTE BOOK	DESIGNED BY KSE	NOV2000
	QUANTITIES BY	
	CHECKED BY	
No.		




David K. Fujiwara
THIS WORK WAS PREPARED BY
ME OR UNDER MY SUPERVISION.

STATE OF HAWAII
DEPARTMENT OF TRANSPORTATION
HIGHWAYS DIVISION


TYPICAL FOOTING REINFORCING PLAN

MAMALAHOA HIGHWAY
REPLACEMENT OF
KEAIWA STREAM BRIDGE
Federal Aid Project No. ER-12(1)R
Scale: As Shown Date: January 2001


SHEET No. S6.3 OF 50 SHEETS

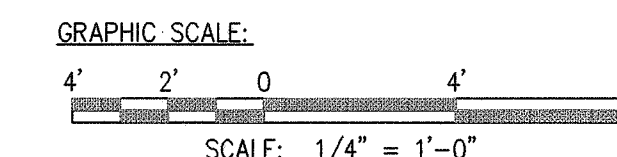


FED. ROAD DIST. NO.	STATE	FED. AID PROJ. NO.	FISCAL YEAR	SHEET NO.	TOTAL SHEETS
HAWAII	HAW.	ER-12(1)R	2001	48	77

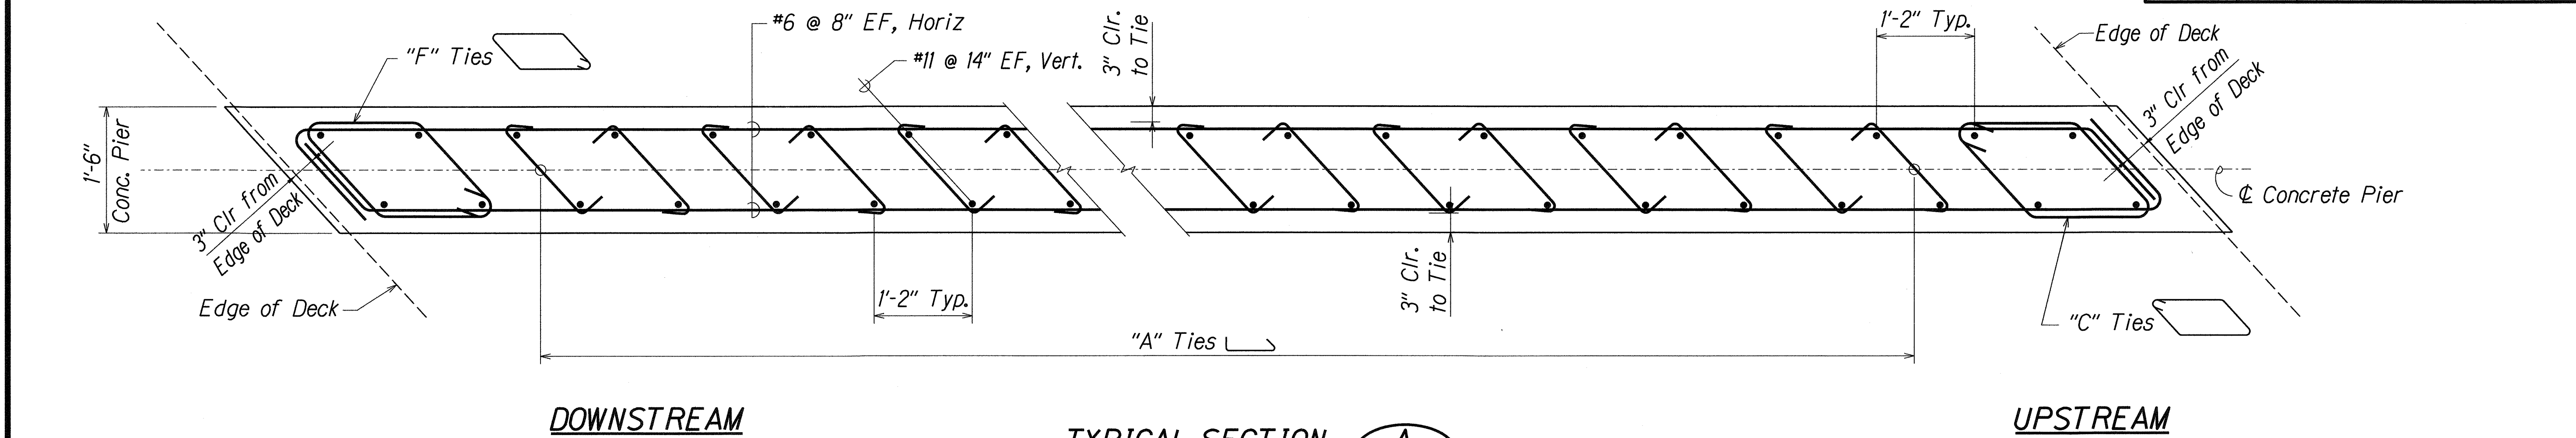



Note:
Splices Shall Not be Allowed for Vertical Rebars.

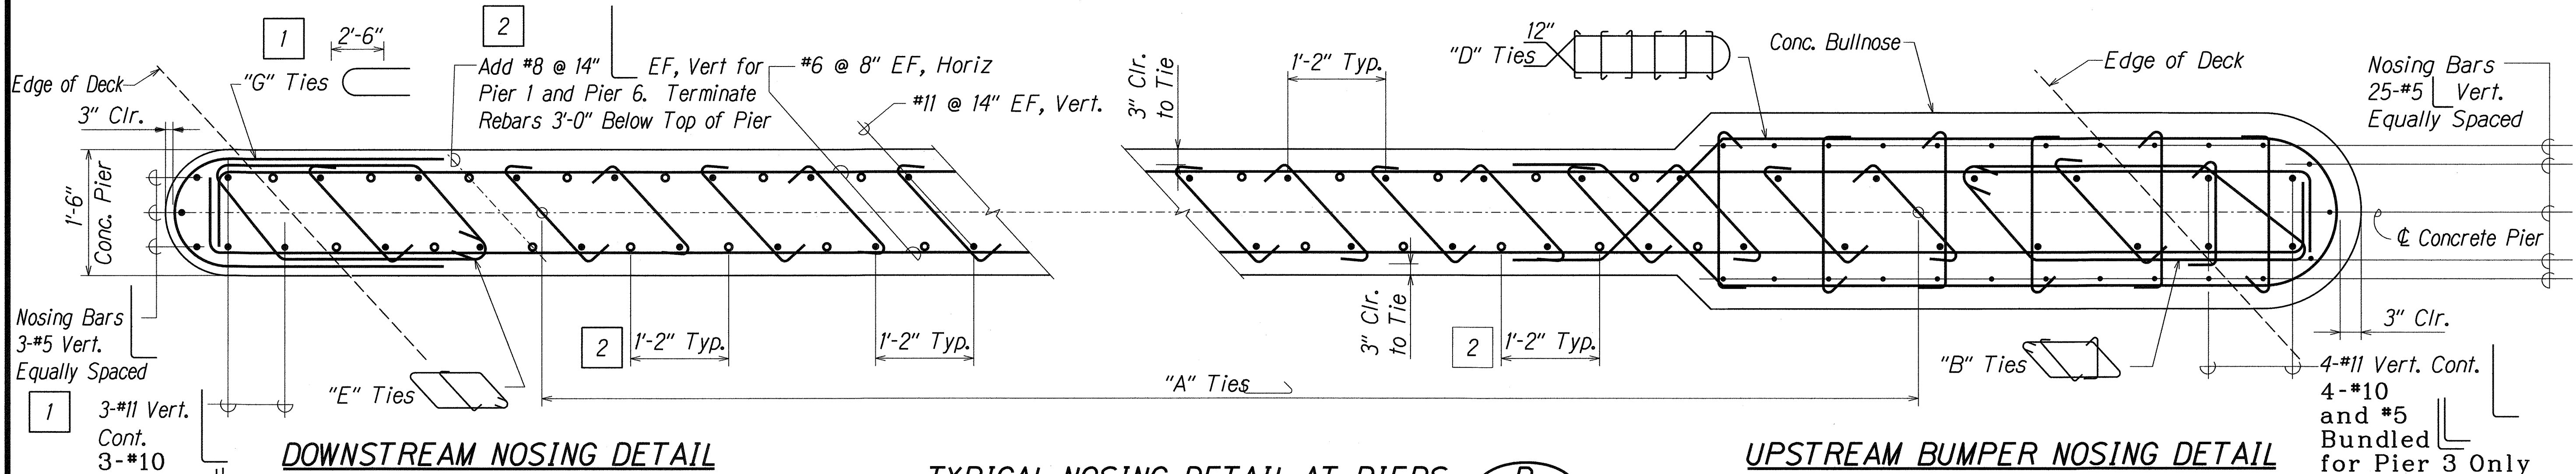

- Notes:
- Splices Shall Not be Allowed for Vertical Rebars.
 - Designates Added Vert. Reinf. for Piers 1 and 6 Only.

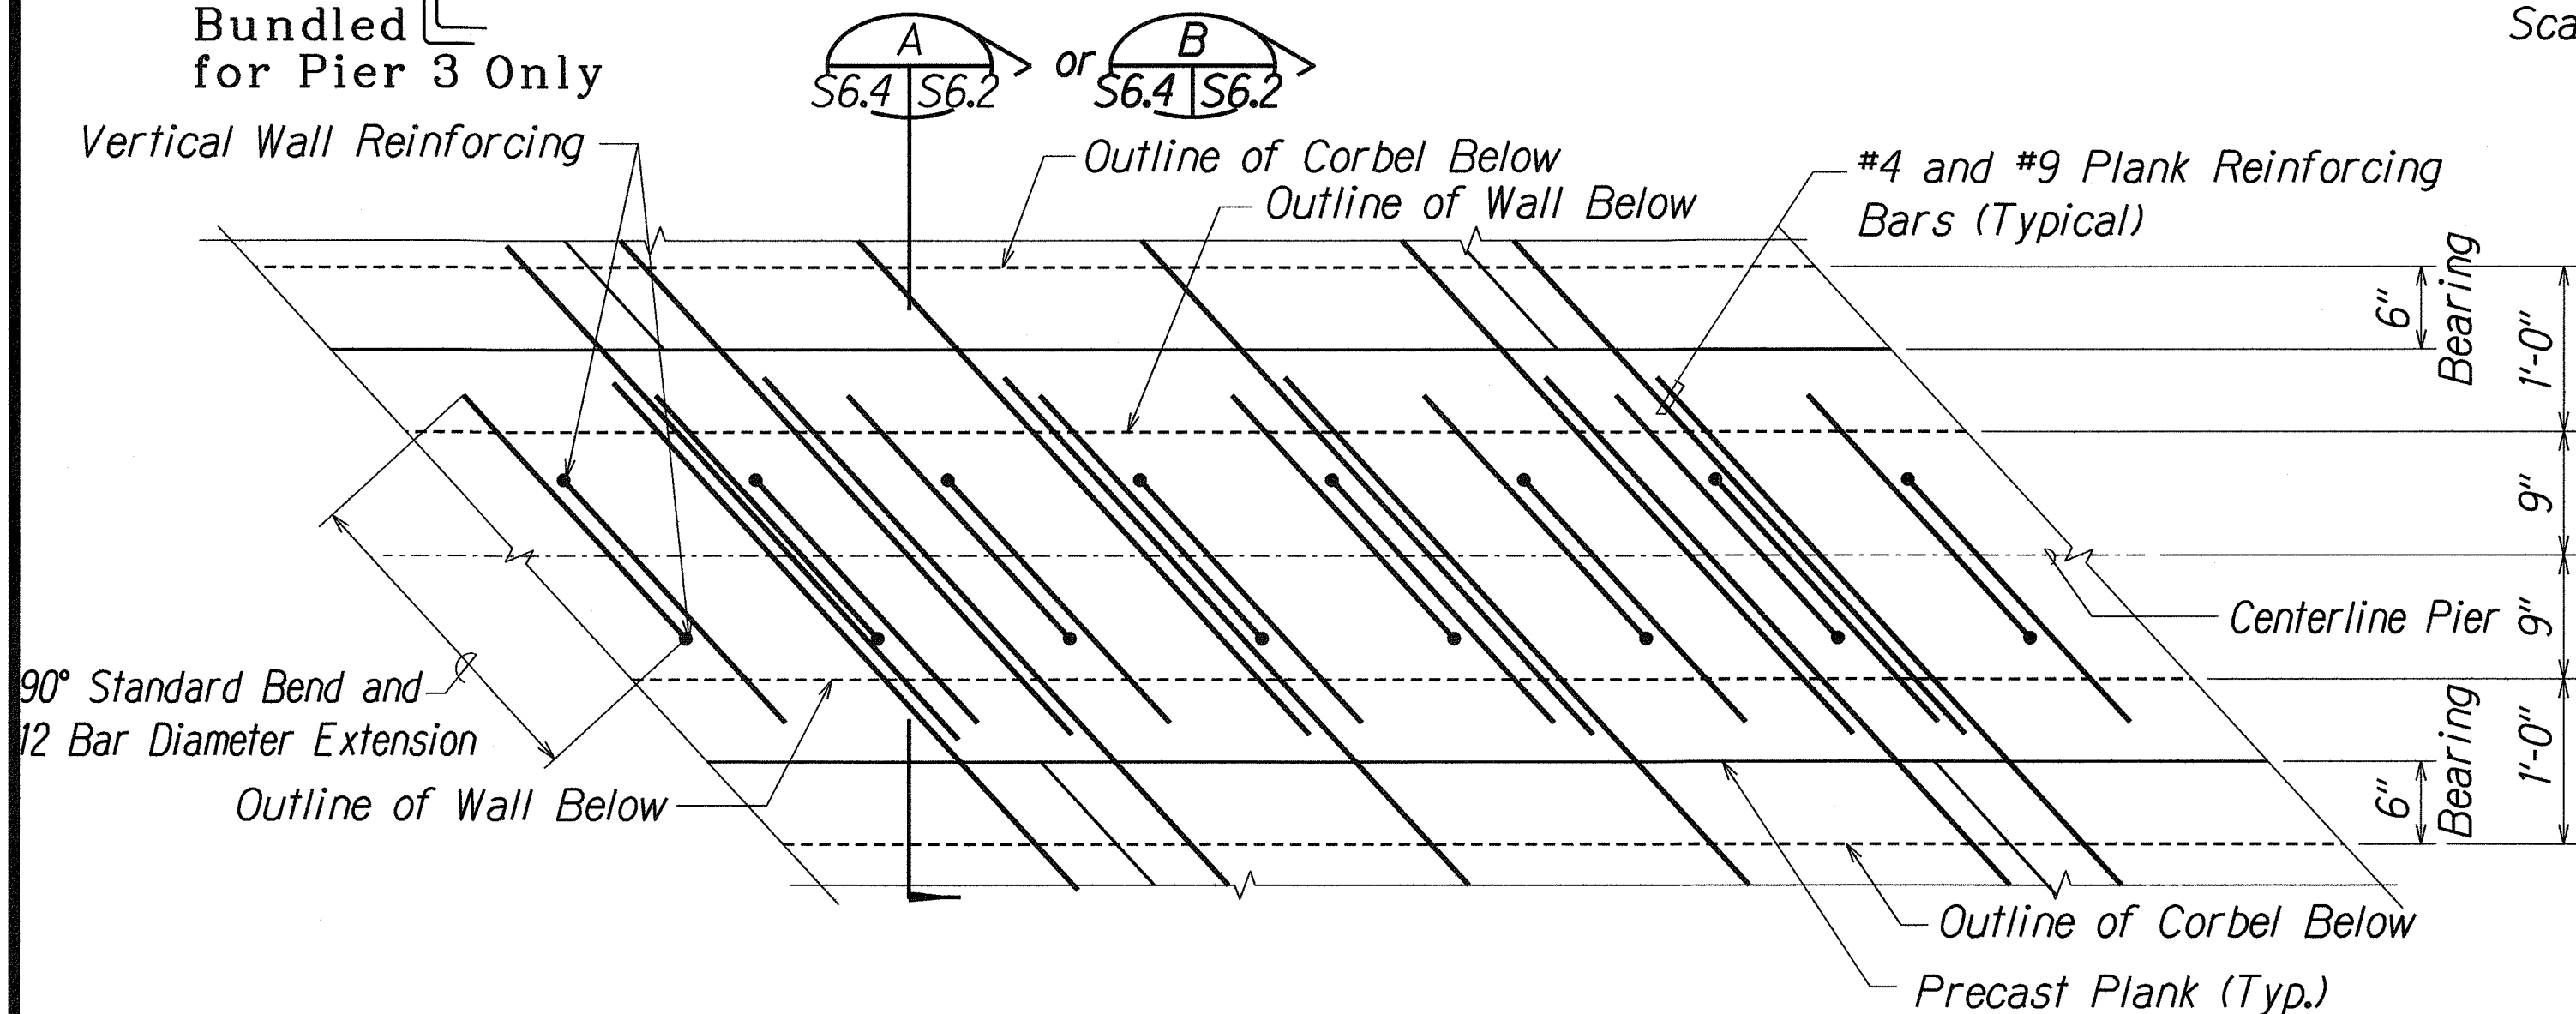

- Notes:
- Remaining Reinforcing Not Shown for Clarity
 - Contractor to Verify that There is No Conflict Between Vertical Wall Reinforcing and Plank Dowels

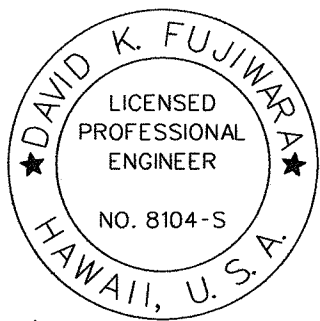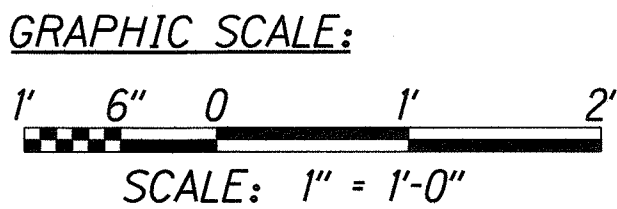


THIS WORK WAS PREPARED BY ME OR UNDER MY SUPERVISION.

LEGEND FOR AS-BUILT POSTINGS	
	Squiggly line for as-built deletion
	Double line for as-built deletion
	Text for as-built posting

DATE	REVISION
02-15-07	As Built - Revised Detail
01-29-01	1 Added "G" Ties and Nosing Bars at Downstream End
	2 Added Vert. Reinf. for Piers 1 and 6 Only


STATE OF HAWAII DEPARTMENT OF TRANSPORTATION HIGHWAYS DIVISION	
TYPICAL PIER DETAILS AND SECTION AT PIERS 1, 2, 5 AND 6	
MAMALAHOA HIGHWAY REPLACEMENT OF KEATWA STREAM BRIDGE Federal-Aid Project No. ER-12(1)R	
Scale: As Shown	Date: January 2001
SHEET No. S6.4 OF 50 SHEETS	

FED. ROAD DIST. NO.	STATE	FED. AID PROJ. NO.	FISCAL YEAR	SHEET NO.	TOTAL SHEETS
HAWAII	HAW.	ER-12(1)R	2001	-	77

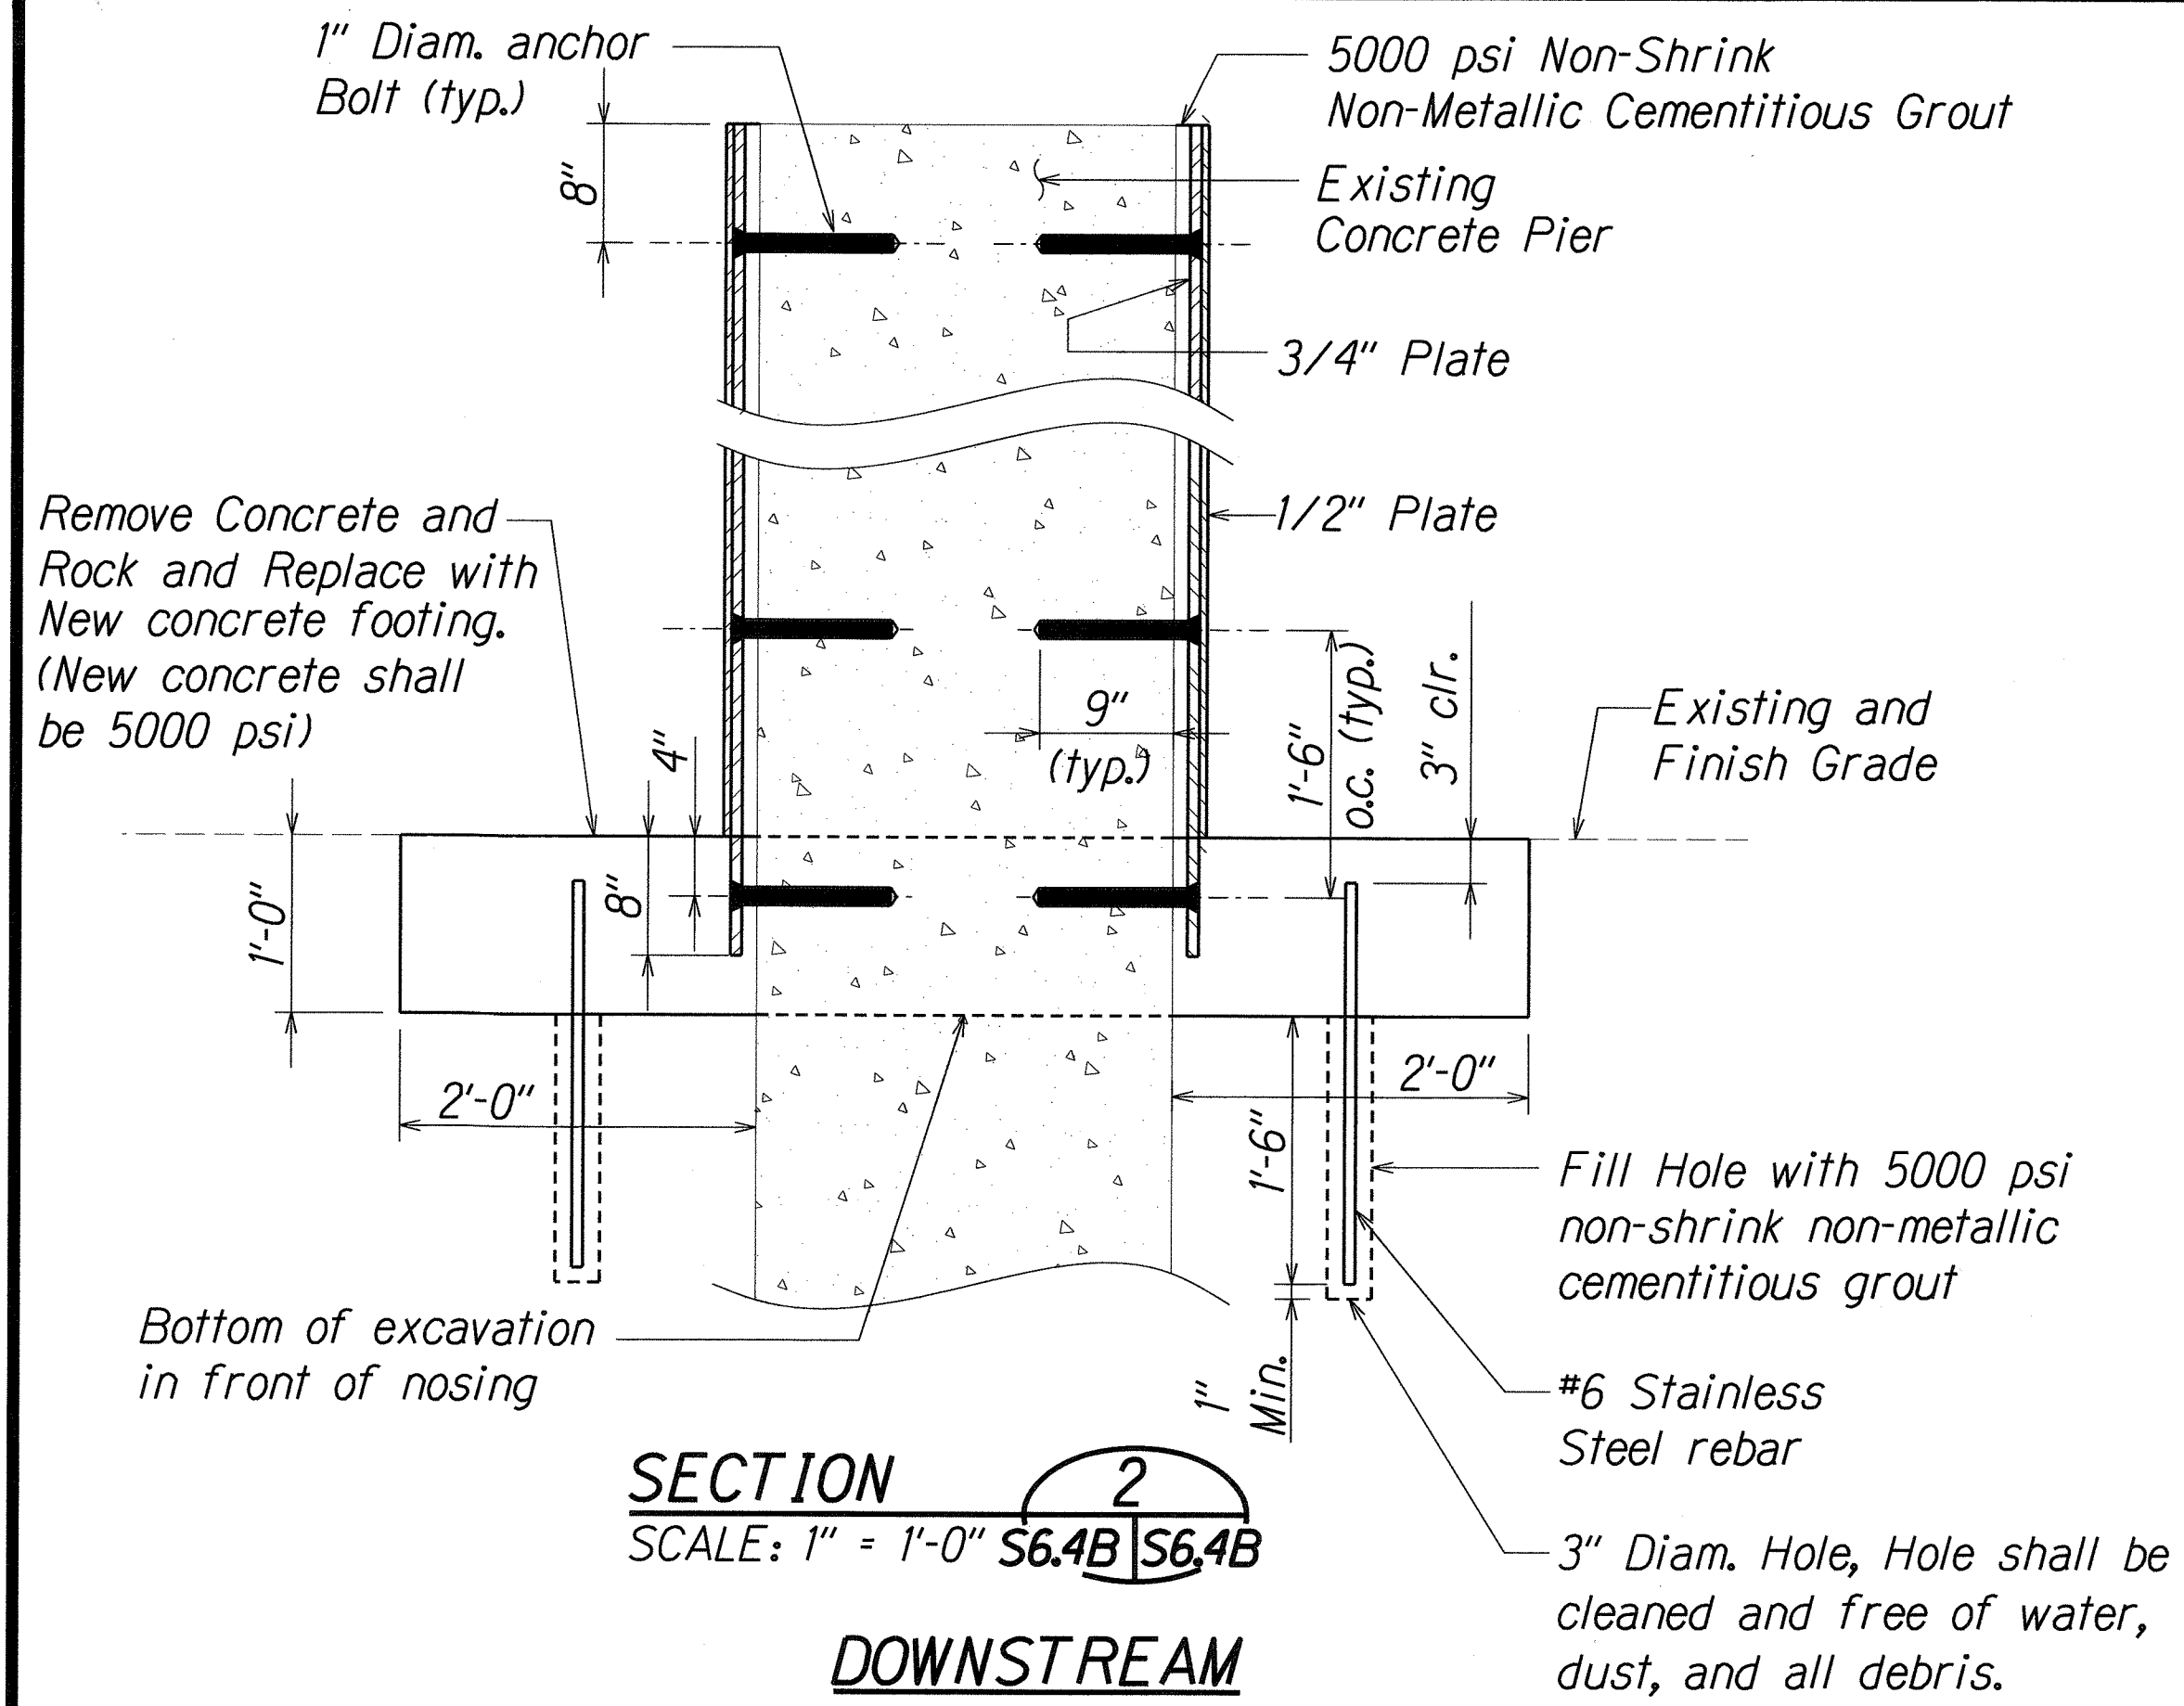

DOWNSTREAM NOSING DETAIL

TYPICAL NOSING DETAIL AT PIER 3 THRU 6
SCALE: 1" = 1'-0"

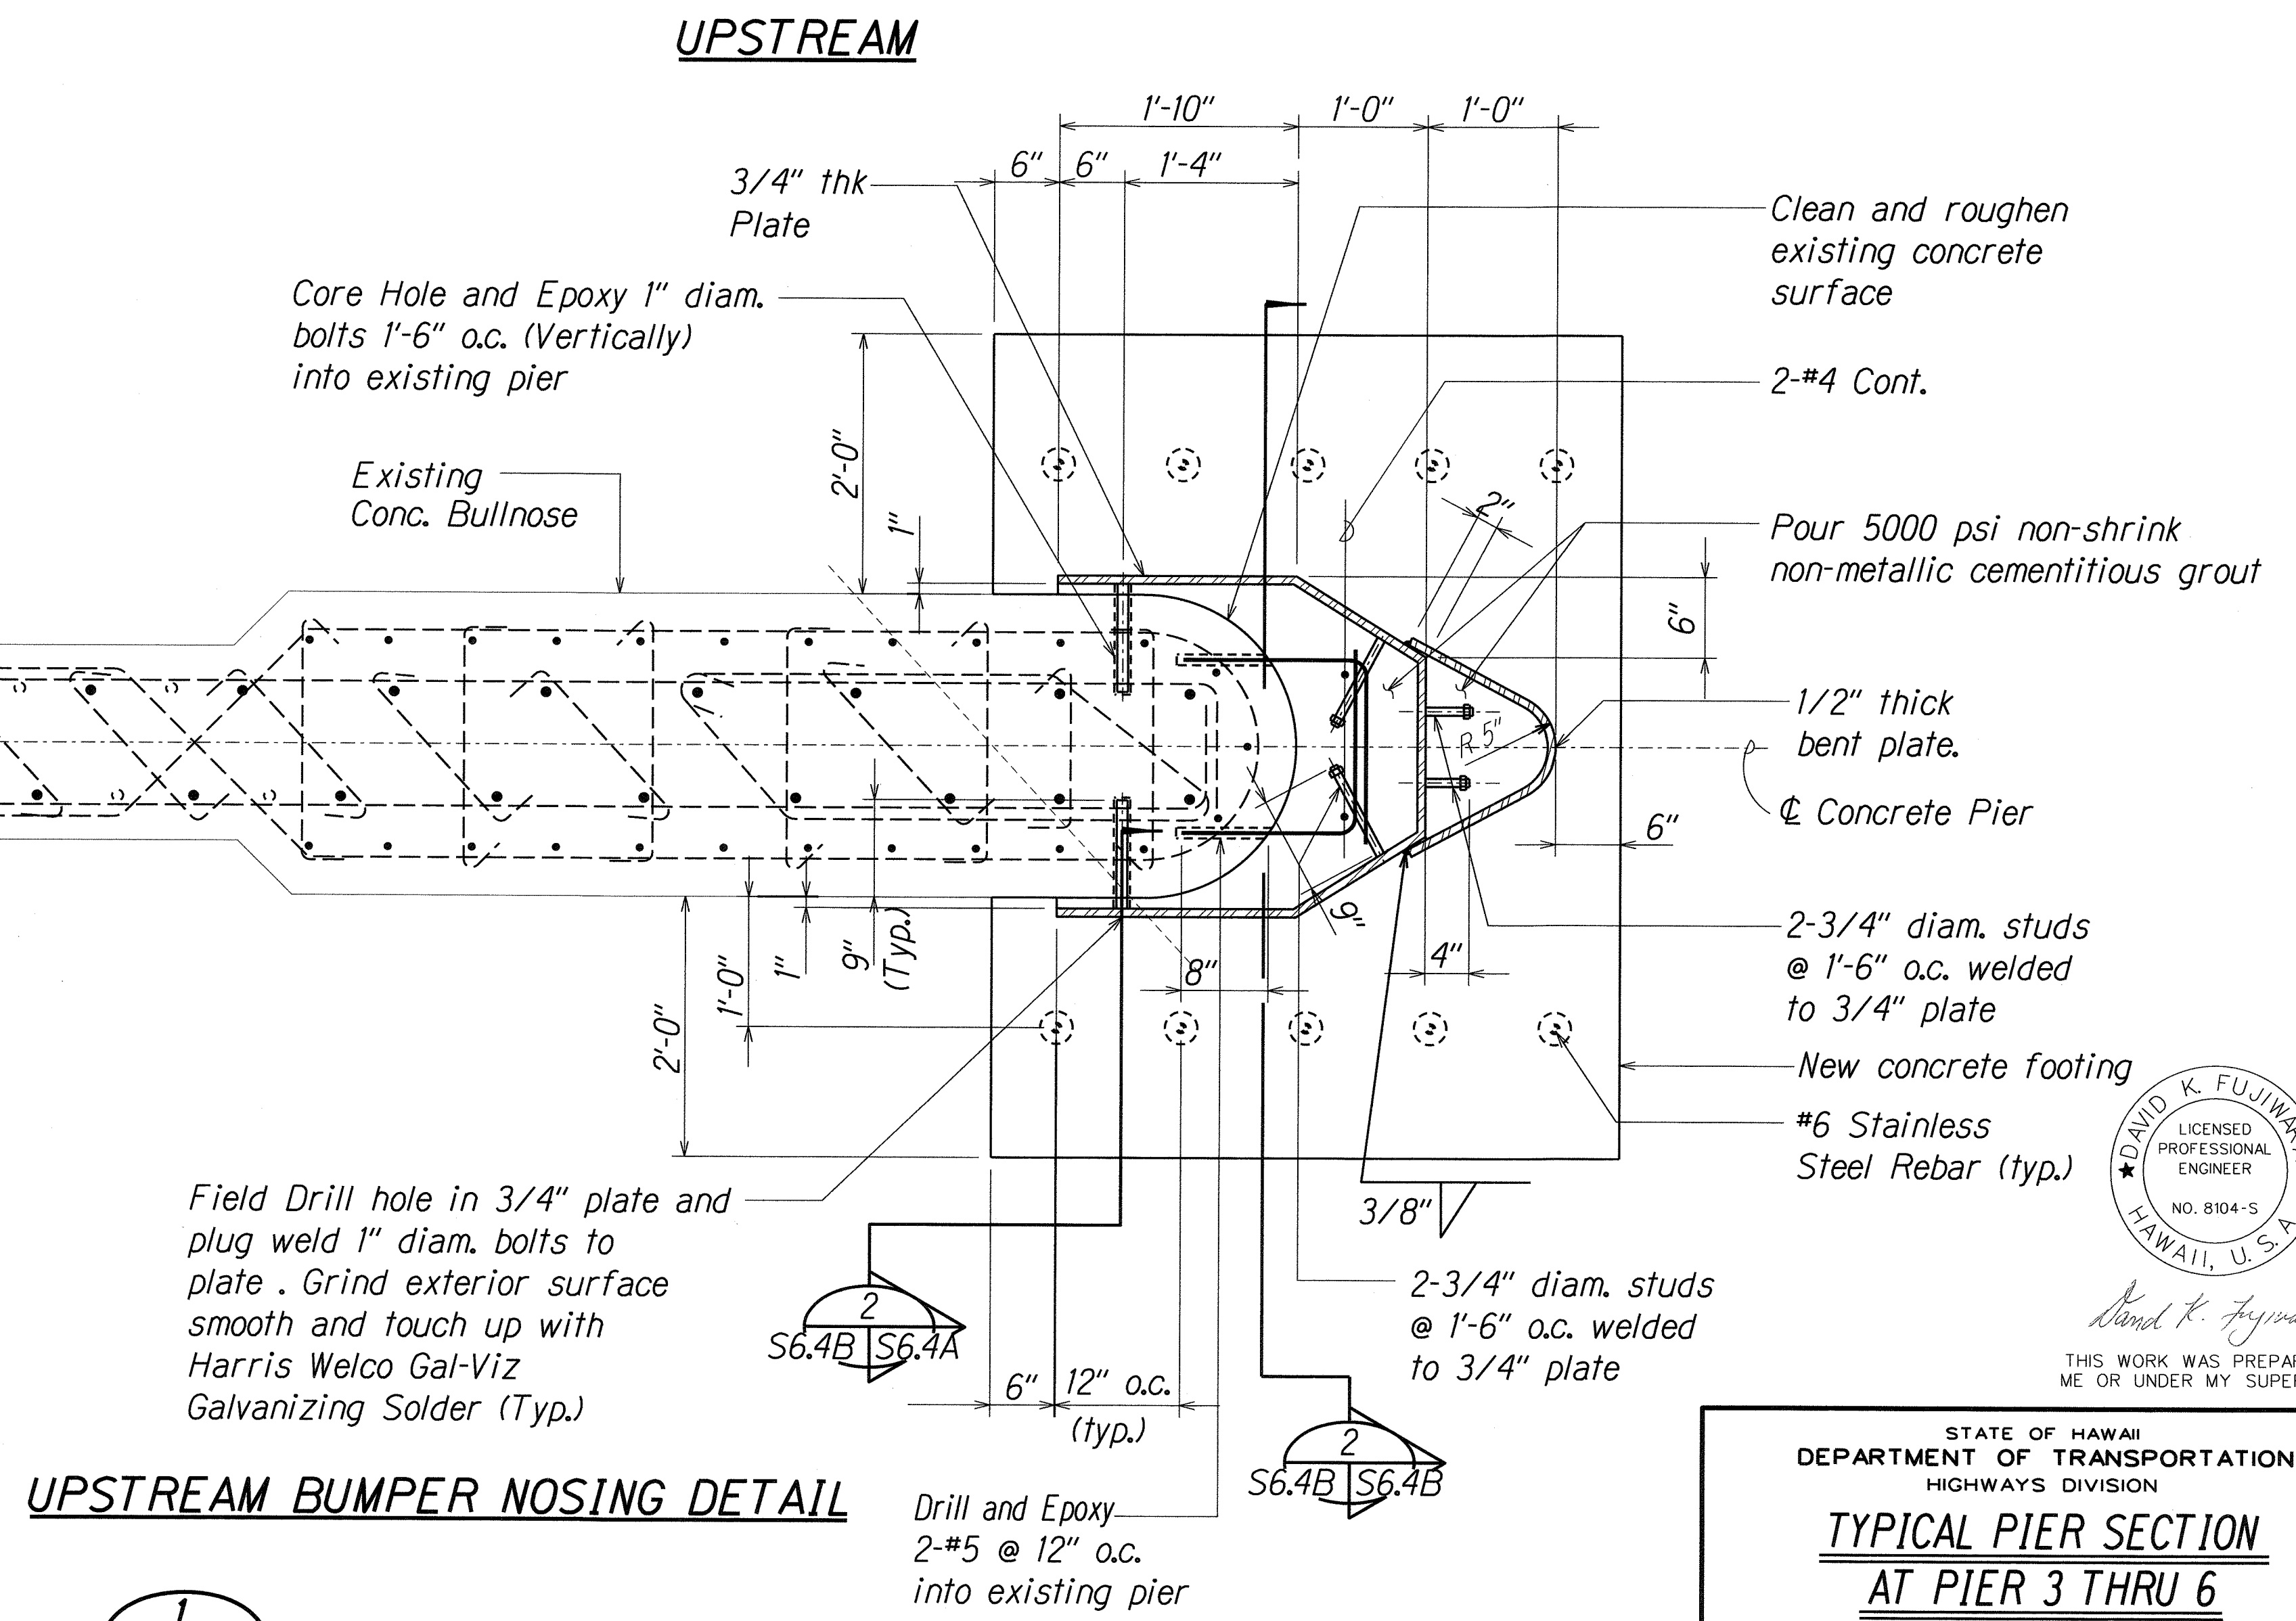


STATE OF HAWAII
DEPARTMENT OF TRANSPORTATION
HIGHWAYS DIVISION

**TYPICAL PIER SECTION
AT PIER 3 THRU 6**

**MAMALAHOA HIGHWAY
REPLACEMENT OF
KEAWA STREAM BRIDGE**
Federal Aid Project No. ER-12(1)R

Scale: As Shown Date: January 2001


SHEET No. S6.4BOF 50 SHEETS

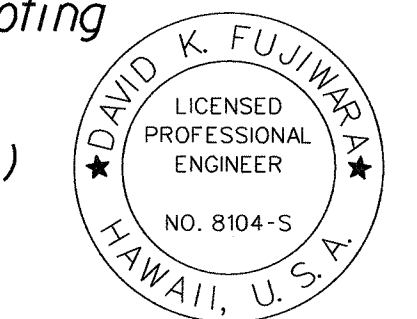

THIS WORK WAS PREPARED BY ME OR UNDER MY SUPERVISION.


SURVEY PLOTTED BY	DATE
DRAWN BY	APR 02
TRACED BY	
CHECKED BY	
ORIGINAL PLAN	
NOTE BOOK	
CHECKED BY	

FED. ROAD DIST. NO.	STATE	FED. AID PROJ. NO.	FISCAL YEAR	SHEET NO.	TOTAL SHEETS
HAWAII	HAW.	ER-12(1)R	2001	49	77

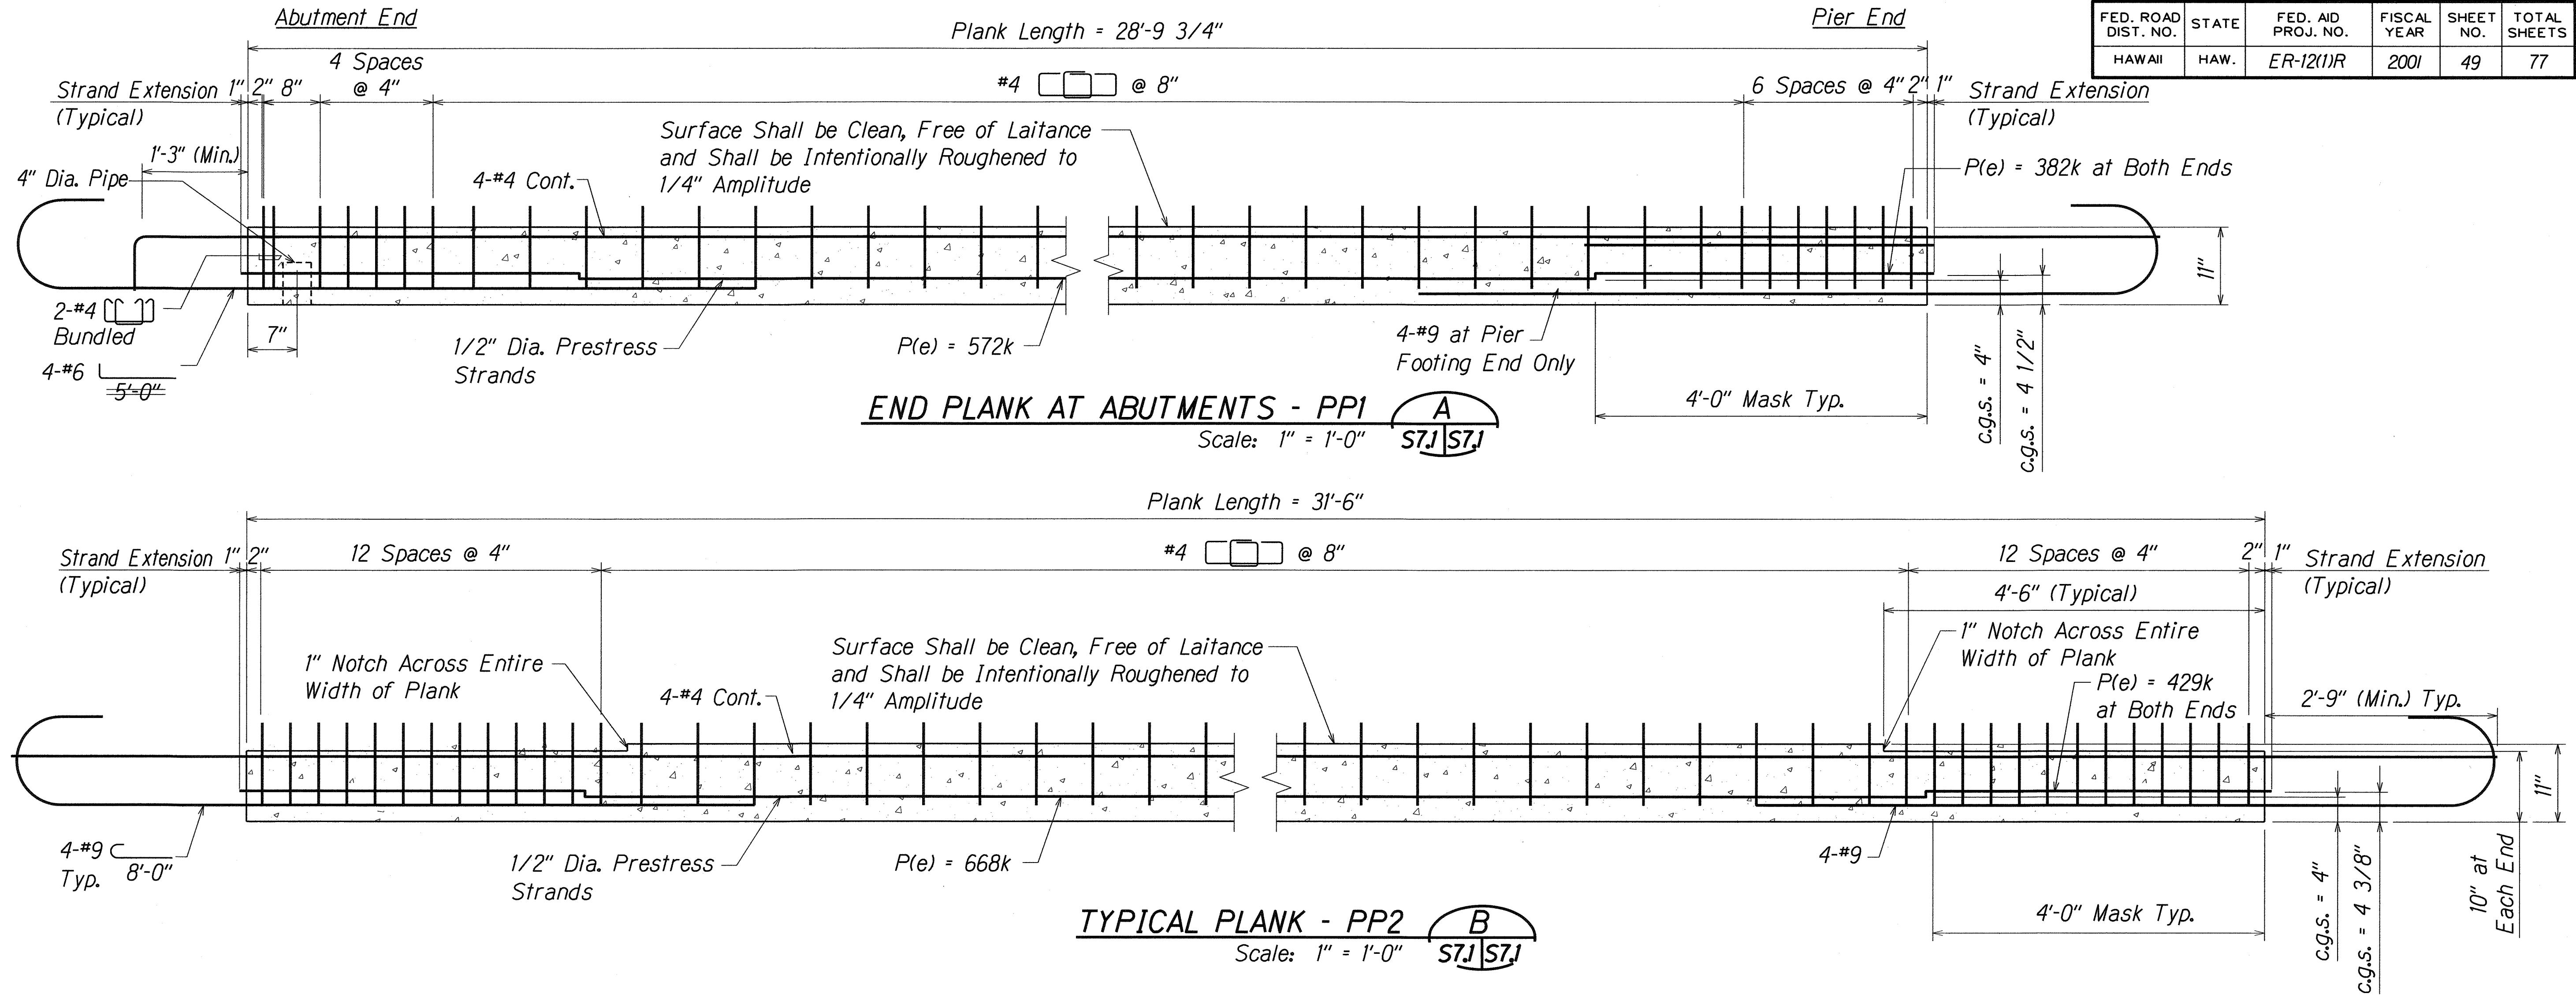


PRESTRESSED PLANK NOTES

- Prestressed concrete 28 day strength $f'_c = 7,000$ PSI. Prestressed concrete strength at time of release $f_{ci} = 4,500$ PSI.
- Pretensioned strands shall be 7 wire $\frac{1}{2}$ " ϕ low relaxation steel strands (Area = 0.153 in²) with an ultimate tensile strength of 270 KSI. For properties, see "State Standard Specifications."
- Non-prestressed reinforcing steel shall be grade 60. For properties, see "State Standard Specifications."
- Strand pattern shall be symmetrical about the longitudinal ϕ of the plank.
- Strand release sequence shall not induce any lateral deflection of the plank.
- Contractor shall submit shop drawings indicating proposed strand pattern, releasing sequence, reinforcing details & hold down device details to the Engineer prior to fabrication.
- During curing, care shall be taken to avoid any lateral deflection of the plank due to improper orientation. Steam curing may be used to accelerate strength gain.
- Lifting devices shall be placed as close as possible to the centerline of bearings of the plank. Details and locations of lifting devices shall be submitted to the Engineer for approval. Such approval does not relieve the Contractor of his responsibilities if beam is damaged due to failure of the lifting device.
- See Sheet S3.1 for location of plank mark numbers.

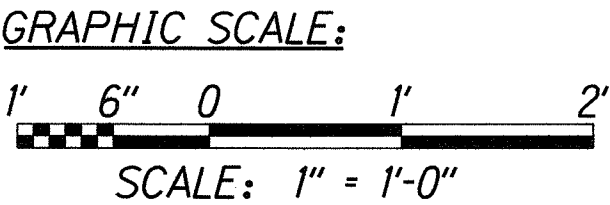

LEGEND FOR AS-BUILT POSTINGS	
	Squiggly line for as-built deletion
	Double line for as-built deletion
Roadway	Text for as-built posting


02-15-07	As Built - Added Note
DATE	REVISION
STATE OF HAWAII DEPARTMENT OF TRANSPORTATION HIGHWAYS DIVISION	
PRECAST PLANK SECTION AND DETAILS	
MAMALAHOA HIGHWAY REPLACEMENT OF KEATWA STREAM BRIDGE Federal-Aid Project No. ER-12(1)R	
Scale: As Shown	Date: January 2001
SHEET No. 57.1 OF 50 SHEETS	

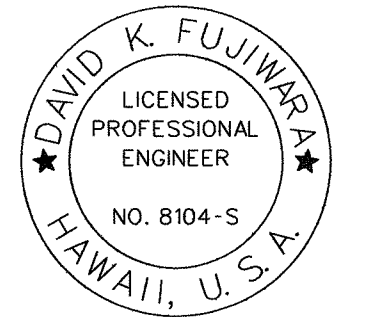







THIS WORK WAS PREPARED BY ME OR UNDER MY SUPERVISION.

ORIGINAL PLAN	DATE: DEC 2000
DESIGNED BY: KSF	
CHECKED BY: KSF	
QUANTITIES BY: KSF	



FED. ROAD DIST. NO.	STATE	FED. AID PROJ. NO.	FISCAL YEAR	SHEET NO.	TOTAL SHEETS
HAWAII	HAW.	ER-12(1)R	2001	50	77

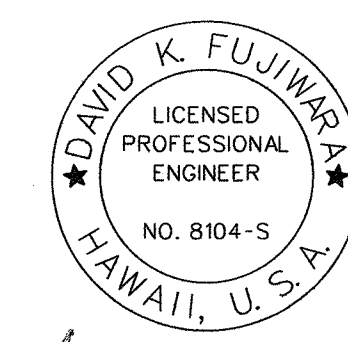

THIS WORK WAS PREPARED BY ME OR UNDER MY SUPERVISION.

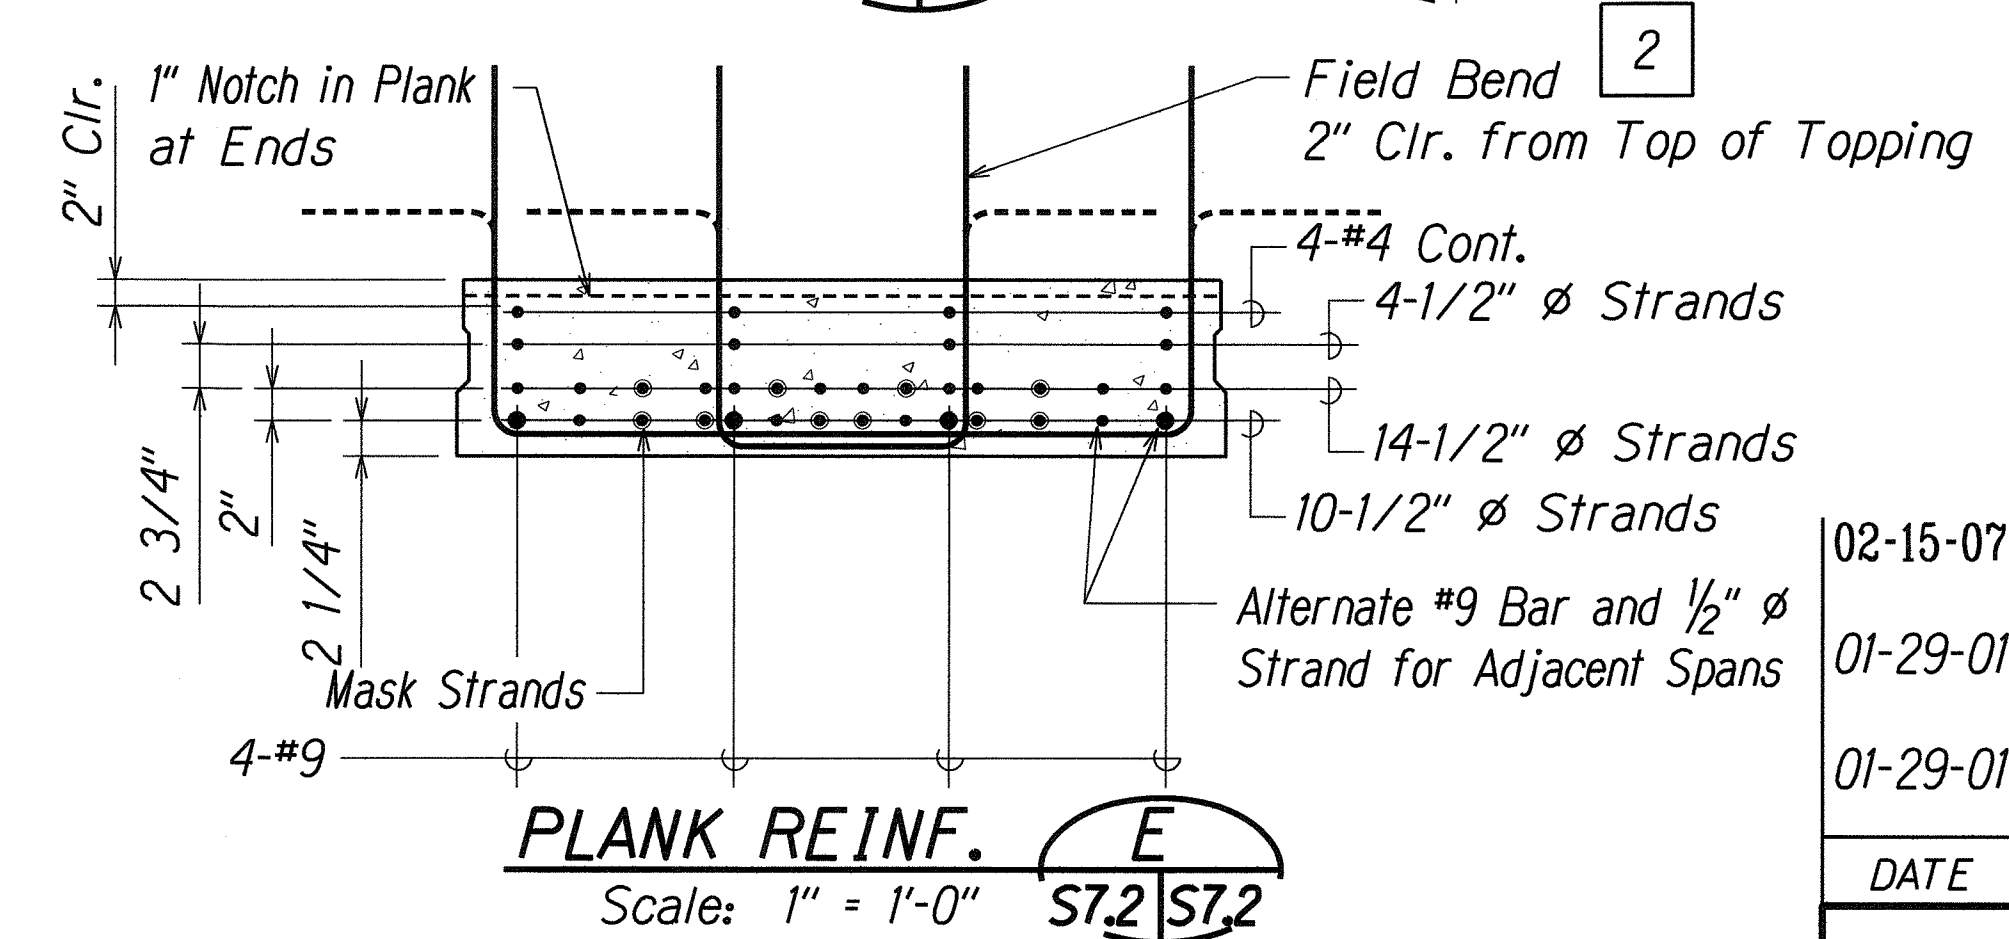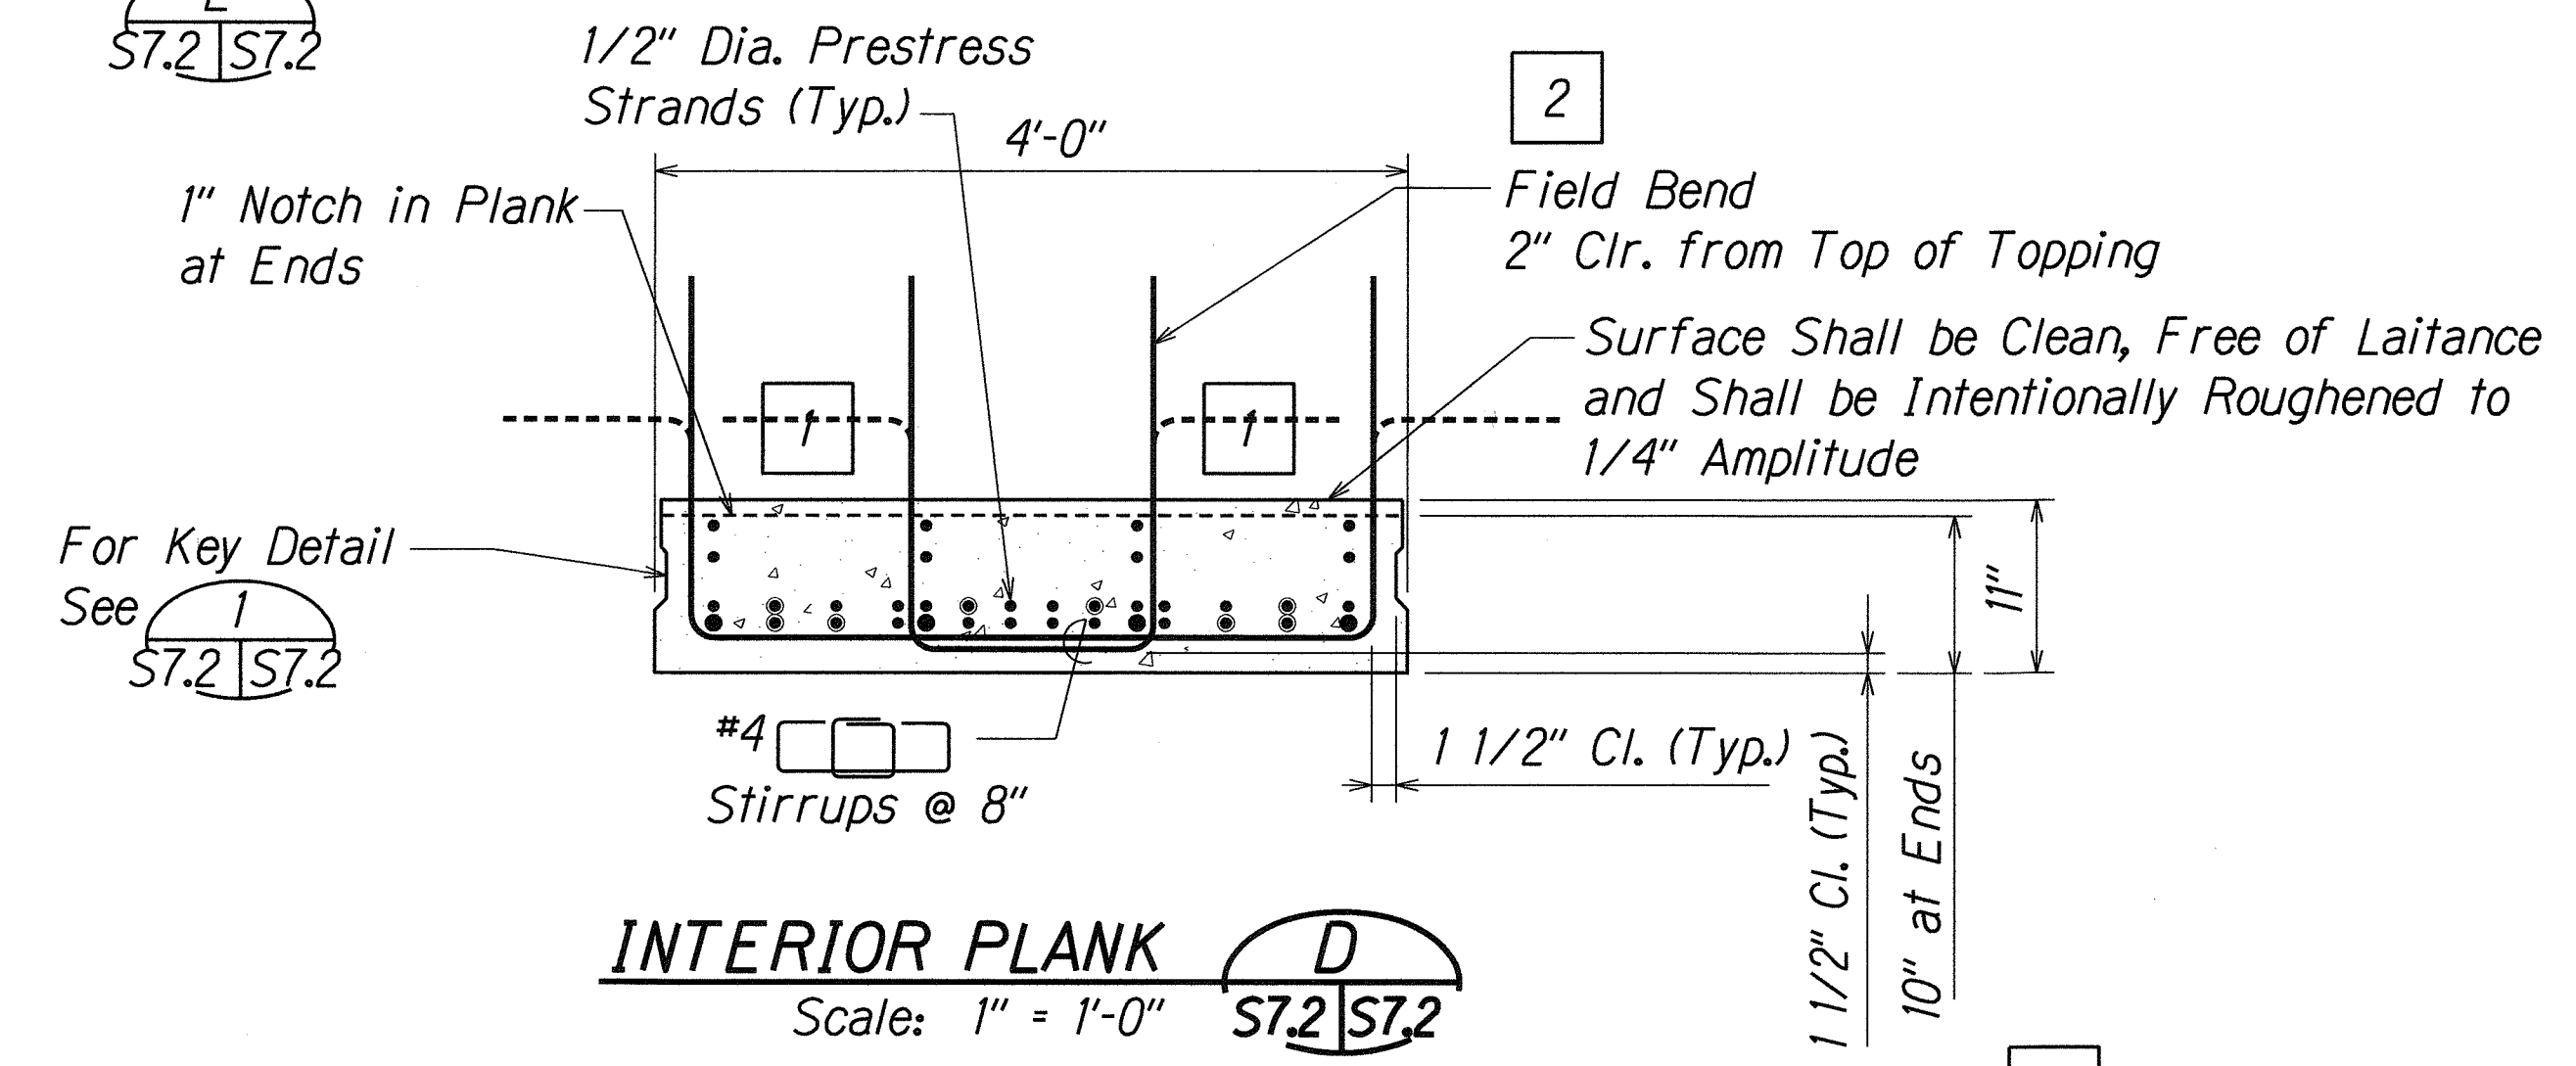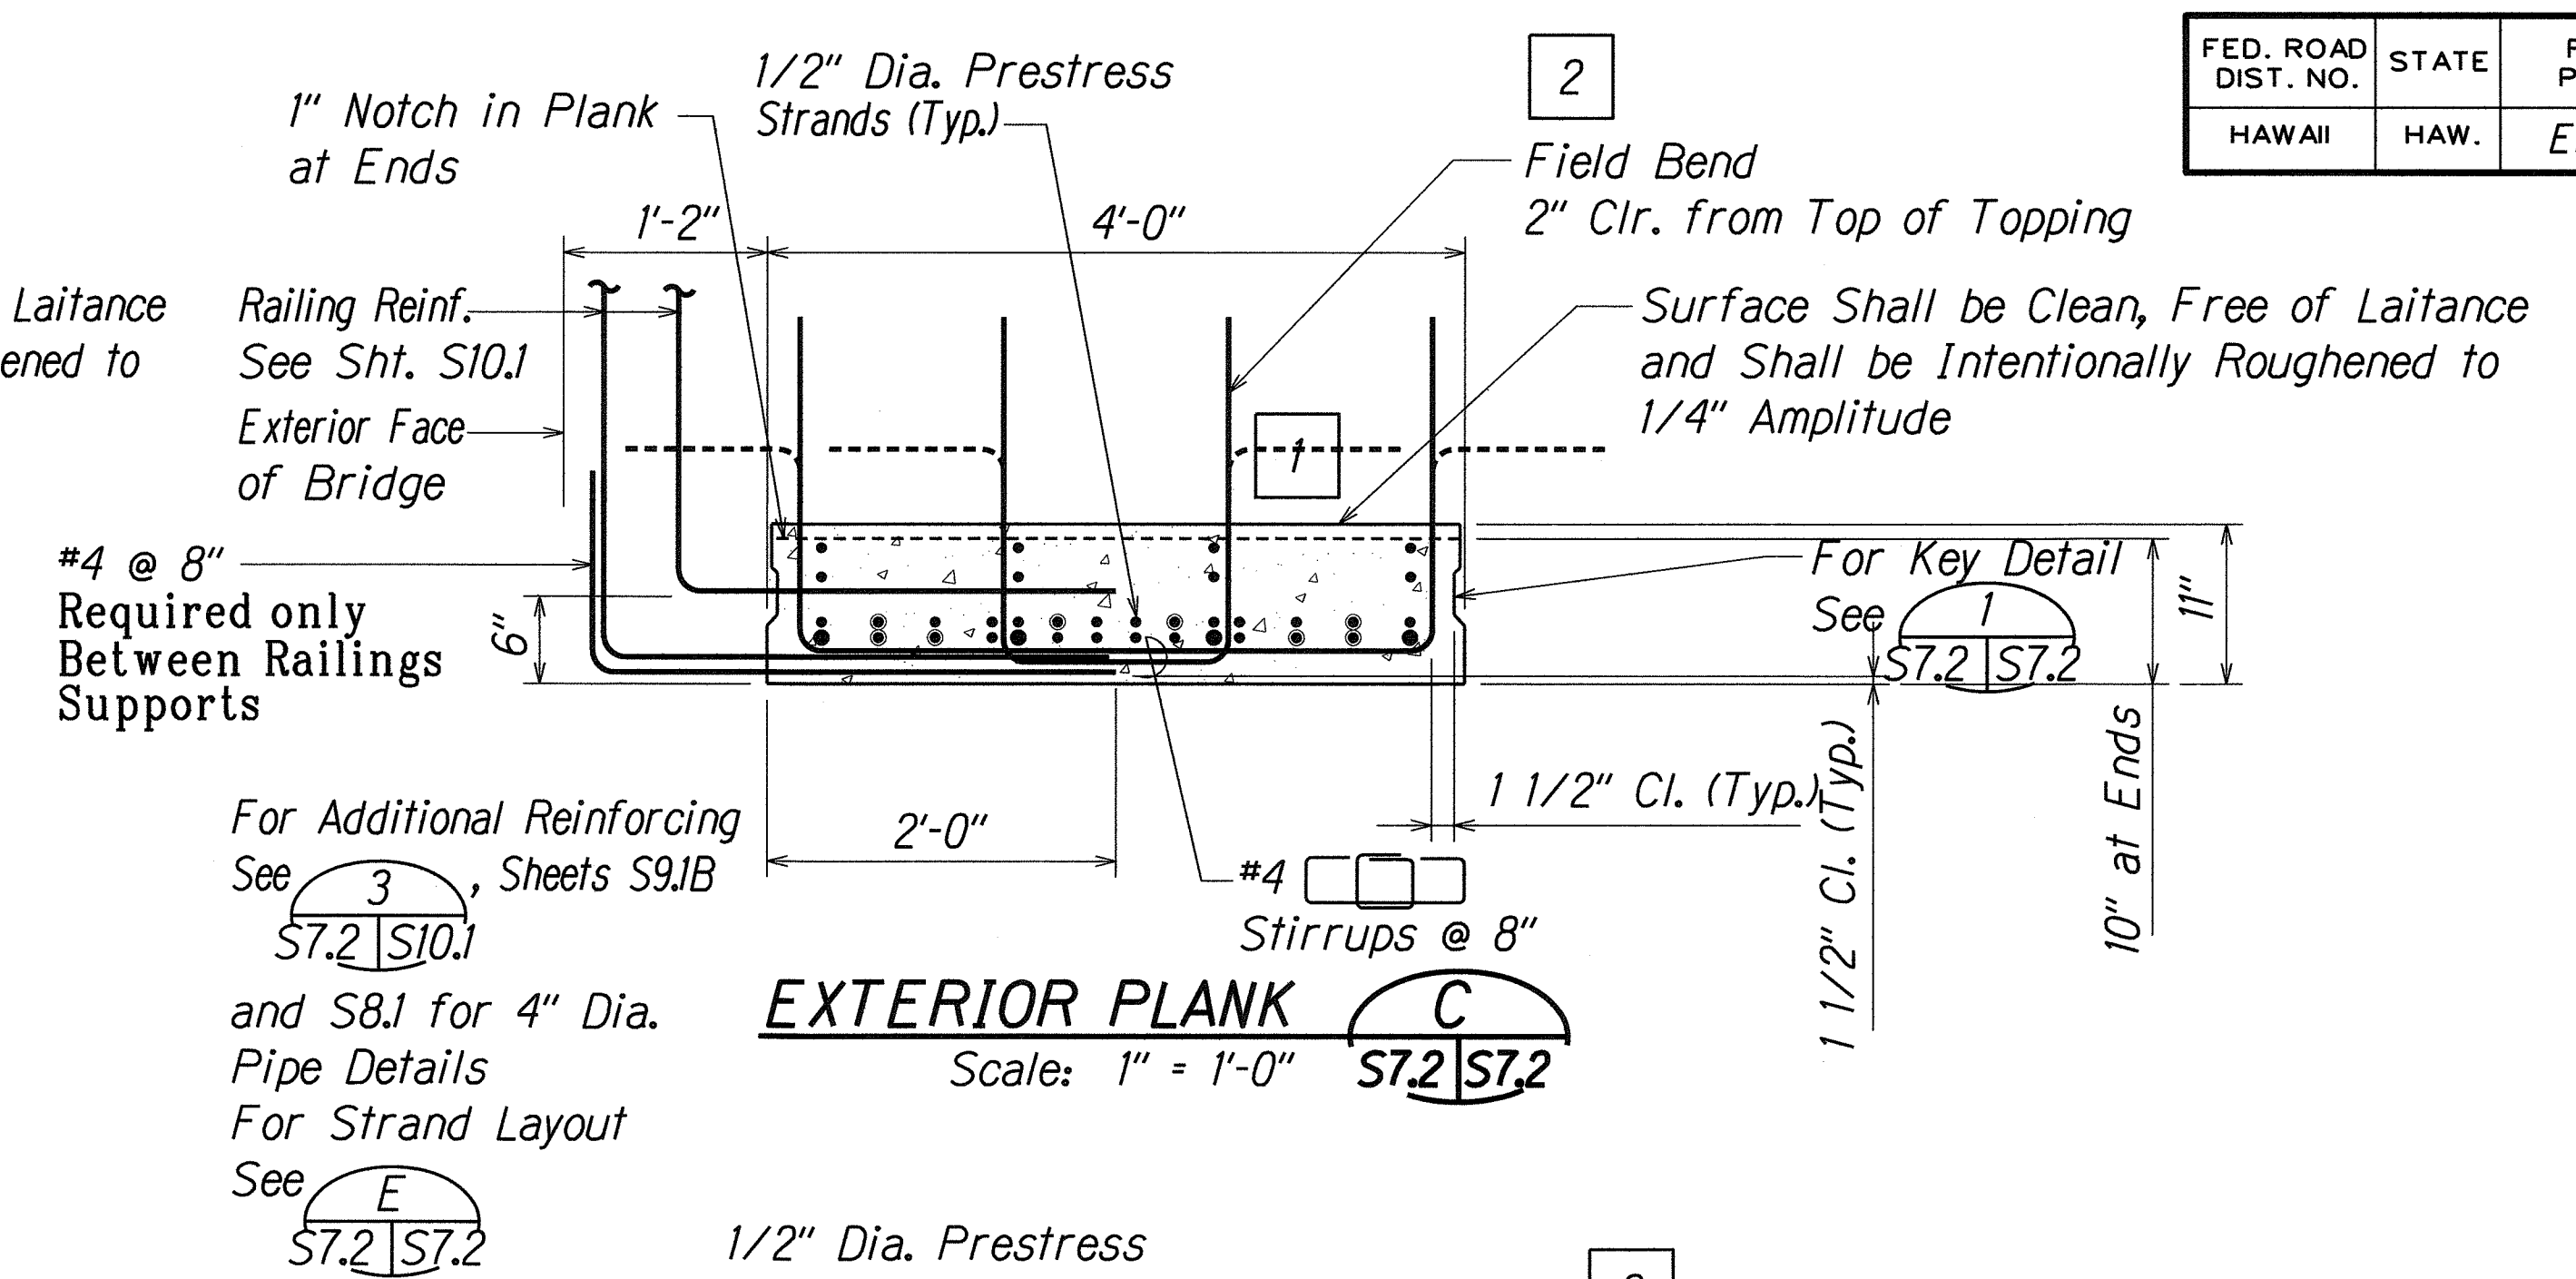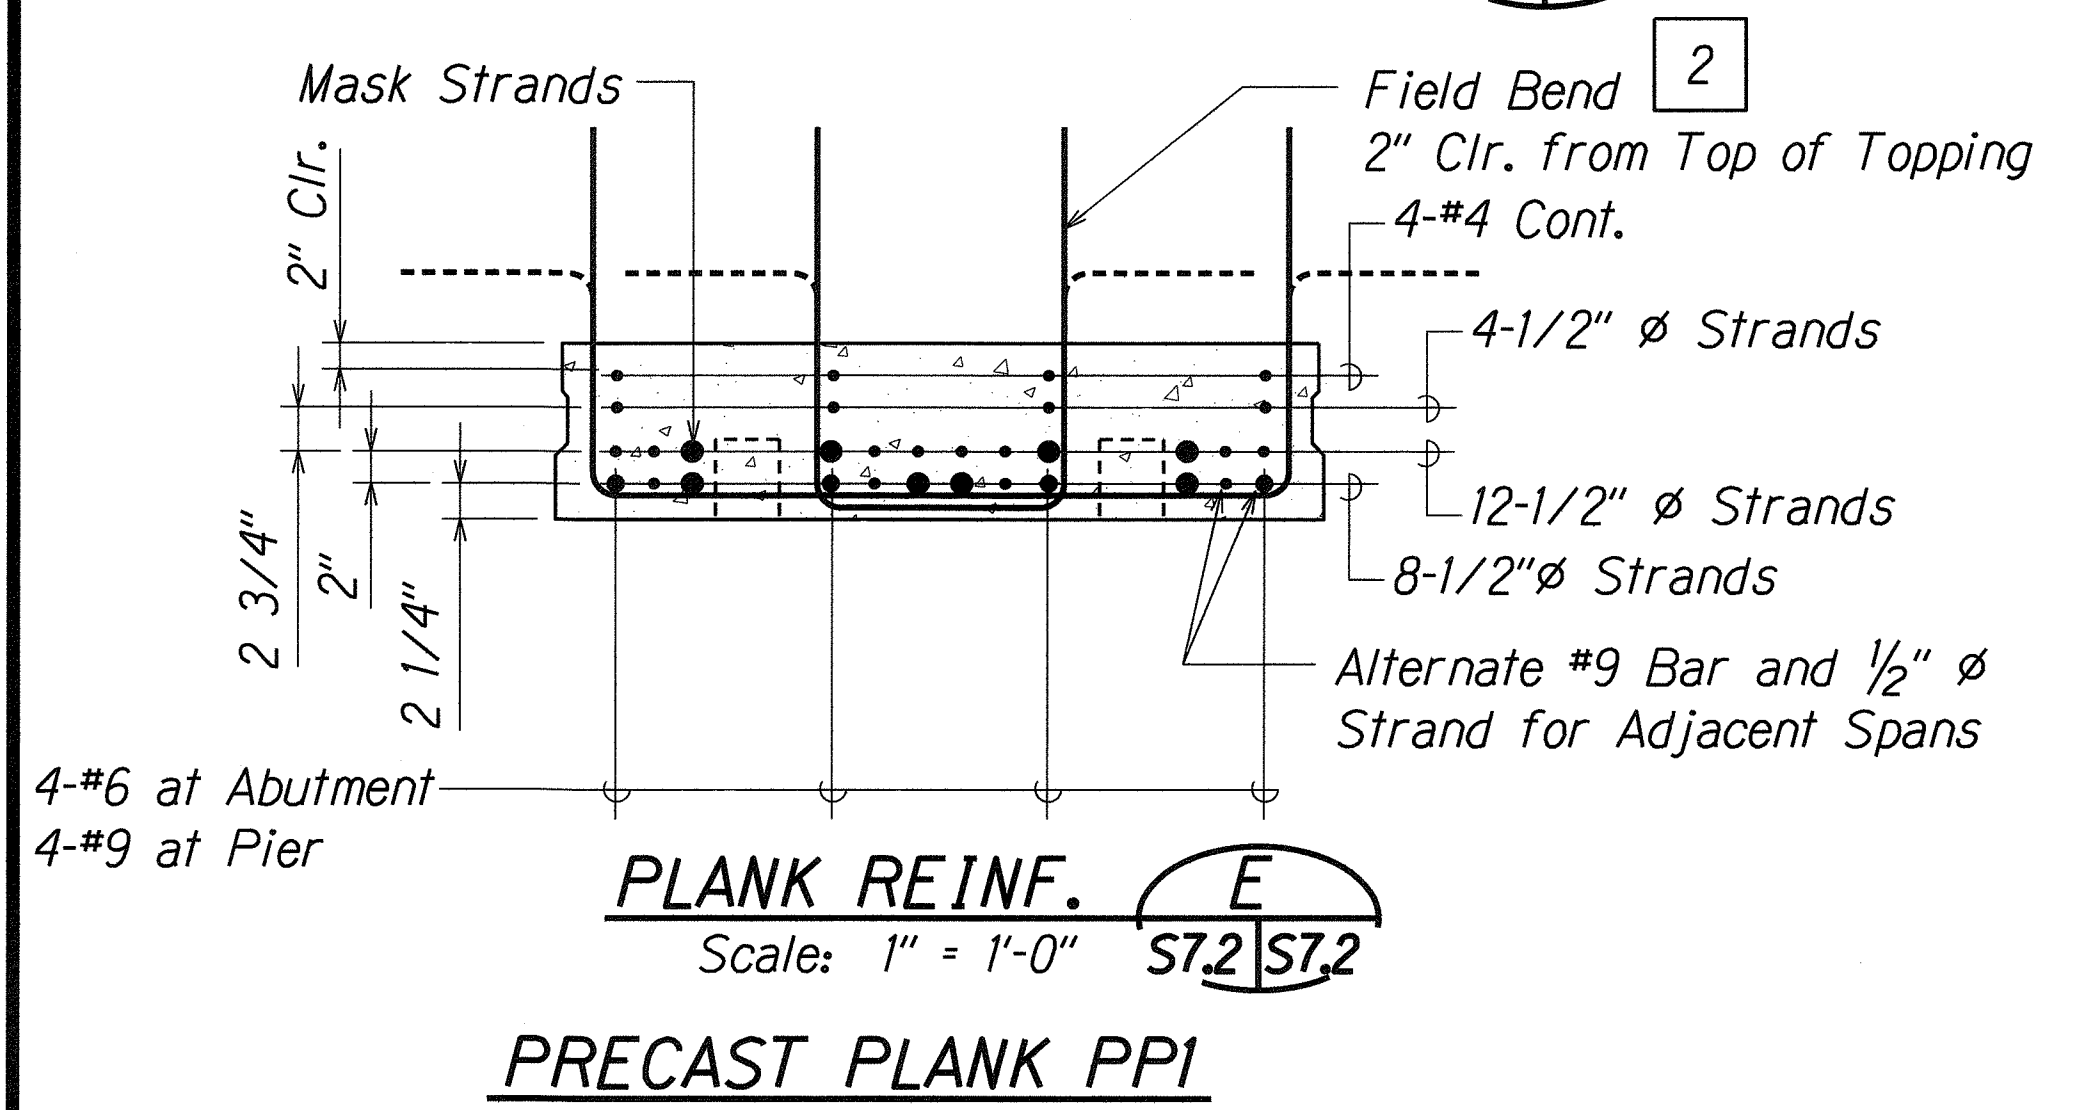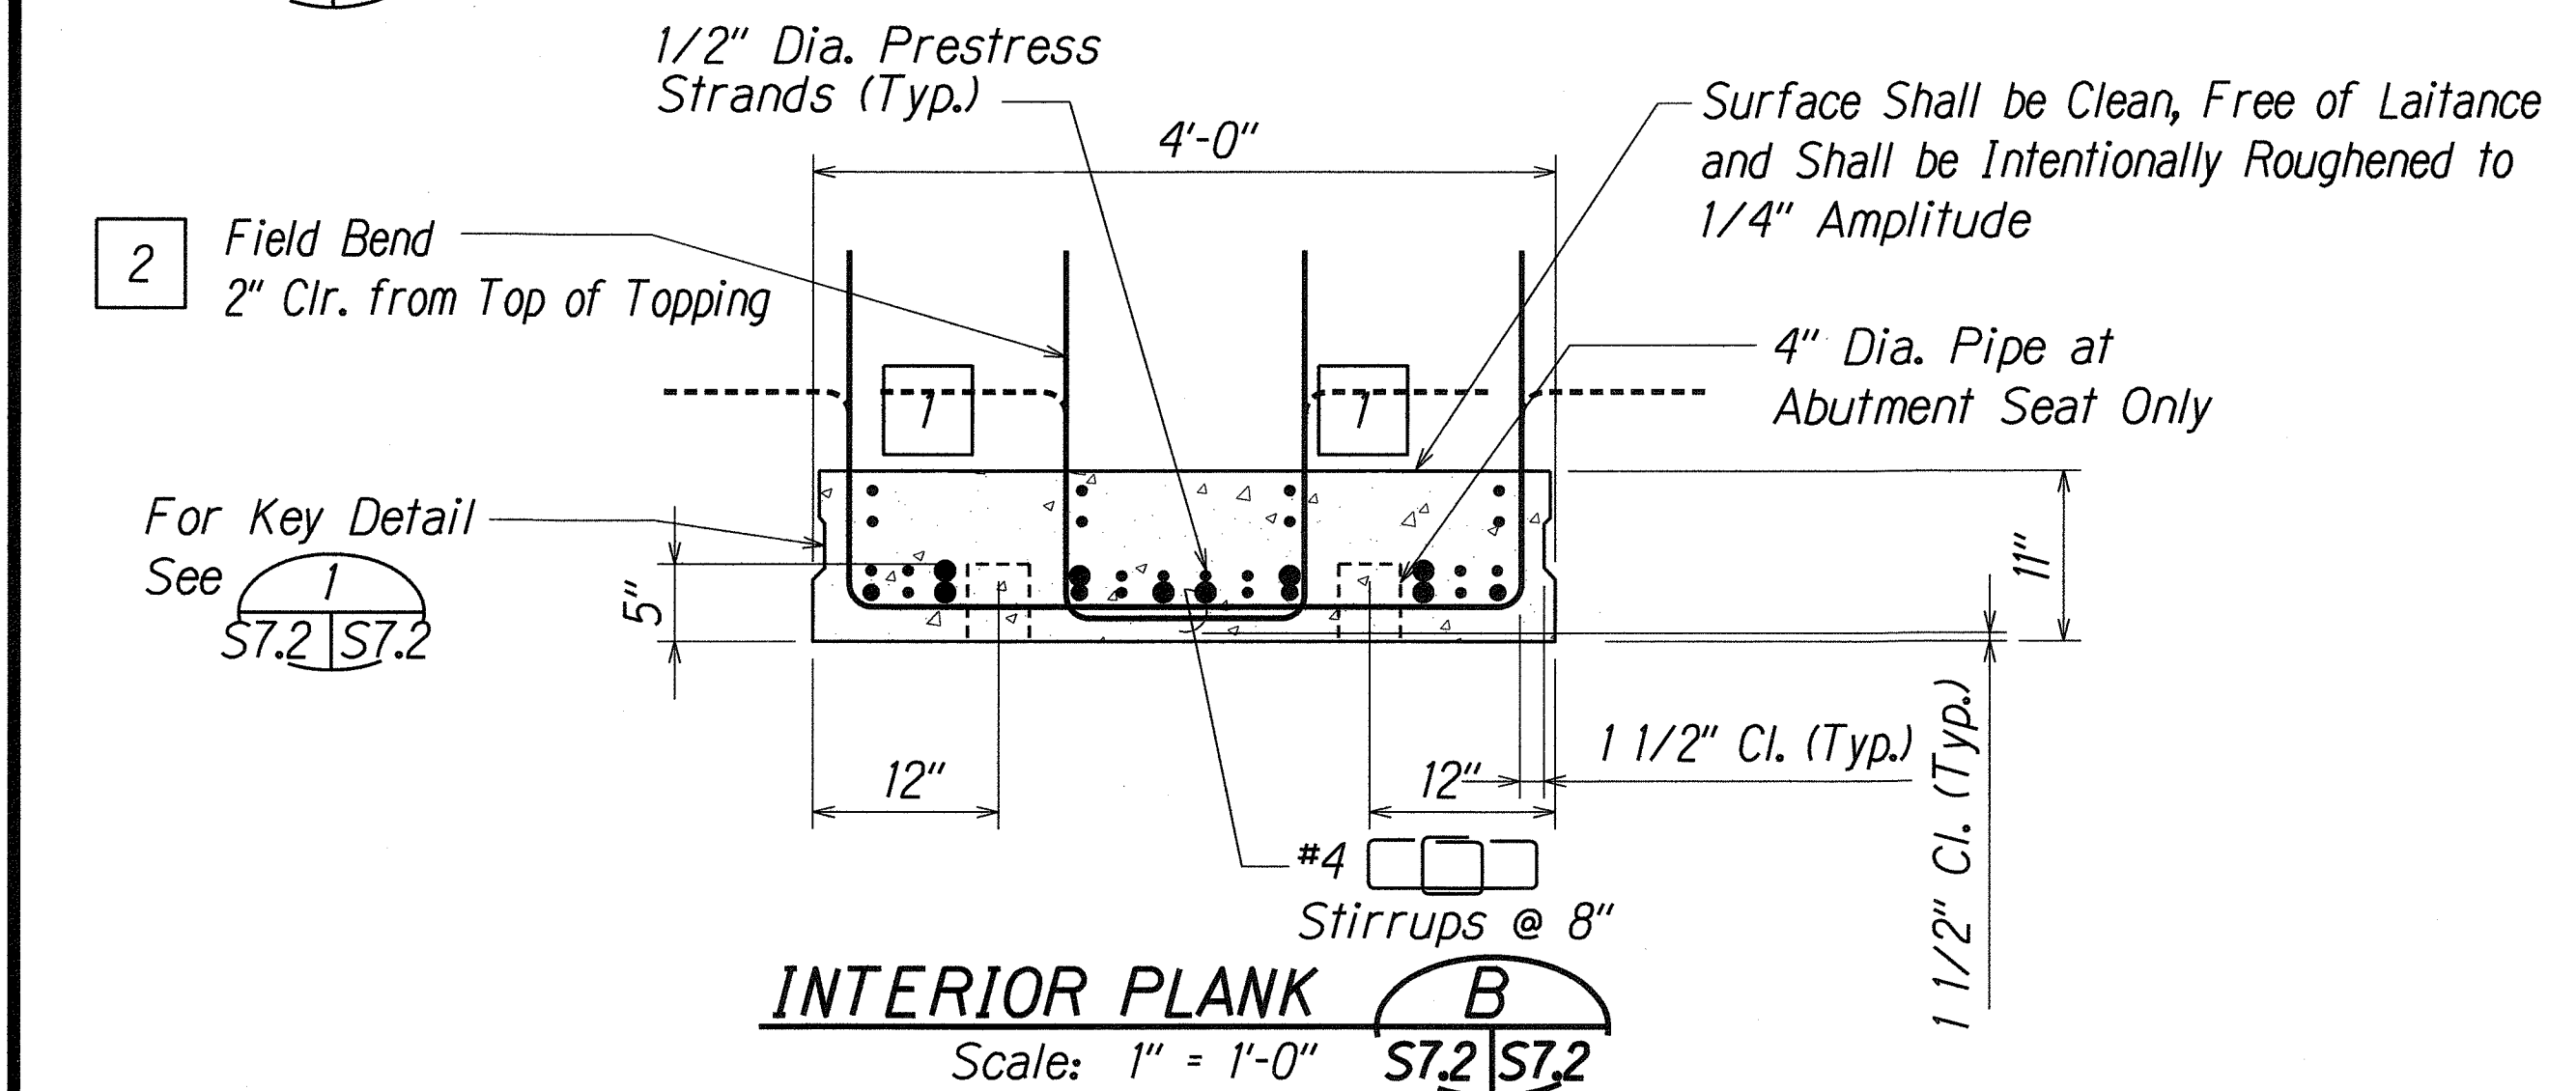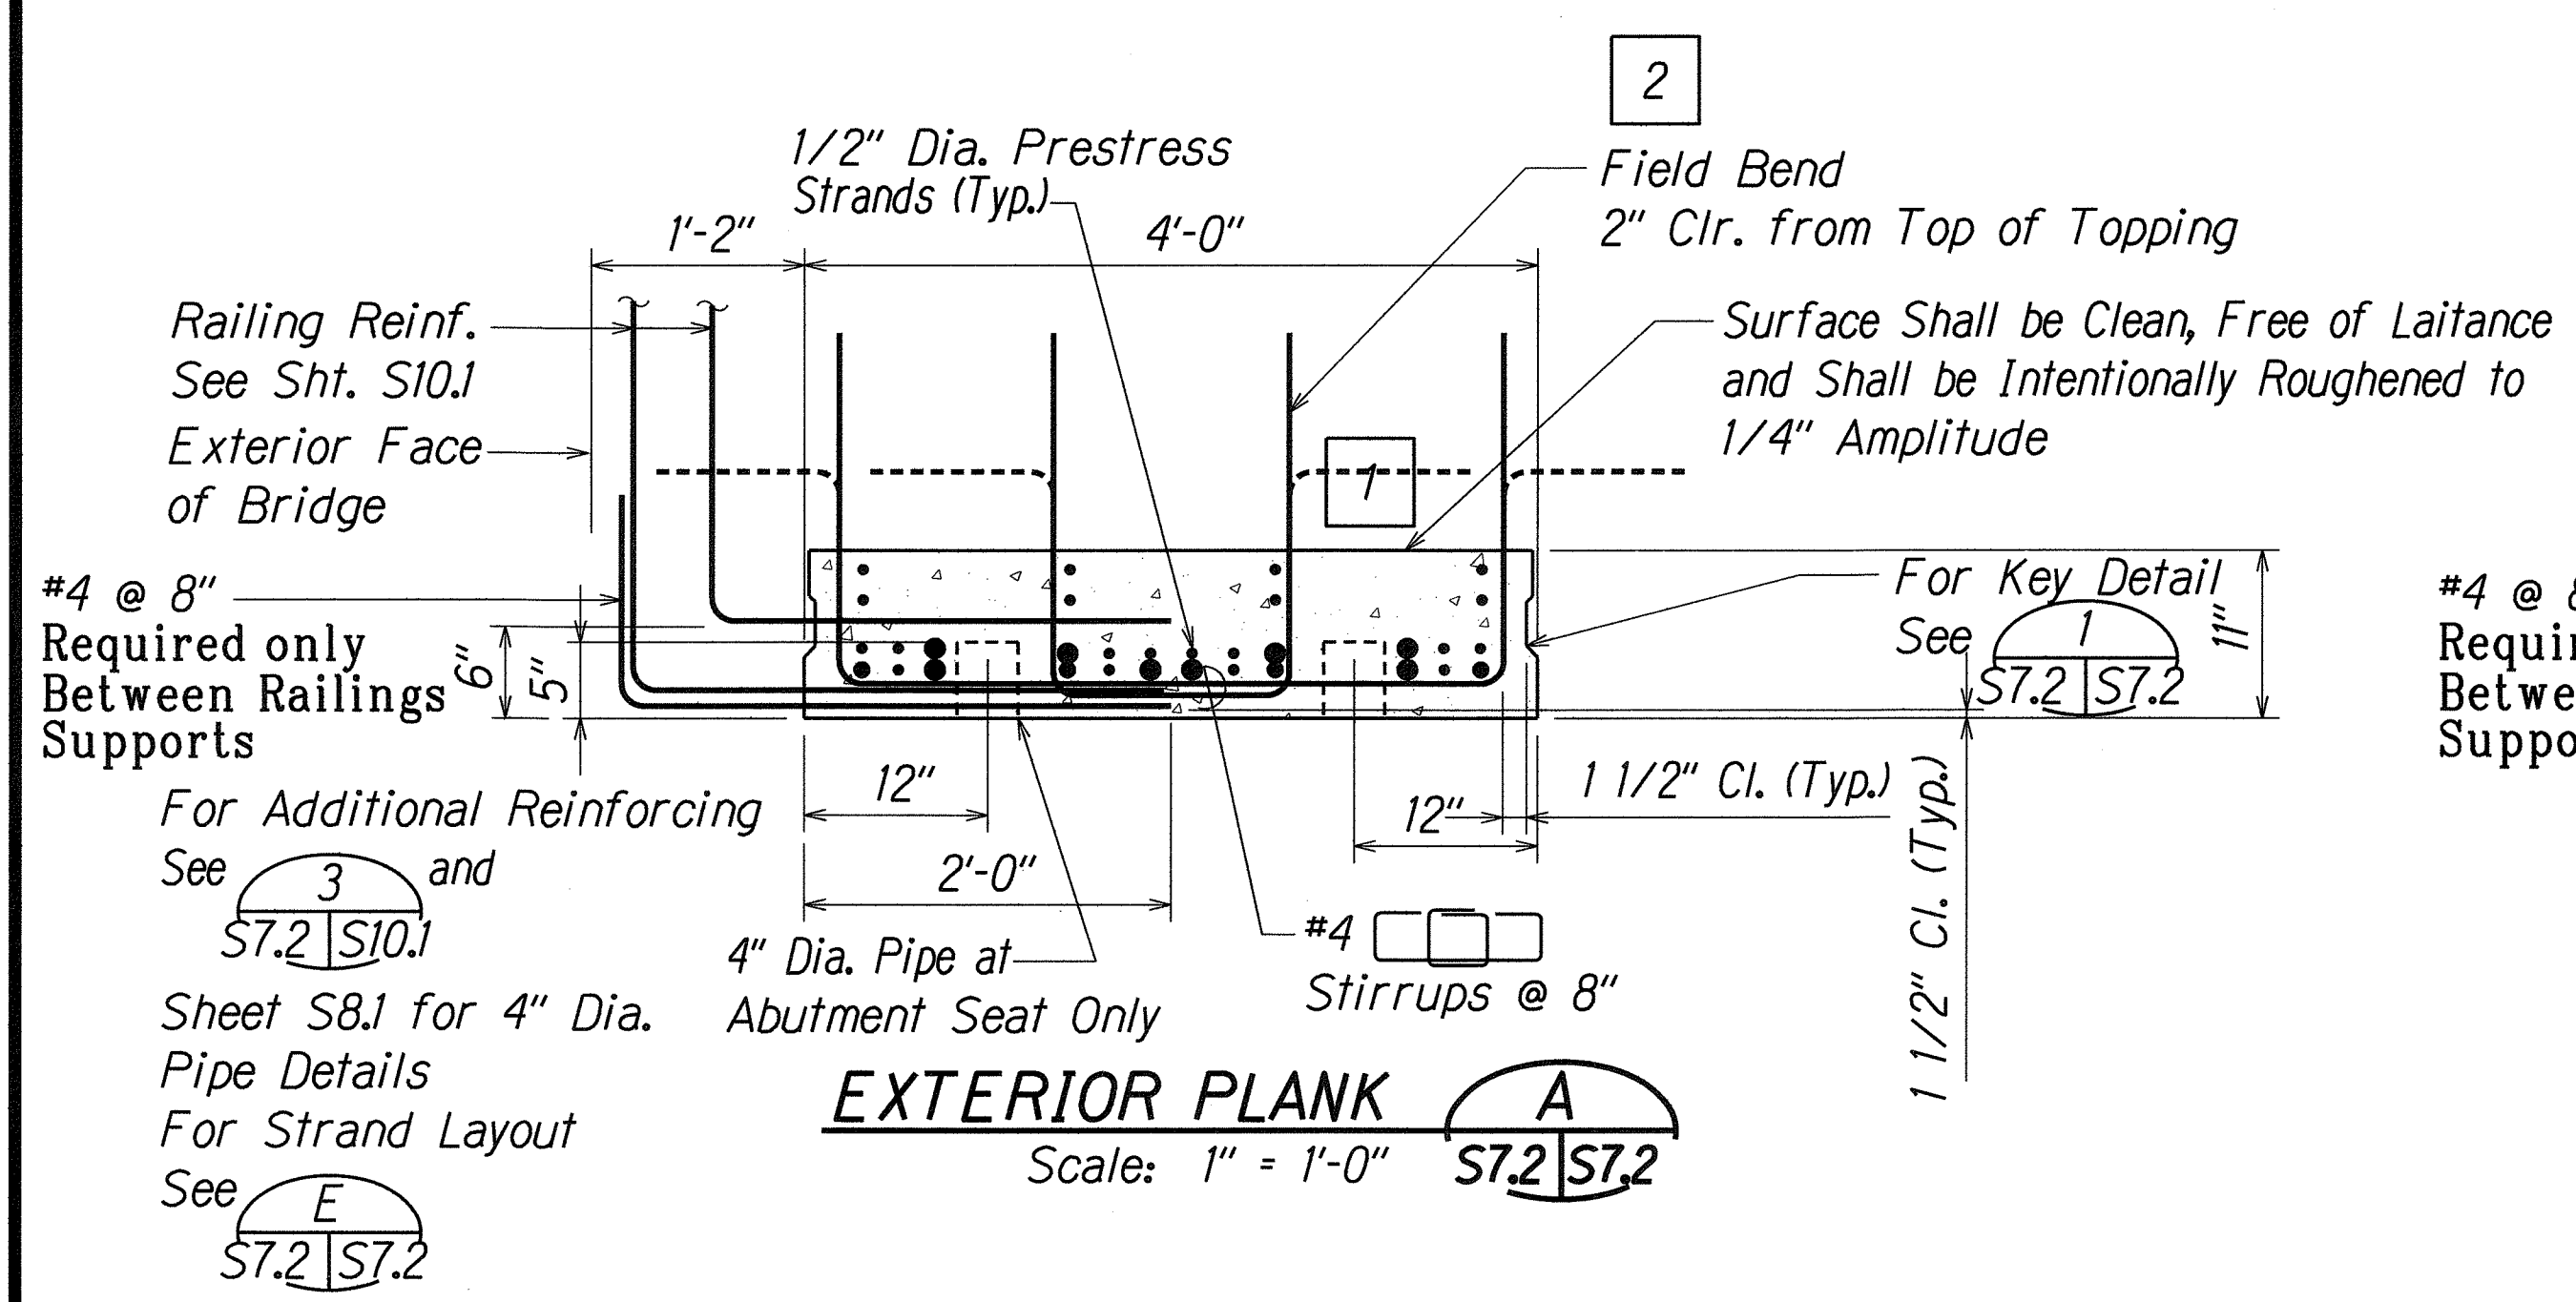

GRAPHIC SCALES:

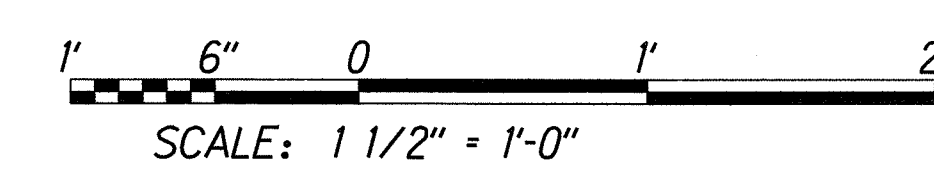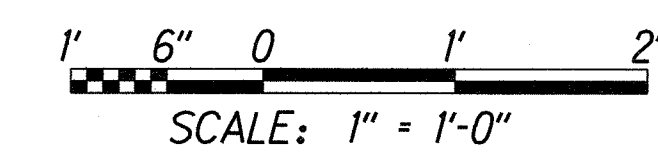

LEGEND FOR AS-BUILT POSTINGS

	Squiggly line for as-built deletion
	Double line for as-built deletion
Roadway	Text for as-built posting

02-15-07	As Built - Added Note
01-29-01	1 Remove Cross Ties
01-29-01	2 Added Note

DATE	REVISION
------	----------

STATE OF HAWAII
DEPARTMENT OF TRANSPORTATION
HIGHWAYS DIVISION


PRECAST PLANK SECTION AND DETAILS

**MAMALAOHA HIGHWAY
REPLACEMENT OF
KEATWA STREAM BRIDGE
Federal Aid Project No. ER-12(1)R**

Scale: As Shown Date: January 2001

SURVEY PLOTTED BY	DATE
DRAWN BY	
DESIGNED BY	
CHECKED BY	


FED. ROAD DIST. NO.	STATE	FED. AID PROJ. NO.	FISCAL YEAR	SHEET NO.	TOTAL SHEETS
HAWAII	HAW.	ER-12(1)R	2001	51	77

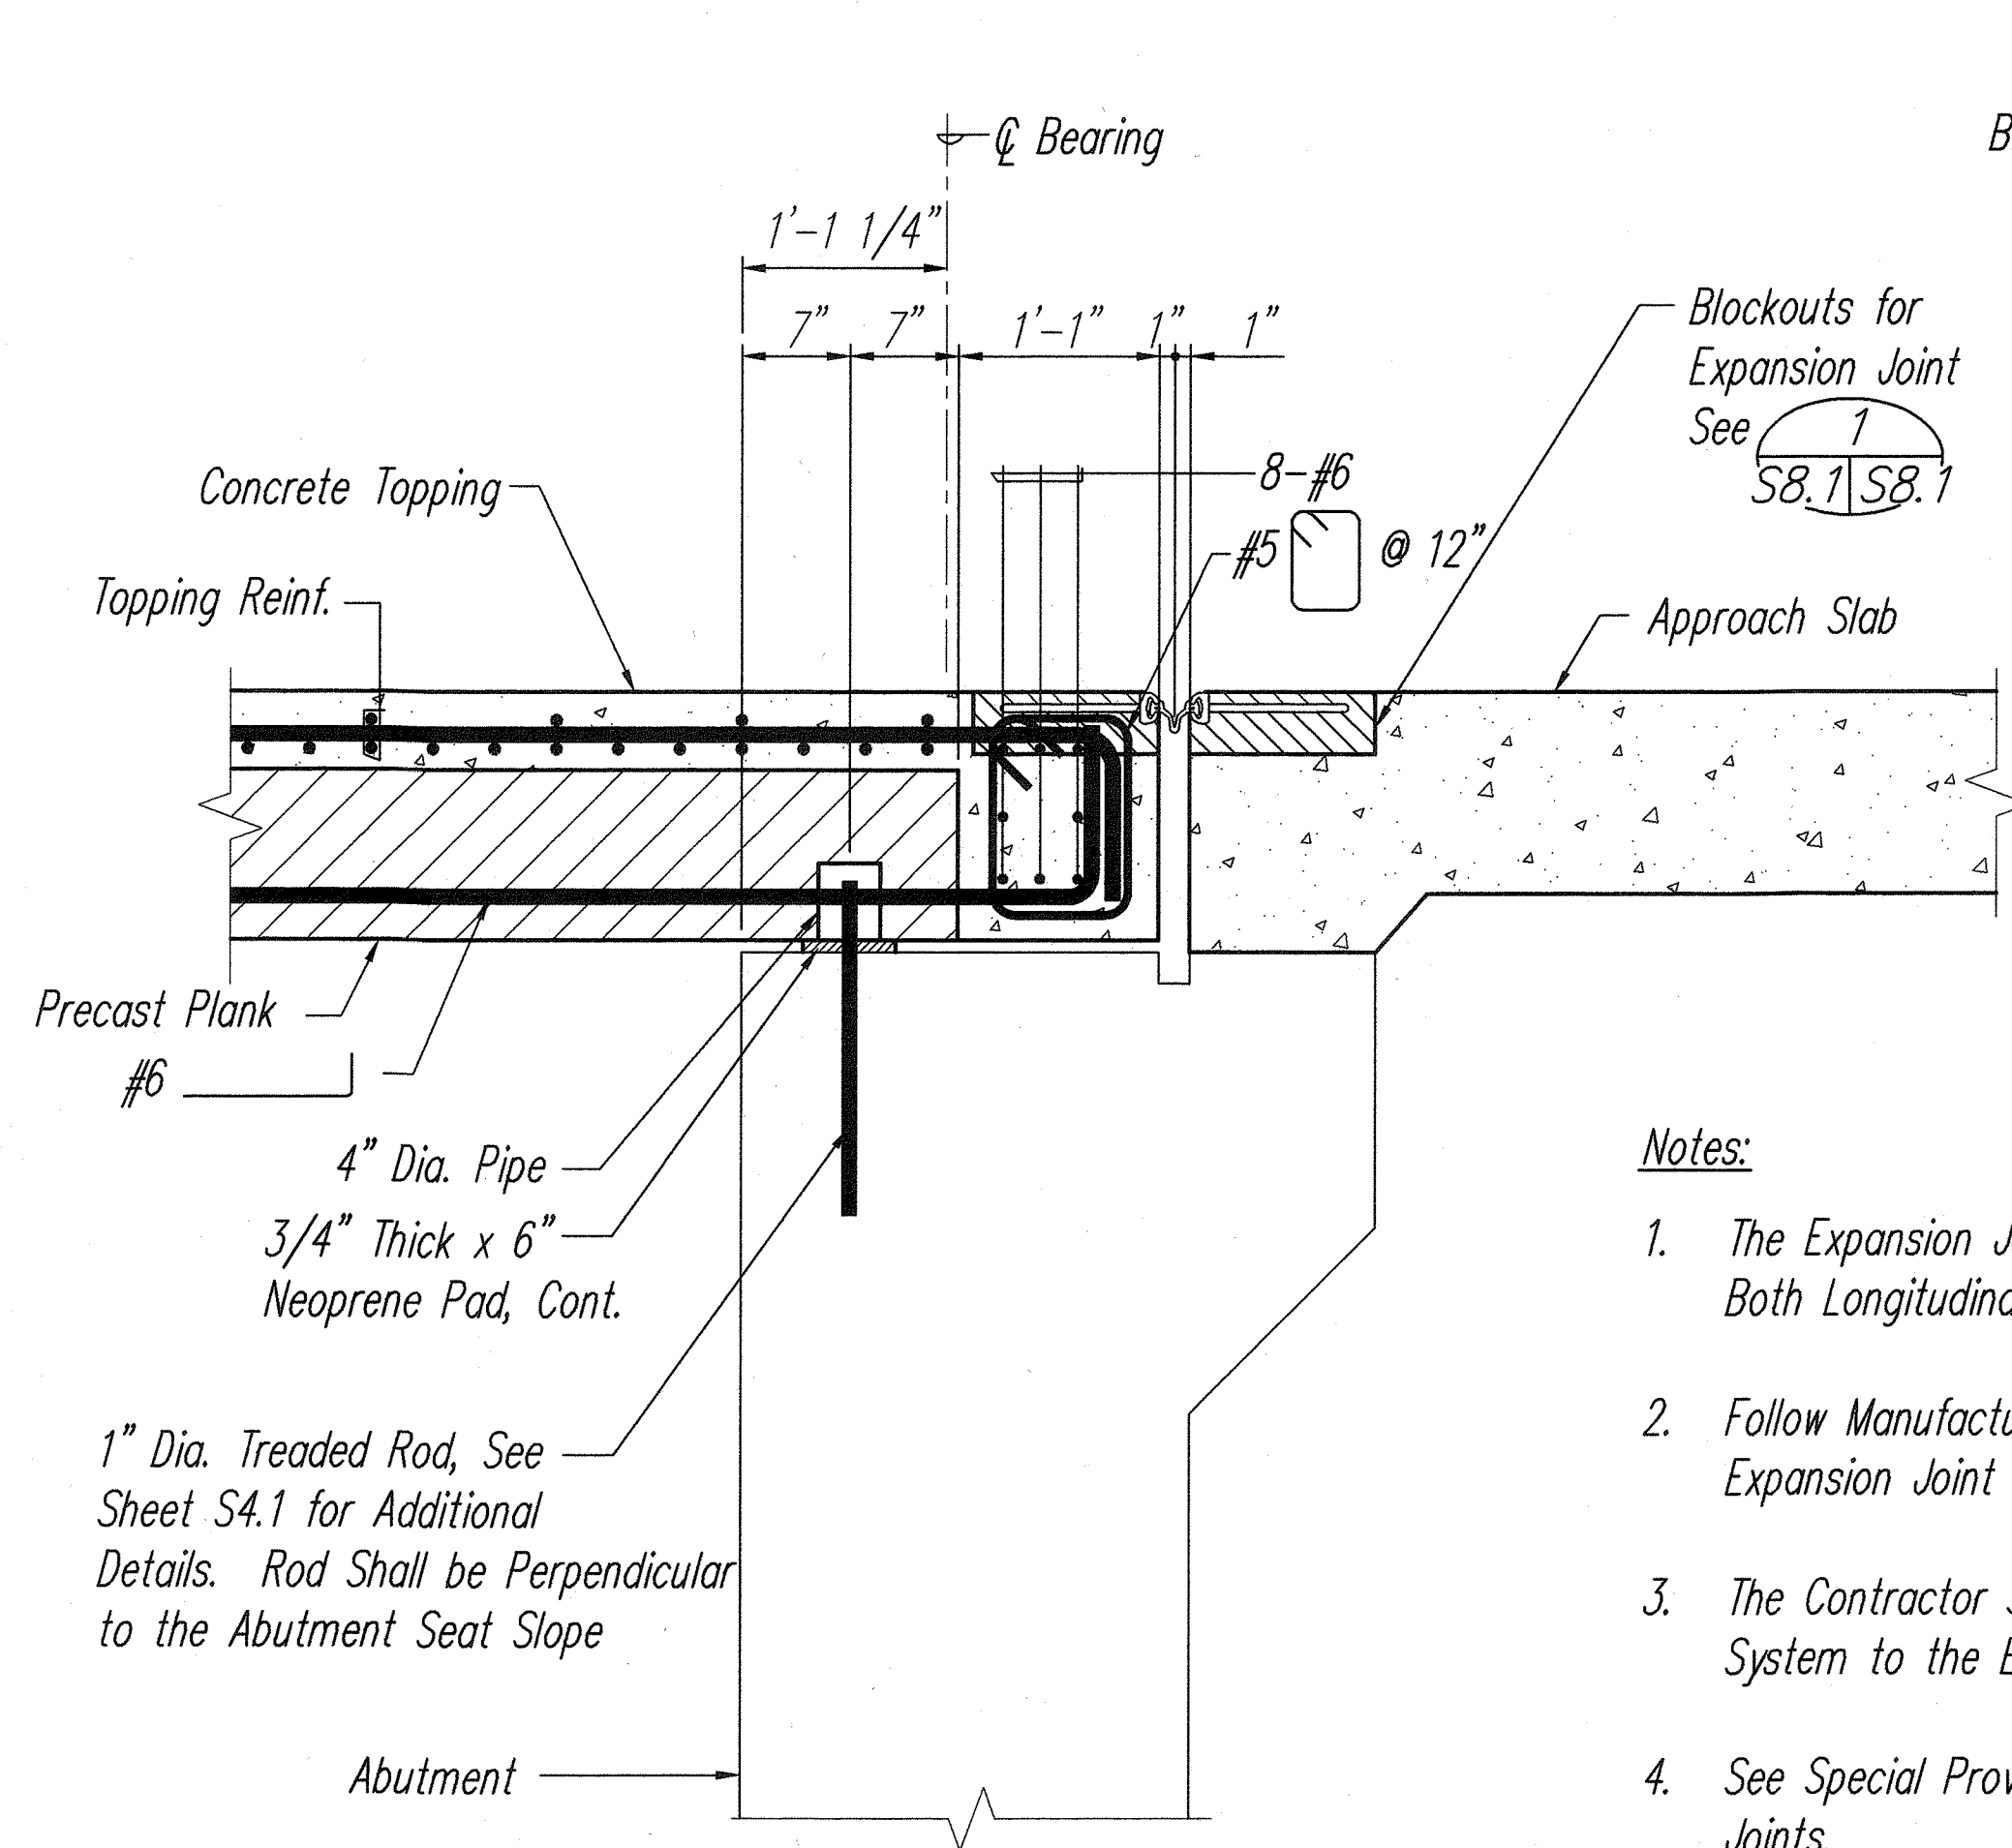


SECTION A
Scale: 1" = 1'-0" S8.1 S8.1

Notes:


1. The Expansion Joint Shall Allow $\pm 2"$ Movement in Both Longitudinal and Transverse Directions.
2. Follow Manufacturer's Recommendations for Expansion Joint System.
3. The Contractor Shall Submit the Expansion Joint System to the Engineer for Approval.
4. See Special Provision Section 585 Expansion Joints.

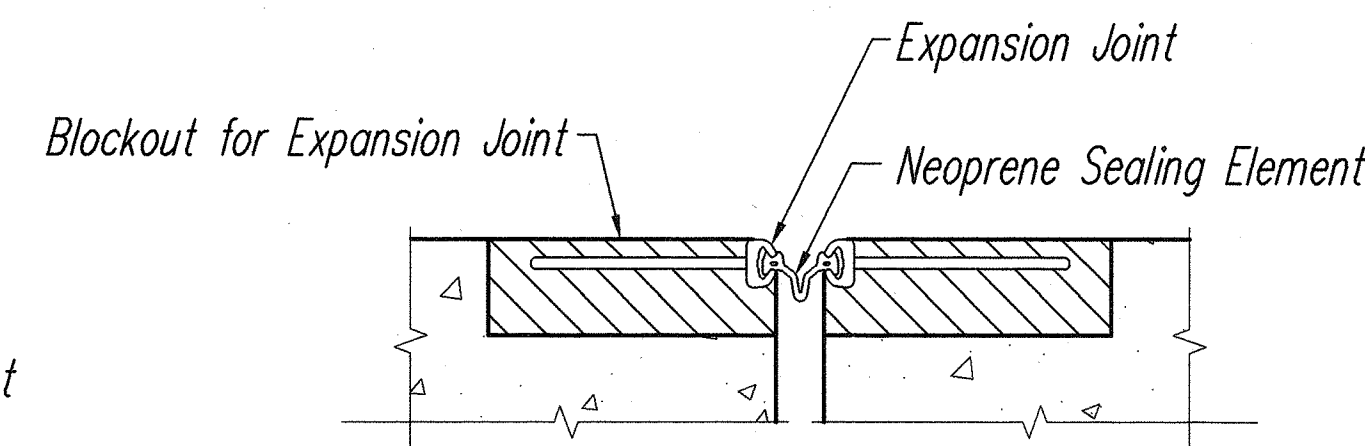


EXPANSION JOINT SYSTEM
ANCHOR METHOD
Scale: 1 1/2" = 1'-0" S8.1 S8.1

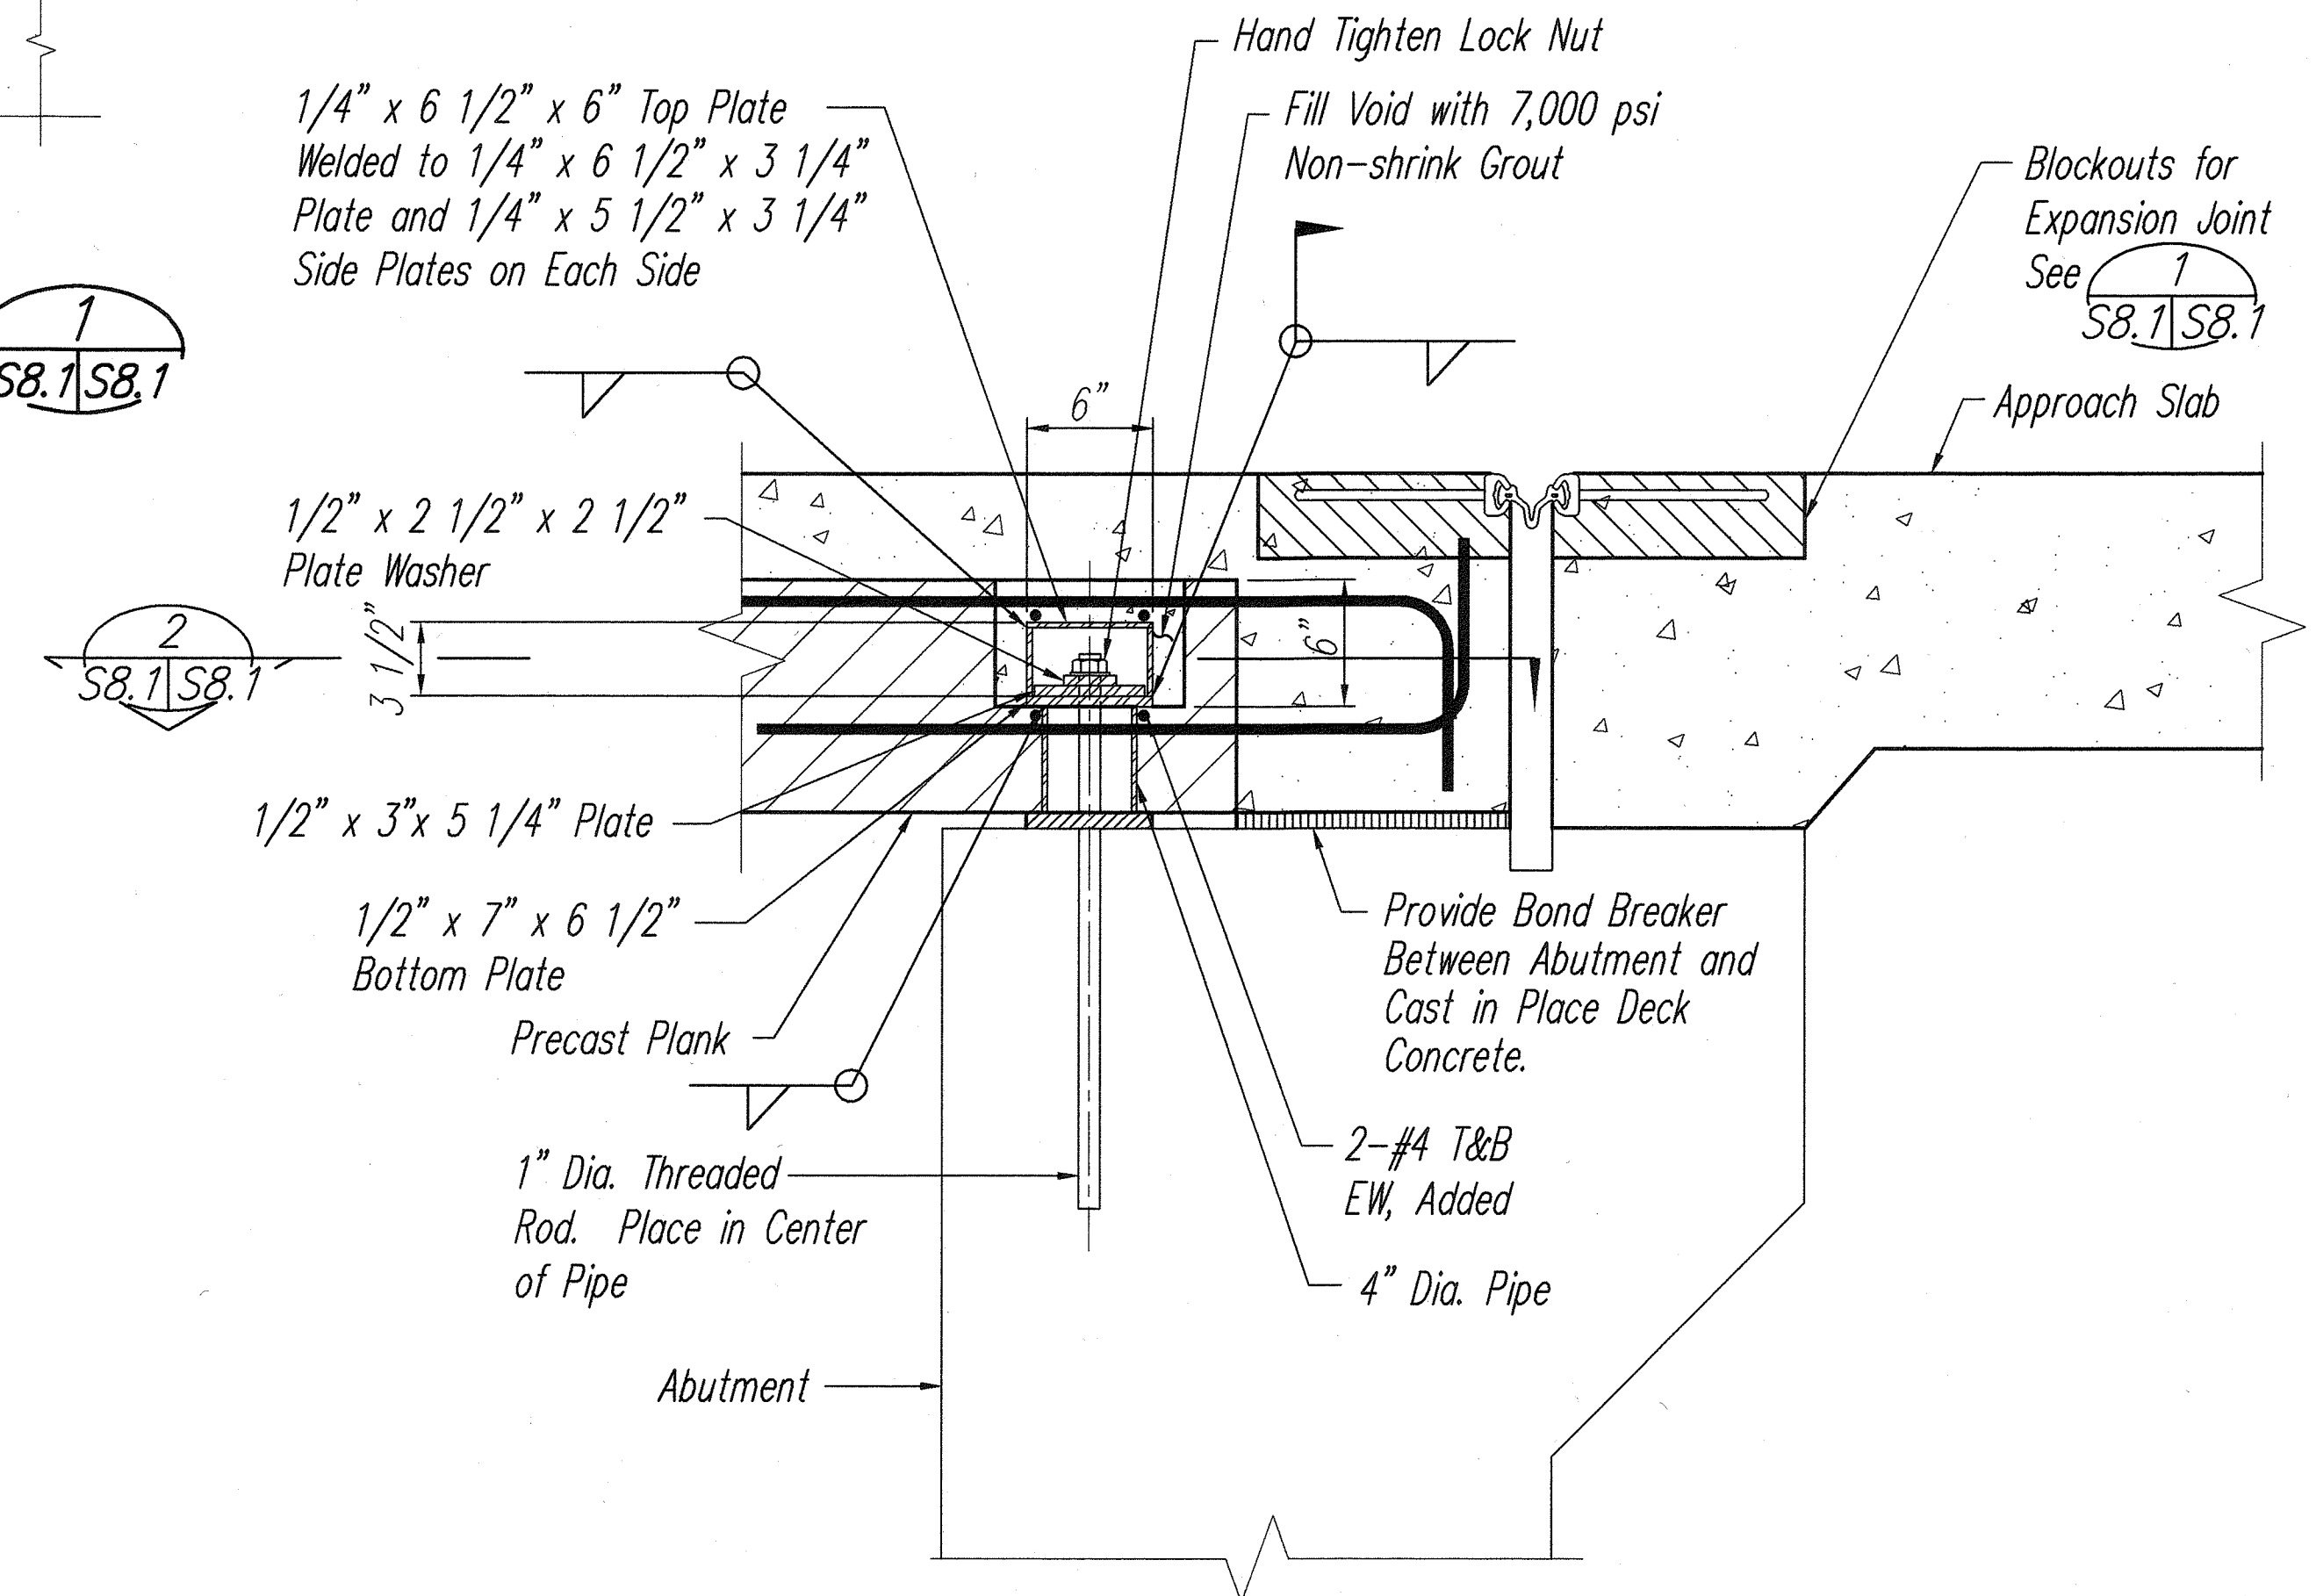





SECTION C
Scale: 1 1/2" = 1'-0" S8.1 S8.1

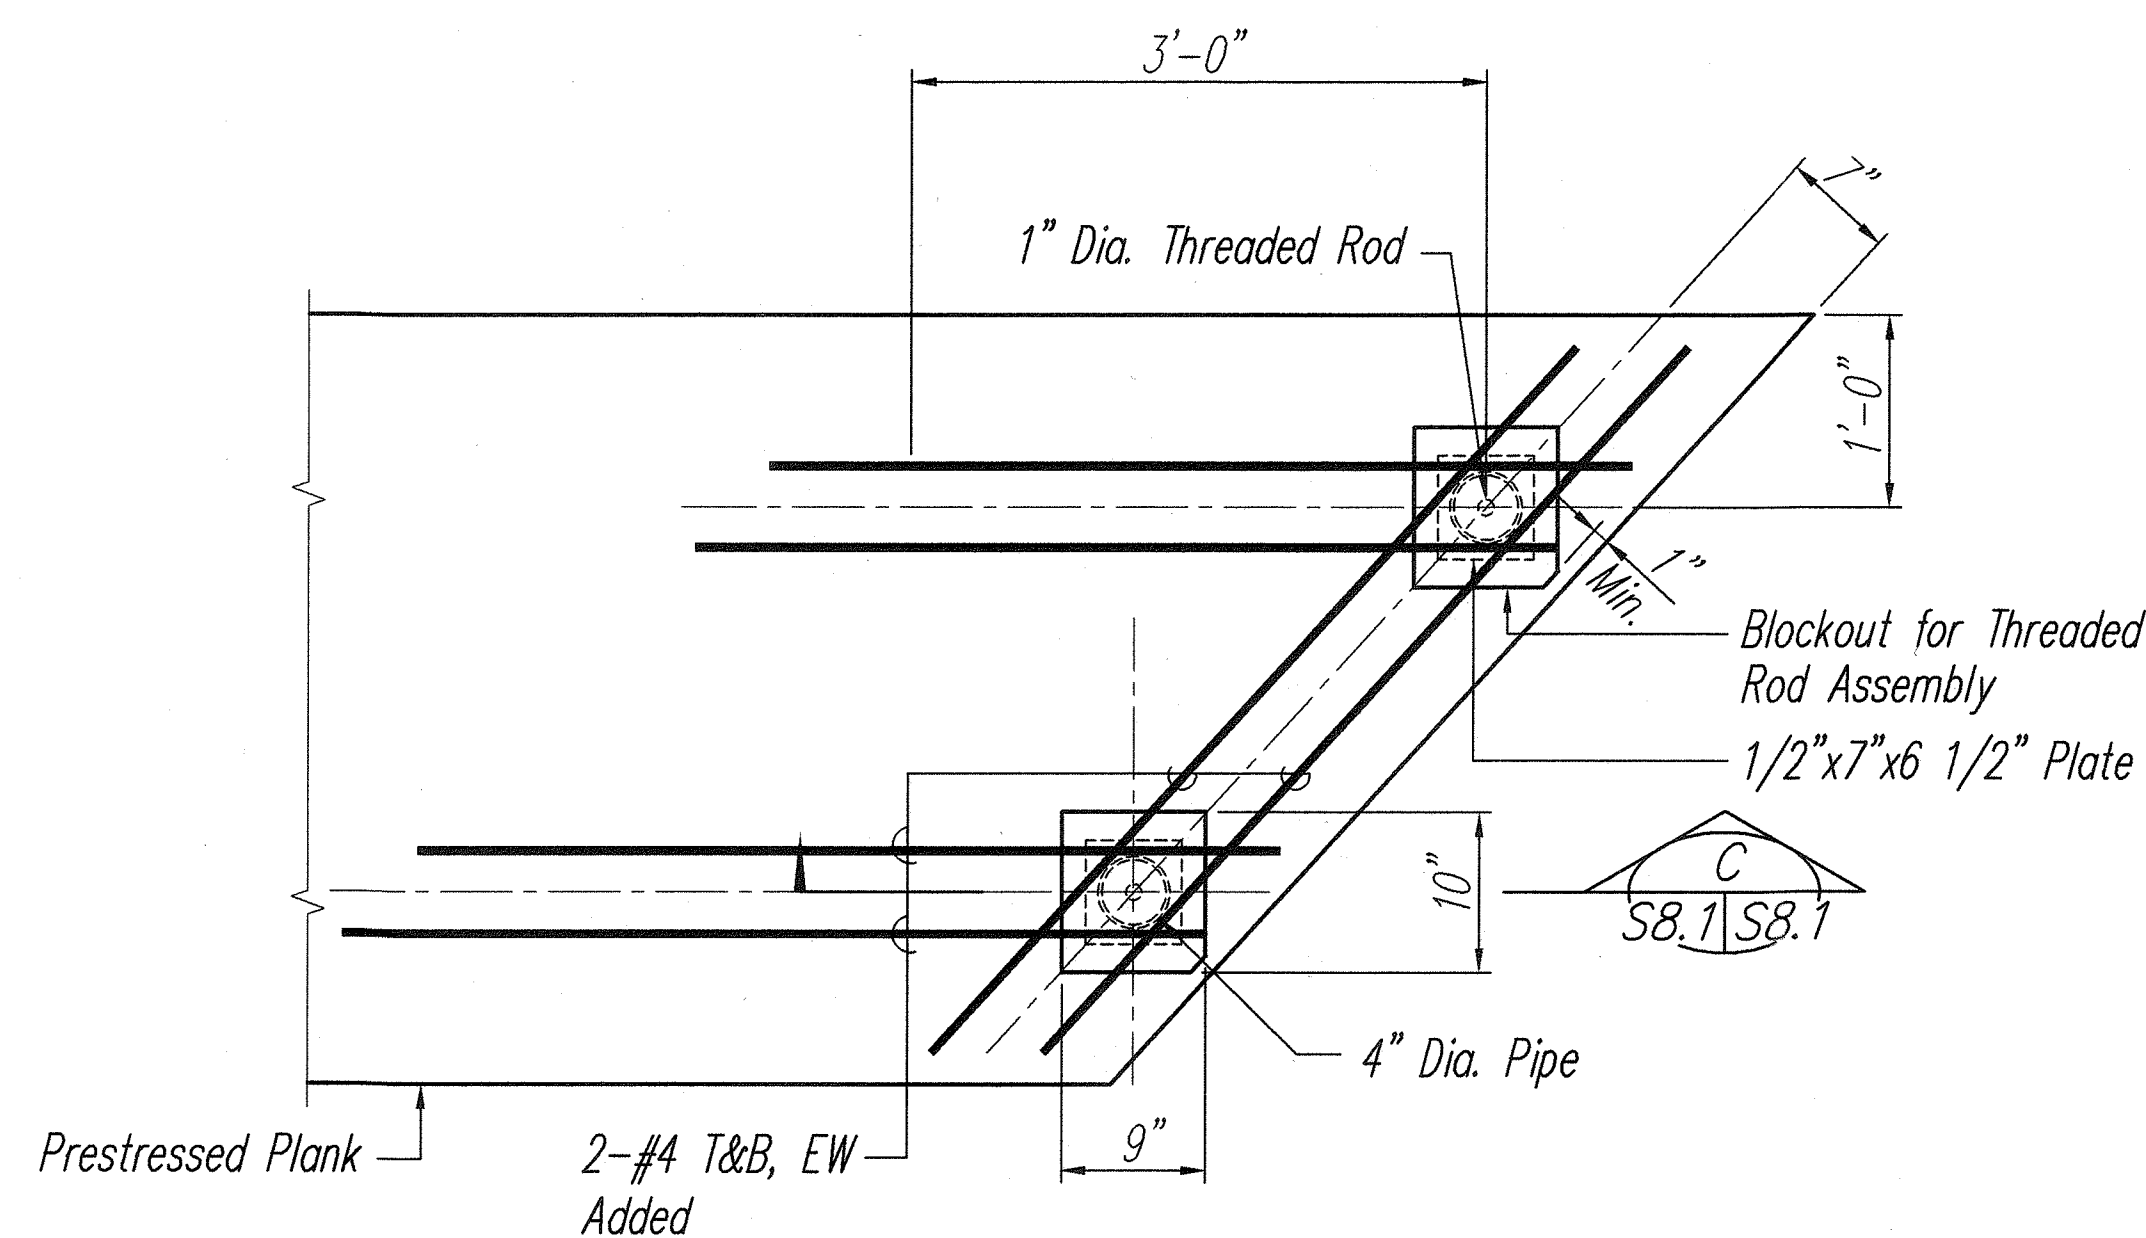

SECTION PLAN B
Scale: 1" = 1'-0" S8.1 S8.1

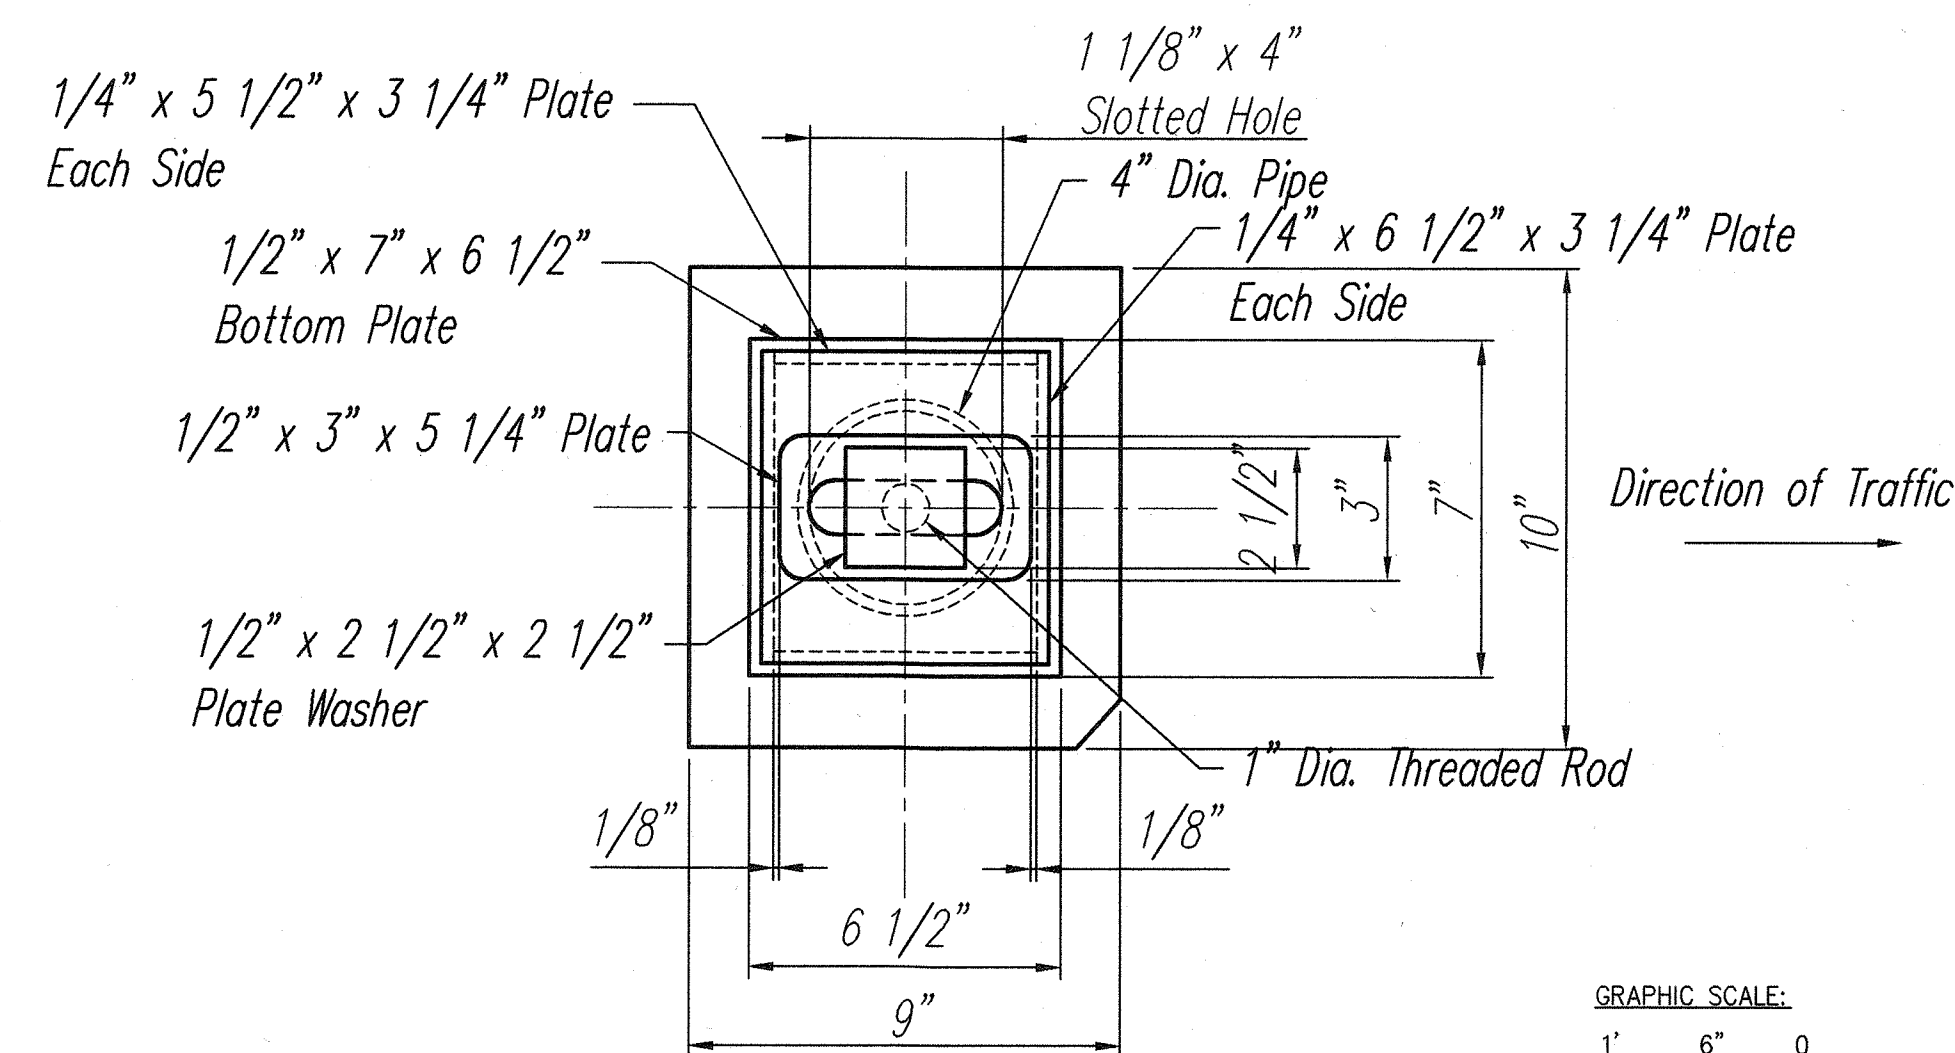

DETAIL 2
Scale: 3" = 1'-0" S8.1 S8.1

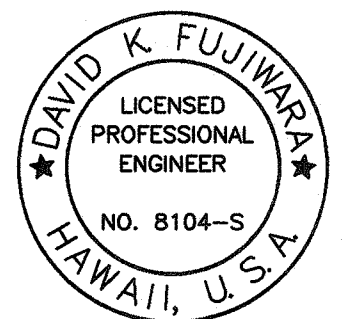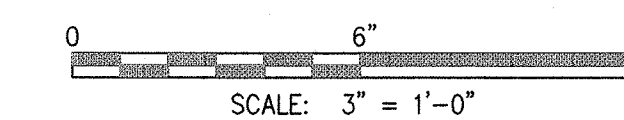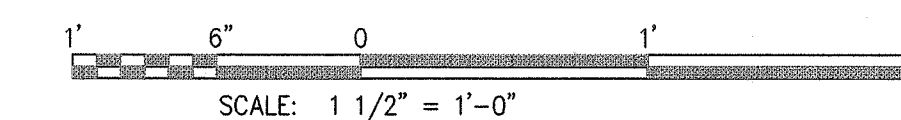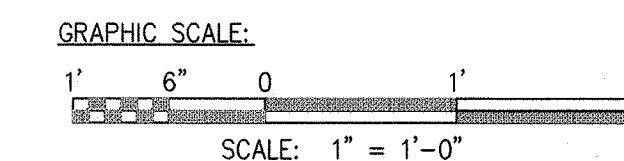

THIS WORK WAS PREPARED BY ME OR UNDER MY SUPERVISION.

STATE OF HAWAII
DEPARTMENT OF TRANSPORTATION
HIGHWAYS DIVISION


SECTIONS AND DETAILS

**MAMALAHOA HIGHWAY
REPLACEMENT OF
KEAIWA STREAM BRIDGE
Federal Aid Project No. ER-12(1)R**
Scale: As Shown Date: January 2001



SHEET No. S8.1 OF 50 SHEETS

SURVEY PLOTTED BY	DATE
DESIGNED BY	DEC 2000
TRACED BY	
NOTE BOOK	
DESIGNED BY	
QUANTITIES BY	
CHECKED BY	
No.	

FED. ROAD DIST. NO.	STATE	FED. AID PROJ. NO.	FISCAL YEAR	SHEET NO.	TOTAL SHEETS
HAWAII	HAW.	ER-12(1)R	2001	52	77

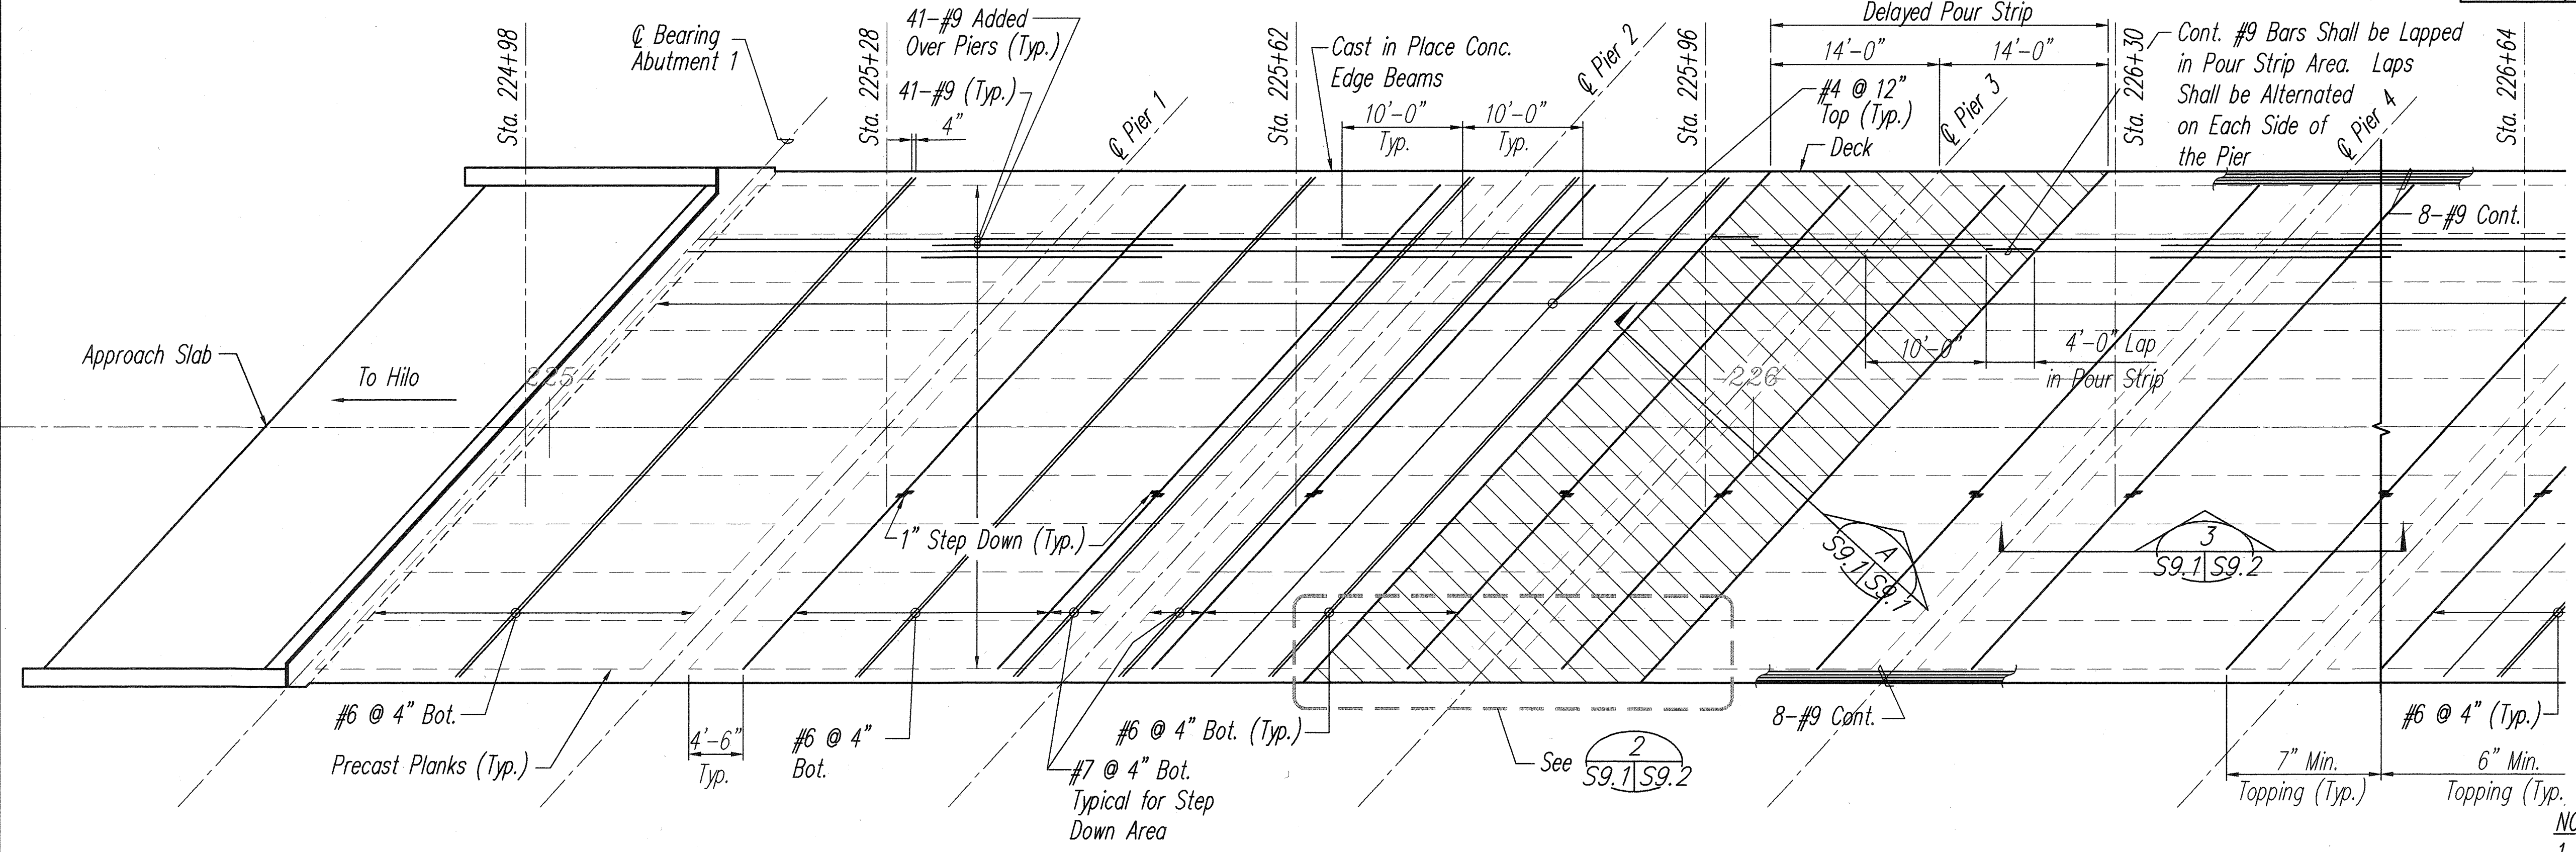


- NOTES:**
1. Top deck reinforcing and concrete edge beam top reinforcing shall be spliced within the middle 1/2 of the span unless otherwise noted.
 2. Concrete edge beam bottom reinforcing shall be spliced 6 to 10 feet from centerline pier unless otherwise noted.

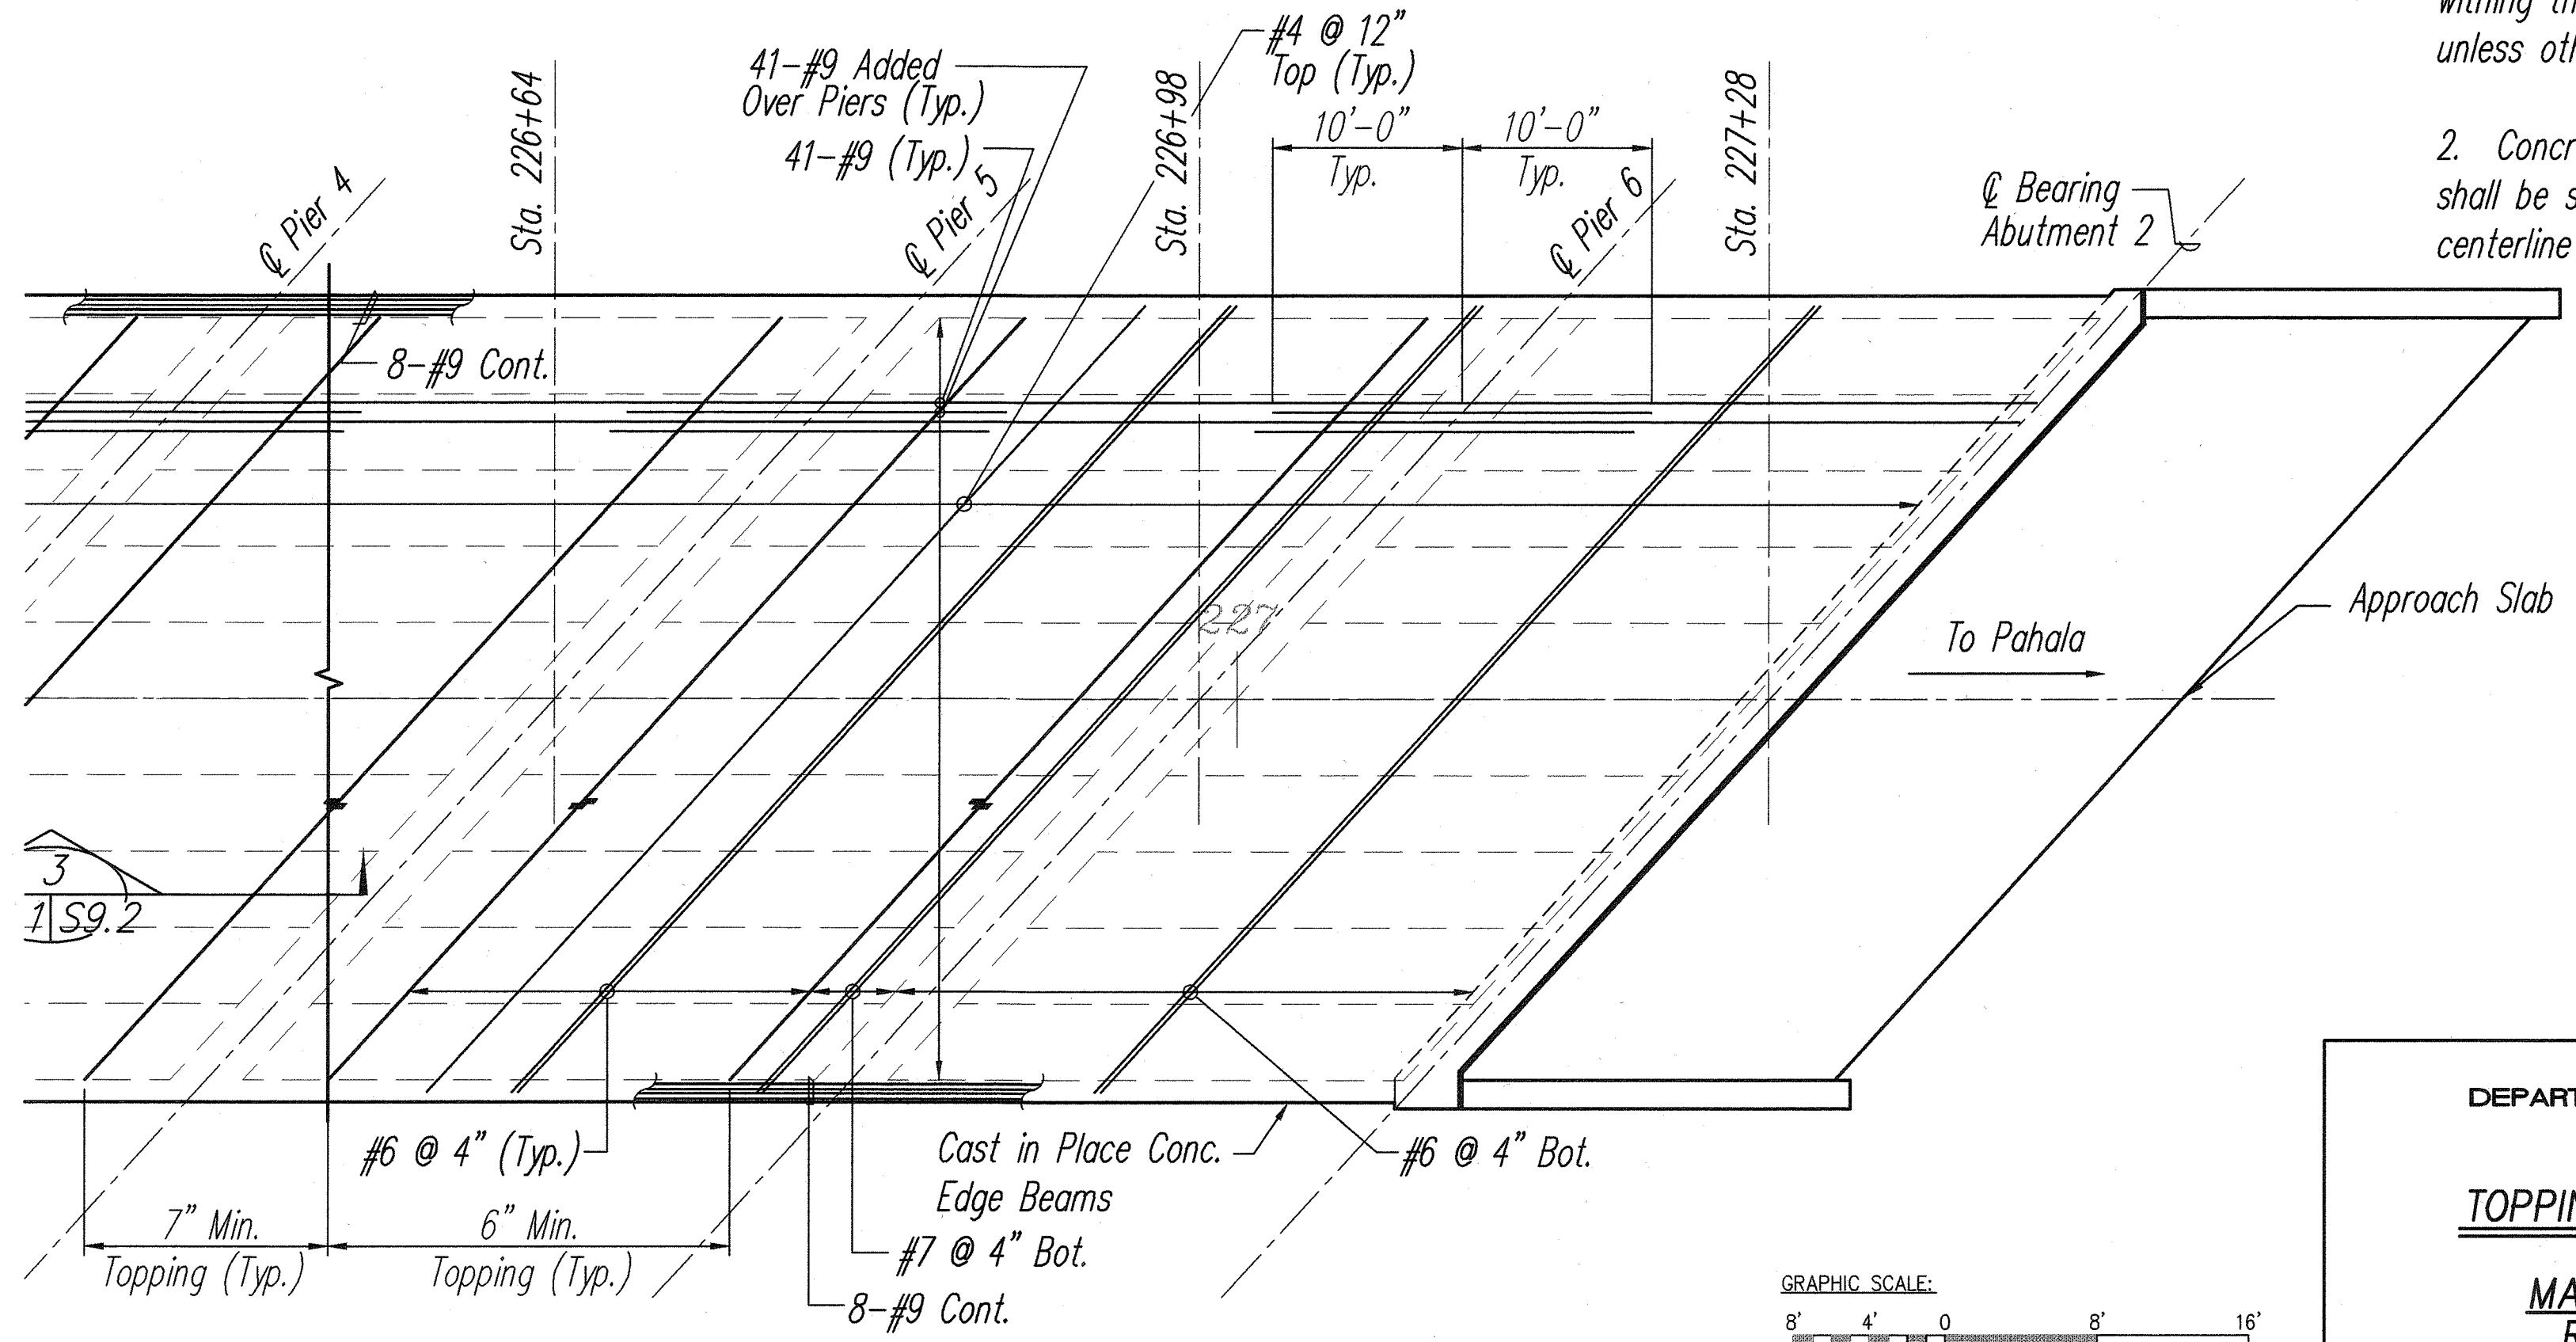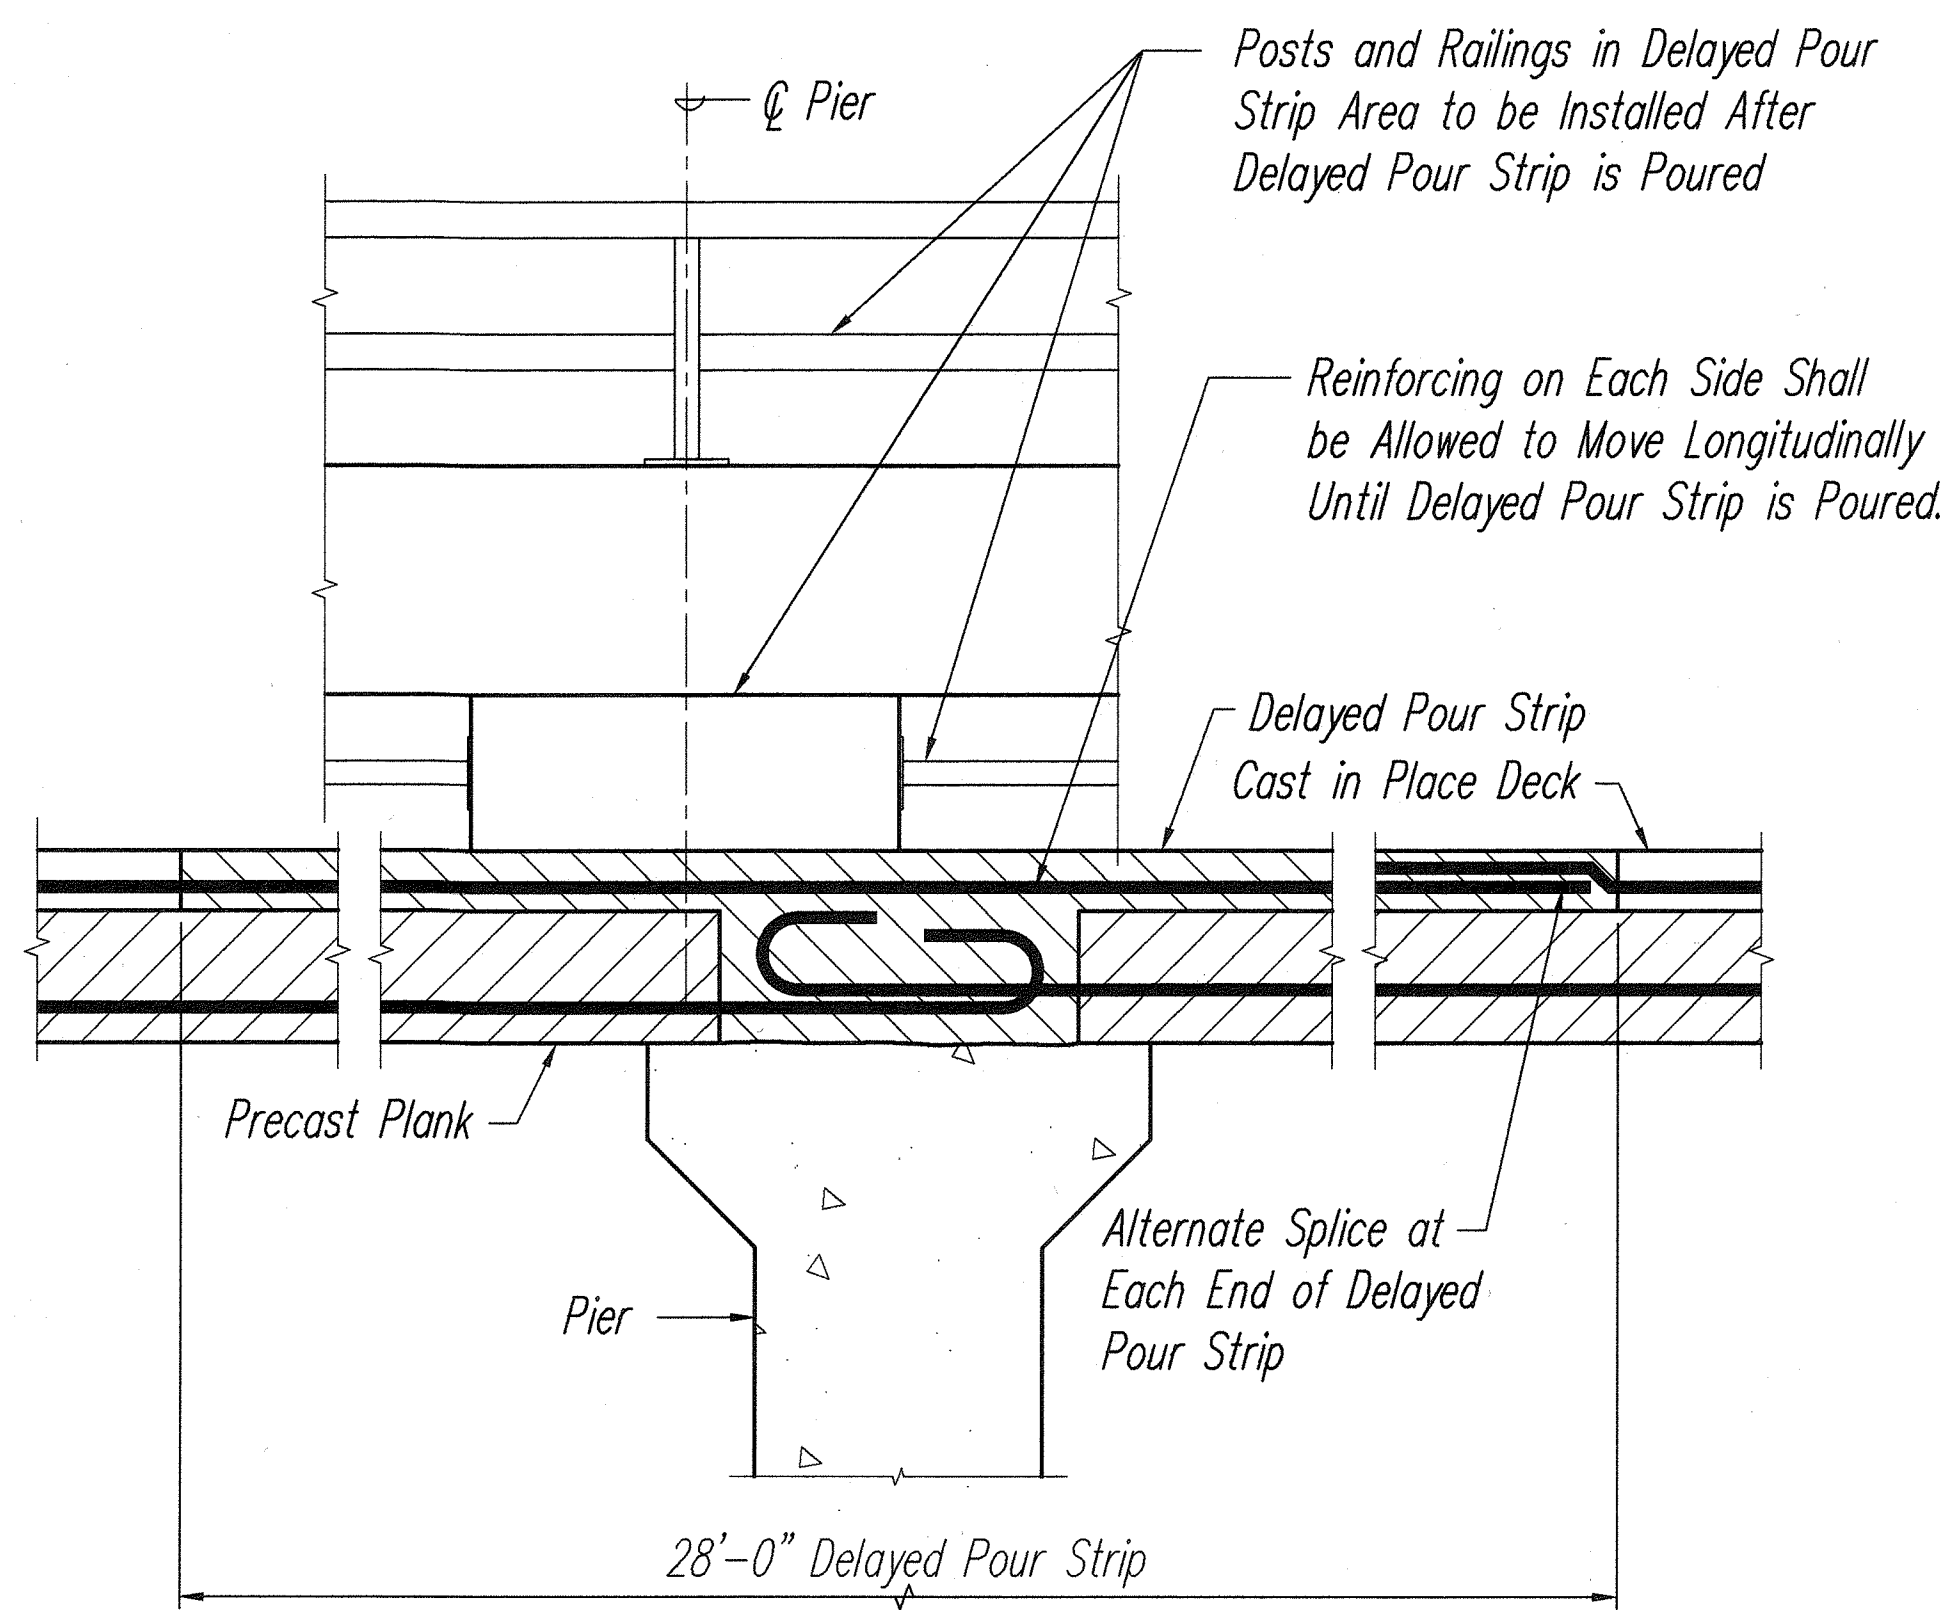


TOPPING REINFORCING PLAN

Scale: 1/8" = 1'-0"

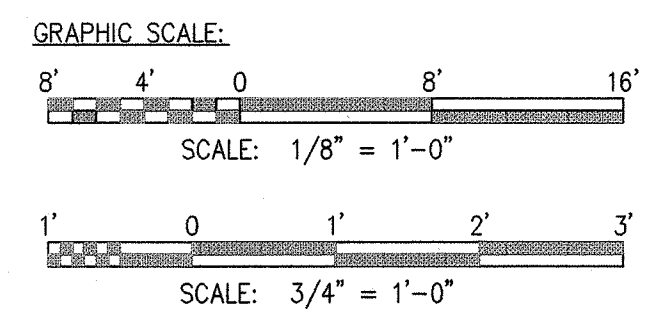

ORIGINAL PLAN	SURVEY PLOTTED BY	DATE
NOTE BOOK	DESIGNED BY KSE	NOV2000
	QUANTITIES BY	
	CHECKED BY	

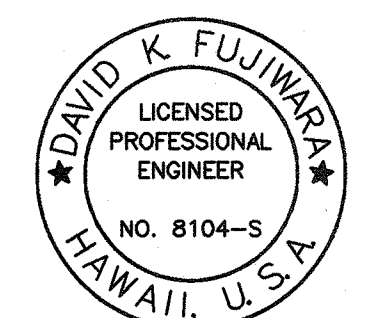

David K. Fujiwara
 THIS WORK WAS PREPARED BY ME OR UNDER MY SUPERVISION.

STATE OF HAWAII
 DEPARTMENT OF TRANSPORTATION
 HIGHWAYS DIVISION


TOPPING REINFORCING PLAN

**MAMALAHOA HIGHWAY
 REPLACEMENT OF
 KEAIIWA STREAM BRIDGE**
 Federal Aid Project No. ER-12(1)R

Scale: As Shown Date: January 2001

SHEET No. S9.1 OF 50 SHEETS

FED. ROAD DIST. NO.	STATE	FED. AID PROJ. NO.	FISCAL YEAR	SHEET NO.	TOTAL SHEETS
HAWAII	HAW.	ER-12(1)R	2001	54	77

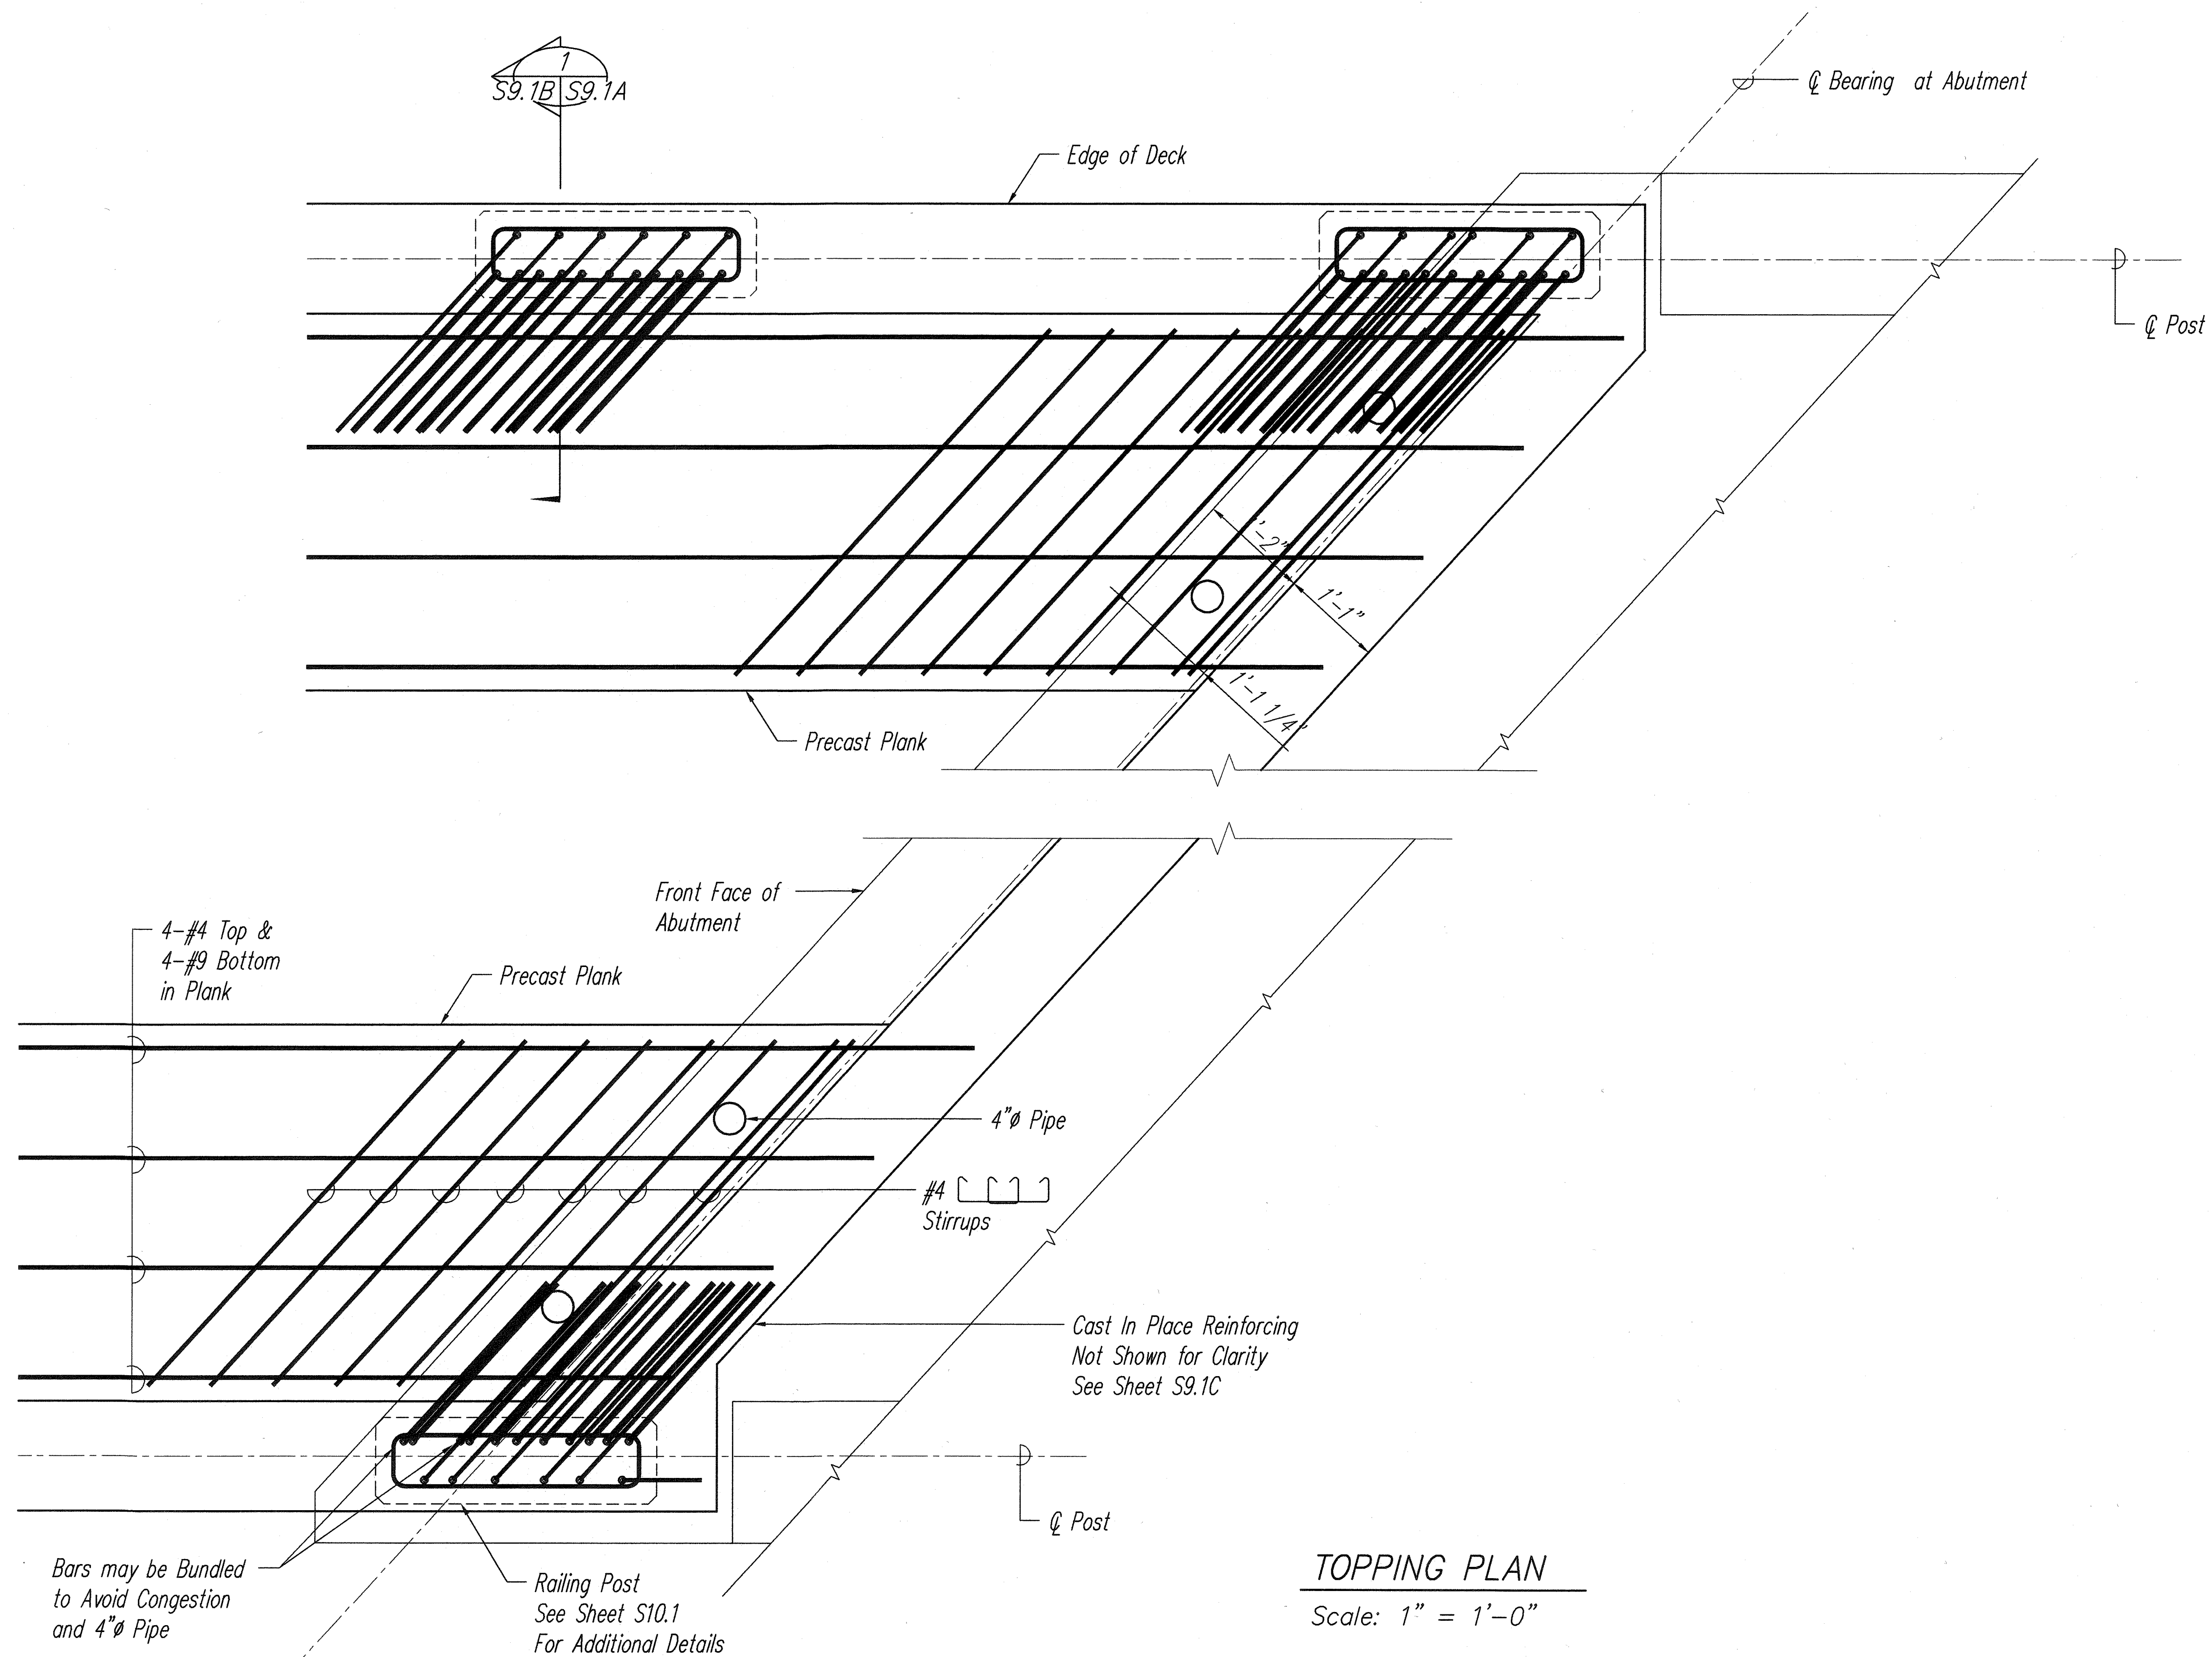


TOPPING PLAN

Scale: 1" = 1'-0"

Note:
Plank Stirrups and Railing Post Reinforcing shall
be Placed Parallel to the Skew of the Bridge

ORIGINAL PLAN	SURVEY PLOTTED BY	DATE
NOTE BOOK	DRAWN BY	NOV2000
No.	DESIGNED BY	
	QUANTITIES BY	
	CHECKED BY	

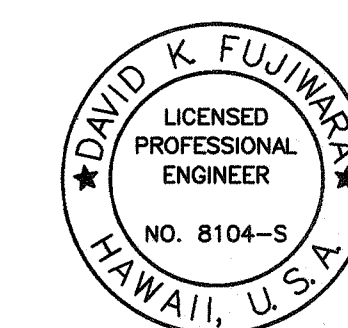

THIS WORK WAS PREPARED BY
ME OR UNDER MY SUPERVISION.

STATE OF HAWAII
DEPARTMENT OF TRANSPORTATION
HIGHWAYS DIVISION


TOPPING PLAN

MAMALAHOA HIGHWAY
REPLACEMENT OF
KEAIWA STREAM BRIDGE
Federal Aid Project No. ER-12(1)R


Scale: As Shown Date: January 2001

SHEET No. S9.1B OF 50 SHEETS

FED. ROAD DIST. NO.	STATE	FED. AID PROJ. NO.	FISCAL YEAR	SHEET NO.	TOTAL SHEETS
HAWAII	HAW.	ER-12(1)R	2001	55	77

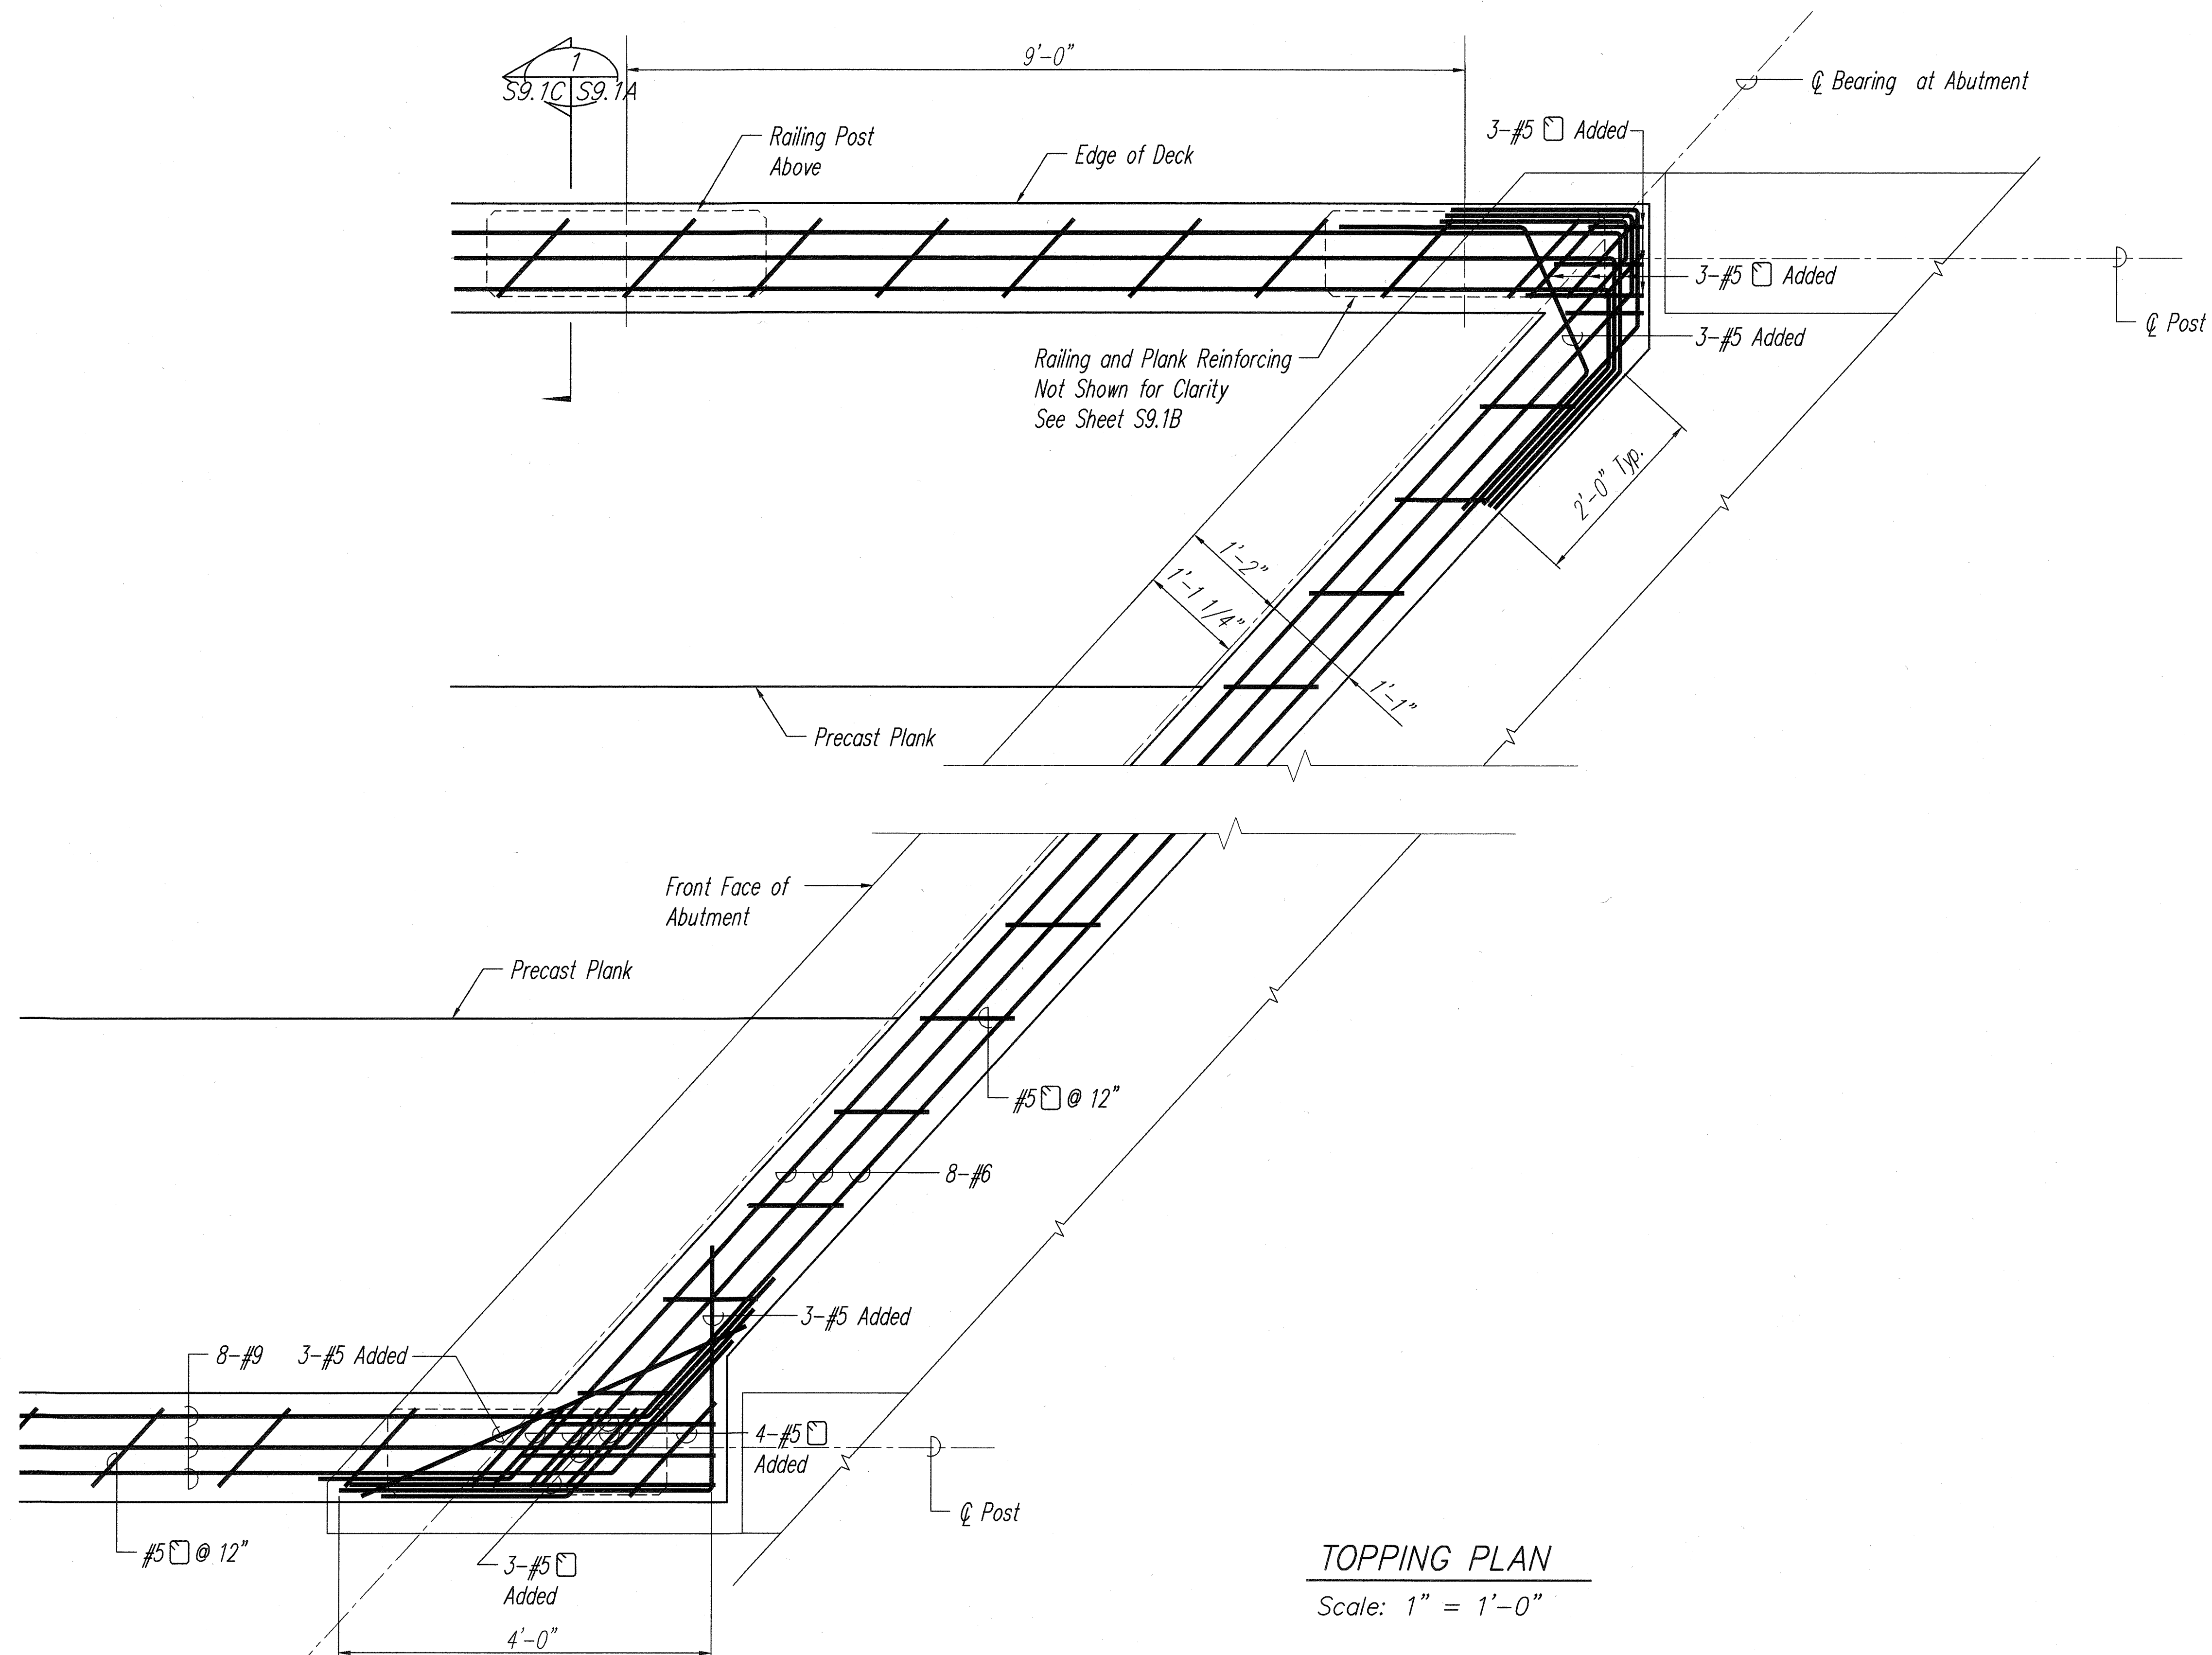

Note:
Cast In Place Beam Stirrups shall be Placed Parallel to the Skew of the Bridge

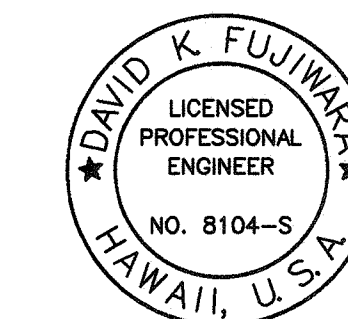

David K. Fujiwara
THIS WORK WAS PREPARED BY ME OR UNDER MY SUPERVISION.

STATE OF HAWAII
DEPARTMENT OF TRANSPORTATION
HIGHWAYS DIVISION

TOPPING PLAN


**MAMALAHOA HIGHWAY
REPLACEMENT OF
KEAIWA STREAM BRIDGE
Federal Aid Project No. ER-12(1)R**

Scale: As Shown Date: January 2001


SHEET No. S9.1C OF 50 SHEETS

ORIGINAL PLAN	SURVEY PLOTTED BY	DATE
NO. 1	NOV 2000	
NO. 2		
NO. 3		
NO. 4		
NO. 5		
NO. 6		
NO. 7		
NO. 8		
NO. 9		
NO. 10		




FED. ROAD DIST. NO.	STATE	FED. AID PROJ. NO.	FISCAL YEAR	SHEET NO.	TOTAL SHEETS
HAWAII	HAW.	ER-12(1)R	2001	56	77

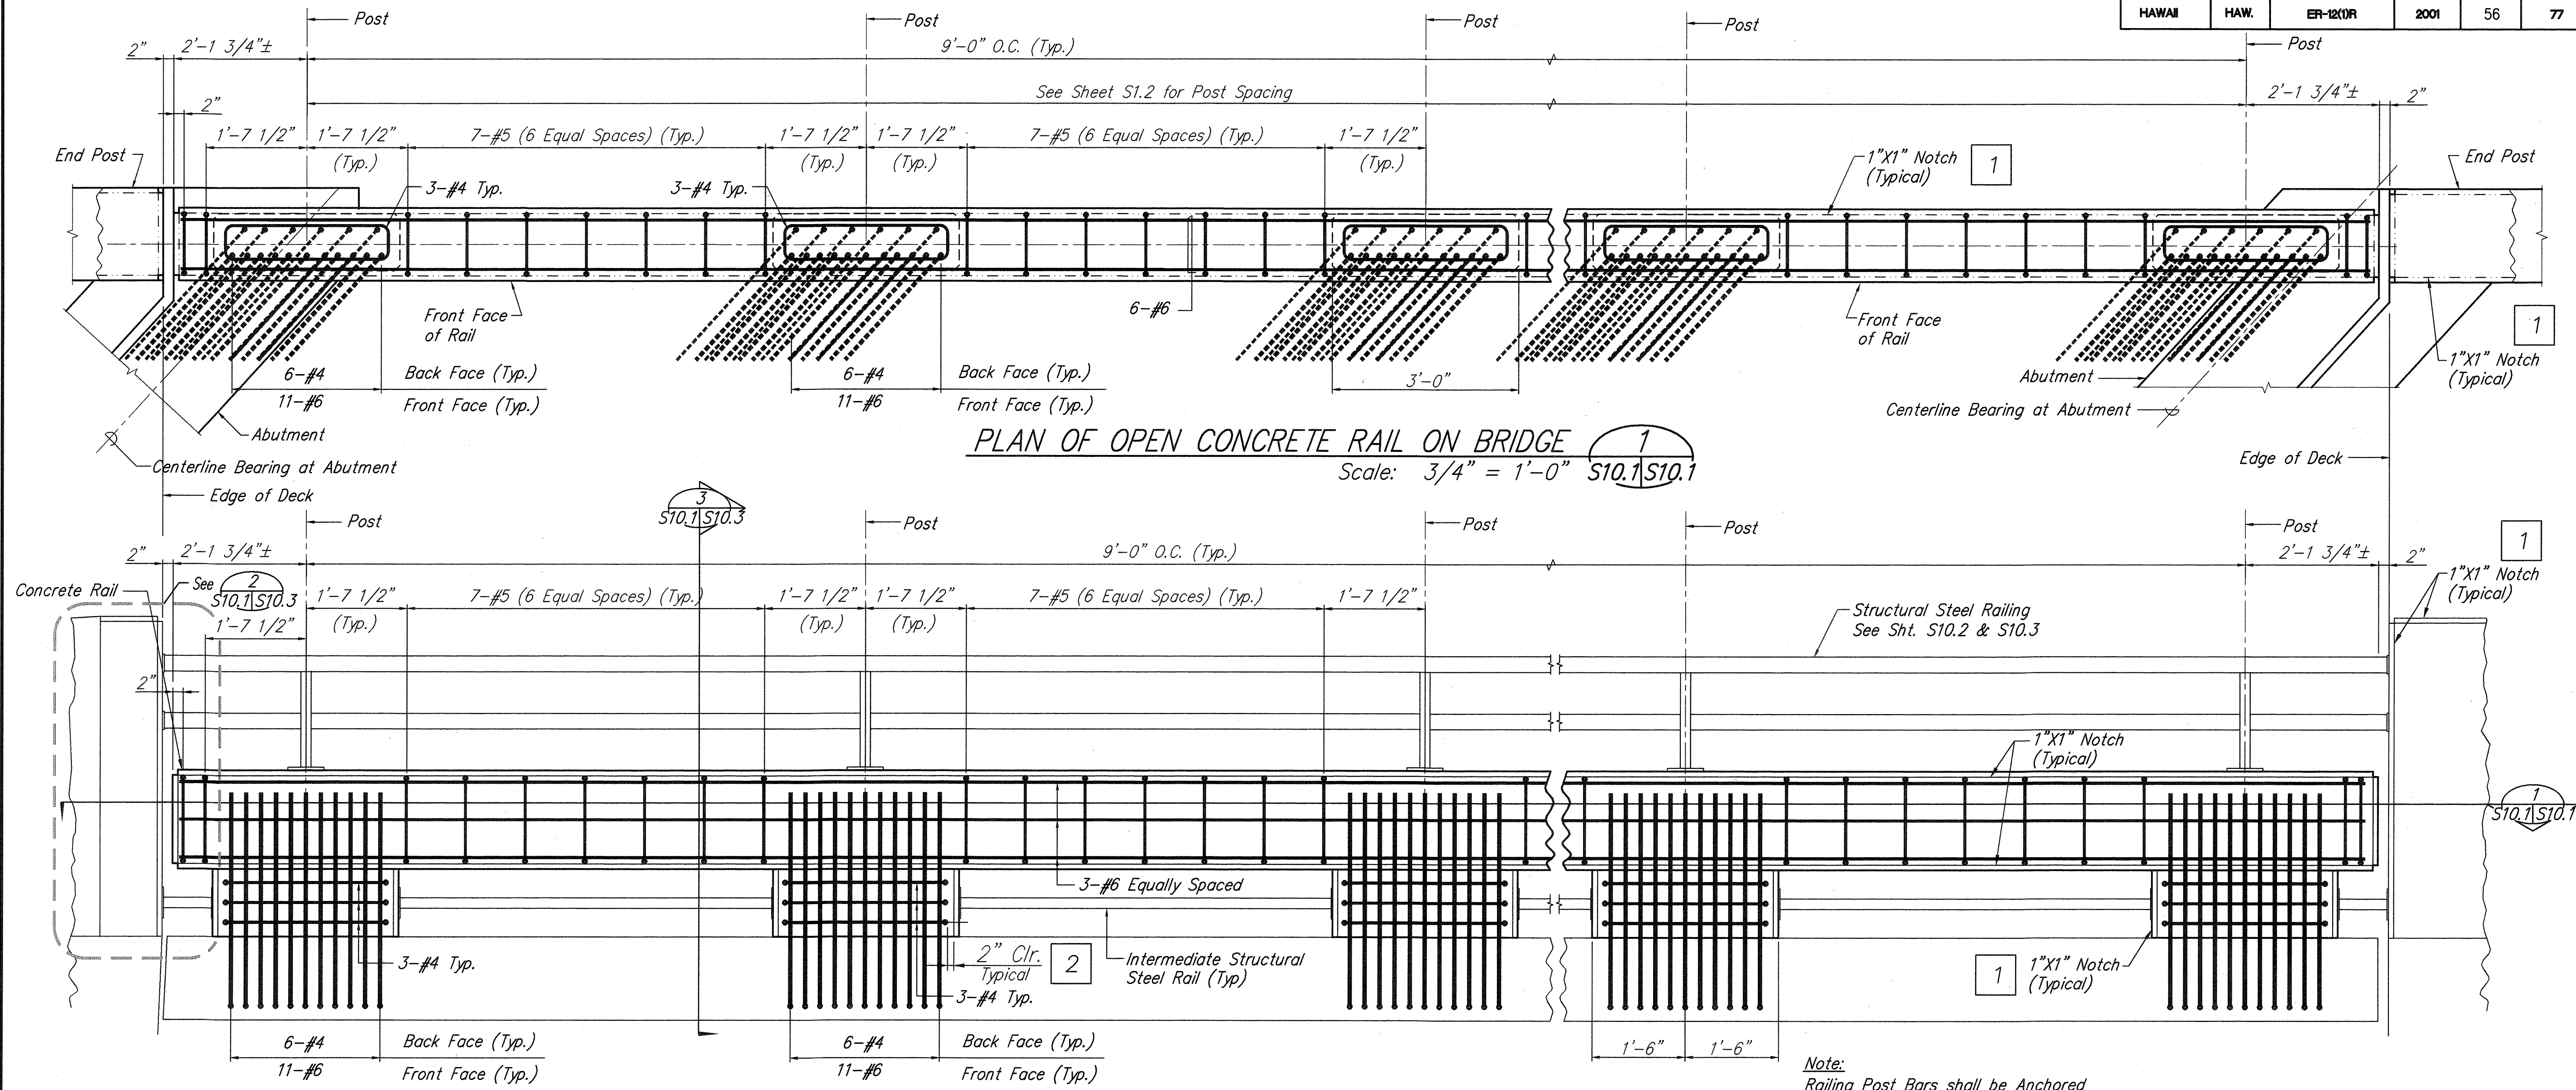


- NOTES:**
- Grind All Outer Corners of Notches to a Uniform 1/8" Radius.
 - Color and Texture of Concrete Shall Match Adjacent Surfaces and Damaged and Non-Uniform Surfaces Shall be Patched.

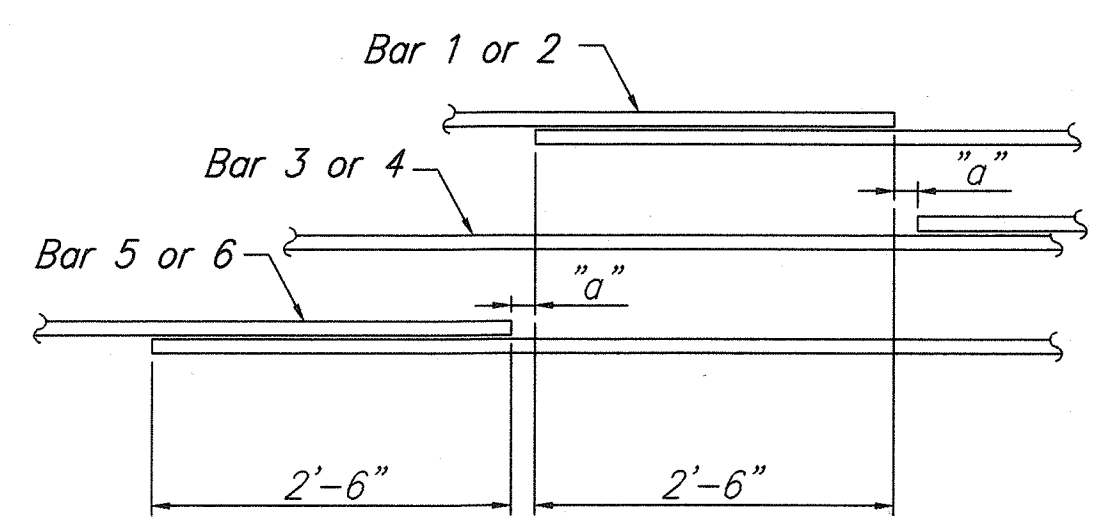

Laps for Bars 1 and 5 shall be staggered.
Laps for Bars 2 and 6 shall be staggered.
Bar 3 to be continuous through laps for Bars 1 and 5
Bar 4 to be continuous through laps for Bars 2 and 6
"a" ≥ Zero

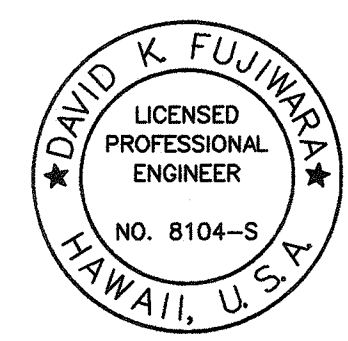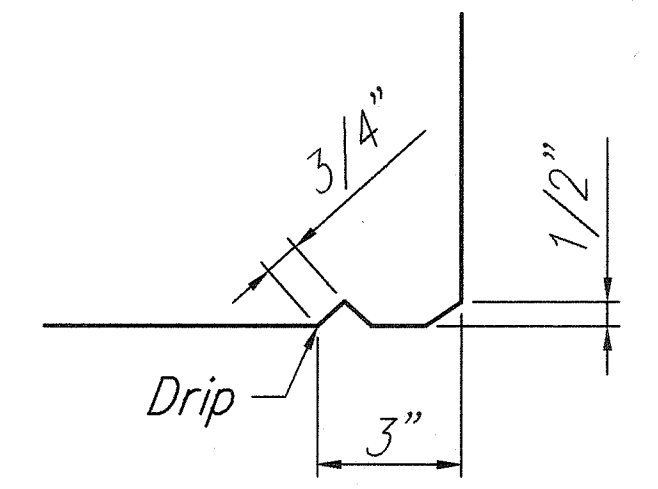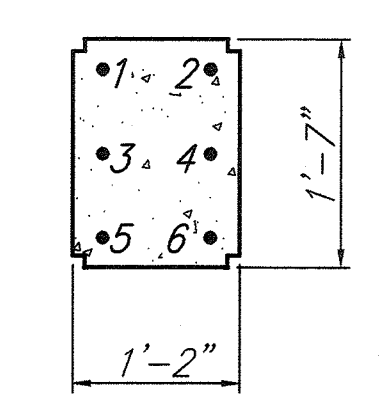


THIS WORK WAS PREPARED BY ME OR UNDER MY SUPERVISION.

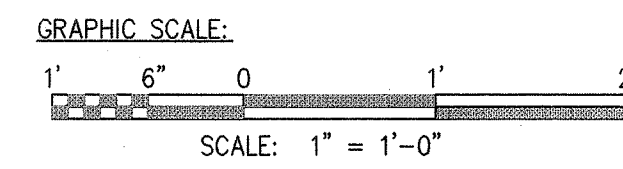

DATE	DESCRIPTION
01-29-01	1 Added Notch in Railing
01-29-01	2 Added Note
01-29-01	3 Changed Detail Number
01-29-01	4 Move Detail
RAILING SECTION AND DETAILS	
STATE OF HAWAII DEPARTMENT OF TRANSPORTATION HIGHWAYS DIVISION	
MAMALAHOA HIGHWAY REPLACEMENT OF KEAIWA STREAM BRIDGE Federal Aid Project No. ER-12(1)R	
Scale: As Shown	Date: January 2001
SHEET No. S10.1 OF 50 SHEETS	


SURVEY PLOTTED BY	DATE
DESIGNED BY	NOV2000
DESIGNED BY KSF	
QUANTITIES BY	
CHECKED BY	
ORIGINAL PLAN	
NOTE BOOK	
No.	

FED. ROAD DIST. NO.	STATE	FED. AID PROJ. NO.	FISCAL YEAR	SHEET NO.	TOTAL SHEETS
HAWAII	HAW.	ER-12(1)R	2001	58	77

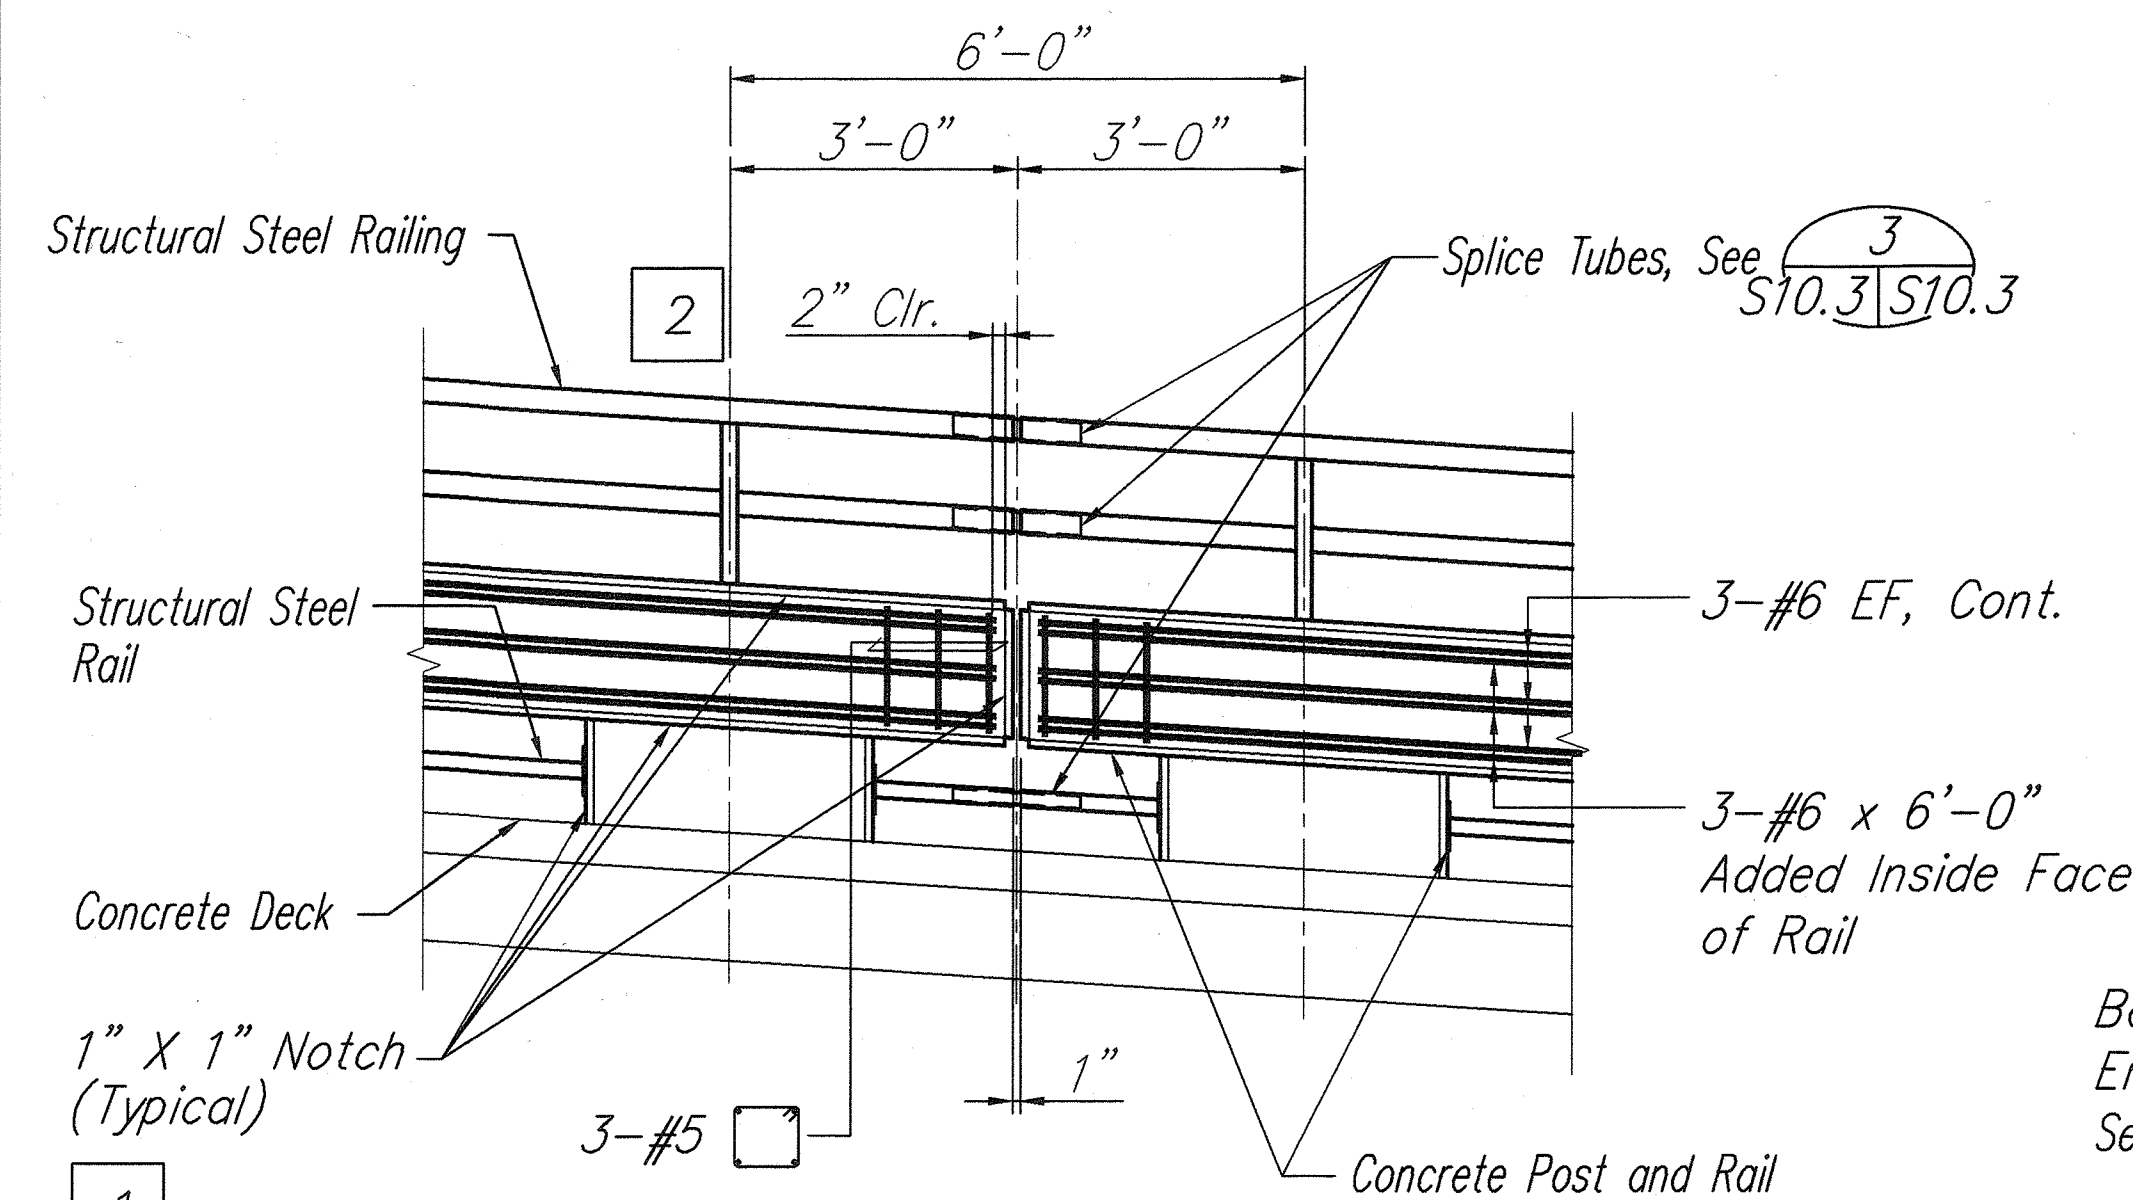


Note:
See Sheets S10.1 and S10.2 for Additional Details

TYPICAL RAILING EXPANSION JOINT
Scale: 1/2" = 1'-0" **S1.2 S10.3**

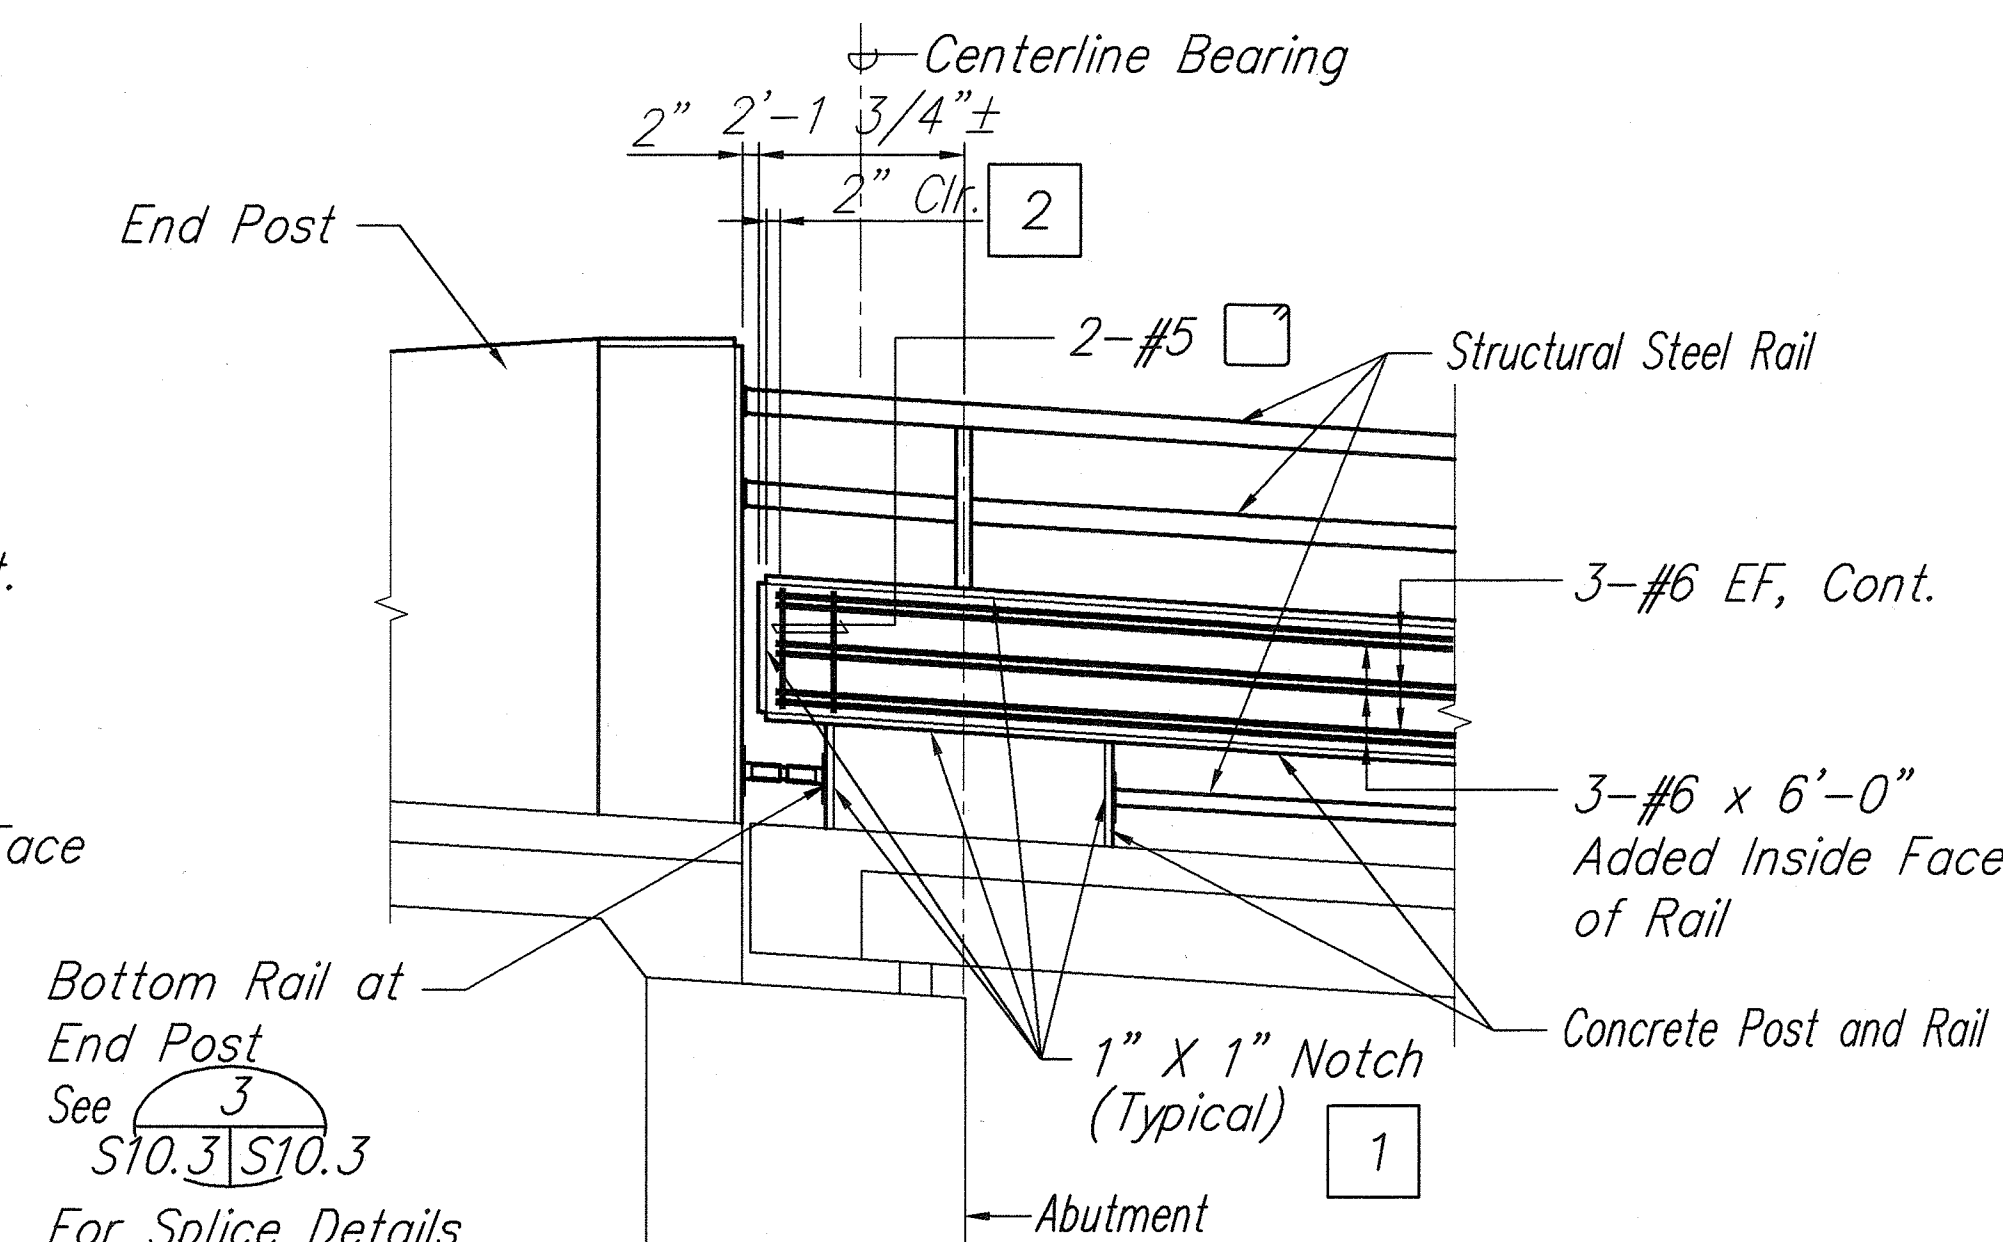


Note:
See Sheet S10.1 and S10.2 for Additional Details


TYPICAL RAILING DETAIL AT END POST
Scale: 1/2" = 1'-0" **S10.1 S10.3 S1.2**

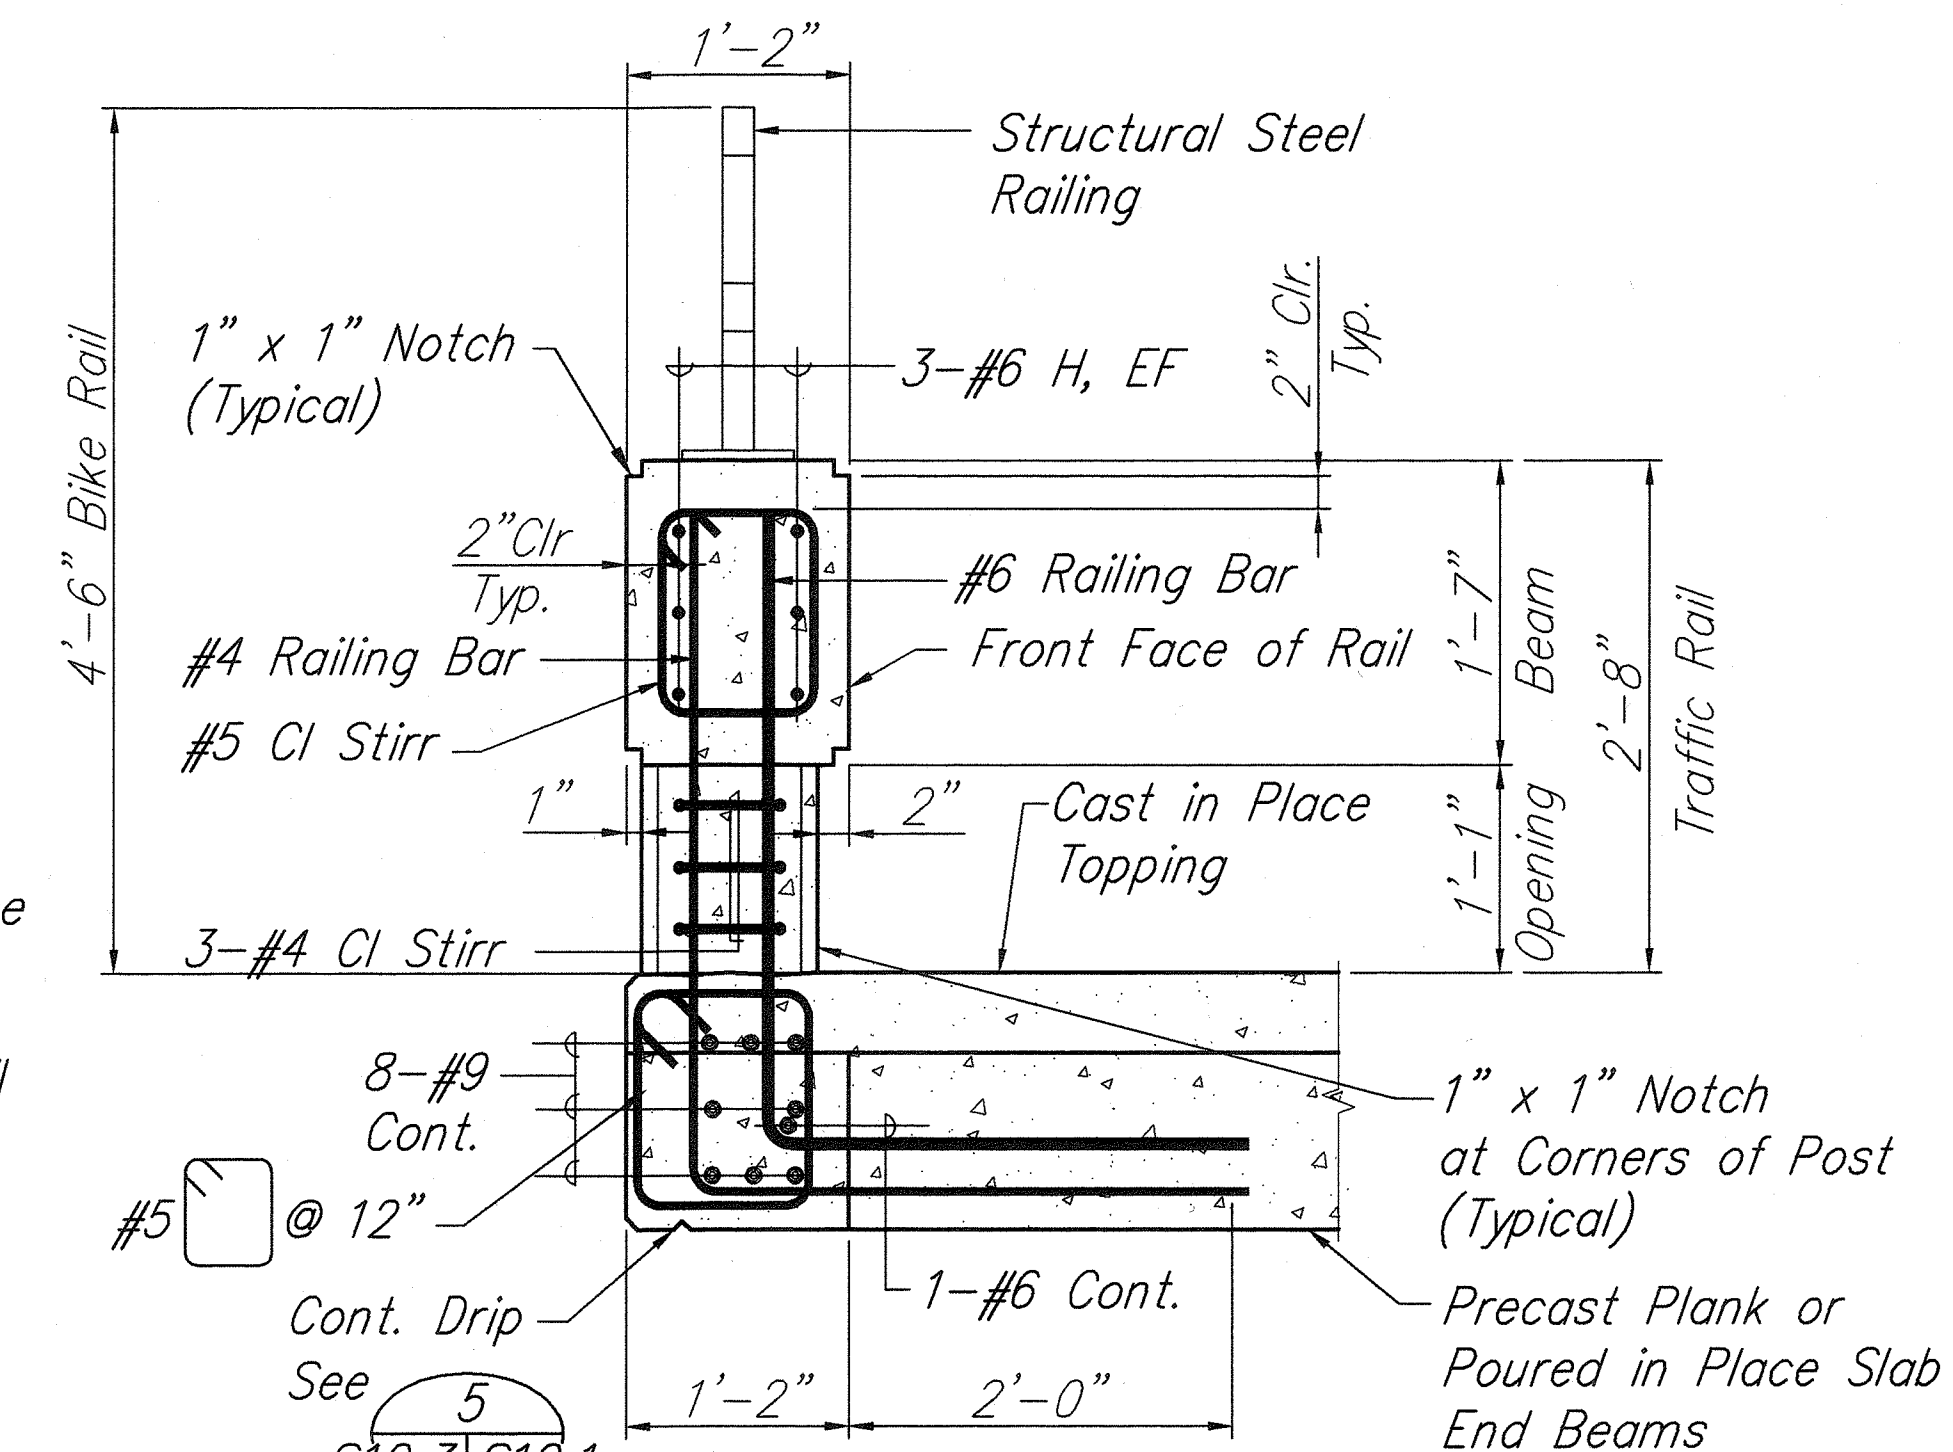

SECTION 3
SCALE: 1" = 1'-0" **S10.1 S10.3**

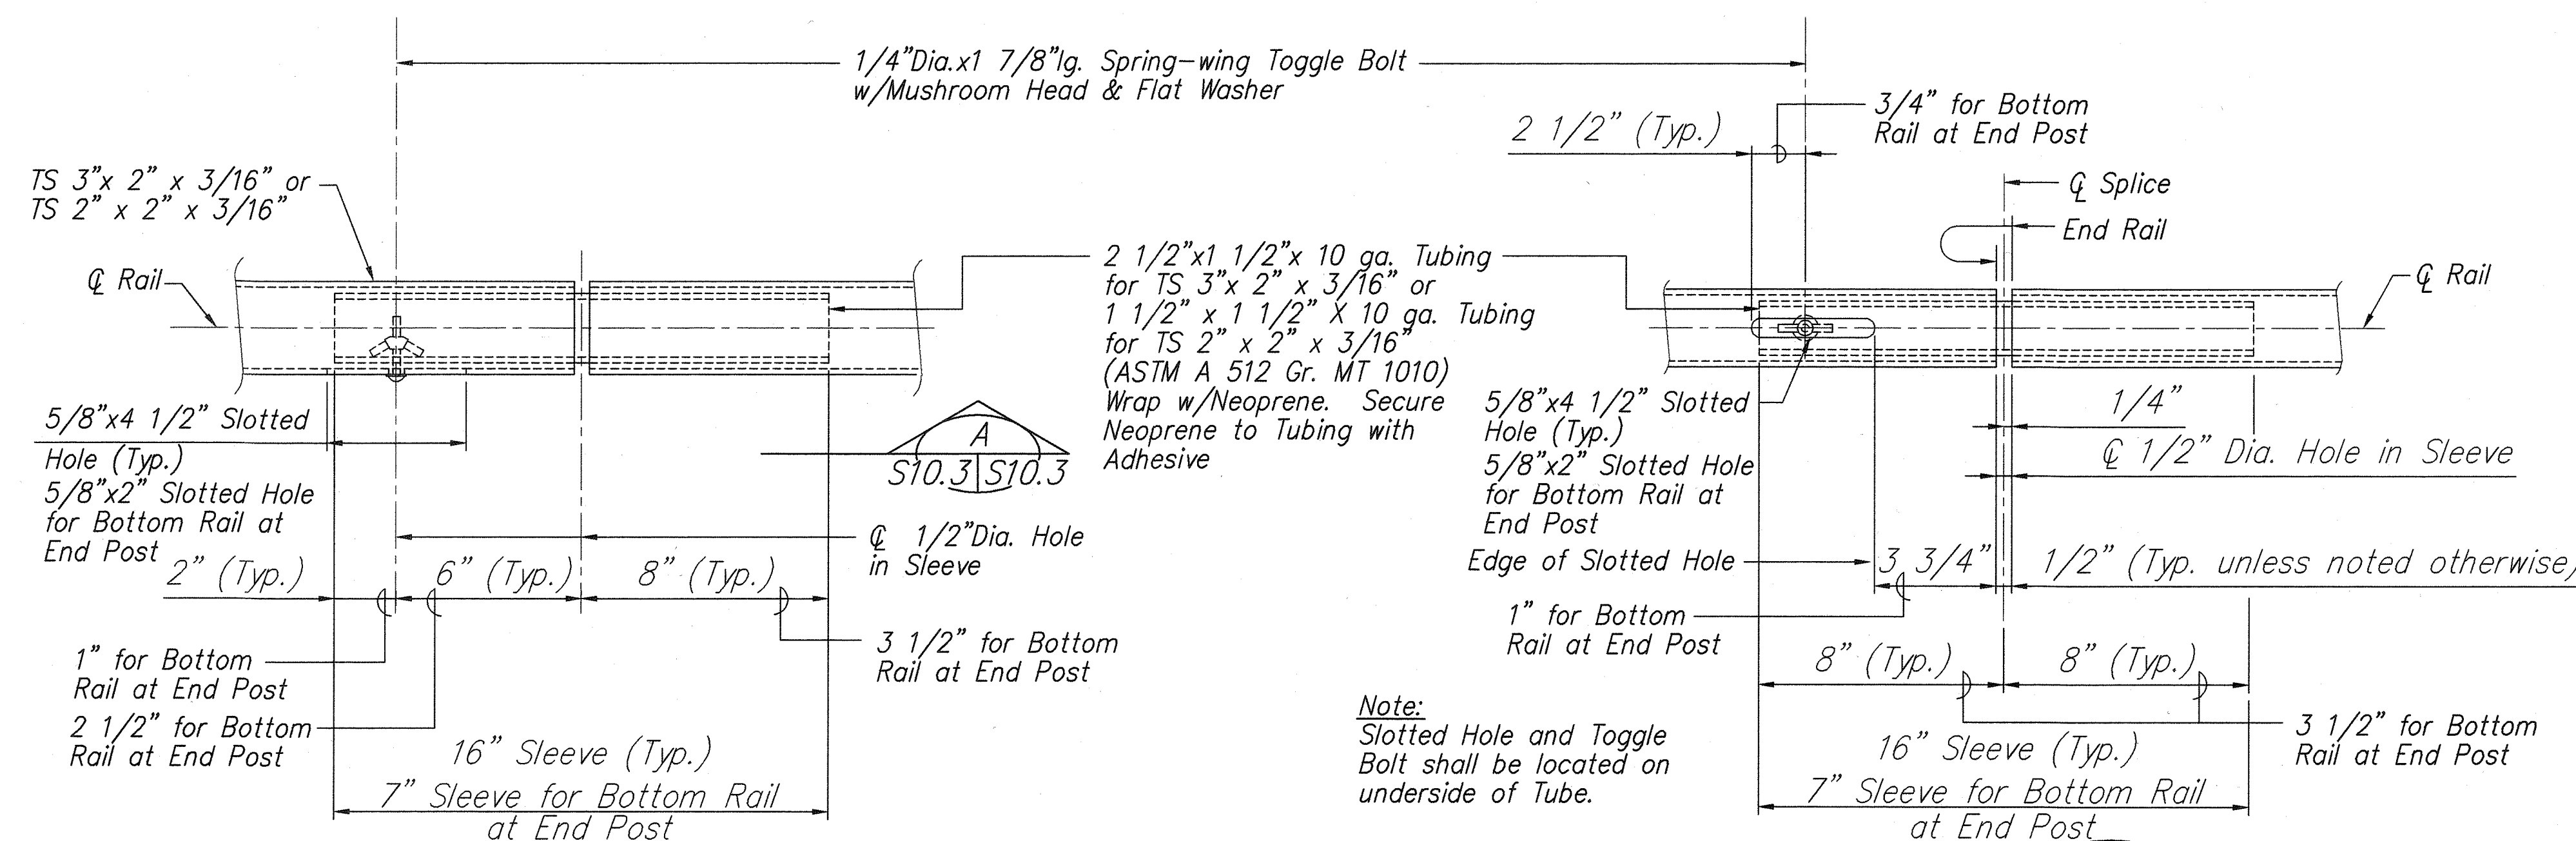


TYPICAL TUBE SPLICE DETAIL
Not to Scale **S10.3 S10.3**

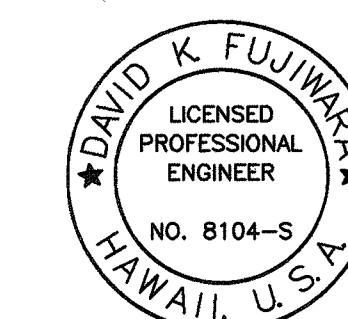

THIS WORK WAS PREPARED BY
ME OR UNDER MY SUPERVISION.

01-29-01	1	Added Notch
01-29-01	2	Added Note
01-29-01	3	Added Detail

DATE	DESCRIPTION
STATE OF HAWAII DEPARTMENT OF TRANSPORTATION HIGHWAYS DIVISION	
RAILING SECTION AND DETAILS	
MAMALAHOA HIGHWAY REPLACEMENT OF KEAIWA STREAM BRIDGE Federal Aid Project No. ER-12(1)R	
Scale: As Shown	Date: January 2001
SHEET No. S10.3 OF 50 SHEETS	

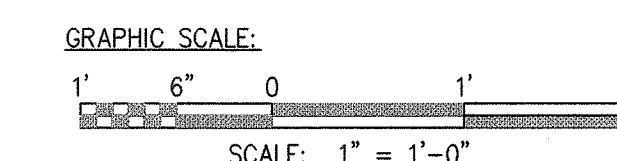

ORIGINAL PLAN	DATE NOV2000
DESIGNED BY KSE	DRAWN BY KSE
CHECKED BY	NOTED BY
QUANTITIES BY	DESIGNED BY KSE
NO.	

ORIGINAL PLAN	SURVEY PLATTED BY	DATE	NOV/2000
	DRAWN BY	"	"
	TRACED BY	"	"
	DESIGNED BY	"	"
NOTE BOOK	QUANTITIES BY		
	CHECKED BY		
No.			

CONSTRUCTION SEQUENCE

STAGE 1: Construct the following in accordance with the Bridge and Roadway Best Management Practices (BMPs): 1

- (1) Abutments No. 1 and No. 2
- (2) Wingwalls No. 1, No. 2, No. 3 and No. 4
- (3) All Piers

Notes: (i) Probing and grouting is included in this stage. 1

(ii) Do not place concrete backfill above footings at all piers until Stage 7.

1 (For Stages 2 through 6, see note below.)

STAGE 2: Erect precast planks at least seven (7) days after pier and abutment pour or until pier and abutment concrete has attained a compressive strength of 3500 psi, whichever occurs later. Concrete compressive strength for precast planks shall have a compressive strength of 7000 psi.

STAGE 3: Pour deck topping except at "Delayed Pour Strip" at Pier 3.

STAGE 4: Construct Railings except at "Delayed Pour Strip" at Pier 3.

For Live Loading requirements, refer to Section 503.03(E) of the Hawaii Standard Specifications for Road, Bridge and Public Works Construction except between Pier 2 and Pier 4 where the Live Load shal be limited to 50 psf or one (1) vehicle with a gross weight not exceeding 5 kips on each side of the "Delayed Pour Strip".

STAGE 5: Pour concrete in "Delayed Pour Strip" thirty (30) days after entire deck pour in Stage 3.

STAGE 6: Construct remaining portion of railing at "Delayed Pour Strip" location.


STAGE 7: Pour concrete backfill above footings at all Piers. Prior to pour, setup one layer of sandbag containment around the footings. 1

STAGE 8: Bridge may be opened for traffic after the concrete in the pour strip and railing have attained a compressive strength of 5000 psi and 4000 psi, respectively, or at least 7 days after the newest pour, whichever occurs later.


STAGE 9: 1 Remove existing detour road and construct embankments, CRM walls, GRP and rip rap in accordance with the Detour Road and Embankments BMPs.

1 NOTE: Stages 2 through 6 will not require containment of work unless stream is flowing. Spilled concrete on the channel shall be removed.

FED. ROAD DIST. NO.	STATE	FED. AID PROJ. NO.	FISCAL YEAR	SHEET NO.	TOTAL SHEETS
HAWAII	HAW.	ER-12(1)R	2001	59	77

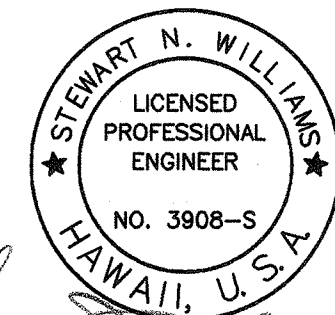

THIS WORK WAS PREPARED BY ME OR UNDER MY SUPERVISION.

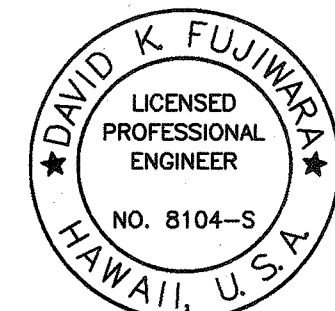

THIS WORK WAS PREPARED BY ME OR UNDER MY SUPERVISION.

01-29-01 1 Modified Note

DATE	DESCRIPTION
STATE OF HAWAII DEPARTMENT OF TRANSPORTATION HIGHWAYS DIVISION	
CONSTRUCTION SEQUENCE	
MAMALAHOA HIGHWAY REPLACEMENT OF KEAIWA STREAM BRIDGE Federal Aid Project No. ER-12(1)R	
Scale: As Shown	Date: January 2001
SHEET No. S11.1 OF 50 SHEETS	