

| INDEX TO DRAWINGS |                                        |
|-------------------|----------------------------------------|
| SHEET NO.         | DESCRIPTION                            |
| 1                 | TITLE SHEET                            |
| 2                 | STANDARD PLANS SUMMARY                 |
| 3 - 4             | WATER POLLUTION & EROSION CONTR. NOTES |
| 5                 | CONSTRUCTION NOTES                     |
| 6                 | BORING LOG                             |
| 7 - 8             | DRAINAGE PLANS                         |
| 9 - 13            | DRAINAGE DETAILS                       |

STATE OF HAWAII

DEPARTMENT OF TRANSPORTATION

HIGHWAYS DIVISION

HONOLULU, HAWAII

"AS-BUILT"

PLANS FOR

MAMALAHOA HIGHWAY


MISCELLANEOUS DRAINAGE IMPROVEMENTS

VICINITY OF HOOKENA


PROJECT NO. 11BC-02-01

DISTRICT OF SOUTH KONA

ISLAND OF HAWAII

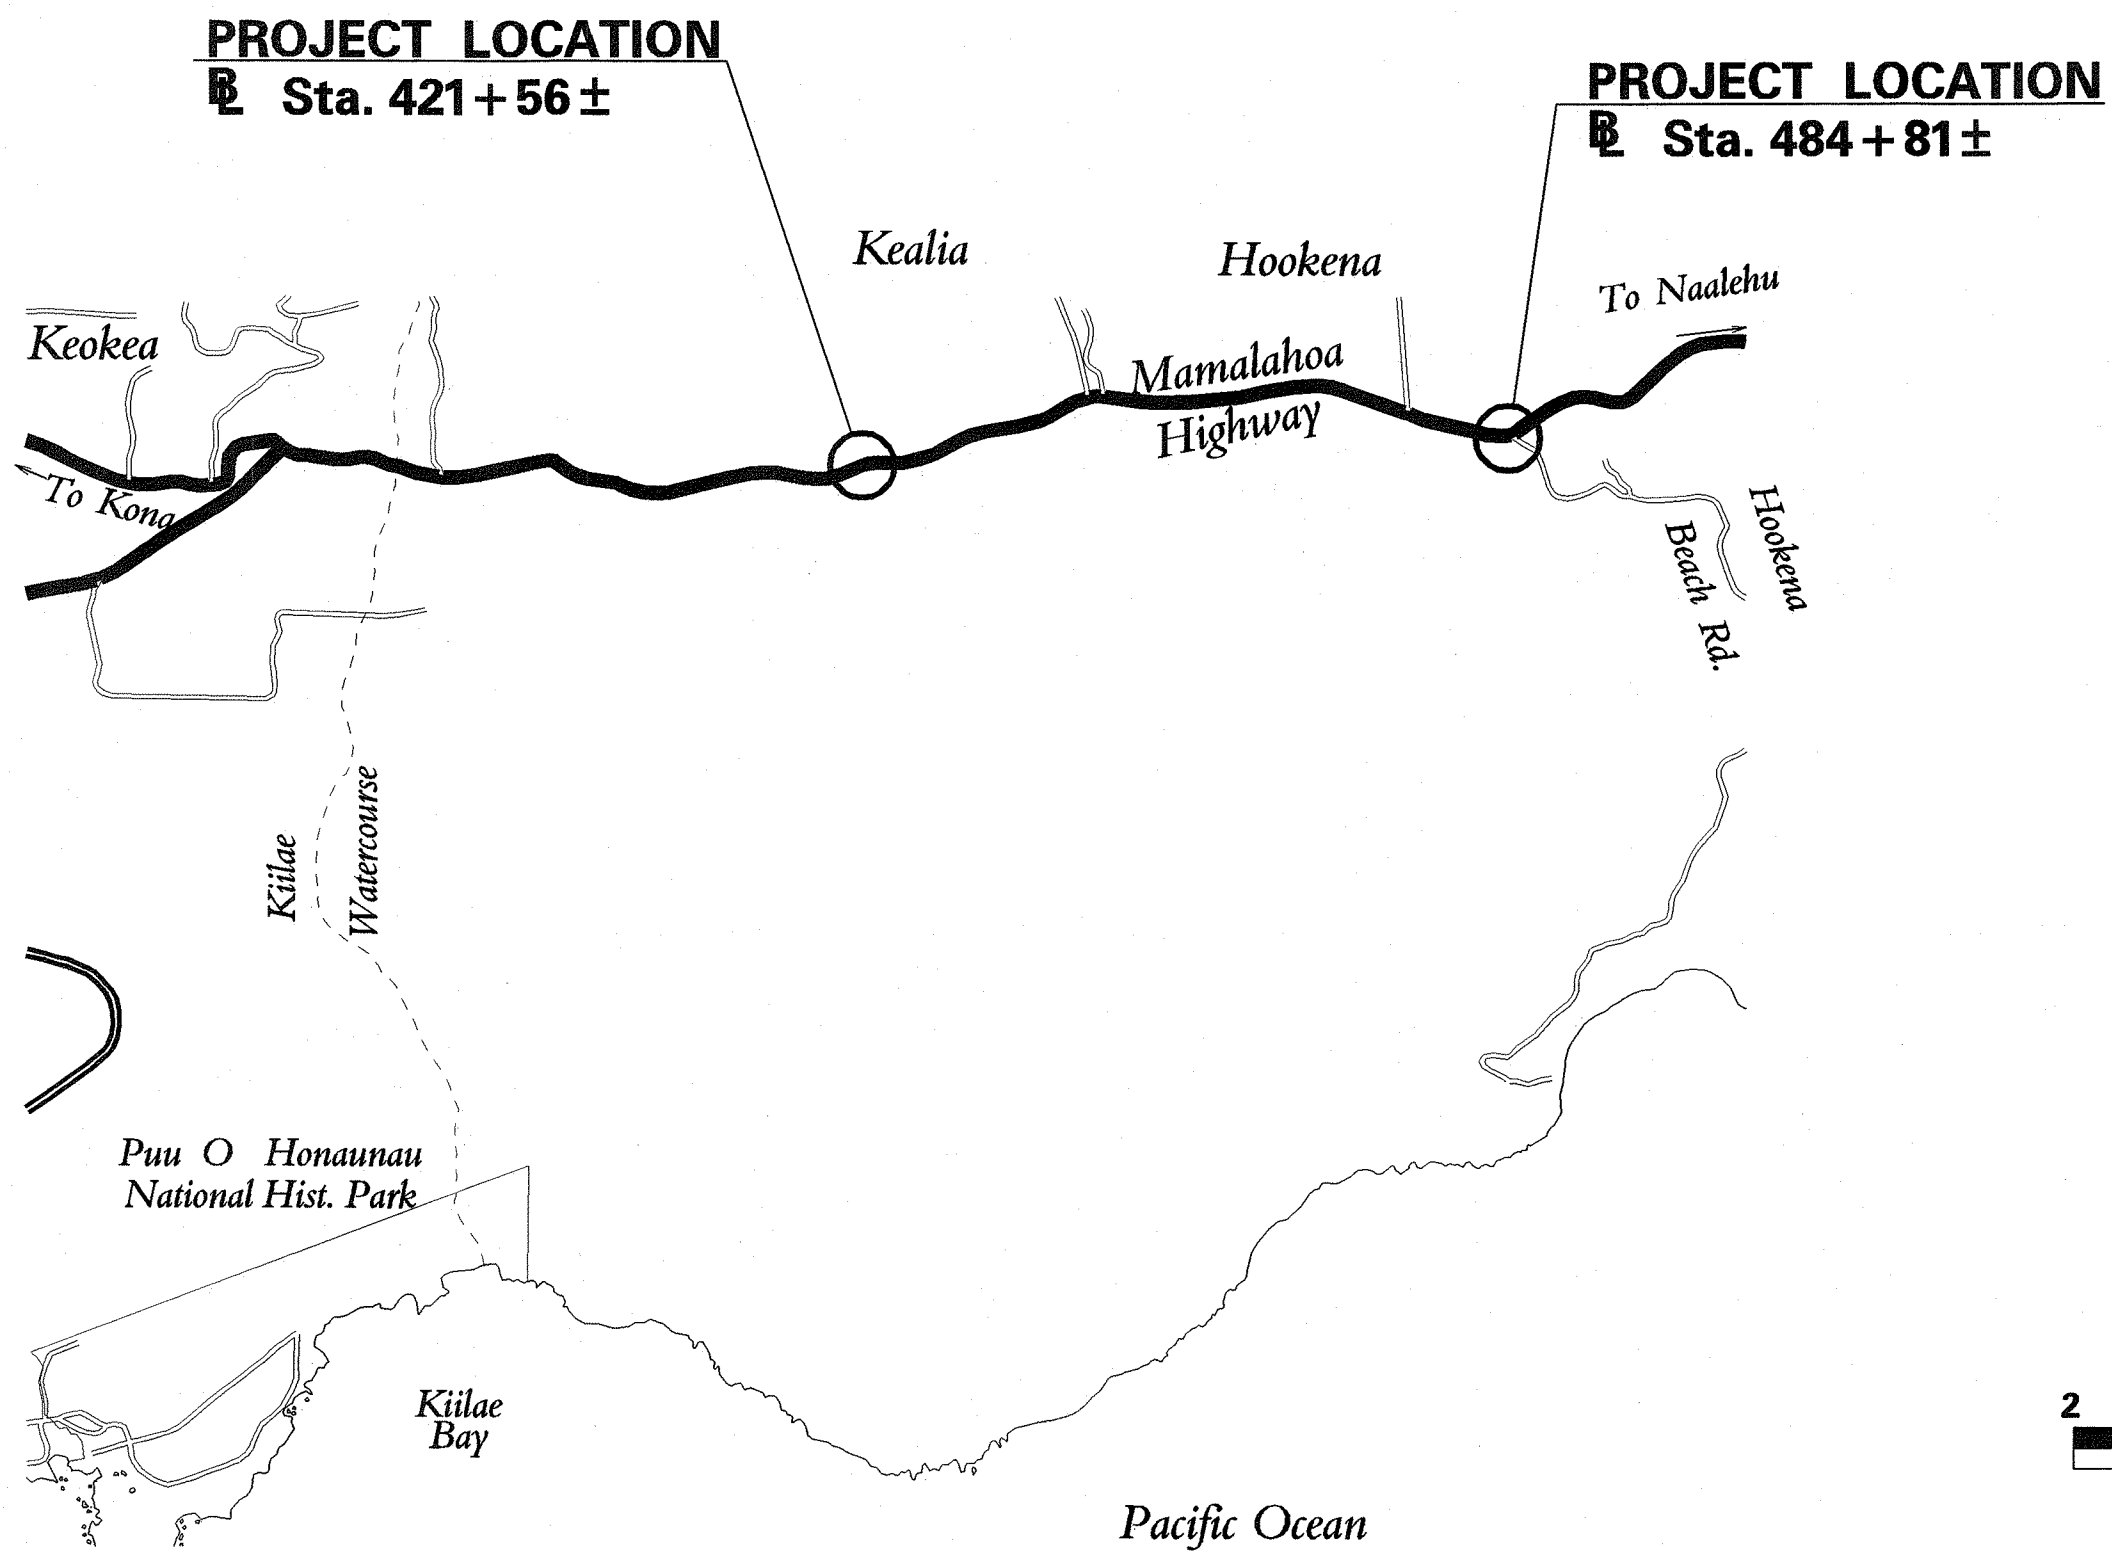

LAYOUT PLAN

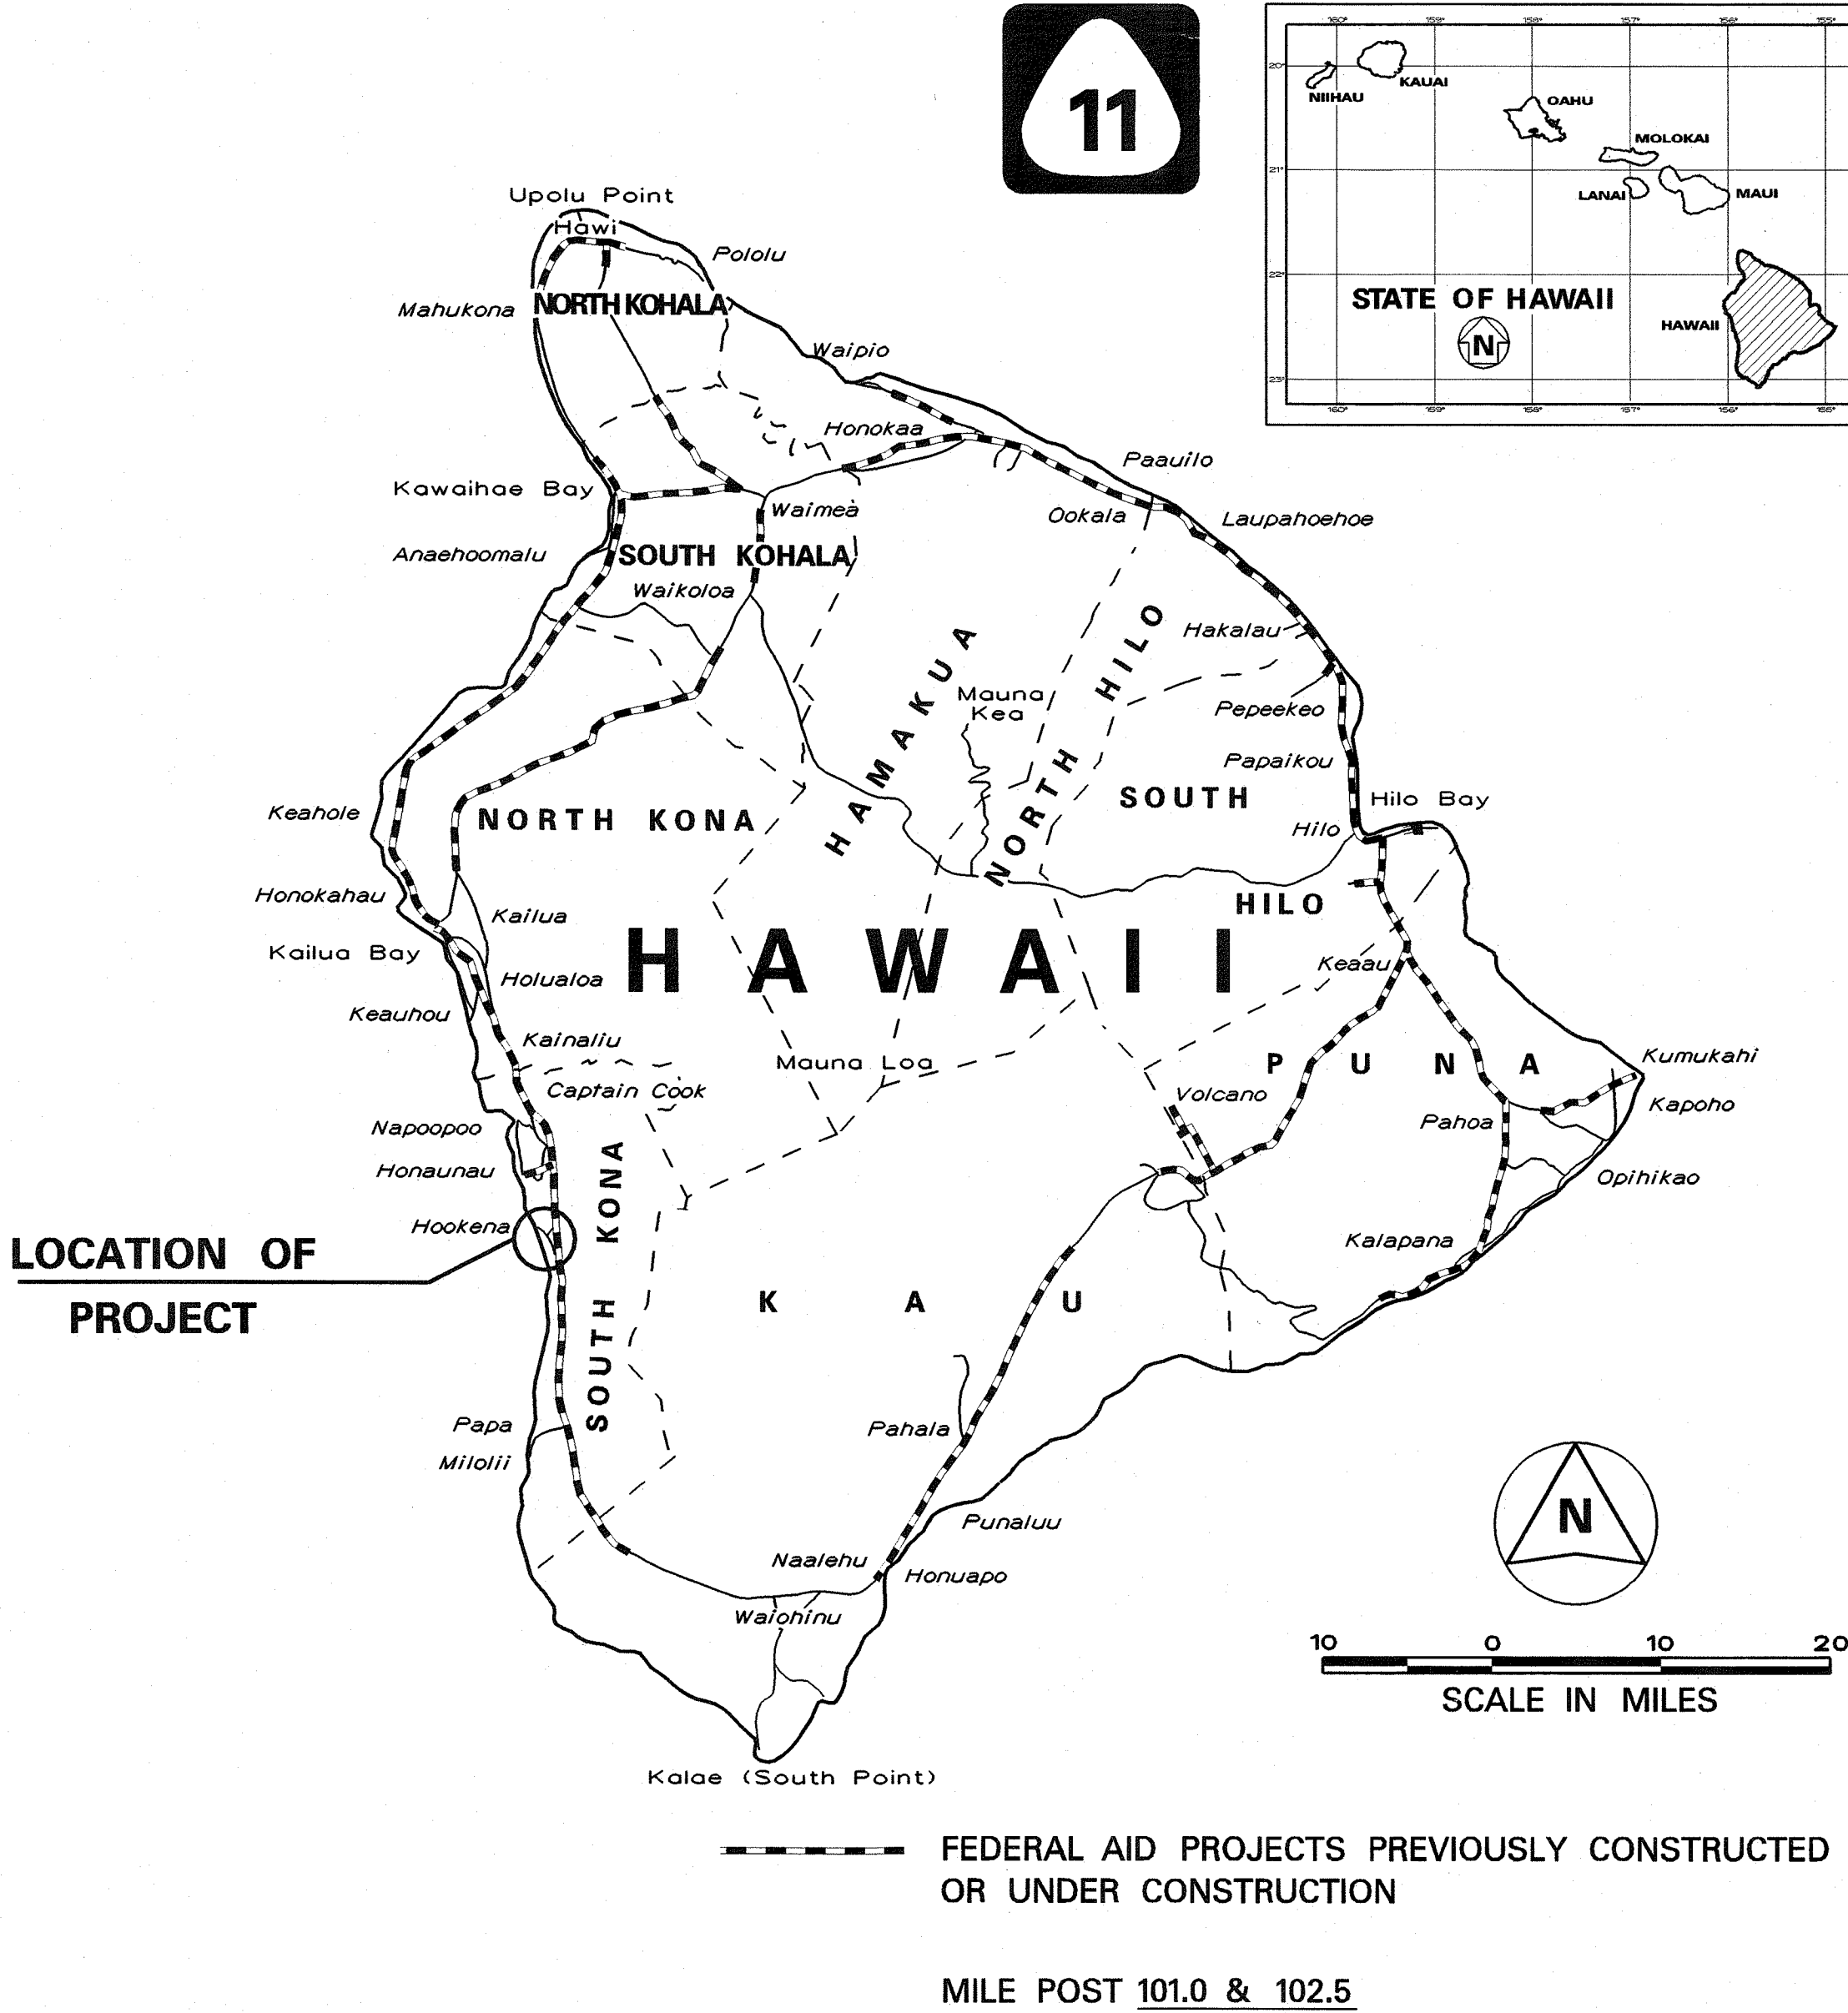

CHANGES MADE DURING CONSTRUCTION HAVE BEEN INCORPORATED ON THESE PLANS EXCEPT CHANGES IN THE ORIGINAL THEORETICAL QUANTITIES. FOR ACTUAL QUANTITIES, REFER TO PROJECT LEDGER AND/OR COMPUTATION BOOK.

*[Signature]* 4/6/2010  
DATE

APPROVED:

*[Signature]* 4/16/2010  
MANAGER DEPT. OF WATER SUPPLY  
COUNTY OF HAWAII DATE

DEPARTMENT OF TRANSPORTATION  
STATE OF HAWAII

APPROVED:

*[Signature]* 4/27/2010  
DIR. OF TRANSPORTATION DATE

DESIGNED BY  
Curtis Matsuda  
P. S. & E. BY  
692-7563  
PHONE  
FEB. 2002  
DATE