

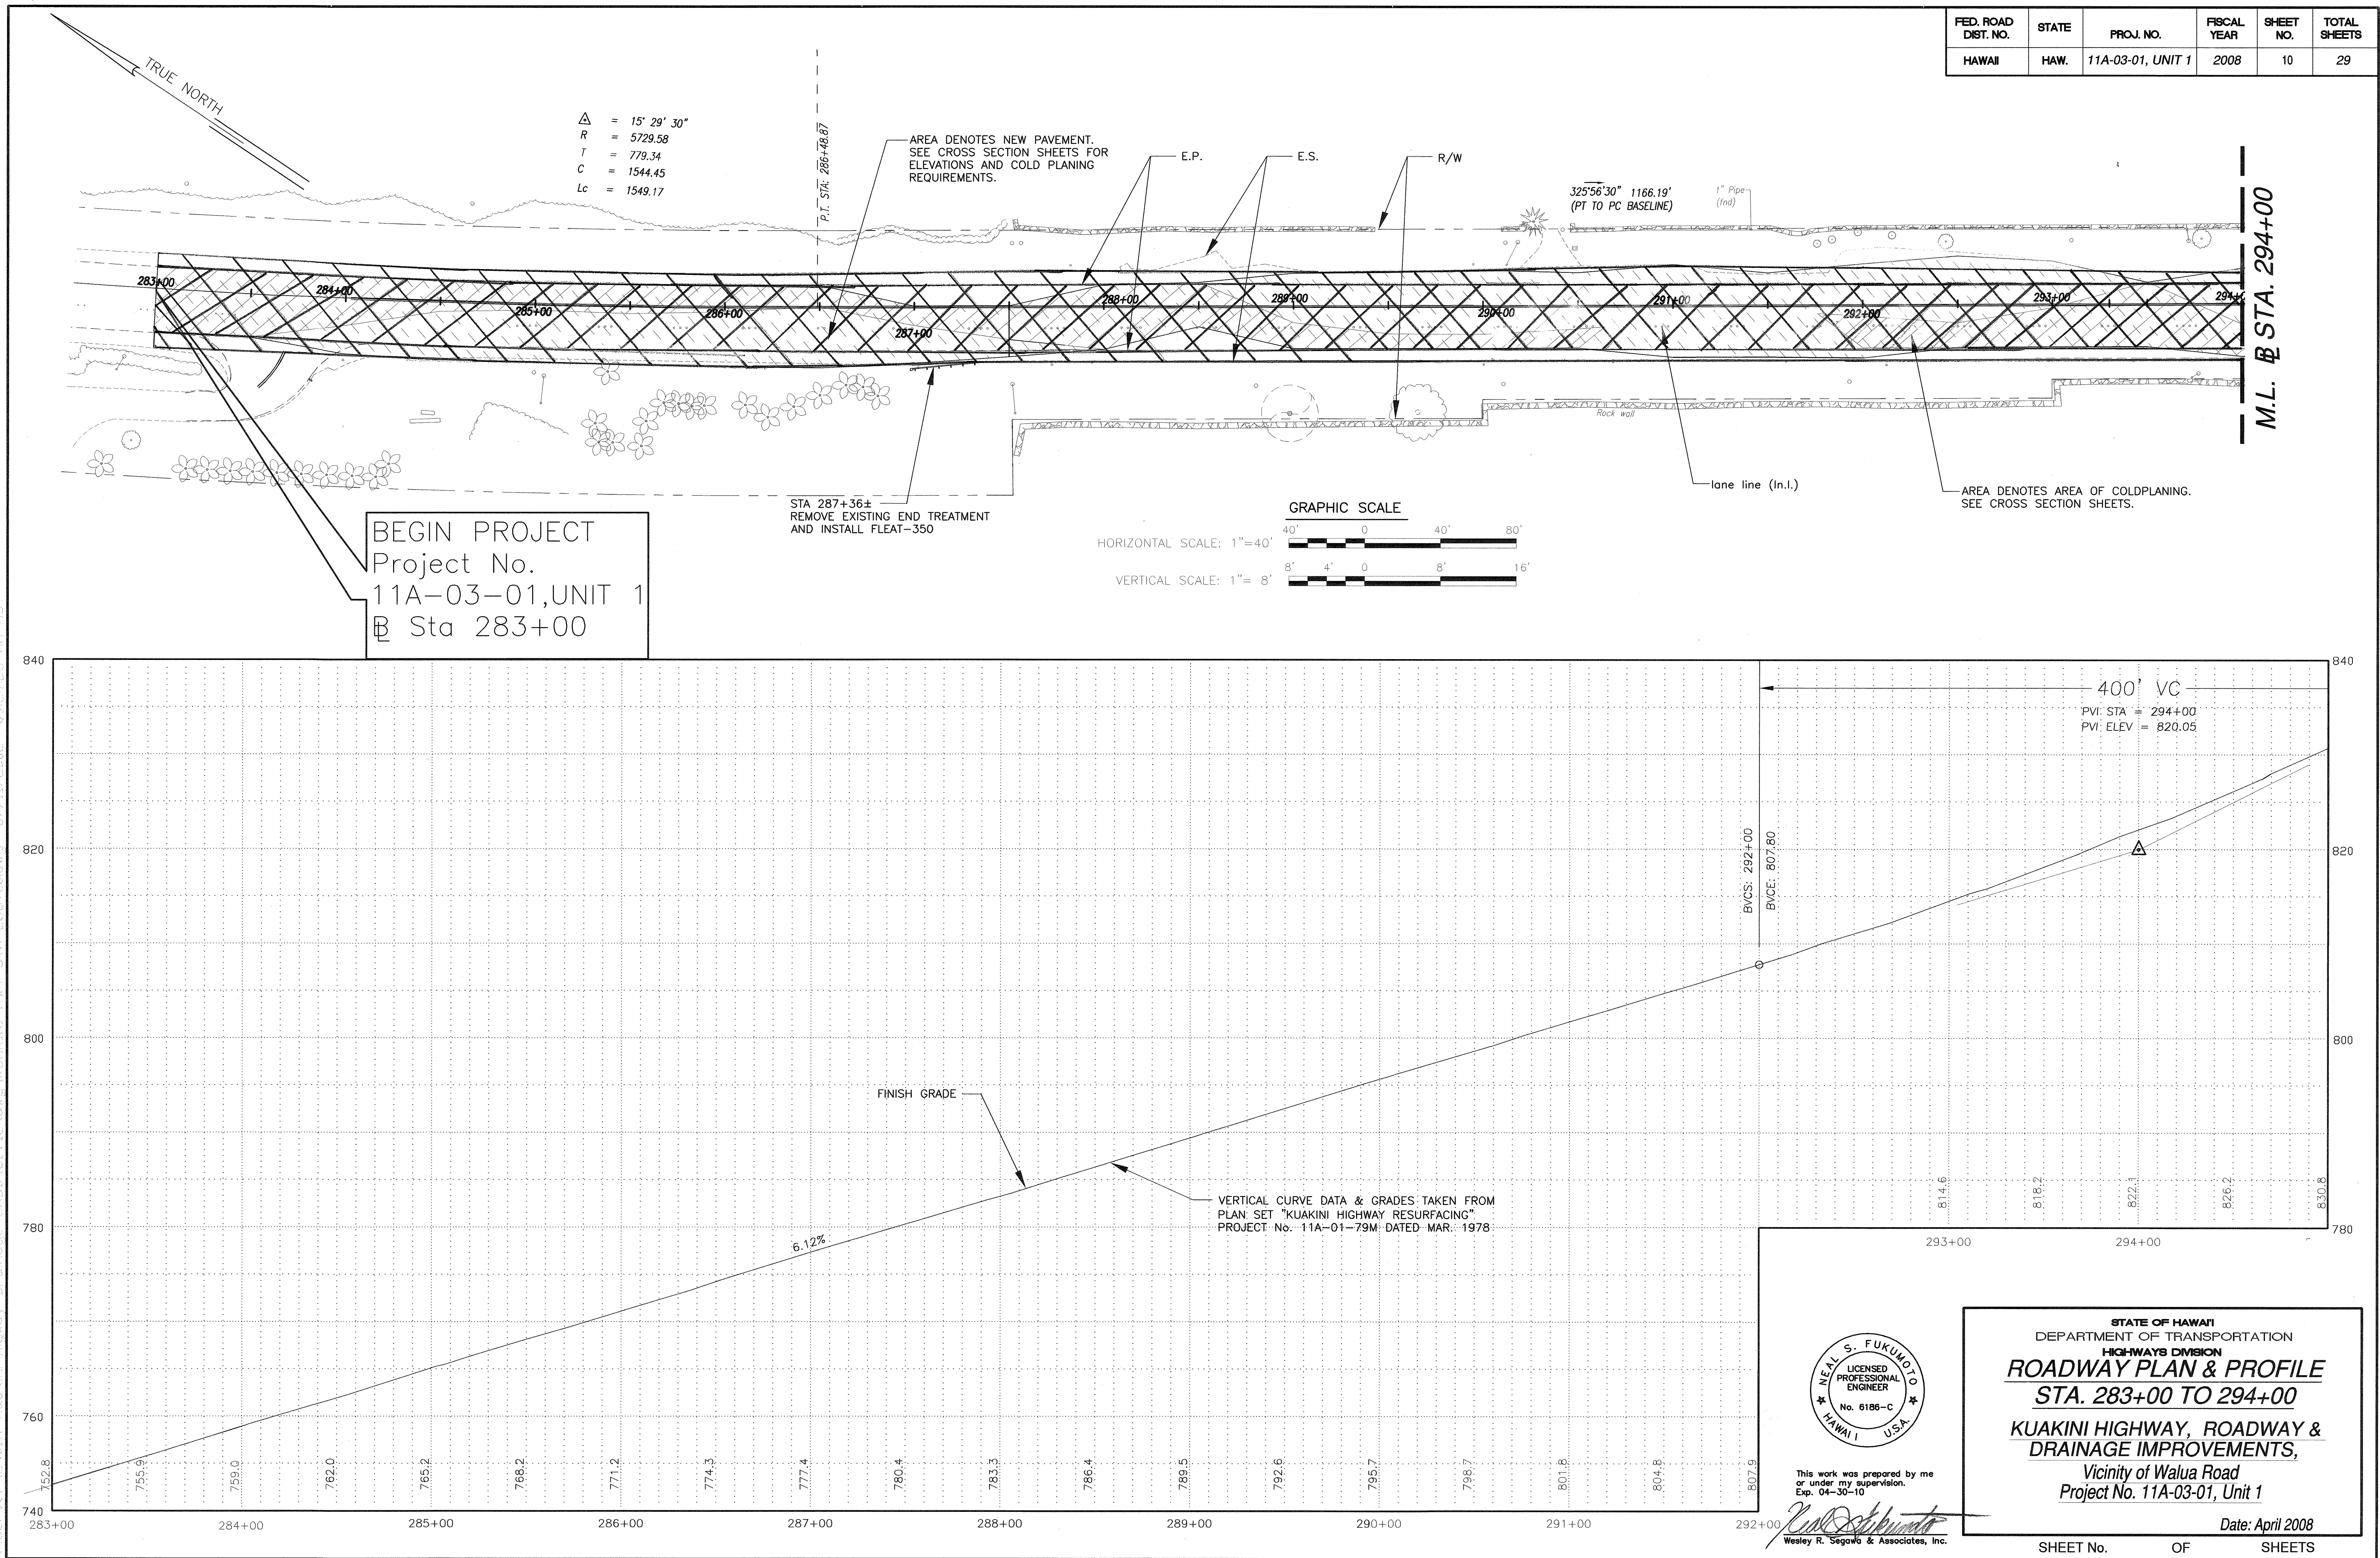
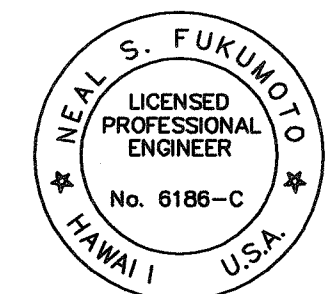


FED. ROAD DIST. NO.	STATE	PROJ. NO.	FISCAL YEAR	SHEET NO.	TOTAL SHEETS
HAWAII	HAW.	11A-03-01, UNIT 1	2008	10	29

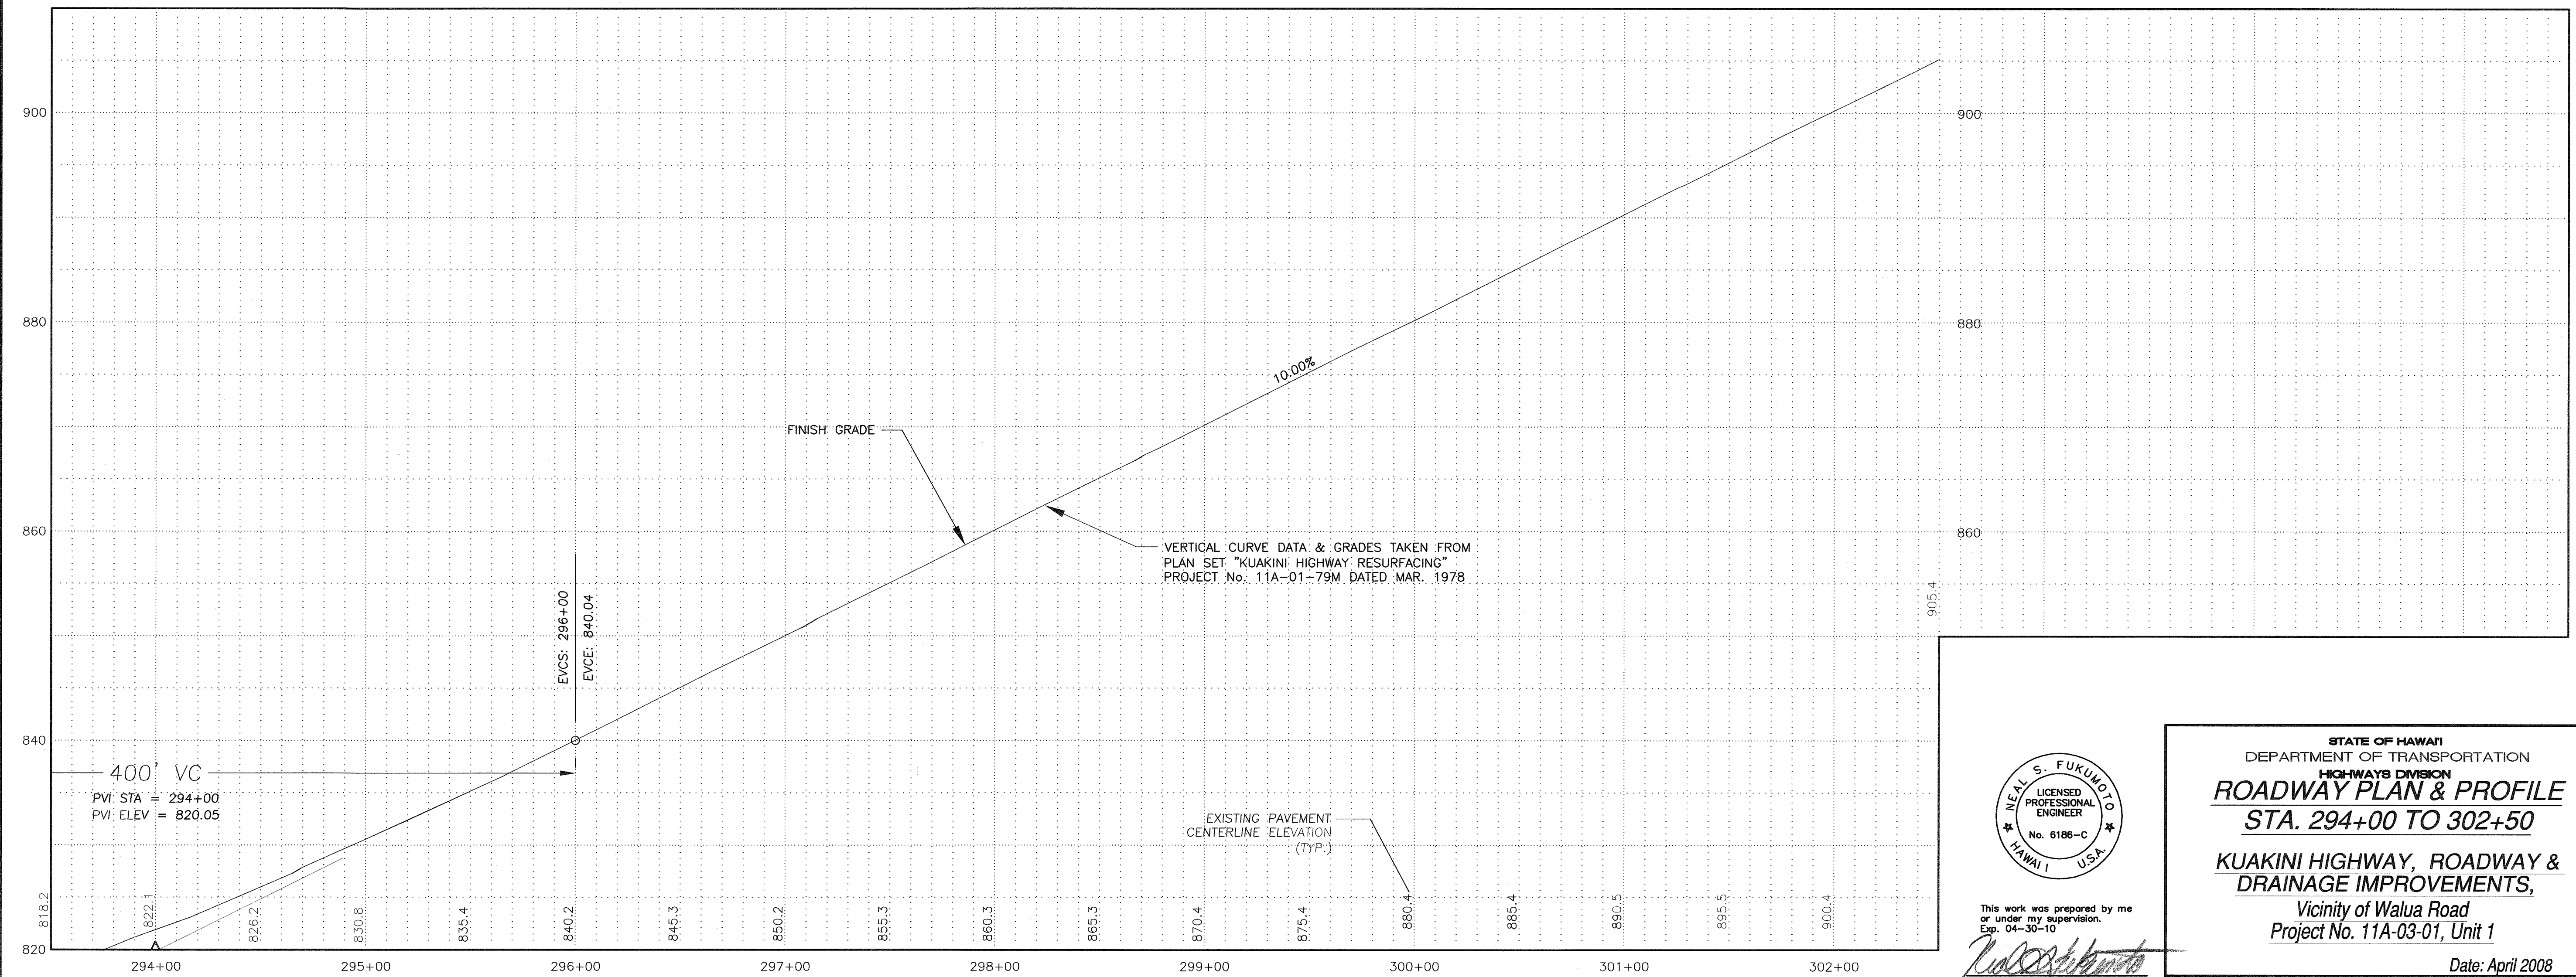

FED. ROAD DIST. NO.	STATE	PROJ. NO.	FISCAL YEAR	SHEET NO.	TOTAL SHEETS
HAWAII	HAW.	11A-03-01, UNIT 1	2008	11	29

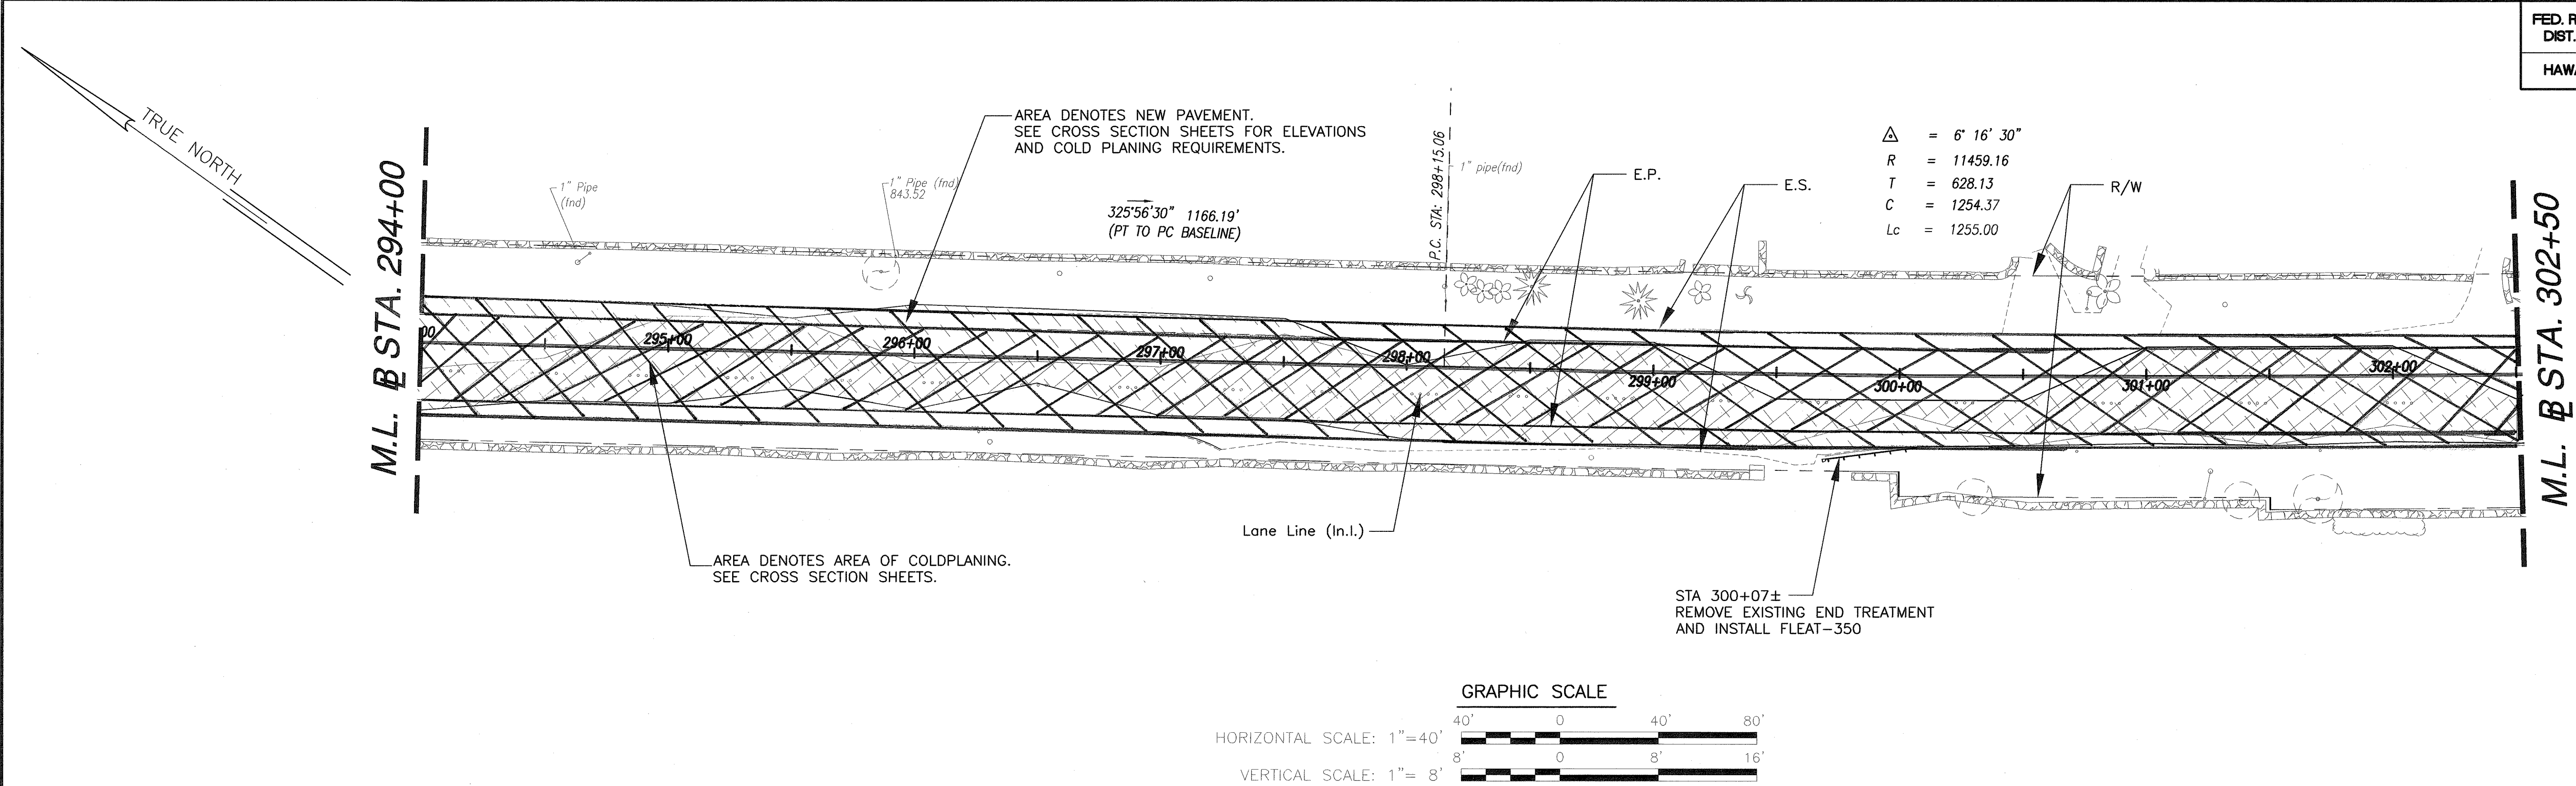

This work was prepared by me or under my supervision.
Exp. 04-30-10
Wesley R. Segawa & Associates, Inc.

STATE OF HAWAII
DEPARTMENT OF TRANSPORTATION
HIGHWAYS DIVISION
ROADWAY PLAN & PROFILE
STA. 294+00 TO 302+50
KUAKINI HIGHWAY, ROADWAY & DRAINAGE IMPROVEMENTS,
Vicinity of Waiua Road
Project No. 11A-03-01, Unit 1





Date: April 2008

SHEET No. OF SHEETS

"AS-BUILT"

11

FED. ROAD DIST. NO.	STATE	PROJ. NO.	FISCAL YEAR	SHEET NO.	TOTAL SHEETS
HAWAII	HAW.	11A-03-01, UNIT 1	2008	12	29

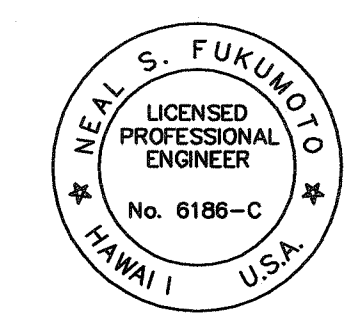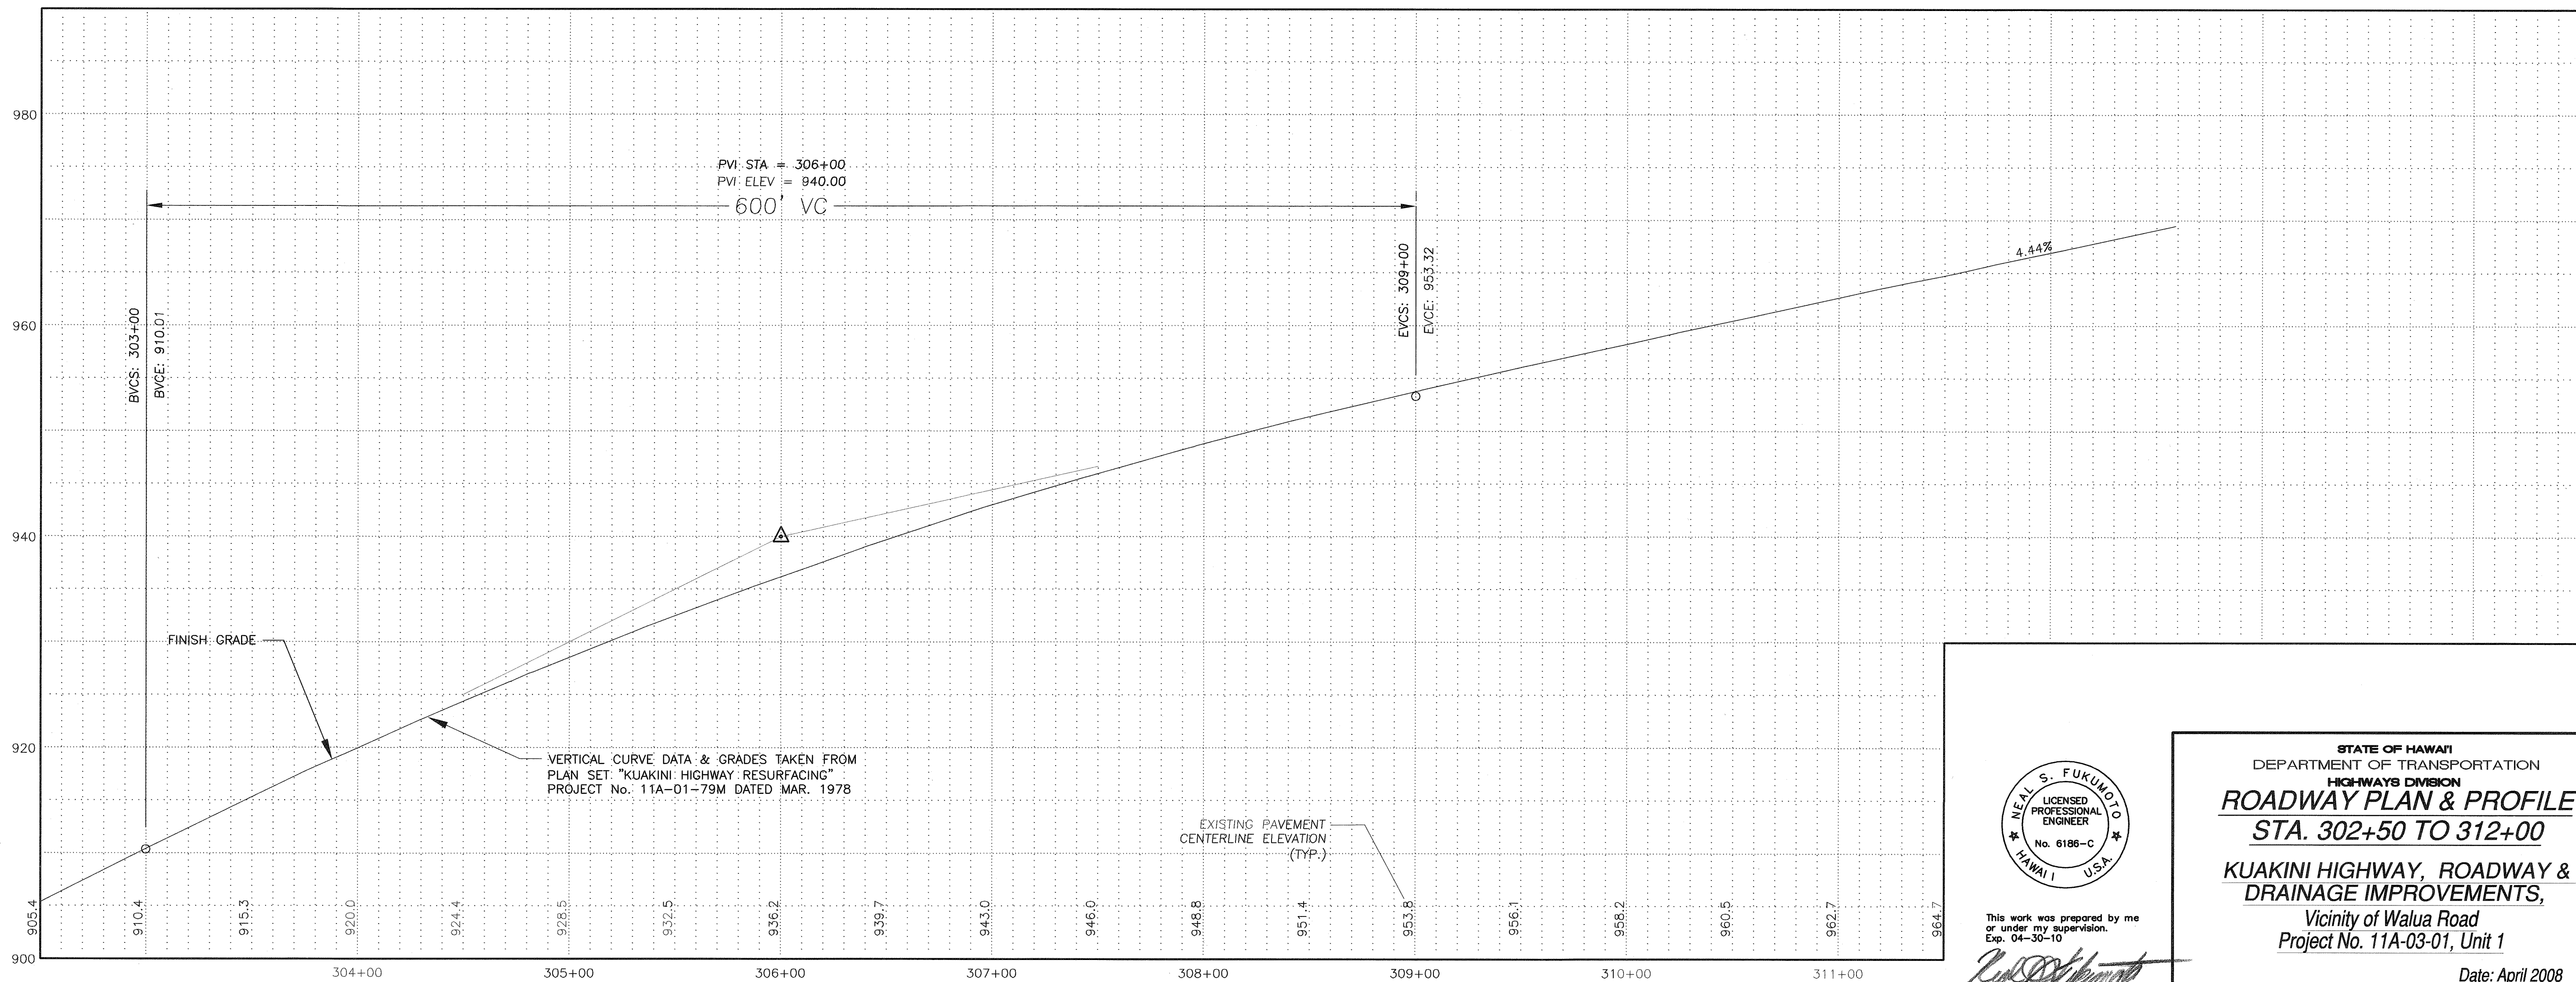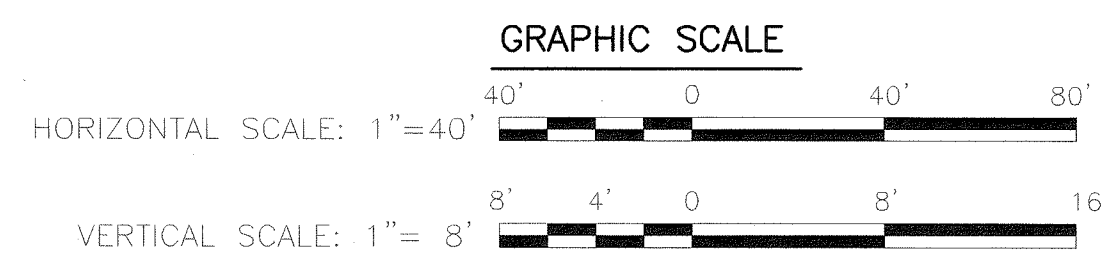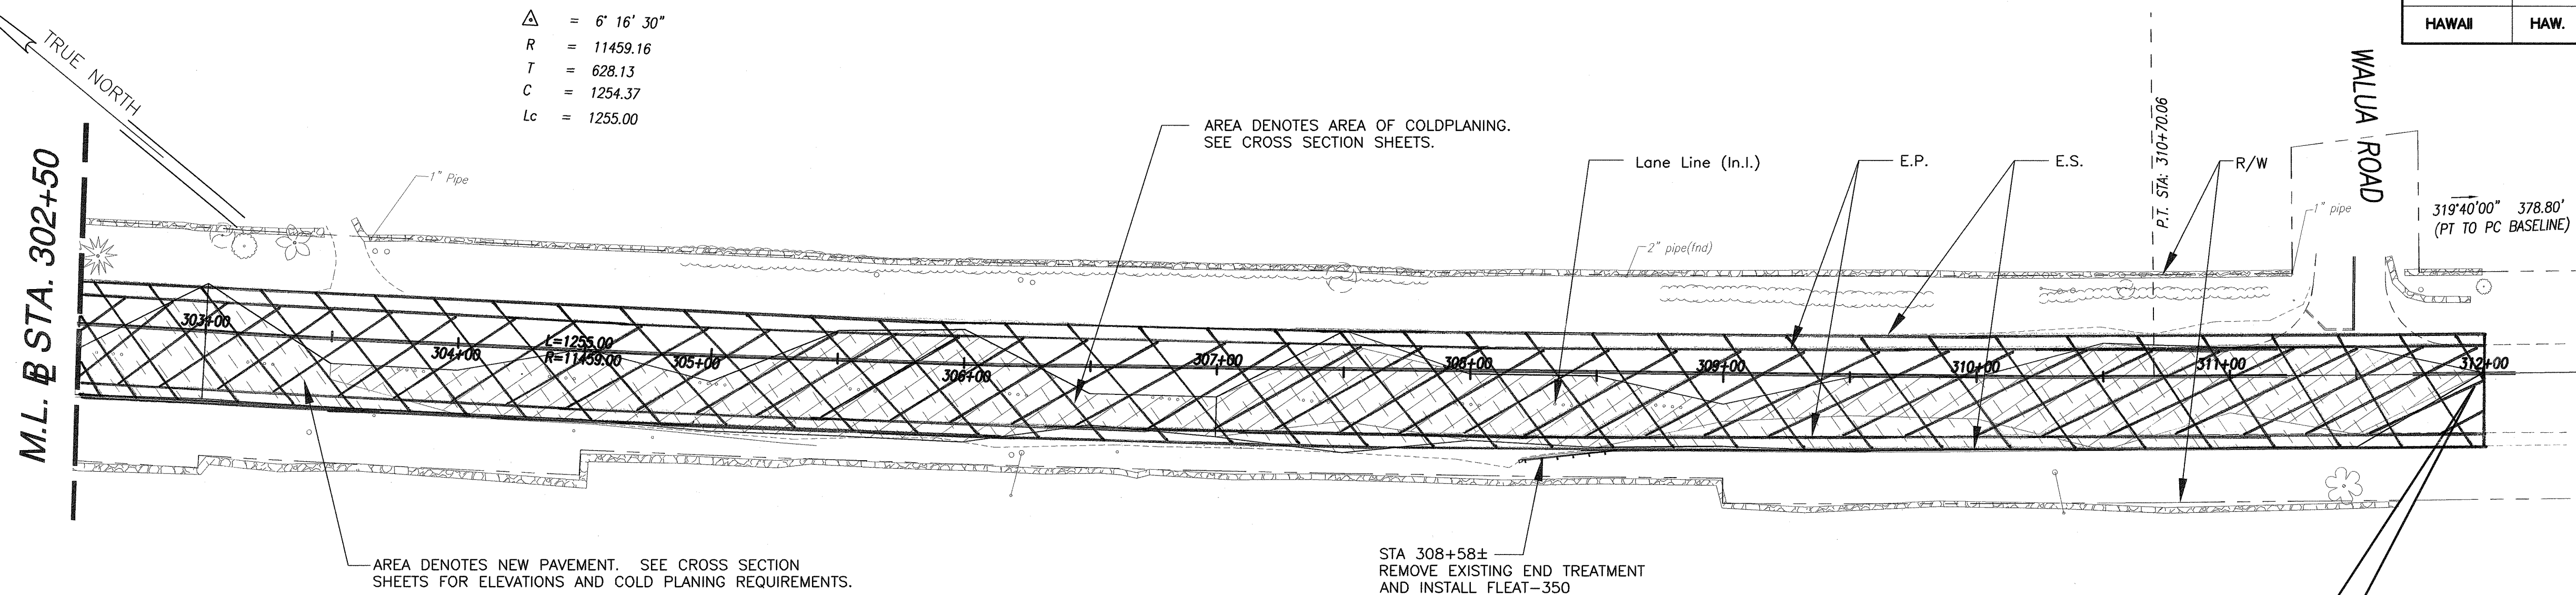

This work was prepared by me
or under my supervision.
Exp. 04-30-10
Wesley R. Segawa & Associates, Inc.

STATE OF HAWAII
DEPARTMENT OF TRANSPORTATION
HIGHWAYS DIVISION
ROADWAY PLAN & PROFILE
STA. 302+50 TO 312+00
KUAKINI HIGHWAY, ROADWAY &
DRAINAGE IMPROVEMENTS,
Vicinity of Walua Road
Project No. 11A-03-01, Unit 1
Date: April 2008

SHEET No. OF SHEETS

"AS-BUILT"