



FED. ROAD DIST. NO.	STATE	PROJ. NO.	FISCAL YEAR	SHEET NO.	TOTAL SHEETS
HAWAII	HAW.	11A-03-01, UNIT 1	2008	13	29

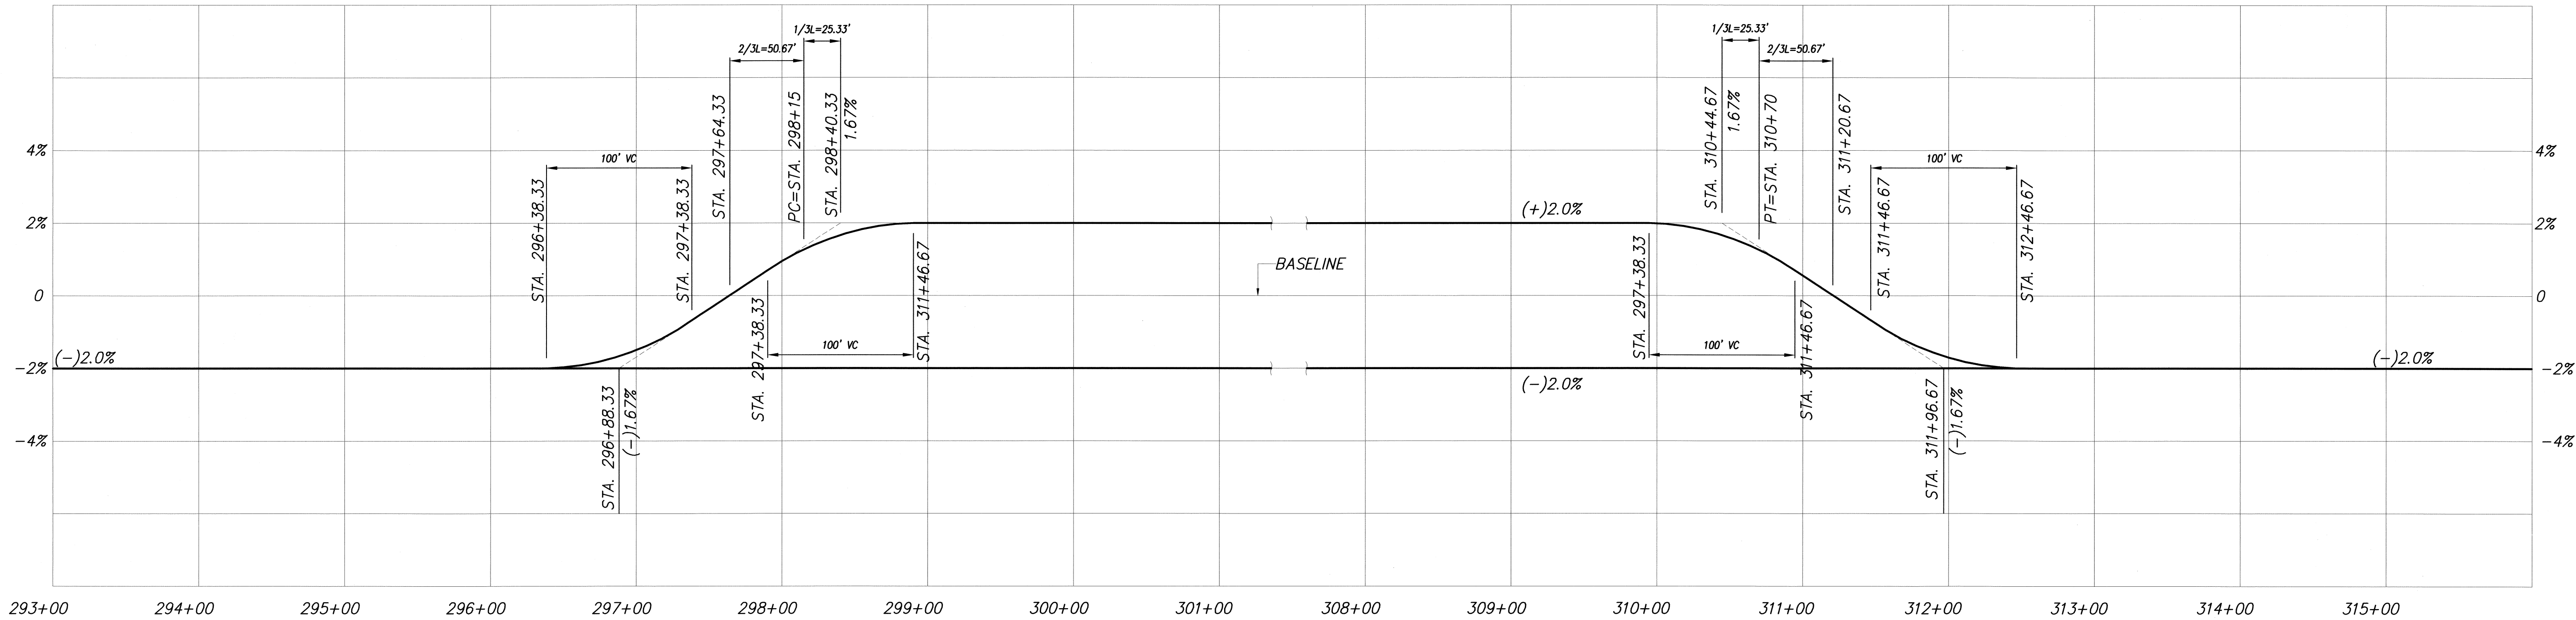



PC STA. 298+15 TO PT STA. 310+70

SCALE: HORIZ 1"=60'
VERT 1"=2%

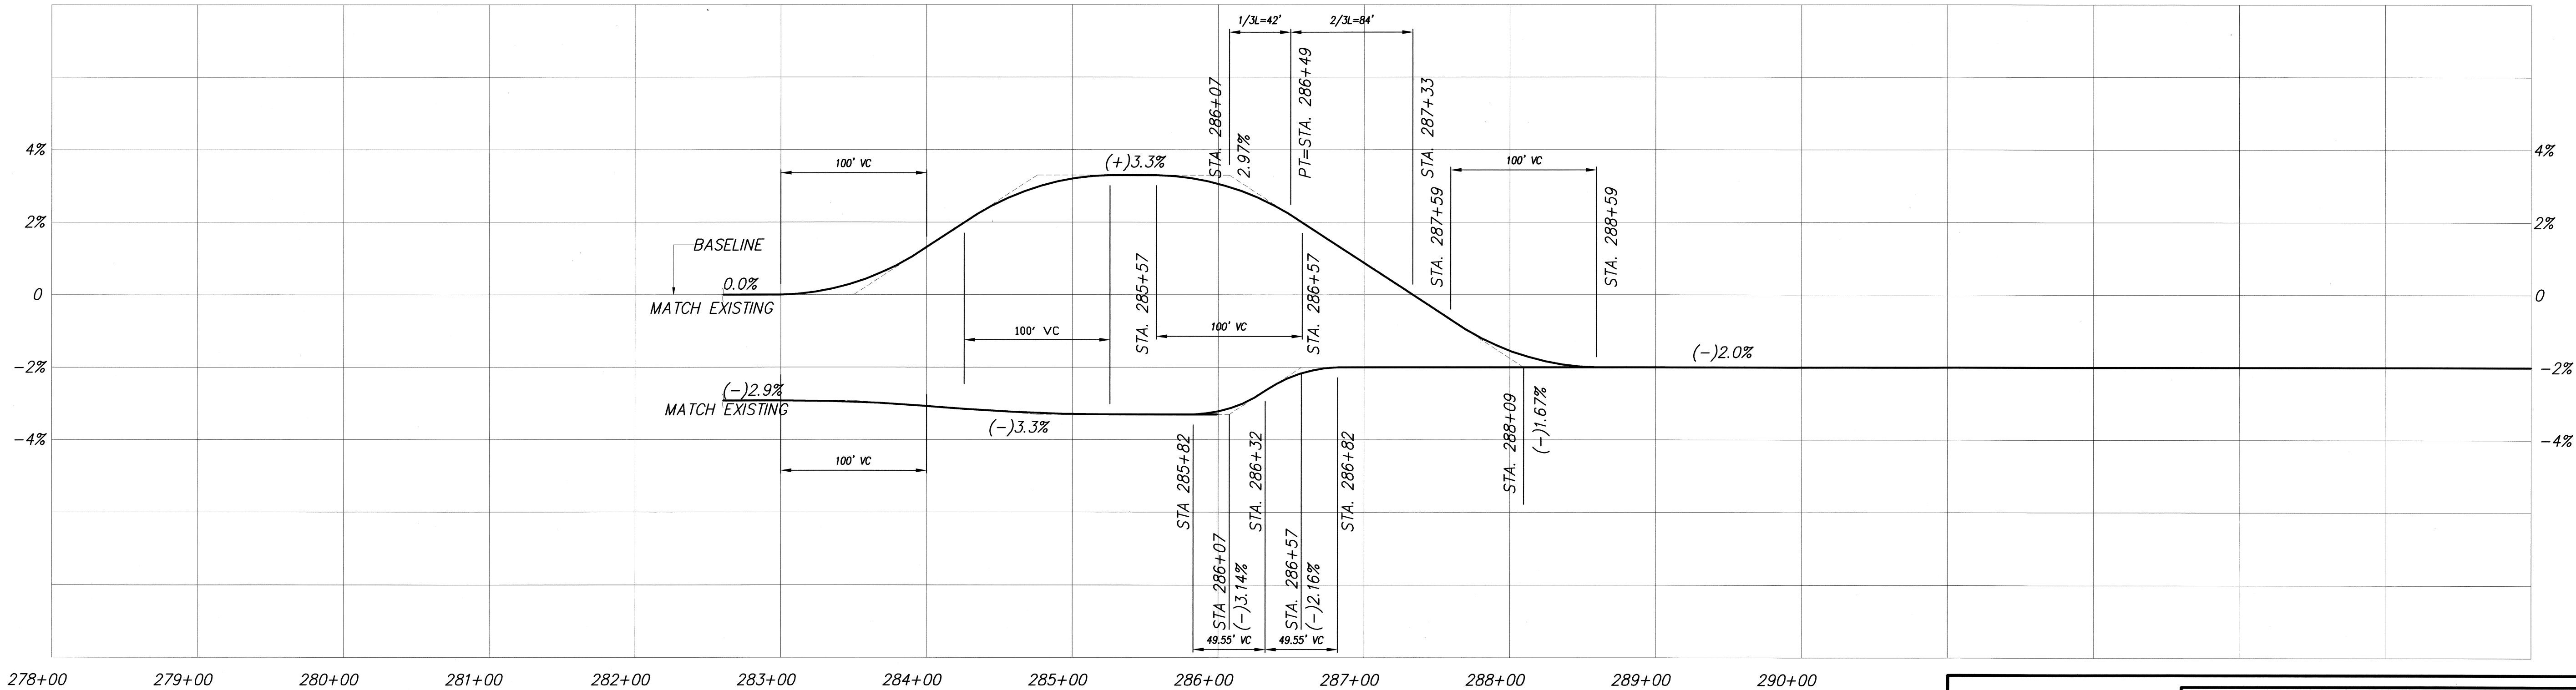

PC STA. 283+50 TO PT STA. 286+49

SCALE: HORIZ 1"=60'
VERT 1"=2%

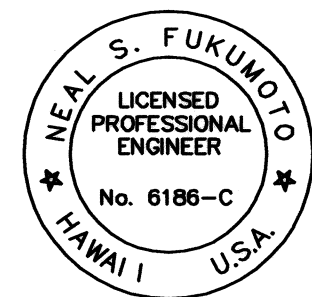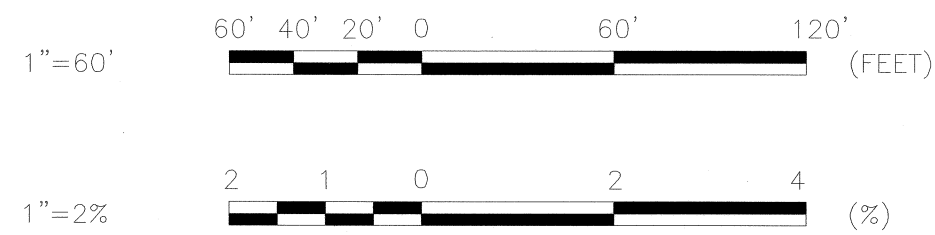

This work was prepared by me
or under my supervision.
Exp. 04-30-10
Neal S. Fukunoto
Wesley R. Segawa & Associates, Inc.

STATE OF HAWAII
DEPARTMENT OF TRANSPORTATION
HIGHWAYS DIVISION

SUPERELEVATION DIAGRAM

**KUAKINI HIGHWAY, ROADWAY &
DRAINAGE IMPROVEMENTS
Vicinity of Walua Road
Project No. 11A-03-01, Unit 1**

Date: April 2008

SHEET No. OF SHEETS