



FED. ROAD DIST. NO.	STATE	PROJ. NO.	FISCAL YEAR	SHEET NO.	TOTAL SHEETS
HAWAII	HAW.	11A-03-01, UNIT 1	2008	8	29

* See Cross Sections on Sheets 23-28 for Dimensions, Thicknesses and Grades.

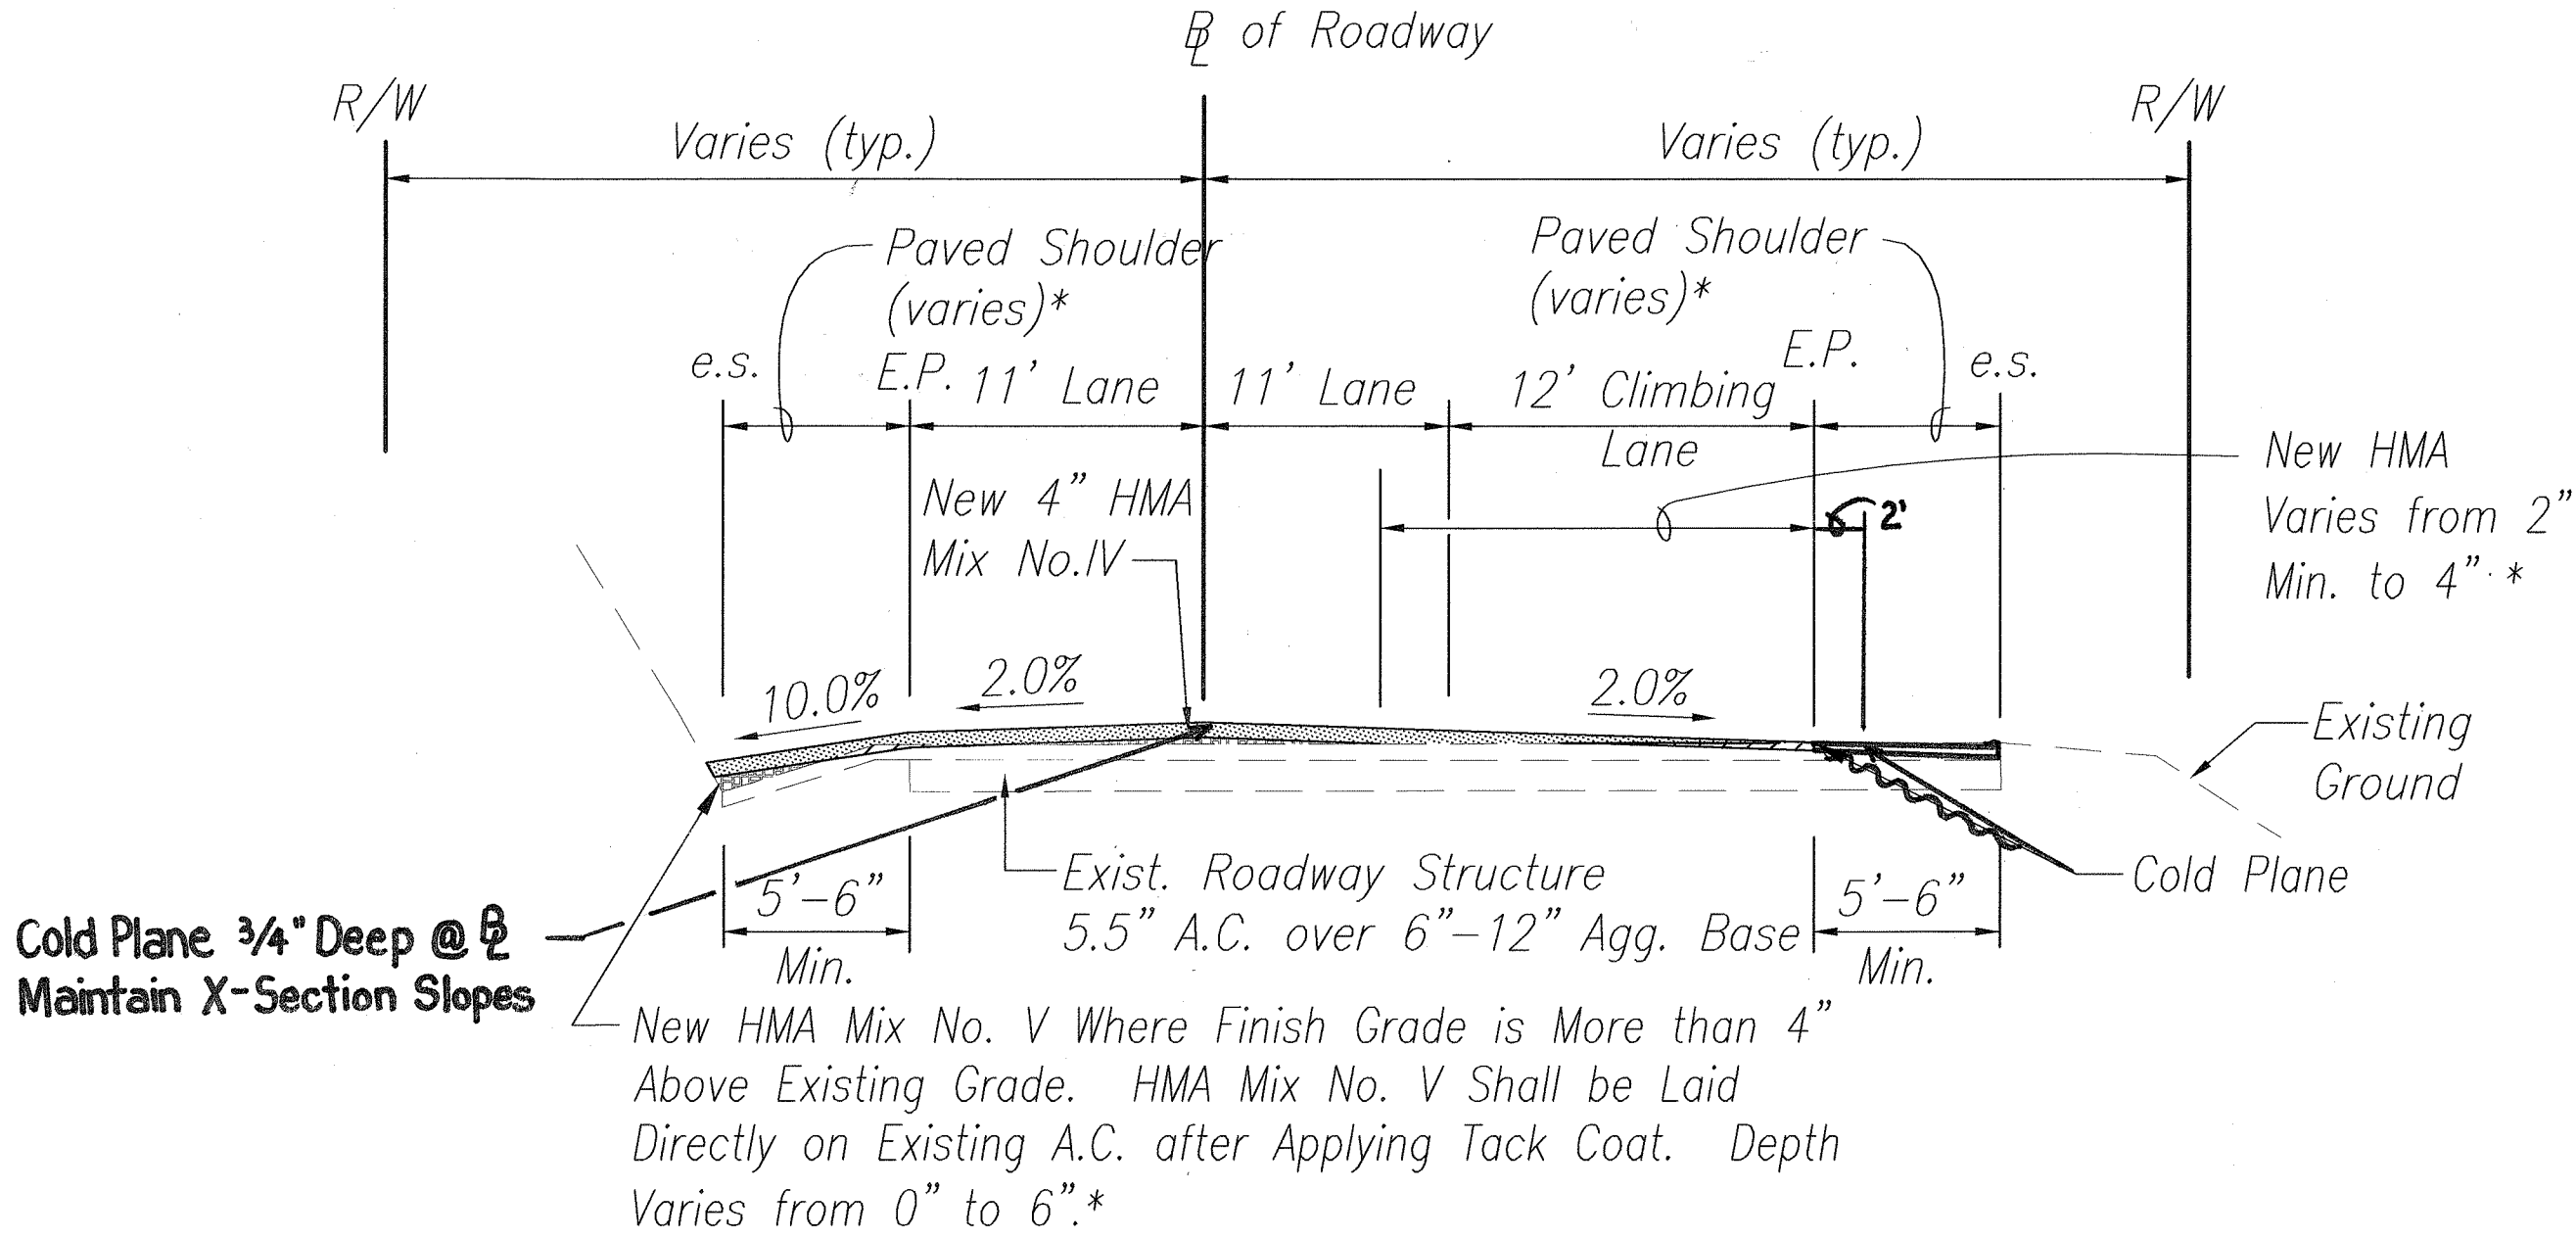


TYPICAL SECTION - KUAKINI HIGHWAY - NORMAL CROWN
Not To Scale

* See Cross Sections on Sheets 23-28 for Dimensions, Thicknesses and Grades.

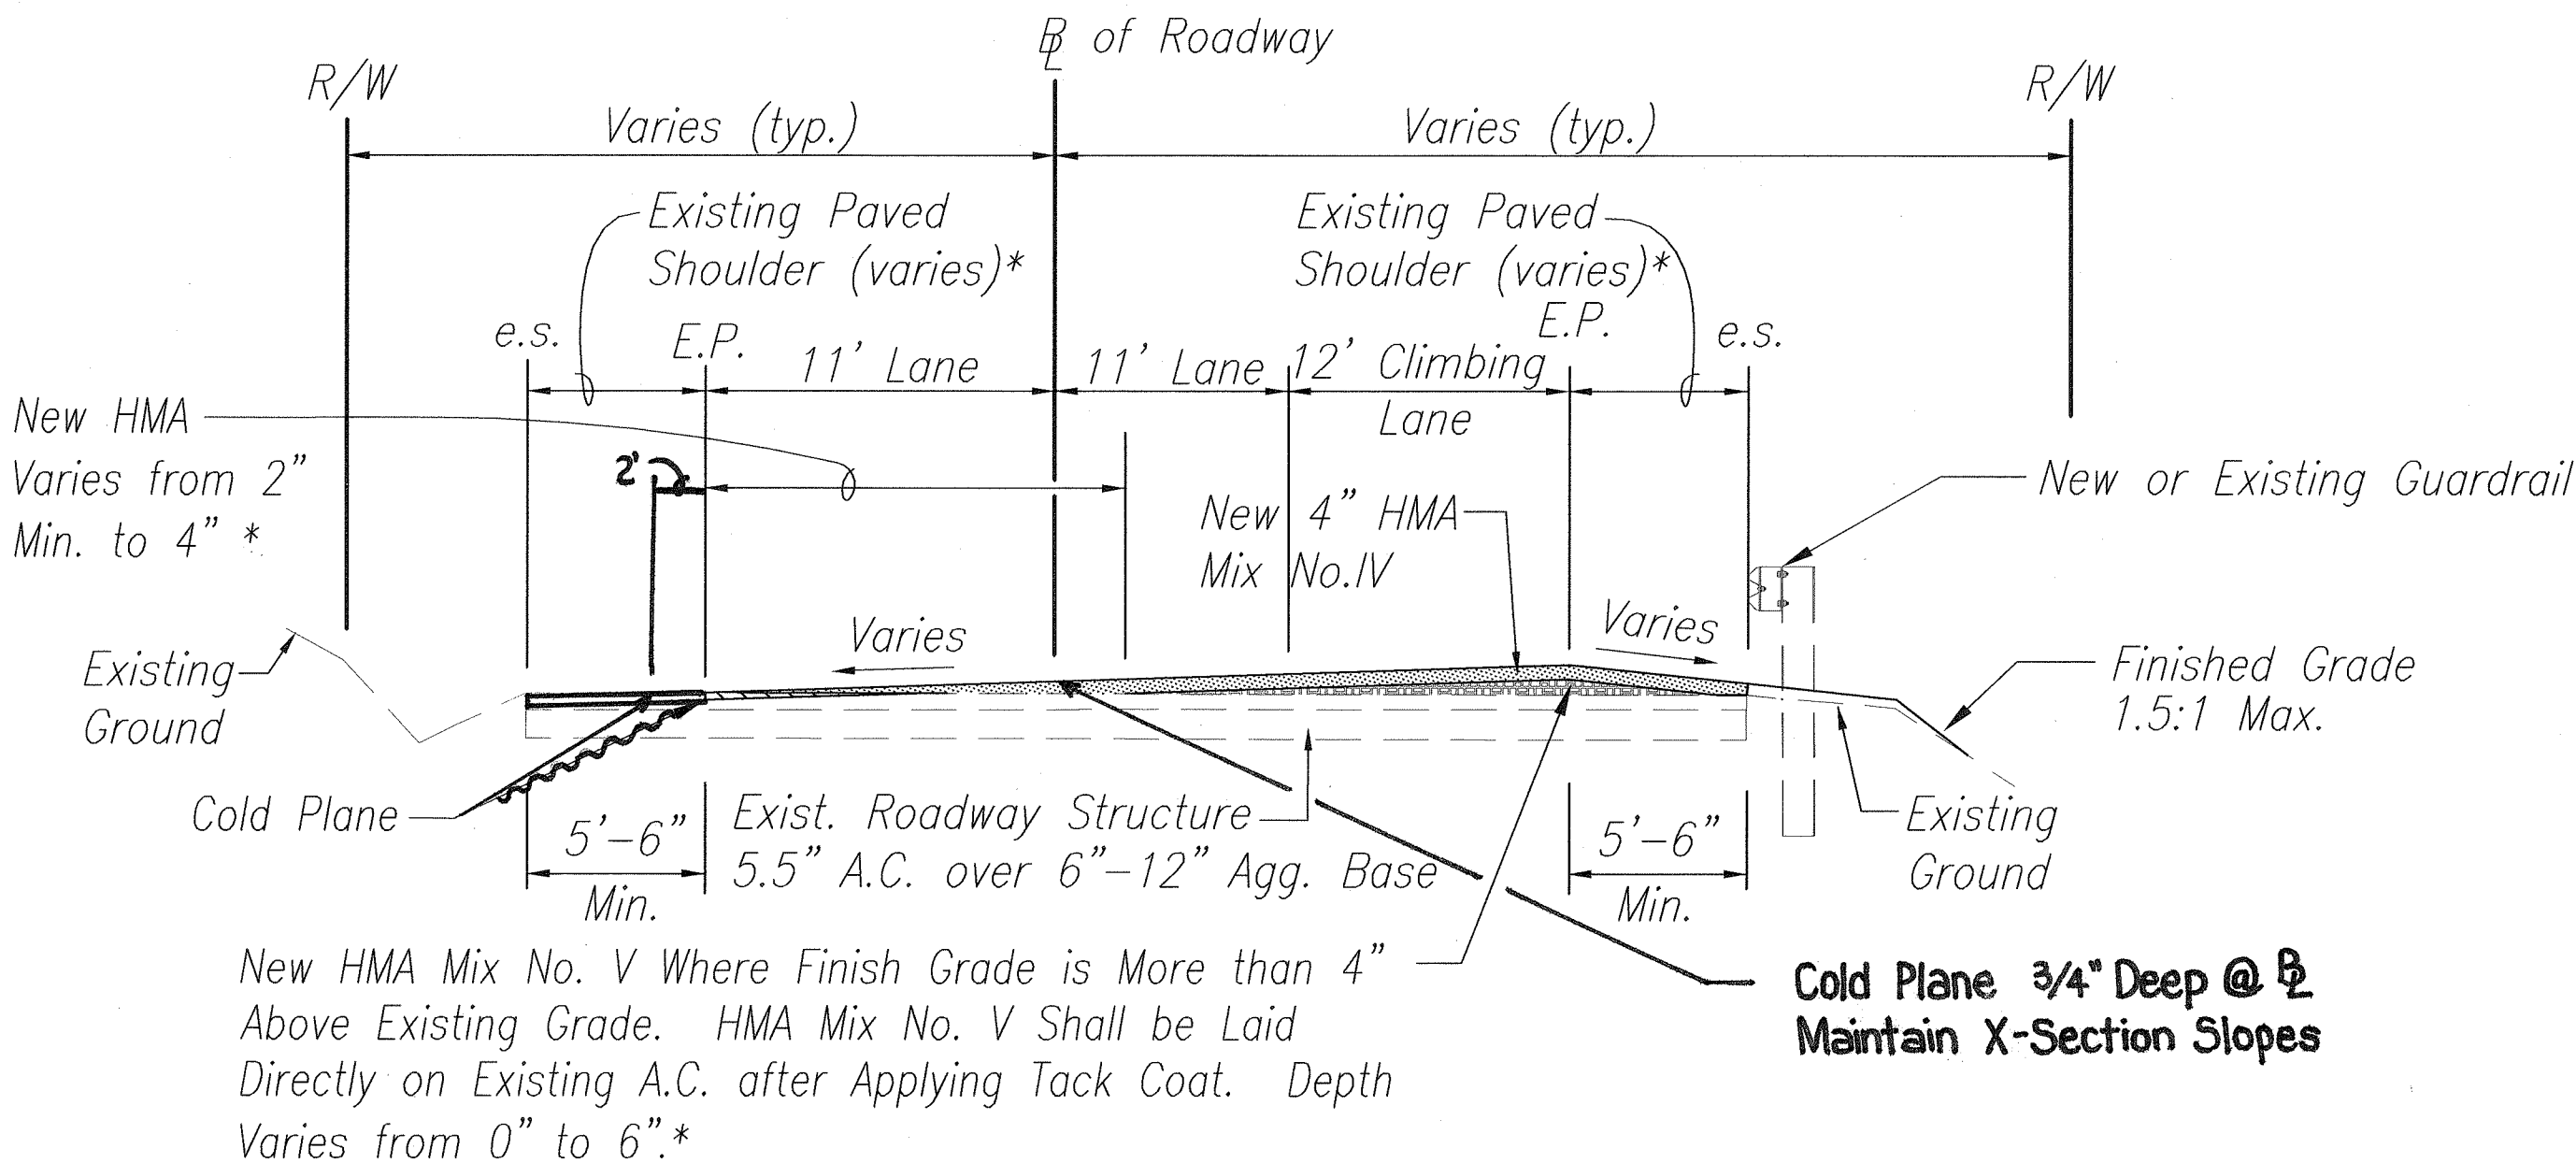

TYPICAL SECTION - KUAKINI HIGHWAY - SUPERELEVATED SECTION
STA. 283+00 to 287+33 AND 297+64 to 311+21
Not To Scale

\\Server\\E\\0111 Kuakini Hwy\\way Drainage CADD\\CIVIL\\dwg\\TYPICAL SECTIONS & DETAILS\\1.dwg 05/23/2002 03:00:15 PM HST

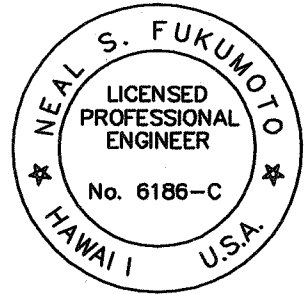

This work was prepared by me or under my supervision.
Exp. 04-30-10

Wesley R. Segawa
Wesley R. Segawa & Associates, Inc.


STATE OF HAWAII
DEPARTMENT OF TRANSPORTATION
HIGHWAYS DIVISION
**TYPICAL SECTIONS
AND DETAILS**
**KUAKINI HIGHWAY, ROADWAY &
DRAINAGE IMPROVEMENTS,**
Vicinity of Waiua Road
Project No. 11A-03-01, Unit 1

Date: April 2008

SHEET No. OF SHEETS


"AS-BUILT"

FED. ROAD DIST. NO.	STATE	PROJ. NO.	FISCAL YEAR	SHEET NO.	TOTAL SHEETS
HAWAII	HAW.	11A-03-01, UNIT 1	2008	9	29

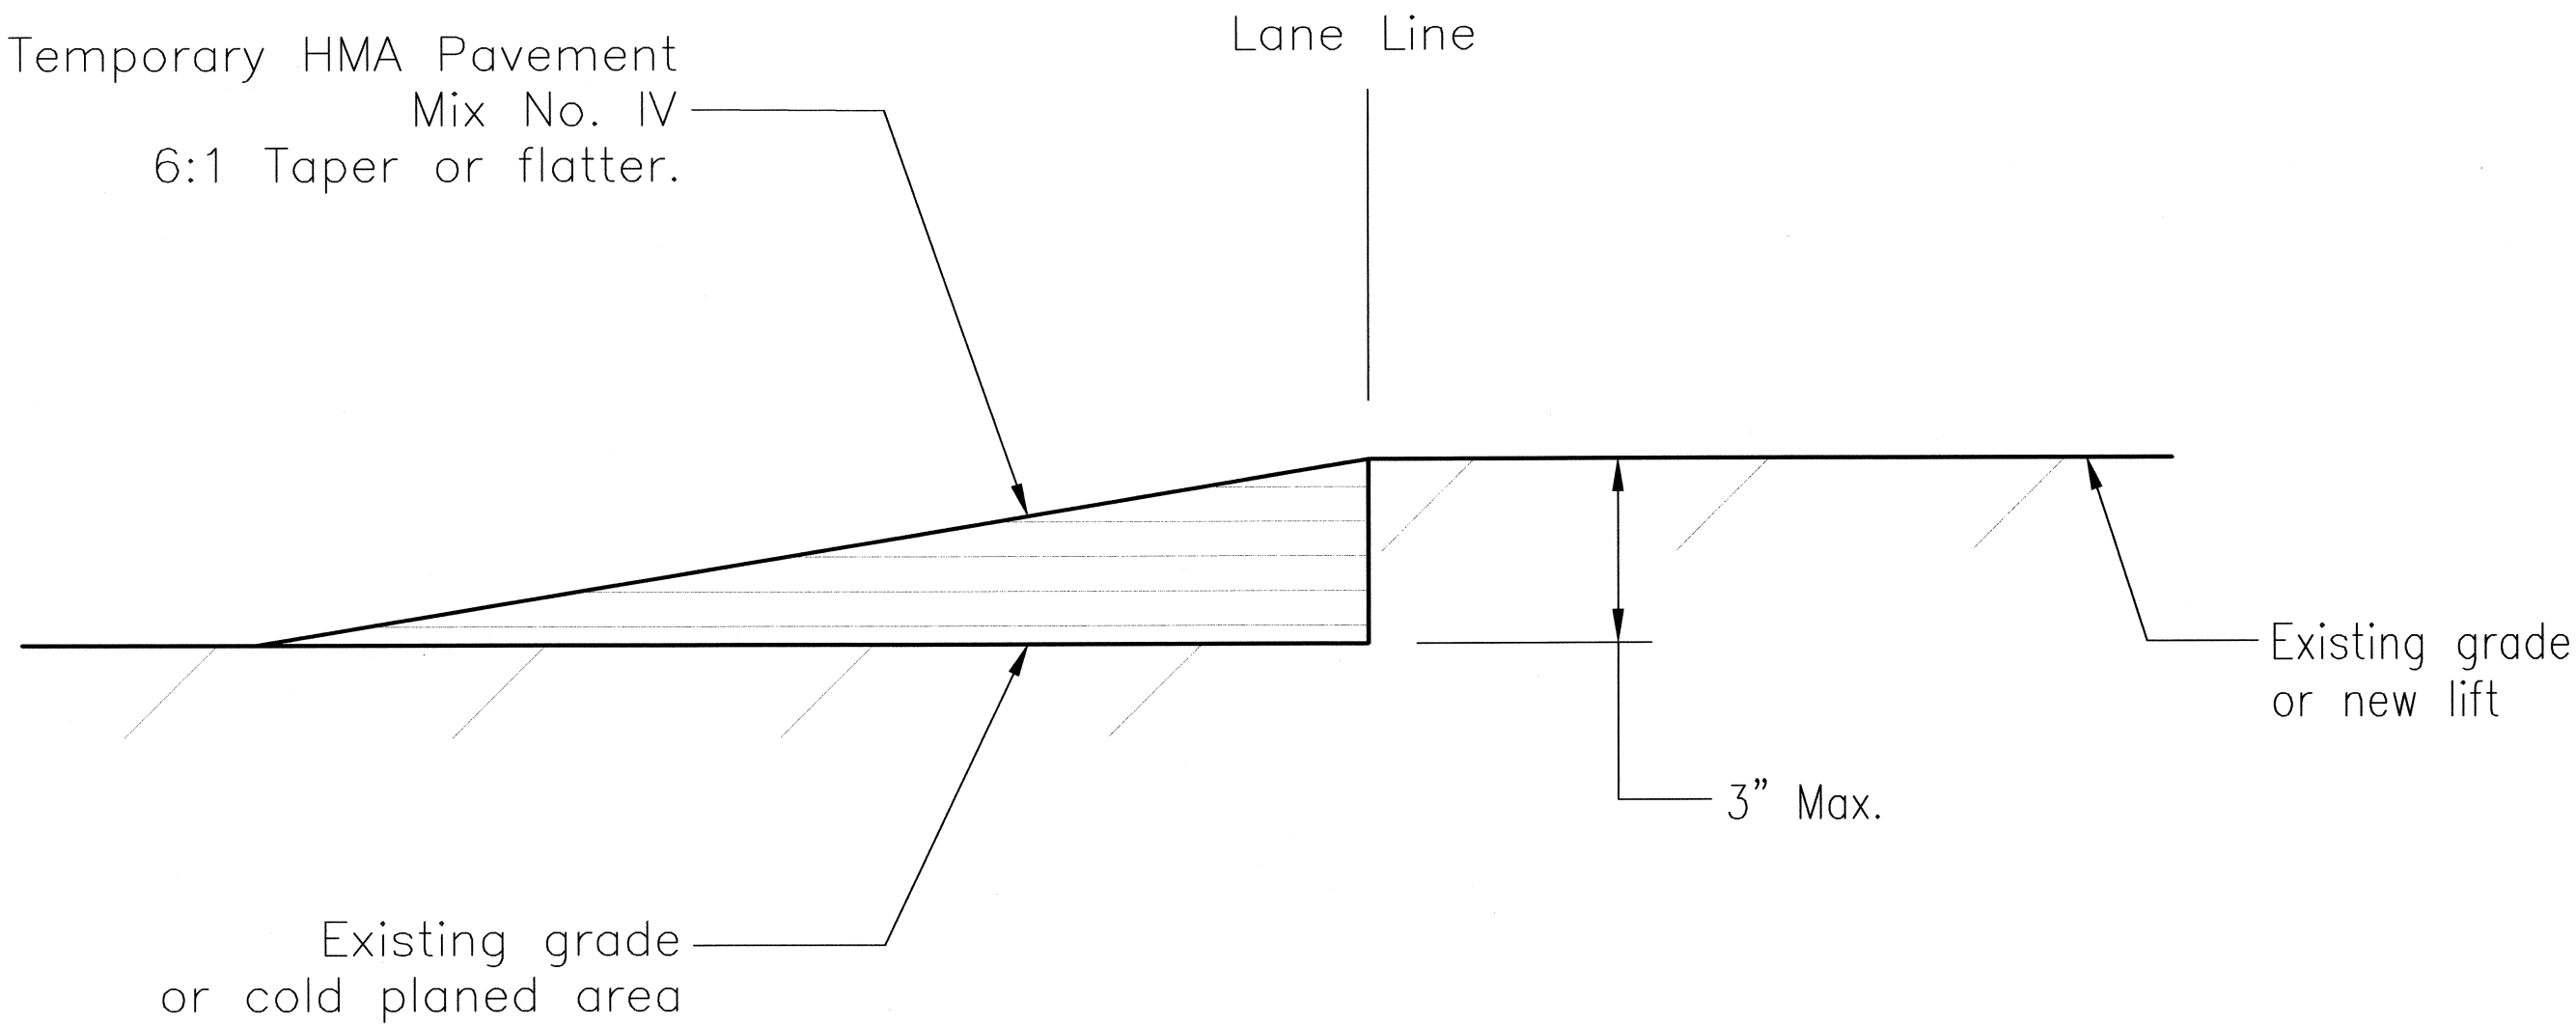


- NOTES:
1. Temporary HMA Pavement shall be removed prior to placement of new pavement.
 2. Placement of Temporary HMA Pavement shall be incidental to 401.0400 HMA Pavement, Mix No. IV Quantity is reflected in Proposal Schedule.
 3. Removal of Temporary HMA Pavement shall be incidental to 415.1000 Cold Planing.


TEMPORARY TREATMENT OF GRADE DIFFERENCES
DURING NON-WORK HOURS
Not To Scale

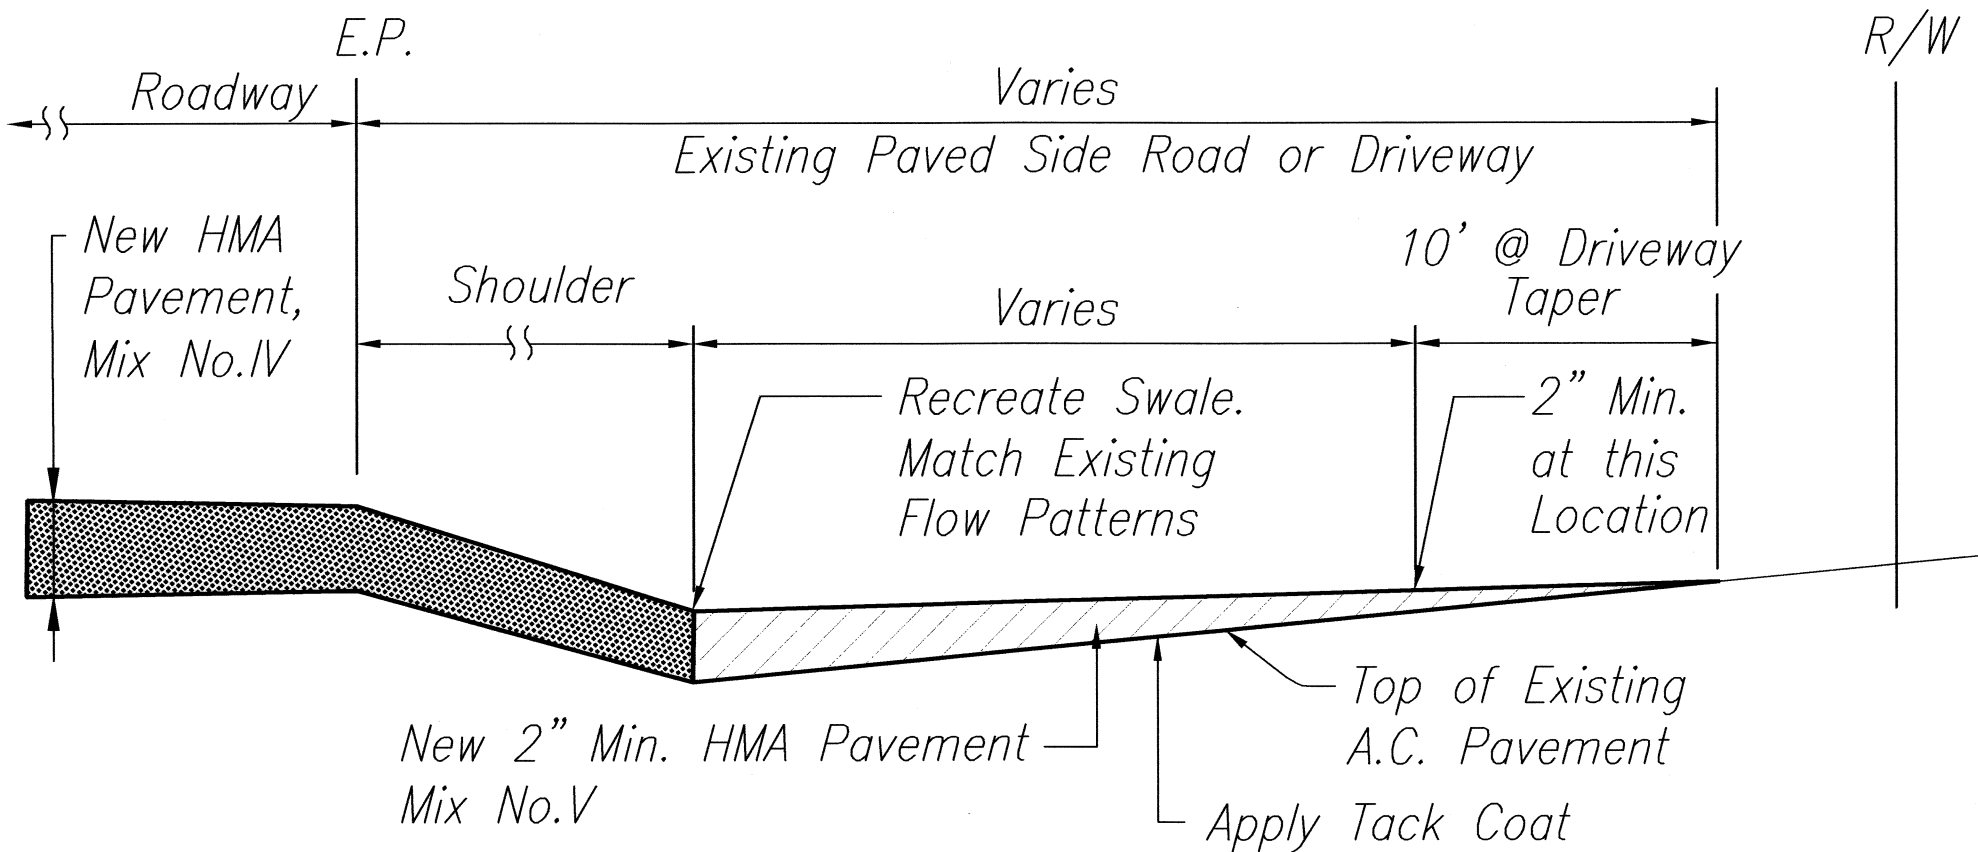

A.C. RESURFACING AT PAVED DRIVEWAY DETAIL
Not To Scale

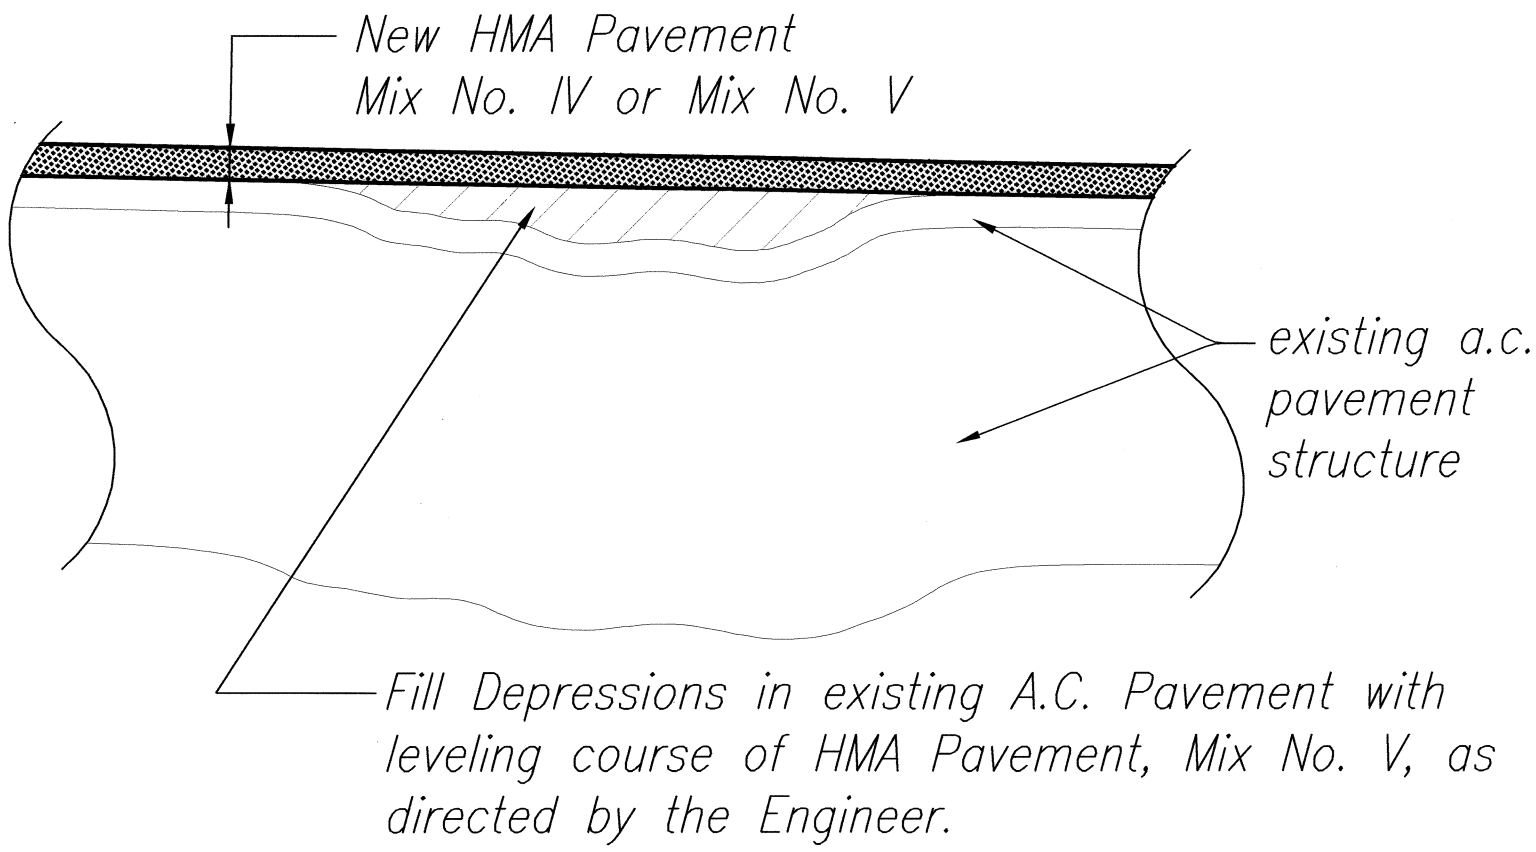

PAVEMENT LEVELING COURSE DETAIL
Not To Scale

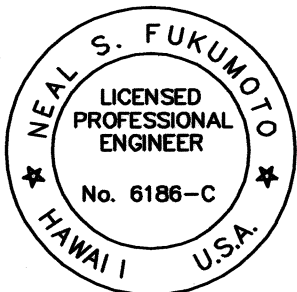

This work was prepared by me
or under my supervision.
Exp. 04-30-10

Wesley R. Segawa
Wesley R. Segawa & Associates, Inc.

STATE OF HAWAII
DEPARTMENT OF TRANSPORTATION
HIGHWAYS DIVISION
**TYPICAL SECTIONS
AND DETAILS**
**KUAKINI HIGHWAY, ROADWAY &
DRAINAGE IMPROVEMENTS,**
Vicinity of Waiua Road
Project No. 11A-03-01, Unit 1

Date: April 2008

SHEET No. OF SHEETS