

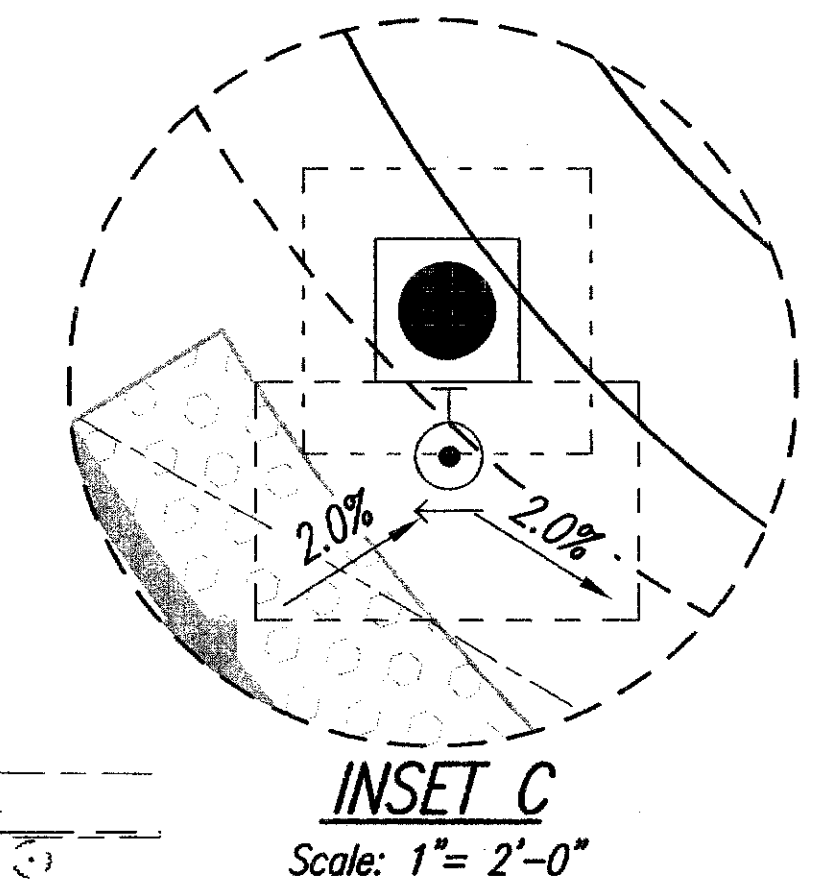
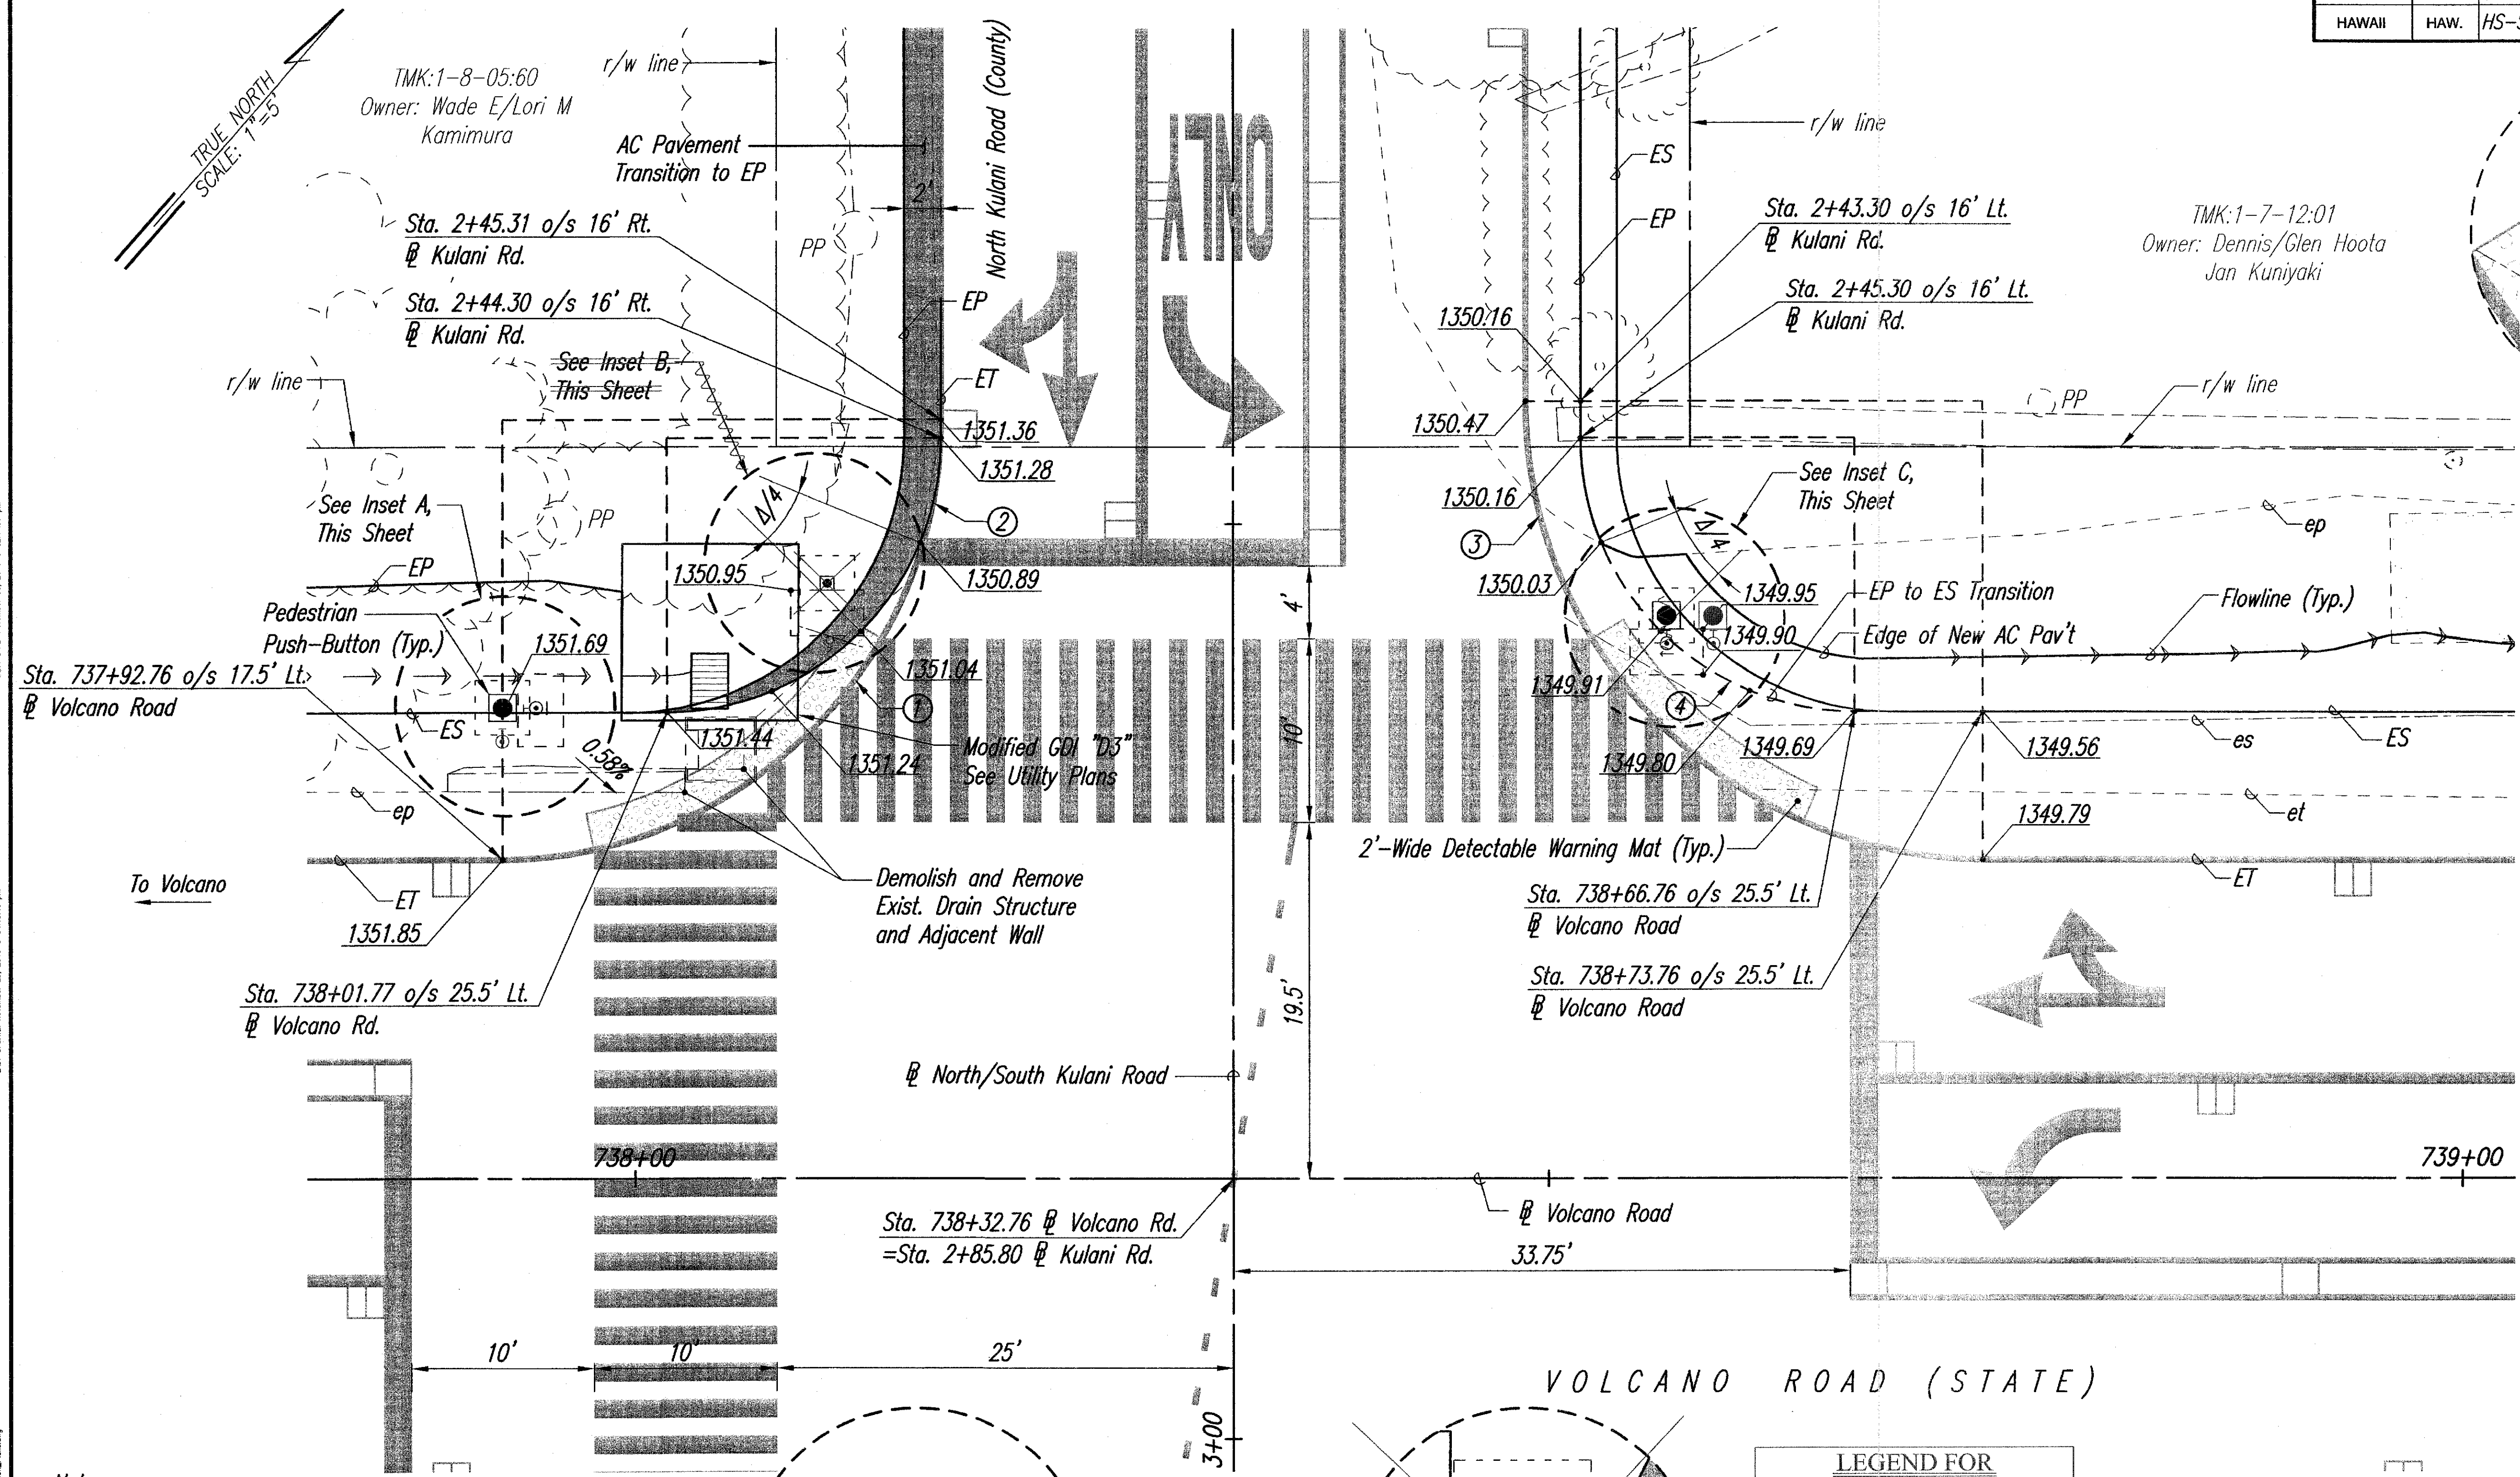


PLOT DATE: November 30, 2010 @ 02:03:35 pm
 LAST UPDATE: November 23, 2010 @ 04:04:03 pm

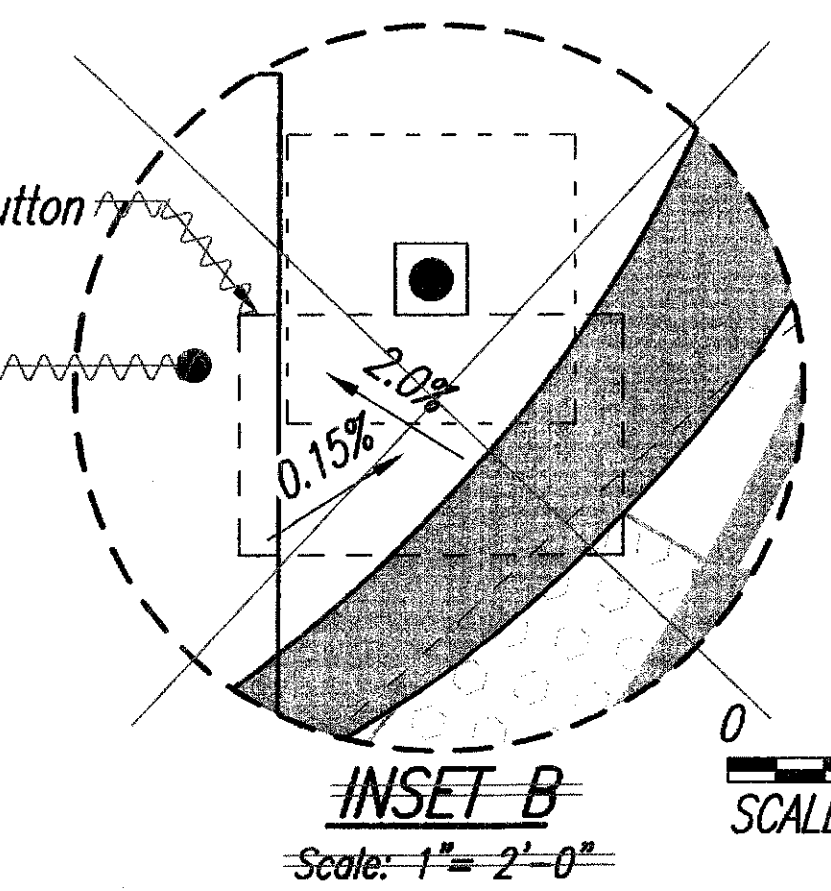

Note:
See Grading Plans for Spot Elevations.

Curve	①	②	③	④
Δ	90°00'00"	90°00'00"	90°00'00"	90°00'00"
$\Delta/2$	45°00'00'	45°00'00'	45°00'00'	45°00'00'
R	24.00	15.00	25.00	15.00
T	24.00	15.00	25.00	15.00
C	33.94	21.21	35.36	21.21
Lc	37.70	23.55	39.27	23.56

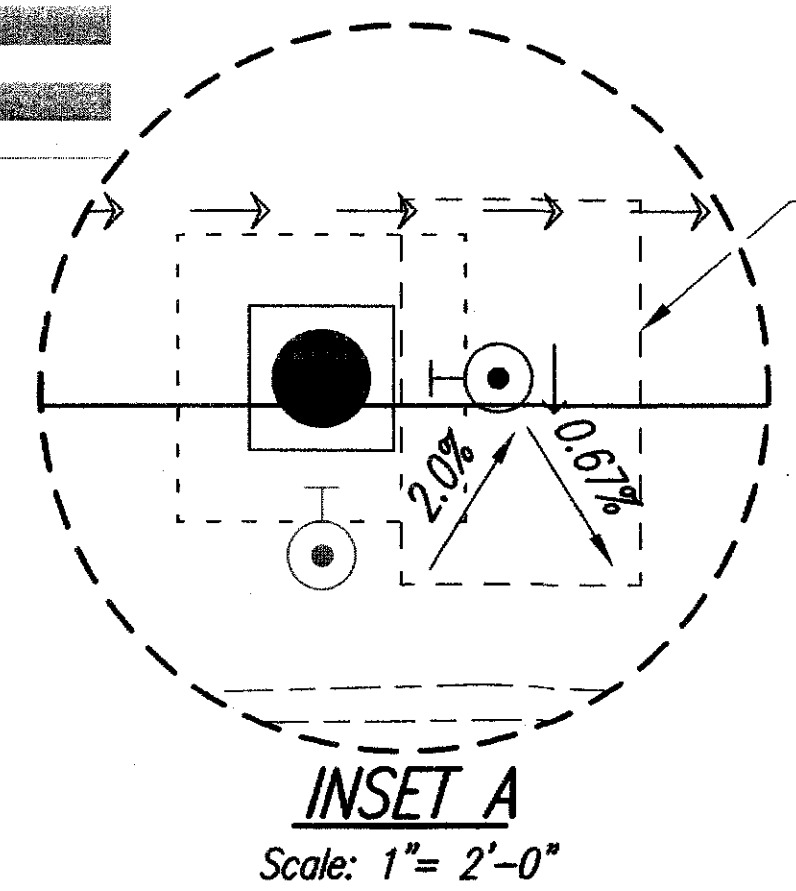

LEGEND FOR AS-BUILT POSTINGS

- Squiggly line for as-built deletion
- Double line for as-built deletion
- Text for as-built posting

LICENSE EXPIRES 4/30/12
 THIS WORK WAS PREPARED BY ME OR UNDER MY SUPERVISION
 HARRY K. MURAKI
 LICENSED PROFESSIONAL ENGINEER
 No. 8418-C
 HAWAII, U.S.A.

STATE OF HAWAII
 DEPARTMENT OF TRANSPORTATION
 HIGHWAYS DIVISION
INTERSECTION PLAN
 Volcano Road Intersection and
 Drainage Improvements
 Federal-Aid Project No. HS-STP-011-2(38)
 Scale: 1"=5' Date: November 2010
 SHEET NO. 1 OF 2 SHEETS

"AS-BUILT"

