


FED. ROAD DIST. NO.	STATE	PROJ. NO.	FISCAL YEAR	SHEET NO.	TOTAL SHEETS
HAWAII	HAW.	11G-01-04	2007	6	9

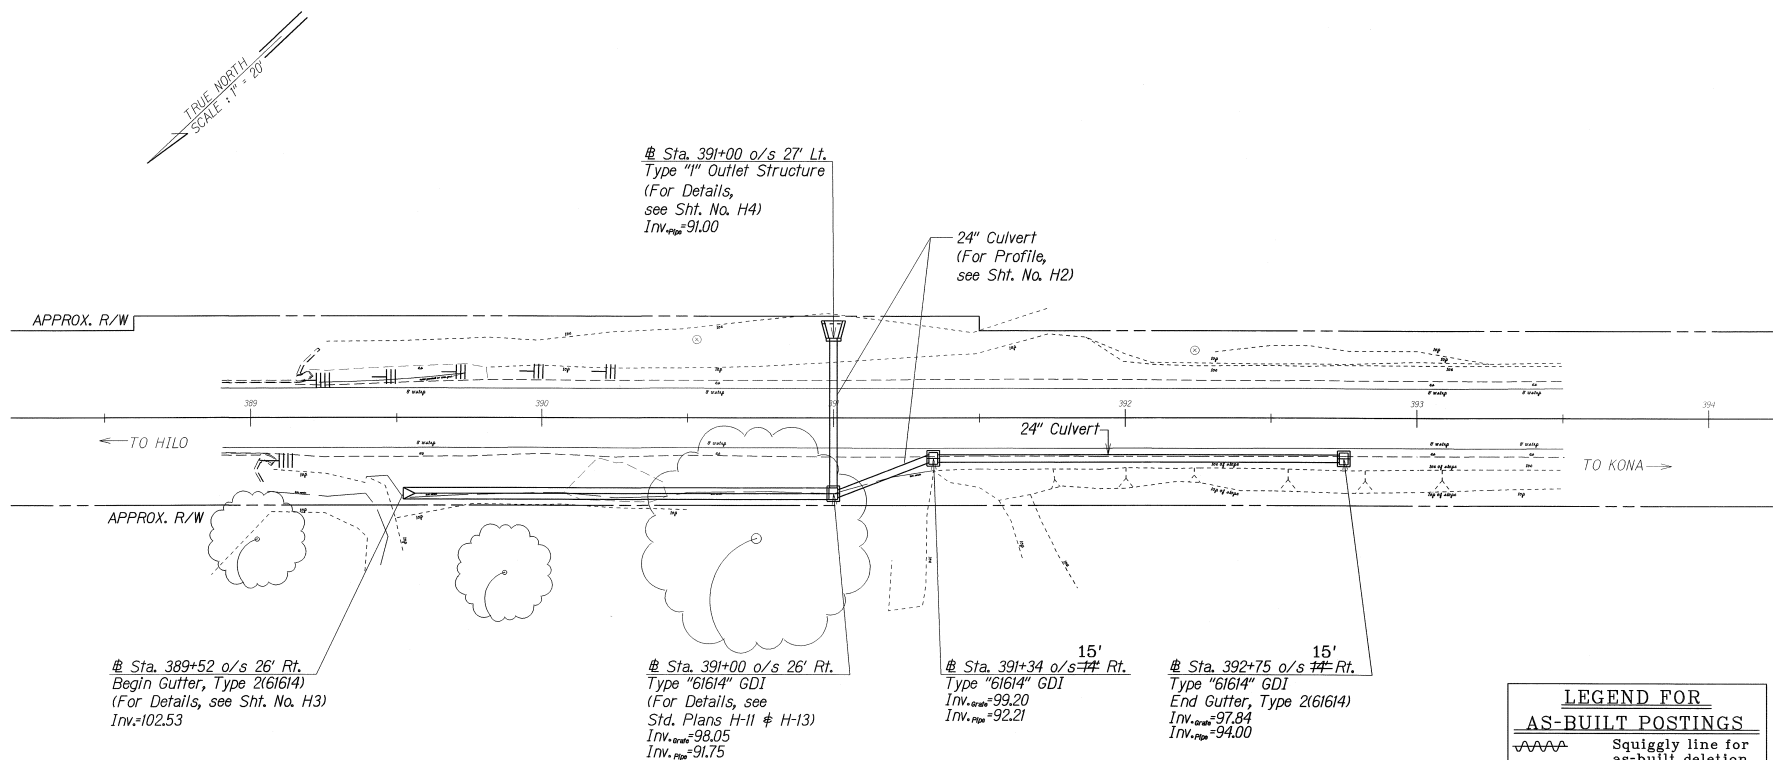

LEGEND FOR AS-BUILT POSTINGS	
	Squiggly line for as-built deletion
	Double line for as-built deletion
Roadway	Text for as-built posting

STATE OF HAWAII
DEPARTMENT OF TRANSPORTATION
HIGHWAYS DIVISION

DRAINAGE PLAN

MAMALAOHA HIGHWAY DRAINAGE IMPROVEMENTS
Vicinity of Kananelu Bridge
Project No. 11G-01-04

Scale: 1"=20' Date: December, 2006

SHEET No. *HI* OF 4 SHEETS

"AS-BUILT"