
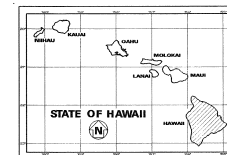


STATE OF HAWAII  
DEPARTMENT OF TRANSPORTATION  
HIGHWAYS DIVISION  
HONOLULU, HAWAII  
"AS-BUILT"  
PLANS FOR

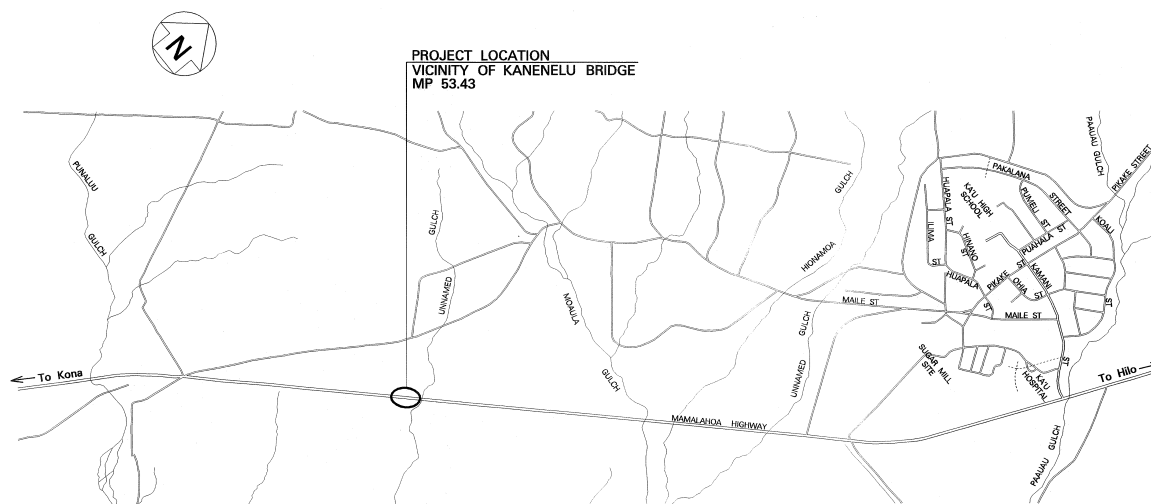



### VICINITY OF KANENELU BRIDGE

**PROJECT NO. 11G-01-04**

DISTRICT OF KAU  
ISLAND OF HAWAII

## LAYOUT PLAN

LENGTH OF PROJECT.....0.04 MILES

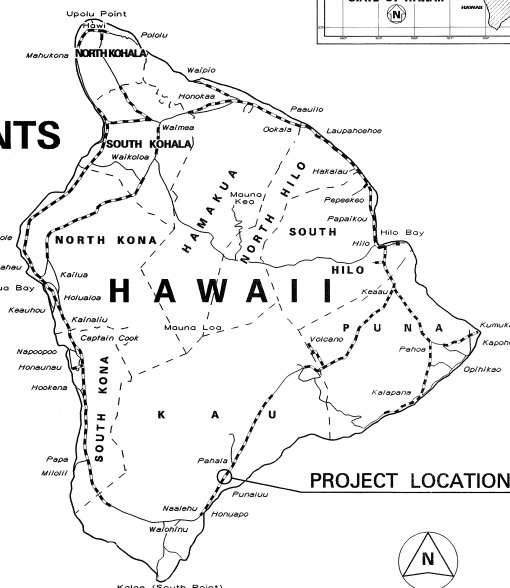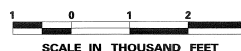

## PROJECT LOCATION



SCALE IN MILES

----- FEDERAL AID PROJECTS PREVIOUSLY CONSTRUCTED  
OR UNDER CONSTRUCTION

MILE POST 53.43 TO MILE POST 53.47

CHANGES MADE DURING CONSTRUCTION HAVE BEEN  
INCORPORATED ON THESE PLANS EXCEPT CHANGE  
IN THE ORIGINAL THEORETICAL QUANTITIES. FOR  
ACTUAL QUANTITIES, REFER TO PROJECT LOGS  
AND/OR COMPUTATION BOOK.

Vincent M. Vrande 5/16/08

DEPARTMENT OF TRANSPORTATION  
STATE OF HAWAII

APPROVED: for Susan M. Mason 3.8.07  
DIR. OF TRANSPORTATION DATE

HWY-D \_\_\_\_\_  
DESIGNED BY \_\_\_\_\_

HWY-DH \_\_\_\_\_  
P. S. & E. BY \_\_\_\_\_

692-7561 \_\_\_\_\_  
PHONE \_\_\_\_\_

DEC. 2006 \_\_\_\_\_  
DATE \_\_\_\_\_