


FED. ROAD DIST. NO.	STATE	FED. AID PROJ. NO.	FISCAL YEAR	SHEET NO.	TOTAL SHEETS
HAWAII	HAW.	STP-011-2(39)	2011	9	33

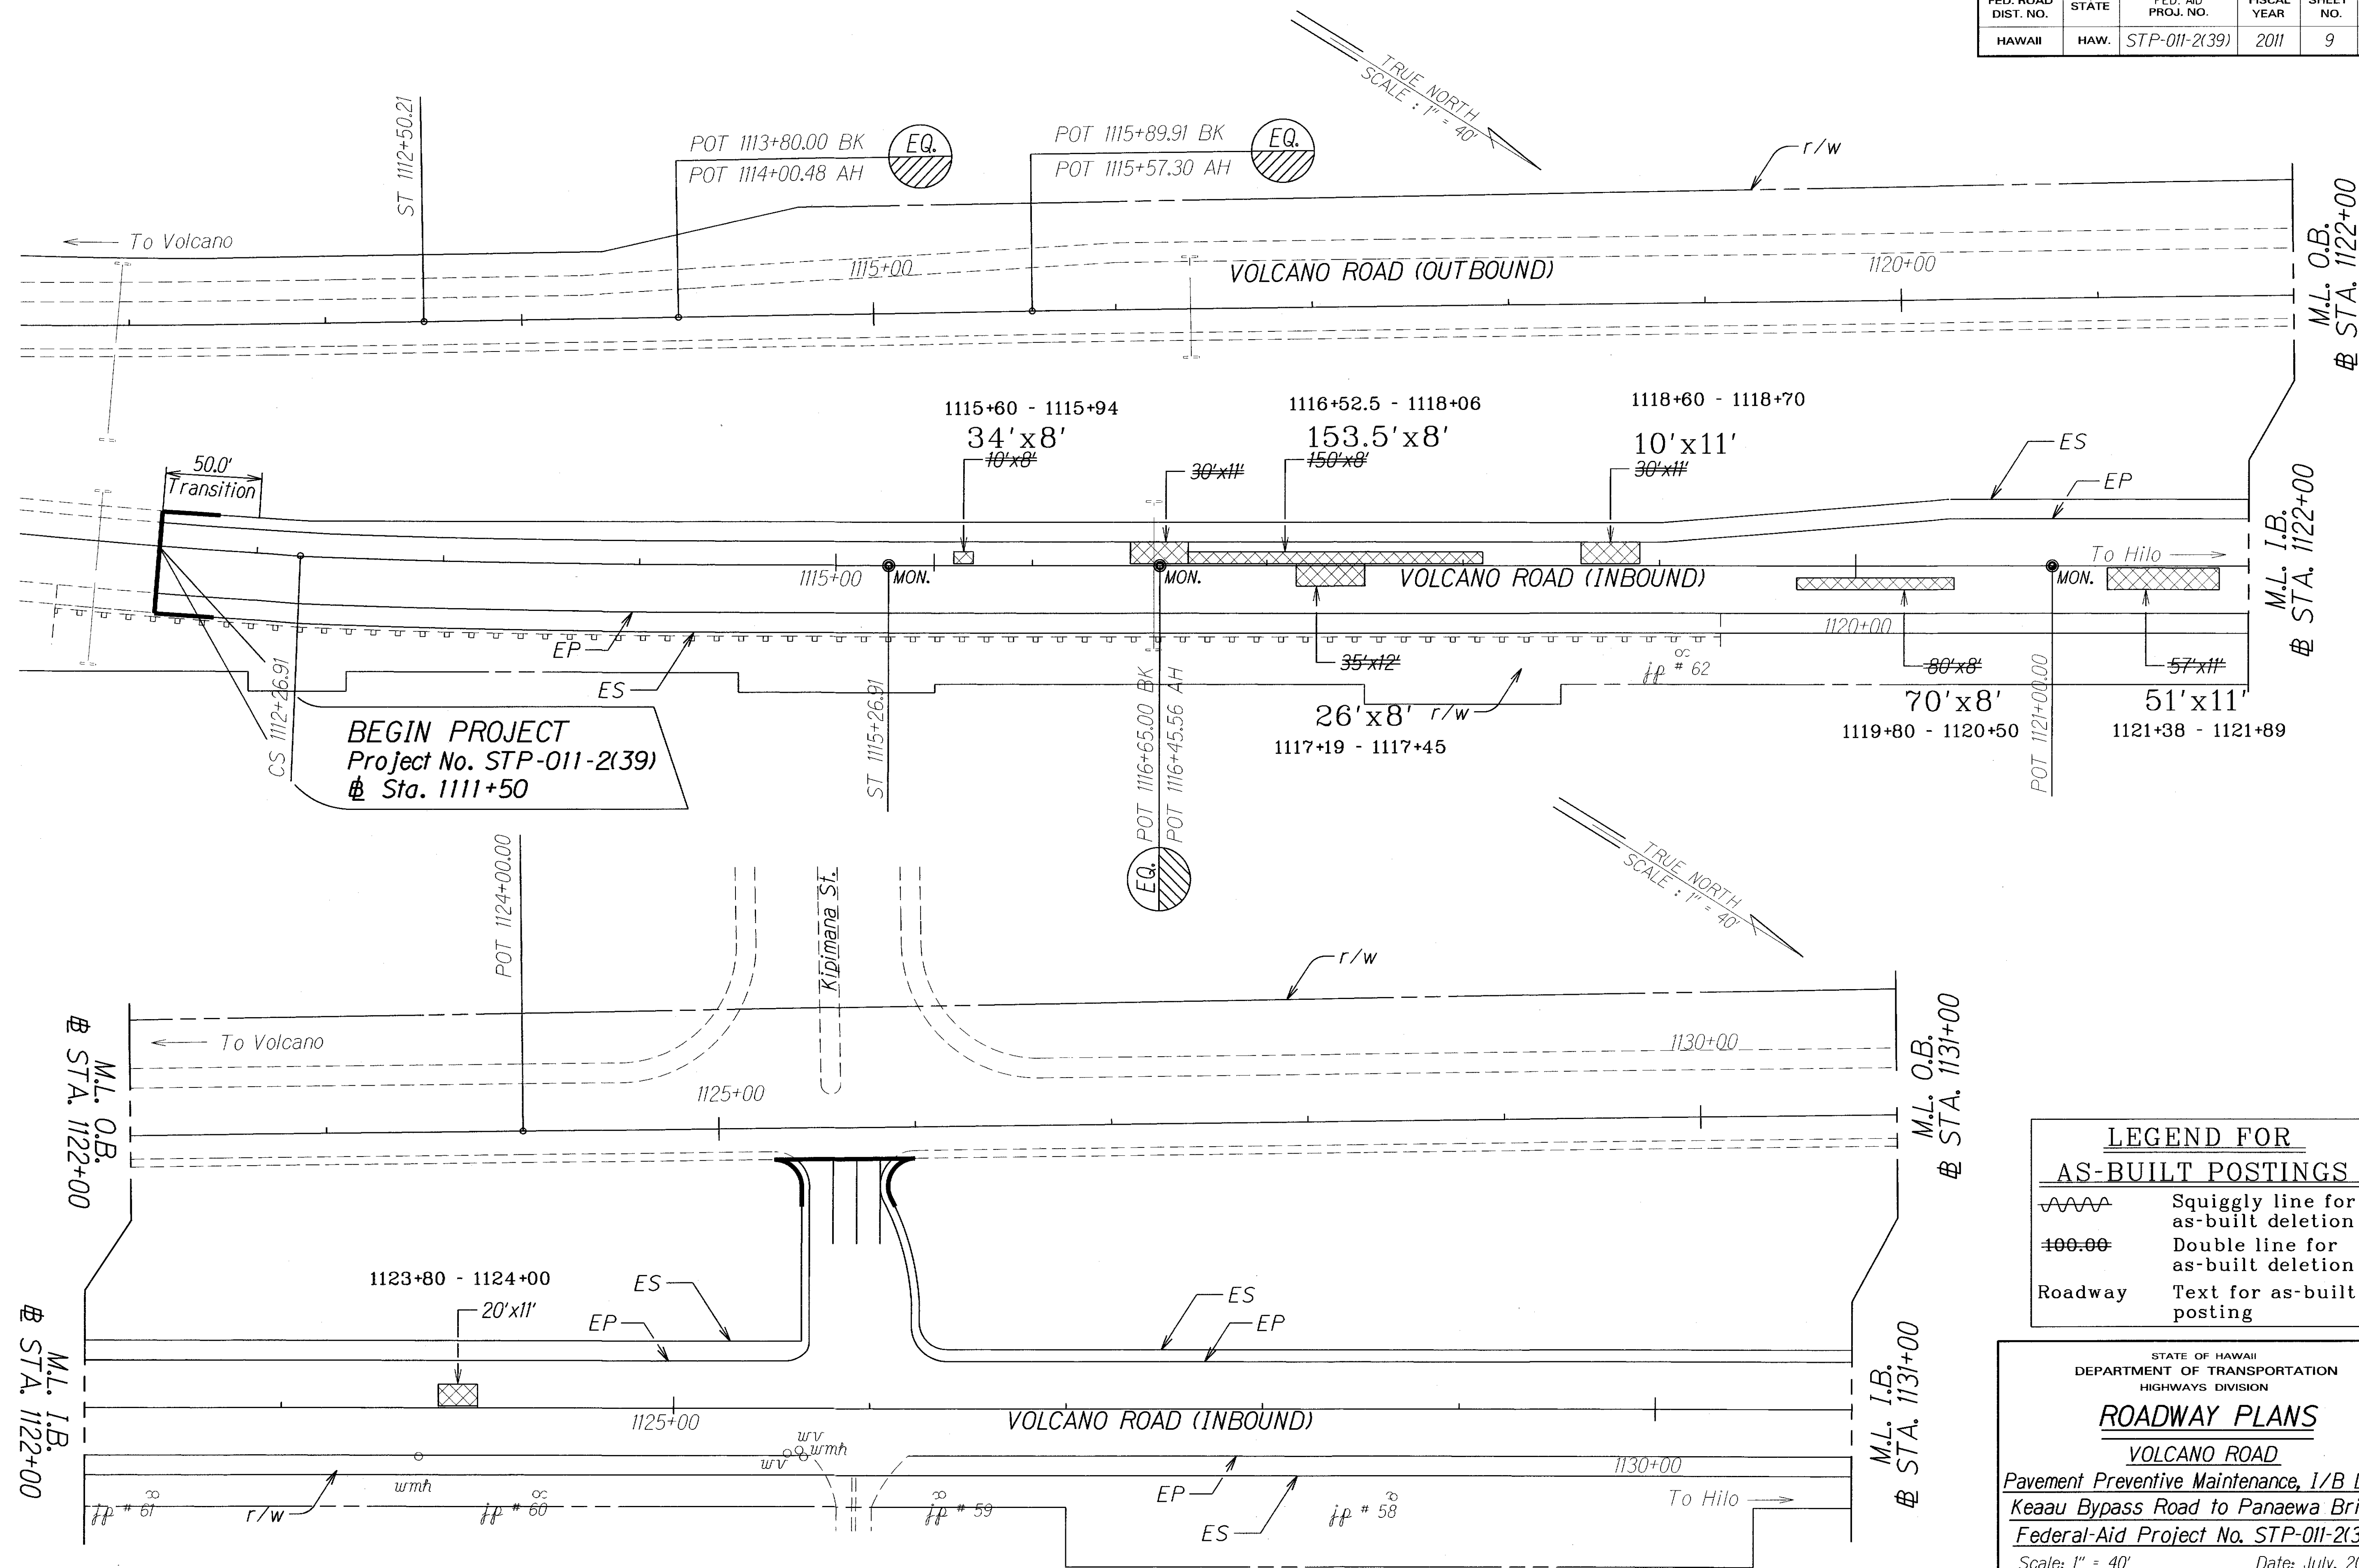

LEGEND FOR AS-BUILT POSTINGS	
	Squiggly line for as-built deletion
	Double line for as-built deletion
	Text for as-built posting

STATE OF HAWAII
DEPARTMENT OF TRANSPORTATION
HIGHWAYS DIVISION

ROADWAY PLANS

VOLCANO ROAD


Pavement Preventive Maintenance, 1/2 Lanes
Keaau Bypass Road to Panaewa Bridge
Federal-Aid Project No. STP-011-2(39)

Scale: 1" = 40' Date: July, 2011

ORIGINAL PLAN	DATE
DESIGNED BY	
DRAWN BY	
CHECKED BY	
NOTED BY	
QUANTITIES BY	
DATE	

"AS-BUILT"

FED. ROAD DIST. NO.	STATE	FED. AID PROJ. NO.	FISCAL YEAR	SHEET NO.	TOTAL SHEETS
HAWAII	HAW.	STP-011-2(39)	2011	ADD.10	33

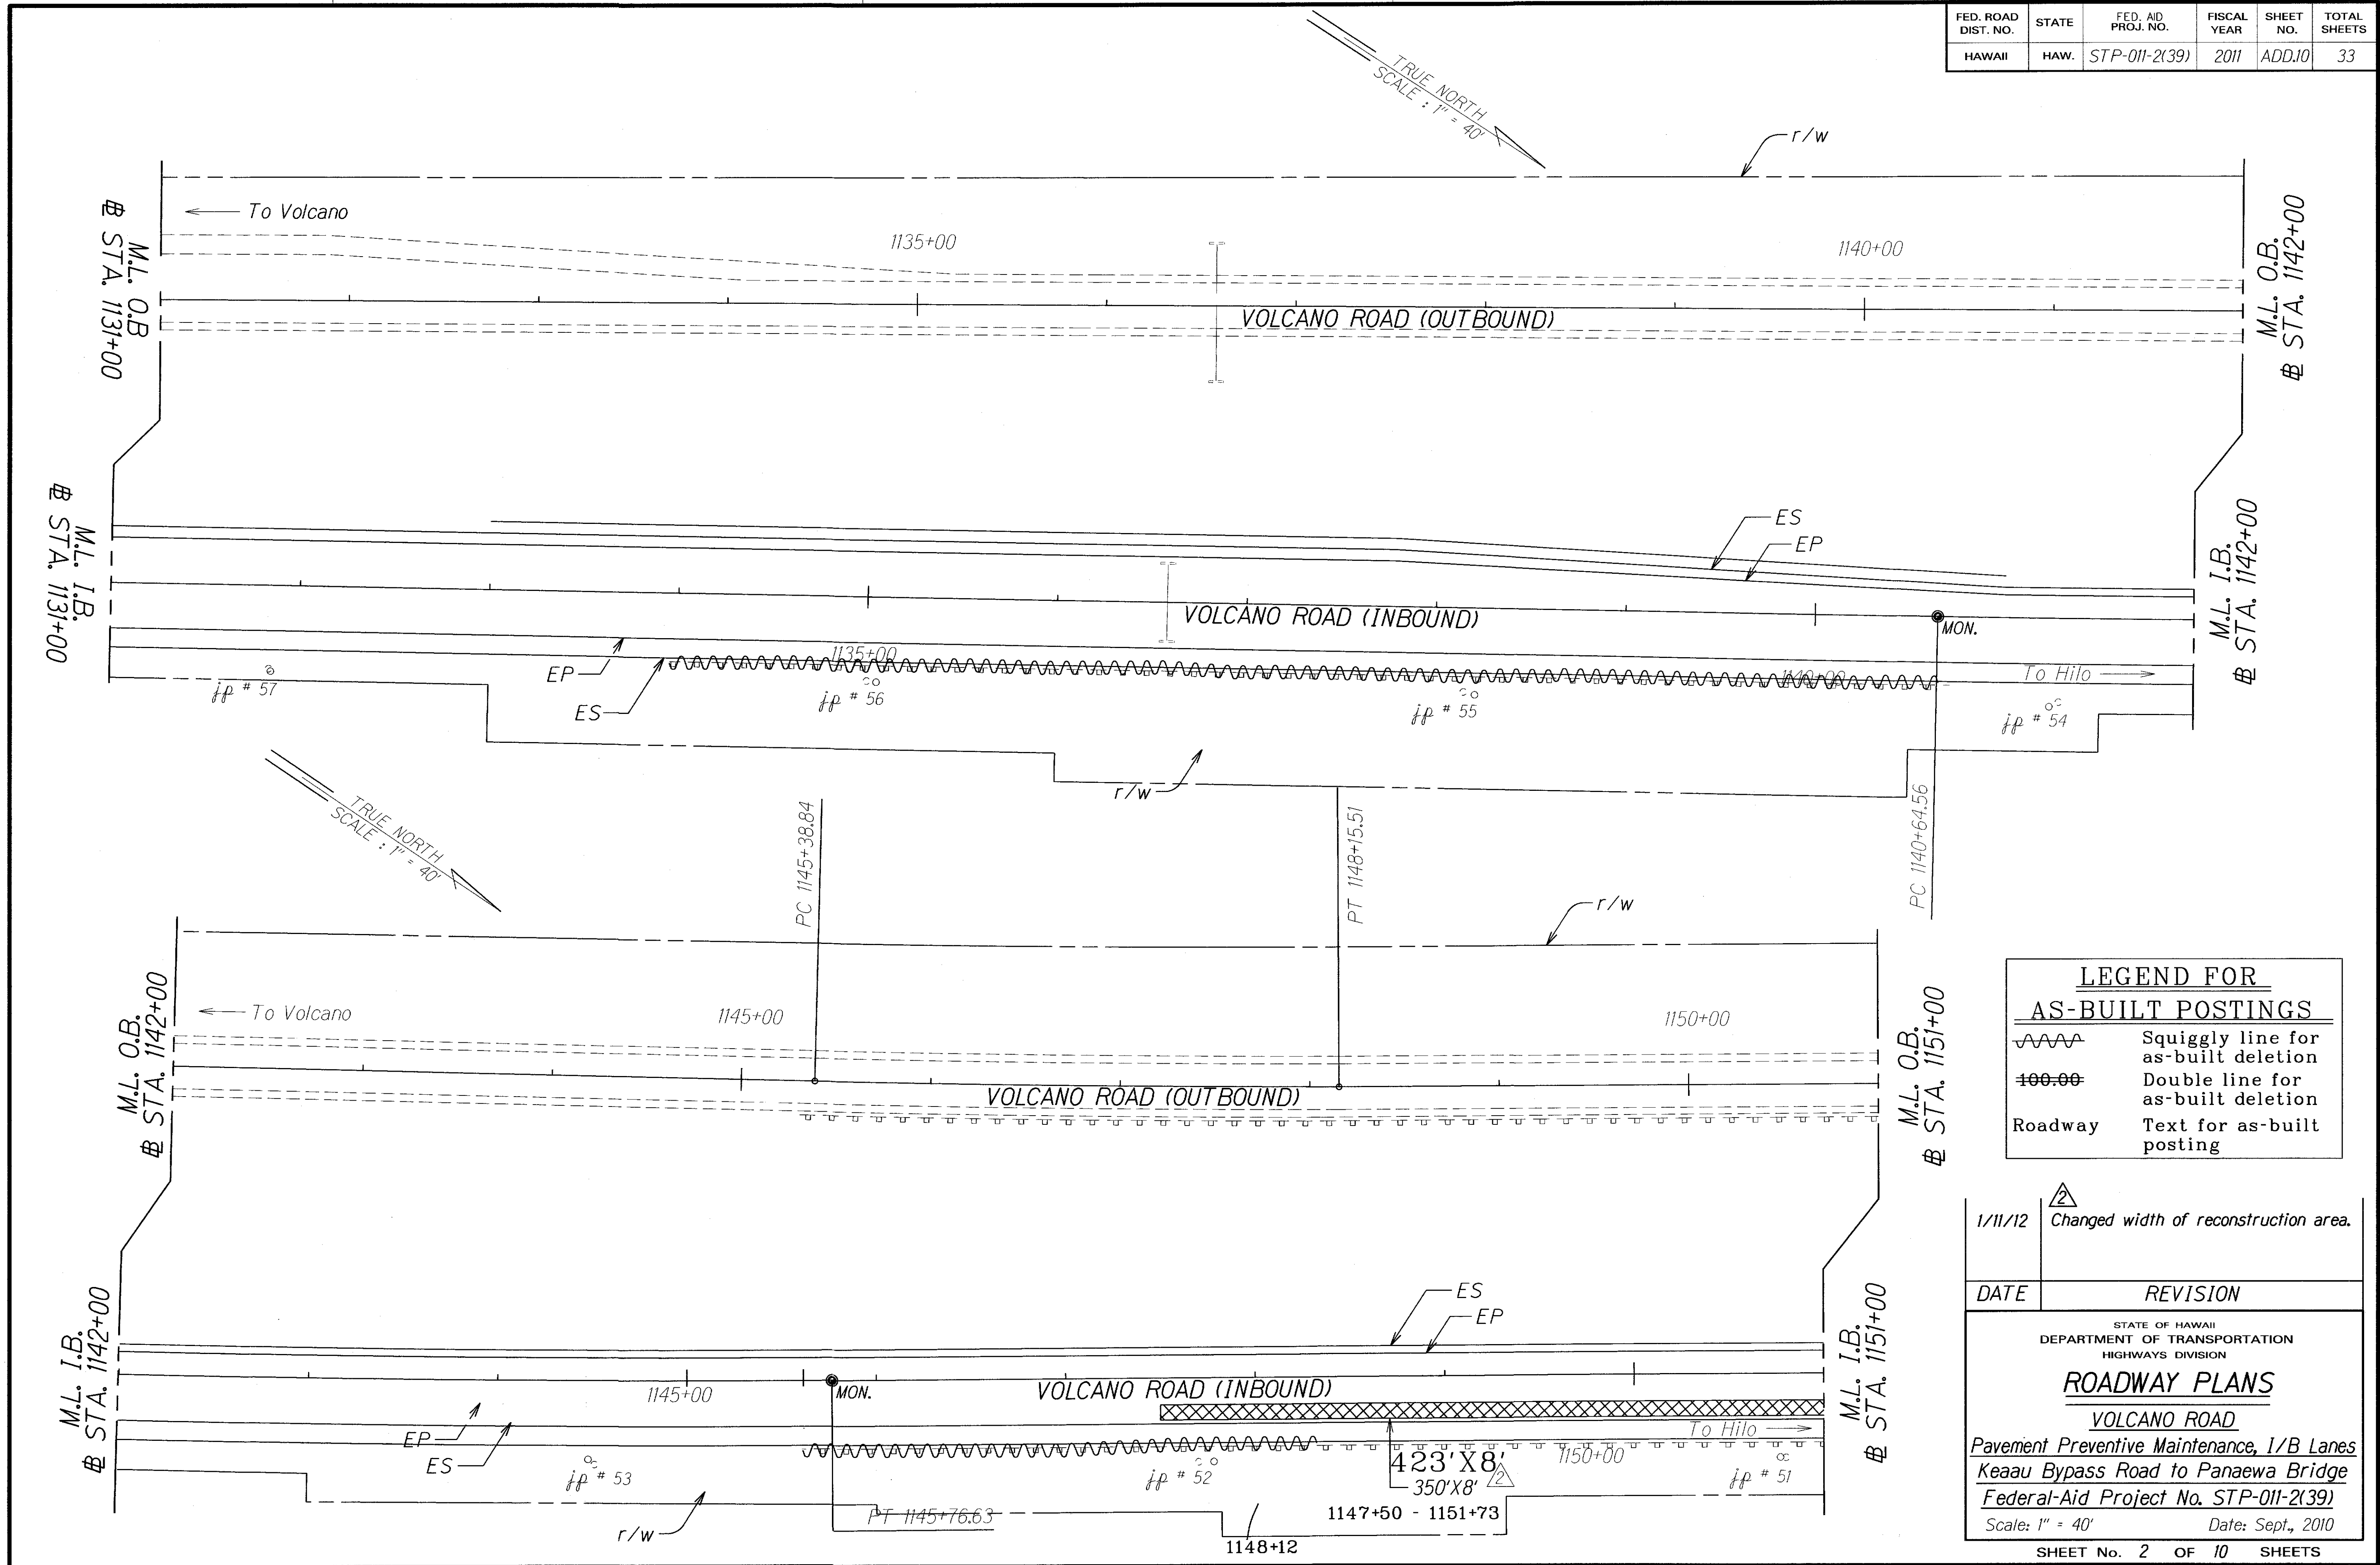

LEGEND FOR AS-BUILT POSTINGS	
	Squiggly line for as-built deletion
	Double line for as-built deletion
Roadway	Text for as-built posting

1/11/12	Changed width of reconstruction area.
---------	---------------------------------------

DATE	REVISION

STATE OF HAWAII
DEPARTMENT OF TRANSPORTATION
HIGHWAYS DIVISION

ROADWAY PLANS

VOLCANO ROAD

Pavement Preventive Maintenance, I/B Lanes
Keaau Bypass Road to Panaewa Bridge
Federal-Aid Project No. STP-011-2(39)

Scale: 1" = 40' Date: Sept., 2010


SHEET No. 2 OF 10 SHEETS

ORIGINAL PLAN	SURVEY PLOTTED BY	DATE
NOTE BOOK	DRAWN BY	
DESIGNED BY		
CHECKED BY		

"AS-BUILT"

ADD.10

FED. ROAD DIST. NO.	STATE	FED. AID PROJ. NO.	FISCAL YEAR	SHEET NO.	TOTAL SHEETS
HAWAII	HAW.	STP-011-2(39)	2011	ADD.11	33

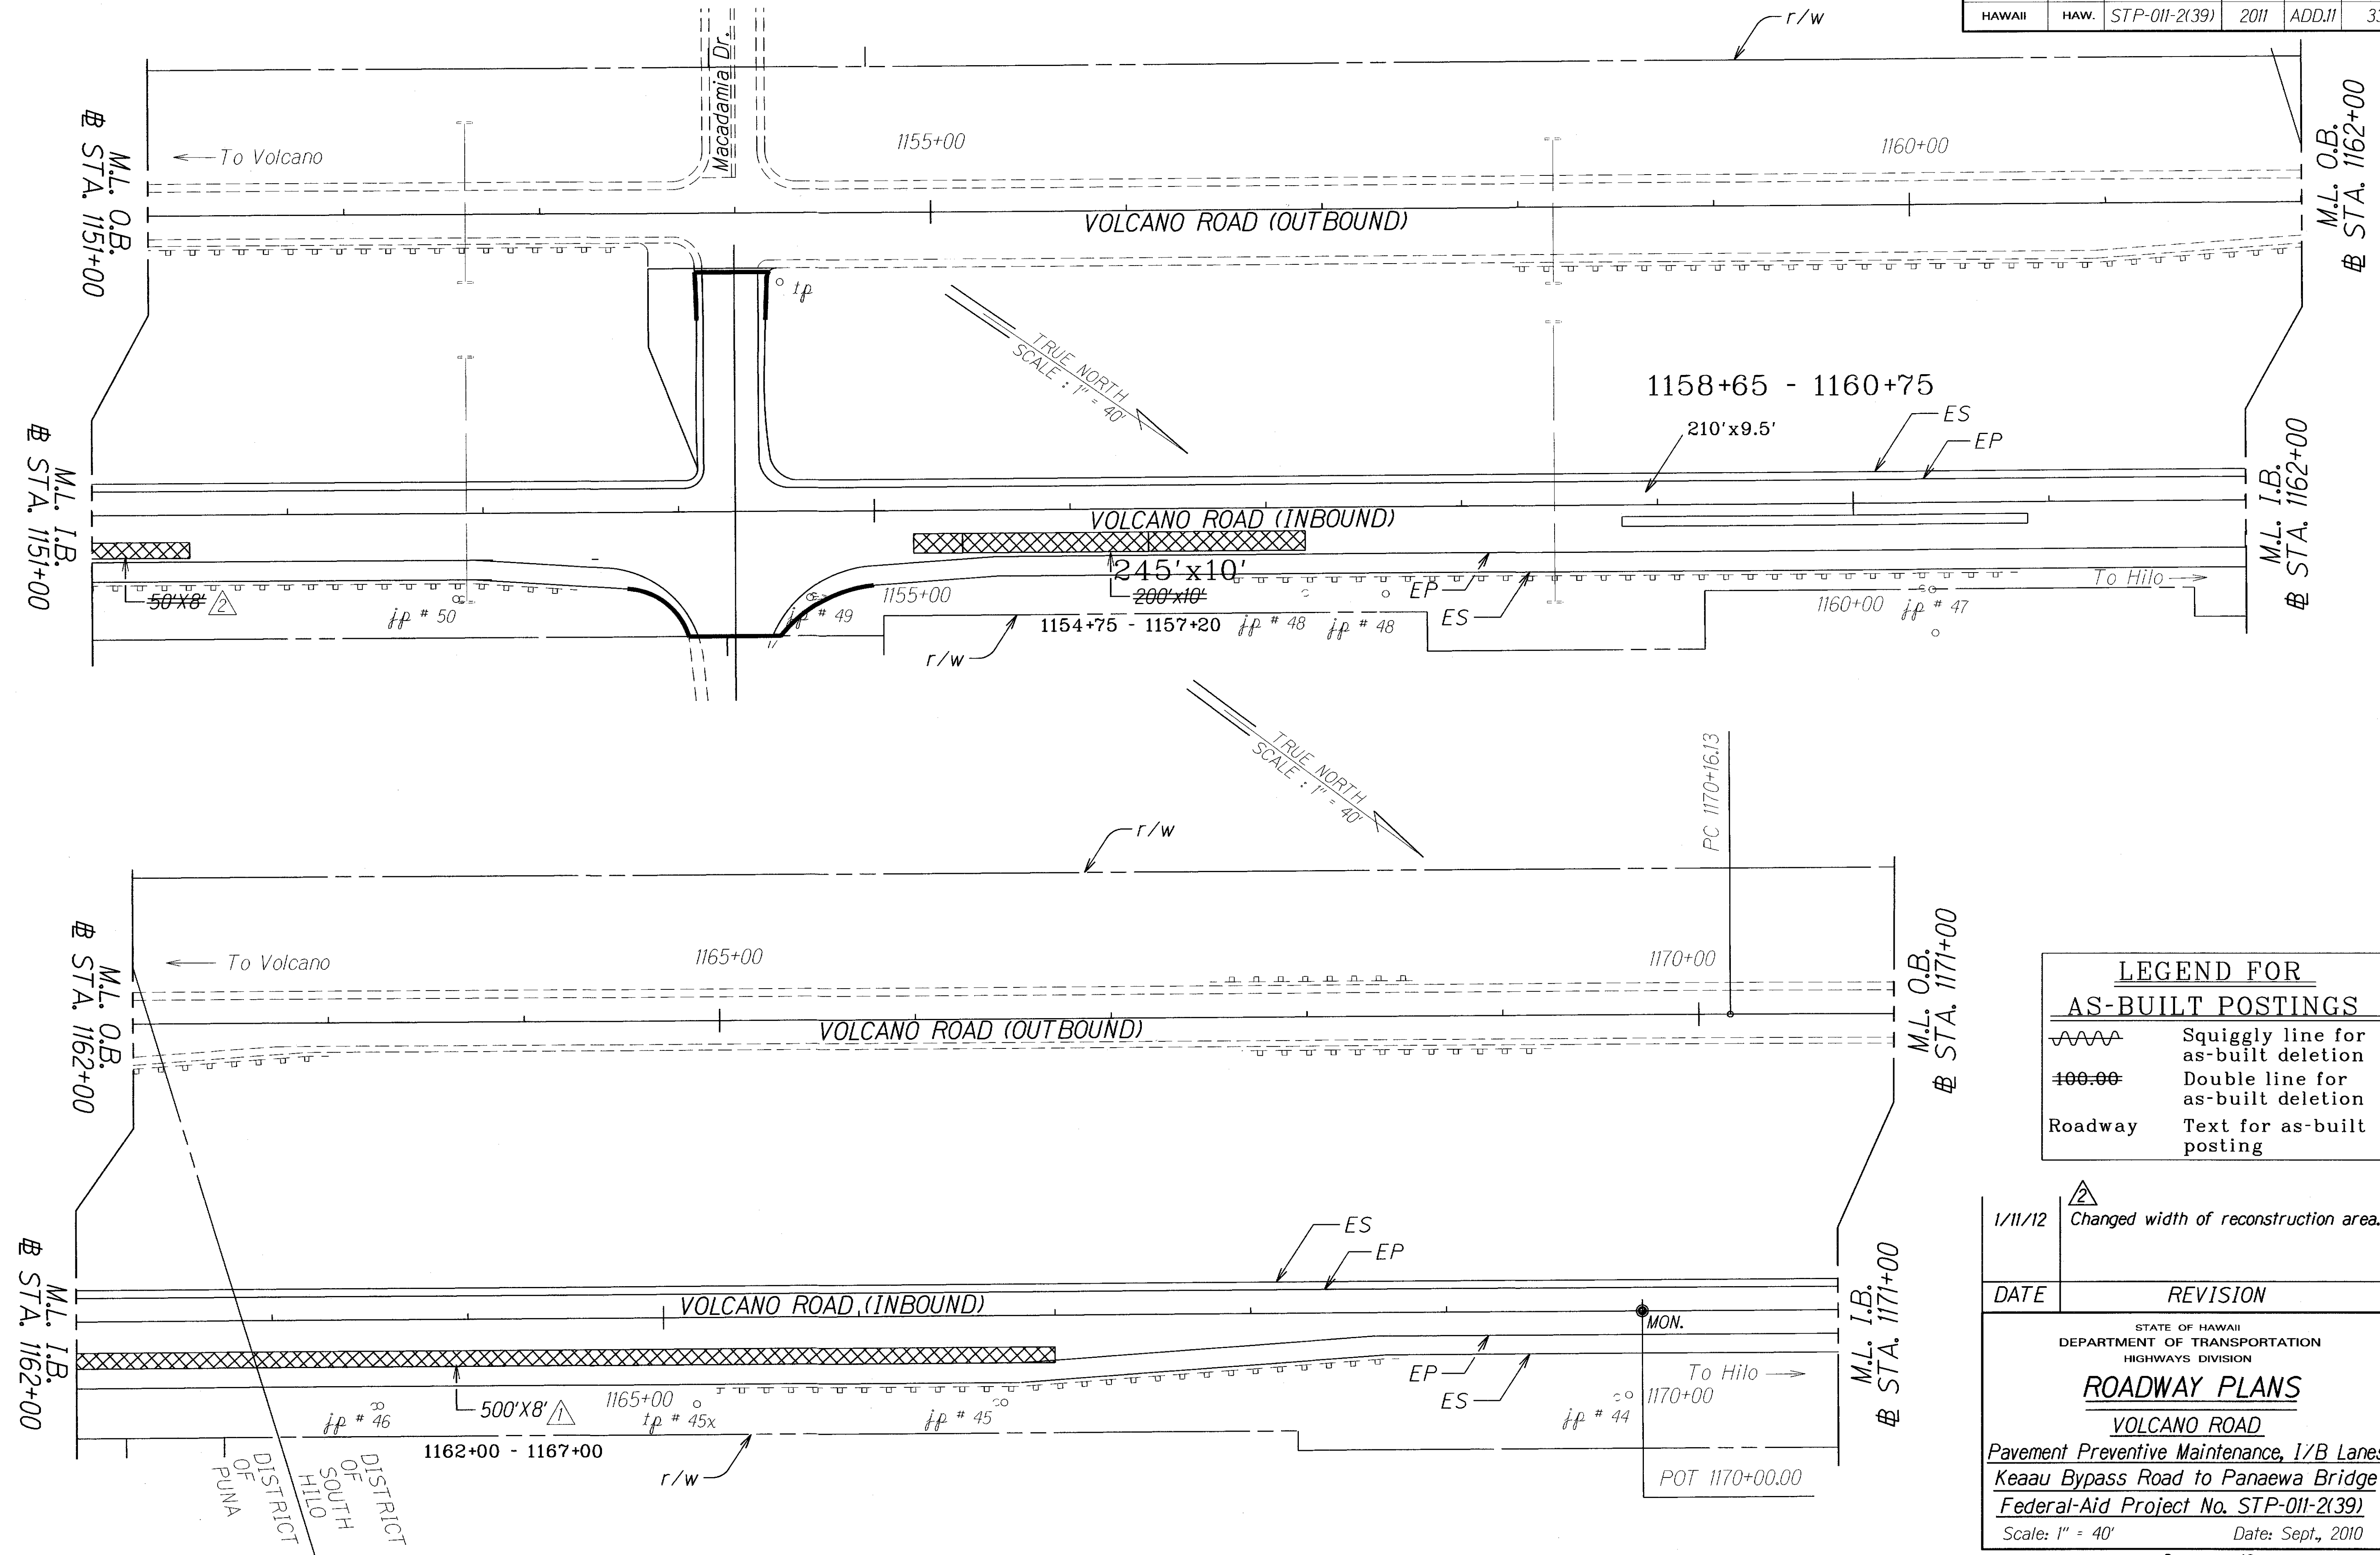

LEGEND FOR AS-BUILT POSTINGS	
	Squiggly line for as-built deletion
	Double line for as-built deletion
Roadway	Text for as-built posting

1/11/12	Changed width of reconstruction area.
---------	---------------------------------------


DATE	REVISION
------	----------

STATE OF HAWAII
DEPARTMENT OF TRANSPORTATION
HIGHWAYS DIVISION

ROADWAY PLANS
VOLCANO ROAD
Pavement Preventive Maintenance, 1/2 Lanes
Keaau Bypass Road to Panaewa Bridge
Federal-Aid Project No. STP-011-2(39)
Scale: 1" = 40' Date: Sept., 2010

ORIGINAL PLAN	SURVEY PLOTTED BY	DATE
NOTE BOOK	DRAWN BY	
DESIGNED BY		
QUANTITIES BY		
CHECKED BY		

FED. ROAD DIST. NO.	STATE	FED. AID PROJ. NO.	FISCAL YEAR	SHEET NO.	TOTAL SHEETS
HAWAII	HAW.	STP-011-2(39)	2011	12	33

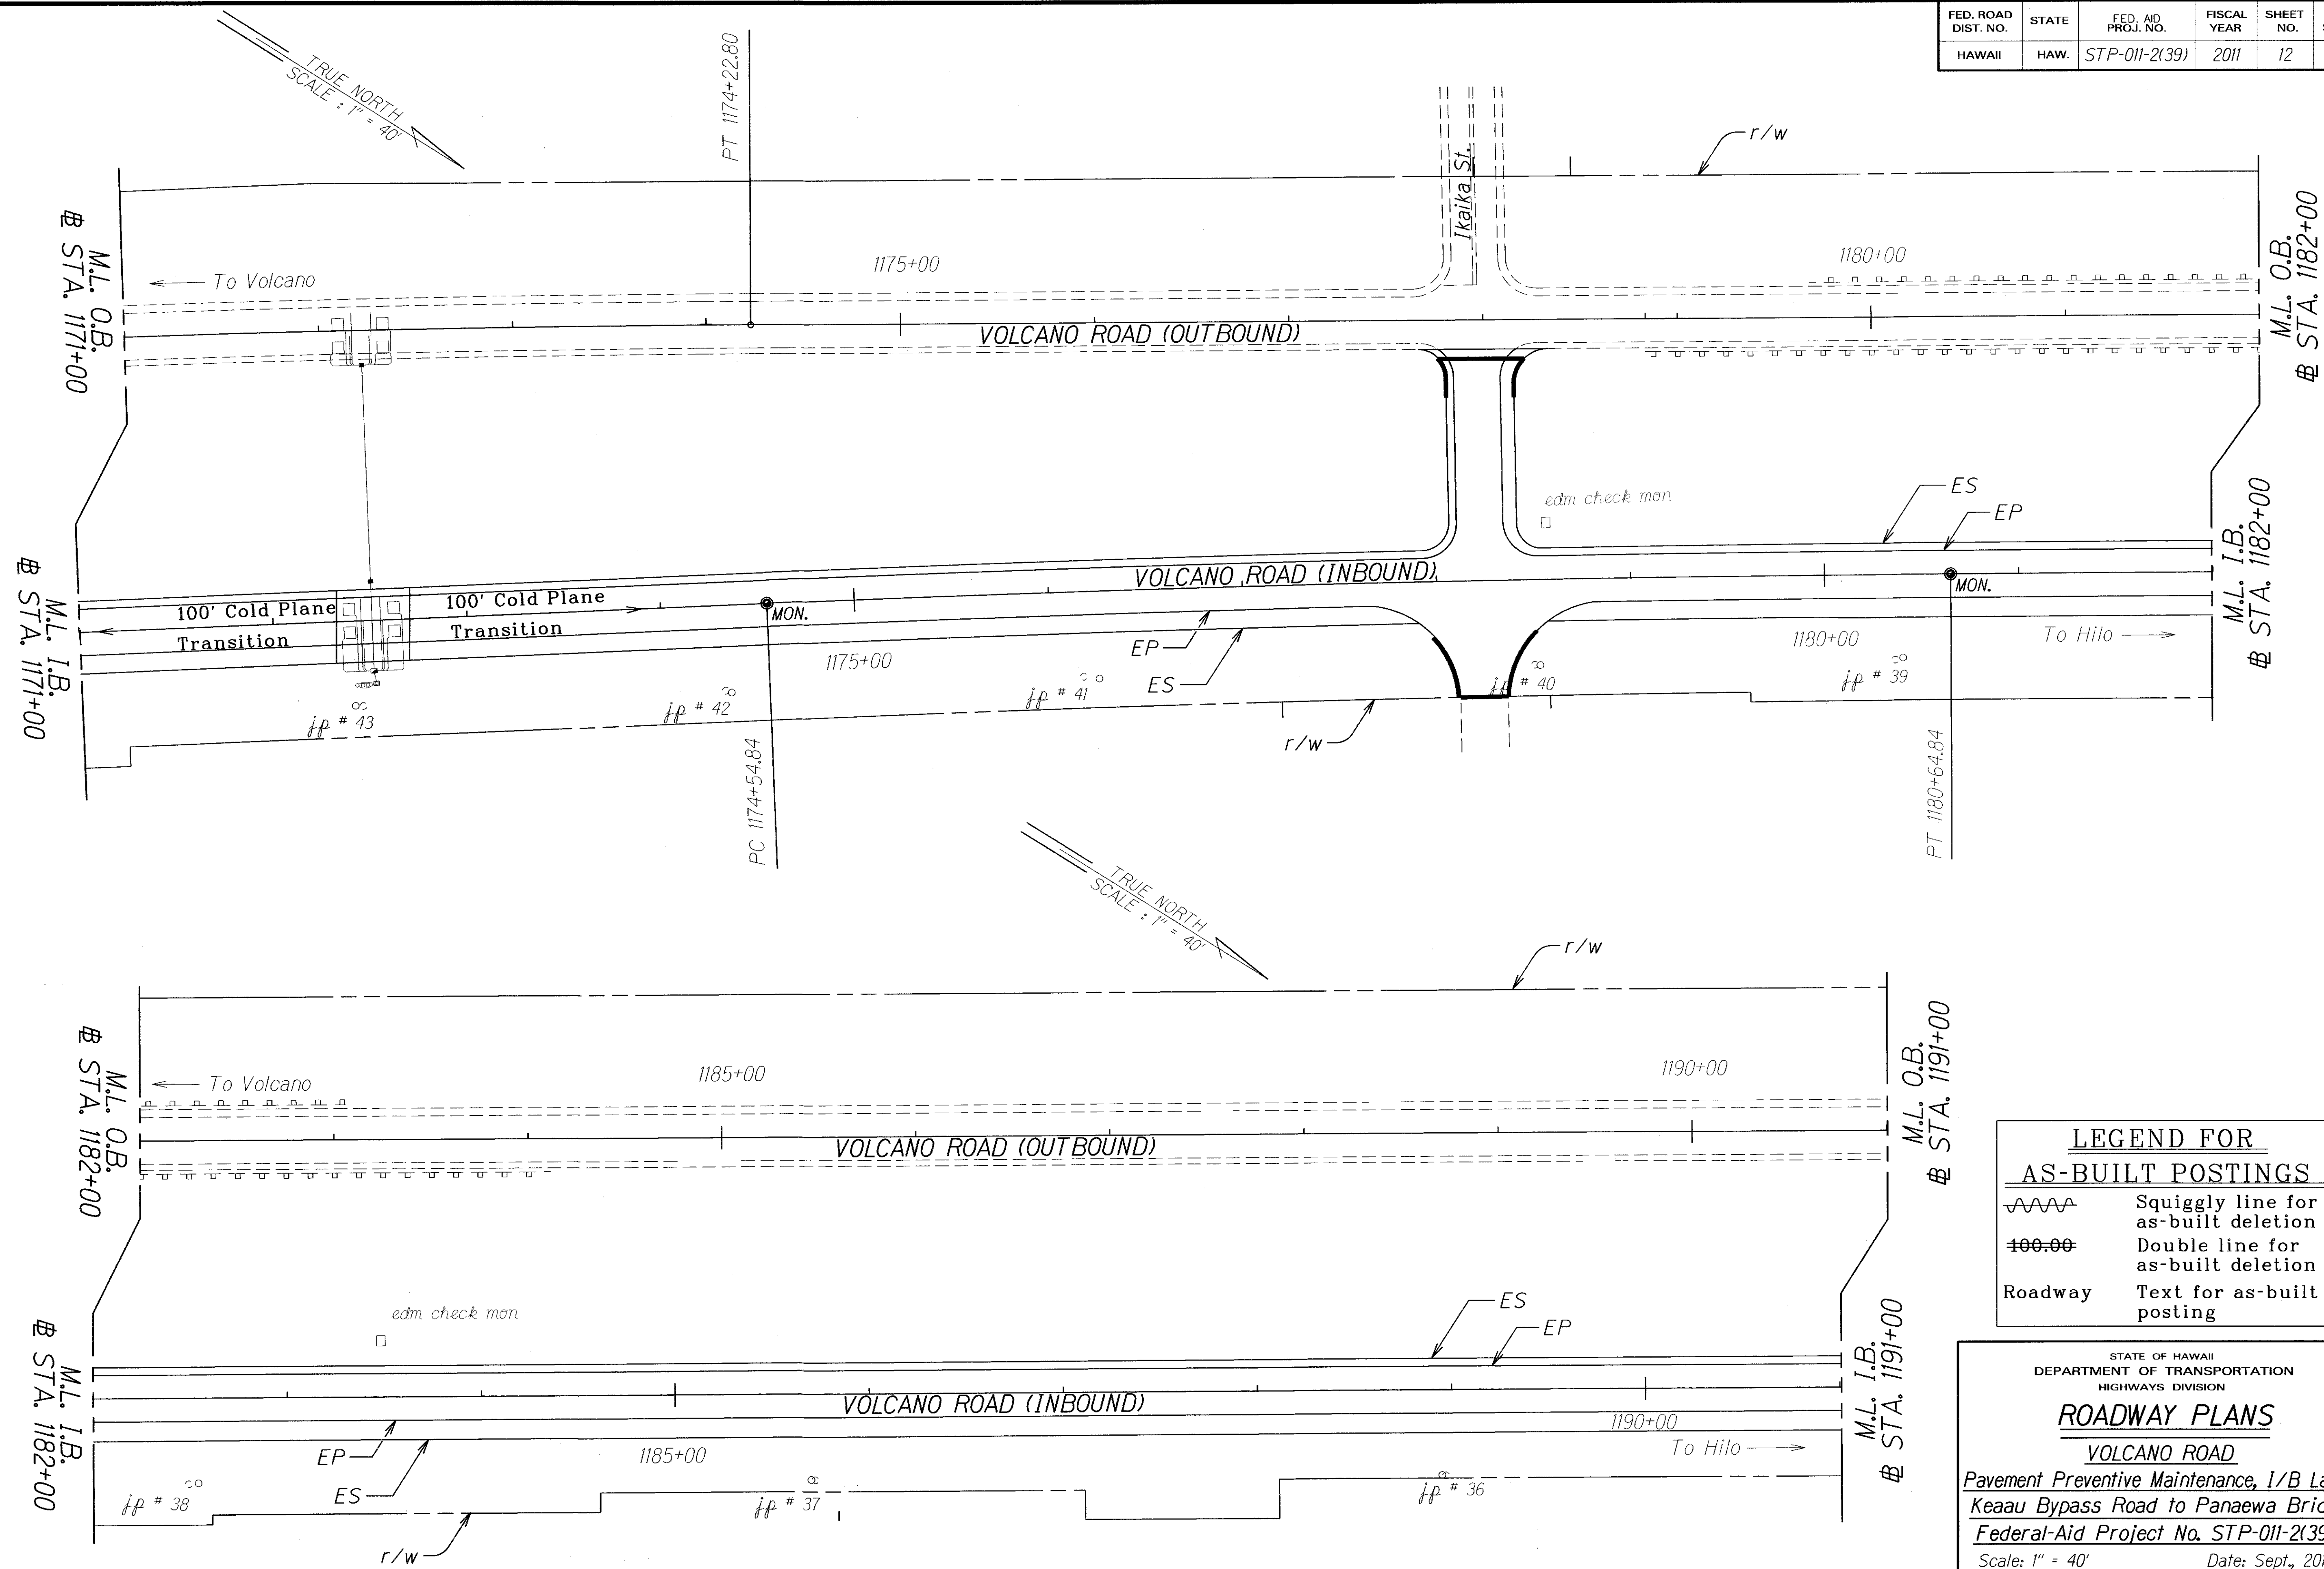

ORIGINAL PLAN	SURVEY PLOTTED BY	DATE
DRAWN BY		
DESIGNED BY		
QUANTITIES BY		
CHECKED BY		

LEGEND FOR AS-BUILT POSTINGS	
	Squiggly line for as-built deletion
	Double line for as-built deletion
Roadway	Text for as-built posting

STATE OF HAWAII
DEPARTMENT OF TRANSPORTATION
HIGHWAYS DIVISION

ROADWAY PLANS



VOLCANO ROAD

Pavement Preventive Maintenance, 1/2 Lanes
Keaau Bypass Road to Panaewa Bridge
Federal-Aid Project No. STP-011-2(39)

Scale: 1" = 40' Date: Sept., 2010

"AS-BUILT"

FED. ROAD DIST. NO.	STATE	FED. AID PROJ. NO.	FISCAL YEAR	SHEET NO.	TOTAL SHEETS
HAWAII	HAW.	STP-011-2(39)	2011	13	33

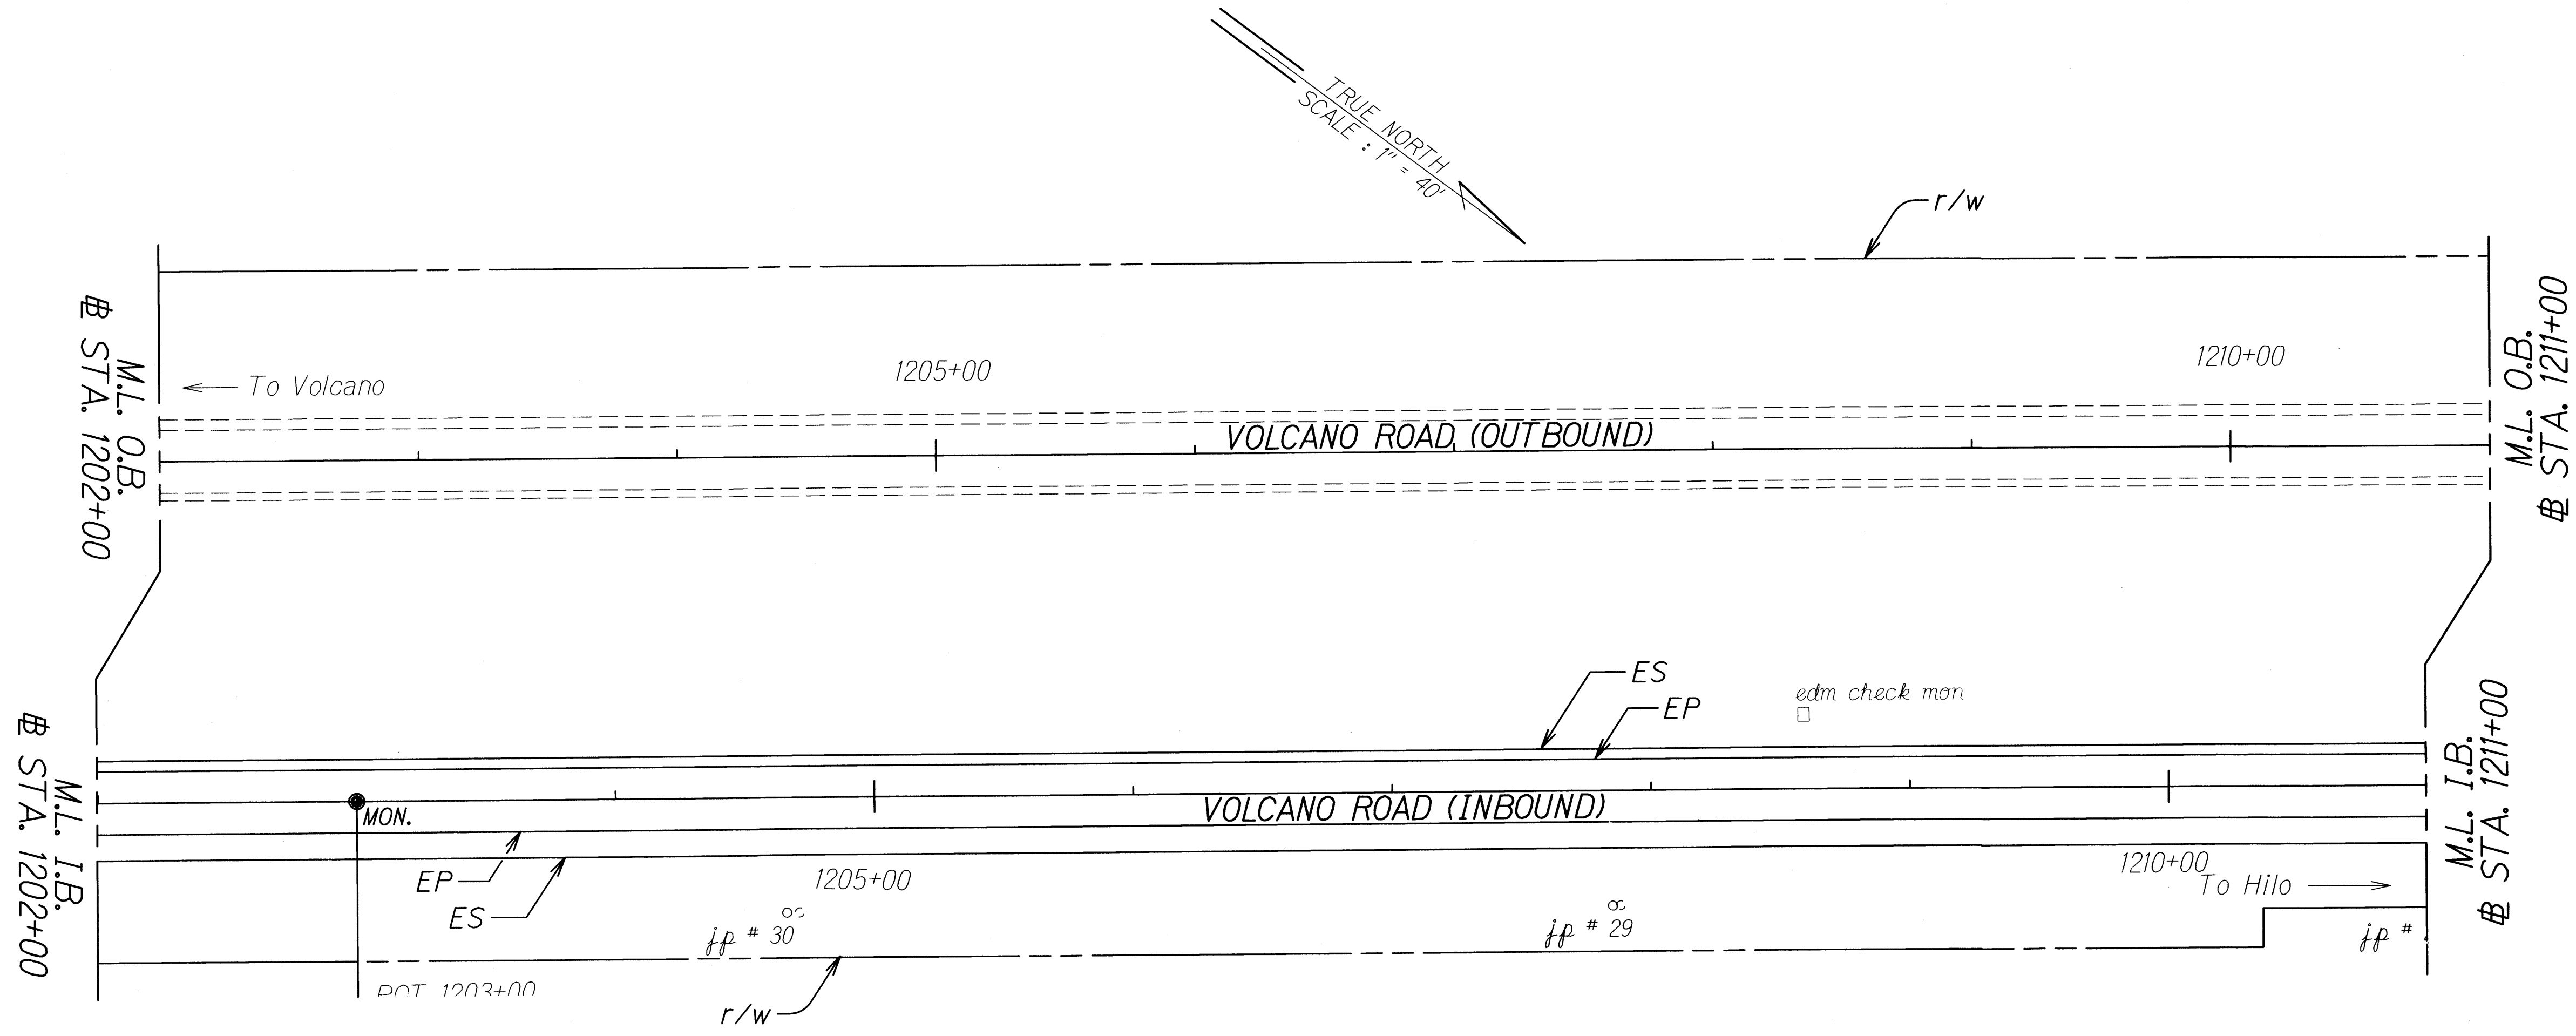
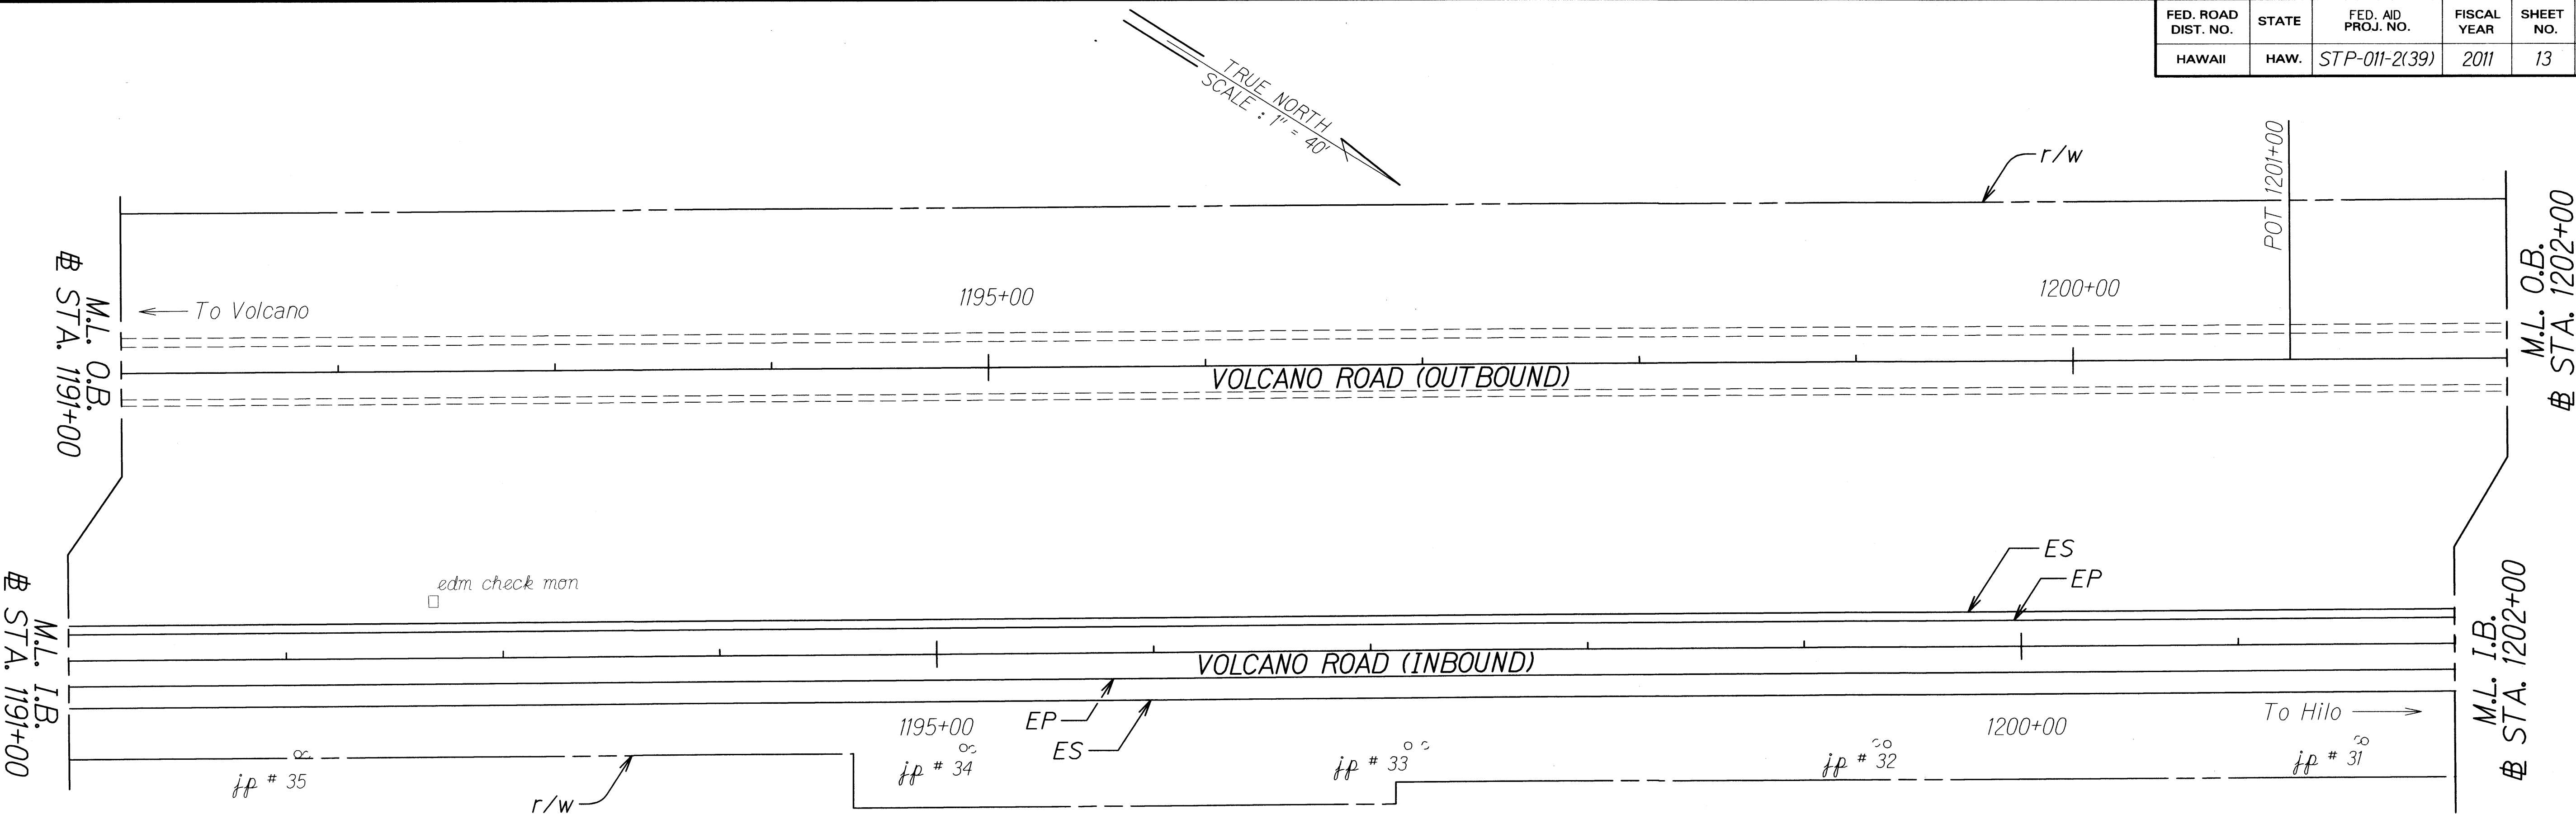


STATE OF HAWAII
DEPARTMENT OF TRANSPORTATION
HIGHWAYS DIVISION

ROADWAY PLANS
VOLCANO ROAD
Pavement Preventive Maintenance, I/B Lanes
Keaau Bypass Road to Panaewa Bridge
Federal-Aid Project No. STP-011-2(39)
Scale: 1" = 40'
Date: Sept., 2010

SURVEY PLOTTED BY	DATE
DRAWN BY	
TRACED BY	
QUANTITIES BY	
CHECKED BY	
ORIGINAL PLAN	
NOTE BOOK	
DATE	
BY	

FED. ROAD DIST. NO.	STATE	FED. AID PROJ. NO.	FISCAL YEAR	SHEET NO.	TOTAL SHEETS
HAWAII	HAW.	STP-011-2(39)	2011	14	33

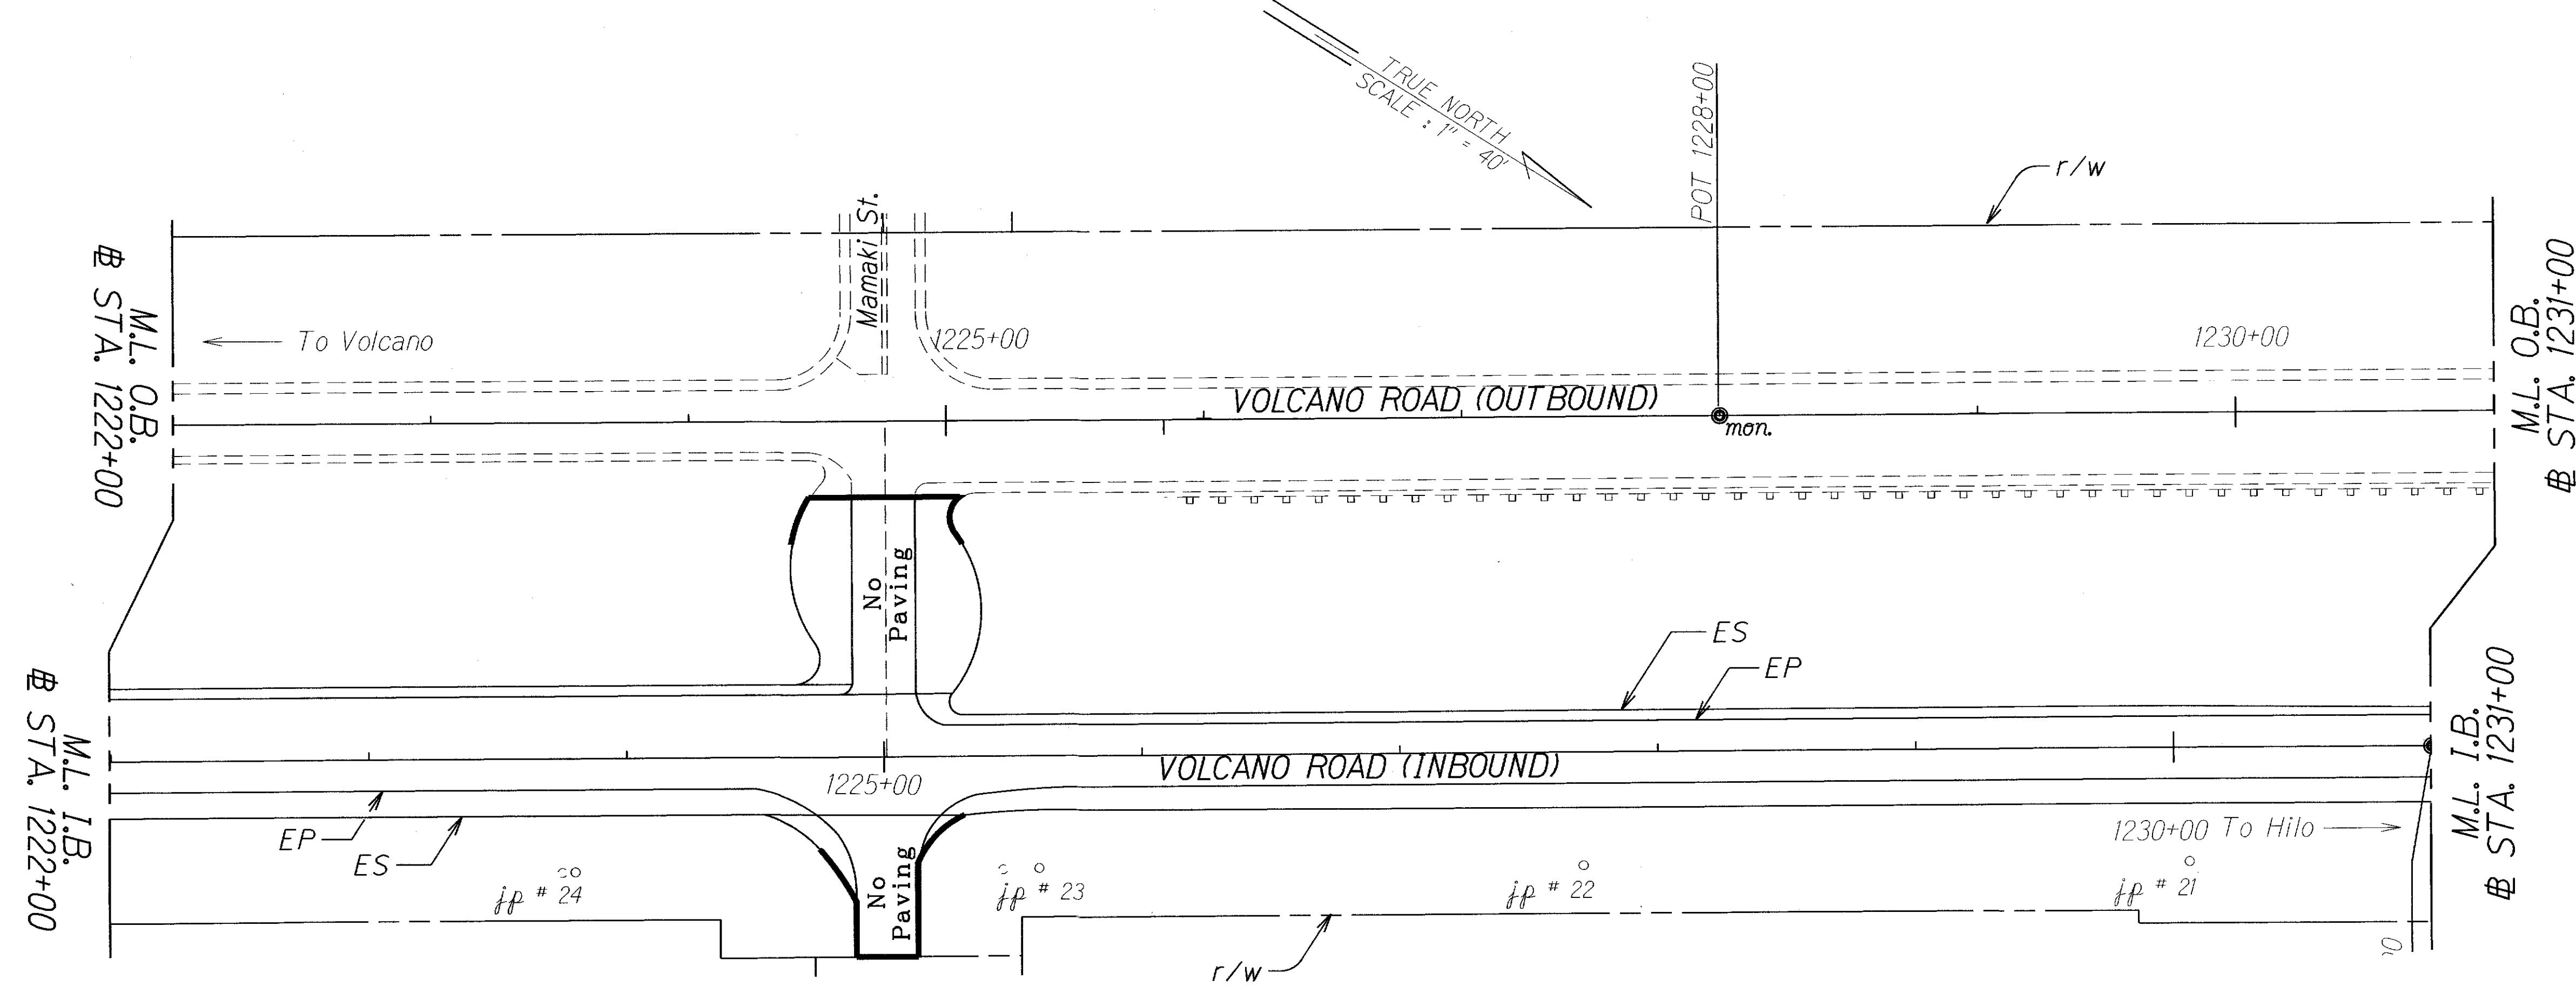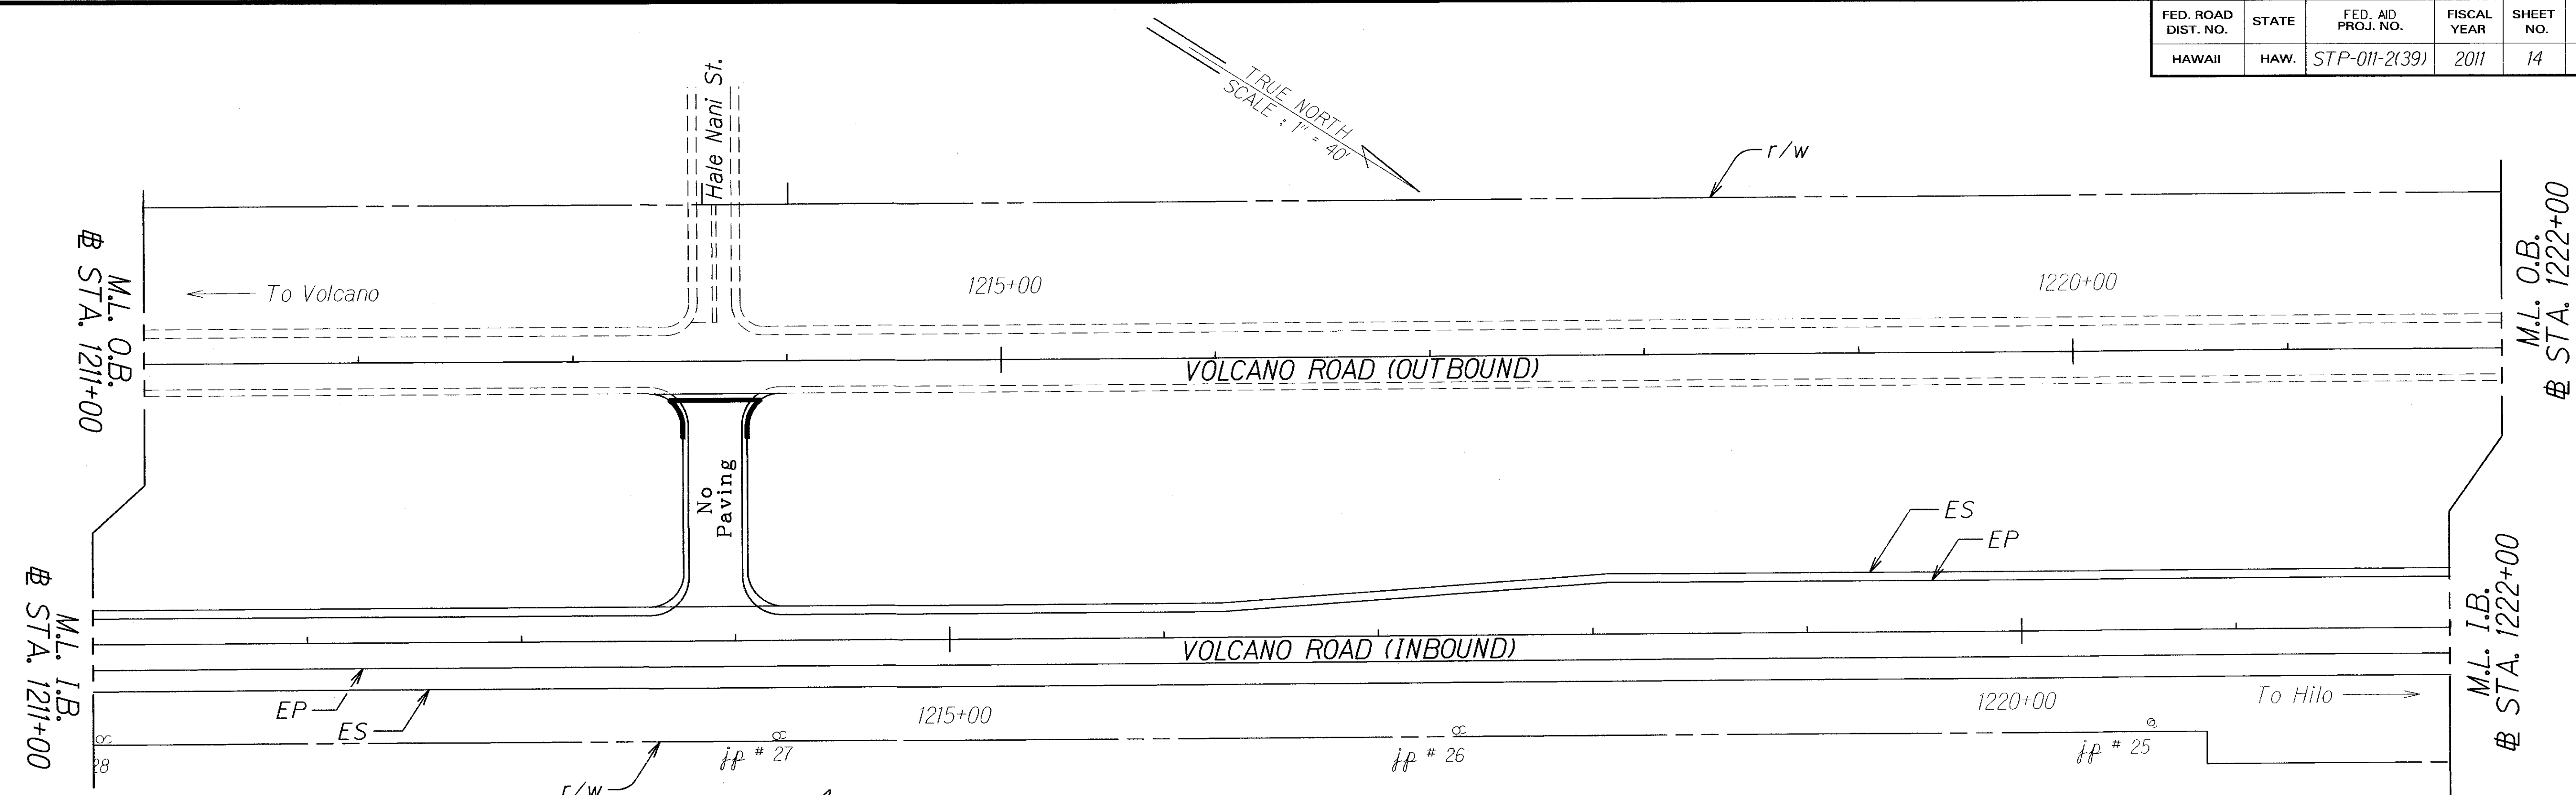

LEGEND FOR AS-BUILT POSTINGS	
	Squiggly line for as-built deletion
	Double line for as-built deletion
Roadway	Text for as-built posting

STATE OF HAWAII
DEPARTMENT OF TRANSPORTATION
HIGHWAYS DIVISION

ROADWAY PLANS

VOLCANO ROAD


*Pavement Preventive Maintenance, 1/2 Lanes
Keaau Bypass Road to Panaewa Bridge
Federal-Aid Project No. STP-011-2(39)*

Scale: 1" = 40' Date: Sept., 2010

ORIGINAL PLAN	SURVEY PLOTTED BY	DATE
NOTE BOOK	DRAWN BY	
DESIGNED BY	CHECKED BY	
QUANTITIES BY		
CHECKED BY		

"AS-BUILT"

FED. ROAD DIST. NO.	STATE	FED. AID PROJ. NO.	FISCAL YEAR	SHEET NO.	TOTAL SHEETS
HAWAII	HAW.	STP-011-2(39)	2011	15	33

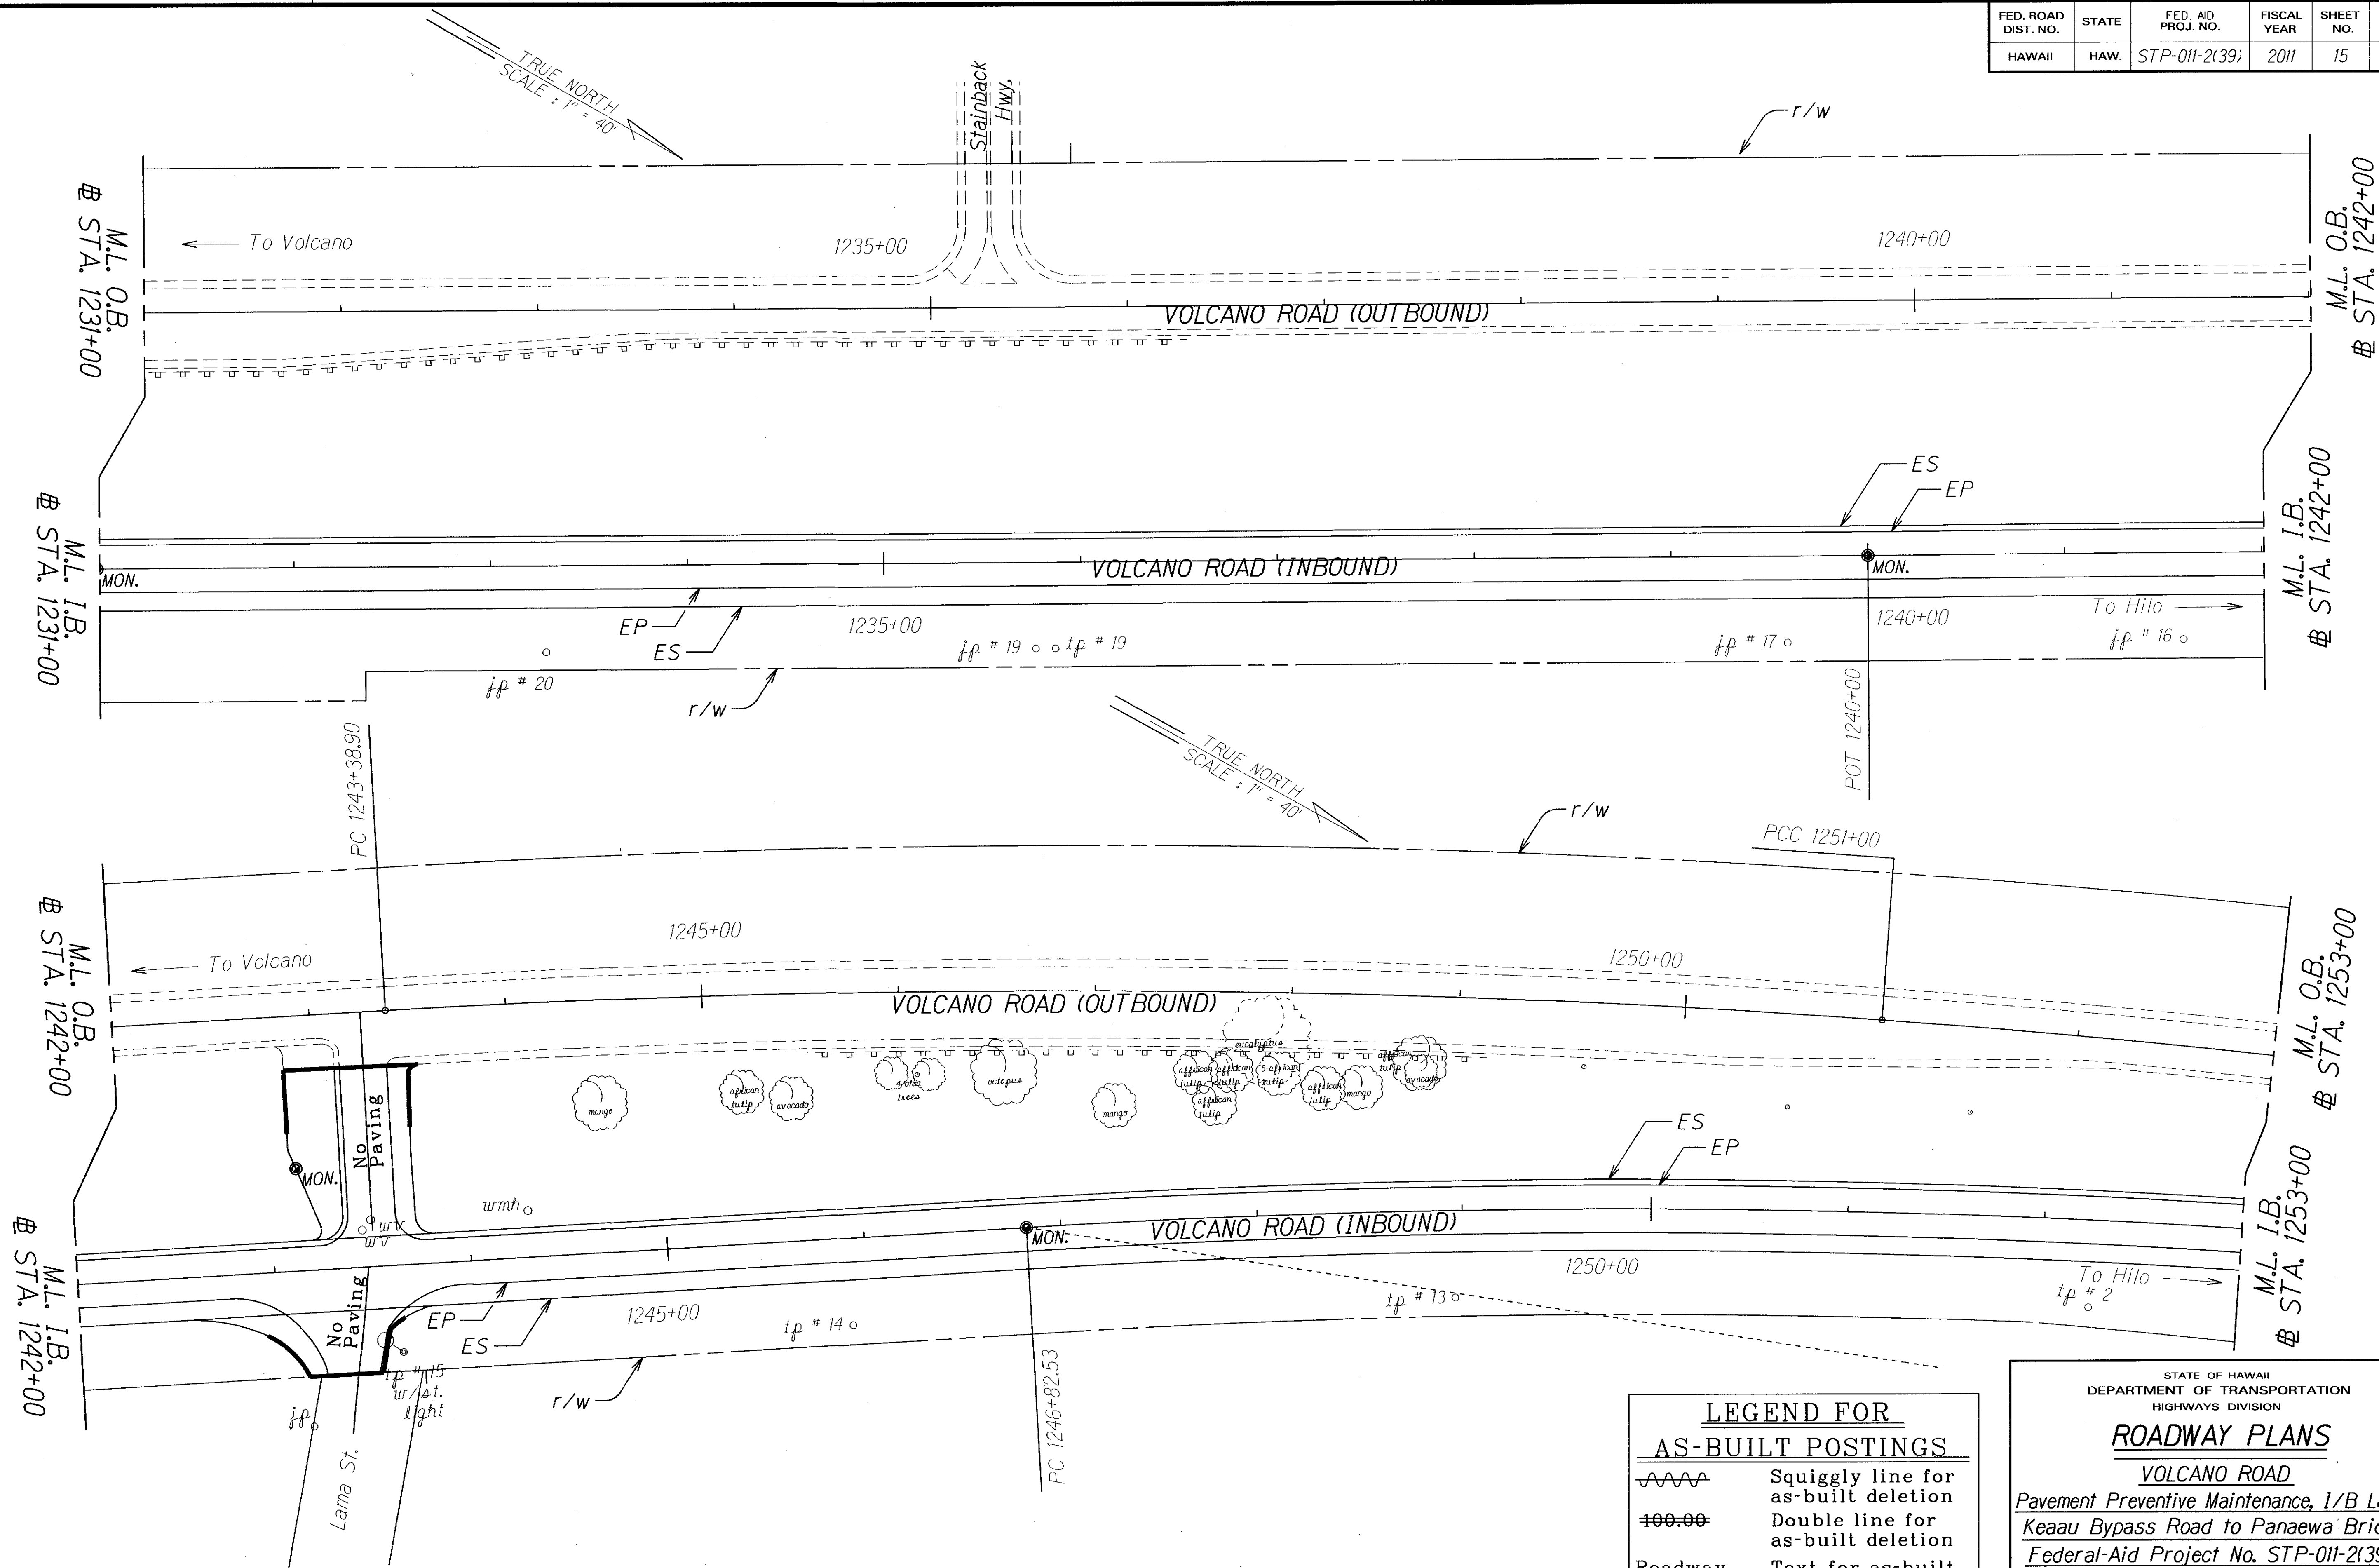

ORIGINAL PLAN	SURVEY PLOTTED BY	DATE
NOTE BOOK	DRAWN BY	
QUANTITIES BY	TRACED BY	
CHECKED BY	NOTED BY	

LEGEND FOR AS-BUILT POSTINGS	
	Squiggly line for as-built deletion
	Double line for as-built deletion
Roadway	Text for as-built posting

STATE OF HAWAII
DEPARTMENT OF TRANSPORTATION
HIGHWAYS DIVISION

ROADWAY PLANS

VOLCANO ROAD


*Pavement Preventive Maintenance, 1/2 Lanes
Keaau Bypass Road to Panaewa Bridge
Federal-Aid Project No. STP-011-2(39)*

Scale: 1" = 40' Date: Sept., 2010

SHEET No. 7 OF 10 SHEETS

"AS-BUILT"

FED. ROAD DIST. NO.	STATE	FED. AID PROJ. NO.	FISCAL YEAR	SHEET NO.	TOTAL SHEETS
HAWAII	HAW.	STP-011-2(39)	2011	16	33

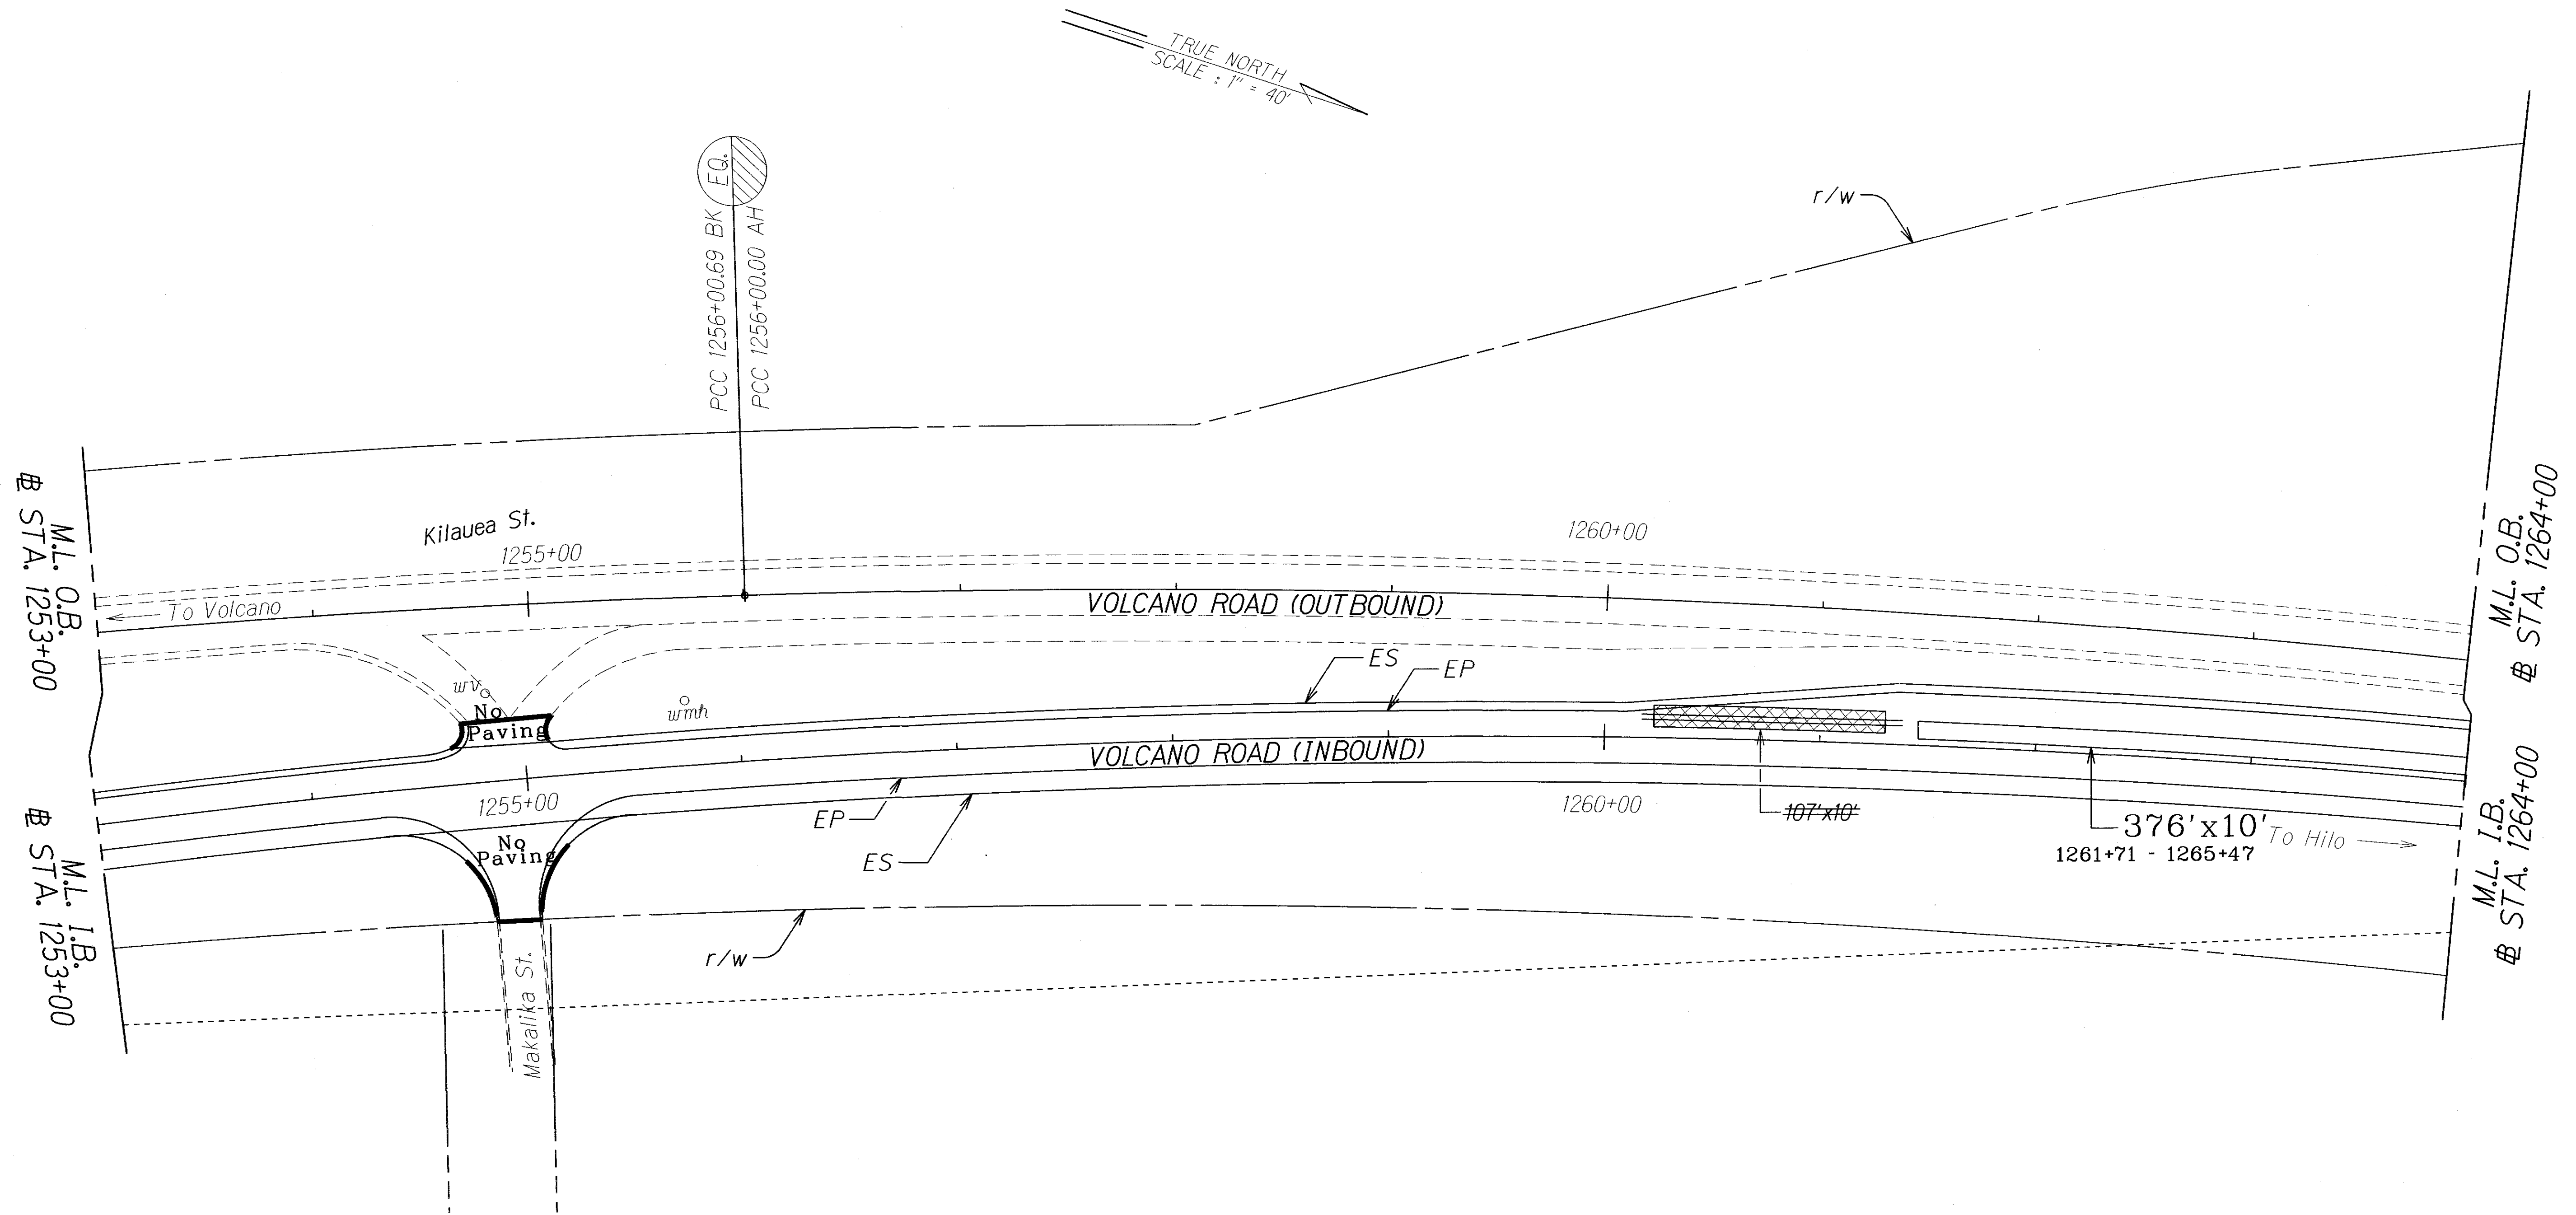

ORIGINAL PLAN	SURVEY PLOTTED BY	DATE
NOTE BOOK	DRAWN BY	
DESIGNED BY		
QUANTITIES BY		
CHECKED BY		

LEGEND FOR AS-BUILT POSTINGS	
	Squiggly line for as-built deletion
	Double line for as-built deletion
Roadway	Text for as-built posting

STATE OF HAWAII
DEPARTMENT OF TRANSPORTATION
HIGHWAYS DIVISION


ROADWAY PLANS

VOLCANO ROAD
Pavement Preventive Maintenance, 1/B Lanes
Keaau Bypass Road to Panaewa Bridge
Federal-Aid Project No. STP-011-2(39)
Scale: 1" = 40' Date: Sept., 2010

SHEET No. 8 OF 10 SHEETS

"AS-BUILT"

FED. ROAD DIST. NO.	STATE	FED. AID PROJ. NO.	FISCAL YEAR	SHEET NO.	TOTAL SHEETS
HAWAII	HAW.	STP-011-2(39)	2011	0	33

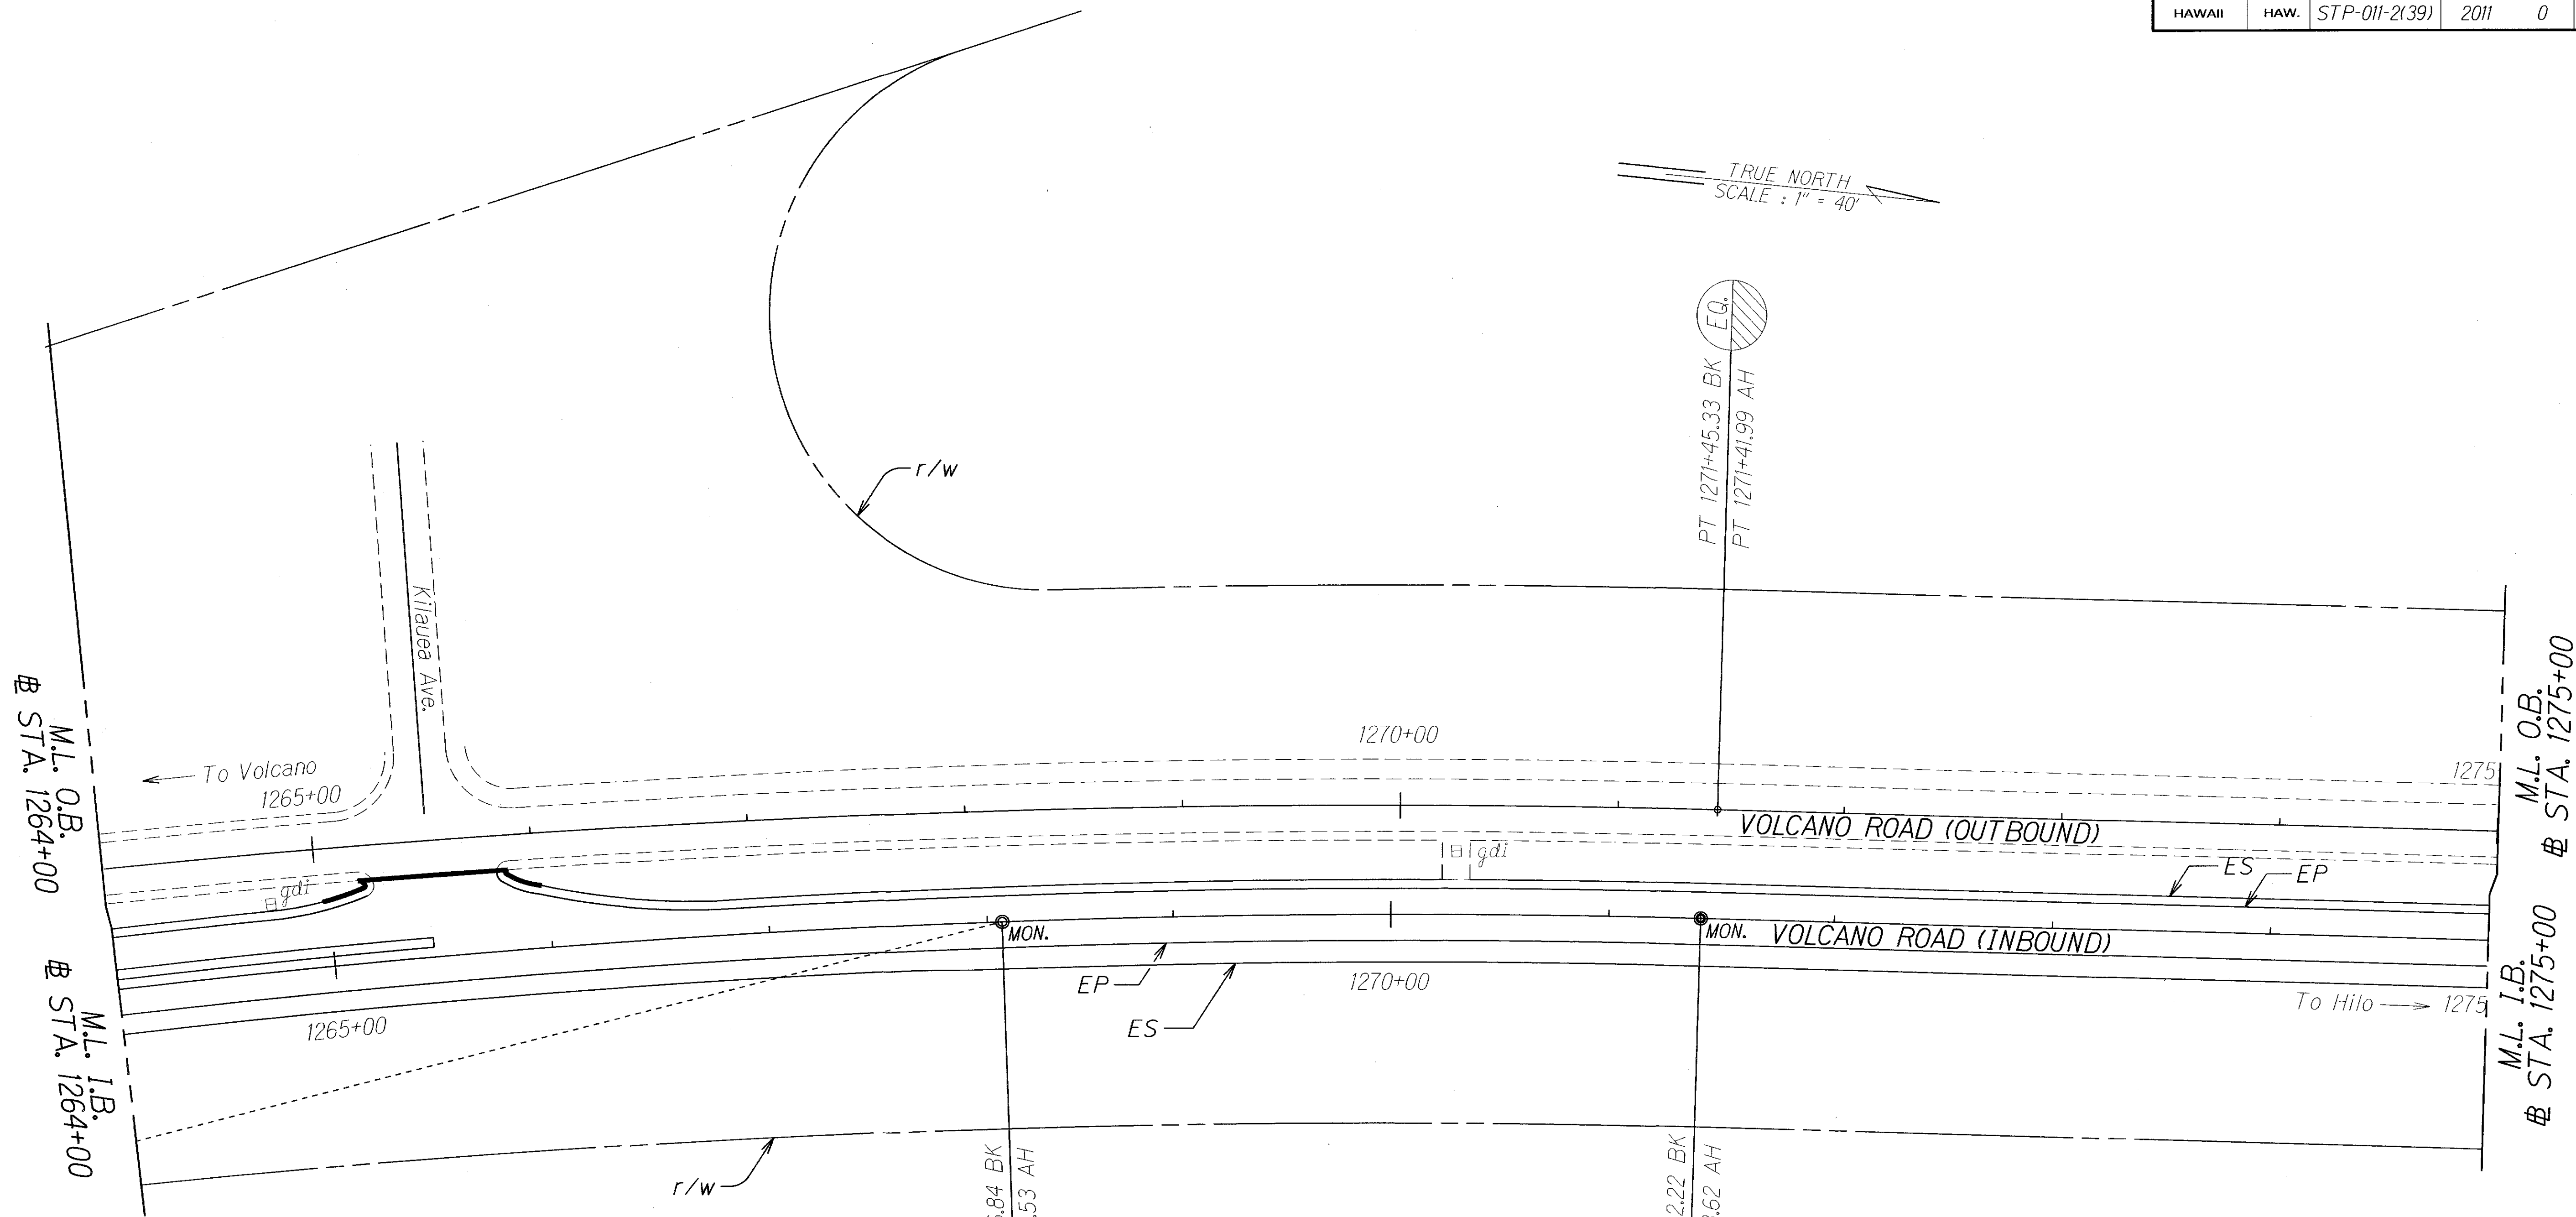

ORIGINAL PLAN	DATE
DRAWN BY	
DESIGNED BY	
CHECKED BY	
NOTED BY	
DATE	


LEGEND FOR AS-BUILT POSTINGS	
	Squiggly line for as-built deletion
	Double line for as-built deletion
Roadway	Text for as-built posting

STATE OF HAWAII DEPARTMENT OF TRANSPORTATION HIGHWAYS DIVISION	
ROADWAY PLANS	
VOLCANO ROAD	
Pavement Preventive Maintenance, 1/2 Lanes	
Keaau Bypass Road to Panaewa Bridge	
Federal-Aid Project No. STP-011-2(39)	
Scale: 1" = 40'	Date: Sept., 2010
SHEET No. 9 OF 10 SHEETS	

"AS-BUILT"

FED. ROAD DIST. NO.	STATE	FED. AID PROJ. NO.	FISCAL YEAR	SHEET NO.	TOTAL SHEETS
HAWAII	HAW.	STP-011-2(39)	2011	18	33

TRUE NORTH
SCALE : 1" = 40'

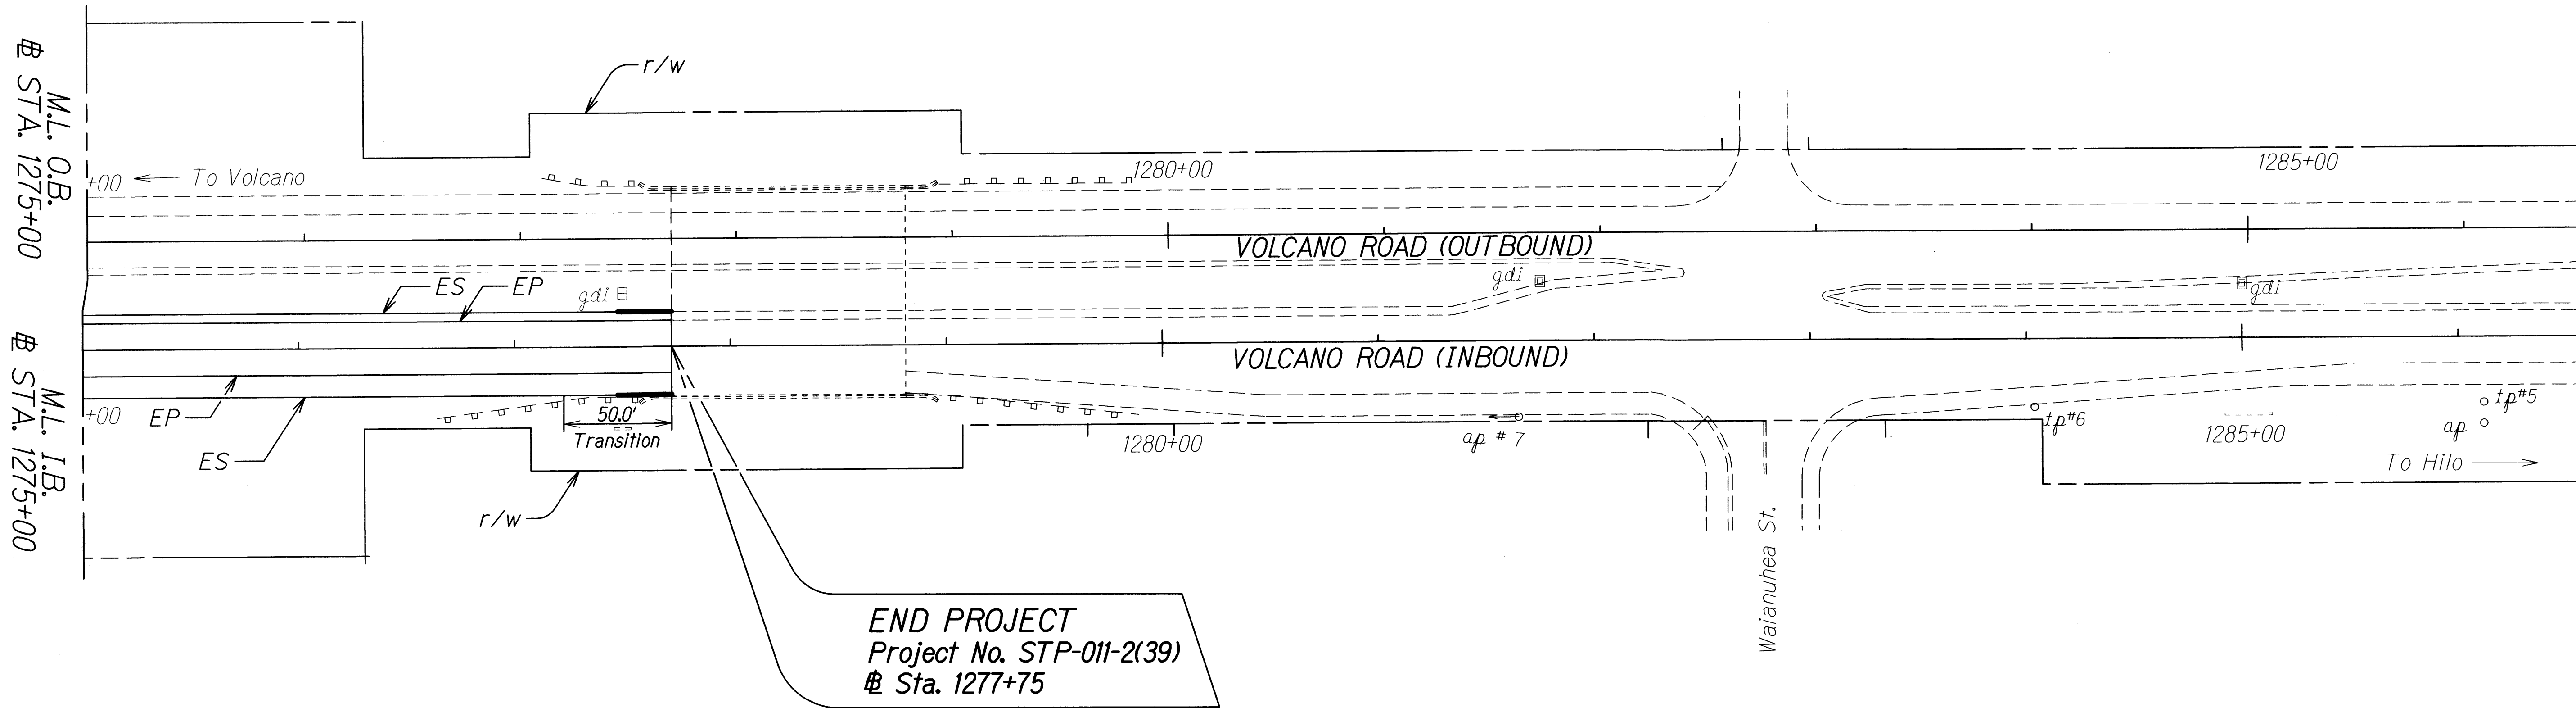

ORIGINAL PLAN	DATE
NOTE BOOK	DESIGNED BY
QUANTITIES BY	CHECKED BY
BY	

STATE OF HAWAII
DEPARTMENT OF TRANSPORTATION
HIGHWAYS DIVISION

ROADWAY PLANS

VOLCANO ROAD

Pavement Preventive Maintenance, I/B Lanes
Keaau Bypass Road to Panaewa Bridge
Federal-Aid Project No. STP-011-2(39)

Scale: 1" = 40' Date: Sept., 2010

SHEET No. 10 OF 10 SHEETS