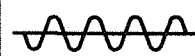
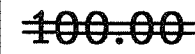


FED. ROAD DIST. NO.	STATE	PROJ. NO.	FISCAL YEAR	SHEET NO.	TOTAL SHEETS
HAWAII	HAW.	11N-01-07M	2008	17	29

RECONSTRUCTION AREA SCHEDULE				
STATION		LENGTH (L.F.)	WIDTH (L.F.)	APPROXIMATE AREA (SQ. FT.)
FROM	TO			
1126+00	1131+60	560	12	6,720
1131+60	1134+16	256	6	1,536
1167+55	1168+34	79	6	474
1177+41	1178+39	98	#	1,078
1187+91	1188+37	46	6	276
1189+52	1189+78	26	6	156
1200+51	1201+12	61	6	366
1206+68	1209+70	302	#	3,322
1225+32	1226+58	126	#	1,386
1235+44	1235+84	40	6	240
1245+75	1247+70	195	6	1,170
1245+70	1257+20	250	18	4,500
			TOTAL	12,756

MONUMENT SCHEDULE				
STATION	MONUMENT TYPE	RECONSTRUCT	RECOVER/EXPOSE AND CLEANOUT	DEPTH NOTES
1112+50.21	ST. MON.		X	unknown
1145+38.84	PC MON.		X	sleeve D=0.23
1148+15.51	PT MON.		X	sleeve D=0.25
1170+16.13	PC MON.		X	sleeve D=0.24
1174+22.80	PT MON.		X	sleeve D=0.25
1177+98.00	CL MON.	X		with cover D=0.65
1201+00	POT MON.		X	sleeve D=0.23
1224+81.00	CL MON.	X		with cover D=0.40
1228+00	POT MON.		X	sleeve D=0.27
1243+38.90	PC MON.		X	sleeve D=0.25
1251+00	PCC MON.		X	sleeve D=0.23
1256+00 (AH) 1256+00.69 (BK)	PCC MON.		X	sleeve D=0.21
1271+41.99 (AH) 1271+45.33 (BK)	PT MON.		X	sleeve D=0.25

ORIGINAL PLAN	SURVEY PLOTTED BY	DATE
NOTE BOOK	DESIGNED BY	
QUANTITIES BY	CHECKED BY	
hobbs/edg		

LEGEND FOR AS-BUILT POSTINGS	
	Squiggly line for as-built deletion
	Double line for as-built deletion
Roadway	Text for as-built posting

STATE OF HAWAII DEPARTMENT OF TRANSPORTATION HIGHWAYS DIVISION
RECONSTRUCTION AREA
MONUMENT SCHEDULES
<u>VOLCANO ROAD</u>
Pavement Preventive Maintenance, O/B Lanes Keaau Bypass Road to Panaewa Bridge Project No. 11N-01-07M
Date: May, 2008
SHEET No. 1 OF 1 SHEETS

"AS-BUILT"