


FED. ROAD DIST. NO.	STATE	PROJ. NO.	FISCAL YEAR	SHEET NO.	TOTAL SHEETS
HAWAII	HAW.	11N-01-07M	2008	7	29

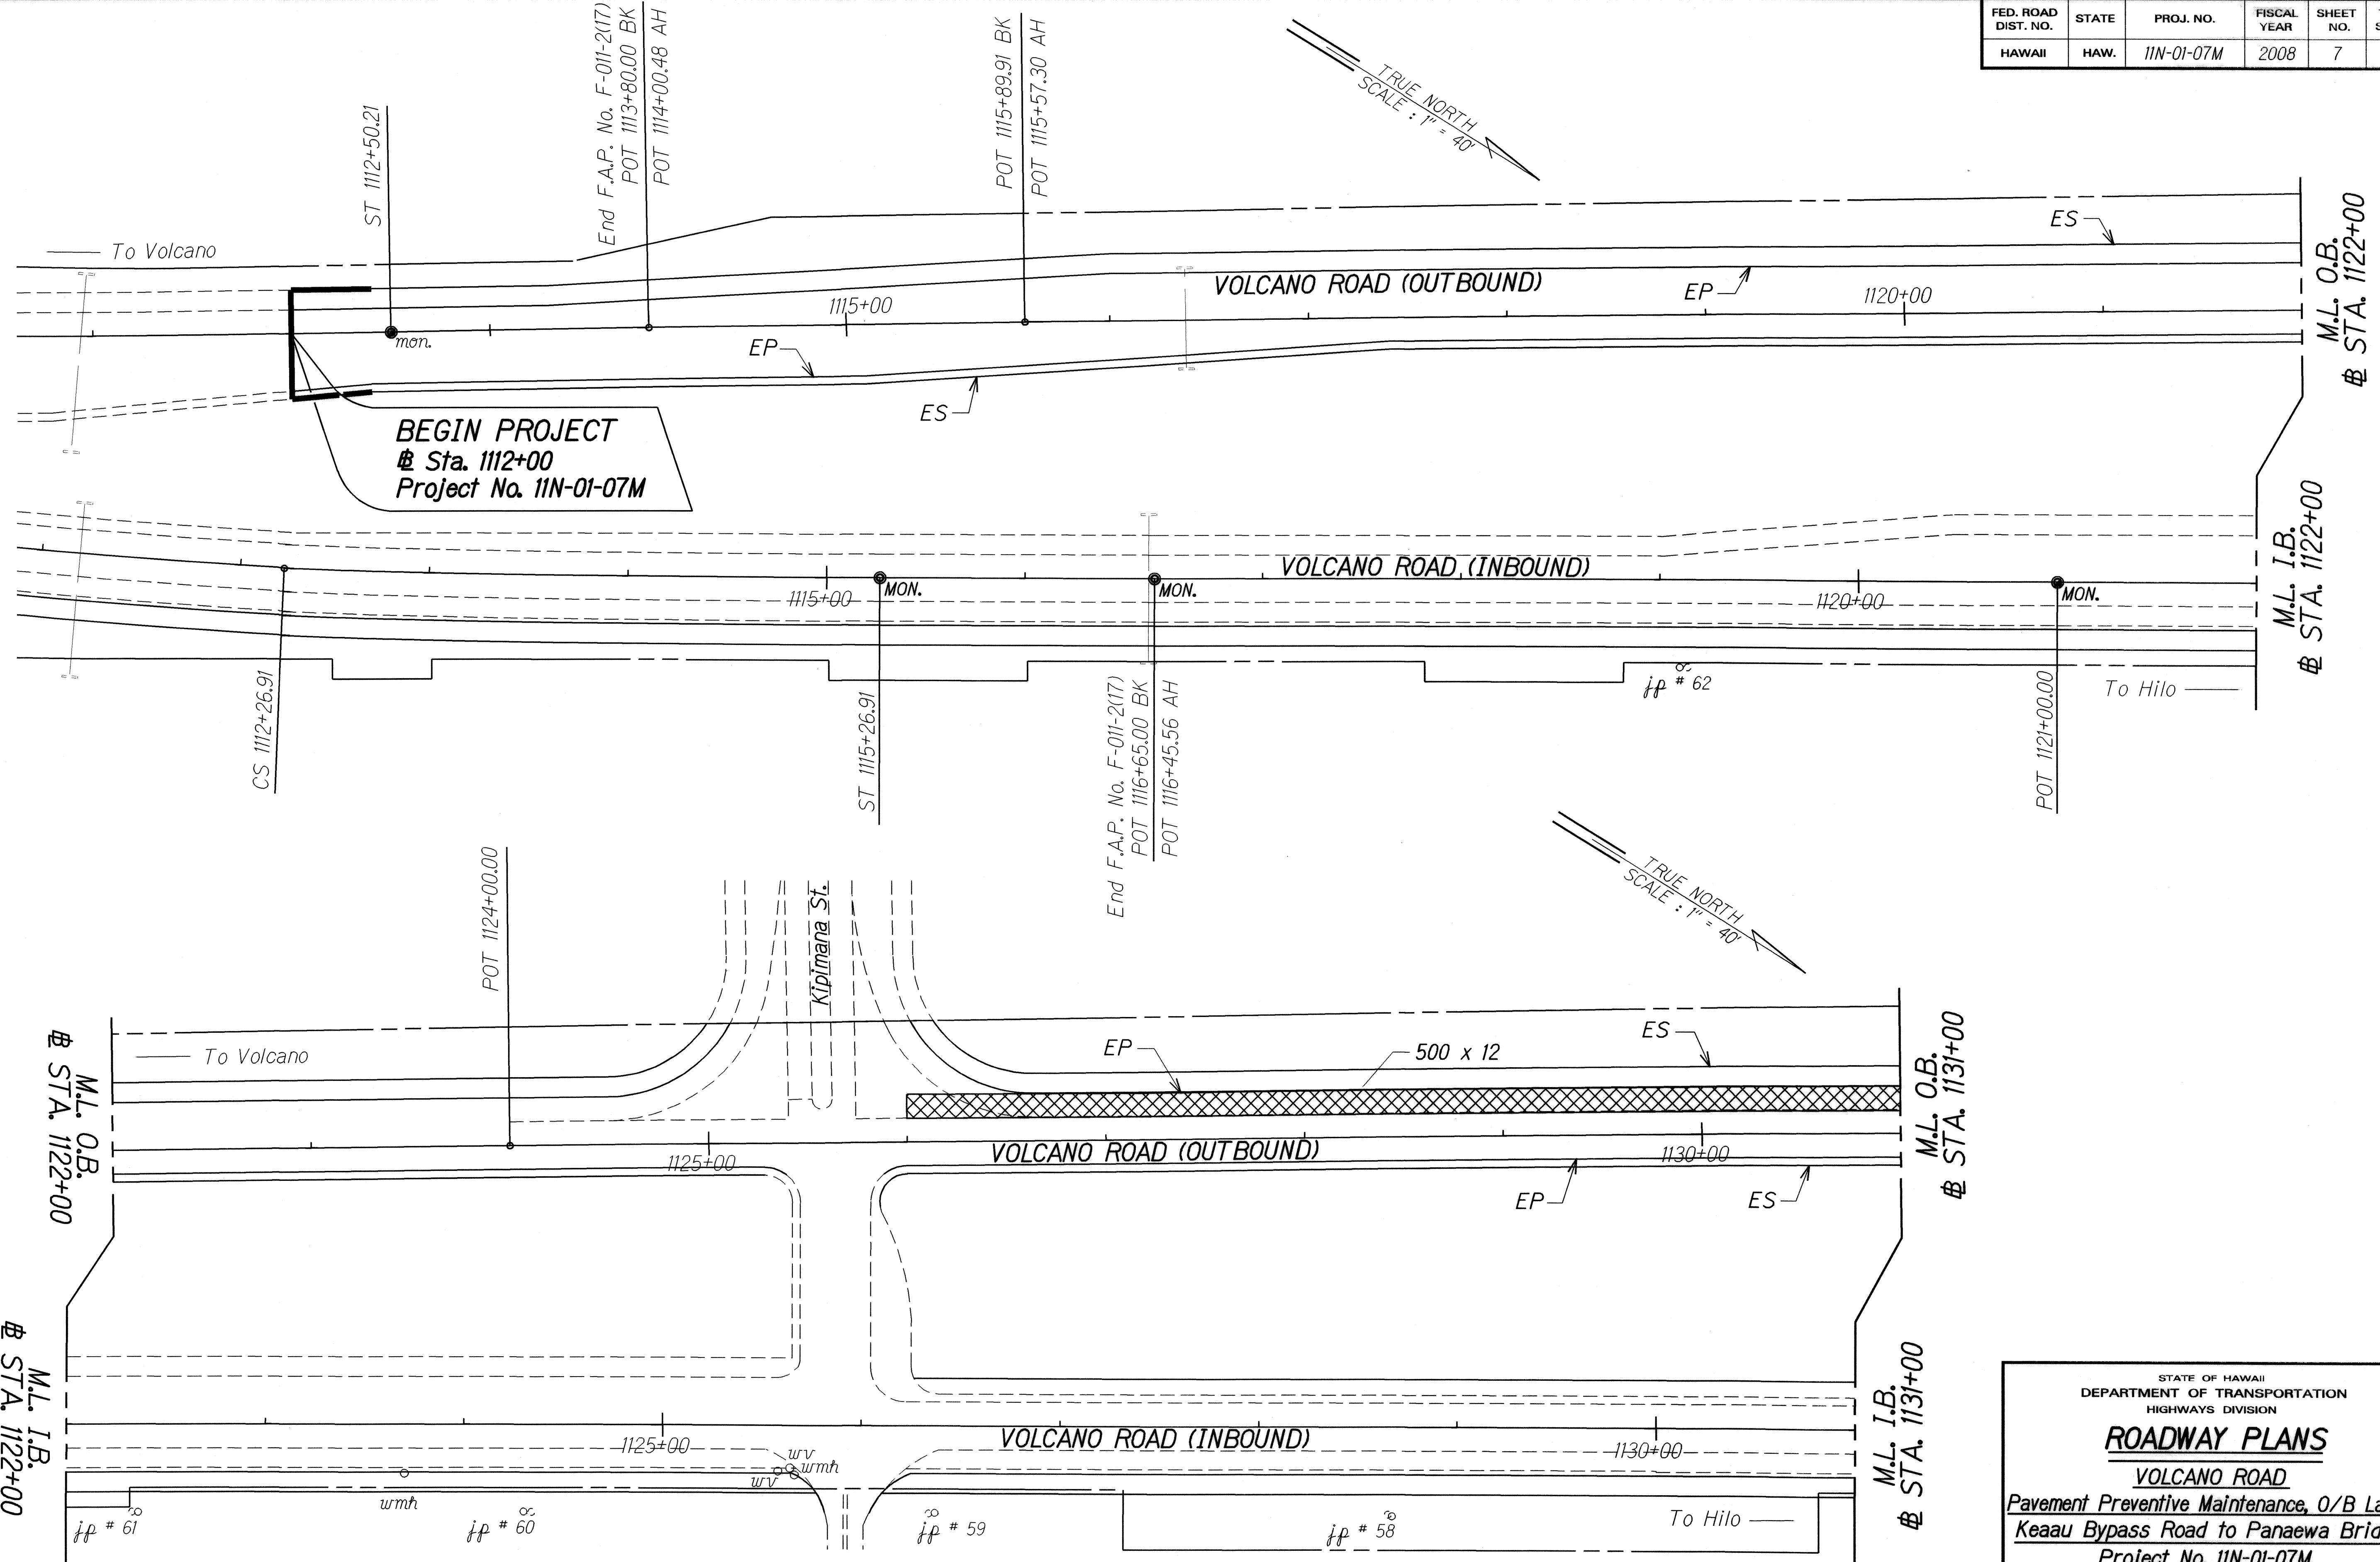

ORIGINAL PLAN	SURVEY PLOTTED BY	DATE
DRAWN BY		
TRACED BY		
CHECKED BY		
DESIGNED BY		
NOTED BY		
DATE		
BY		
CHECKED BY		
DATE		
BY		

STATE OF HAWAII
DEPARTMENT OF TRANSPORTATION
HIGHWAYS DIVISION

ROADWAY PLANS


VOLCANO ROAD

Pavement Preventive Maintenance, O/B Lanes
 Keaau Bypass Road to Panaewa Bridge
 Project No. 11N-01-07M

Scale: 1" = 40' Date: May, 2008

SHEET No. 1 OF 10 SHEETS

FED. ROAD DIST. NO.	STATE	PROJ. NO.	FISCAL YEAR	SHEET NO.	TOTAL SHEETS
HAWAII	HAW.	11N-01-07M	2008	8	29

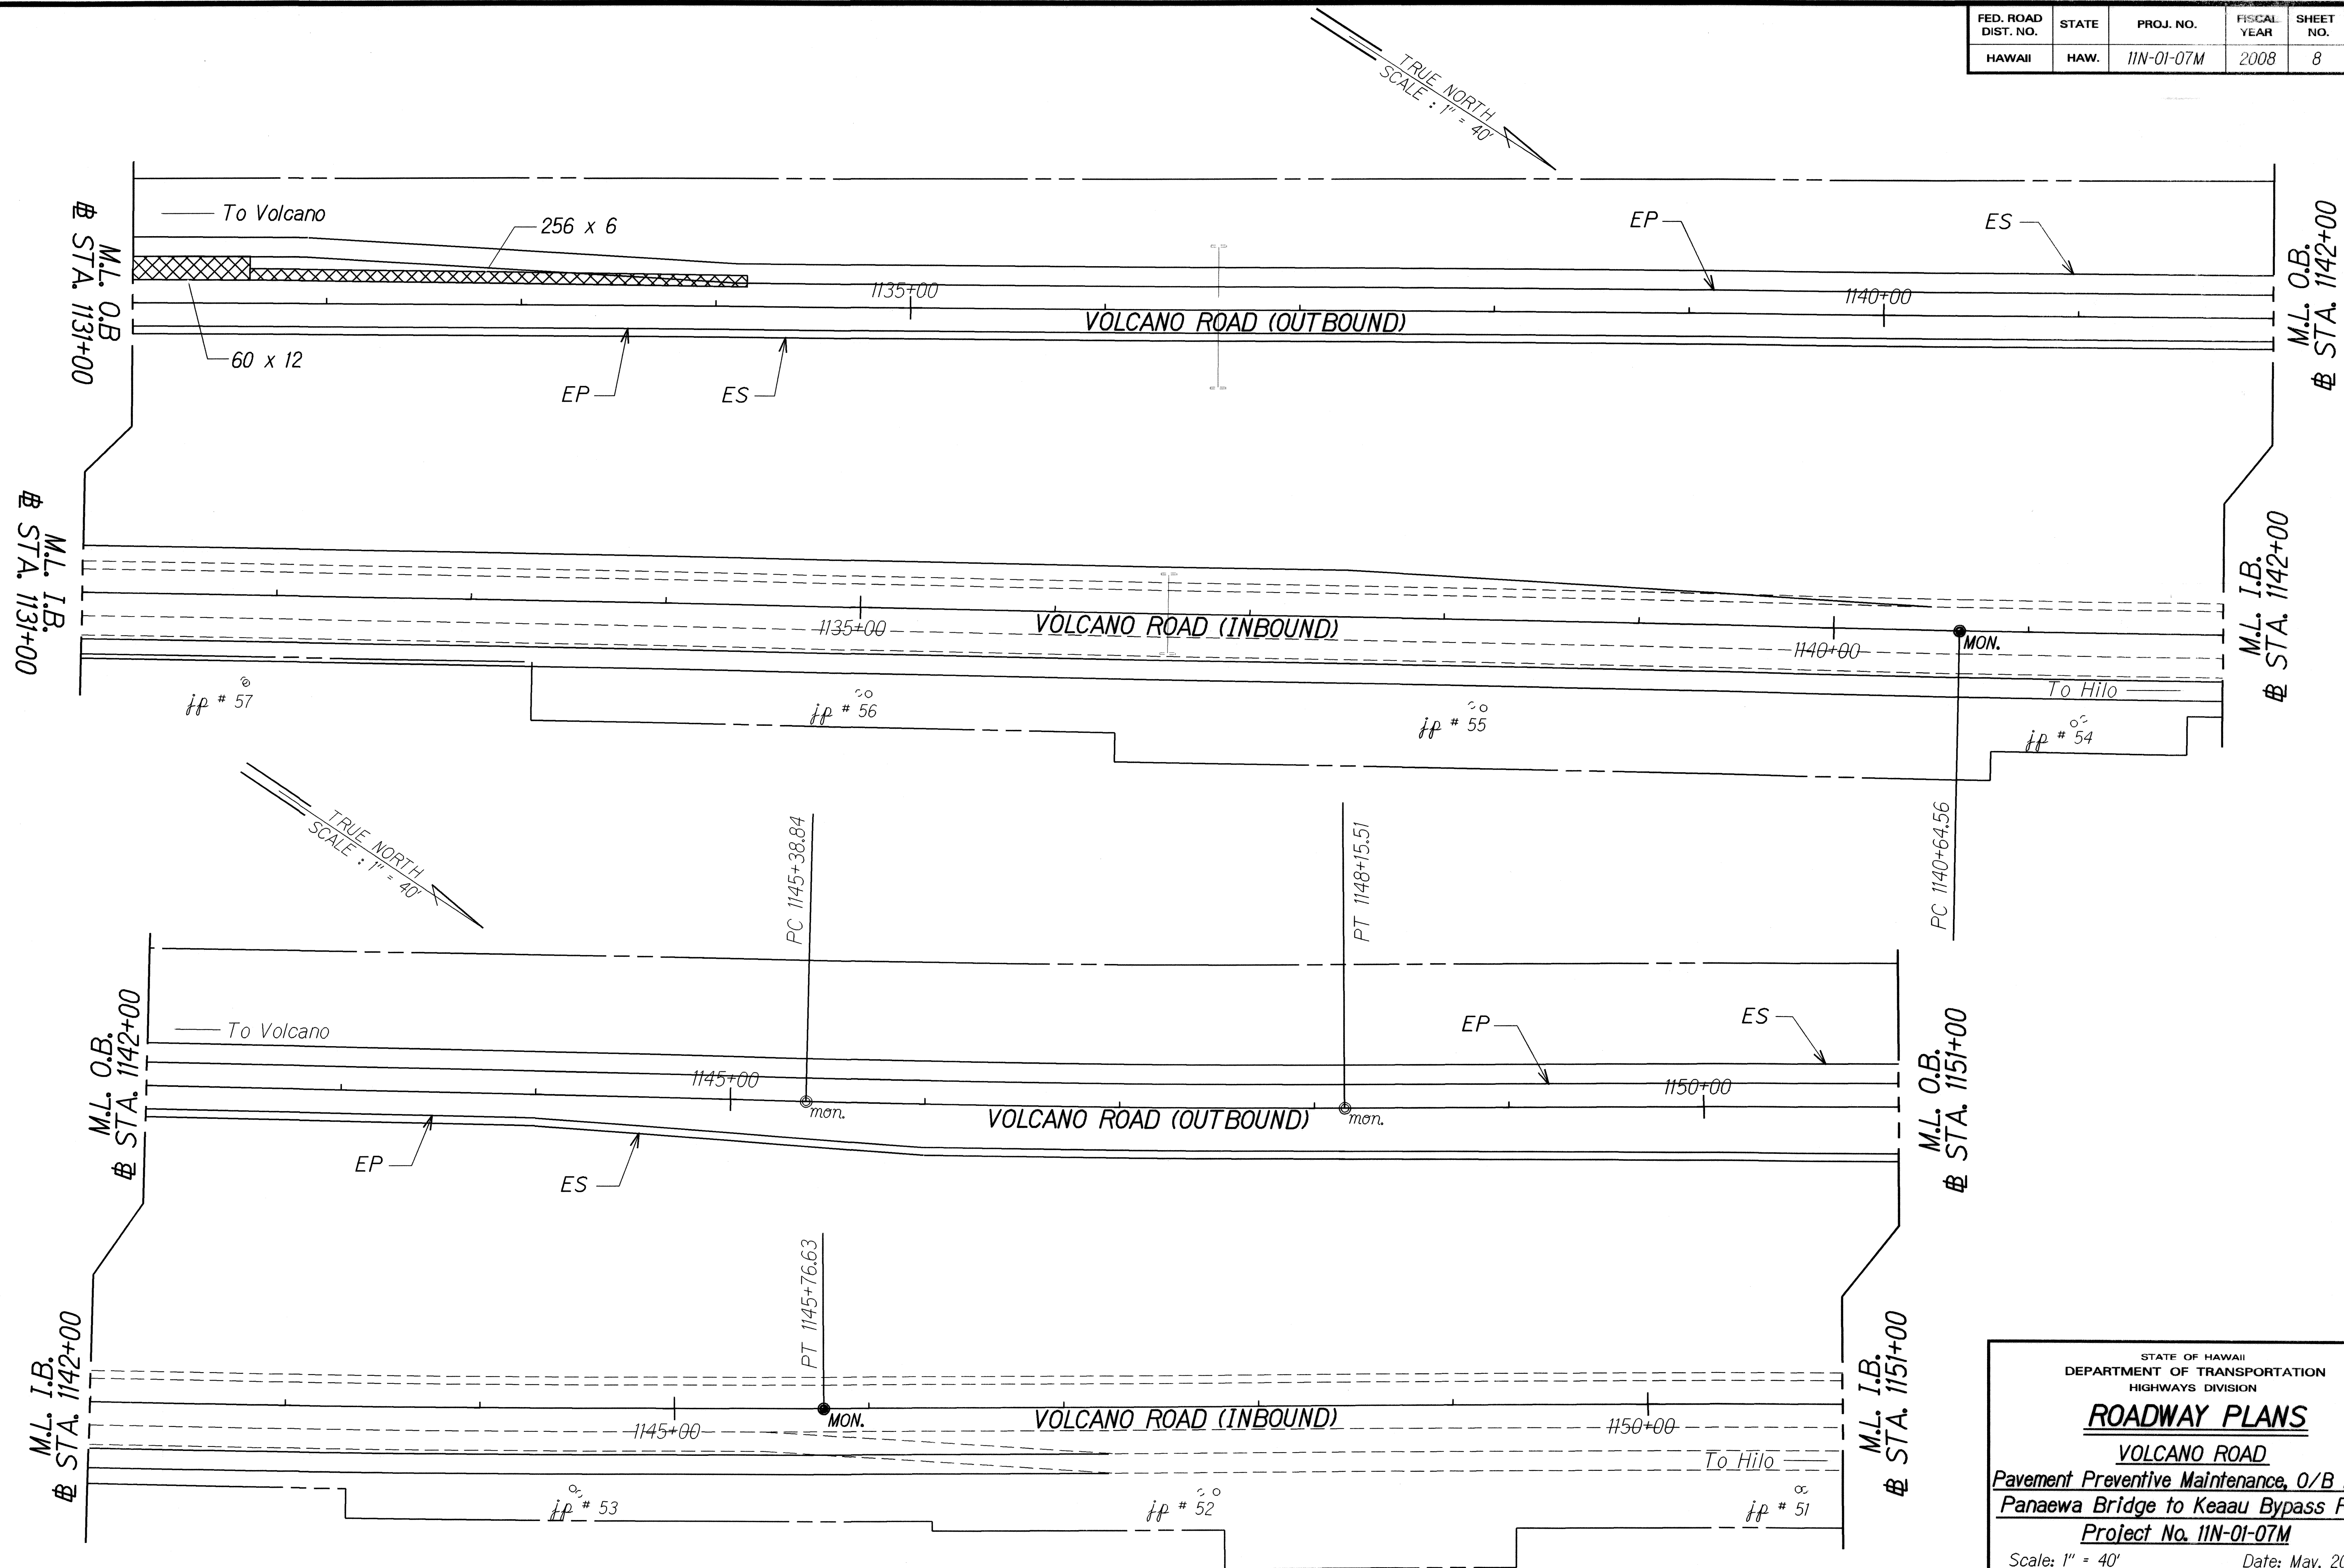

ORIGINAL SURVEY PLOTTED BY	DATE
PLAN	
DRAWN BY	
DESIGNED BY	
CHECKED BY	
NOTE BOOK	
DESIGNED BY	
CHECKED BY	
DATE	

STATE OF HAWAII
DEPARTMENT OF TRANSPORTATION
HIGHWAYS DIVISION

ROADWAY PLANS


VOLCANO ROAD

Pavement Preventive Maintenance, O/B Lanes
Panaewa Bridge to Keaau Bypass Road
Project No. 11N-01-07M

Scale: 1" = 40' Date: May, 2008

SHEET No. 2 OF 10 SHEETS

FED. ROAD DIST. NO.	STATE	PROJ. NO.	FISCAL YEAR	SHEET NO.	TOTAL SHEETS
HAWAII	HAW.	11N-01-07M	2008	9	29

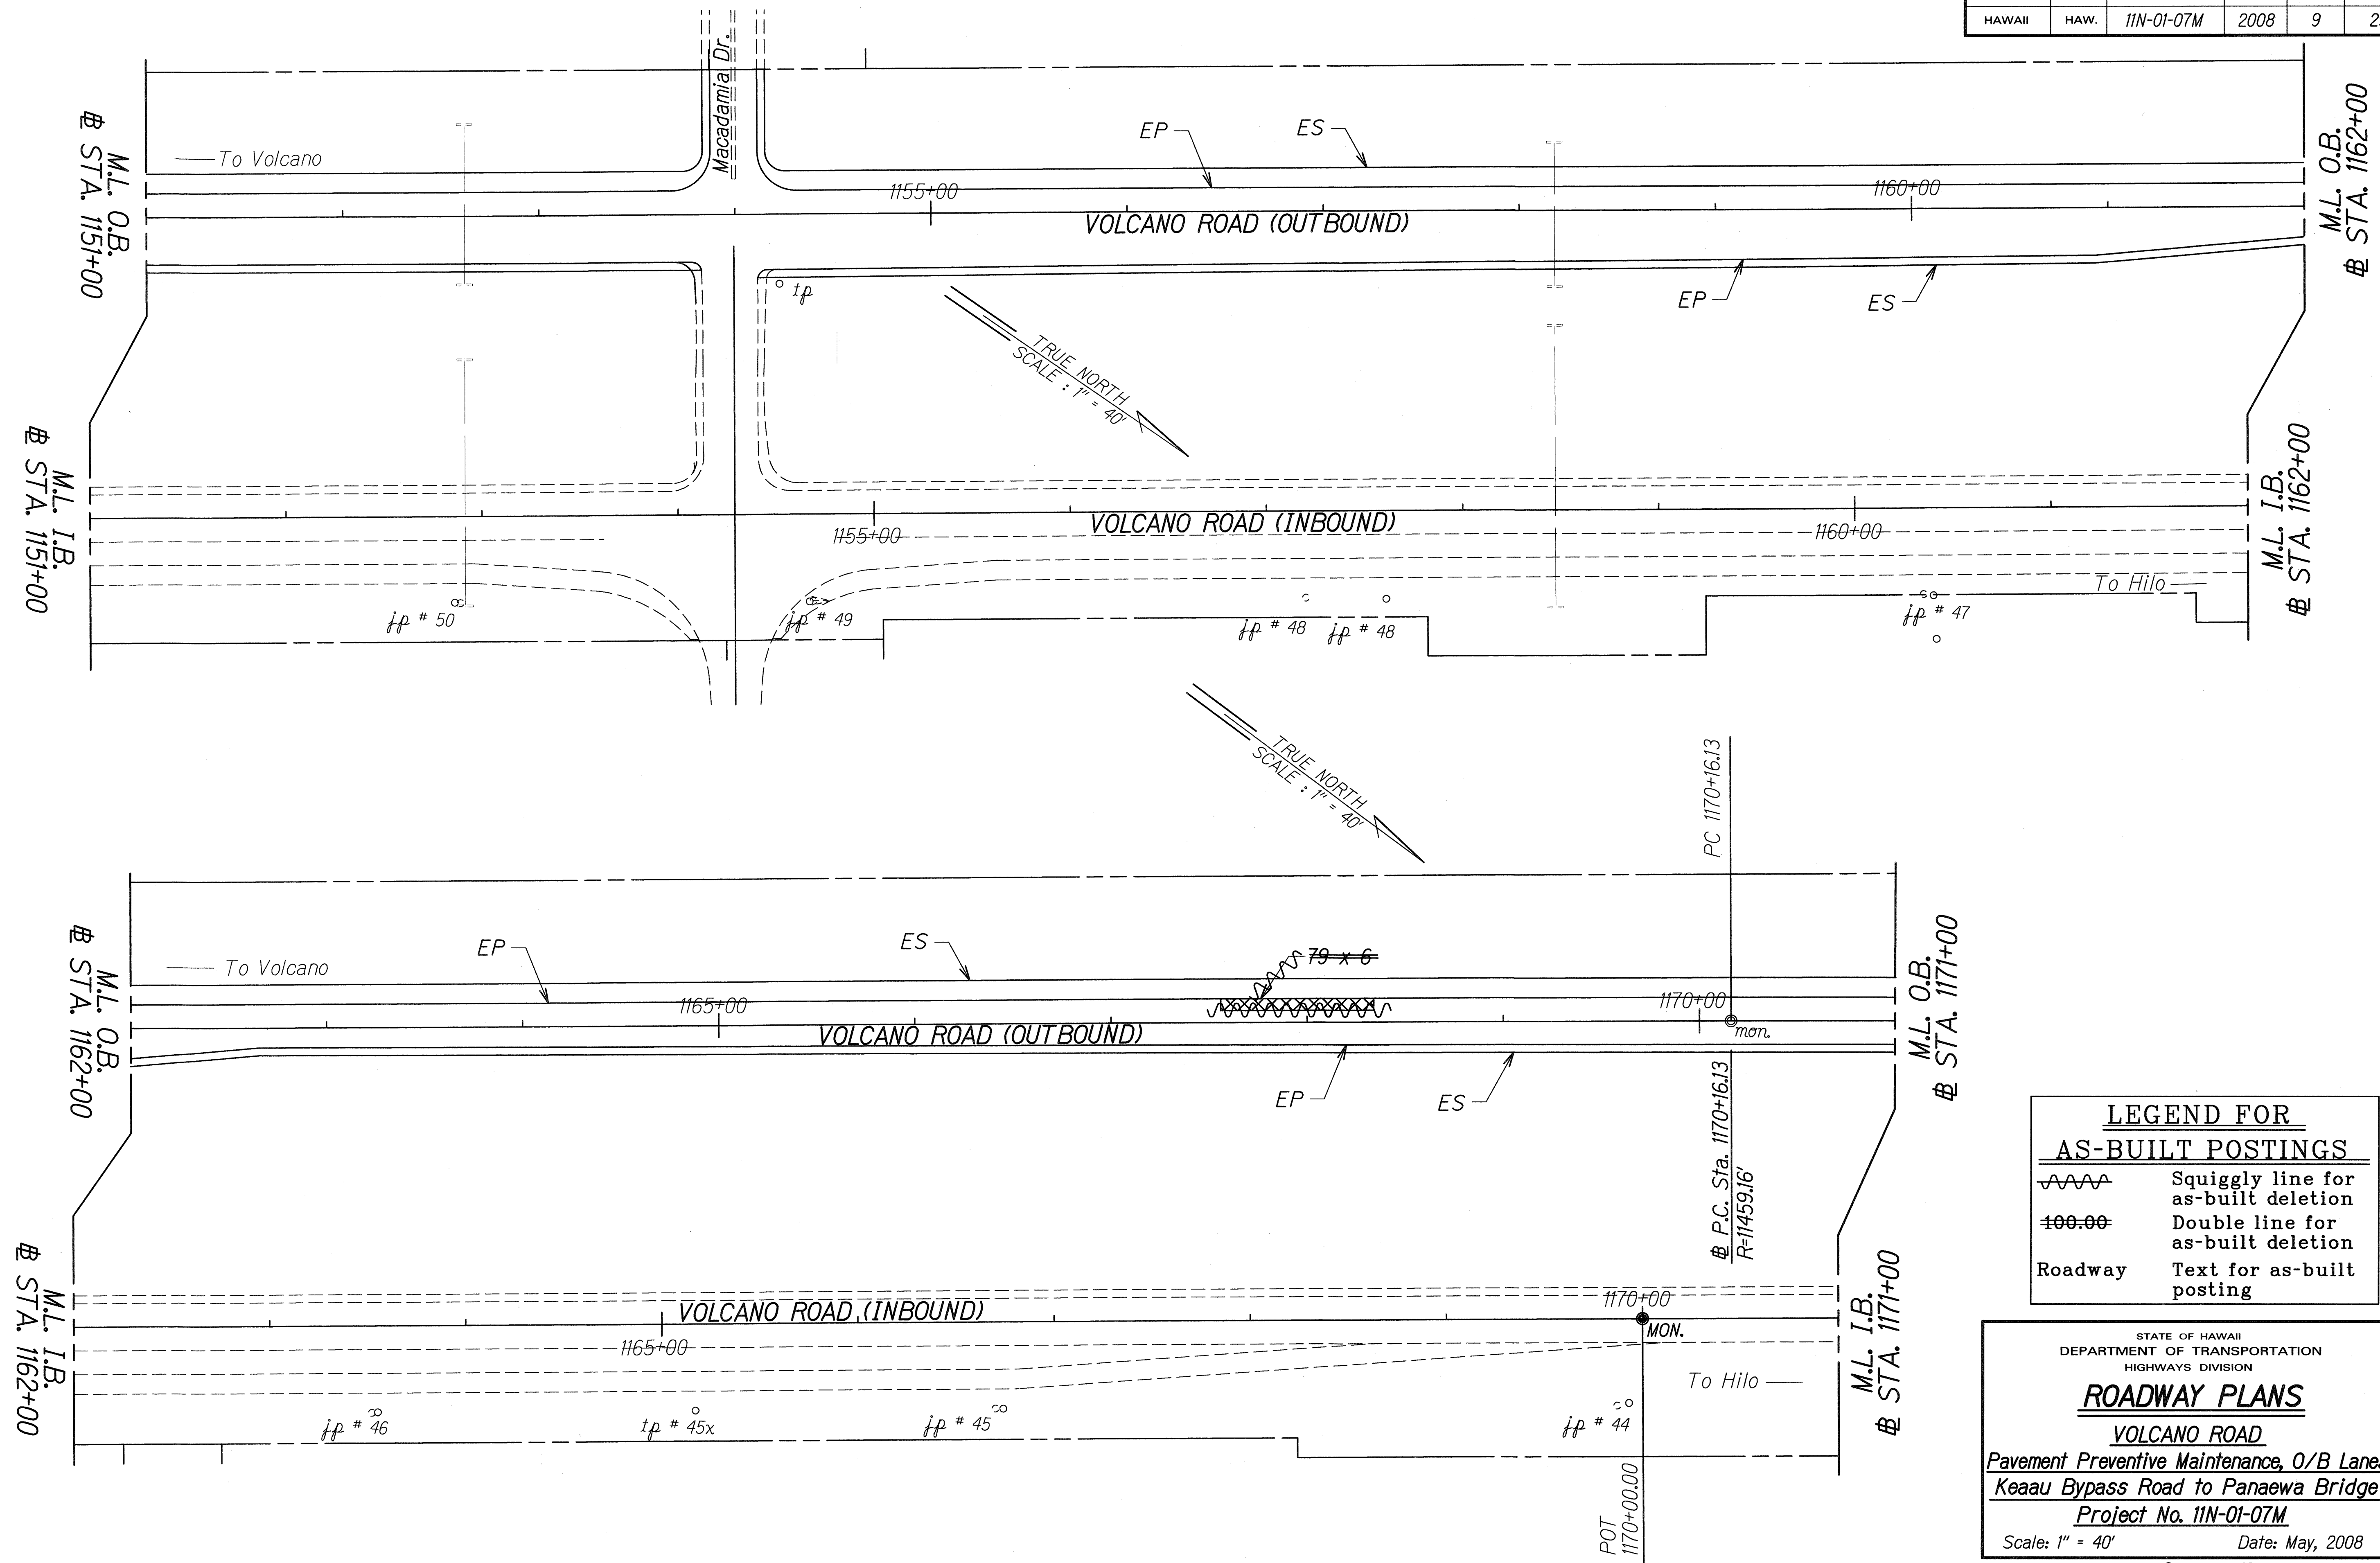


LEGEND FOR AS-BUILT POSTINGS	
	Squiggly line for as-built deletion
	Double line for as-built deletion
Roadway	Text for as-built posting

STATE OF HAWAII
DEPARTMENT OF TRANSPORTATION
HIGHWAYS DIVISION

ROADWAY PLANS
VOLCANO ROAD
Pavement Preventive Maintenance, O/B Lanes
Keaau Bypass Road to Panaewa Bridge
Project No. 11N-01-07M
Scale: 1" = 40'
Date: May, 2008

ORIGINAL PLAN	SURVEY PLOTTED BY	DATE
NOTE BOOK	DRAWN BY	
DESIGNED BY	TRACED BY	
CHECKED BY	DESIGNED BY	
APPROVED BY	DESIGNED BY	

FED. ROAD DIST. NO.	STATE	PROJ. NO.	FISCAL YEAR	SHEET NO.	TOTAL SHEETS
HAWAII	HAW.	11N-01-07M	2008	10	29

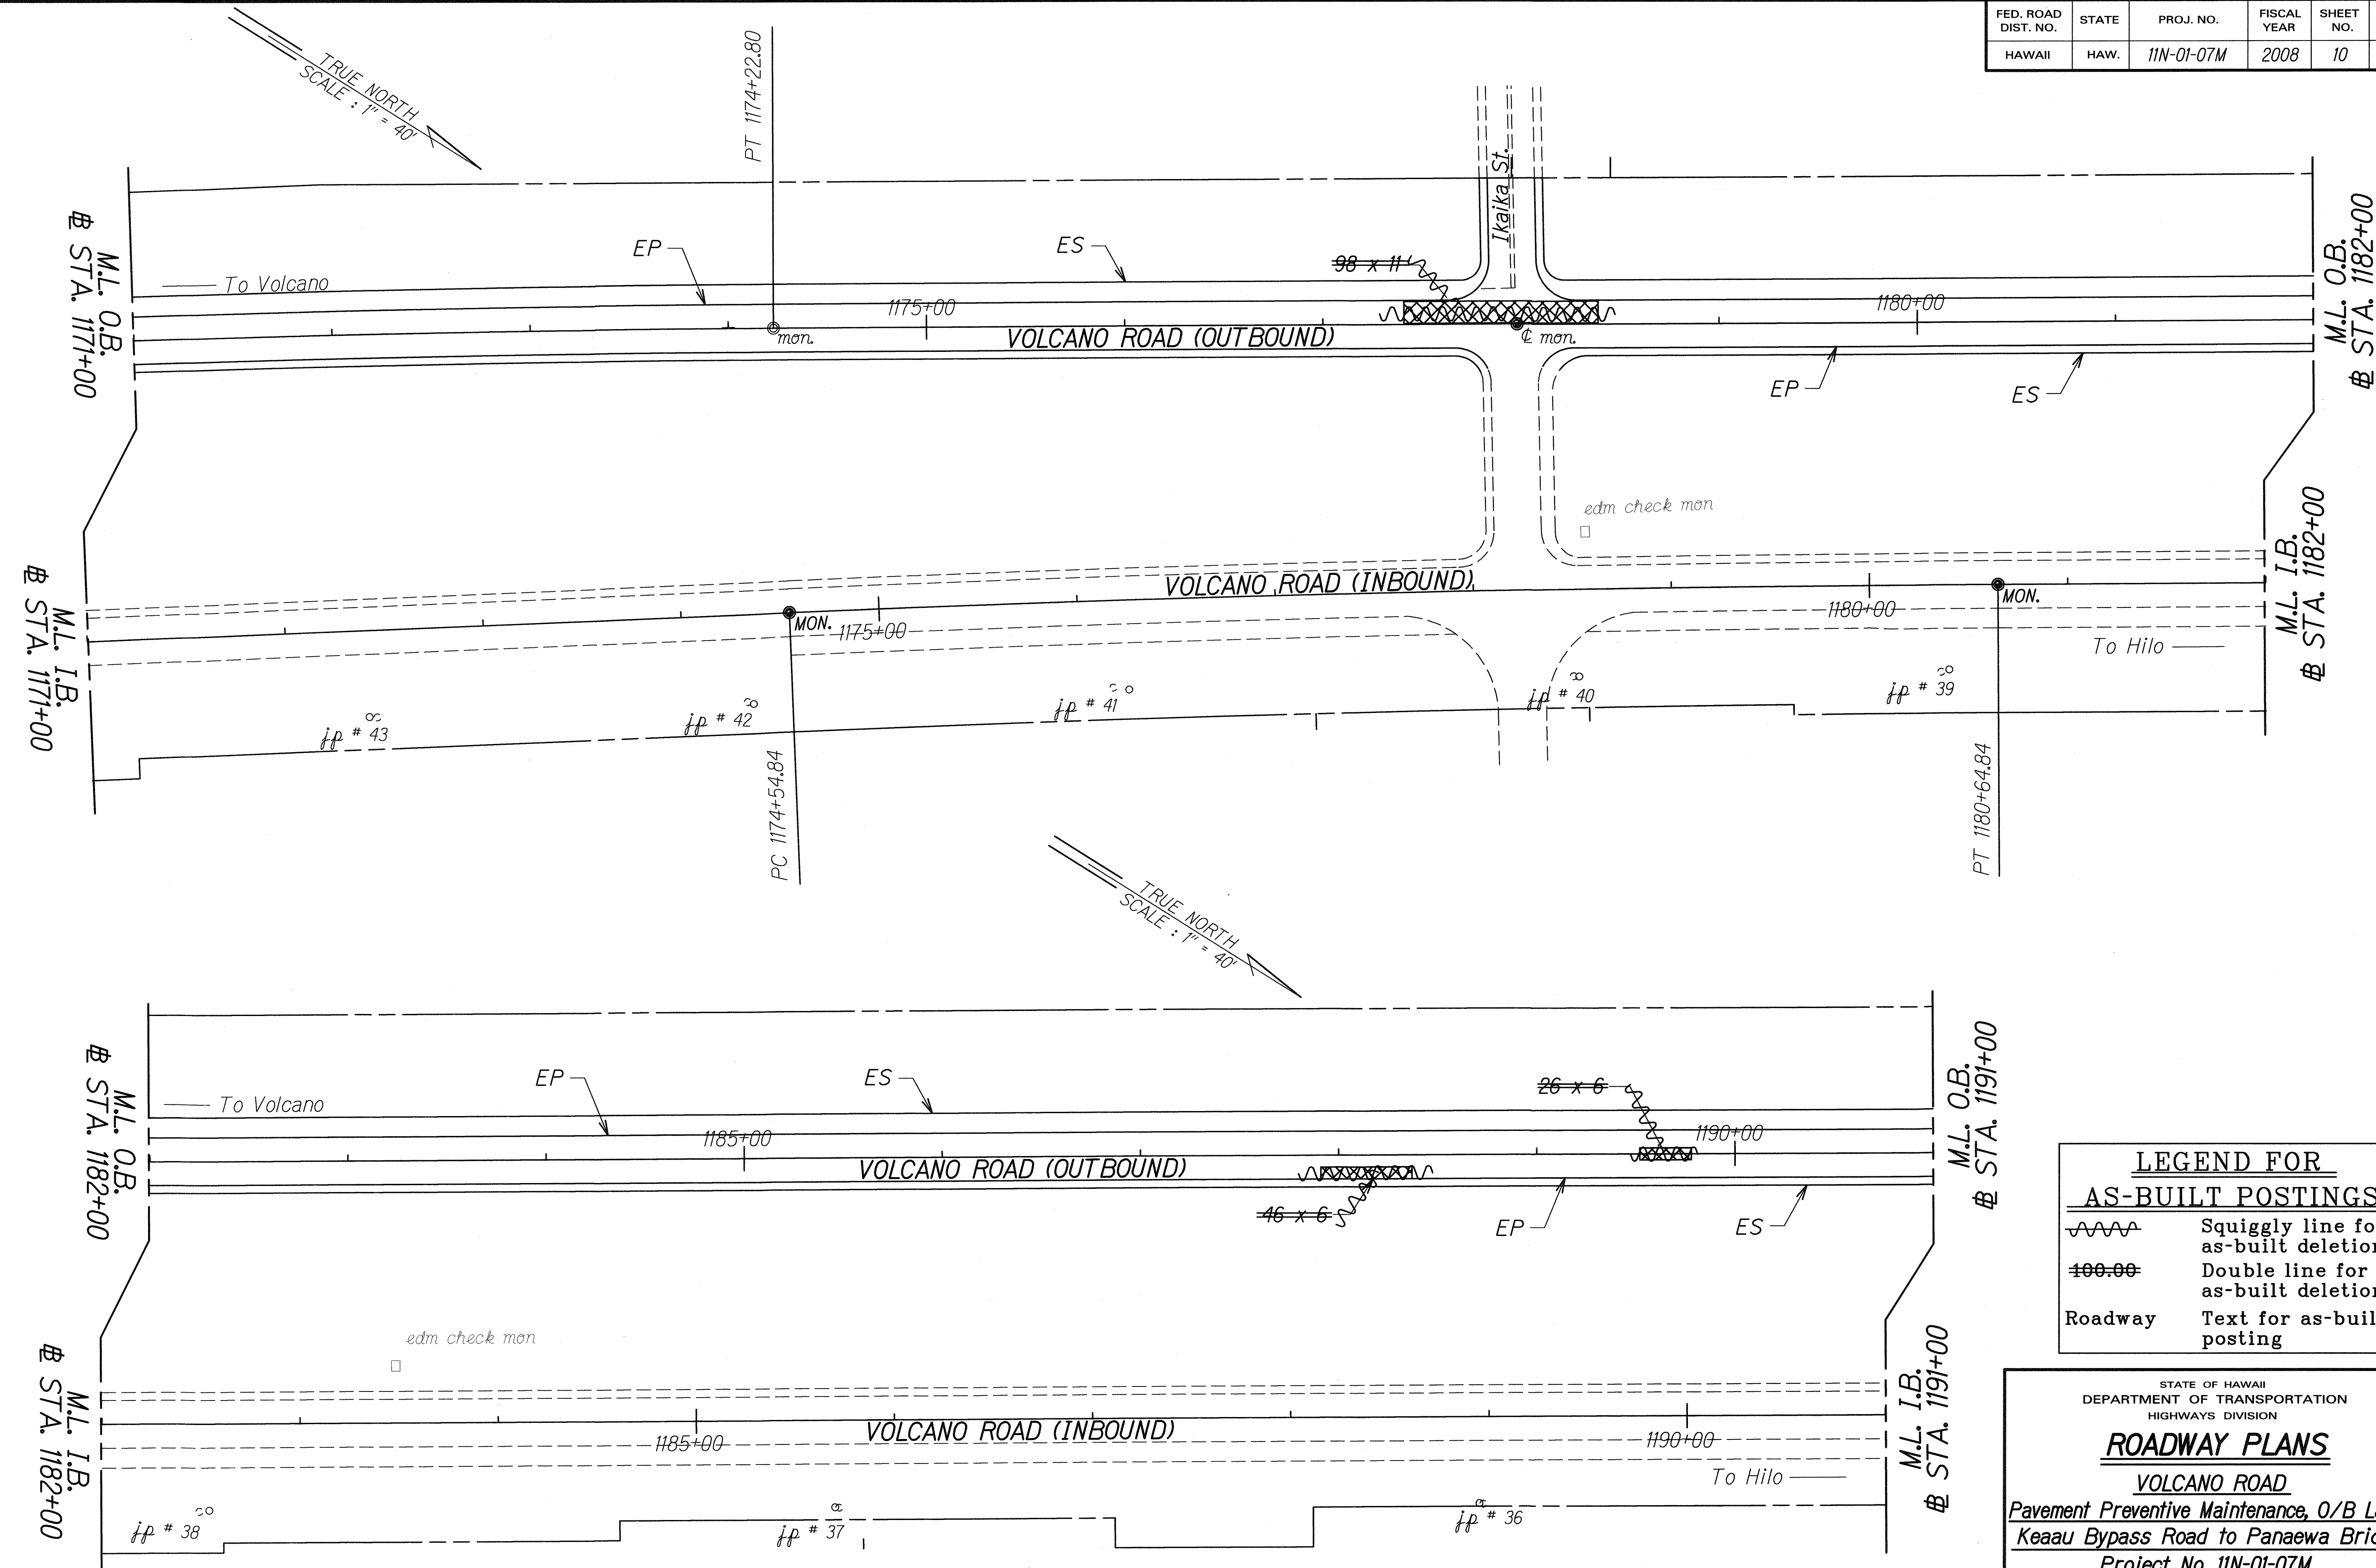

ORIGINAL PLAN	DATE
DESIGNED BY	
CHECKED BY	
NOTED BY	
TRACED BY	
DESIGNED BY	
CHECKED BY	
NOTED BY	
TRACED BY	


LEGEND FOR AS-BUILT POSTINGS	
	Squiggly line for as-built deletion
	Double line for as-built deletion
Roadway	Text for as-built posting

STATE OF HAWAII
DEPARTMENT OF TRANSPORTATION
HIGHWAYS DIVISION

ROADWAY PLANS
VOLCANO ROAD
Pavement Preventive Maintenance, O/B Lanes
Keaau Bypass Road to Panaewa Bridge
Project No. 11N-01-07M
Scale: 1" = 40' Date: May, 2008

"AS-BUILT"

FED. ROAD DIST. NO.	STATE	PROJ. NO.	FISCAL YEAR	SHEET NO.	TOTAL SHEETS
HAWAII	HAW.	11N-01-07M	2008	11	29

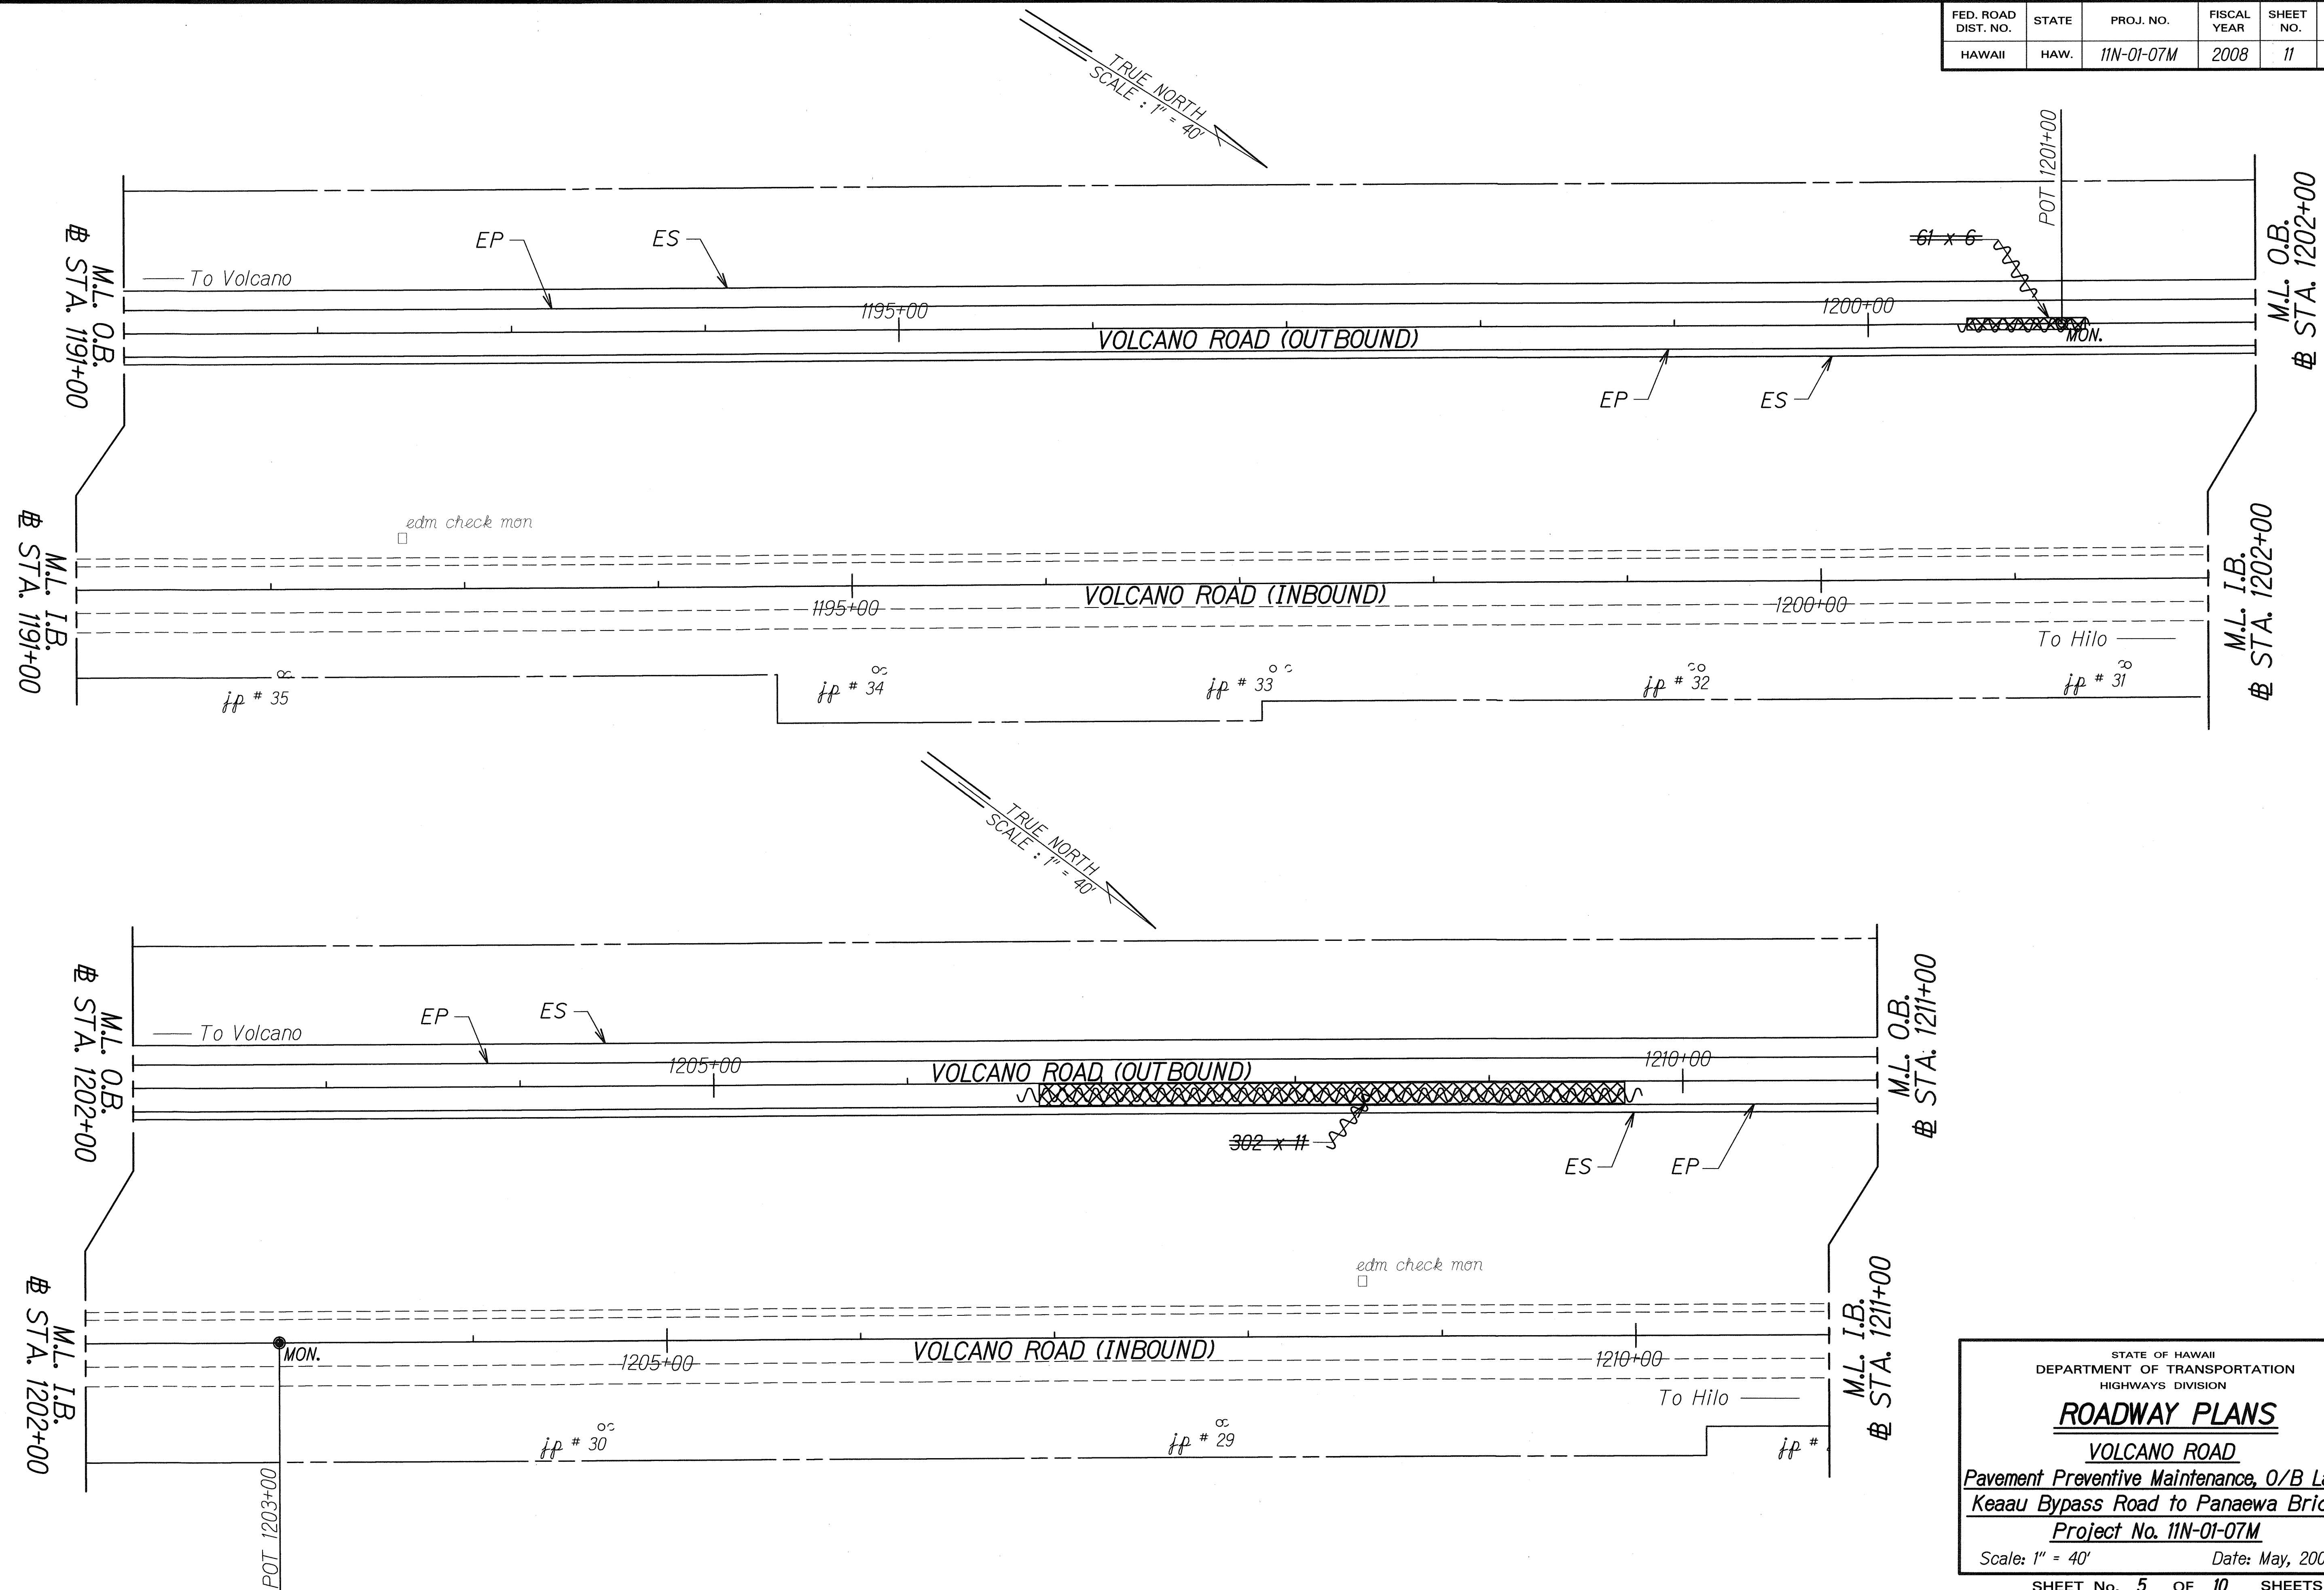


ORIGINAL PLAN	DATE
DESIGNED BY	
DRAWN BY	
CHECKED BY	
NOTED BY	
TRACED BY	
REVIEWED BY	

STATE OF HAWAII
DEPARTMENT OF TRANSPORTATION
HIGHWAYS DIVISION

ROADWAY PLANS
VOLCANO ROAD
Pavement Preventive Maintenance, O/B Lanes
Keaau Bypass Road to Panaewa Bridge
Project No. 11N-01-07M
Scale: 1" = 40' Date: May, 2008

"AS-BUILT"

FED. ROAD DIST. NO.	STATE	PROJ. NO.	FISCAL YEAR	SHEET NO.	TOTAL SHEETS
HAWAII	HAW.	11N-01-07M	2008	ADD. 12	29

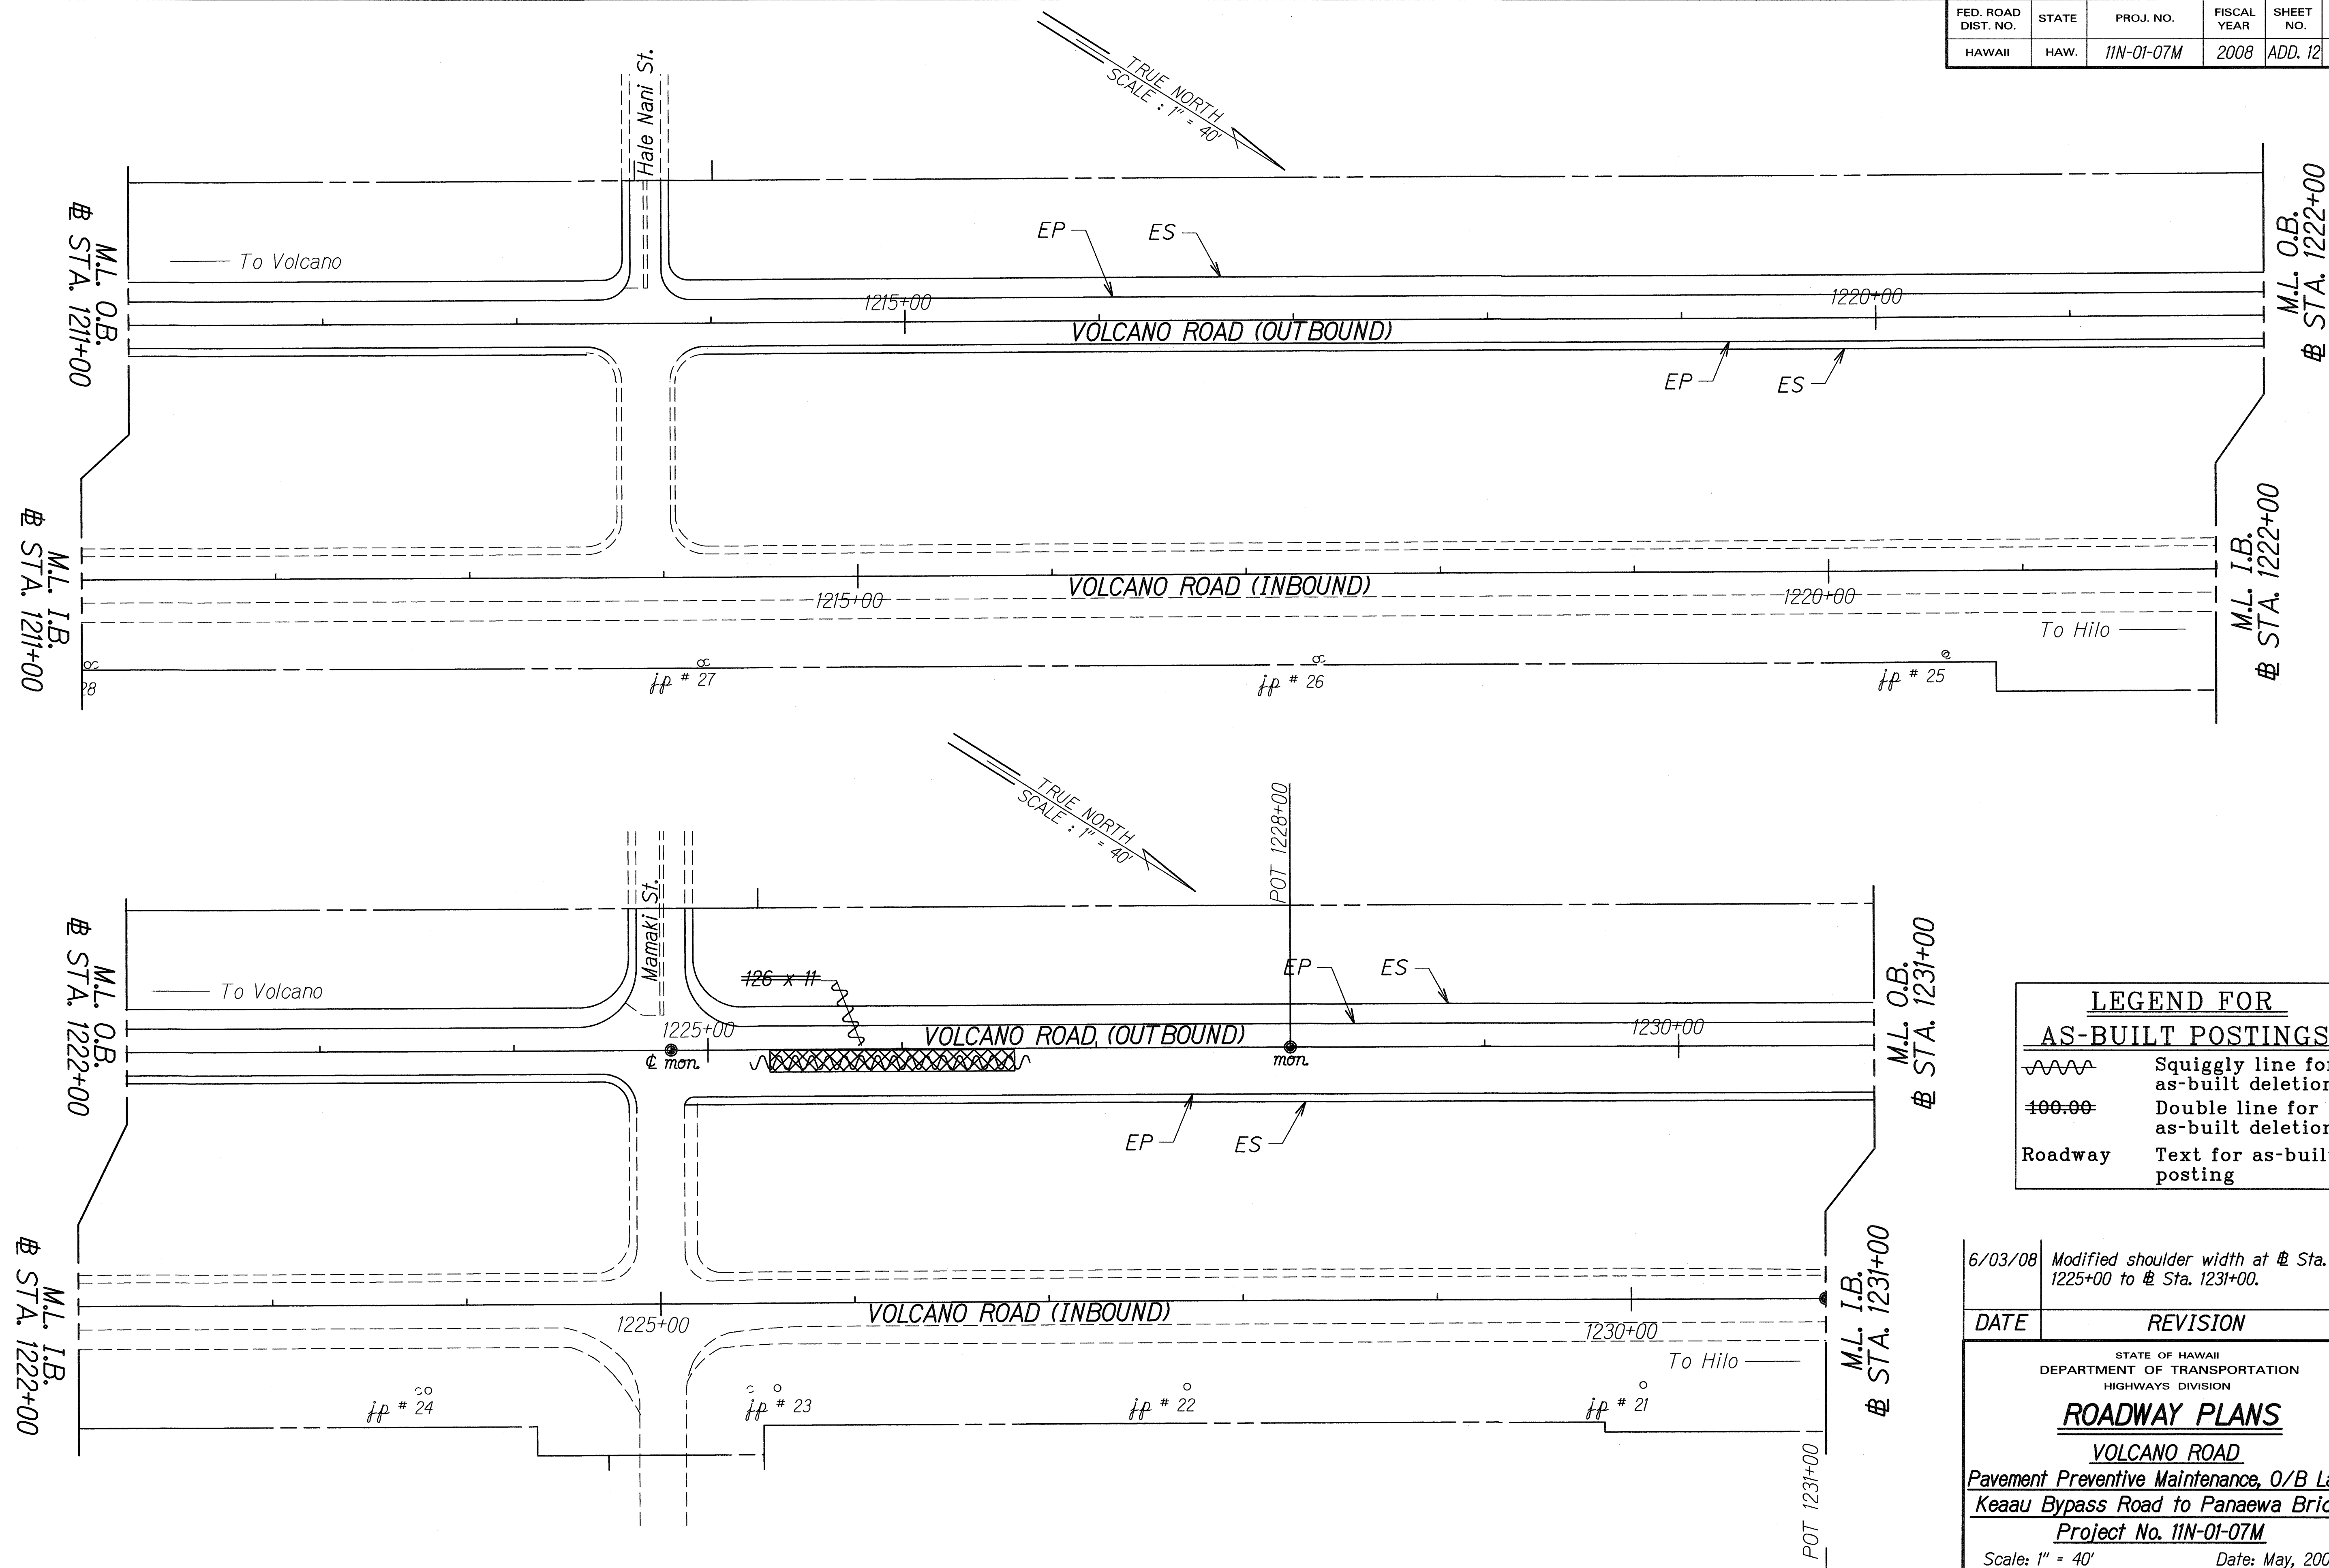

LEGEND FOR AS-BUILT POSTINGS	
	Squiggly line for as-built deletion
	Double line for as-built deletion
Roadway	Text for as-built posting

6/03/08	Modified shoulder width at Sta. 1225+00 to Sta. 1231+00.
DATE	REVISION
STATE OF HAWAII DEPARTMENT OF TRANSPORTATION HIGHWAYS DIVISION	
ROADWAY PLANS	
VOLCANO ROAD	
Pavement Preventive Maintenance, O/B Lanes	
Keaau Bypass Road to Panaewa Bridge	
Project No. 11N-01-07M	
Scale: 1" = 40'	Date: May, 2008


SHEET No. 6 OF 10 SHEETS

ORIGINAL PLAN	DATE
DESIGNED BY	
DRAWN BY	
CHECKED BY	
NOTED BY	
QUANTITIES BY	
REVISIONS	

"AS-BUILT"

ADD. 12

FED. ROAD DIST. NO.	STATE	PROJ. NO.	FISCAL YEAR	SHEET NO.	TOTAL SHEETS
HAWAII	HAW.	11N-01-07M	2007	ADD. 13	29

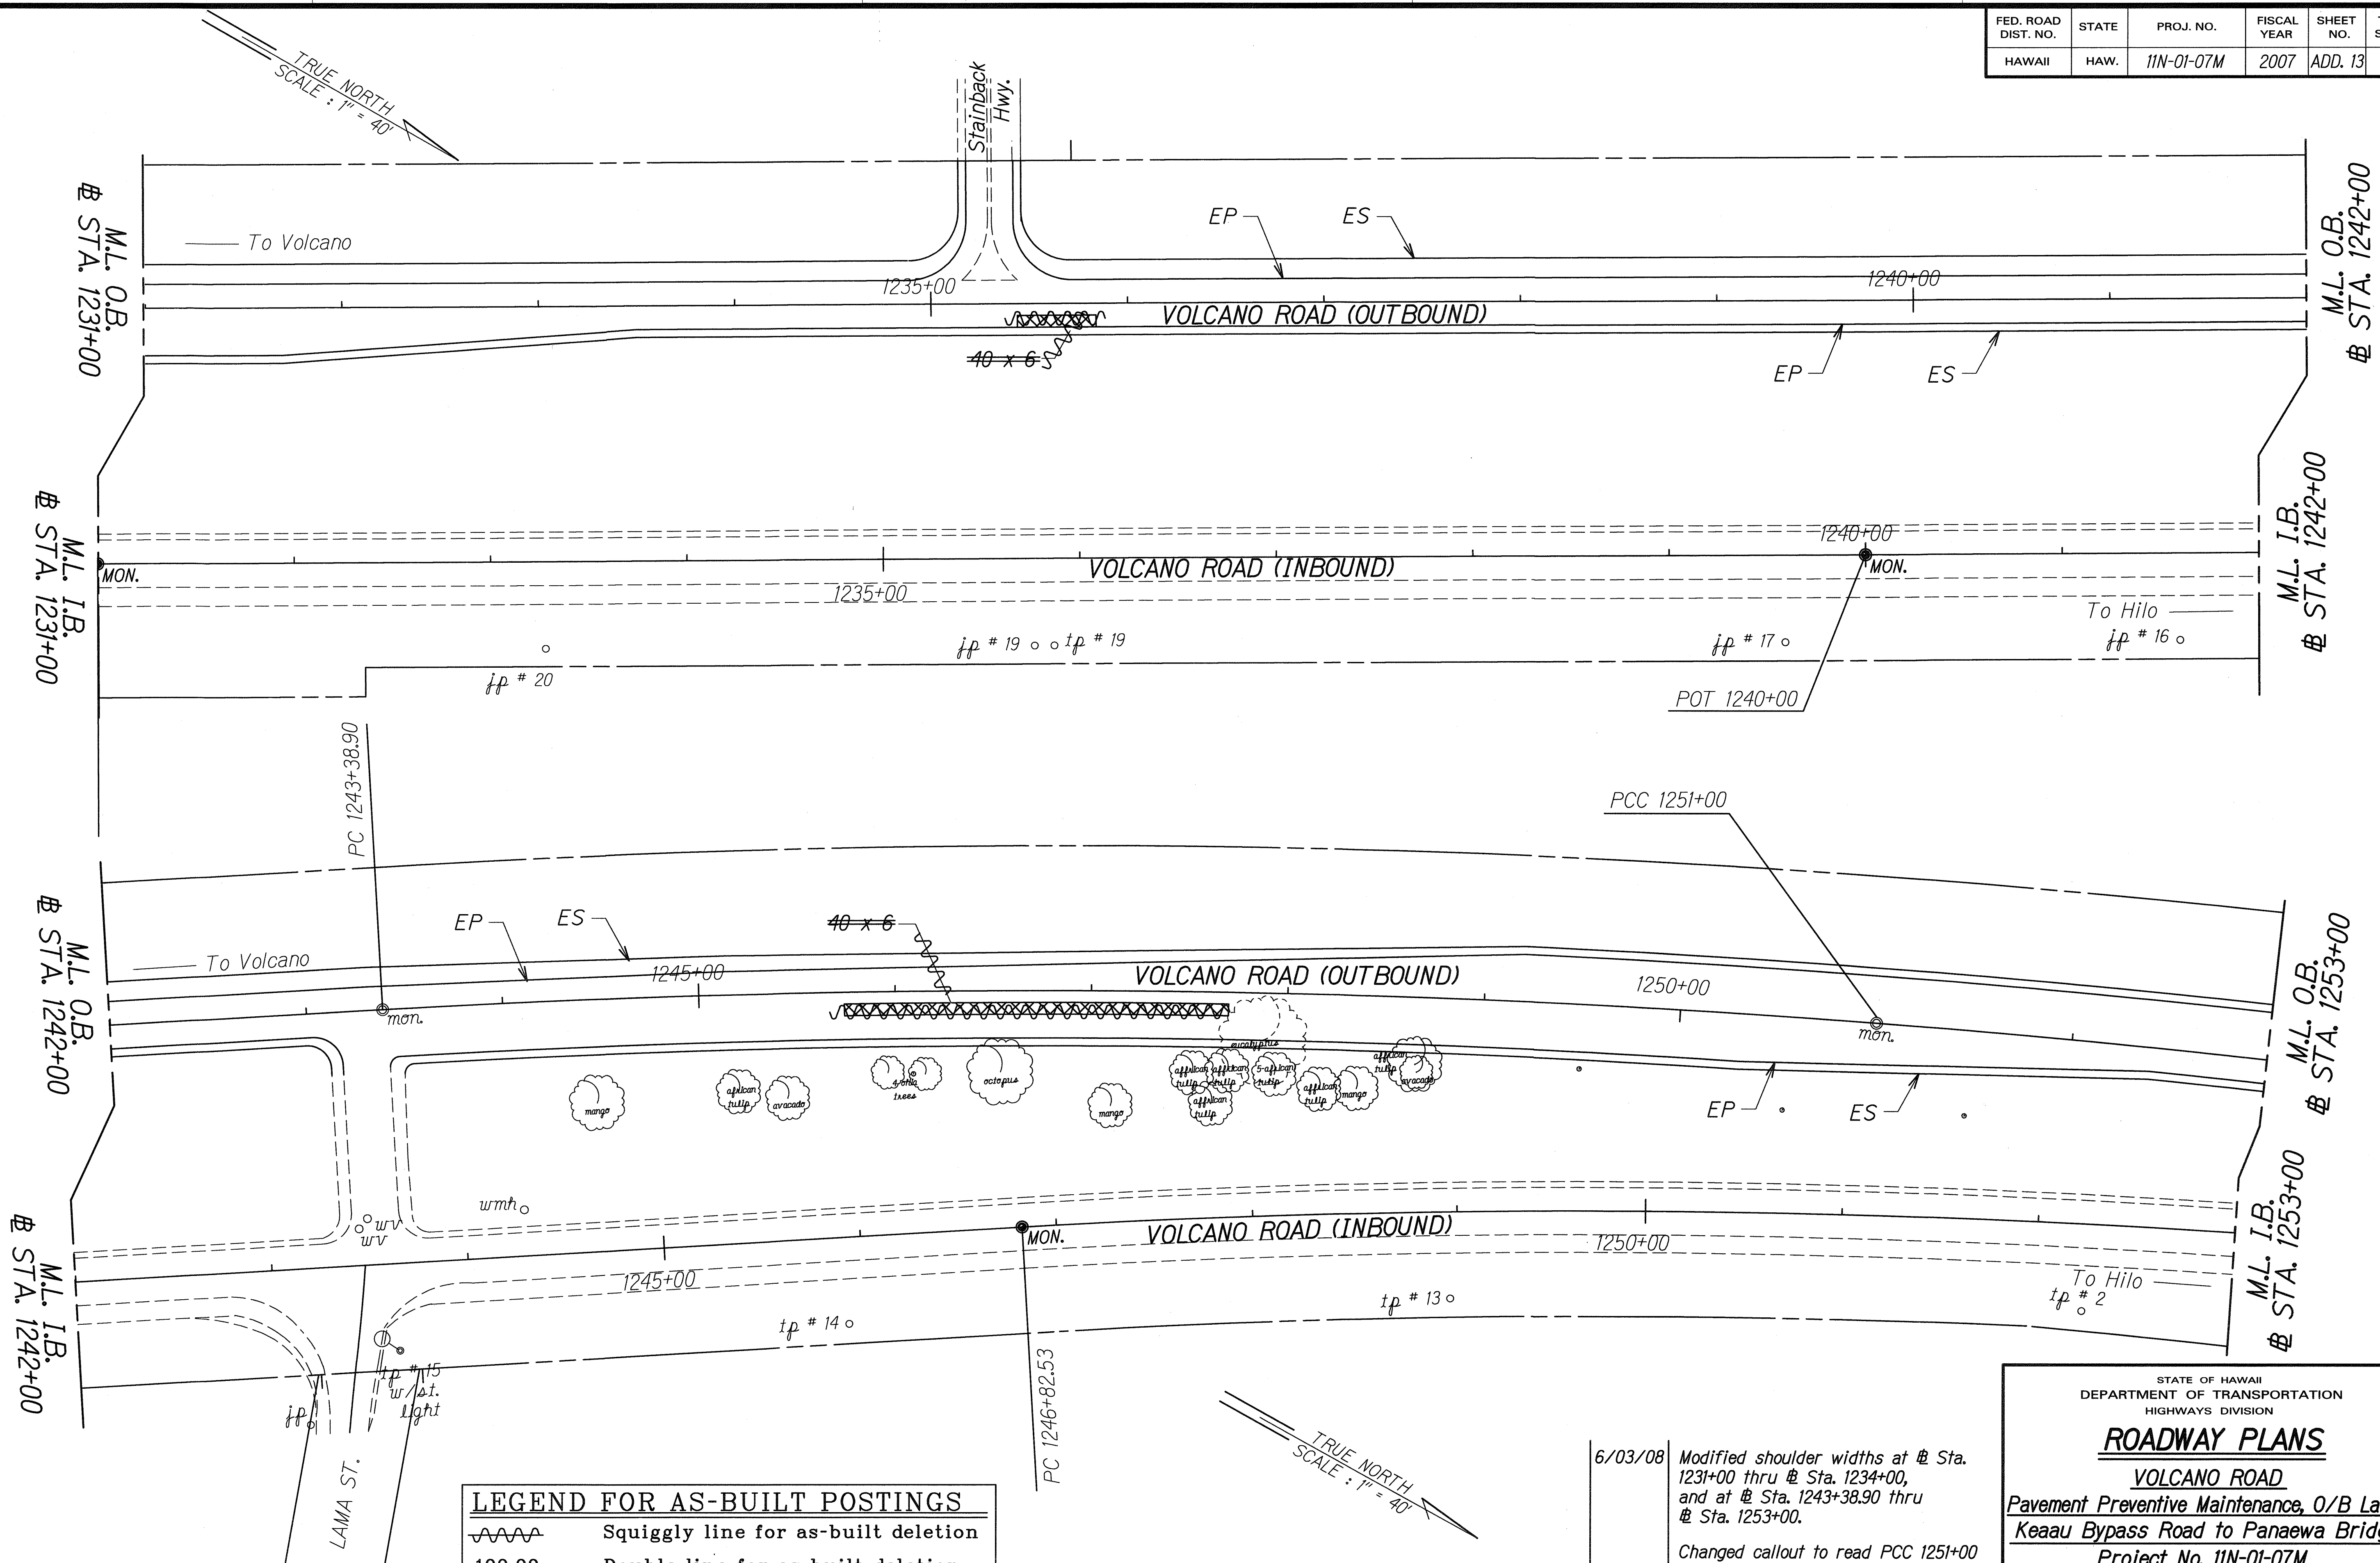

ORIGINAL PLAN	SURVEY PLOTTED BY _____	DATE _____
NOTE BOOK	DRAWN BY _____	_____
422	TRACED BY _____	_____
422	DESIGNED BY _____	_____
422	QUANTITIES BY _____	_____
422	CHECKED BY _____	_____
422		_____

6/03/08	Modified shoulder widths at Sta. 1231+00 thru Sta. 1234+00, and at Sta. 1243+38.90 thru Sta. 1253+00. Changed callout to read PCC 1251+00
DATE	REVISION

STATE OF HAWAII
DEPARTMENT OF TRANSPORTATION
HIGHWAYS DIVISION

ROADWAY PLANS

VOLCANO ROAD

Pavement Preventive Maintenance, 0/B Lanes
Keaau Bypass Road to Panaewa Bridge
Project No. 11N-01-07M


Scale: 1" = 40' Date: May, 2008

SHEET No. 7 OF 10 SHEETS

"AS-BUILT"

ADD. 13

FED. ROAD DIST. NO.	STATE	PROJ. NO.	FISCAL YEAR	SHEET NO.	TOTAL SHEETS
HAWAII	HAW.	11N-01-07M	2008	ADD. 14	29

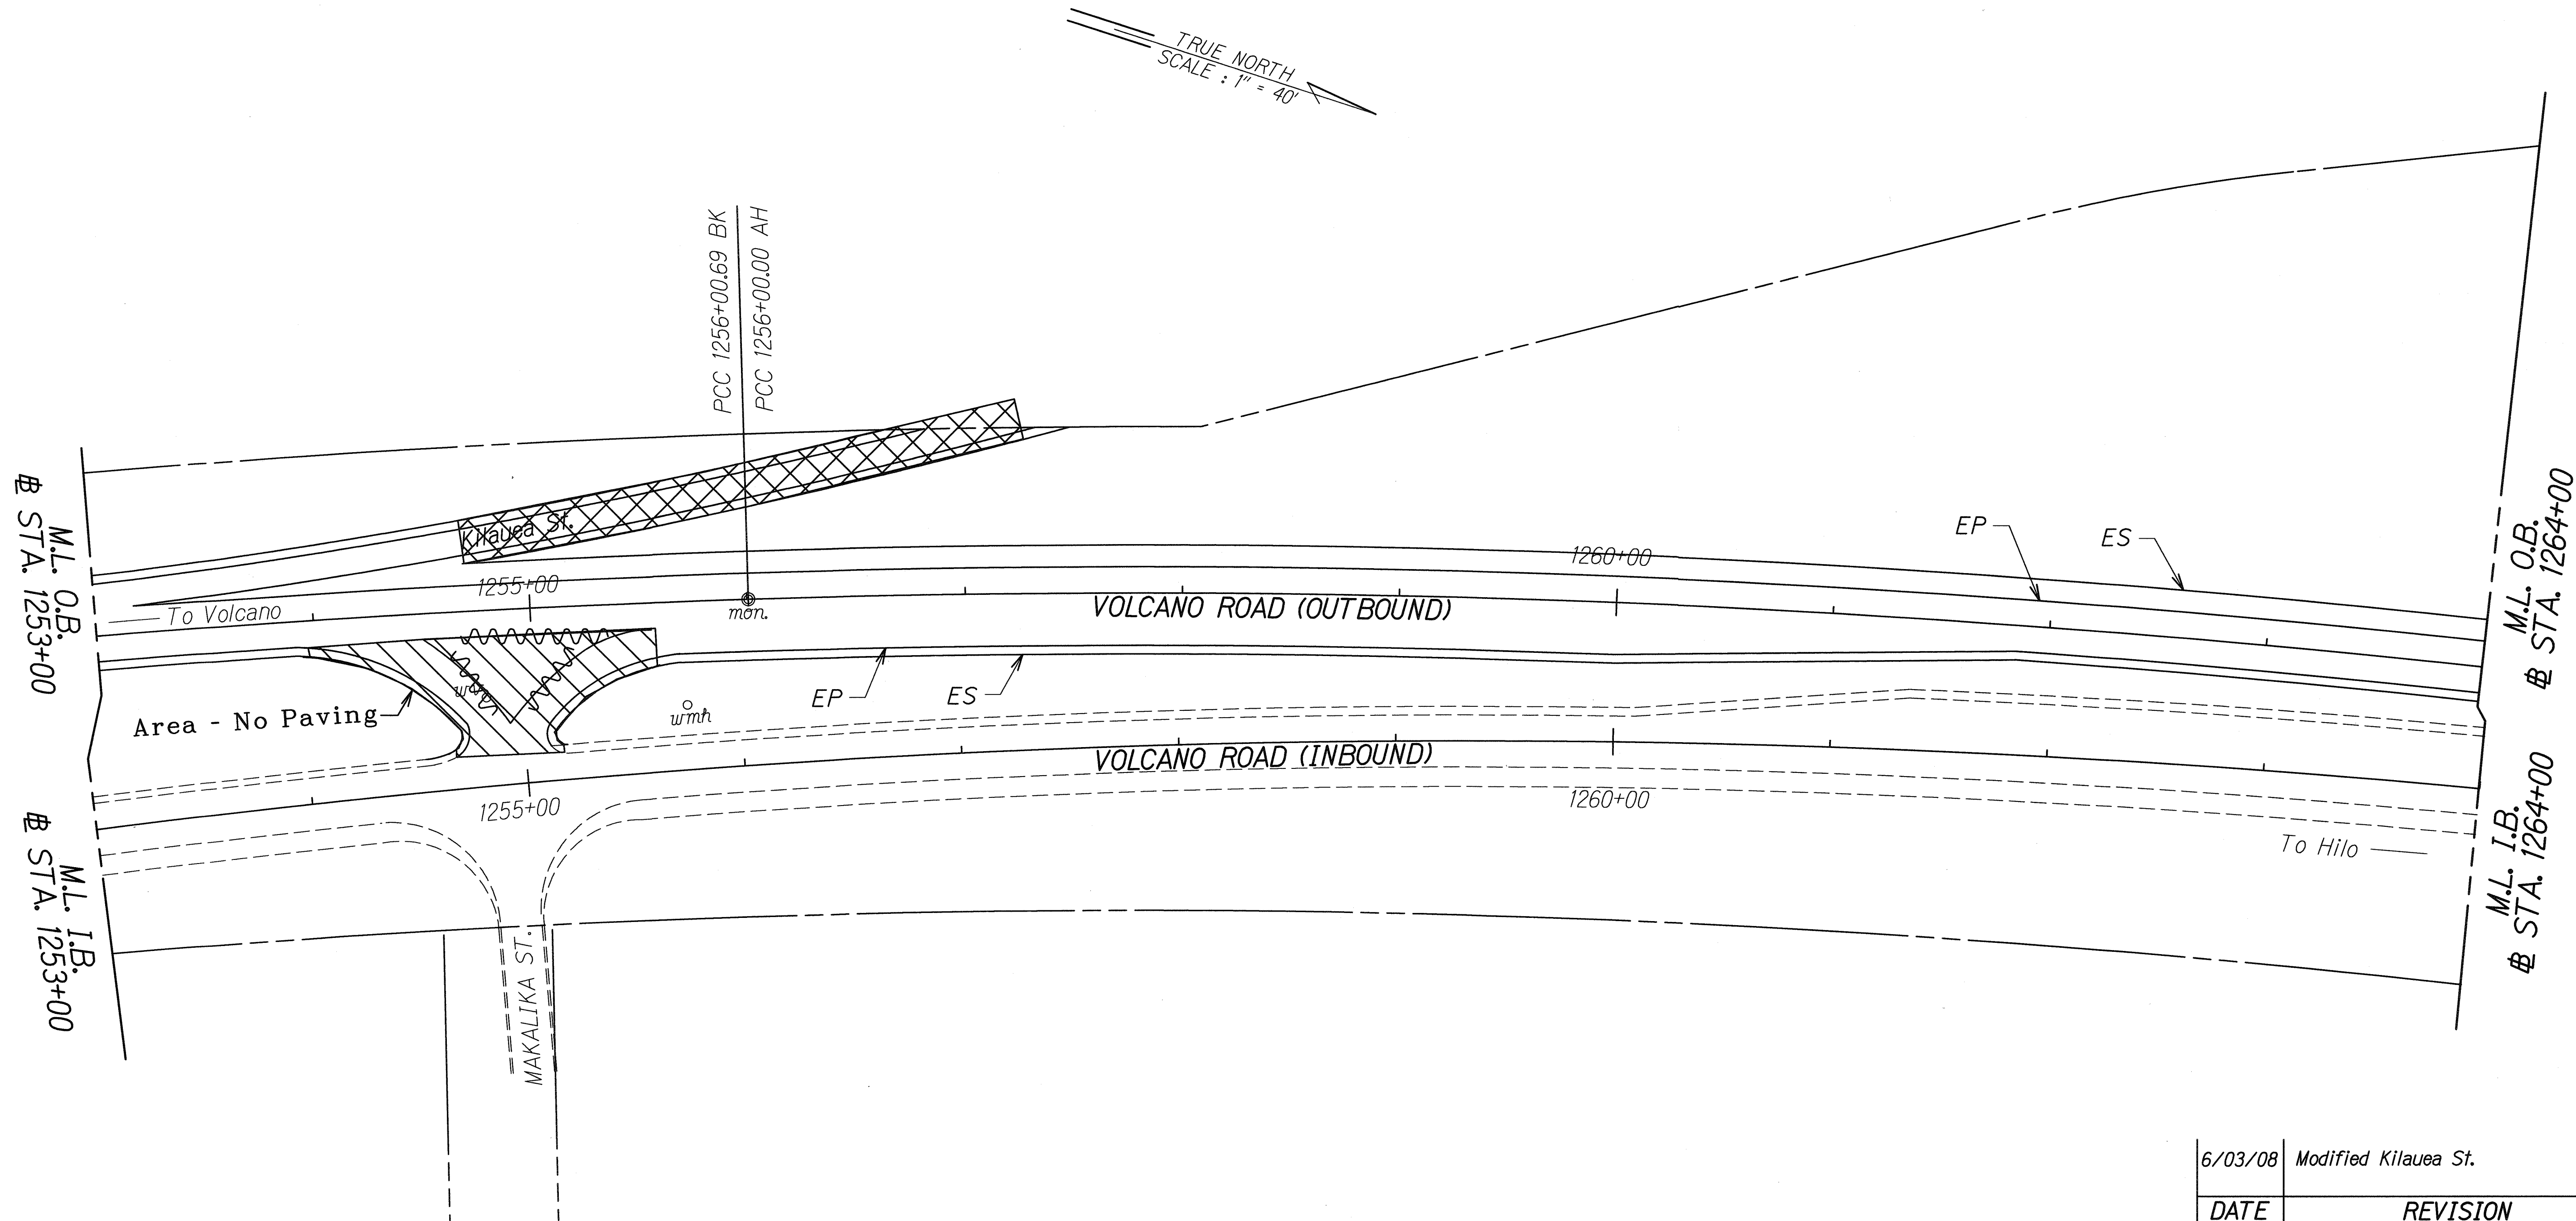

ORIGINAL PLAN	DATE
DESIGNED BY	
TRACED BY	
NOTED BY	
CHECKED BY	
DATE	


LEGEND FOR AS-BUILT POSTINGS	
	Squiggly line for as-built deletion
	Double line for as-built deletion
Roadway	Text for as-built posting

6/03/08	Modified Kilauea St.
DATE	REVISION
STATE OF HAWAII DEPARTMENT OF TRANSPORTATION HIGHWAYS DIVISION ROADWAY PLANS <u>VOLCANO ROAD</u> Pavement Preventive Maintenance, O/B Lanes Keaau Bypass Road to Panaewa Bridge Project No. 11N-01-07M Scale: 1" = 40' Date: May, 2008	
SHEET No. 8 OF 10 SHEETS	

"AS-BUILT"

ADD. 14

FED. ROAD DIST. NO.	STATE	PROJ. NO.	FISCAL YEAR	SHEET NO.	TOTAL SHEETS
HAWAII	HAW.	11N-01-07M	2008	15	29

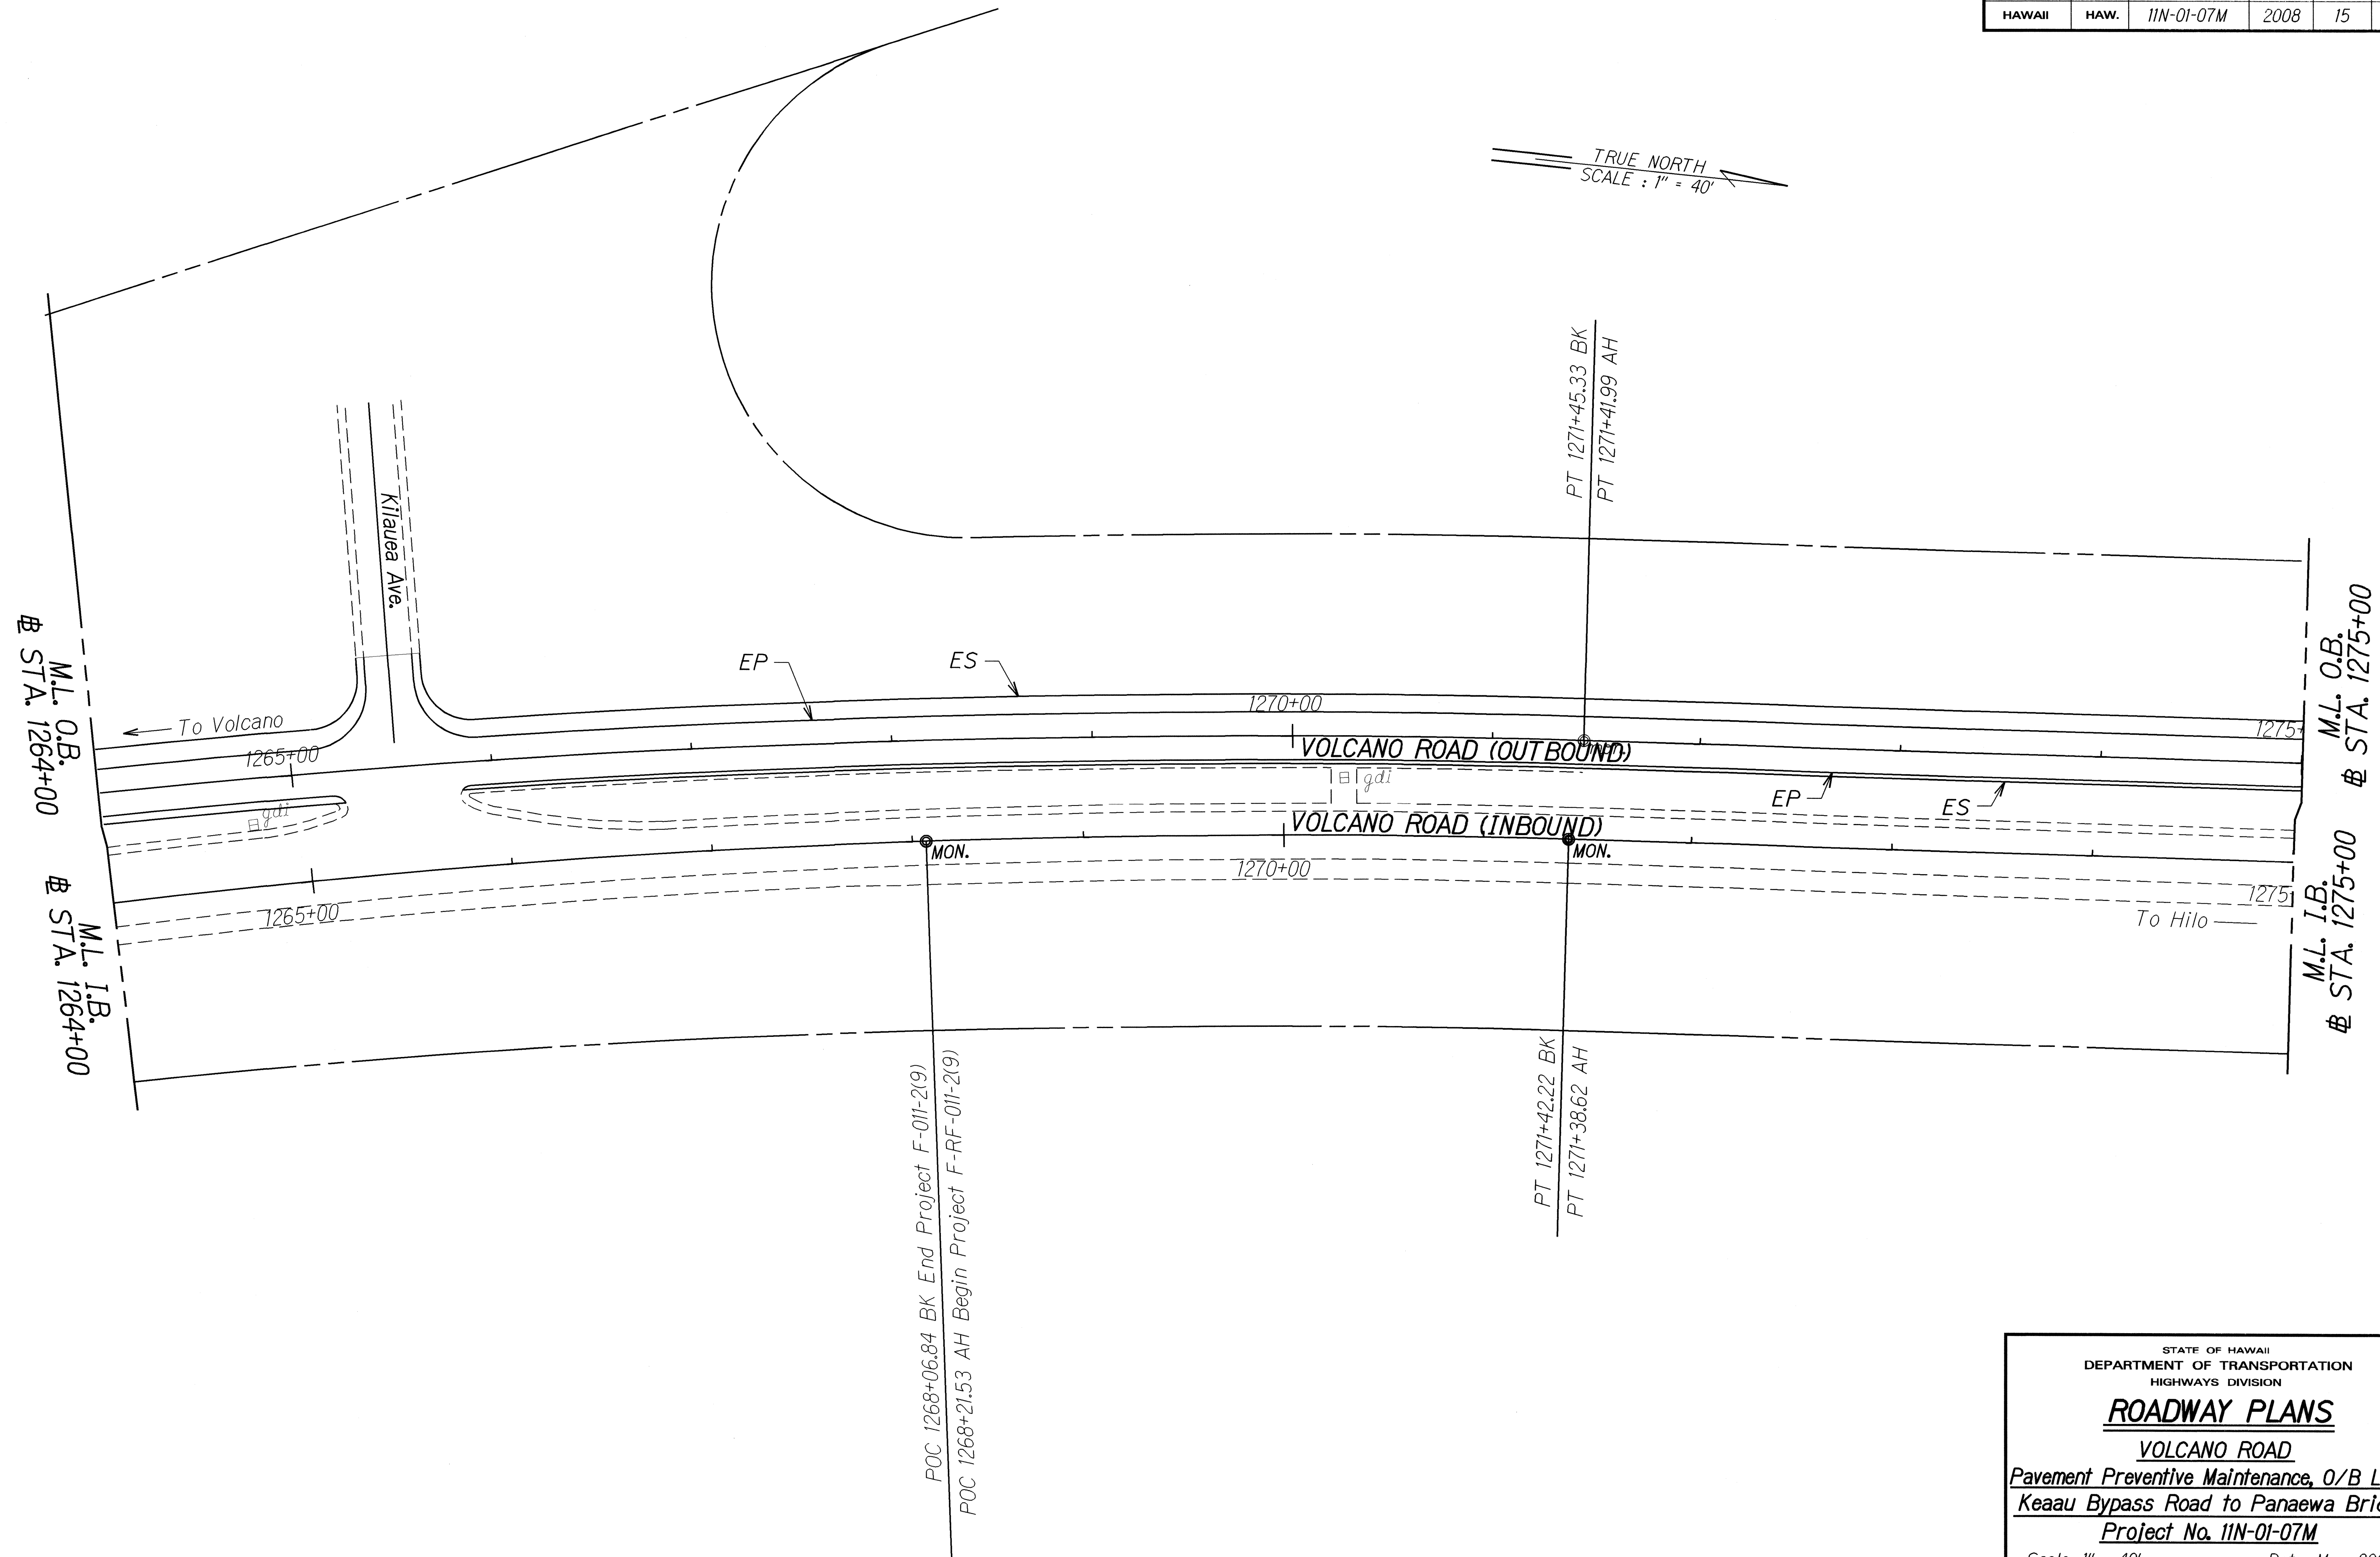

ORIGINAL PLAN	SURVEY PLOTTED BY	DATE
TRACED BY		
NOTE BOOK		
QUANTITIES BY		
CHECKED BY		

STATE OF HAWAII
DEPARTMENT OF TRANSPORTATION
HIGHWAYS DIVISION

ROADWAY PLANS

VOLCANO ROAD


*Pavement Preventive Maintenance, O/B Lanes
Keaau Bypass Road to Panaewa Bridge*

Project No. 11N-01-07M

Scale: 1" = 40' Date: May, 2008

FED. ROAD DIST. NO.	STATE	PROJ. NO.	FISCAL YEAR	SHEET NO.	TOTAL SHEETS
HAWAII	HAW.	11N-01-07M	2008	16	29

TRUE NORTH
SCALE : 1" = 40'

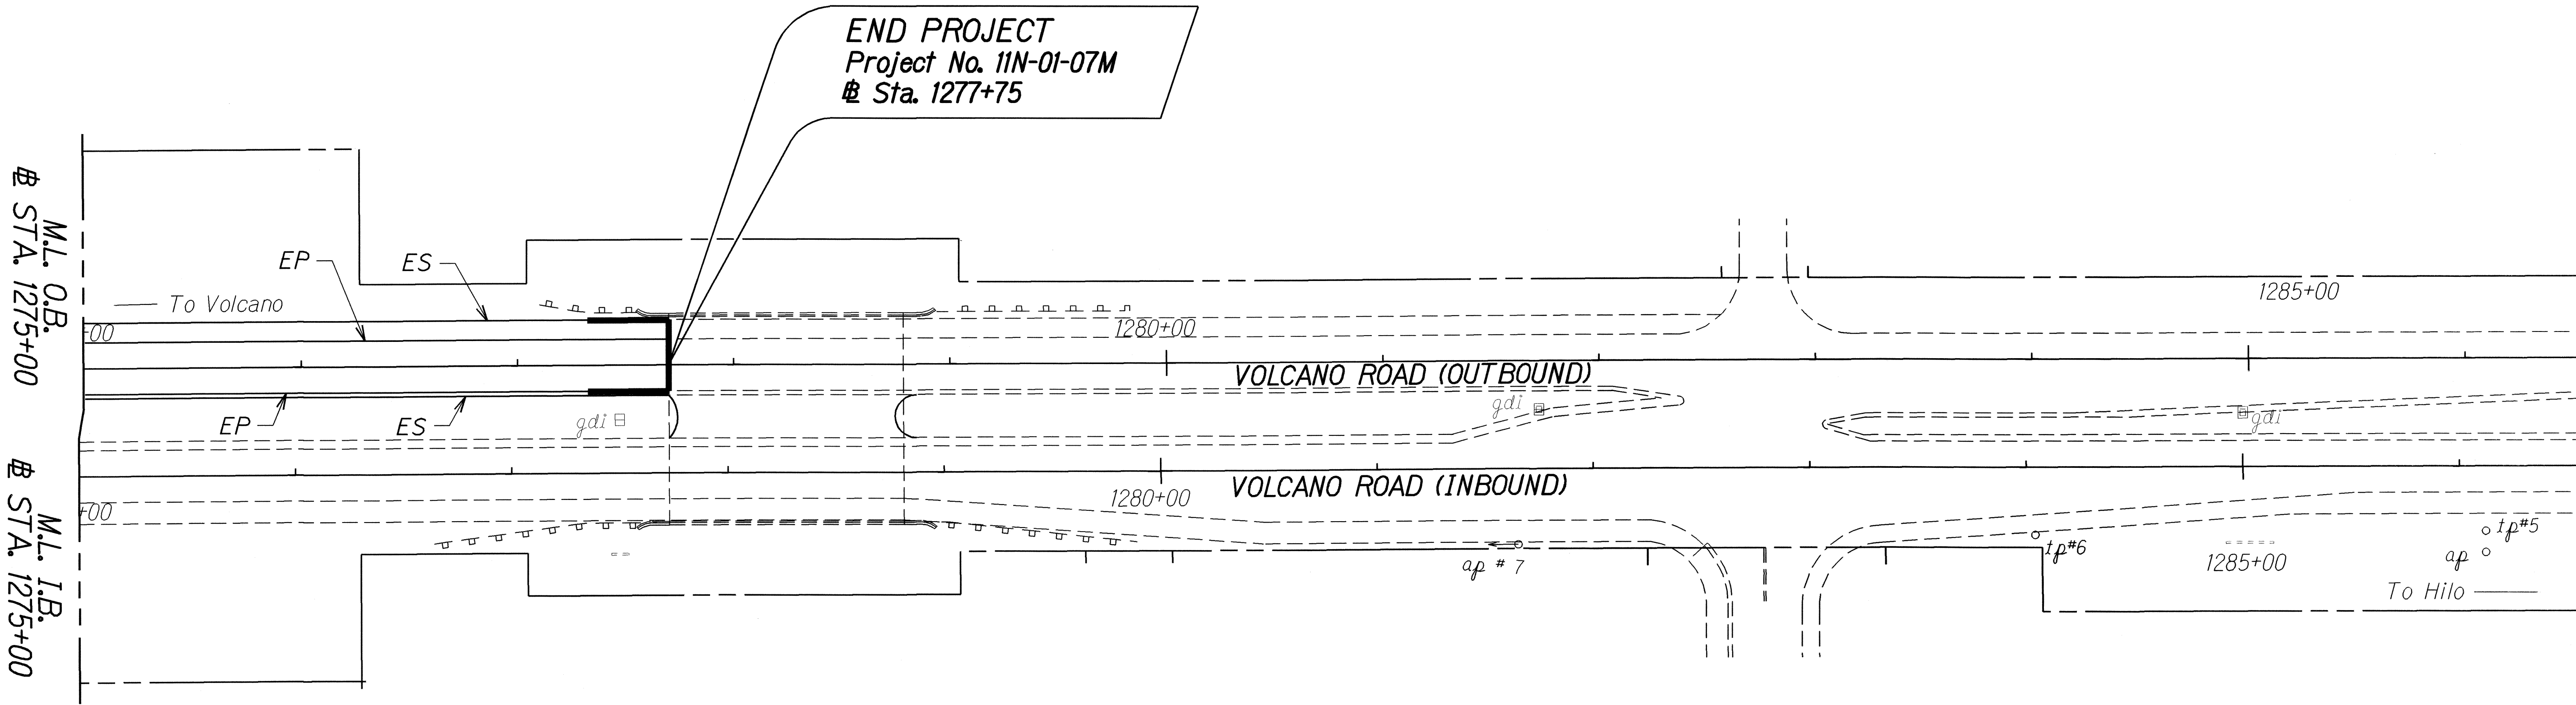

ORIGINAL PLAN	SURVEY PLOTTED BY	DATE
NOVE BOOK	DRAWN BY	
NO. 100/10000000	TRACED BY	
	CHECKED BY	

STATE OF HAWAII
DEPARTMENT OF TRANSPORTATION
HIGHWAYS DIVISION

ROADWAY PLANS

VOLCANO ROAD

*Pavement Preventive Maintenance, O/B Lanes
Keaau Bypass Road to Panaewa Bridge
Project No. 11N-01-07M*

Scale: 1" = 40' Date: May, 2008

SHEET No. 10 OF 10 SHEETS