



FED. ROAD DIST. NO.	STATE	PROJ. NO.	FISCAL YEAR	SHEET NO.	TOTAL SHEETS
HAWAII	HAW.	11N-01-07M	2008	6	29

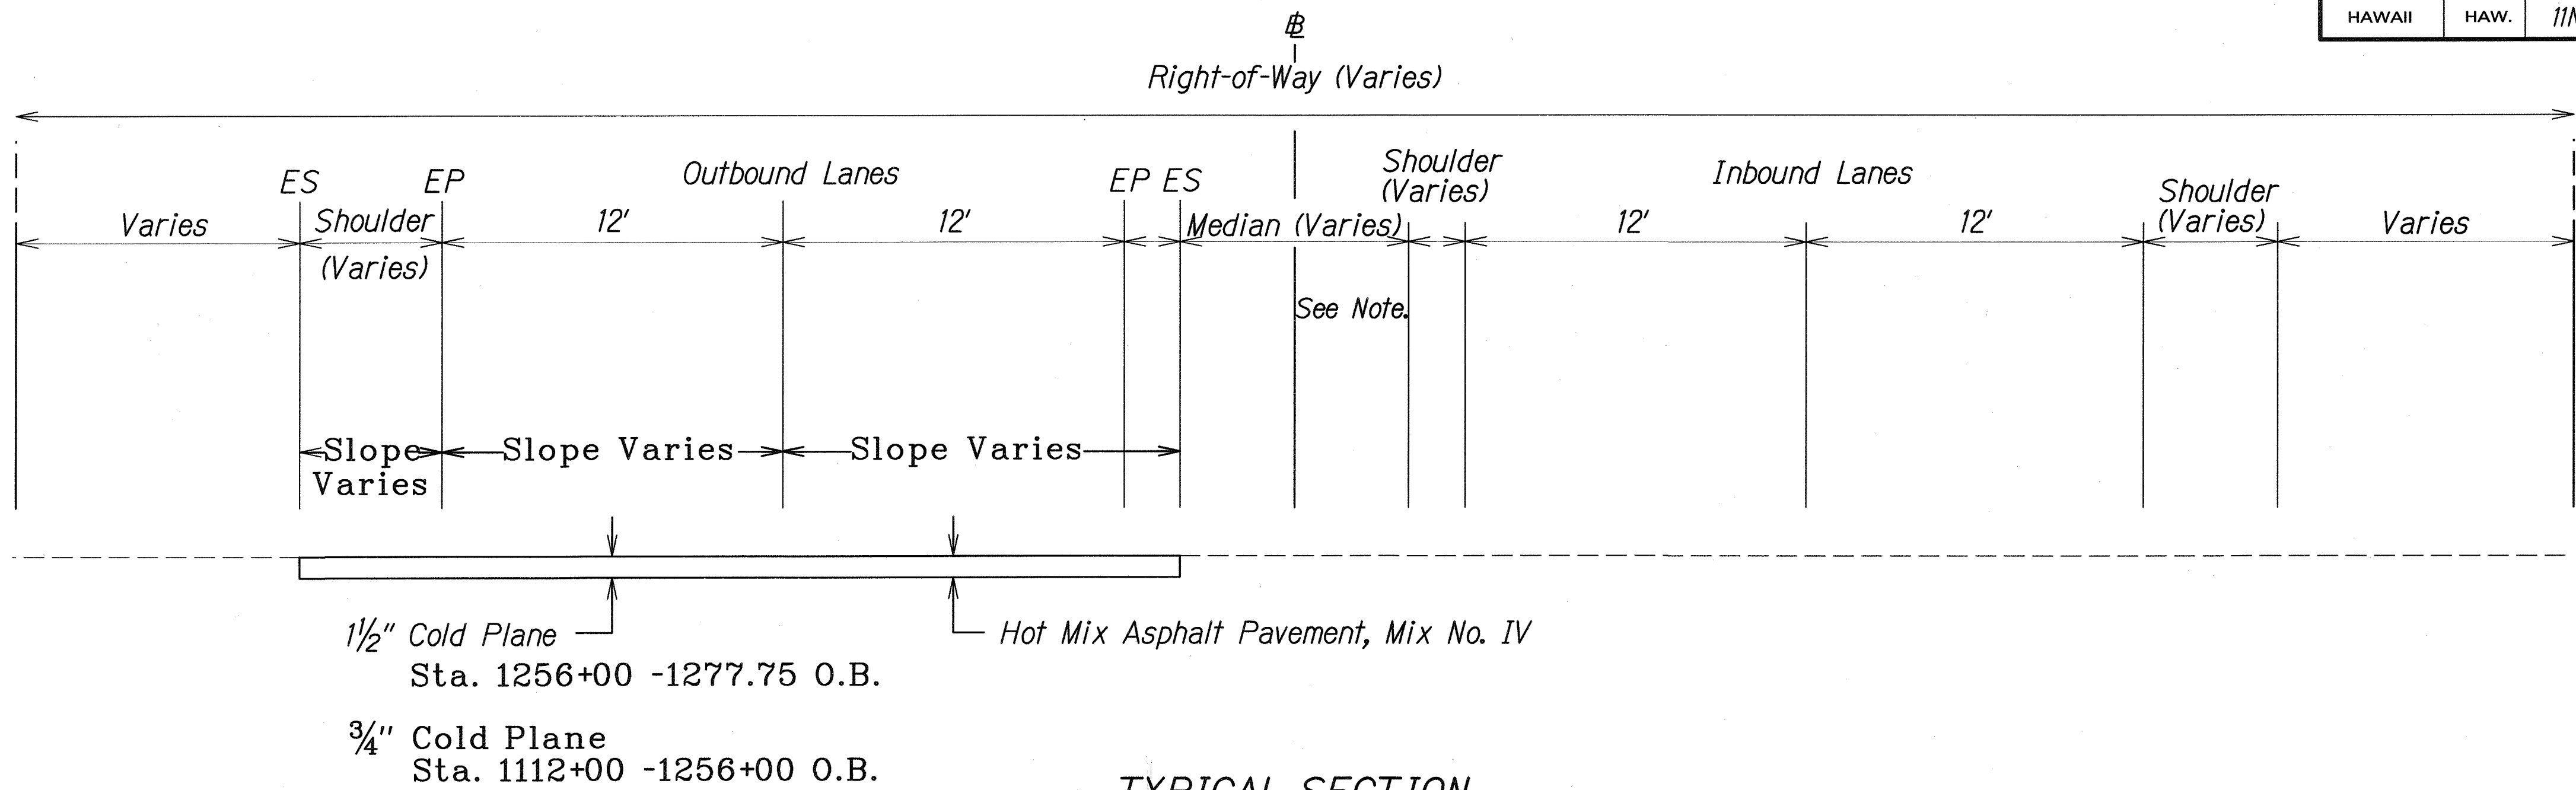


**TYPICAL SECTION**  
Not to Scale

**NOTE:**  
Do not cold plane or pave median. Median width varies, reference Roadway Plan sheets for width.

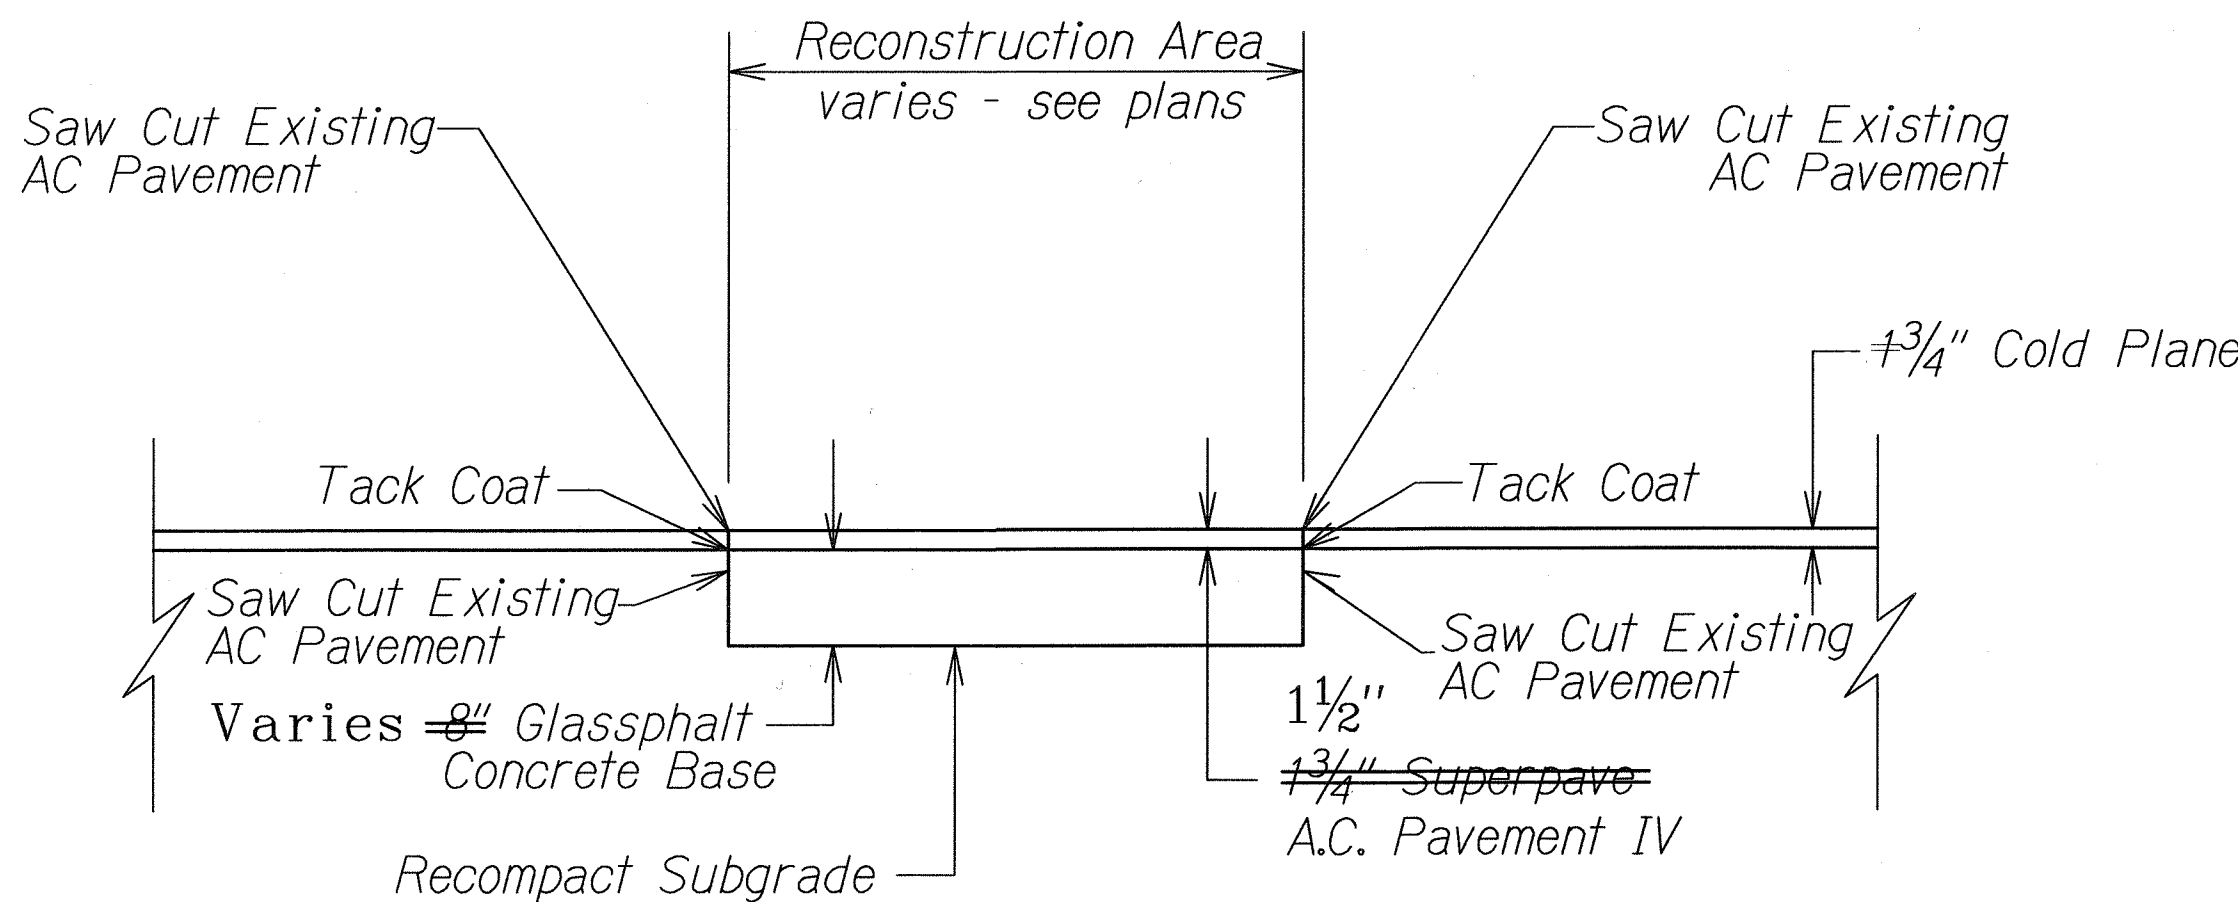

**TYPICAL RECONSTRUCTION AREA**  
Not to Scale

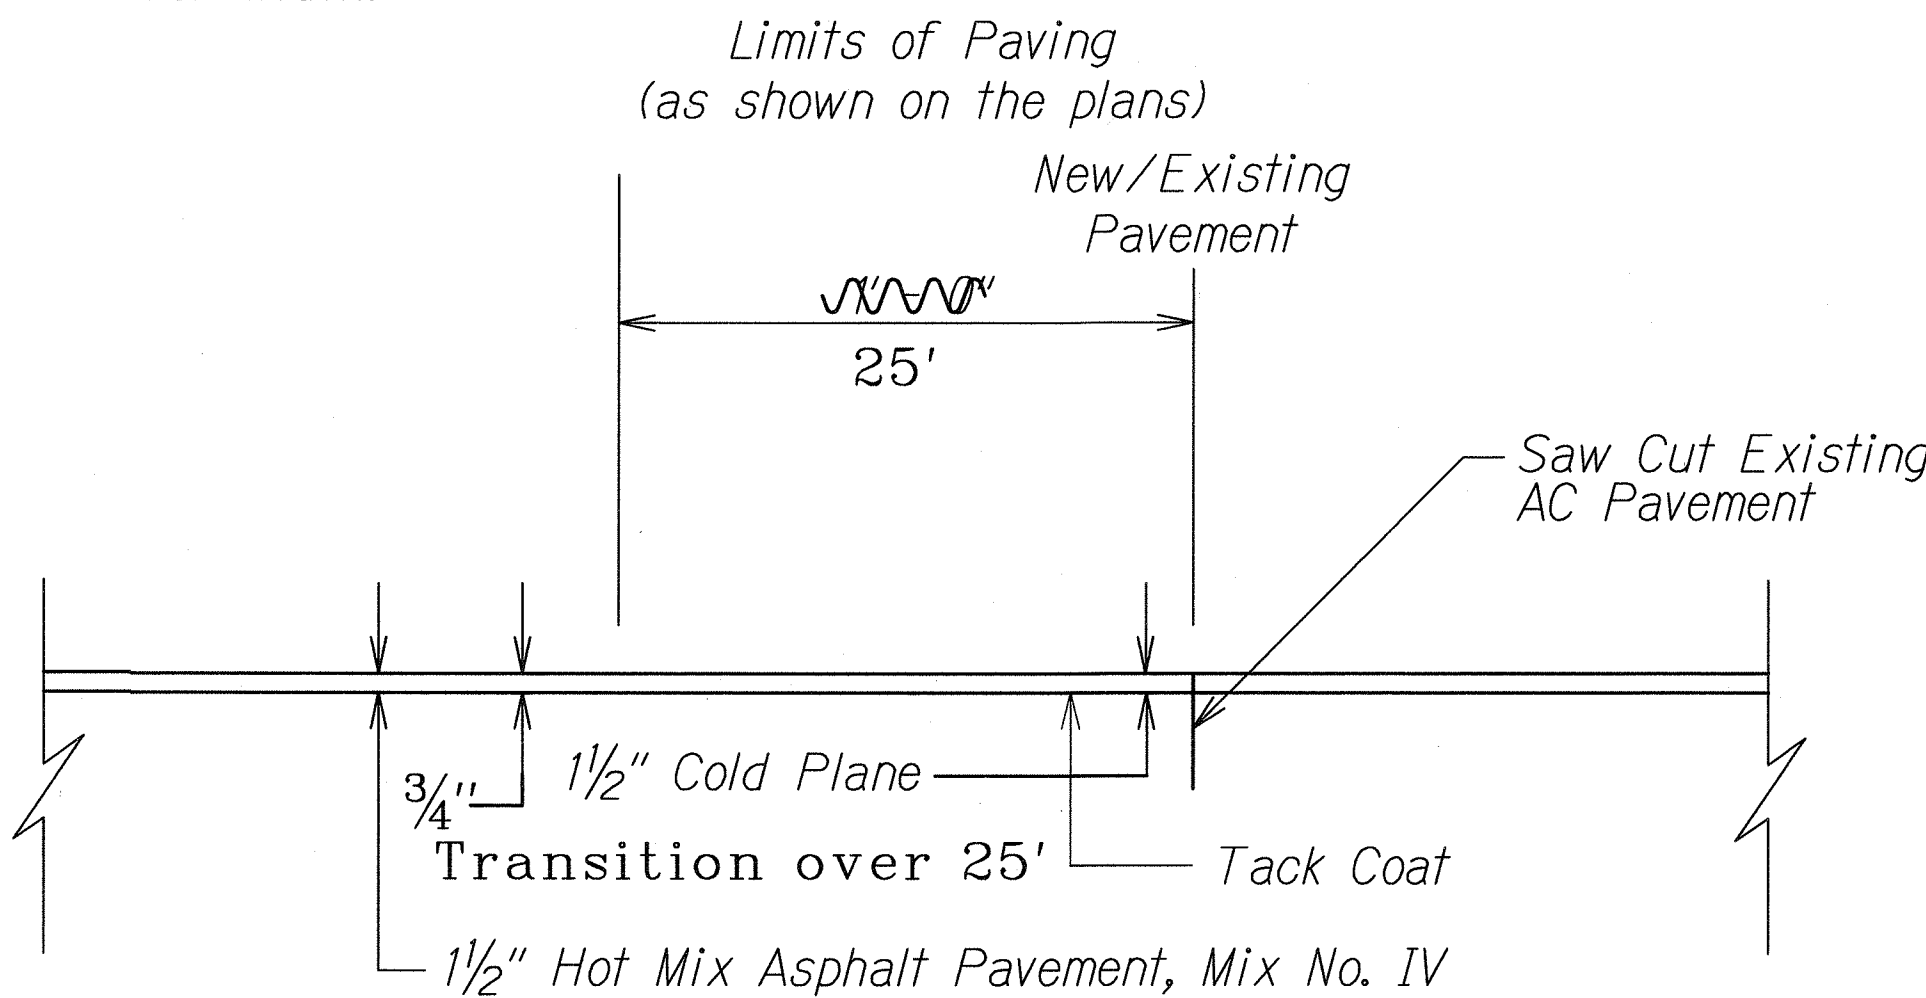

**NEW PAVEMENT to EXISTING PAVEMENT**  
**TRANSITION DETAIL**  
Not to Scale

**NOTE:**  
At transitions between new and existing pavement, sawcut 1'-0" beyond the Limits of Paving shown on the plans. Place new pavement up to sawcut line. Elevation of new pavement shall match elevation of existing pavement.

LEGEND FOR AS-BUILT POSTINGS	
	Squiggly line for as-built deletion
	Double line for as-built deletion
Roadway	Text for as-built posting

STATE OF HAWAII  
DEPARTMENT OF TRANSPORTATION  
HIGHWAYS DIVISION

**TYPICAL SECTION**  
VOLCANO ROAD  
Pavement Preventive Maintenance, O/B Lanes  
Keaau Bypass Road to Panaewa Bridge  
Project No. 11N-01-07M  
Not to Scale Date: May, 2008

SHEET No. 1 OF 1 SHEETS

ORIGINAL PLAN	DATE
DESIGNED BY	
CHECKED BY	
NOTED BY	
QUANTITIES BY	
REVISIONS	