
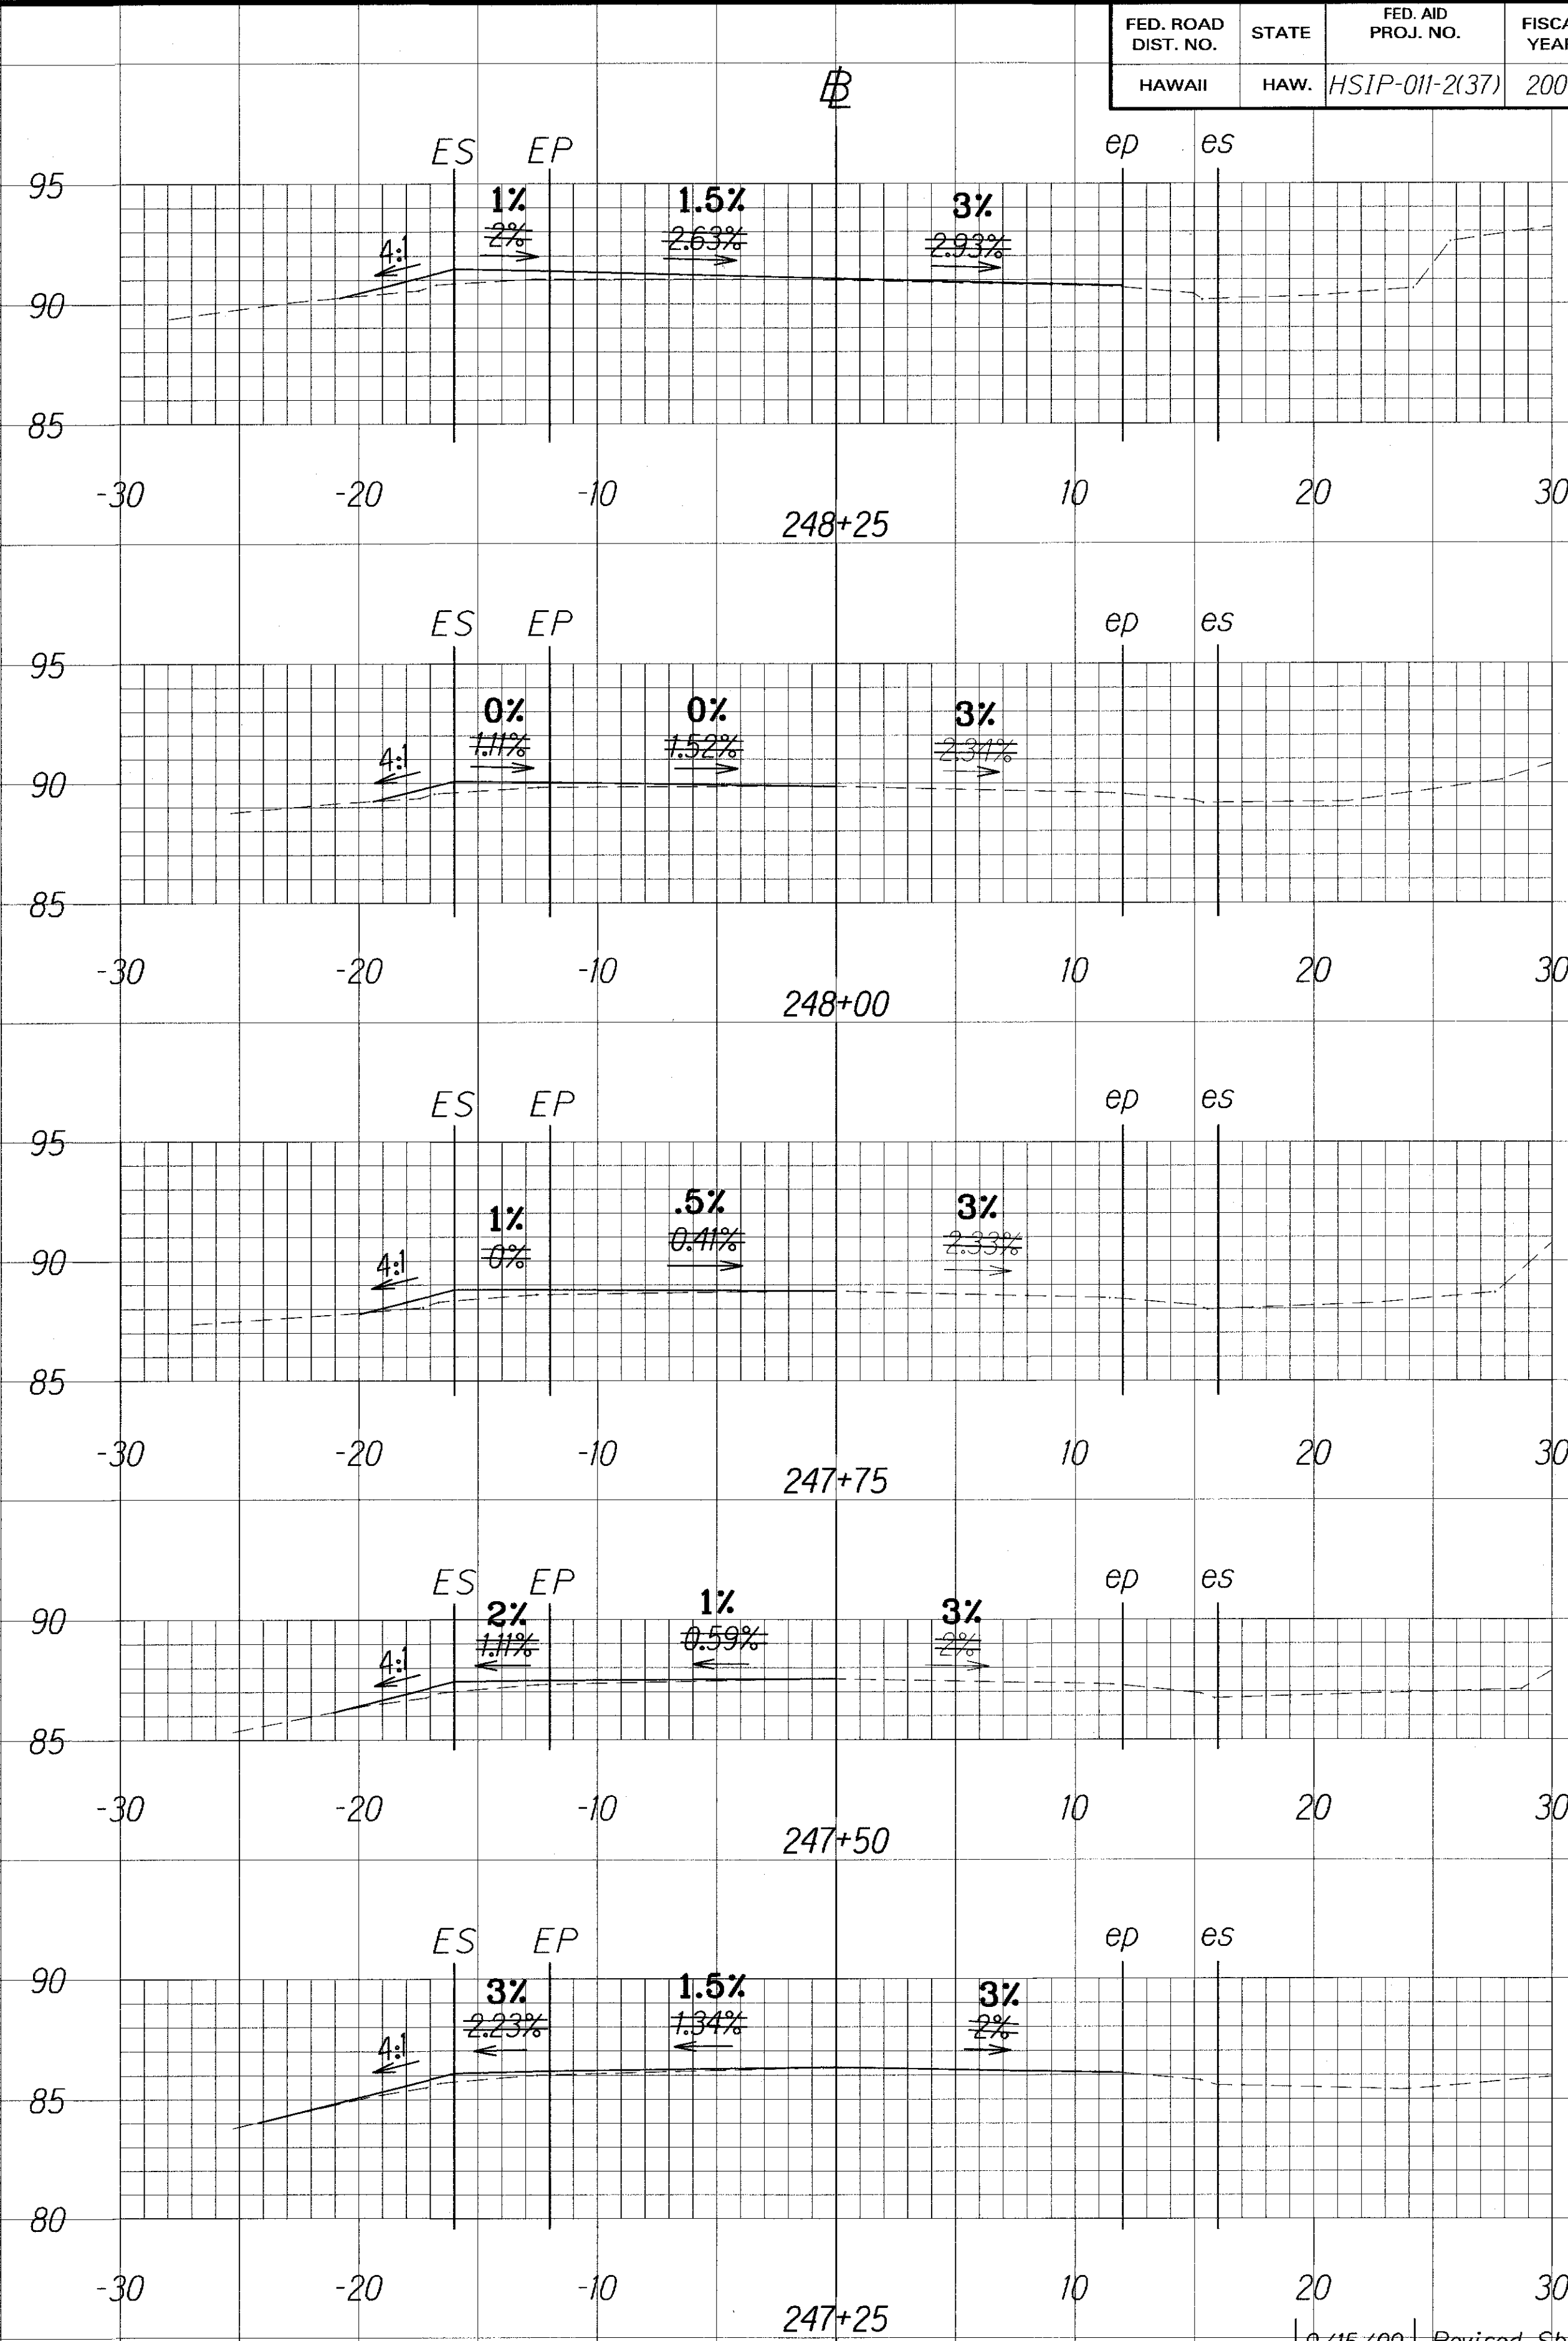


LEGEND FOR AS-BUILT POSTINGS
Squiggly line for as-built deletion
Double line for as-built deletion
Roadway
Text for as-built posting

ORIGINAL PLAN
DATE
SURVEY PLOTTED BY
DRAWN BY
DESIGNED BY
NOTE BOOK
QUANTITIES BY
CHECKED BY

SCALE
Horizontal: 1"=5'
Vertical: 1"=5'

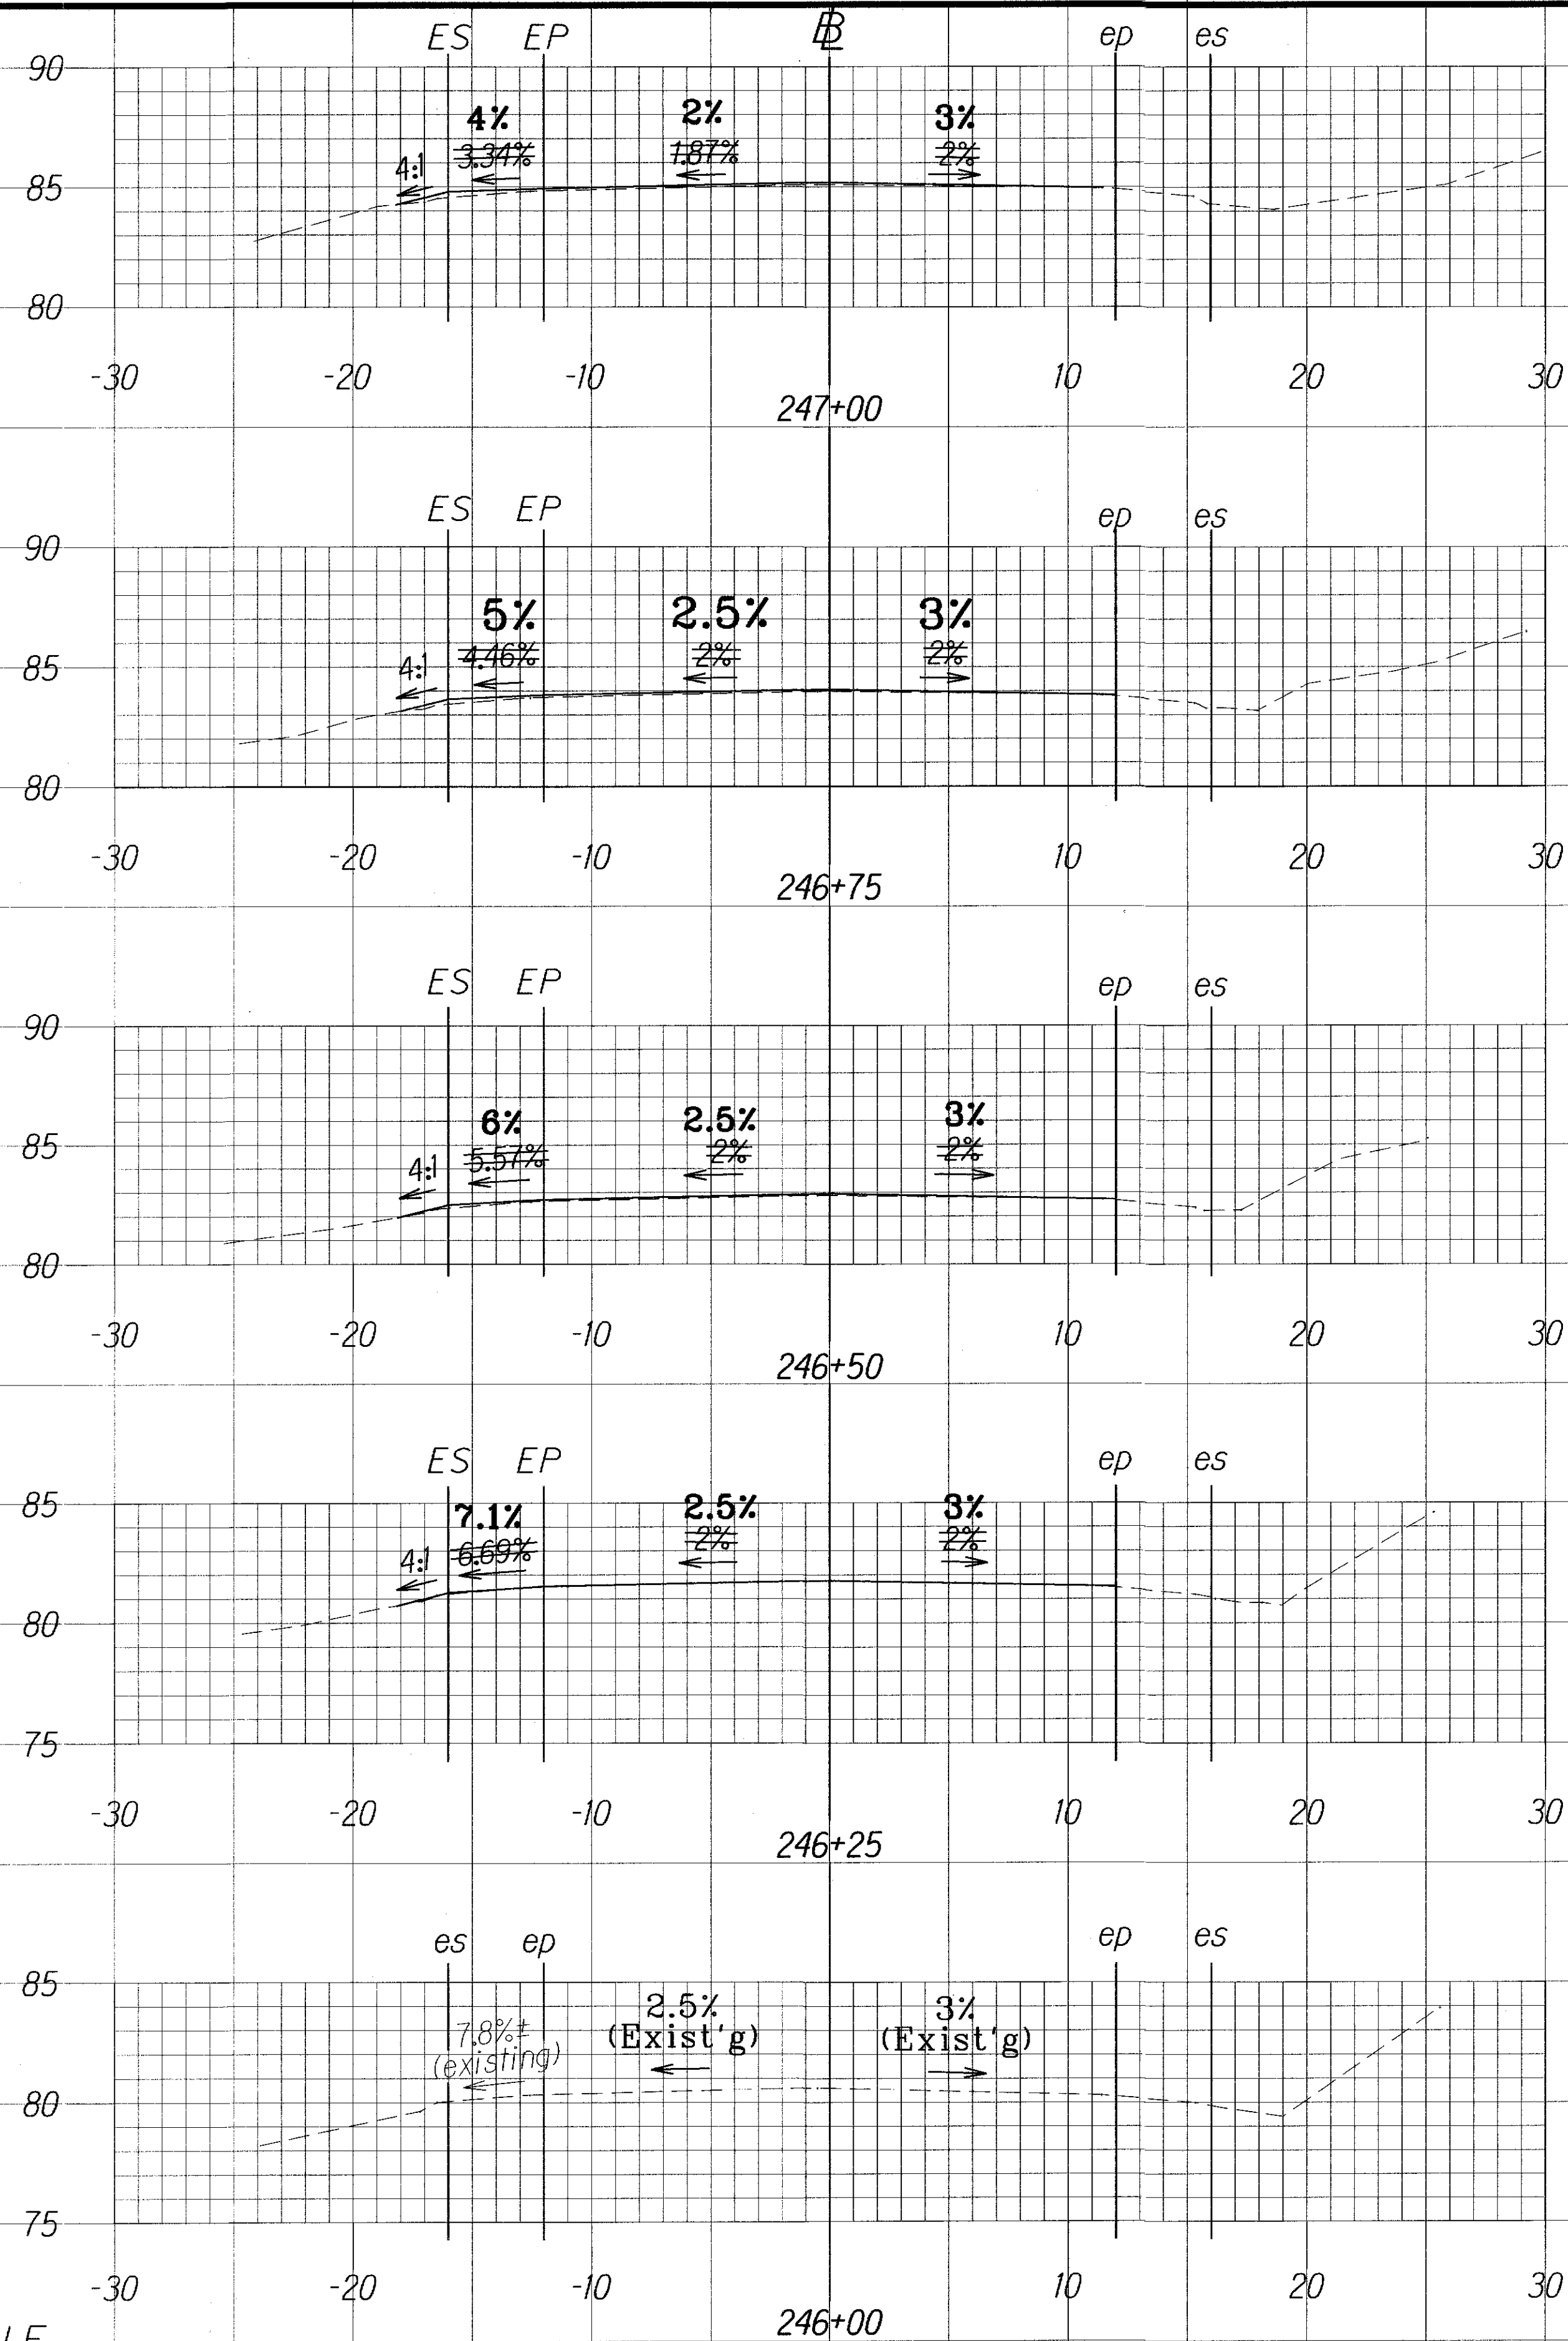



FED. ROAD DIST. NO.	STATE	FED. AID PROJ. NO.	FISCAL YEAR	SHEET NO.	TOTAL SHEETS
HAWAII	HAW.	HSIP-011-2(37)	2009	ADD. 27	34

9/15/09	Revised Shoulder Slopes.
DATE	REVISION
SHEET No. 1	OF 8 SHEETS

"AS-BUILT"

ADD. 27

	FED. ROAD DIST. NO.	STATE	FED. AID PROJ. NO.	FISCAL YEAR	SHEET NO.	TOTAL SHEETS
	HAWAII	HAW.	HSIP-011-2(37)	2009	ADD. 28	34

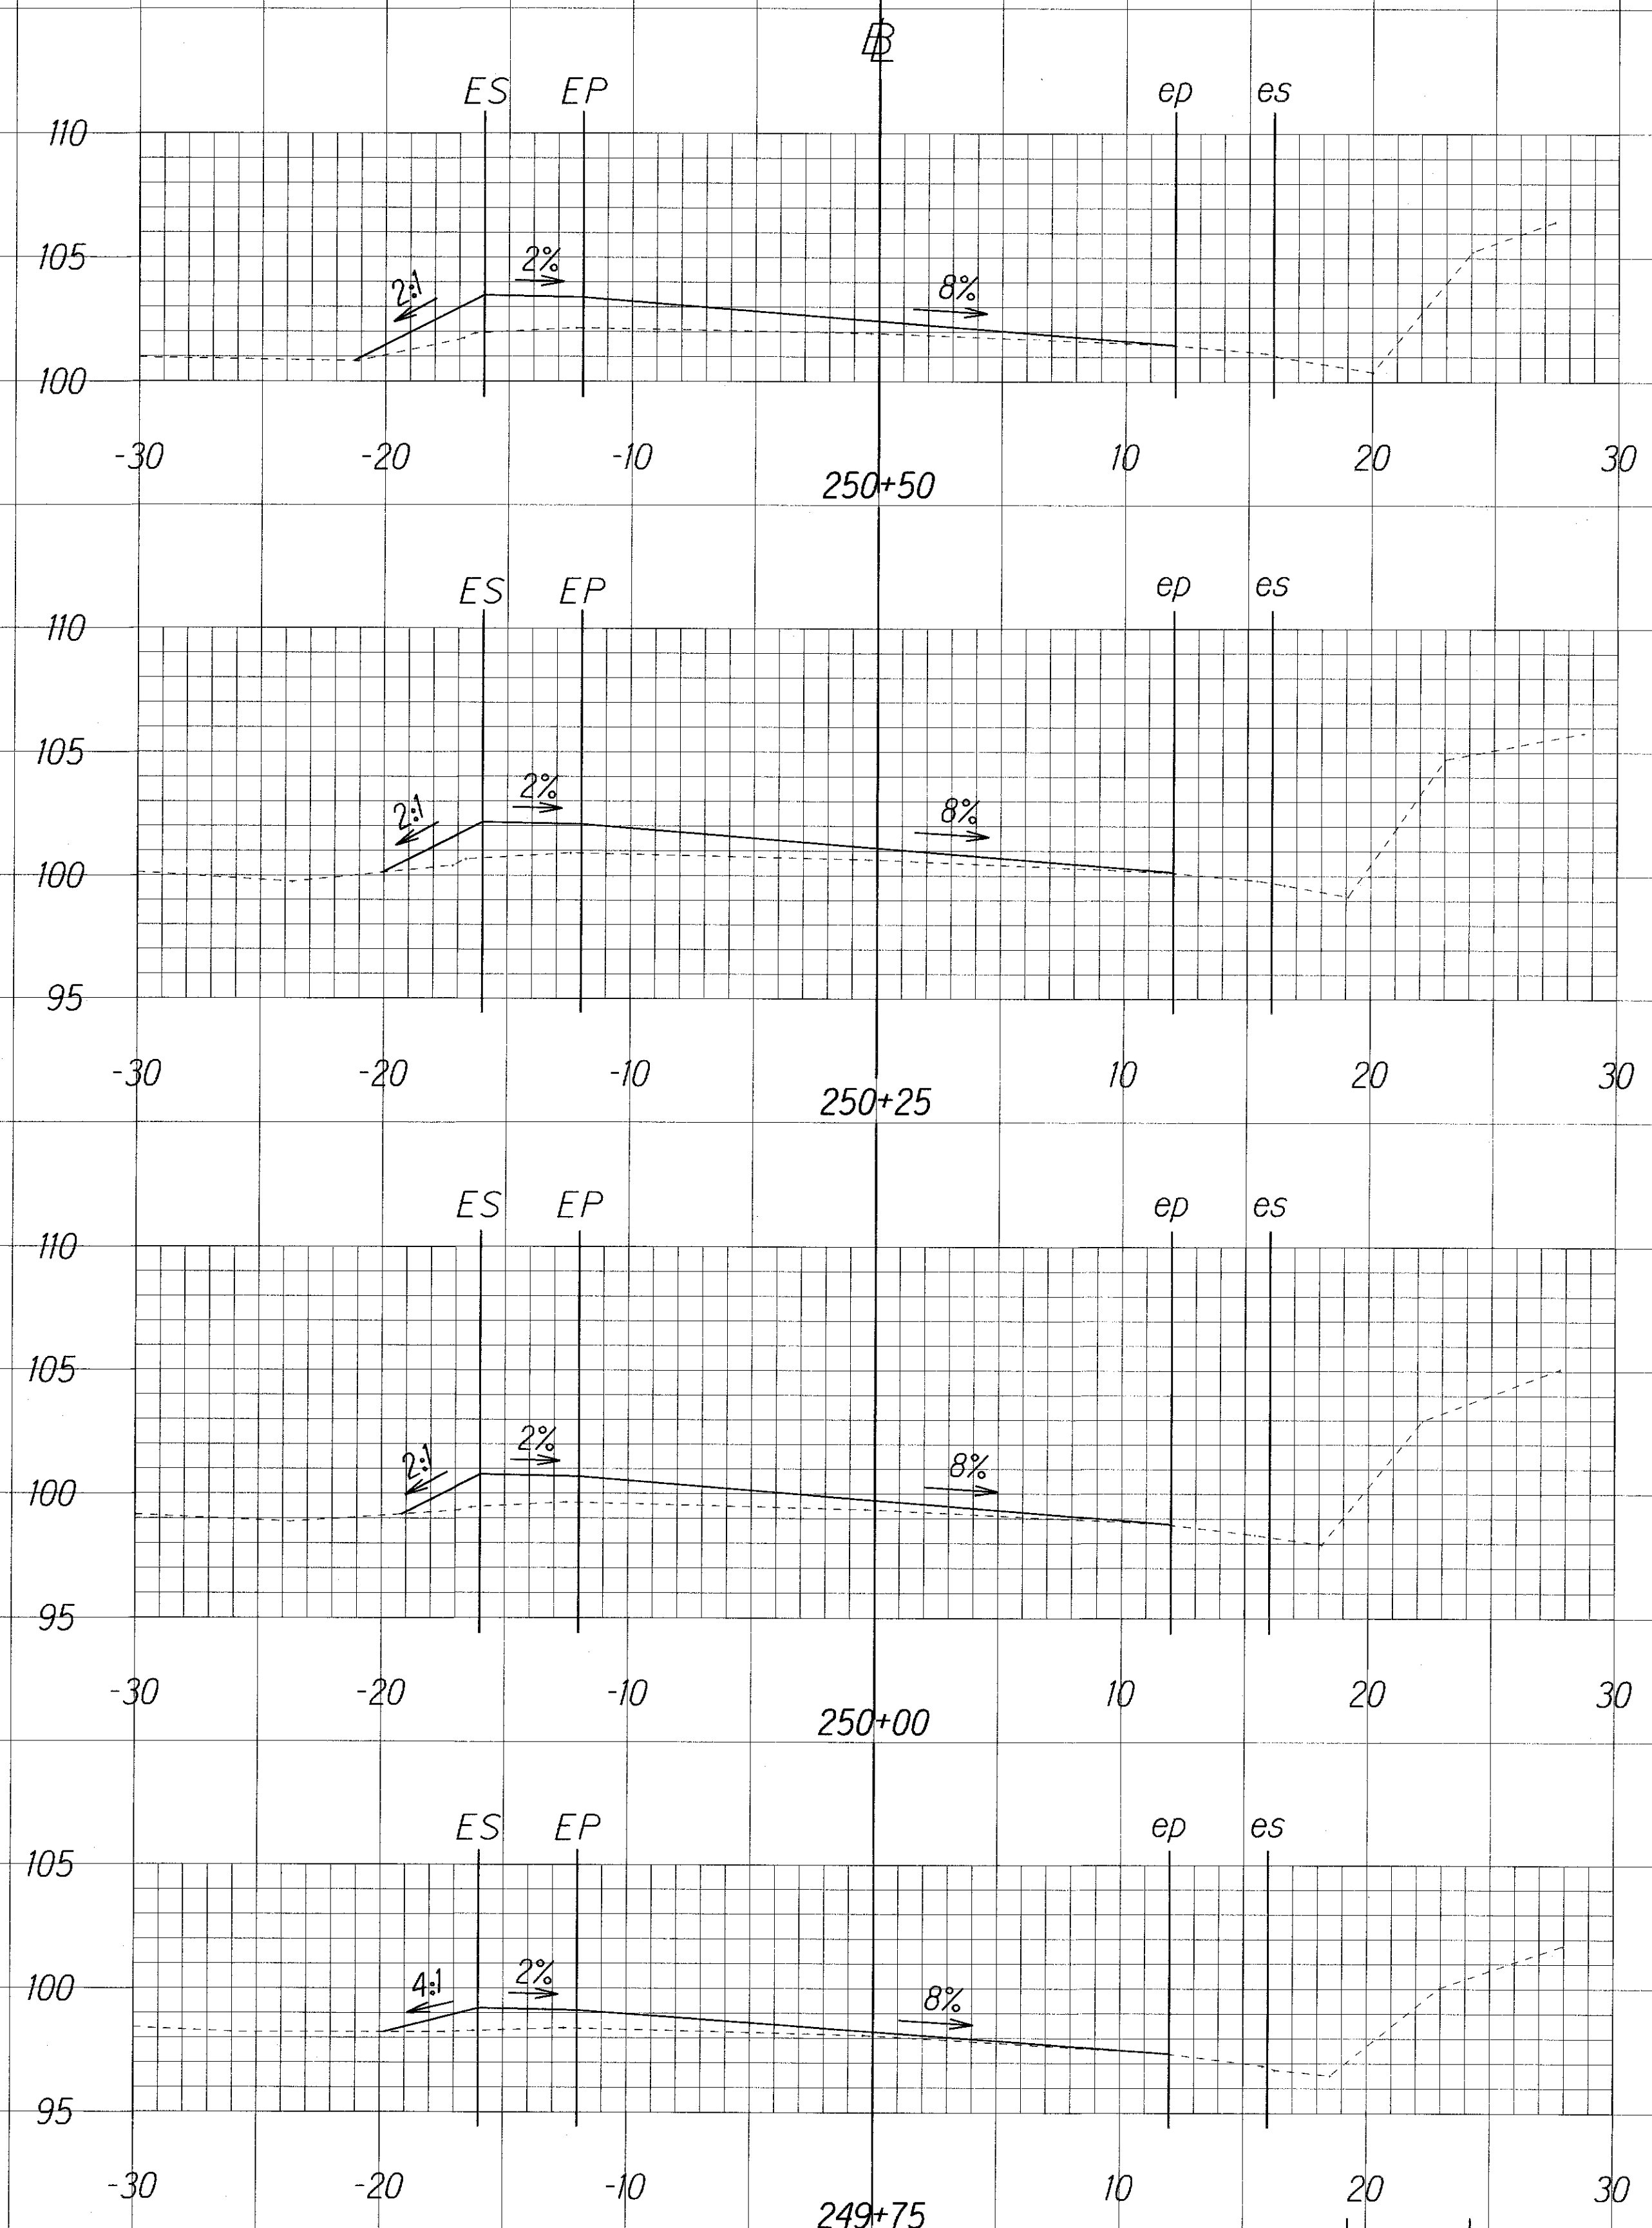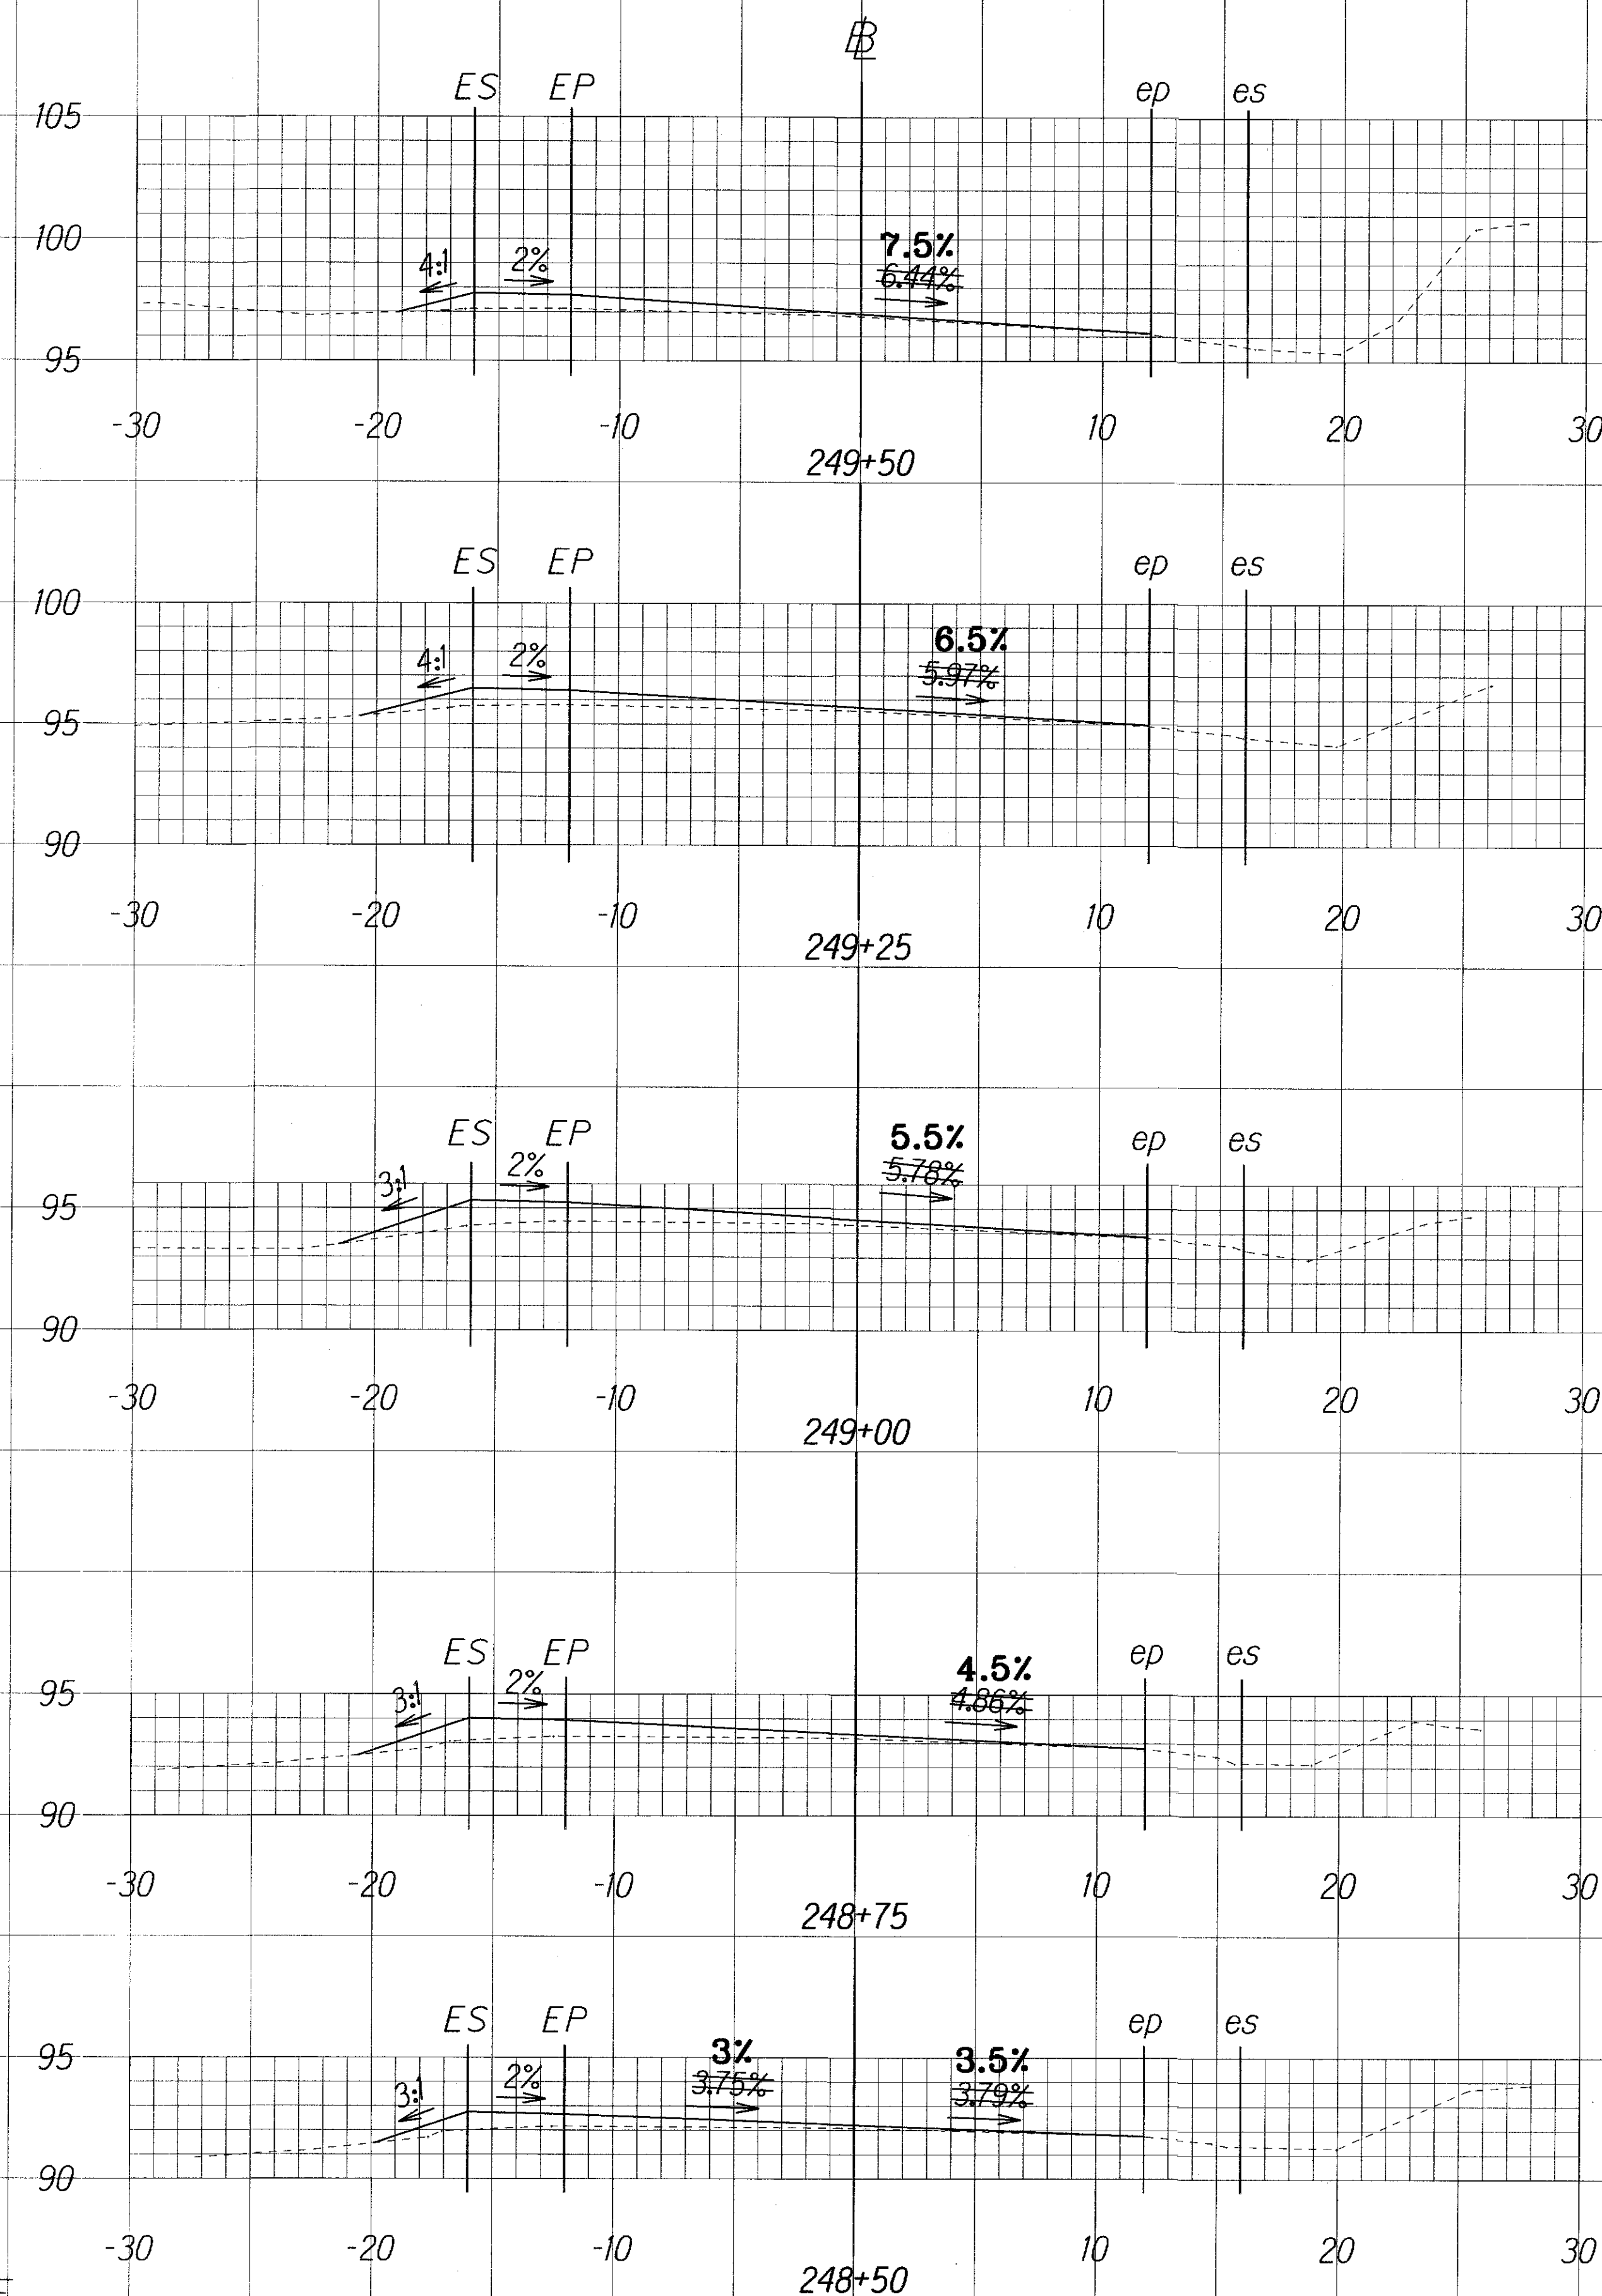

LEGEND FOR AS-BUILT POSTINGS	
~~~~~	Squiggly line for as-built deletion
###	Double line for as-built deletion
~~~~~ Roadway	Text for as-built posting

ORIGINAL PLAN	SURVEY PLOTTED BY _____	DATE _____
	DRAWN BY <u>X</u>	<u>X</u>
NOTE BOOK	DESIGNED BY _____	_____
<u>tbl neg</u>	TRANSMITTED BY _____	_____
<u>transmitt. addl</u>	QUANTITIES BY _____	_____
	CHECKED BY _____	_____
No _____		



SCALE
Horizontal: 1"=5'
Vertical: 1"=5'

9/15/09	Revised Shoulder Slopes.		
DATE	REVISION		
SHEET No. 2 OF 8 SHEETS			

"AS-BUILT"

ADD. 28

	FED. ROAD DIST. NO.	STATE	FED. AID PROJ. NO.	FISCAL YEAR	SHEET NO.	TOTAL SHEETS
	HAWAII	HAW.	HSIP-011-2(37)	2009	ADD. 29	34

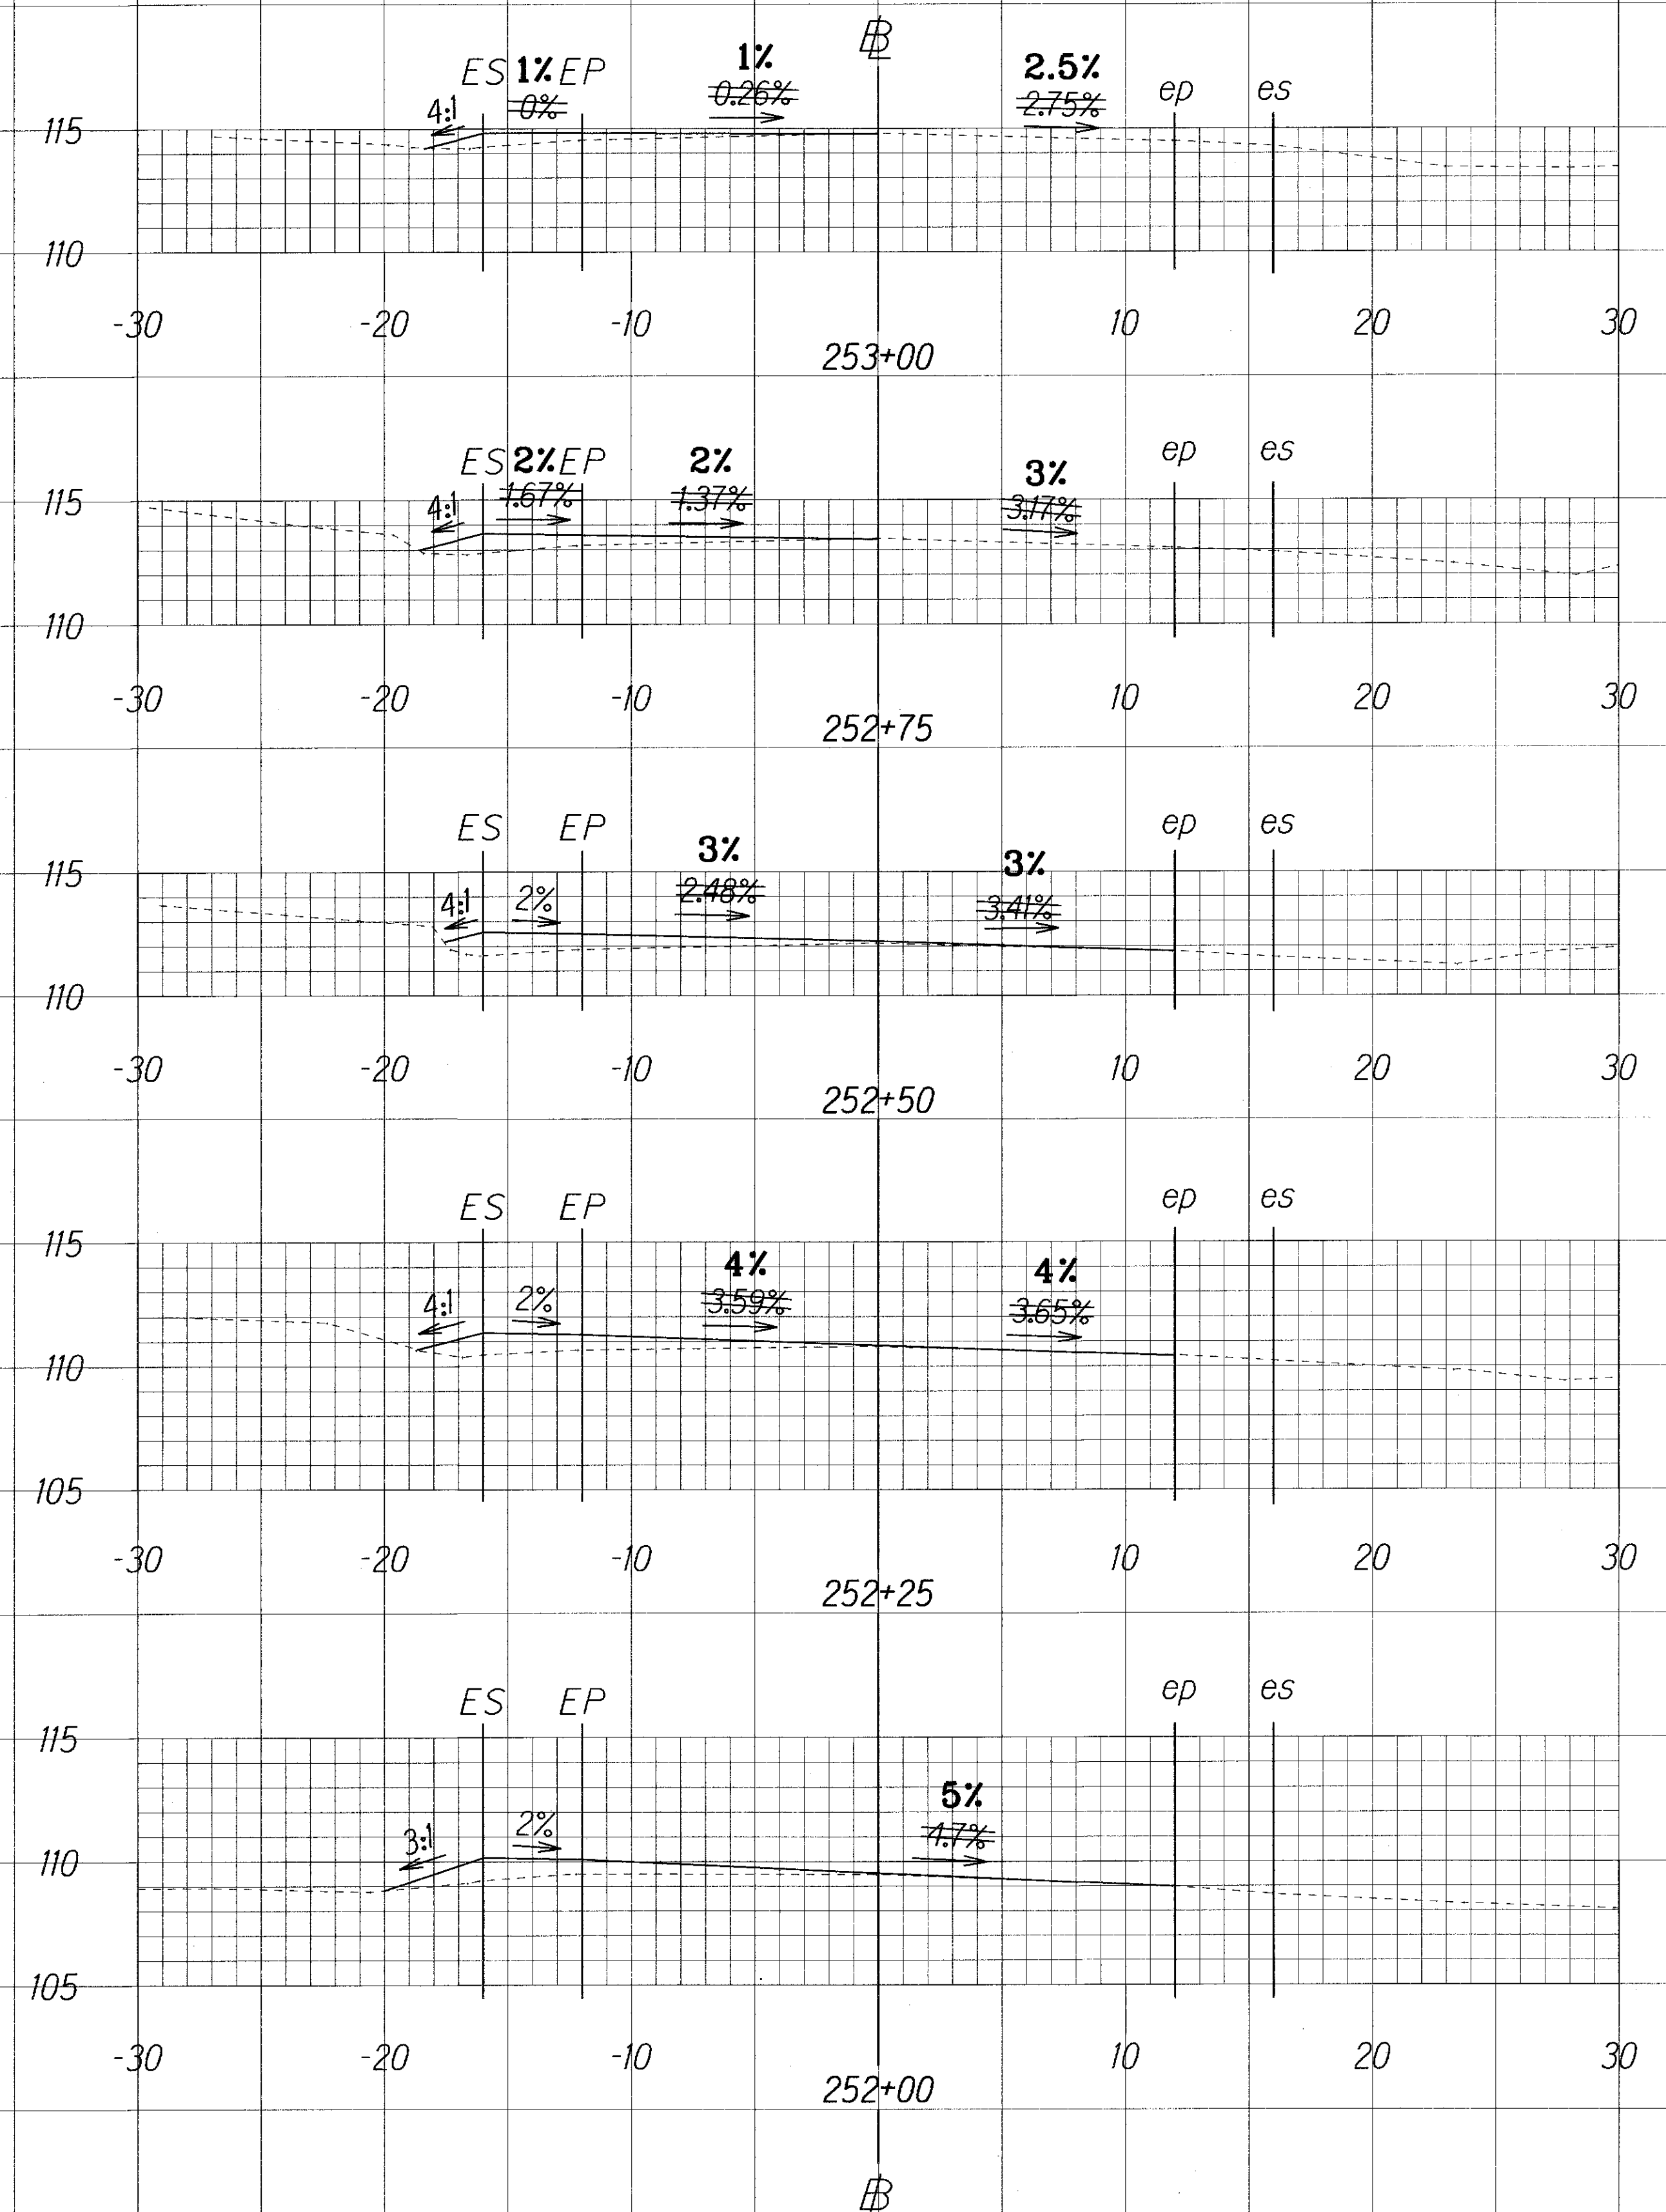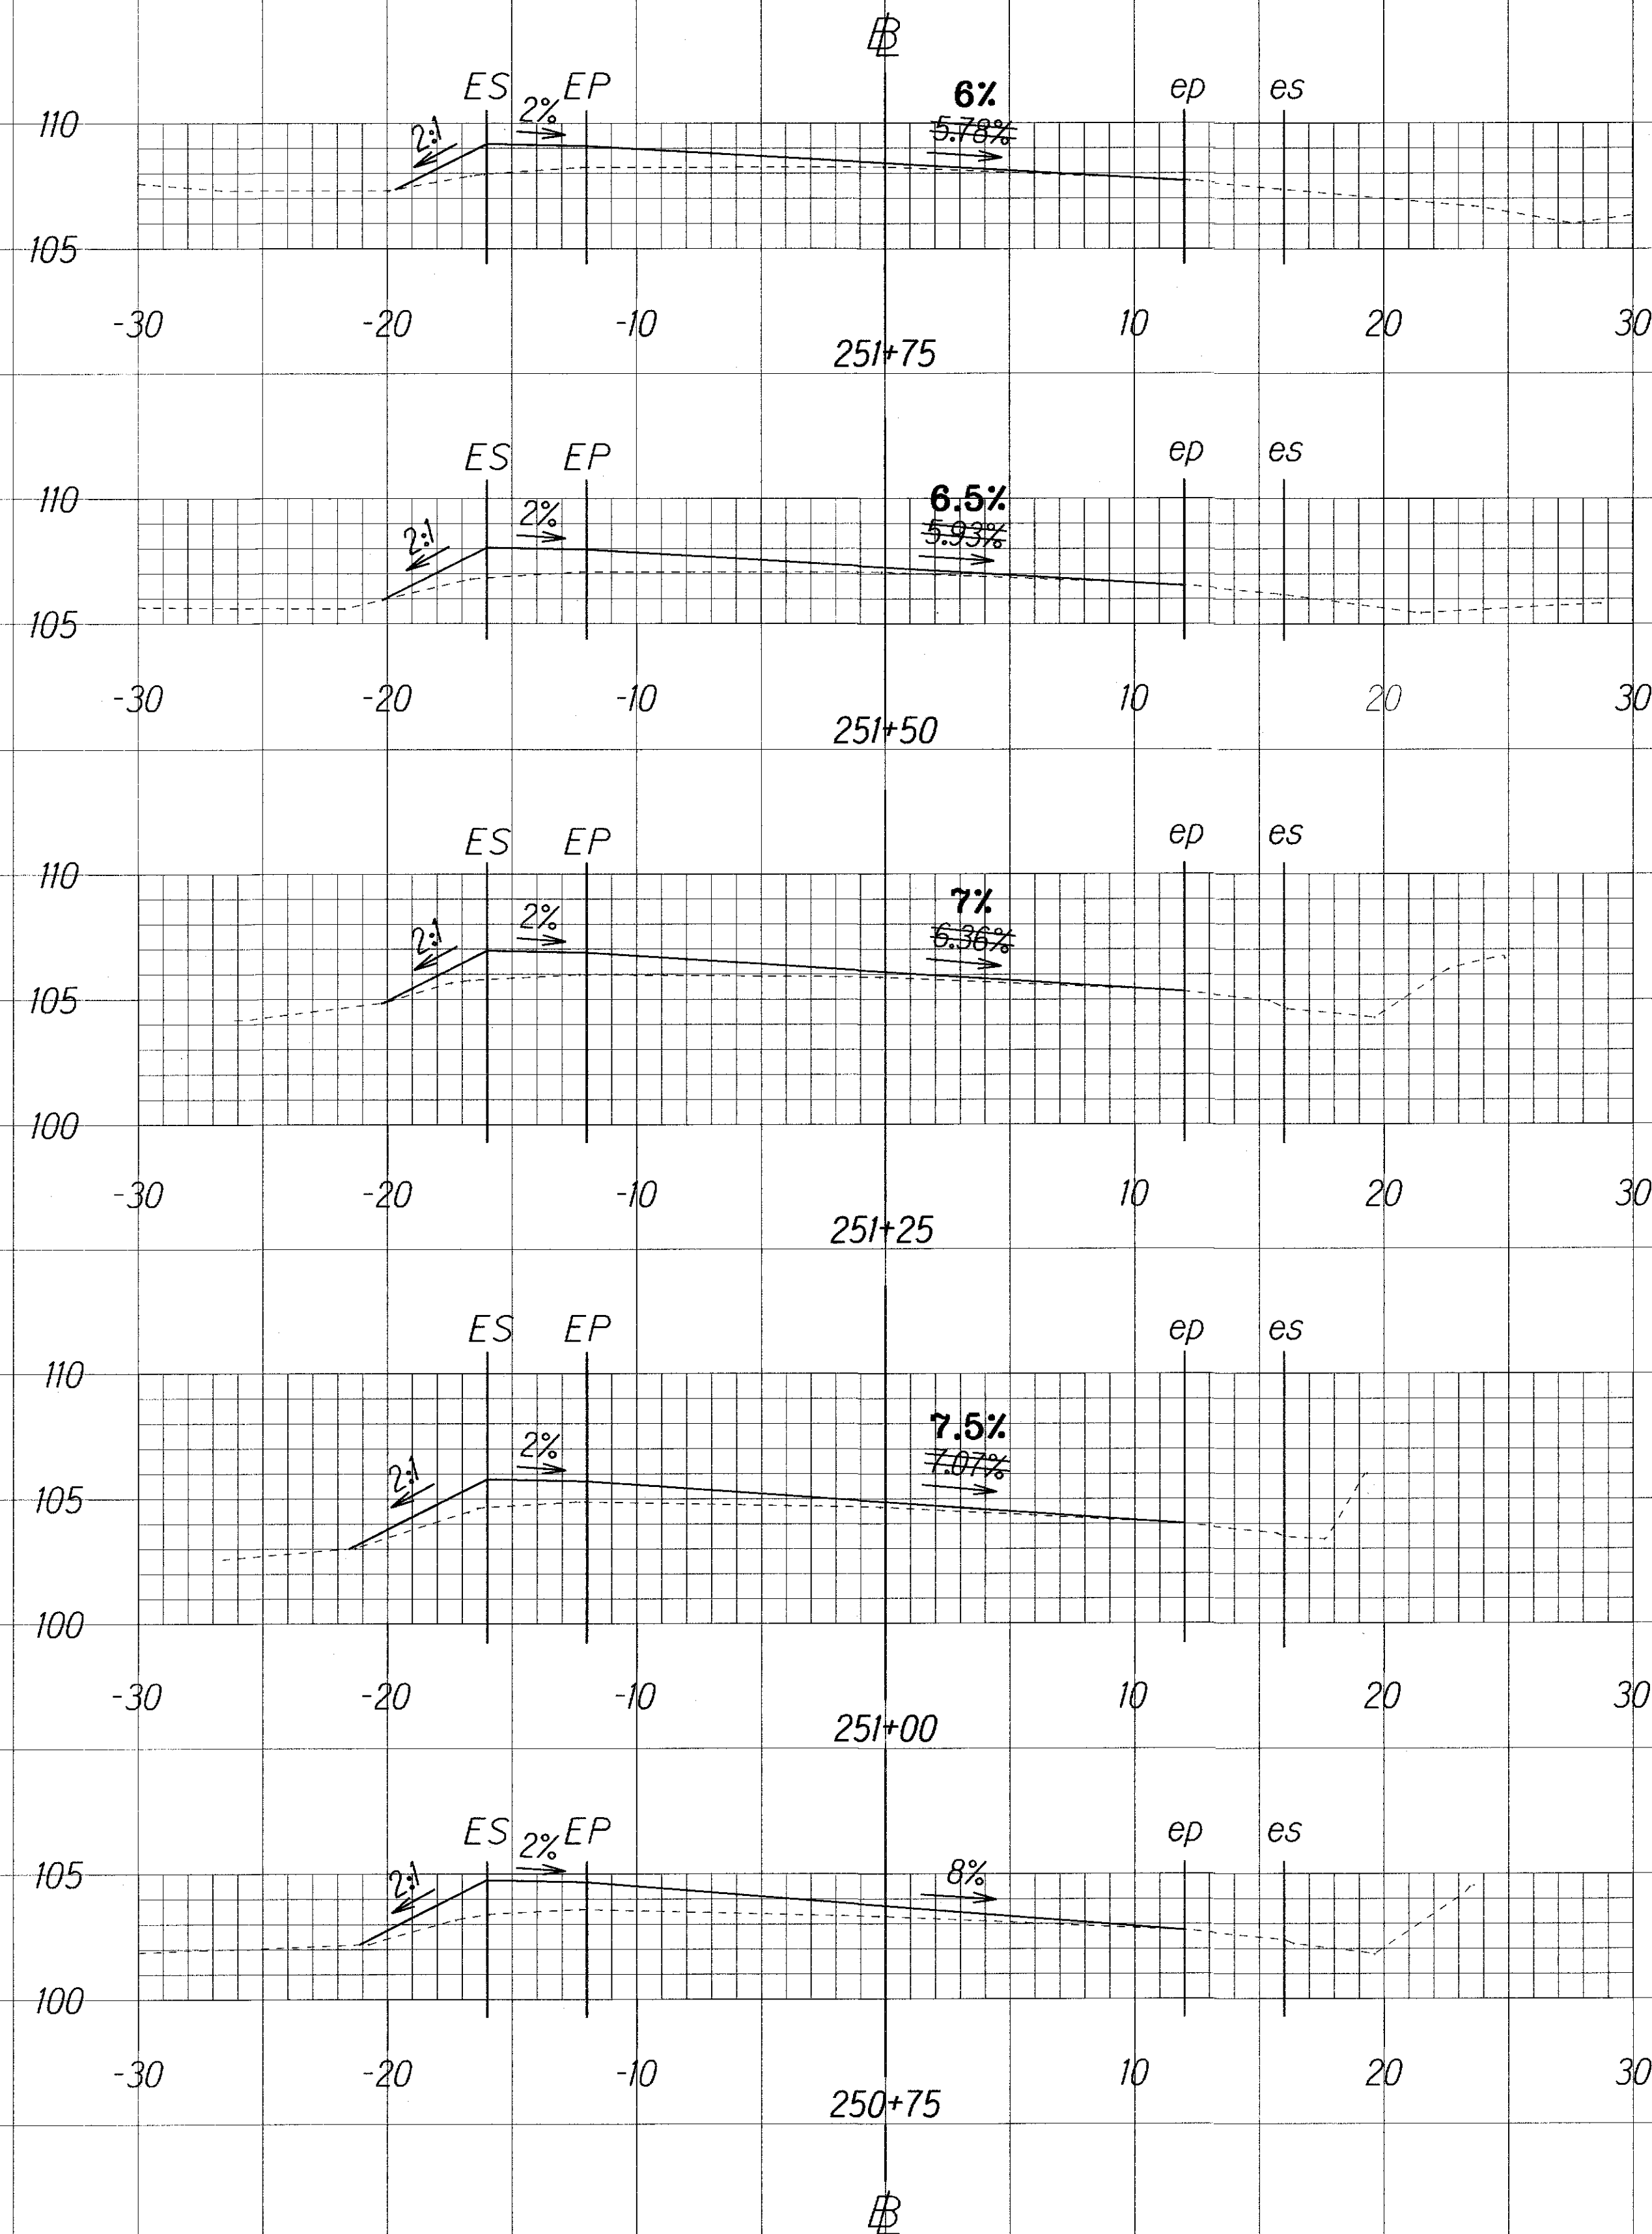

SCALE

Horizontal: $1''=5'$
Vertical: $1''=5'$

9/15/09 Revised Shoulder Slopes.

DATE	REVISION
------	----------


SHEET No. 3 OF 8 SHEETS

"AS-BUILT"

ADD. 29

FED. ROAD DIST. NO.	STATE	FED. AID PROJ. NO.	FISCAL YEAR	SHEET NO.	TOTAL SHEETS
HAWAII	HAW.	HSIP-011-2(37)	2009	ADD. 30	34

NOTE:
SAME CROSS SECTION CONTINUES TO STA. 255+50

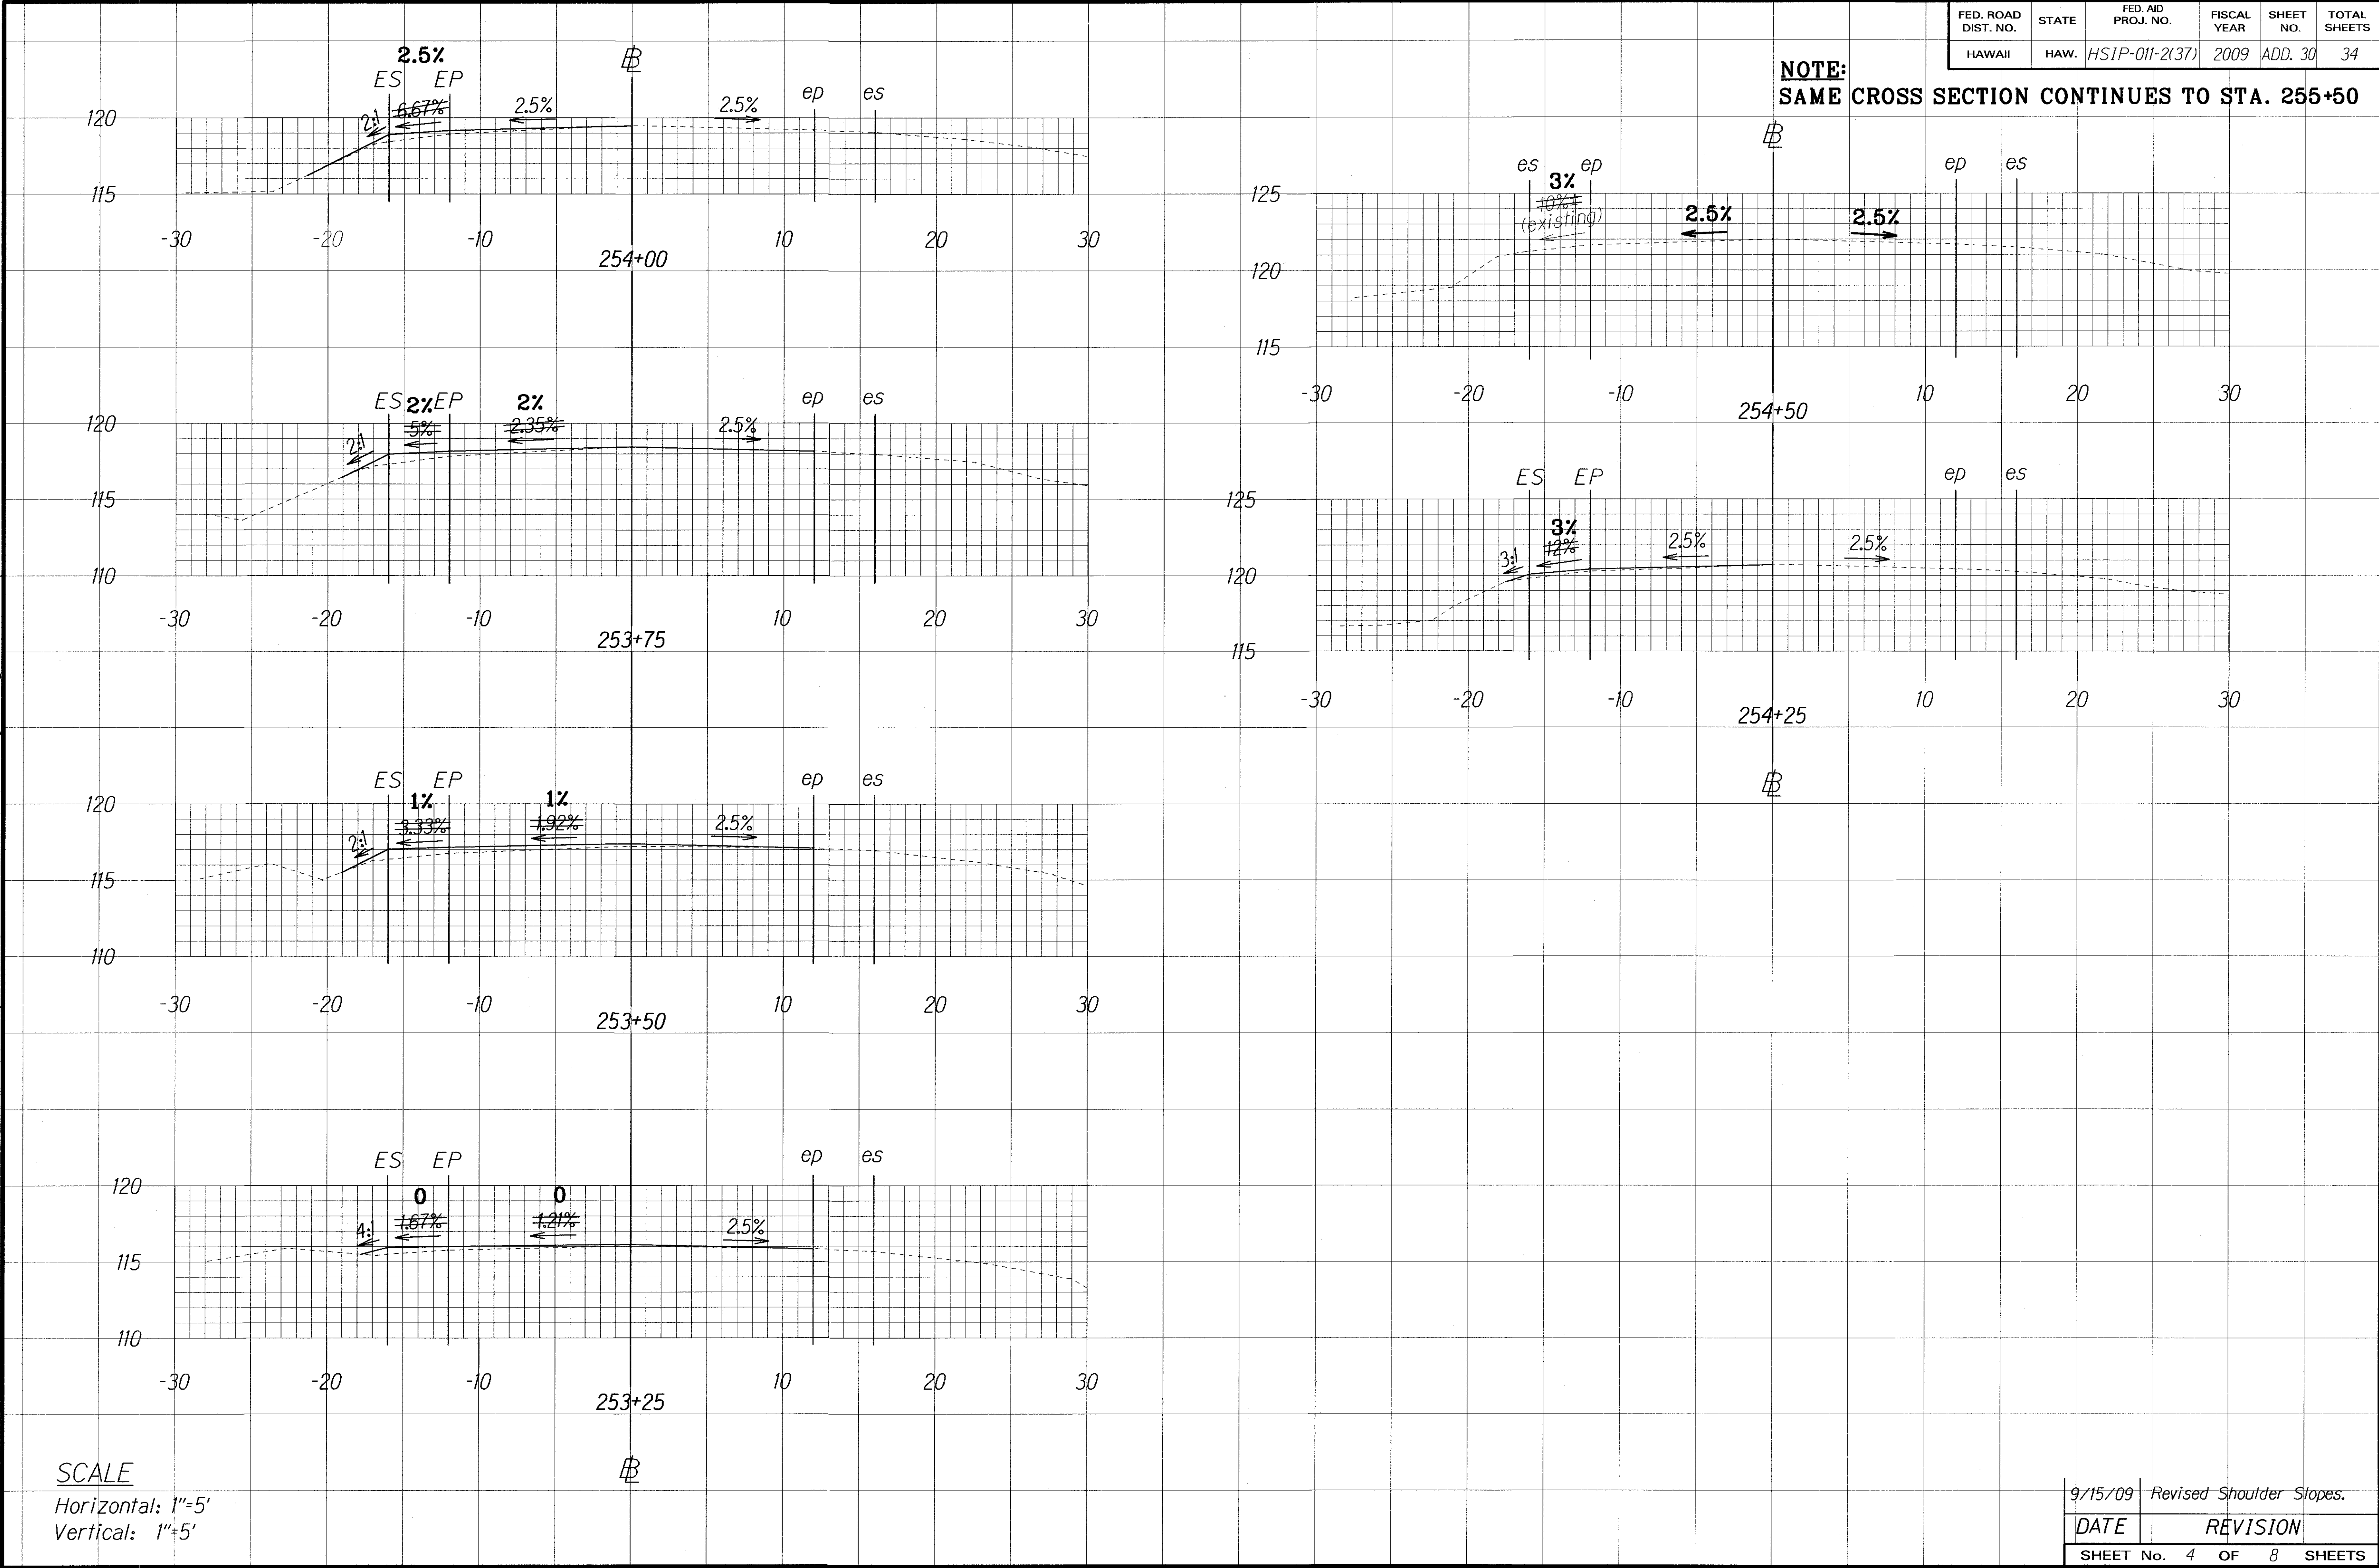

LEGEND FOR AS-BUILT POSTINGS
Squiggly line for as-built deletion
Double line for as-built deletion
Roadway Text for as-built posting

ORIGINAL PLAN	SURVEY PLOTTED BY	DATE
NOTE BOOK	DRAWN BY	
12/2/09	CHECKED BY	
12/2/09	QUANTITIES BY	
12/2/09	CHECKED BY	

SCALE
Horizontal: 1"=5'
Vertical: 1"=5'

9/15/09	Revised Shoulder Slopes.
DATE	REVISION
SHEET No. 4	OF 8 SHEETS

FED. ROAD DIST. NO.	STATE	FED. AID PROJ. NO.	FISCAL YEAR	SHEET NO.	TOTAL SHEETS
HAWAII	HAW.	HSIP-011-2(37)	2009	ADD. 31	34

LEGEND FOR AS-BUILT POSTINGS

Squiggly line for as-built deletion

Double line for as-built deletion

Roadway

Text for as-built posting

ORIGINAL PLAN

SURVEY PLOTTED BY

DRAWN BY

TRACED BY

NOTED BY

QUANTITIES BY

CHECKED BY

DATE

10/2/09

10/2/09

SCALE

Horizontal: 1"=5'

Vertical: 1"=5'



2%

4%

265+00

NOTE:

REPAIRED DIP IN ROAD AT STA. 265+00 TO STA. 265+50

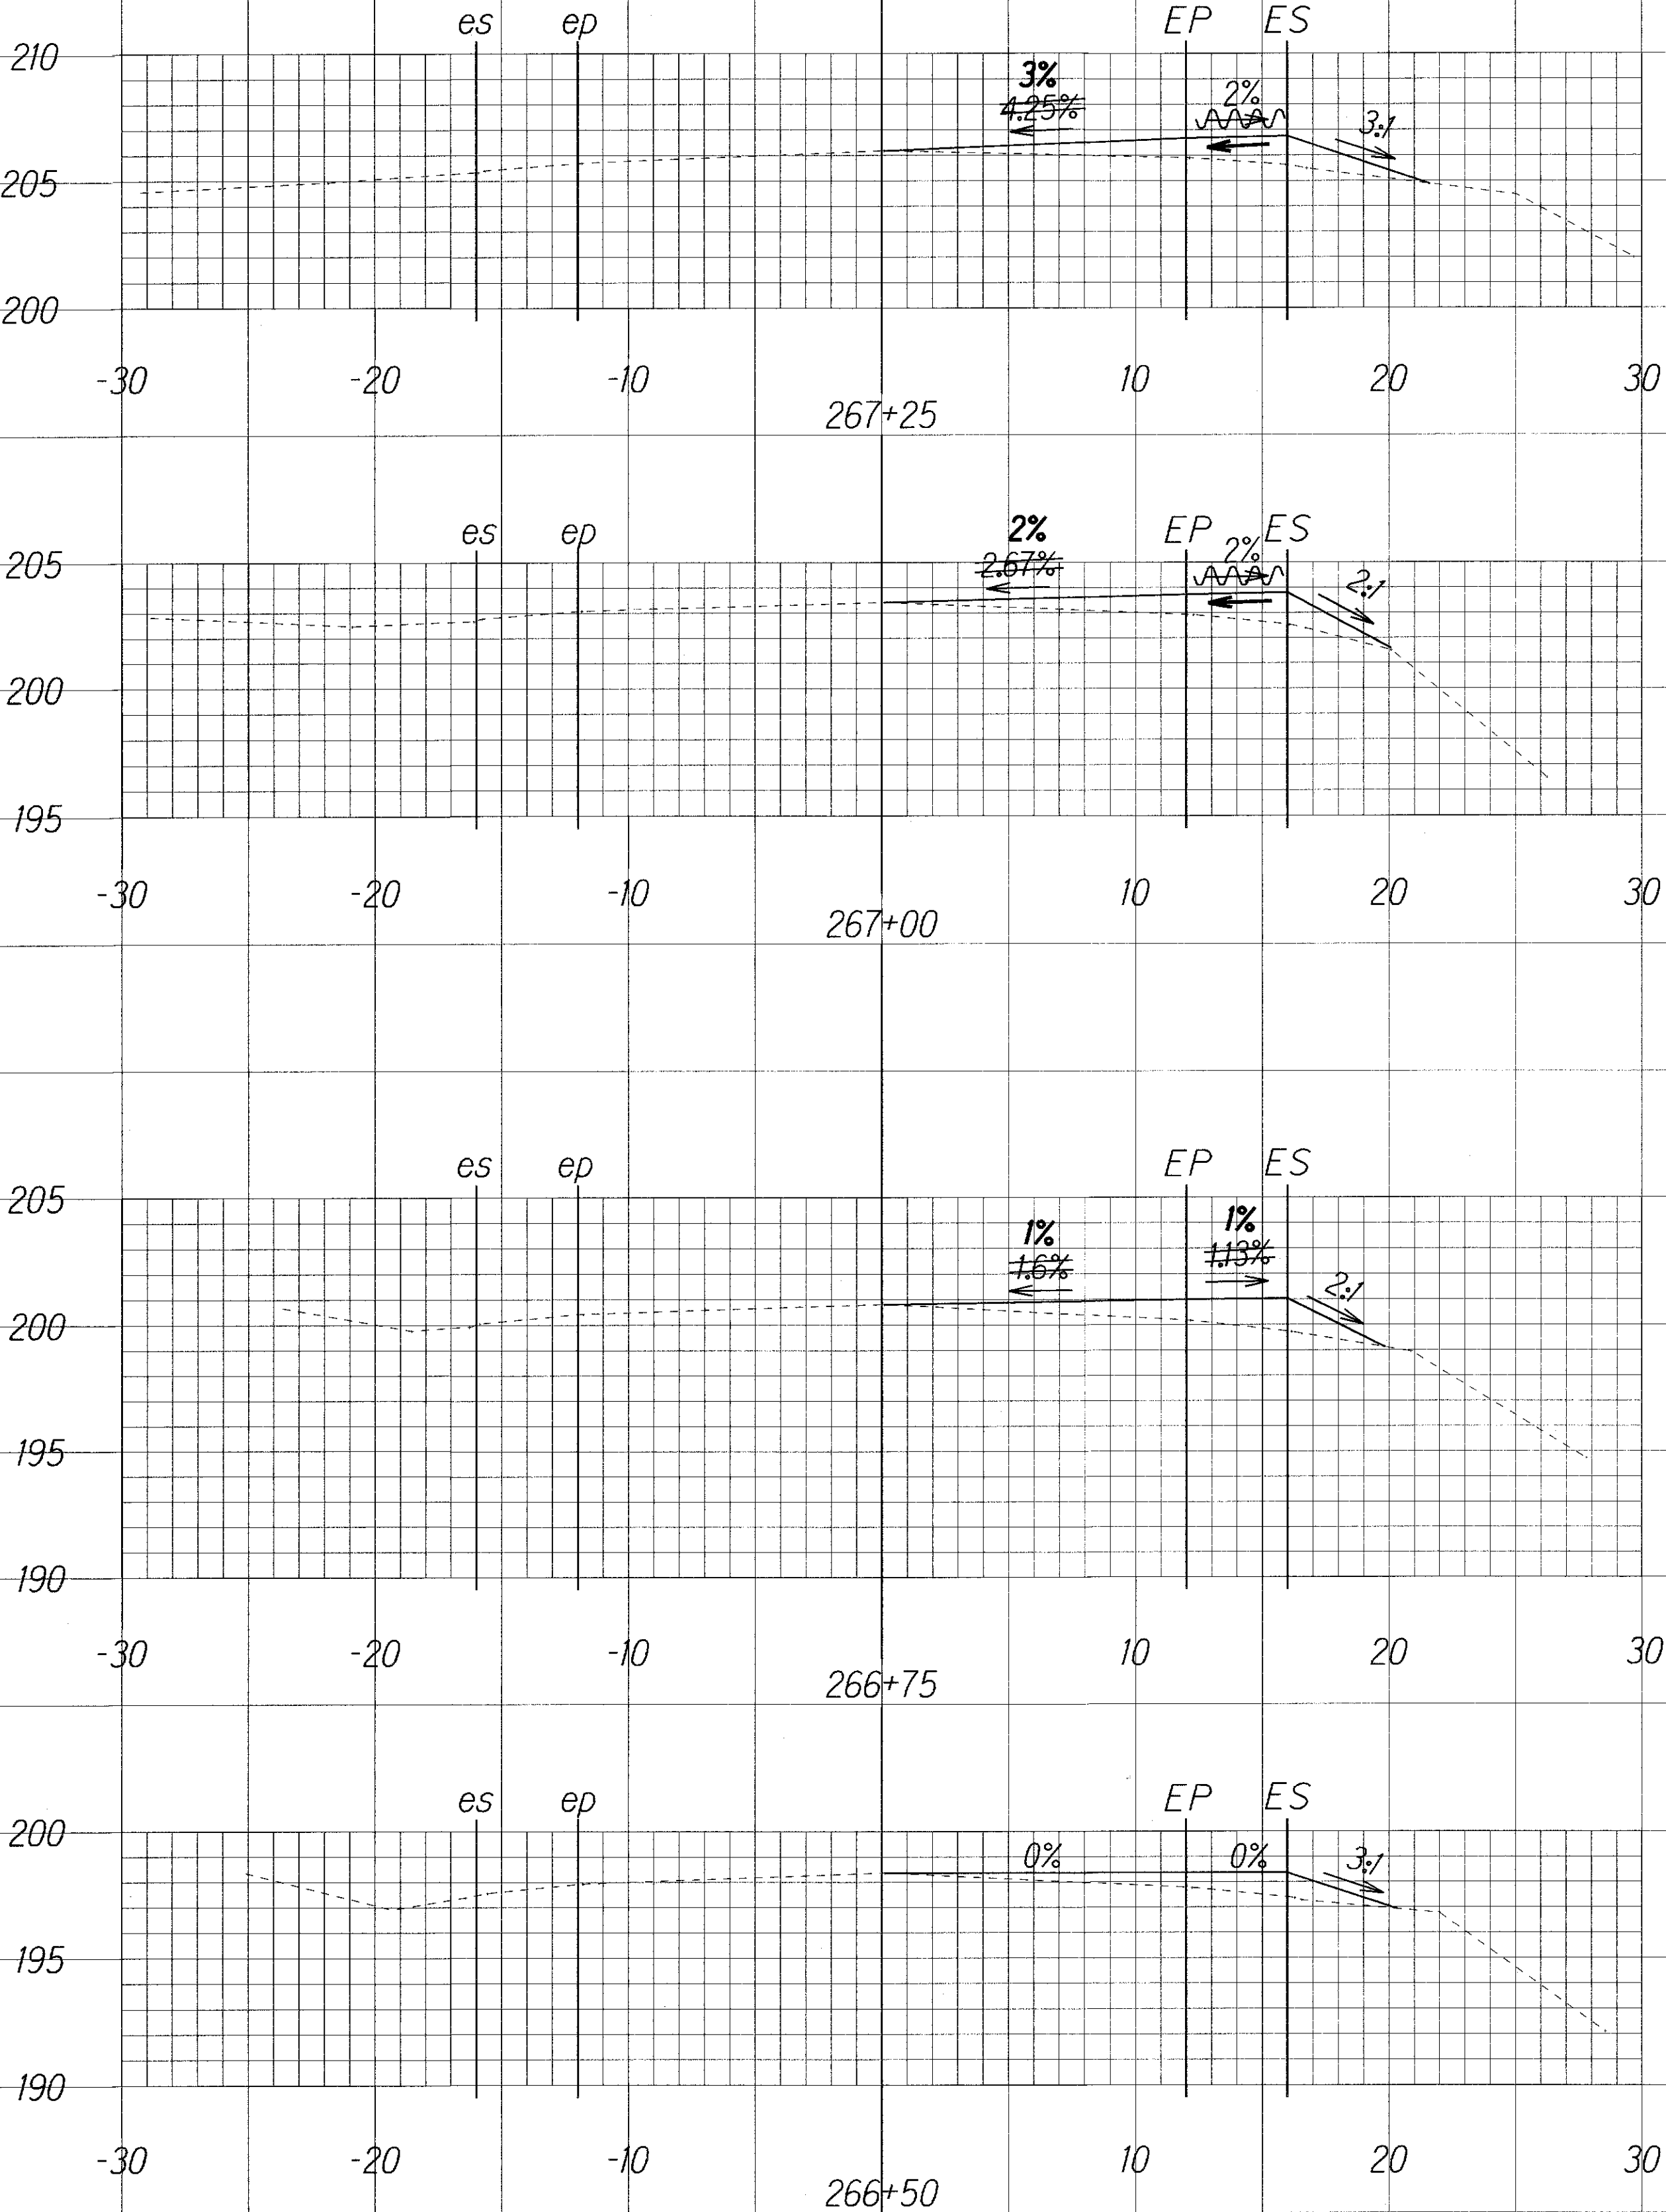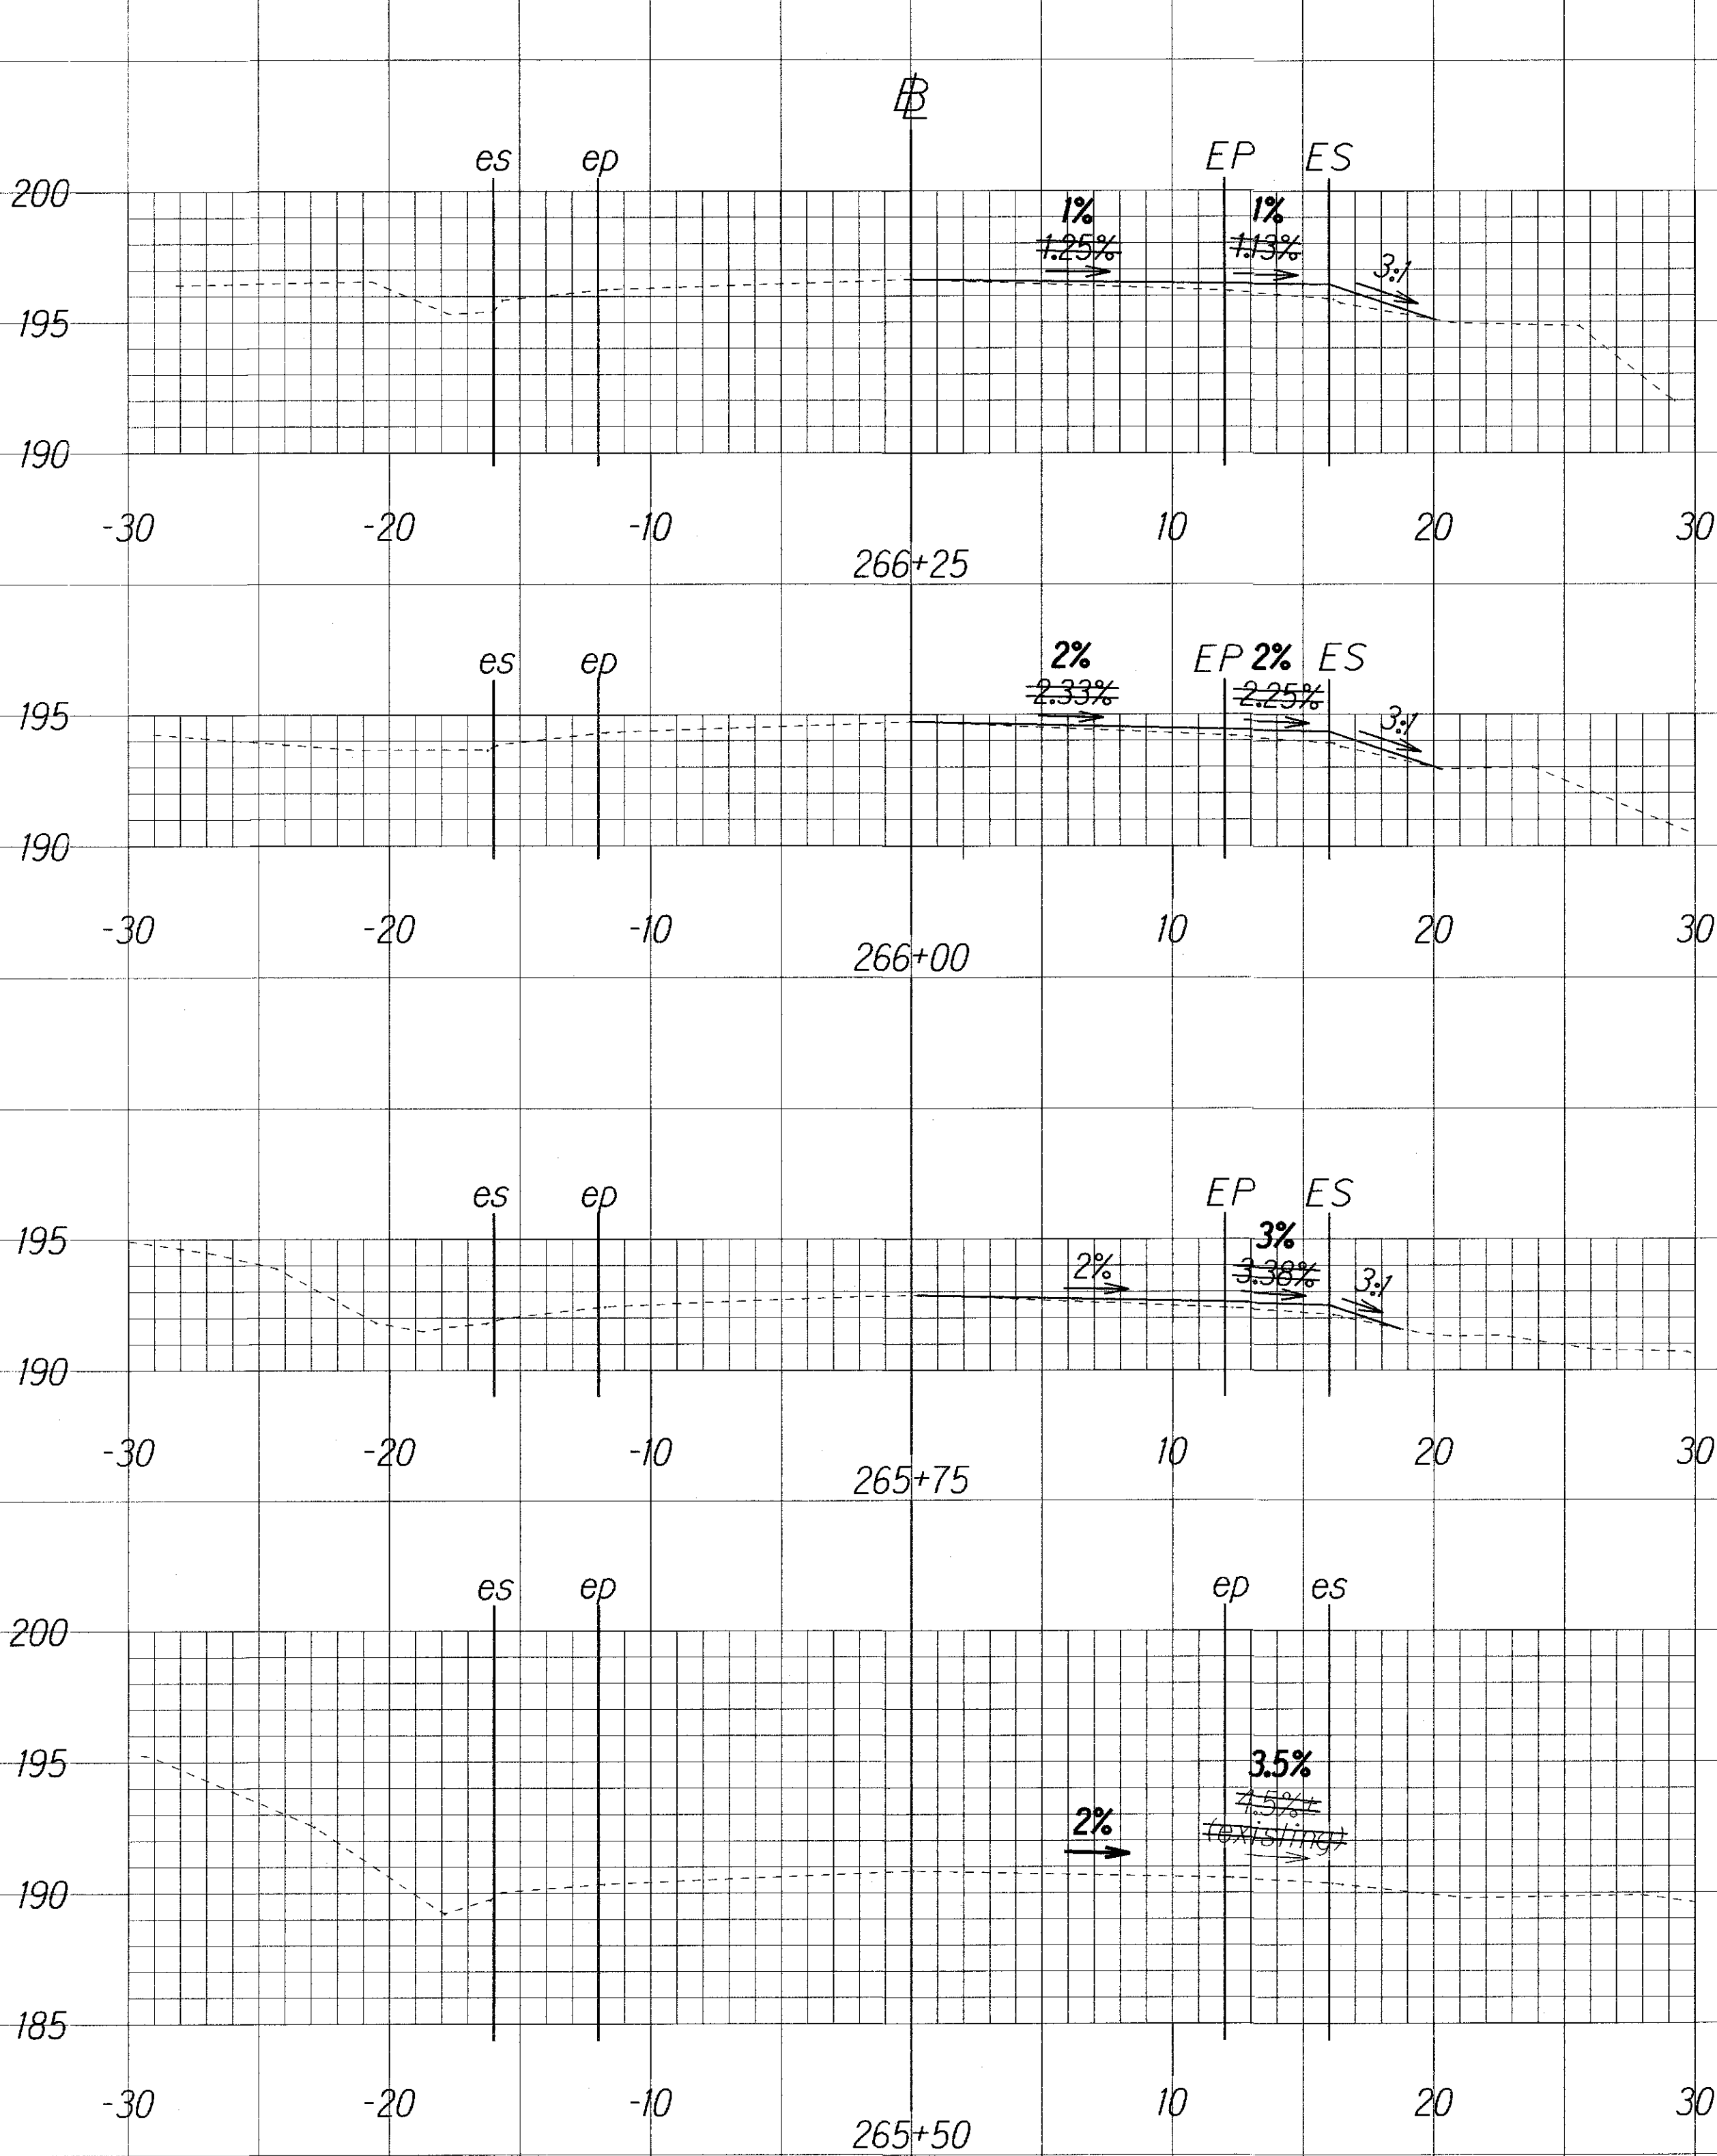

9/15/09	Revised Shoulder Slopes.
DATE	REVISION
SHEET No. 5	OF 8 SHEETS

FED. ROAD DIST. NO.	STATE	FED. AID PROJ. NO.	FISCAL YEAR	SHEET NO.	TOTAL SHEETS
HAWAII	HAW.	HSIP-011-2(37)	2009	ADD. 32	34

LEGEND FOR AS-BUILT POSTINGS

~~~~~ Squiggly line for as-built deletion

==== Double line for as-built deletion

##### Roadway



Text for as-built posting

|               |                   |      |
|---------------|-------------------|------|
| ORIGINAL PLAN | SURVEY PLOTTED BY | DATE |
| NOTE BOOK     | DRAWN BY          |      |
| Field         | DESIGNED BY       |      |
| Revised       | QUANTITIES BY     |      |
| SA            | CHECKED BY        |      |

SCALE

Horizontal: 1"=5'

Vertical: 1"=5'

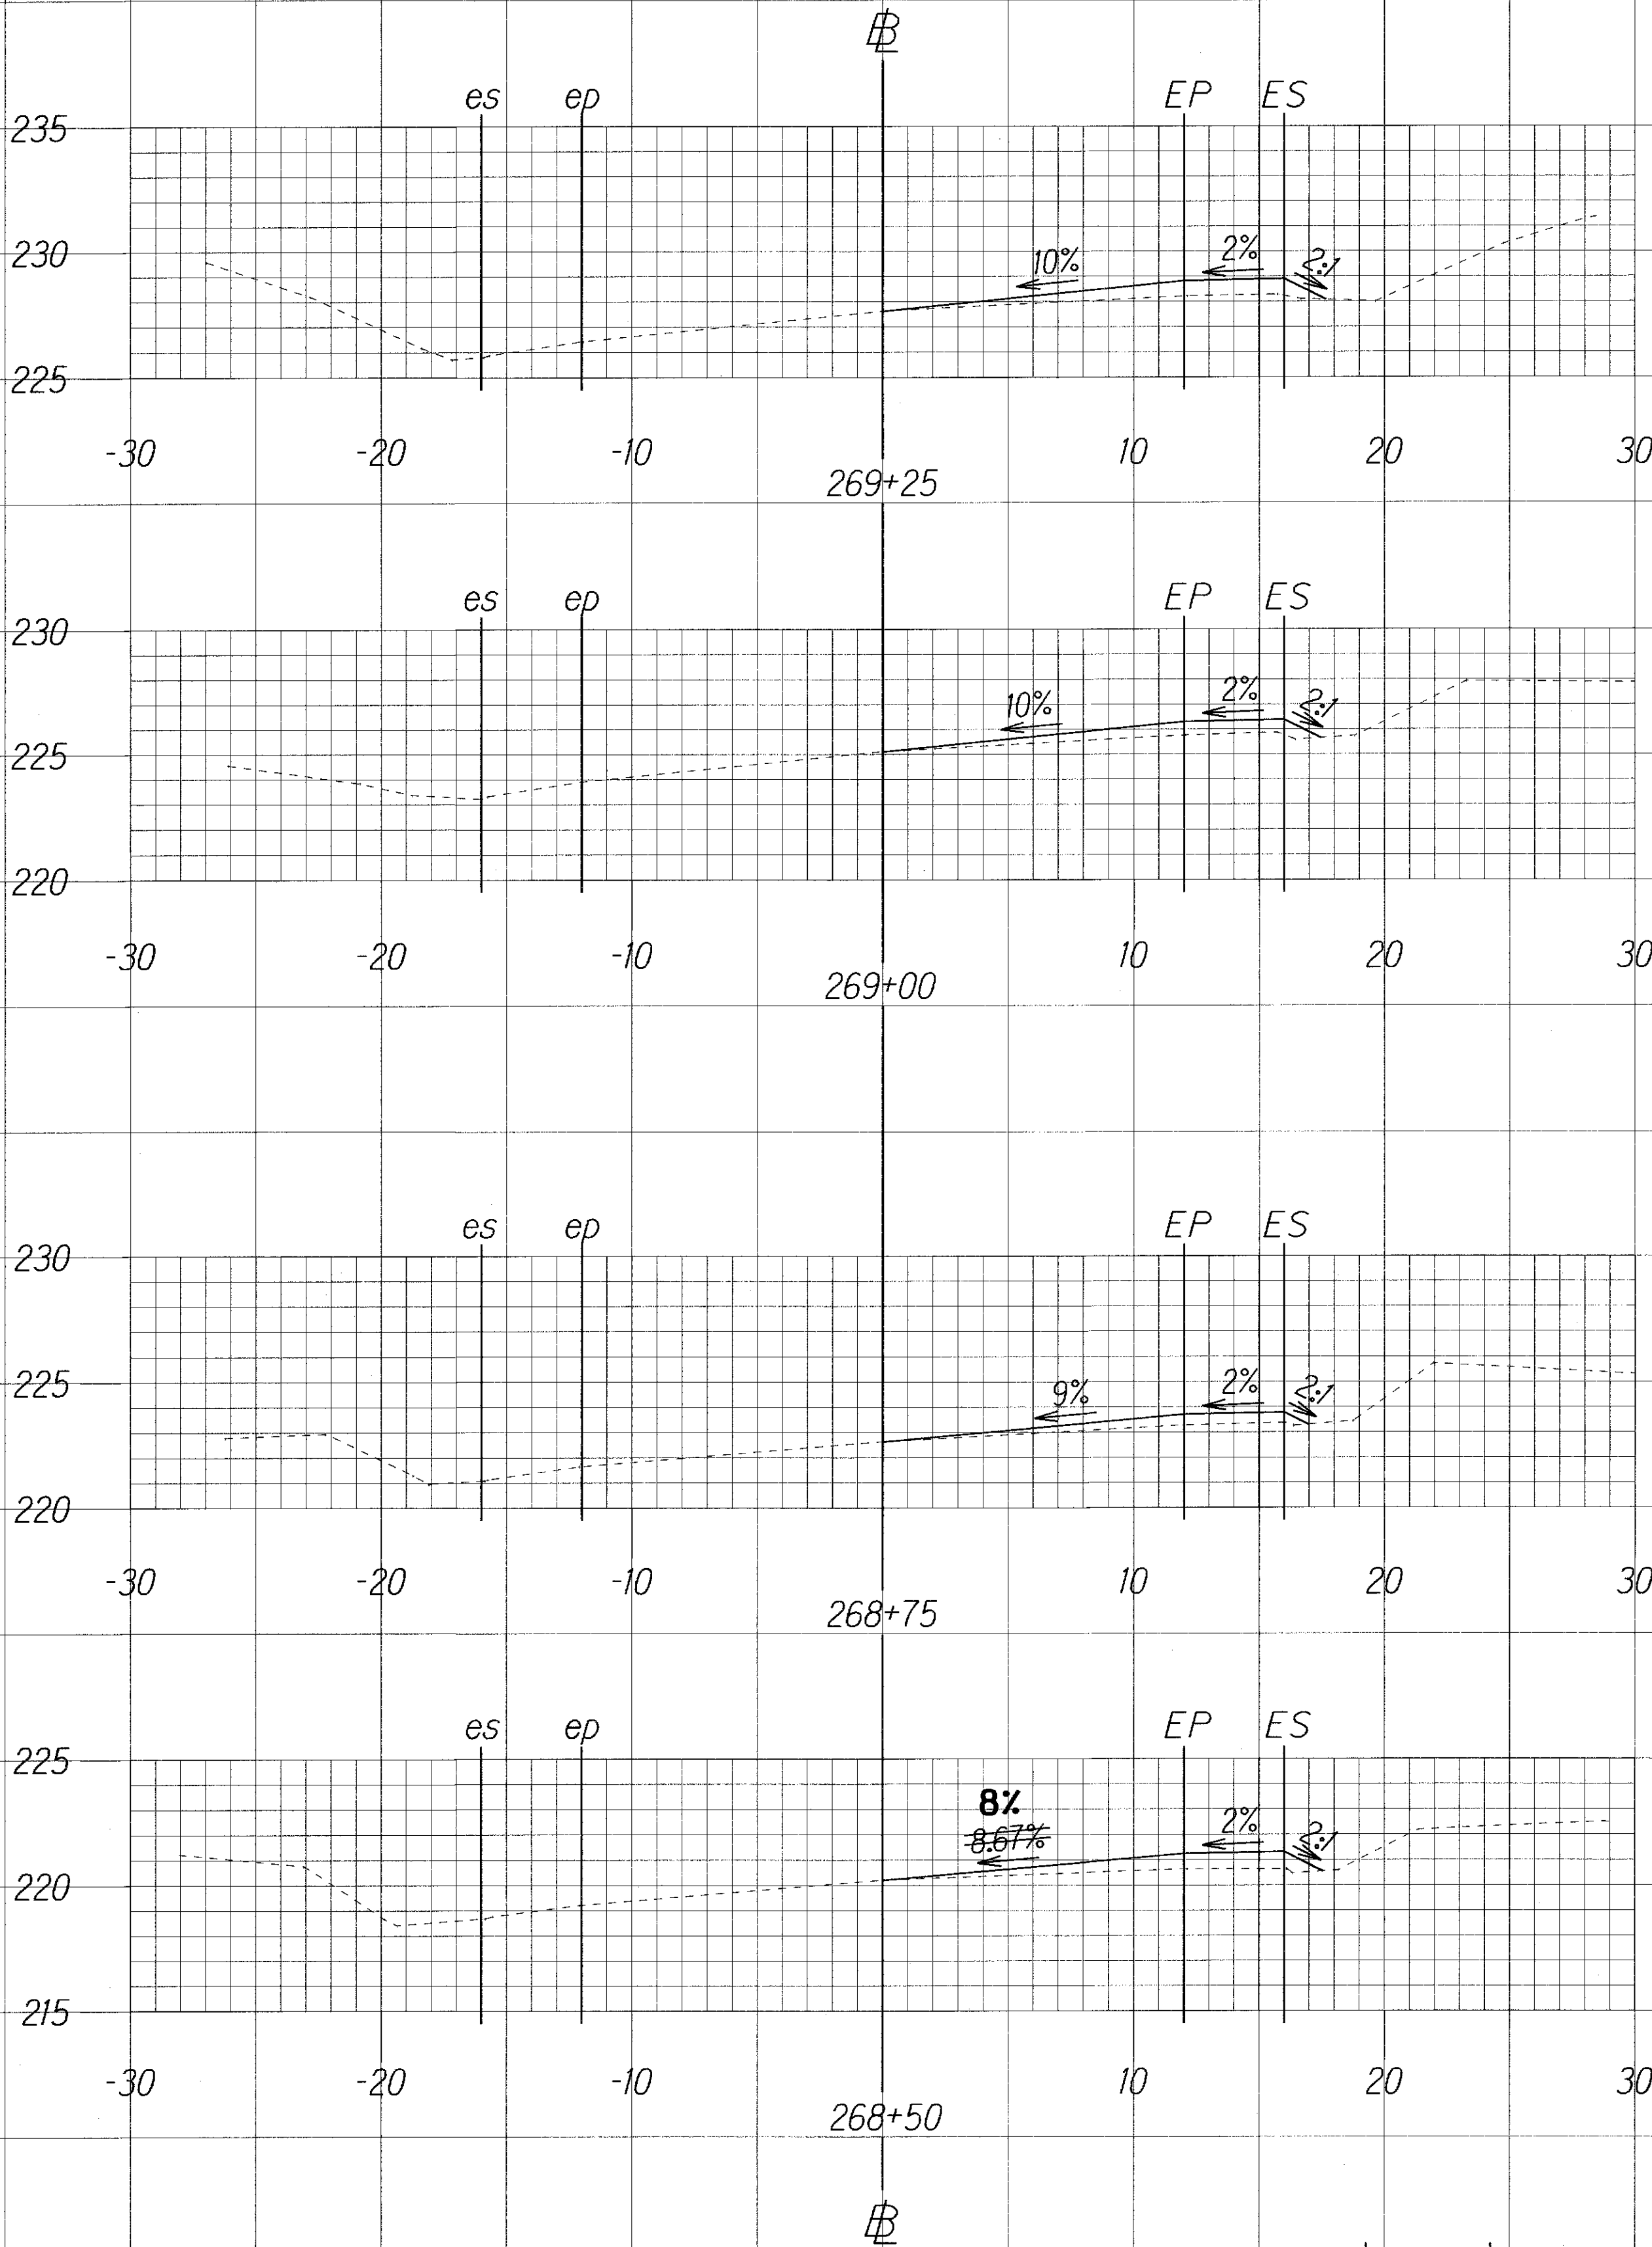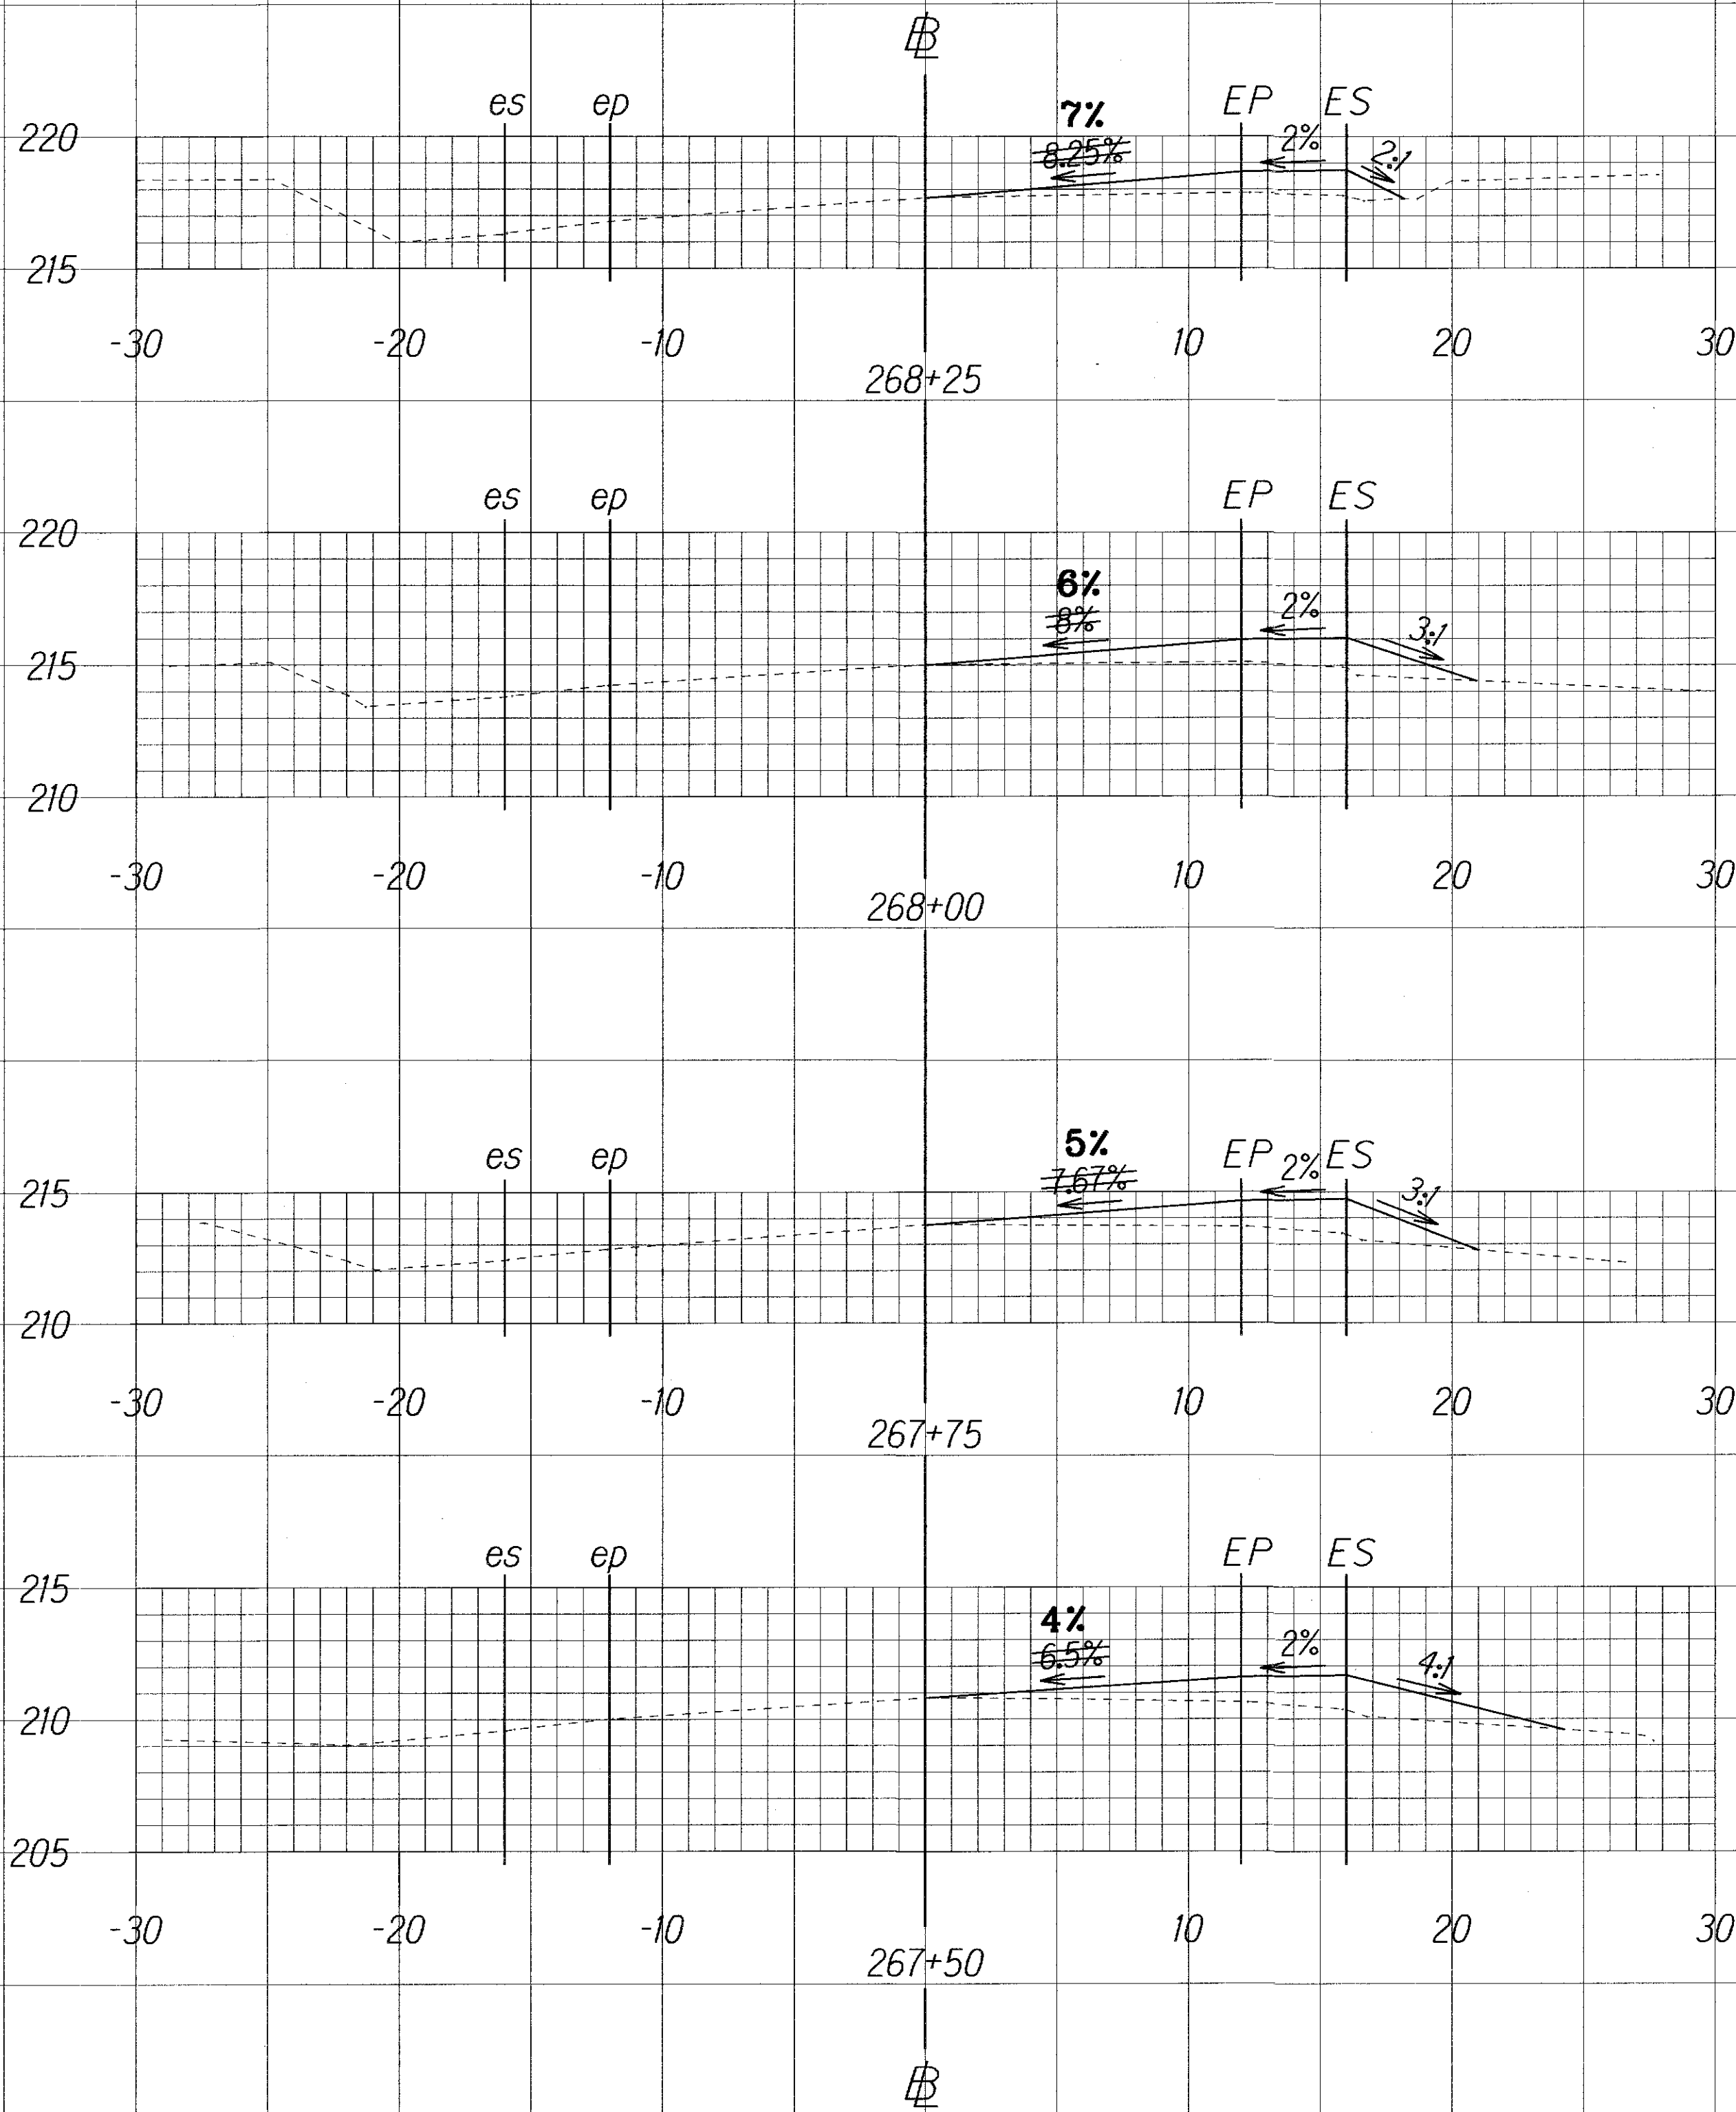

|             |                          |
|-------------|--------------------------|
| 9/15/09     | Revised Shoulder Slopes. |
| DATE        | REVISION                 |
| SHEET No. 6 | OF 8 SHEETS              |

"AS-BUILT"

ADD. 32

| FED. ROAD DIST. NO. | STATE | FED. AID PROJ. NO. | FISCAL YEAR | SHEET NO. | TOTAL SHEETS |
|---------------------|-------|--------------------|-------------|-----------|--------------|
| HAWAII              | HAW.  | HSIP-011-K(37)     | 2009        | ADD. 33   | 34           |

LEGEND FOR AS-BUILT POSTINGS

~~~~~ Squiggly line for as-built deletion

==== Double line for as-built deletion









Roadway Text for as-built posting

| | | |
|---------------|-------------------|------|
| ORIGINAL PLAN | SURVEY PLOTTED BY | DATE |
| NOTE BOOK | DRAWN BY | |
| QUANTITIES BY | TRACED BY | |
| CHECKED BY | NOTED BY | |

SCALE

Horizontal: 1"=5'

Vertical: 1"=5'

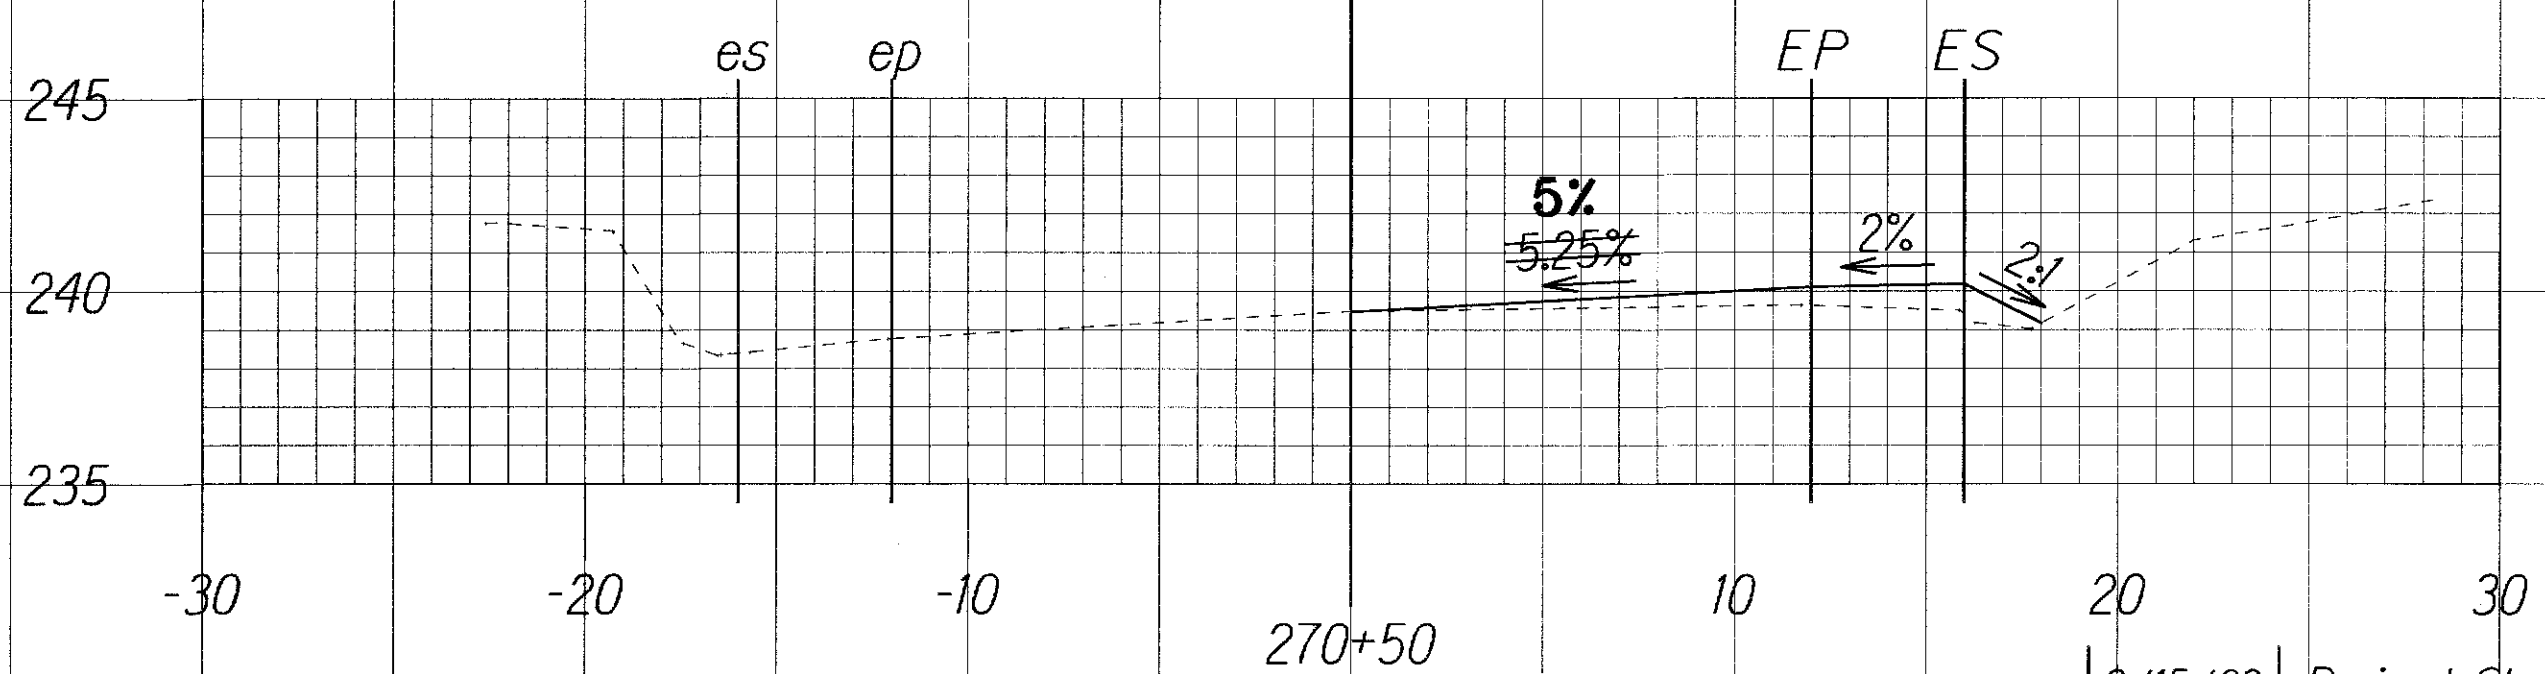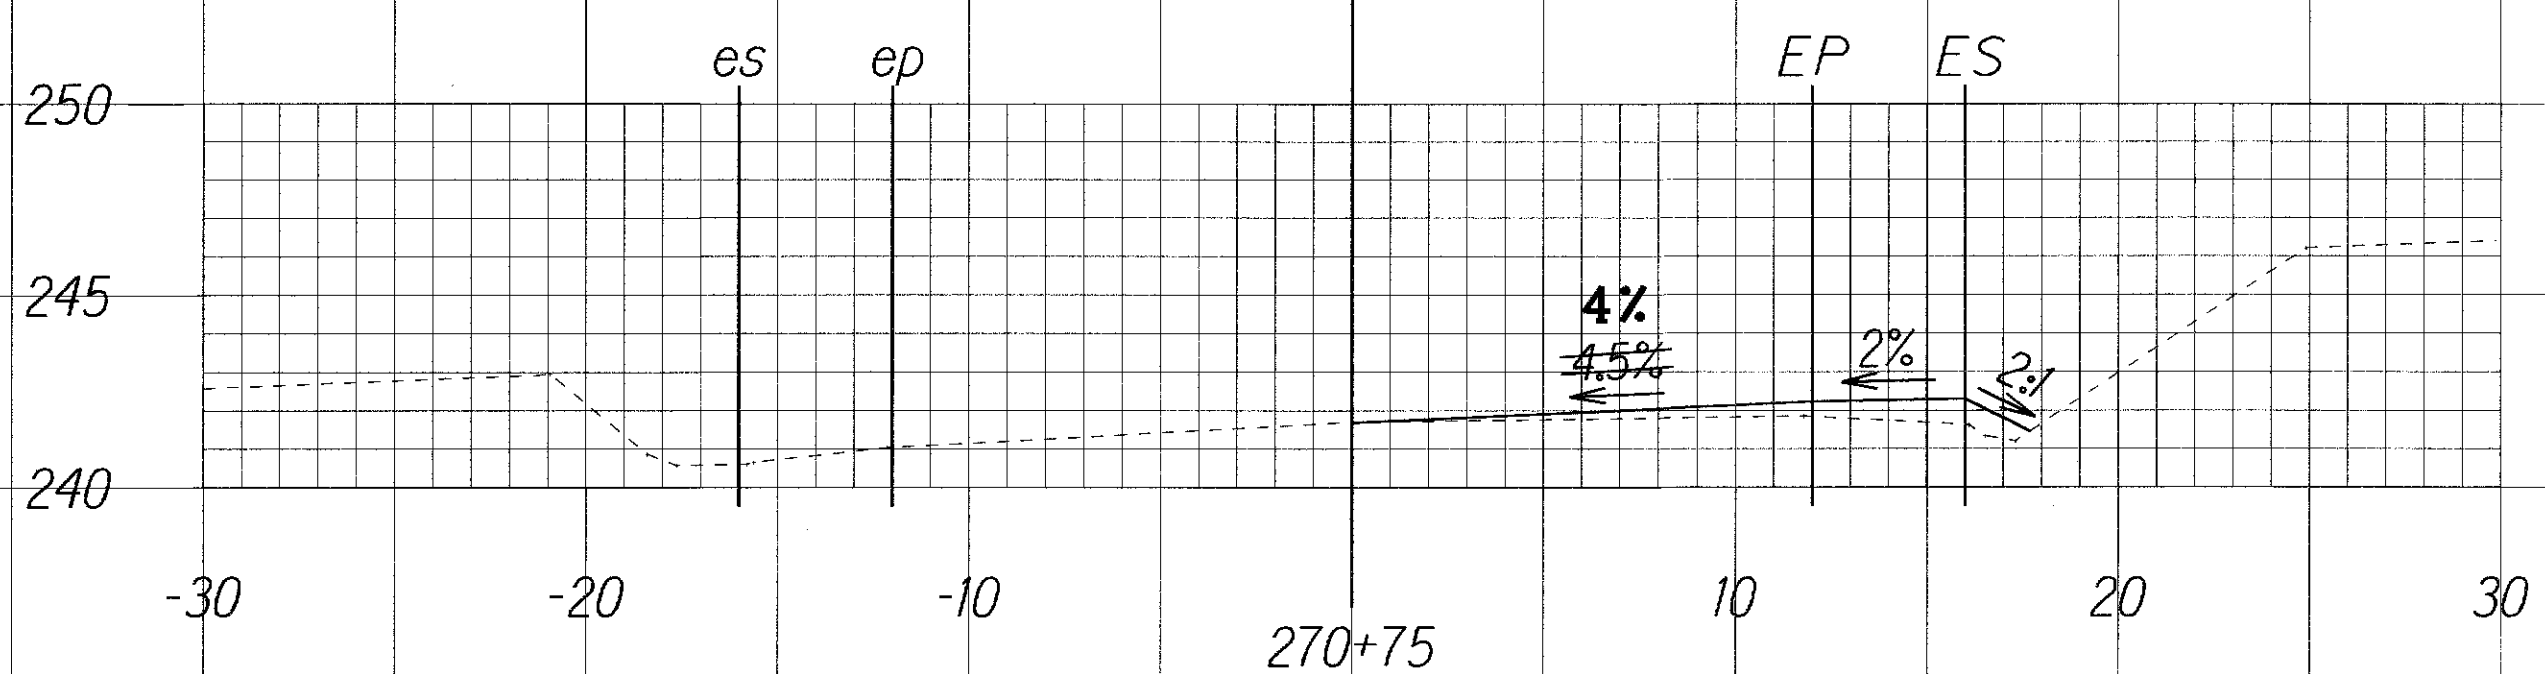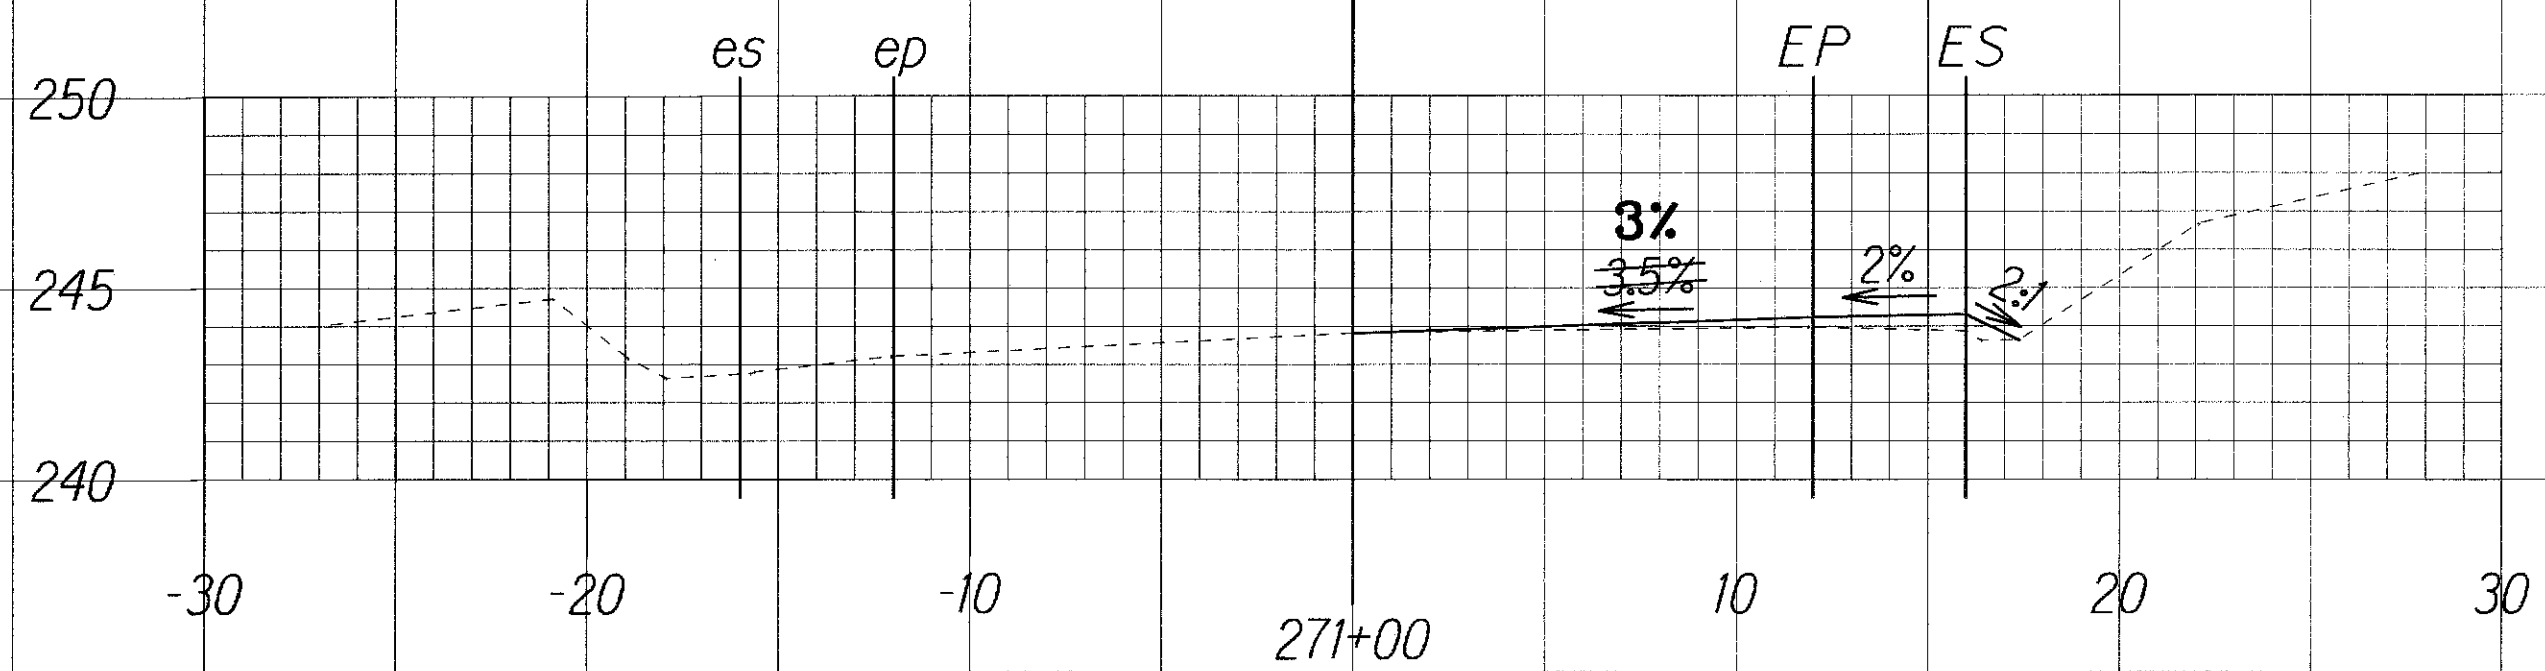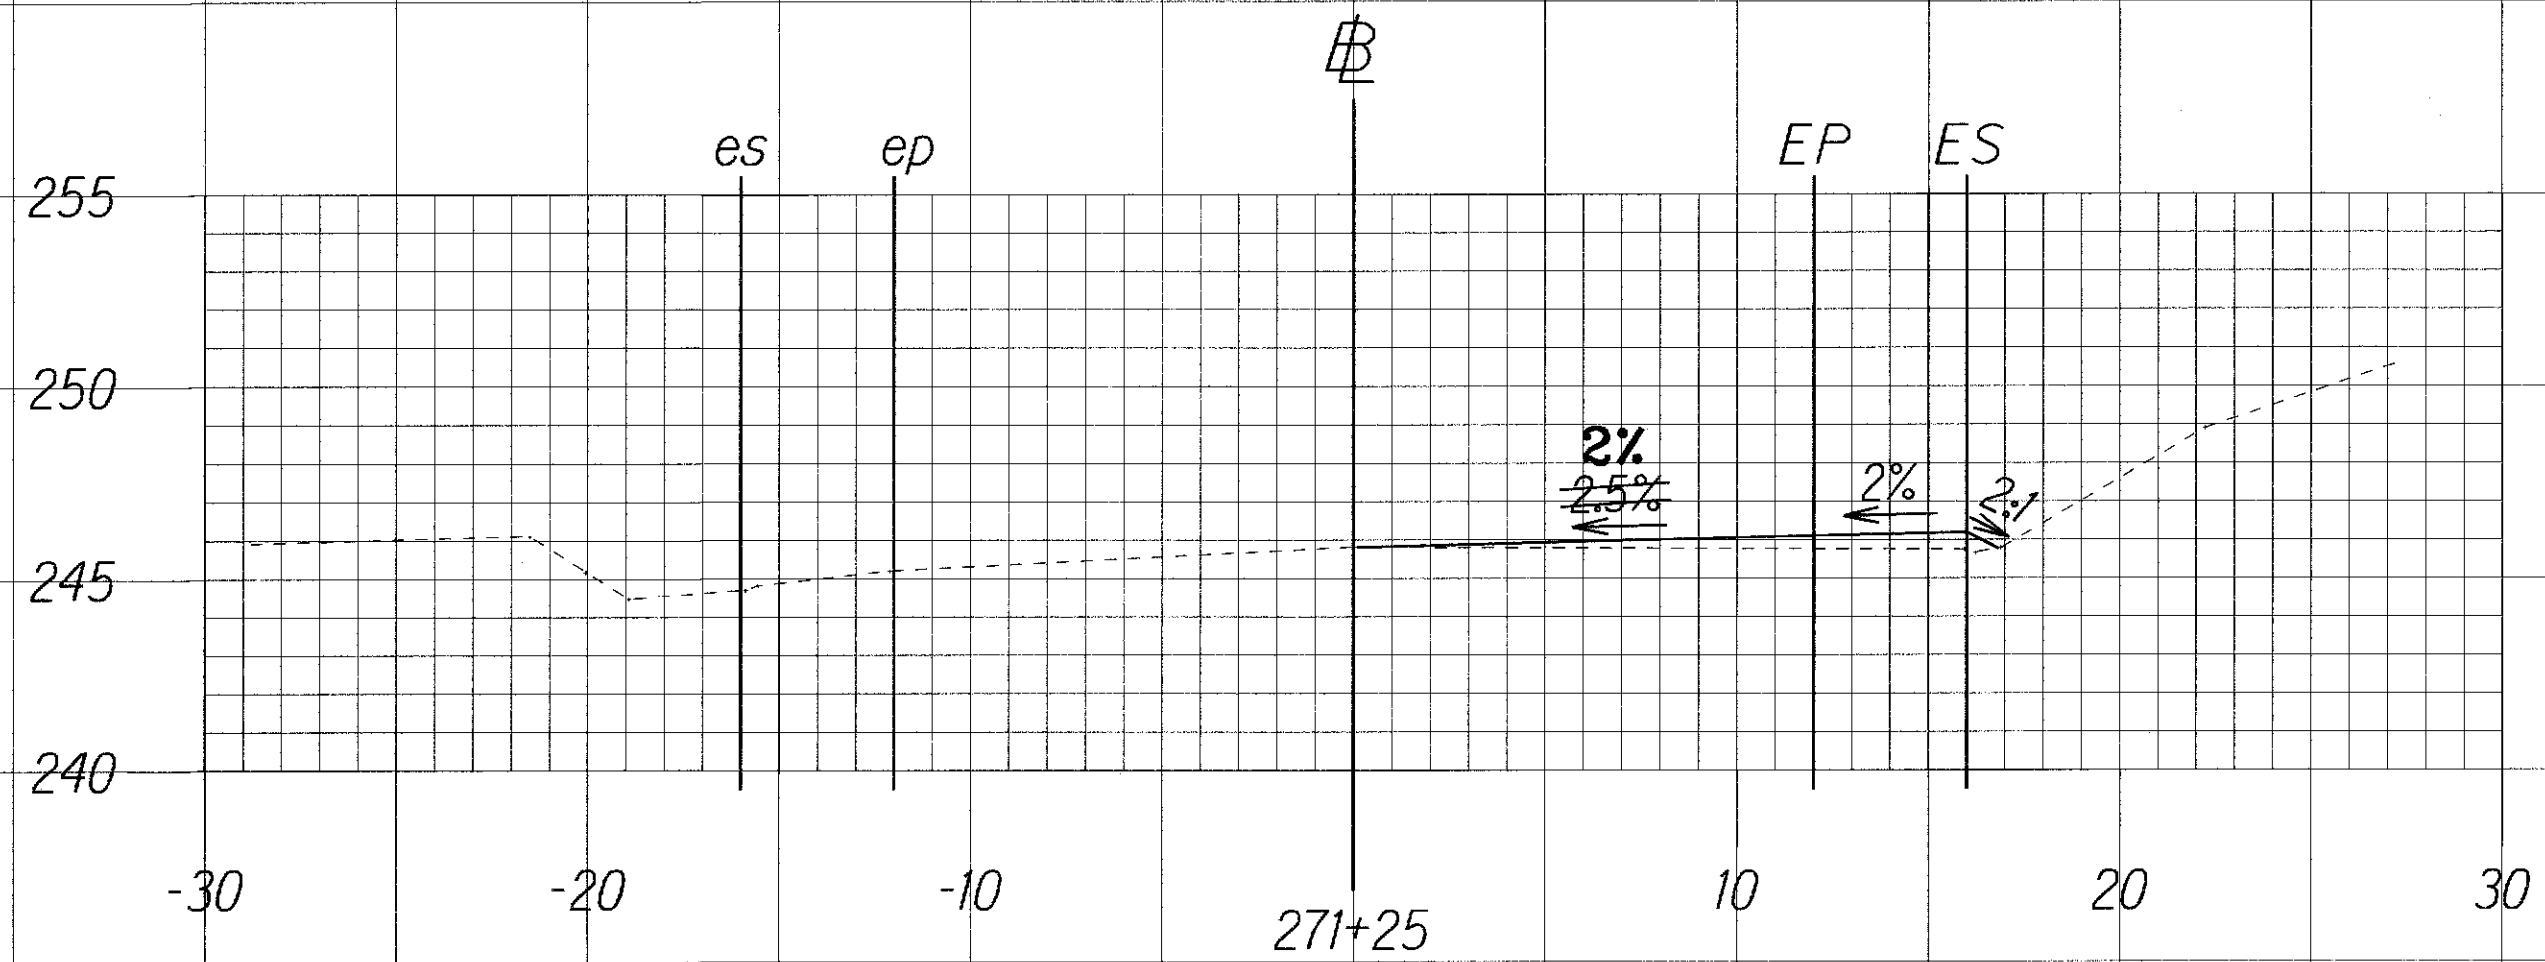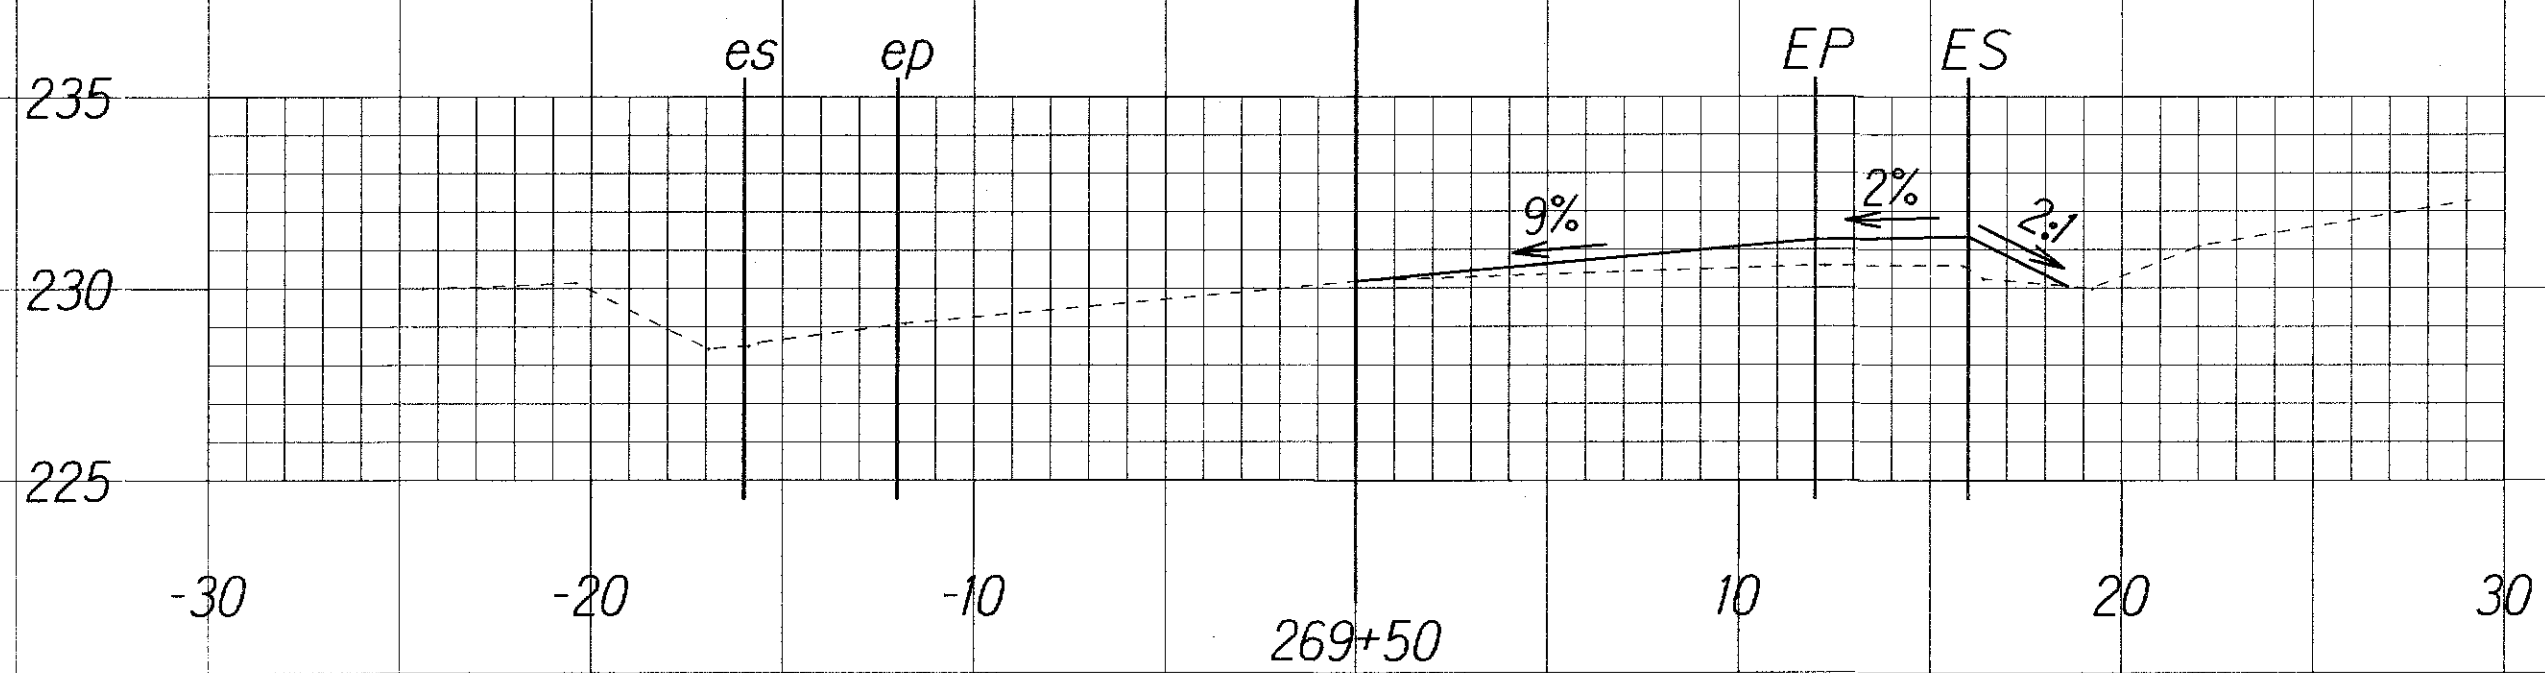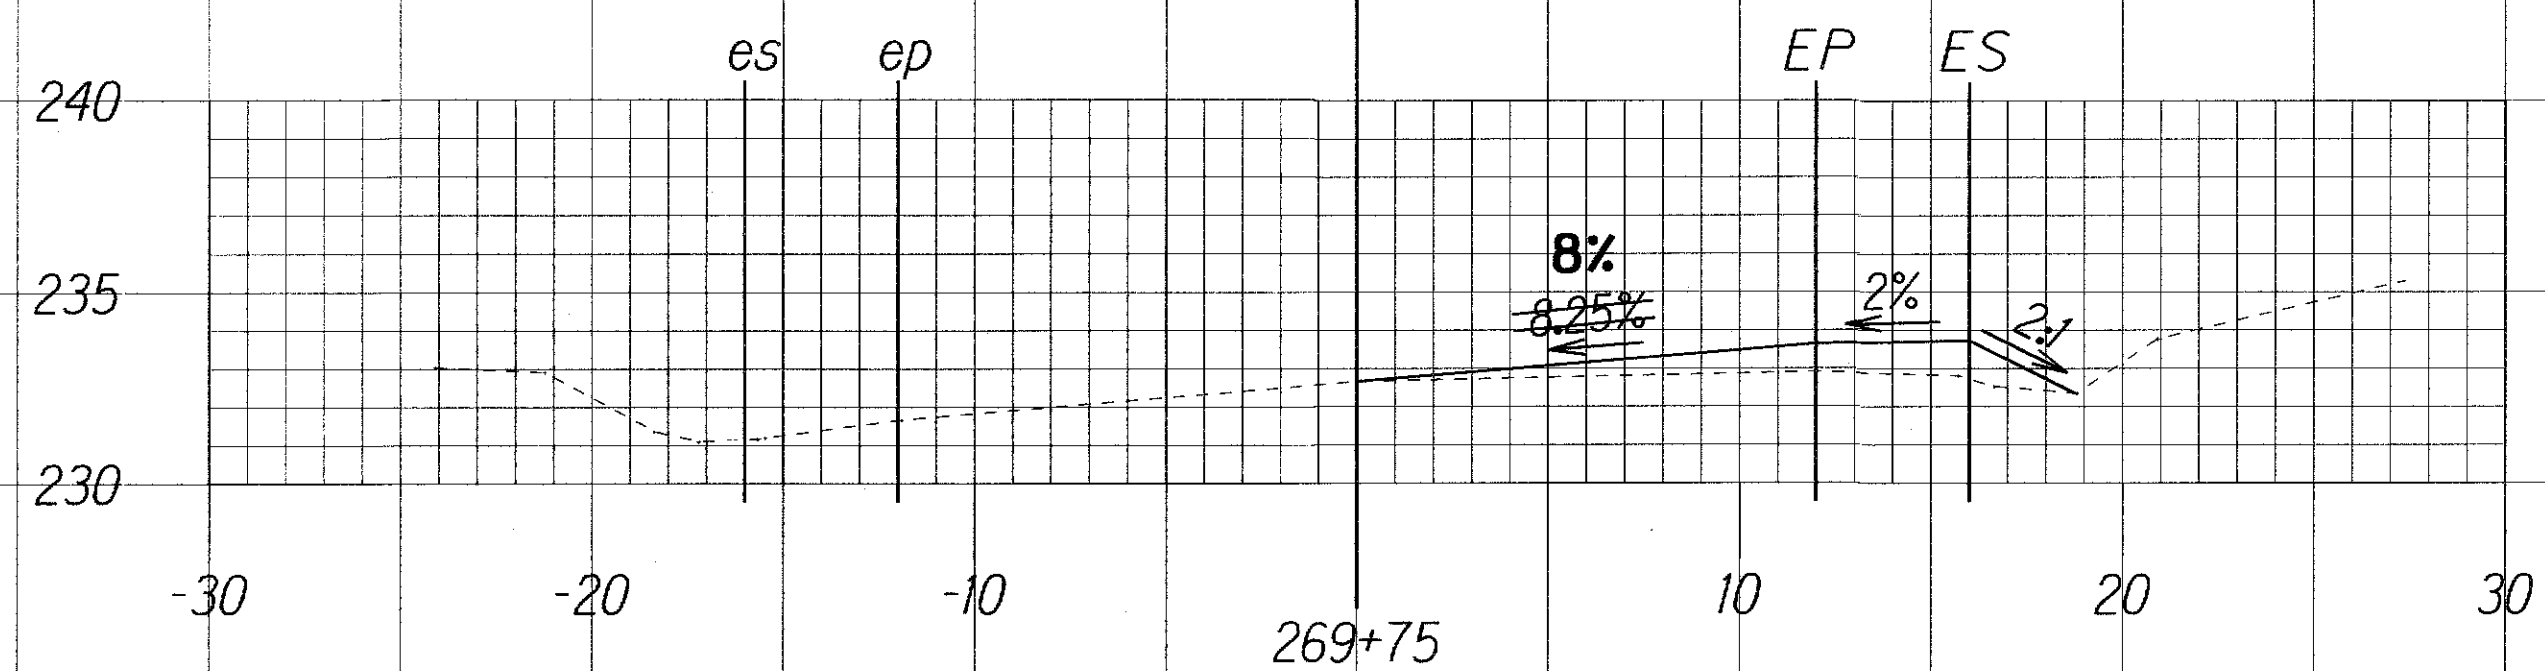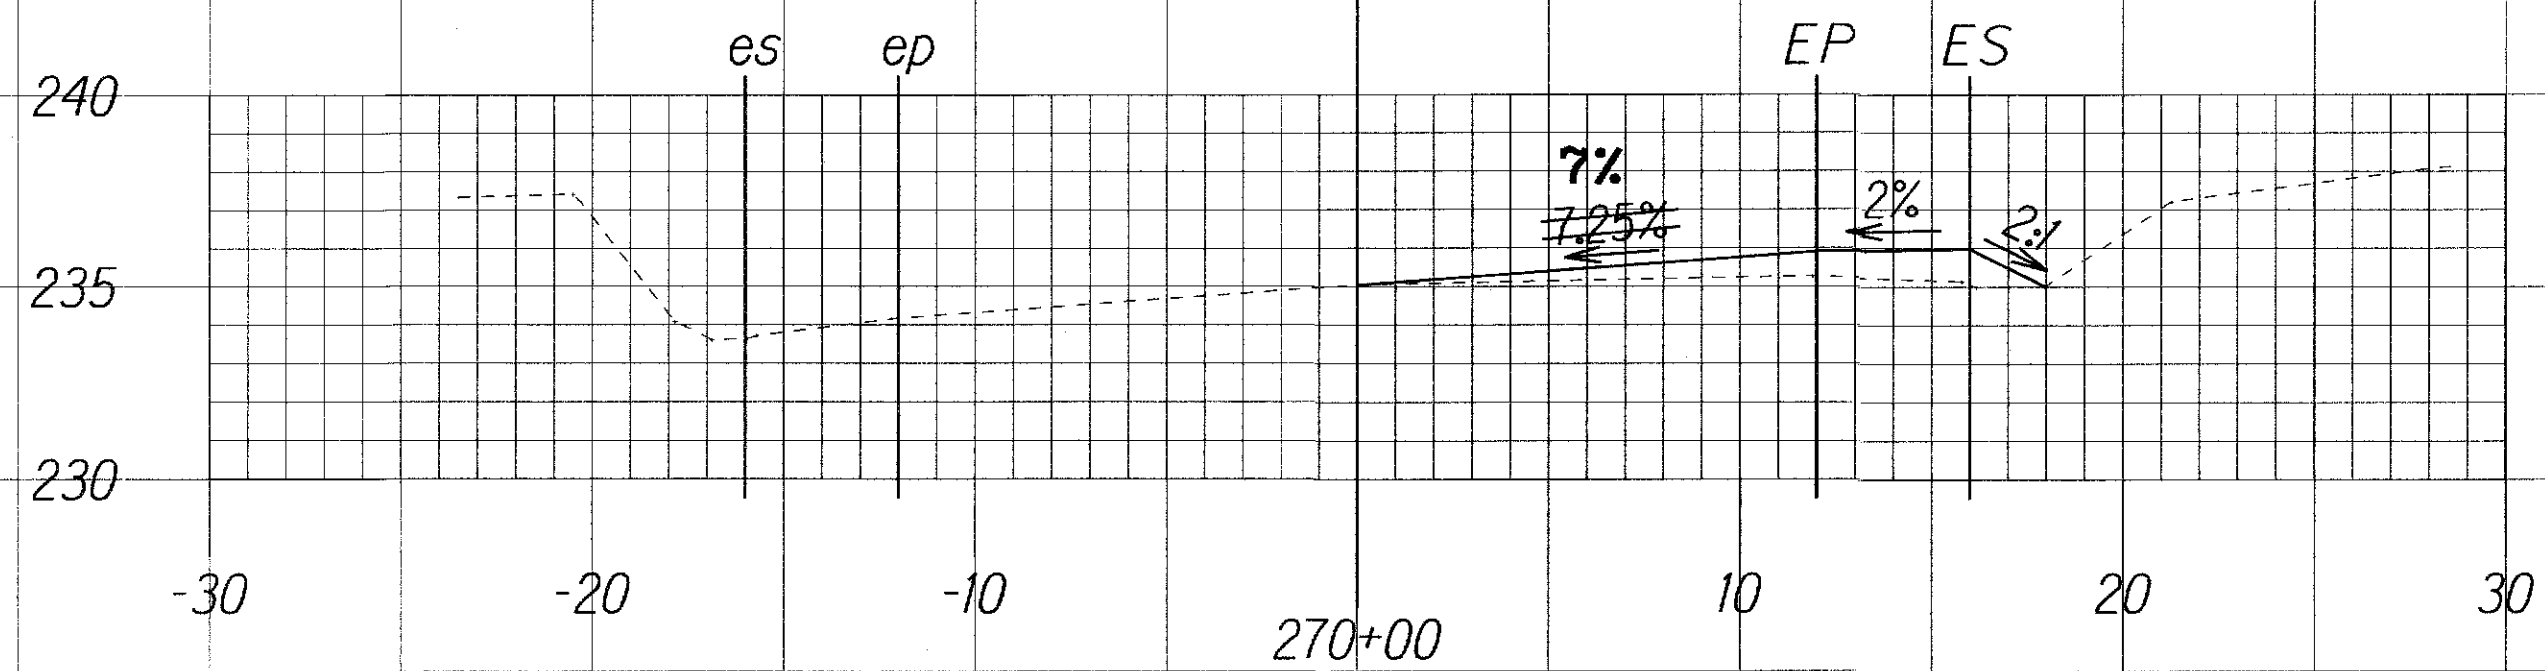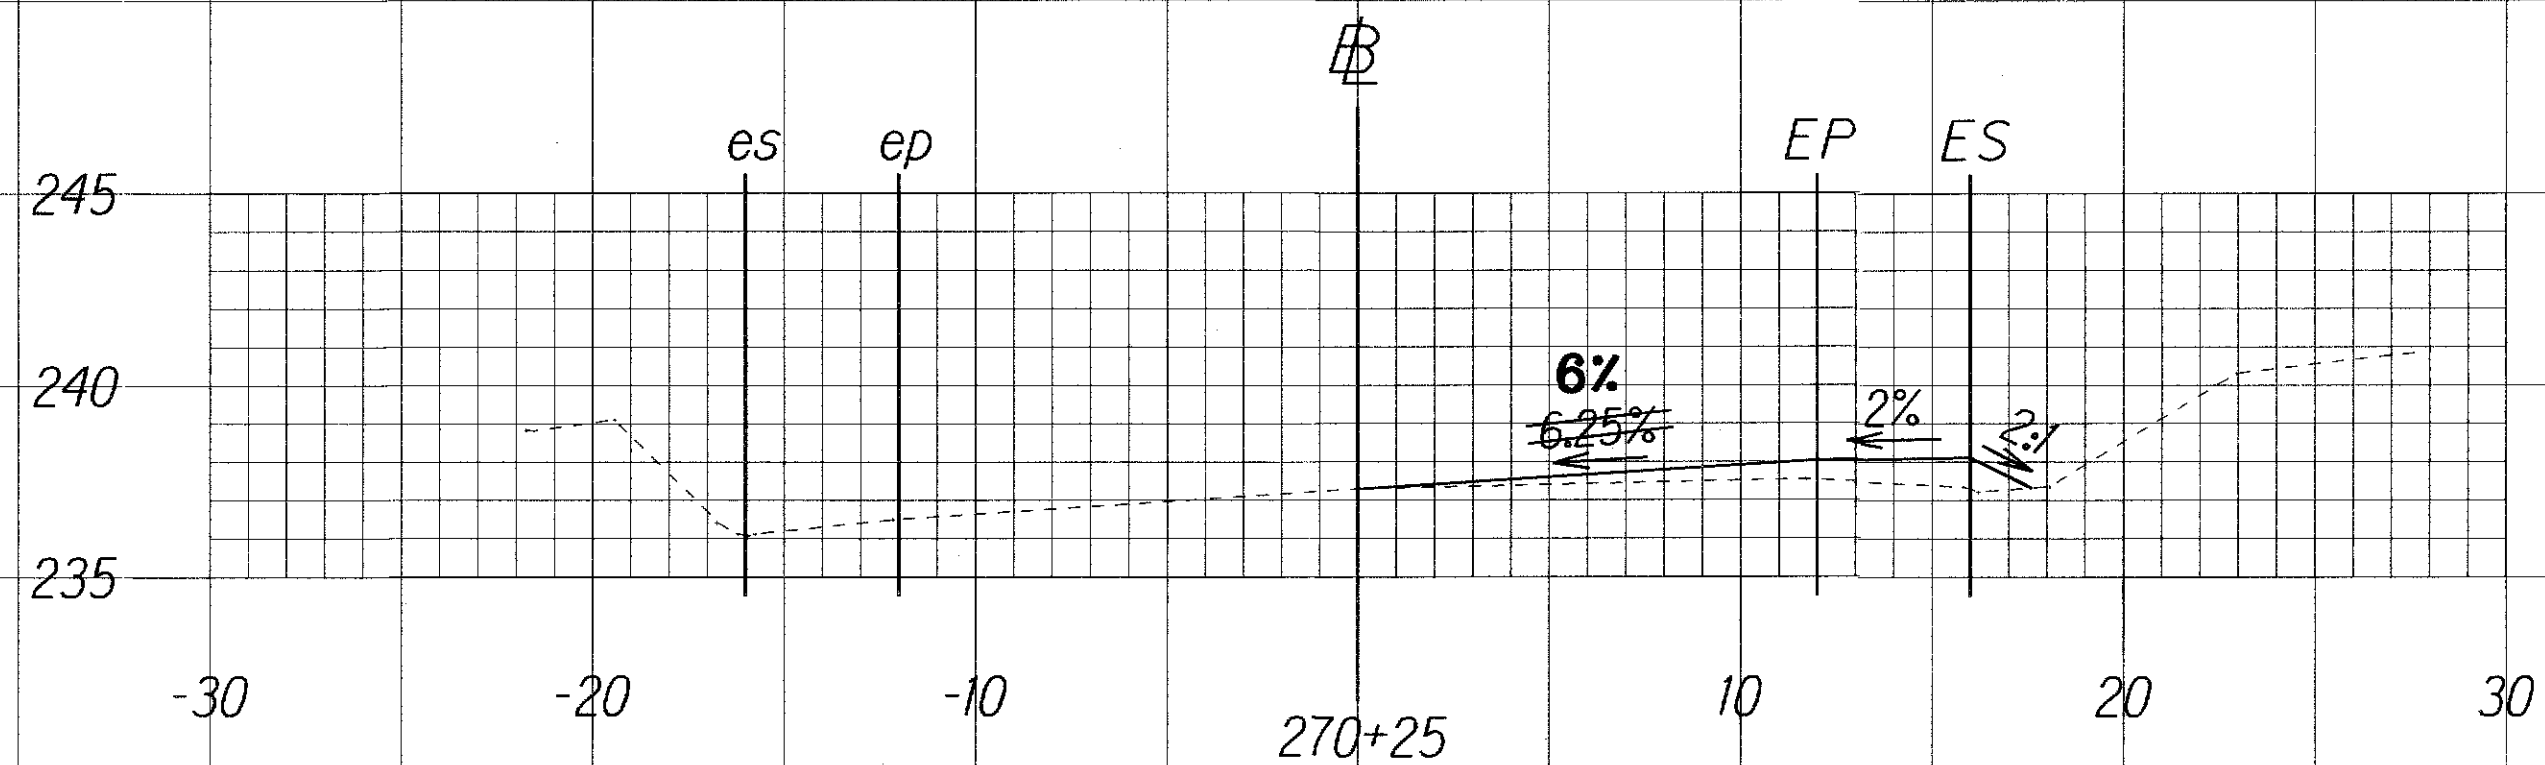

9/15/09 Revised Shoulder Slopes.

DATE REVISION

SHEET No. 7 OF 8 SHEETS

"AS-BUILT"

ADD. 33

| FED. ROAD
DIST. NO. | STATE | FED. AID
PROJ. NO. | FISCAL
YEAR | SHEET
NO. | TOTAL
SHEETS |
|------------------------|-------|-----------------------|----------------|--------------|-----------------|
| HAWAII | HAW. | HSIP-011-2(37) | 2009 | ADD. 34 | 34 |

LEGEND FOR AS-BUILT POSTINGS

~~~~~ Squiggly line for as-built deletion

== Roadway

== Double line for as-built deletion

Text for as-built posting

ORIGINAL PLAN

DATE

SURVEY PLOTTED BY

DRAWN BY

NOTED BY

DESIGNED BY

QUANTITIES BY

CHECKED BY

1

1

1


1

1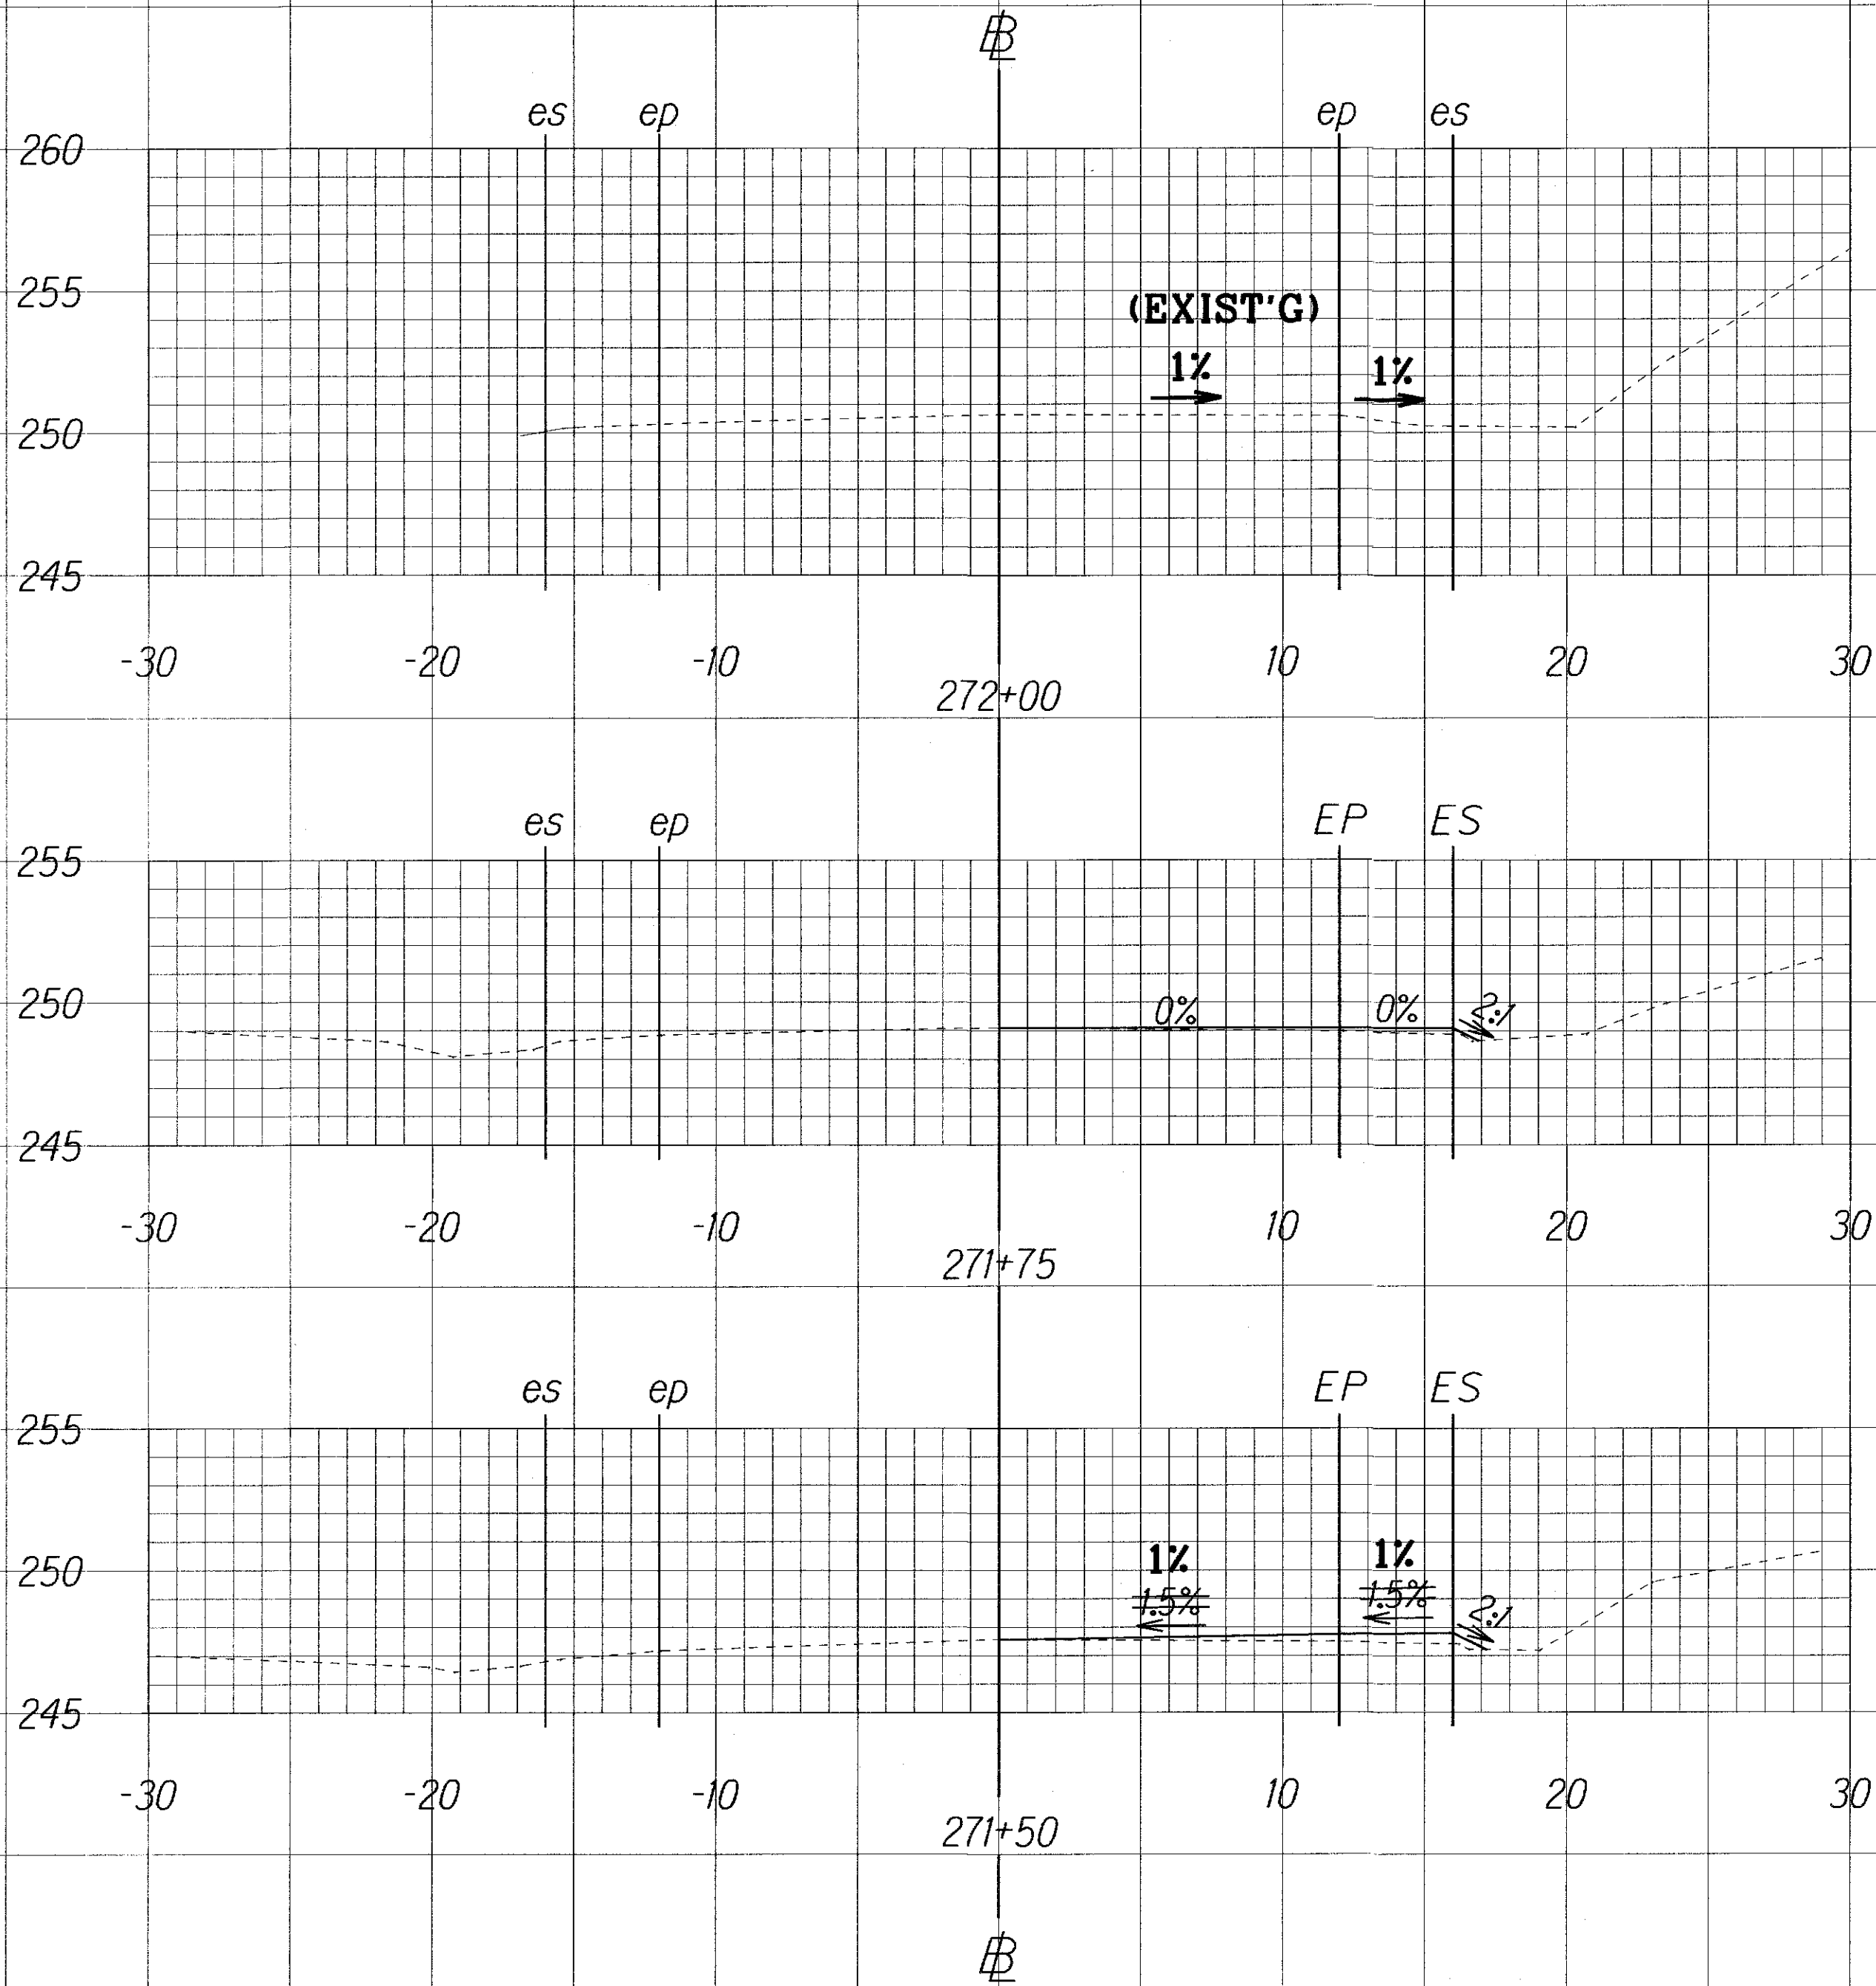

SCALE  
Horizontal: 1"=5'  
Vertical: 1"=5'

|             |                          |
|-------------|--------------------------|
| 9/15/09     | Revised Shoulder Slopes. |
| DATE        | REVISION                 |
| SHEET No. 8 | OF 8 SHEETS              |

"AS-BUILT"

ADD. 34