

INDEX TO DRAWINGS	
SHEET NO.	DESCRIPTION
1	TITLE SHEET
2	STANDARD PLANS SUMMARY
3	GENERAL NOTES AND LEGEND
4 - 5	WATER POLLUTION AND EROSION CONTROL NOTES
6	TYPICAL SECTIONS
7 - 8	GRADING PLAN
9	PAVEMENT MARKING LEGEND DETAILS & NOTES
10	WORK ZONE SIGNING PLAN, NOTES & DETAILS
11 - 17	PAVEMENT MARKING AND SIGNING PLAN
18	CENTERLINE MILLED RUMBLE STRIP DETAIL
19	EDGE LINE MILLED RUMBLE STRIP DETAIL FOR SHOULDER 3' TO 4.5'
20	TYPICAL INSTALLATION OF SHOULDER OR EDGE LINE MILLED RUMBLE STRIP
21	EDGE LINE RUMBLE STRIP SIGN DETAILS & NOTES
22 - 26	GUARDRAIL DETAILS & NOTES
27 - 34	CROSS-SECTIONS

STATE OF HAWAII

DEPARTMENT OF TRANSPORTATION

HIGHWAYS DIVISION

HONOLULU, HAWAII

"AS-BUILT"

PLANS FOR

MAMALAHOA HIGHWAY

SAFETY IMPROVEMENTS





VICINITY OF KIOLAKAA HOMESTEAD ROAD

FEDERAL AID PROJECT NO. HSIP-011-2(37)

DISTRICT OF KAU

ISLAND OF HAWAII

FED. ROAD DIST. NO.	STATE	FED. AID PROJ. NO.	FISCAL YEAR	SHEET NO.	TOTAL SHEETS
HAWAII	HAW.	HSIP-011-2(37)	2009	1	34

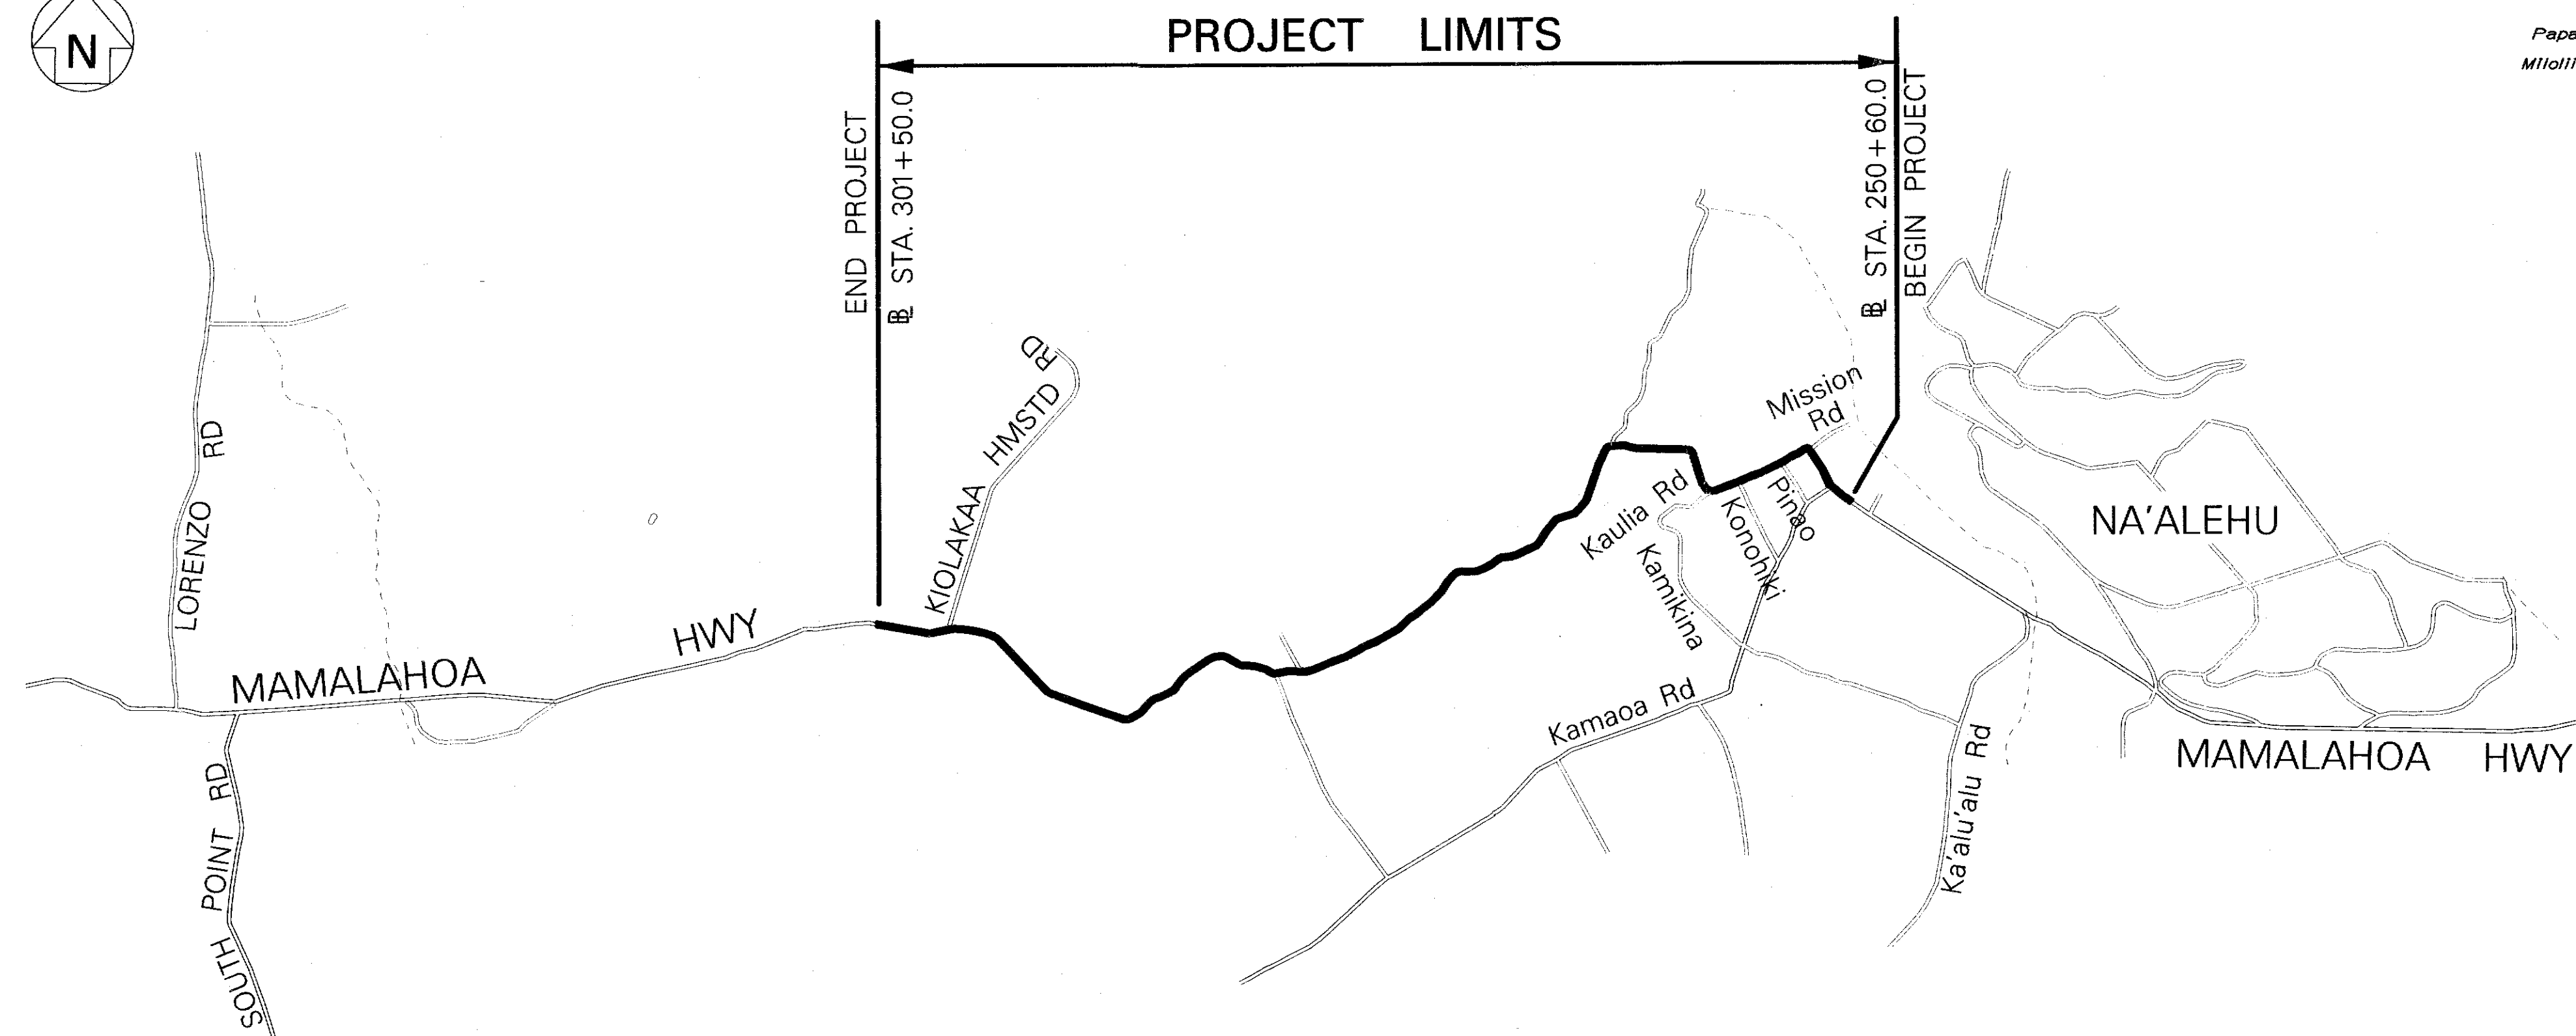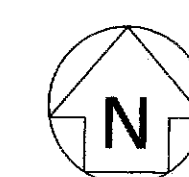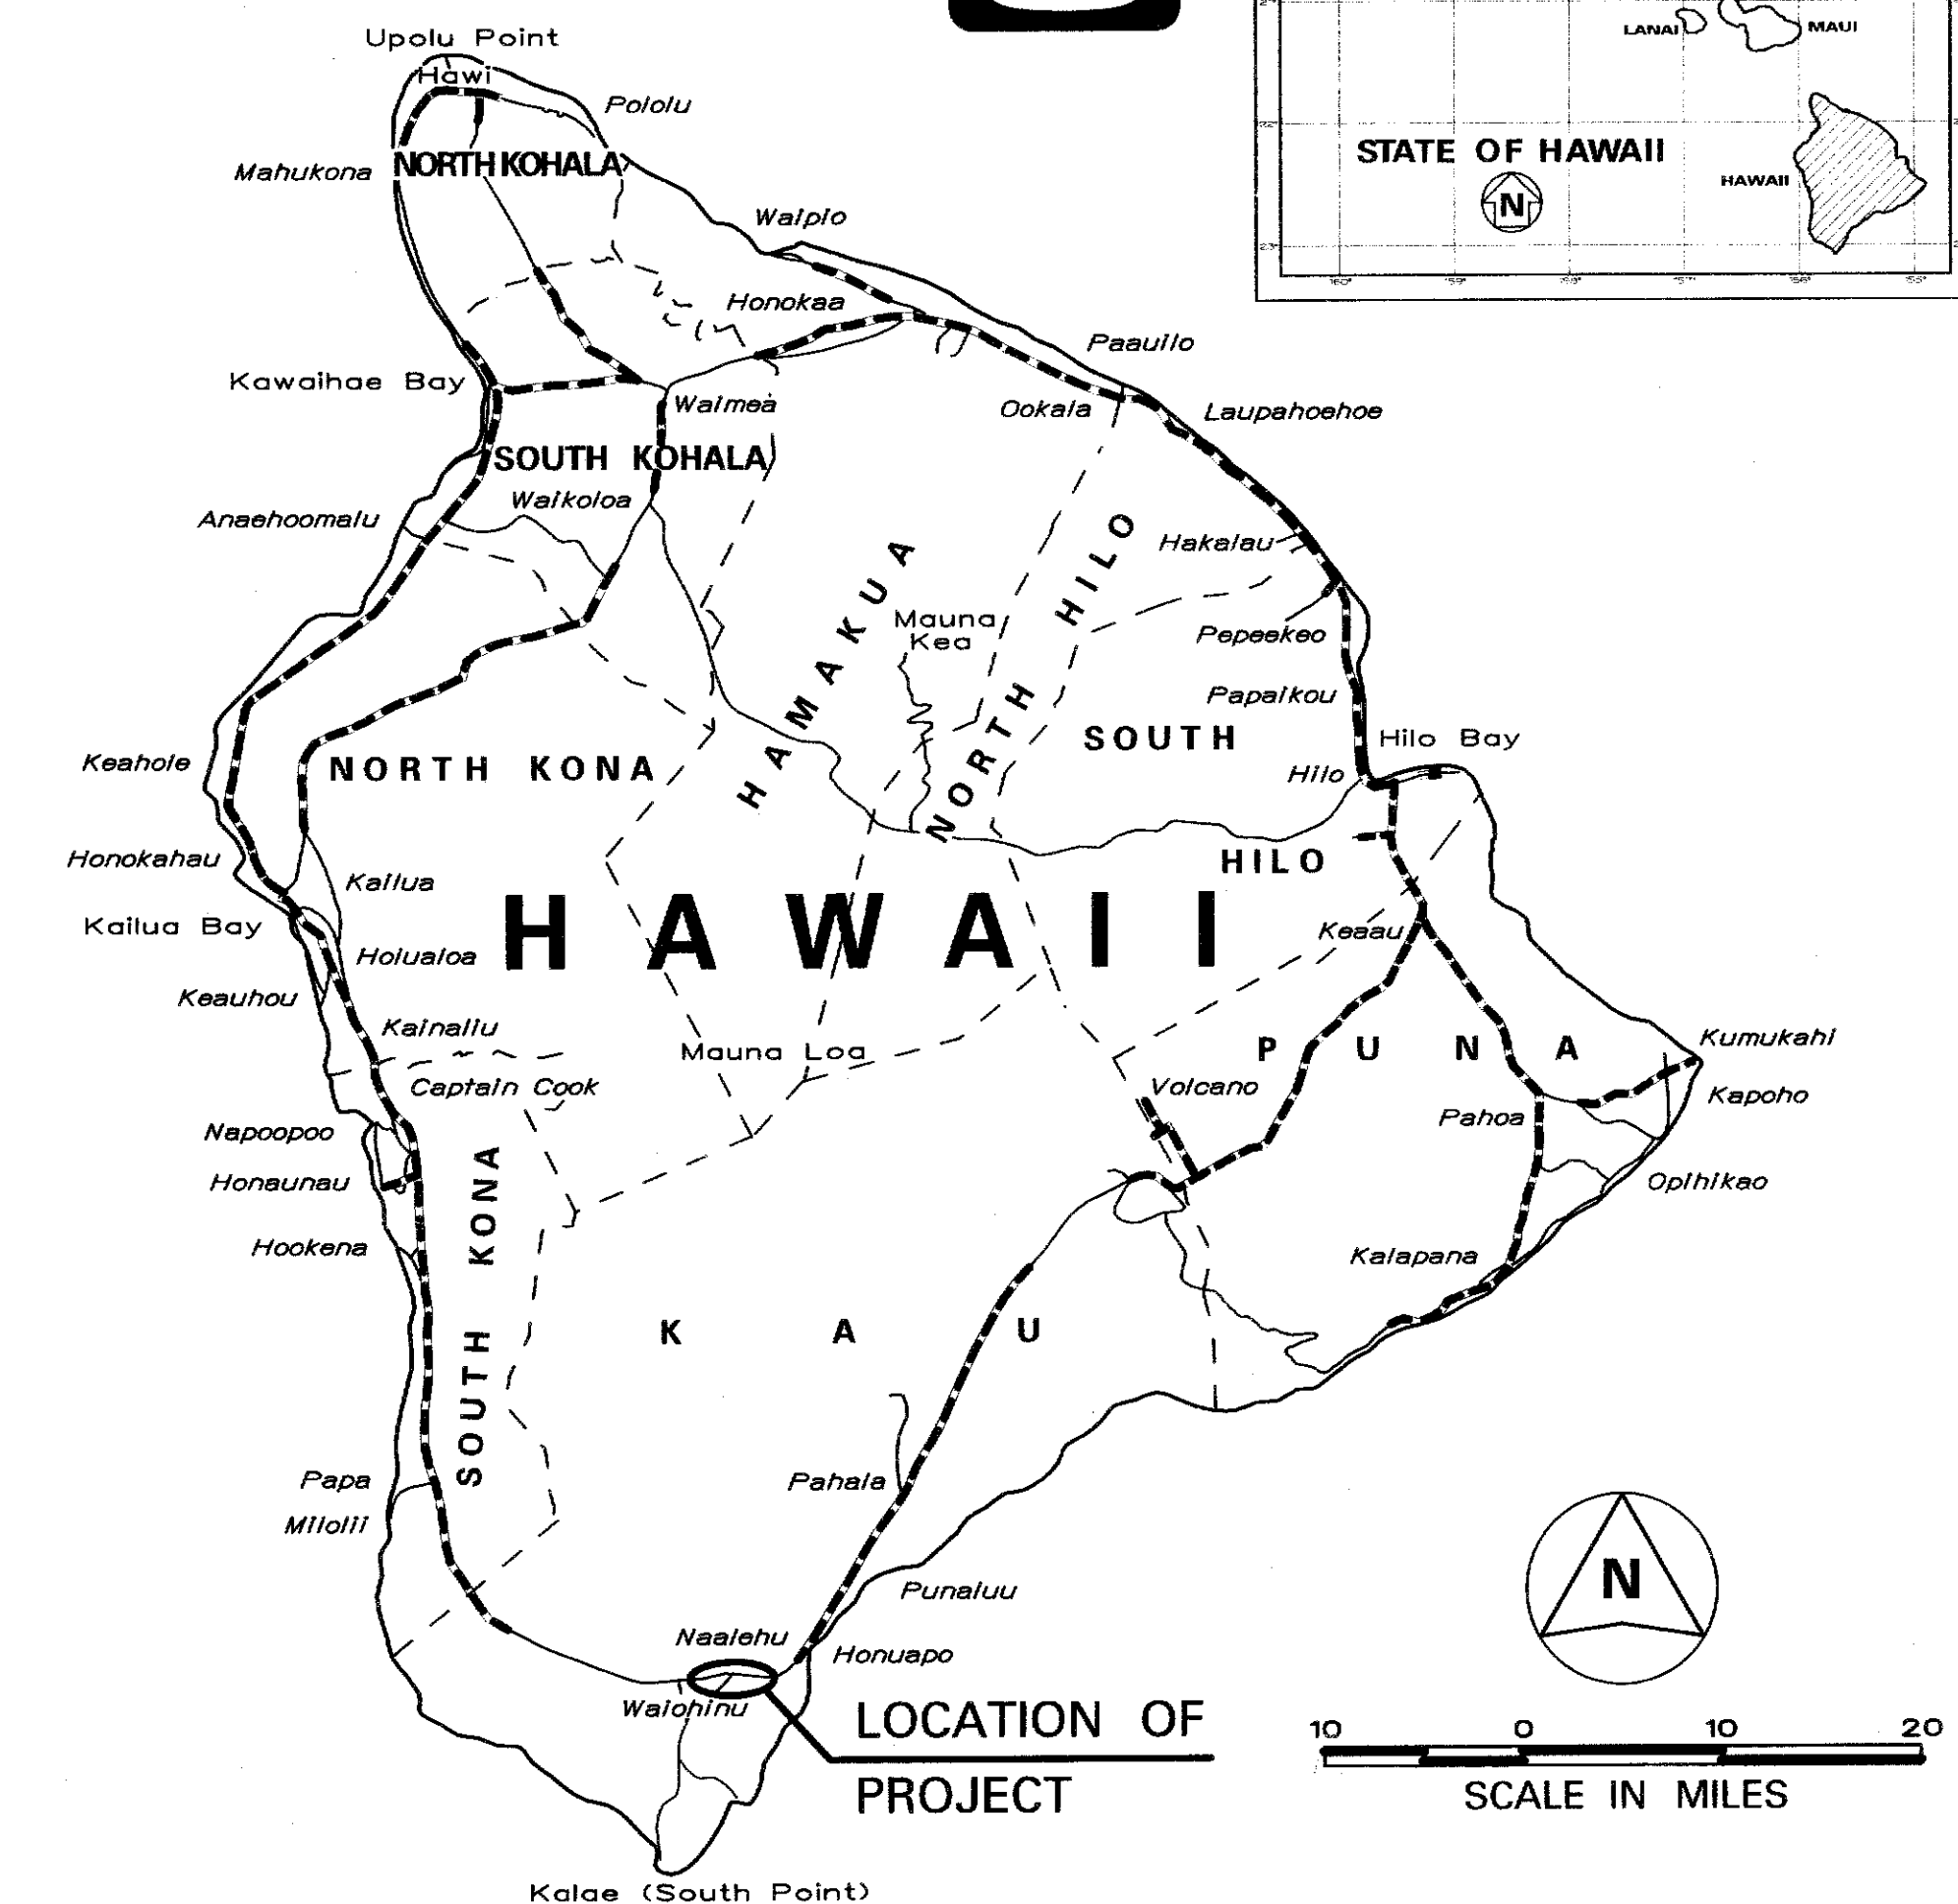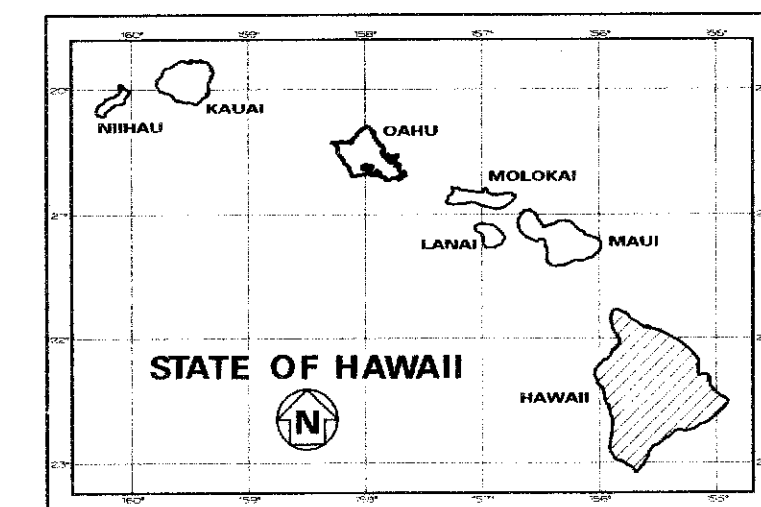

LAYOUT PLAN

GROSS LENGTH OF PROJECT.....2.93 MILES

NET LENGTH OF PROJECT.....2.93 MILES

2 0 2 4 6

SCALE IN THOUSAND FEET

FEDERAL AID PROJECTS PREVIOUSLY CONSTRUCTED OR UNDER CONSTRUCTION

MILE POST 65.60 TO MILE POST 68.53

DESIGN DESIGNATION

ADT (2009)..... 3,780

ADT (2019)..... 5,250

DHV 470

D 60/40

T 4.0 %

V 45 M.P.H.

CHANGES MADE DURING CONSTRUCTION HAVE BEEN INCORPORATED ON THESE PLANS EXCEPT CHANGES IN THE ORIGINAL THEORETICAL QUANTITIES. FOR ACTUAL QUANTITIES, REFER TO PROJECT LEDGER AND/OR COMPUTATION BOOK.

8-13-15

DATE

DEPARTMENT OF TRANSPORTATION STATE OF HAWAII	
APPROVED:	
8-24-09	DATE

DESIGNED BY

MANAGED BY

PHONE

DATE