
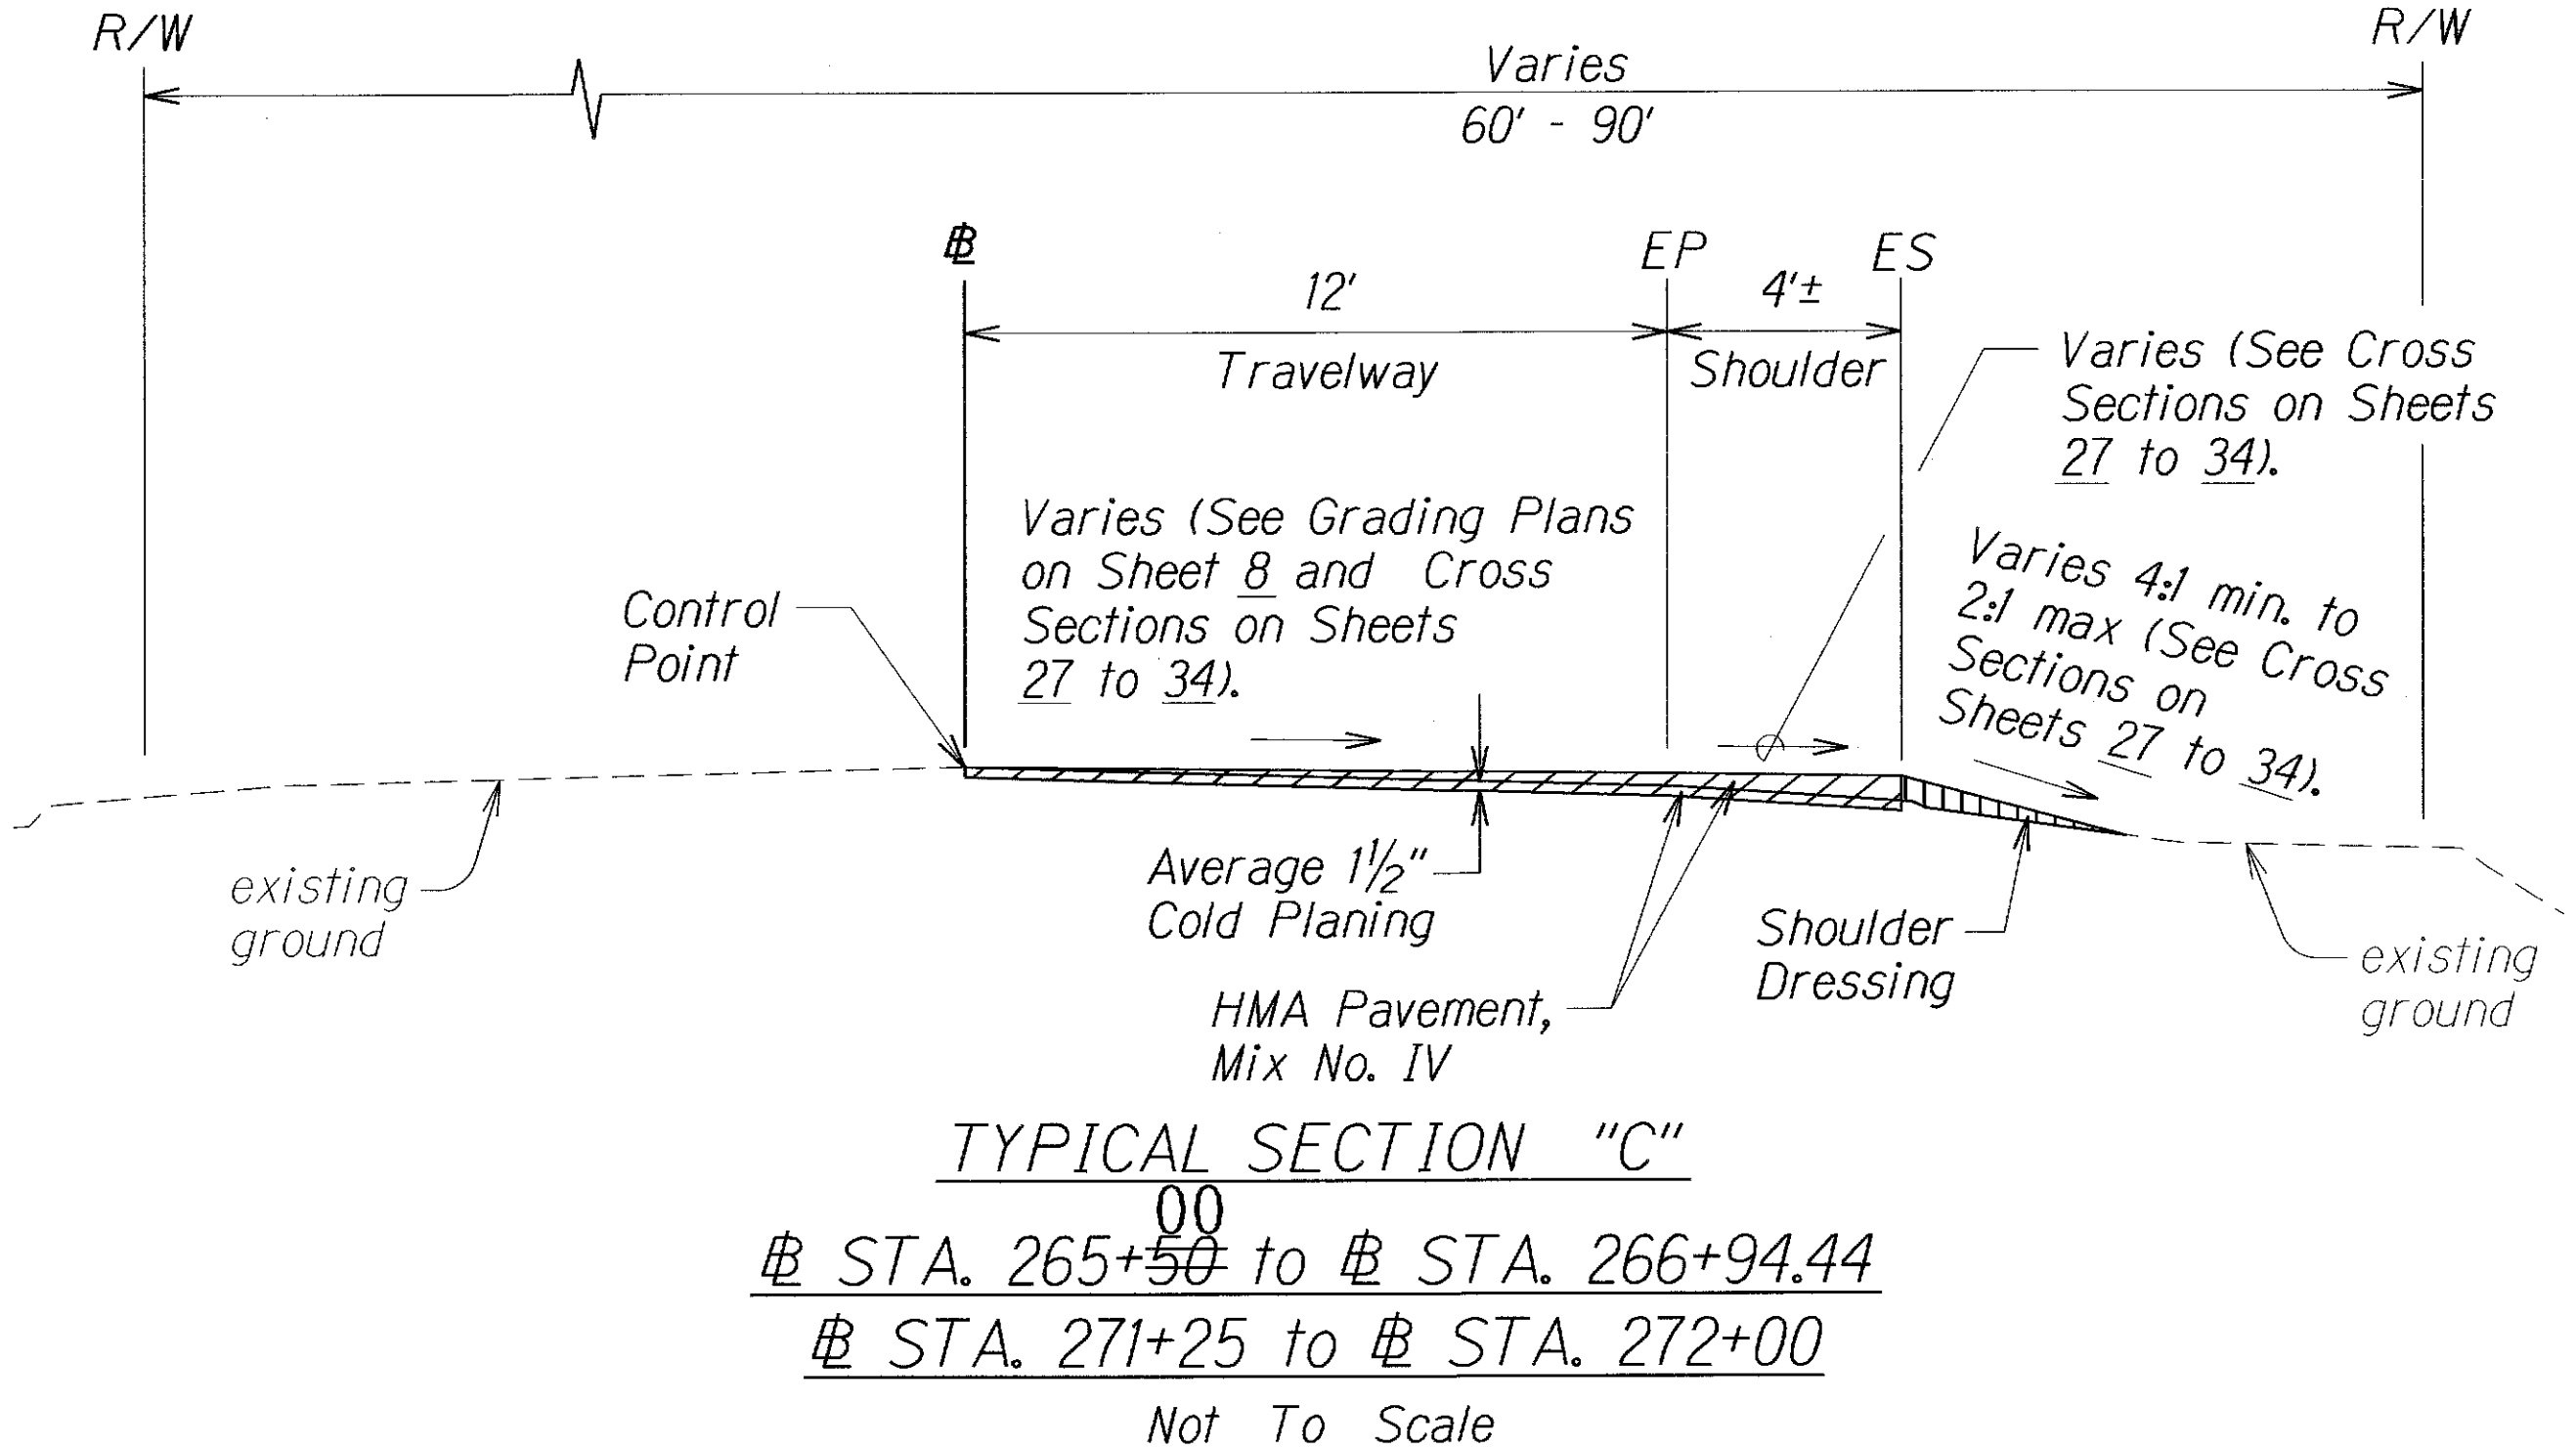
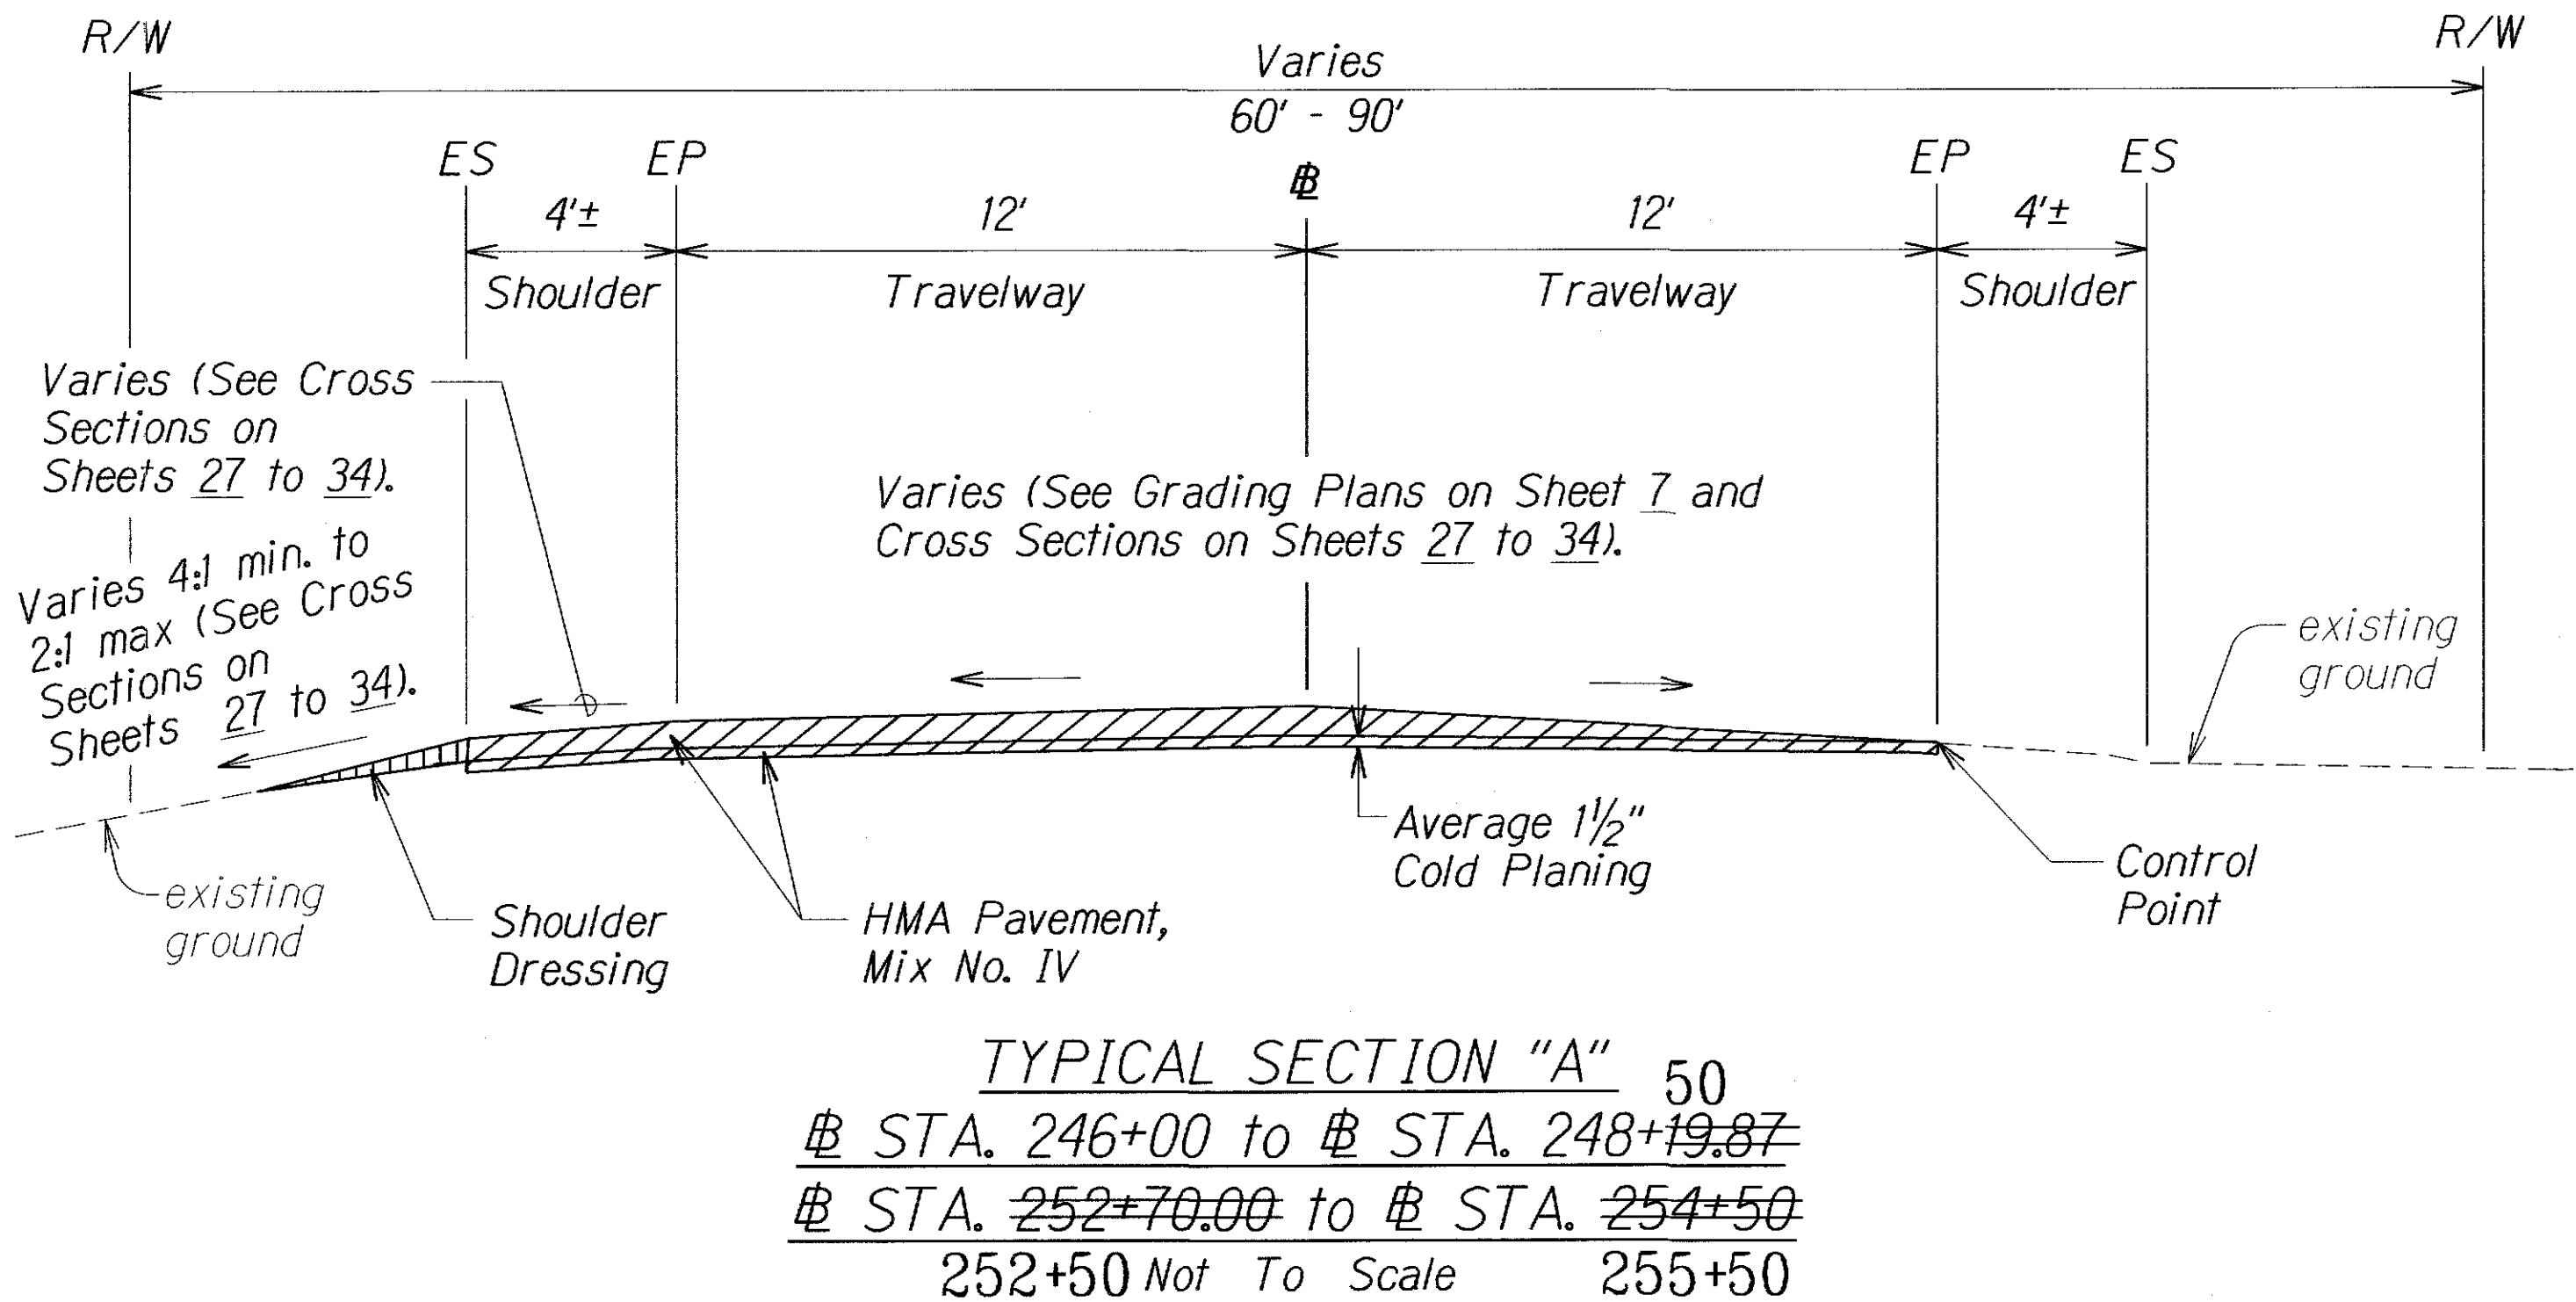
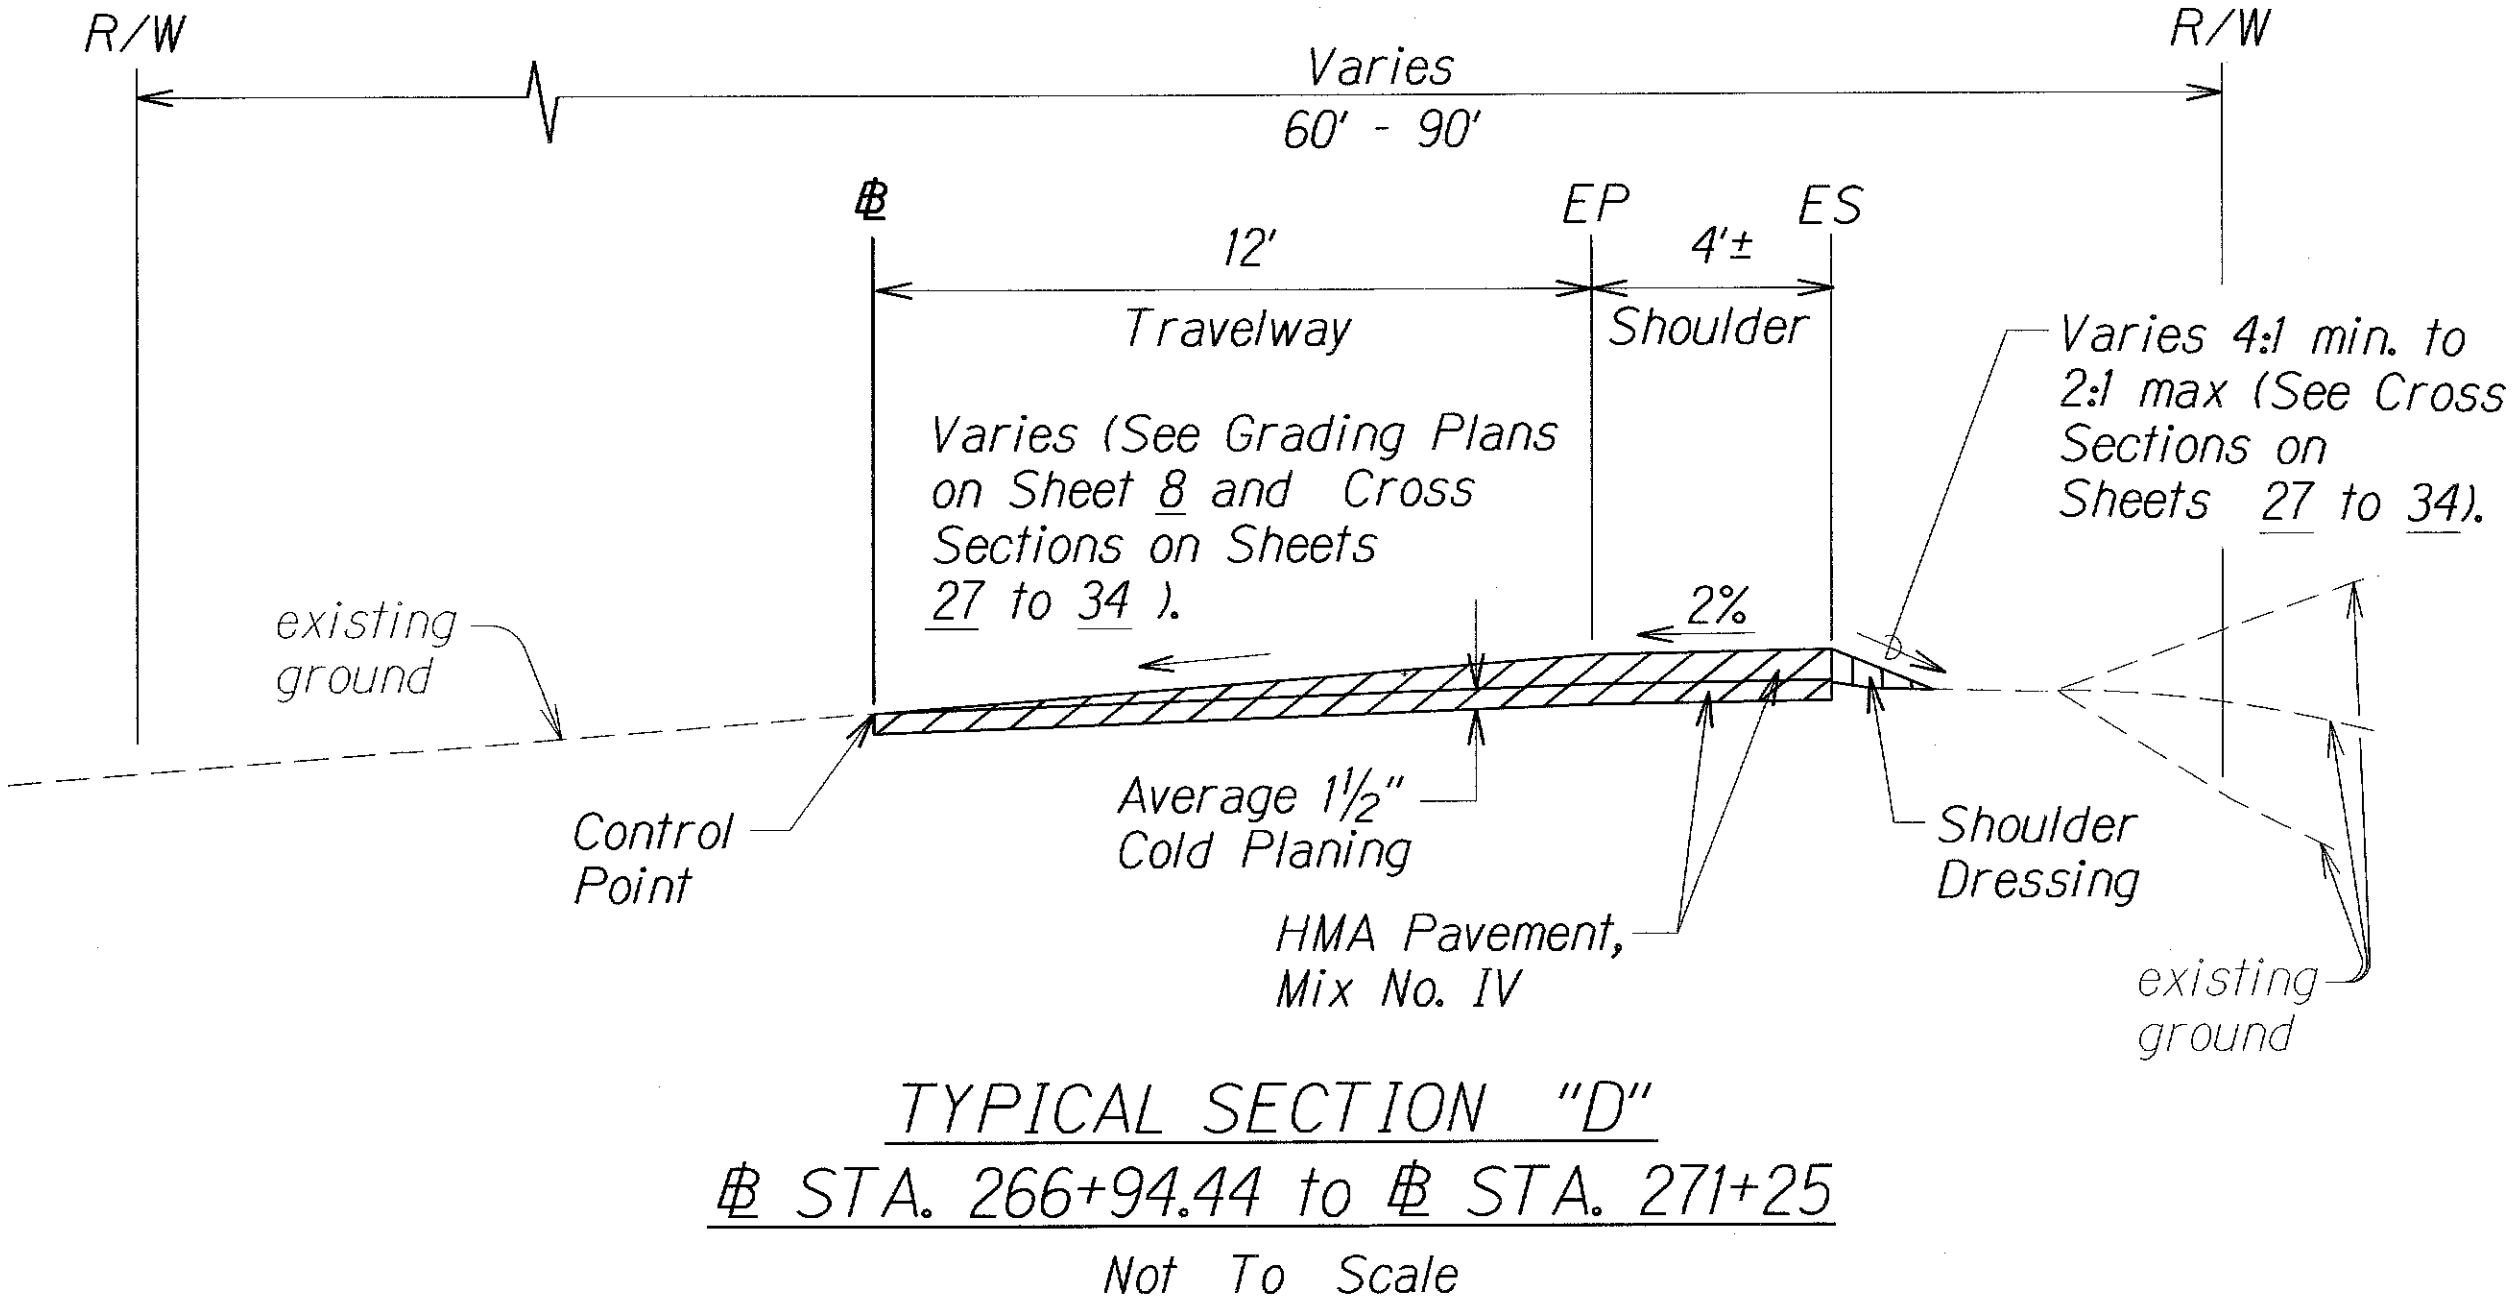


FED. ROAD DIST. NO.	STATE	FED. AID PROJ. NO.	FISCAL YEAR	SHEET NO.	TOTAL SHEETS
HAWAII	HAW.	HSIP-011-2(37)	2009	ADD. 6	34

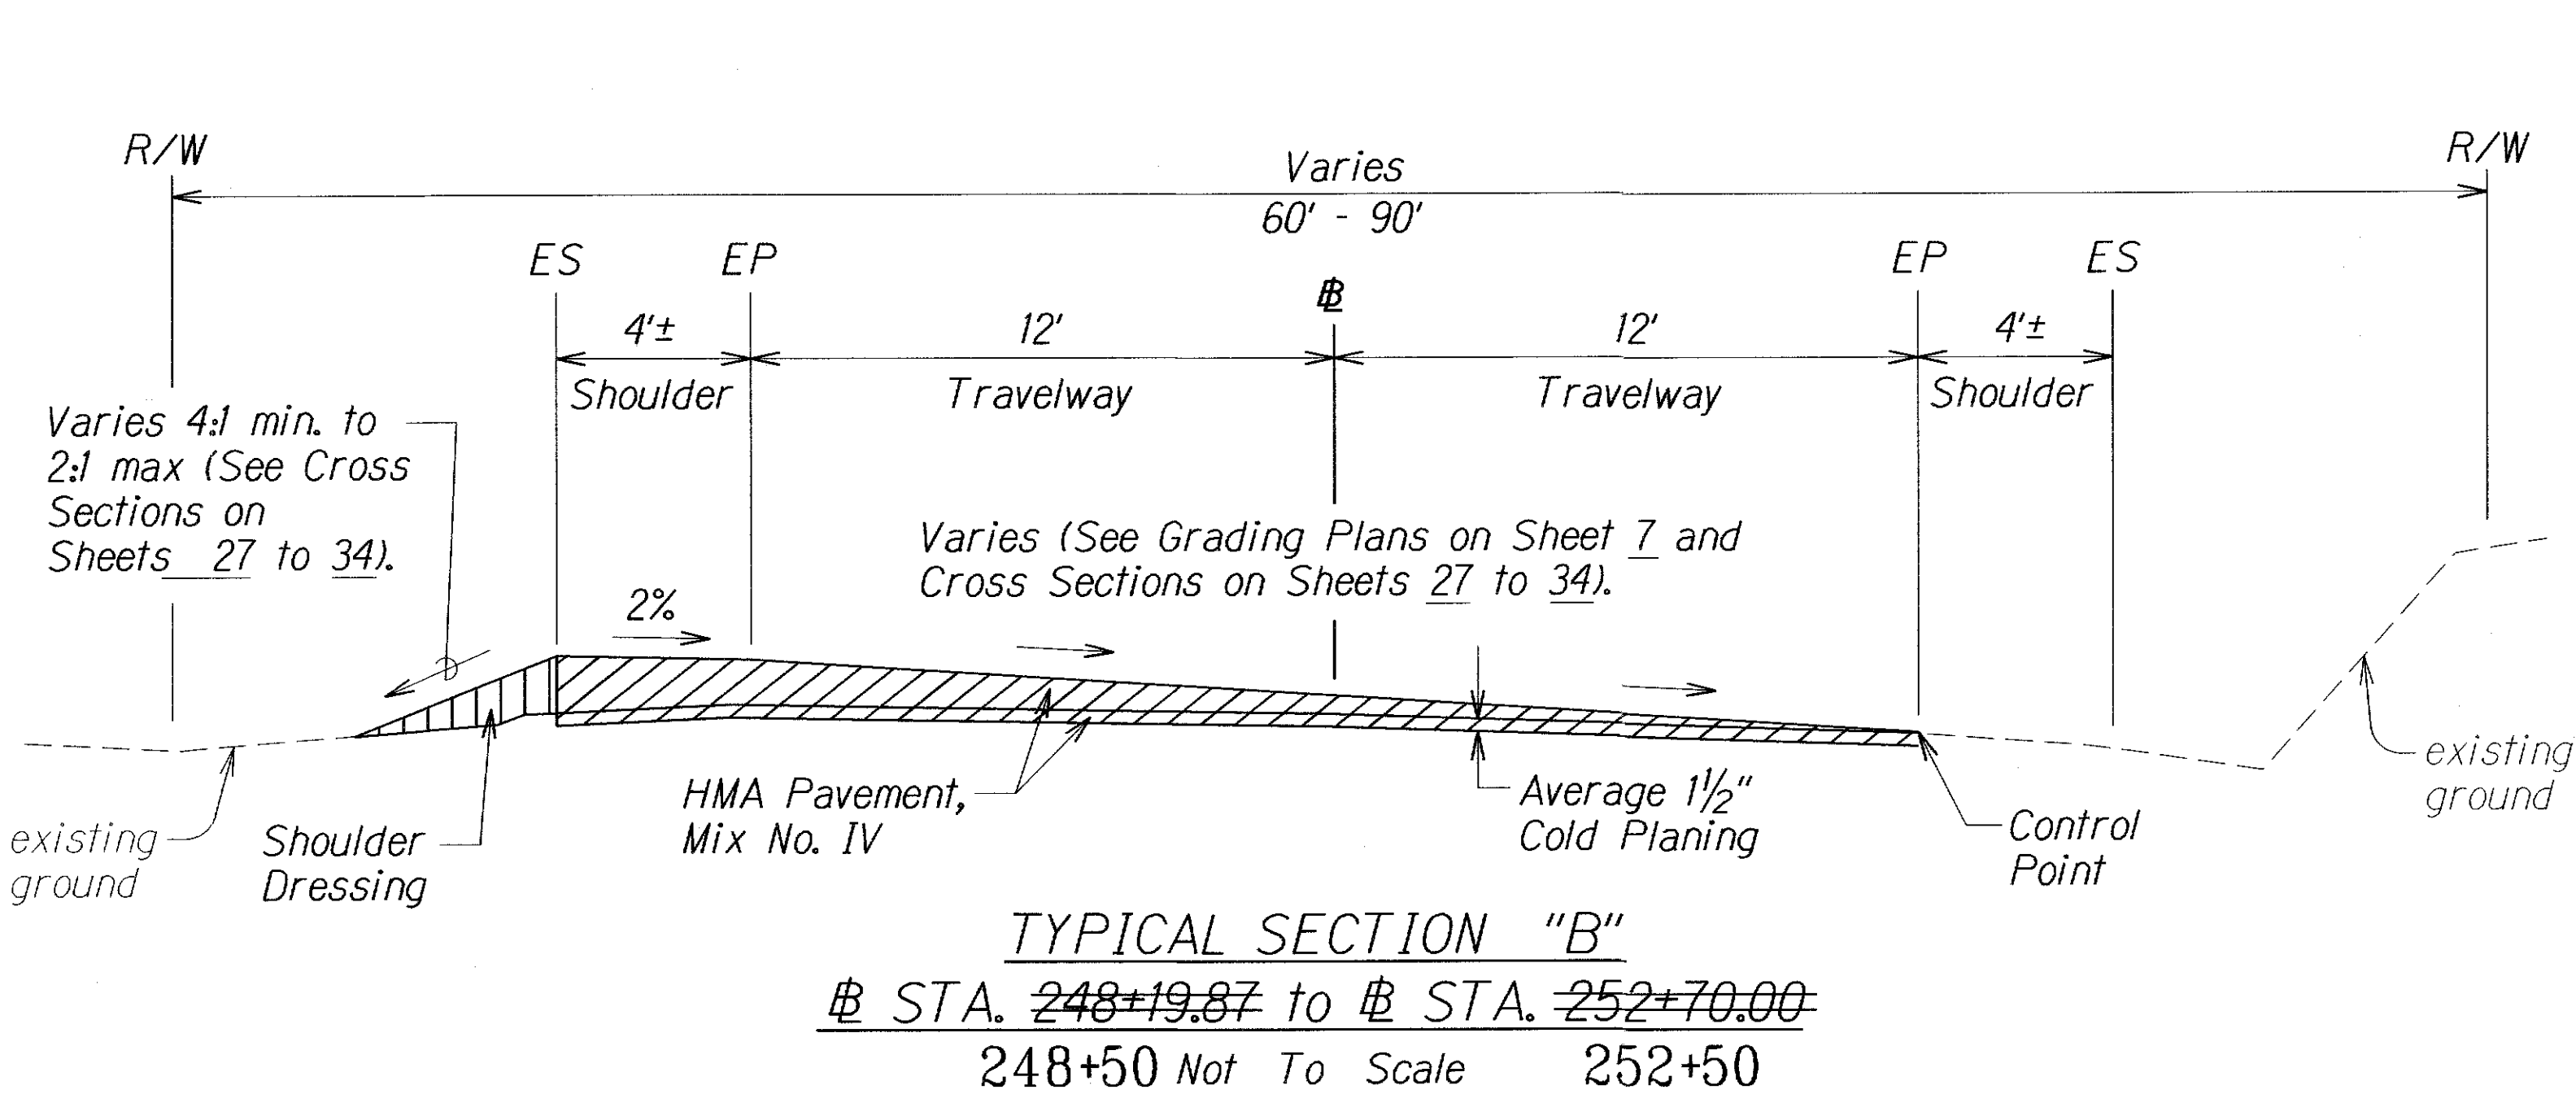

Notes:

- Shoulder dressing shall be considered incidental to Item No. 401.0100 - HMA Pavement, Mix No. IV.
- The Contractor shall provide and maintain a smooth transition with no drop offs between travel lanes during non-working hours. If pavement is not completed, a 6:1 wedge may be used for transition, at no increase in contract price or contract time.
- The Contractor must shield shoulder drop offs with Type II Barricades if exposed during non-working hours.

LEGEND FOR AS-BUILT POSTINGS	
~~~~~	Squiggly line for as-built deletion
====	Double line for as-built deletion
Roadway	Text for as-built posting

9/15/09	Added Notes. Revised Shoulder Slope. Revised Stationing for each Typical Section.
DATE	REVISION

STATE OF HAWAII  
DEPARTMENT OF TRANSPORTATION  
HIGHWAYS DIVISION  
**TYPICAL SECTIONS**  
MAMALAOA HIGHWAY  
SAFETY IMPROVEMENTS  
Vicinity of Kiolakaa Homestead Road  
Federal-Aid Project No. HSIP-011-2(37)

Scale: NTS  
Date: September 2009

SHEET No. 1 OF 1 SHEETS