


FED. ROAD DIST. NO.	STATE	FED. AID PROJ. NO.	FISCAL YEAR	SHEET NO.	TOTAL SHEETS
HAWAII	HAW.	HSIP-011-1(25)	2009	7	18

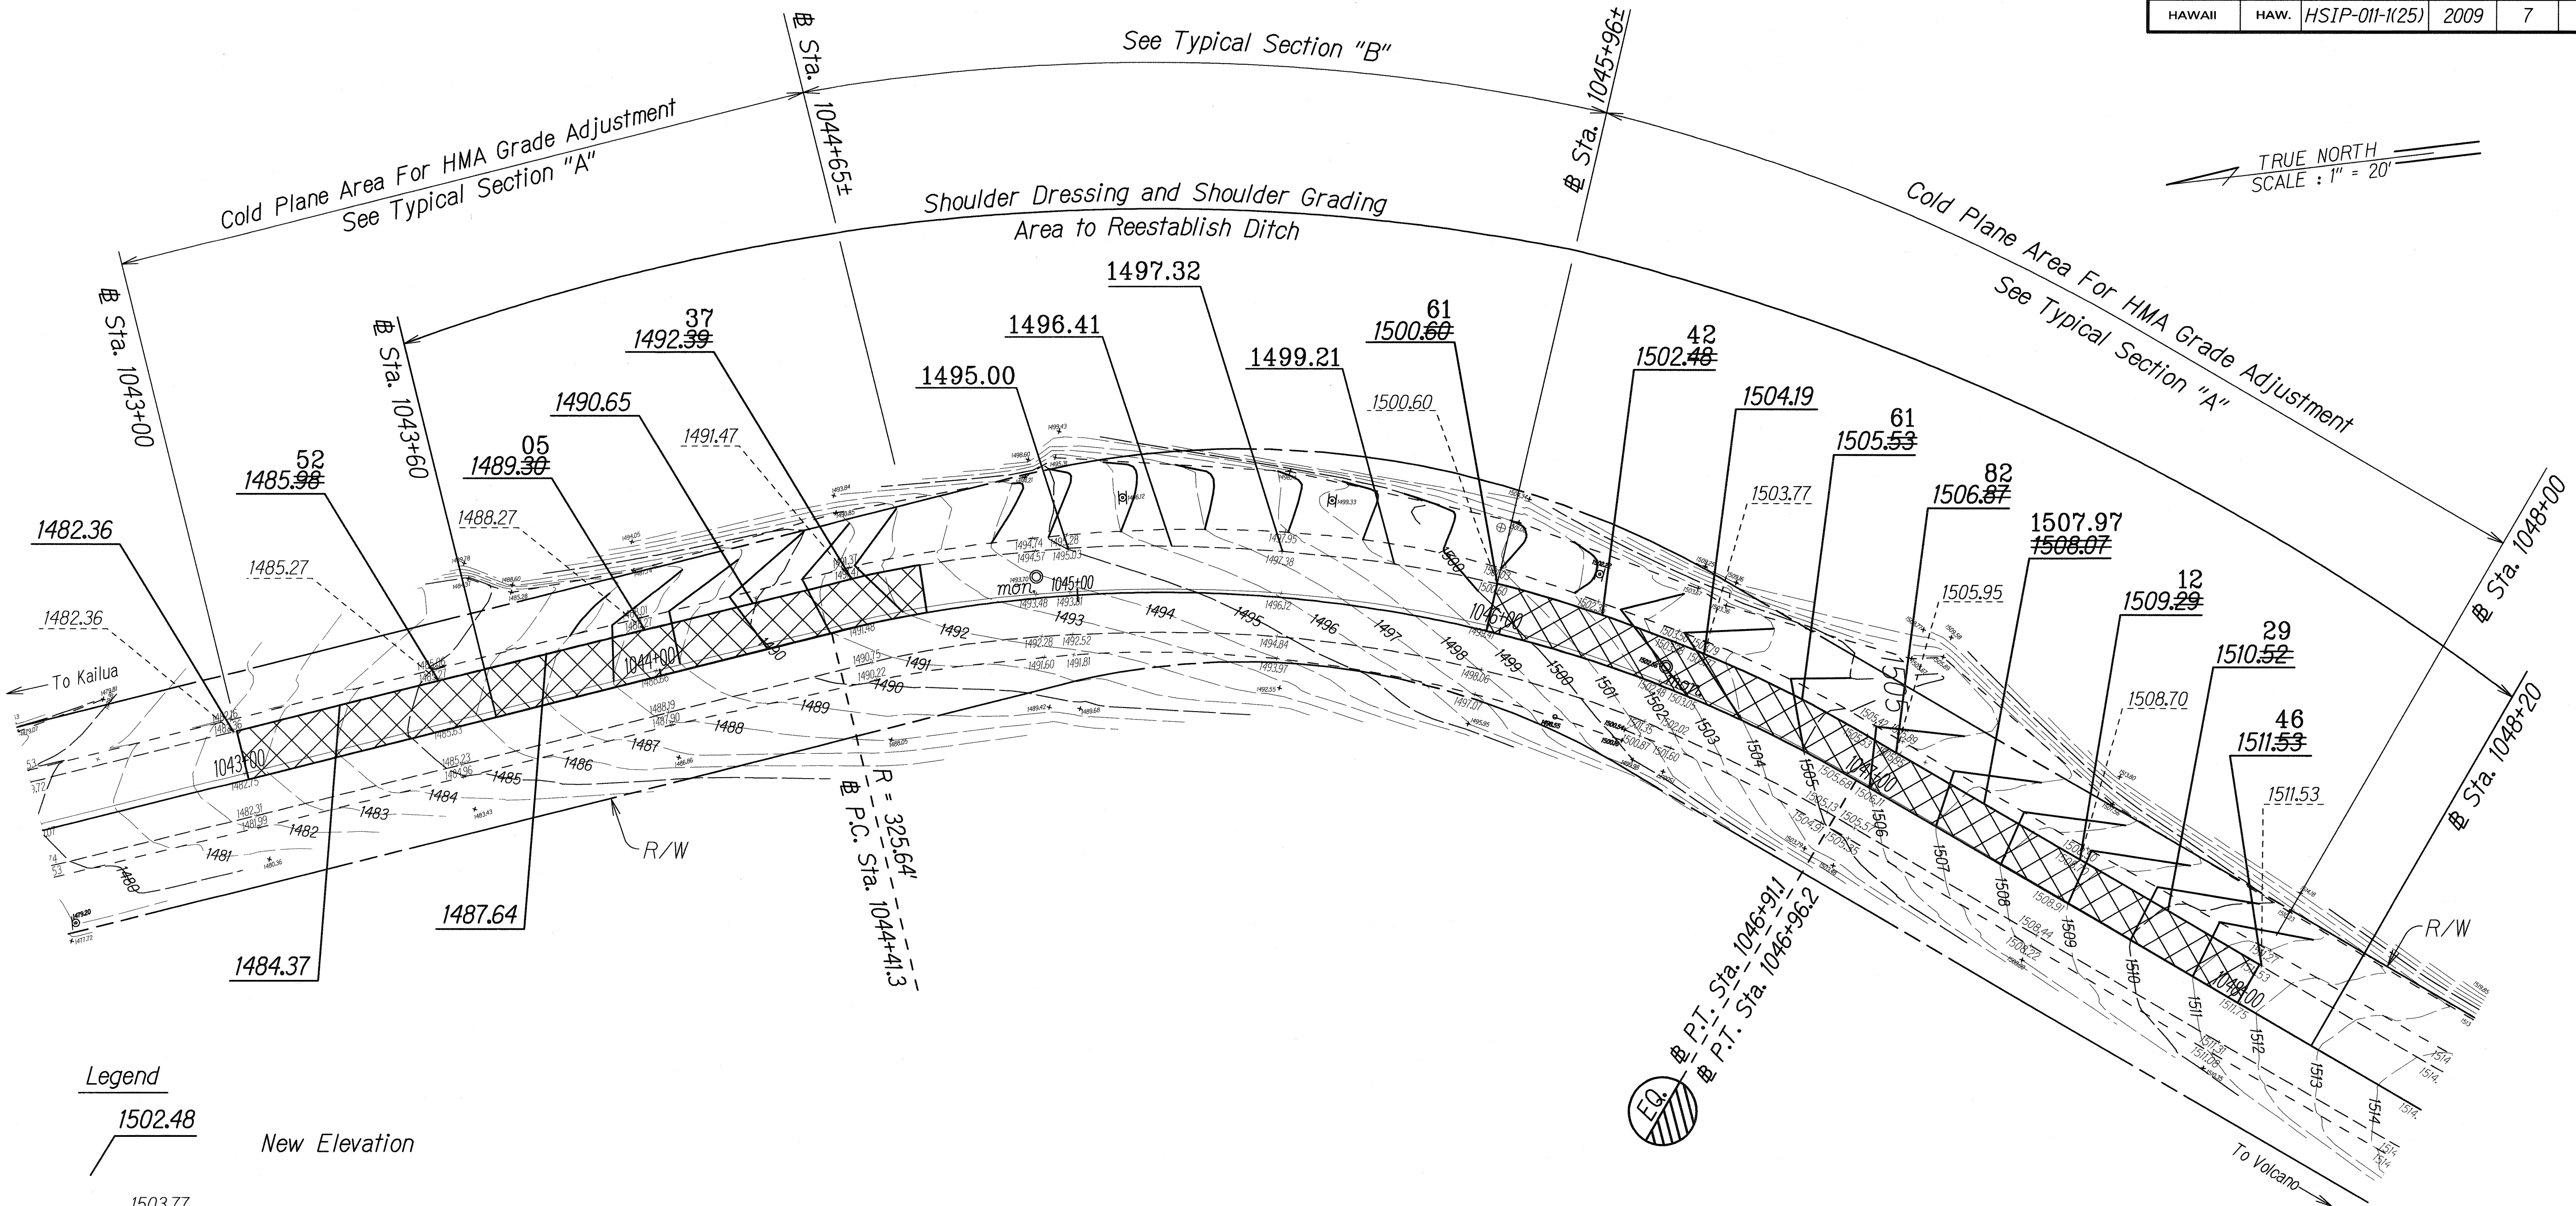

Legend

1502.48
New Elevation

1503.77
Existing Elevation

Cold Plane Area For HMA Pavement Grade Adjustment

NOTE:

1. Shoulder Dressing and Shoulder Grading to Reestablish Ditch Shall Be Considered Incidental to Item No. 401.0100 - HMA Pavement, Mix No. IV.

LEGEND FOR AS-BUILT POSTINGS

Squiggly line for as-built deletion

Double line for as-built deletion

Roadway Text for as-built posting

STATE OF HAWAII
DEPARTMENT OF TRANSPORTATION
HIGHWAYS DIVISION

GRADING PLAN

MAMALAHOA HIGHWAY
SAFETY IMPROVEMENTS
Vicinity of C.Q. Yee Hop Ranch
Federal Aid Project No. HSIP-011-1(25)

Scale: 1"=20' Date: August, 2008

SHEET No. 1 OF 1 SHEETS