



FED. ROAD DIST. NO.	STATE	FED. AID PROJ. NO.	FISCAL YEAR	SHEET NO.	TOTAL SHEETS
HAWAII	HAW.	HSIP-011-K(25)	2009	ADD. 6	18

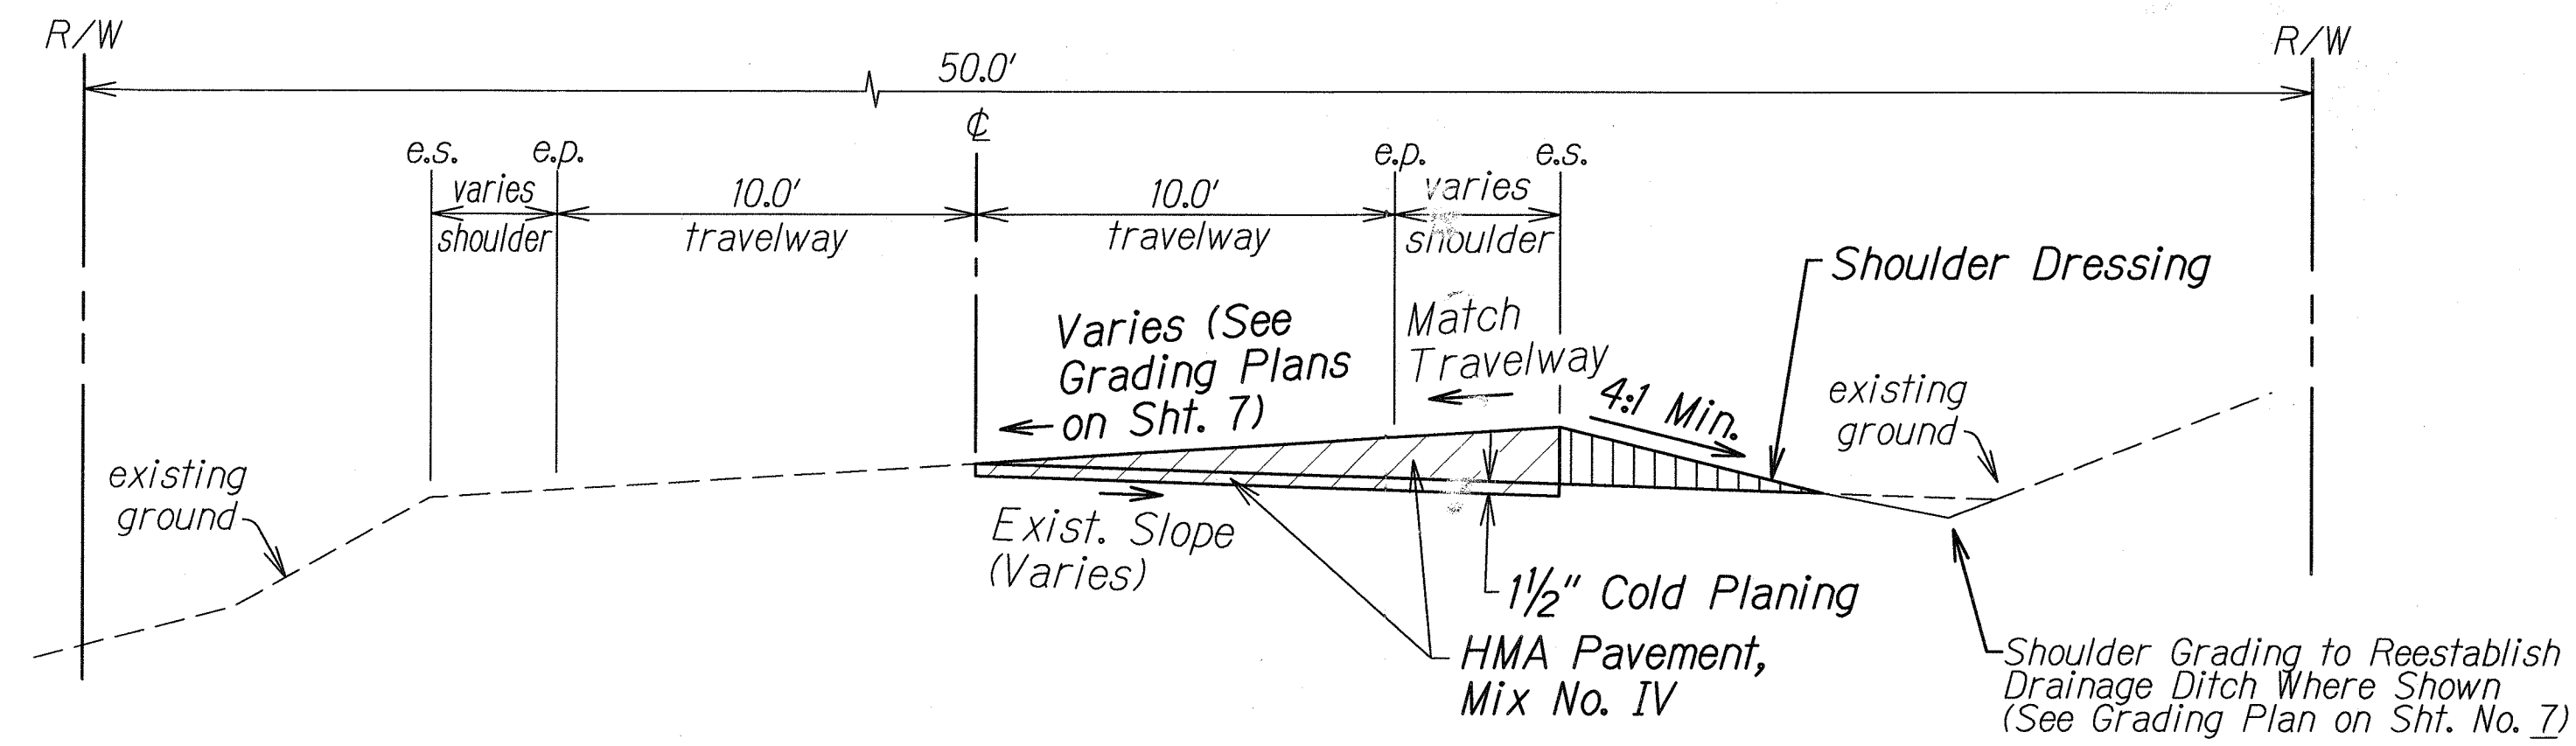

**TYPICAL SECTION "A"**  
Not To Scale

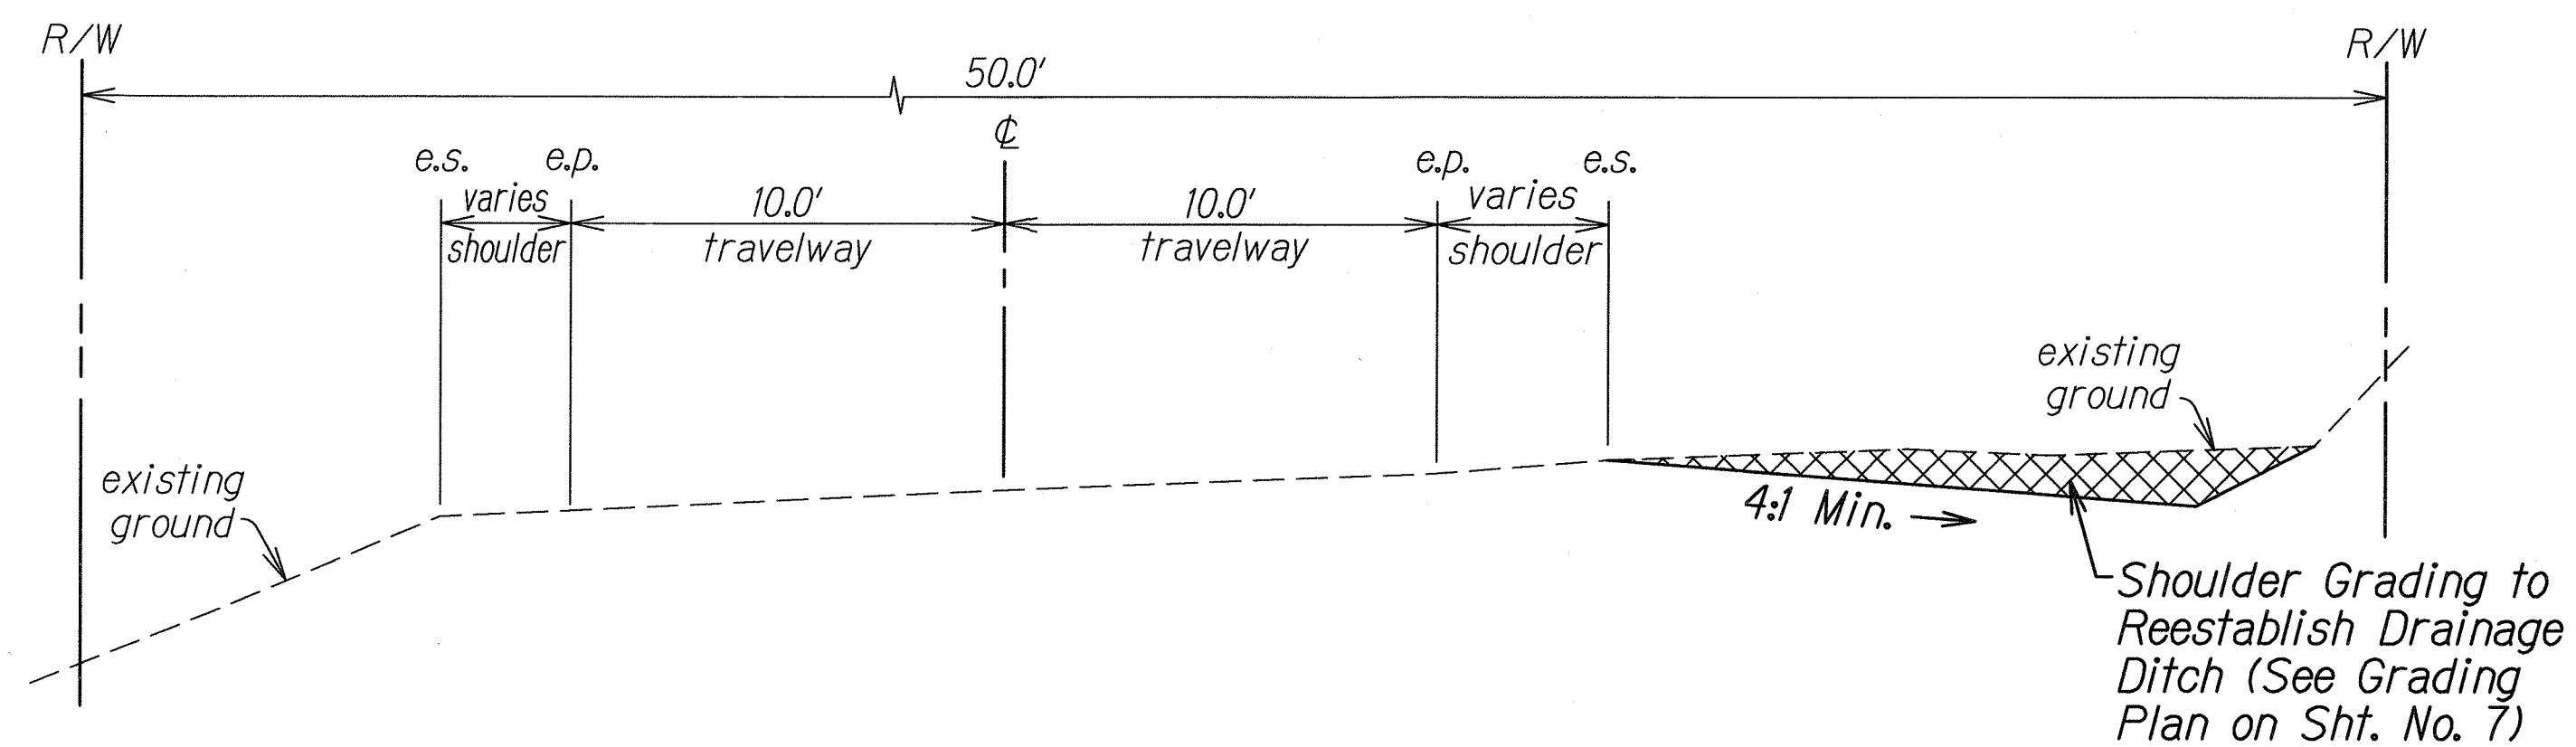

**TYPICAL SECTION "B"**  
Not To Scale

**NOTE:**  
Shoulder Dressing and Shoulder Grading to Reestablish Drainage Ditch Shall Be Considered Incidental to Item No. 401.0100 - HMA Pavement Mix No. IV.

5/27/09	Added shoulder slope and revised sheet number callout
DATE	REVISION
STATE OF HAWAII DEPARTMENT OF TRANSPORTATION HIGHWAYS DIVISION <b>TYPICAL SECTIONS</b> <b>MAMALAHOA HIGHWAY</b> <b>SAFETY IMPROVEMENTS</b> <b>Vicinity of C.Q. Yee Hop Ranch</b> <b>Federal Aid Project No. HSIP-011-K(25)</b> Scale: As Shown Date: May 2009 SHEET No. 1 OF 1 SHEETS	

ORIGINAL PLAN	SURVEY PLOTTED BY	DATE
NOTED BOOK	DRAWN BY	
10/2/09	DESIGNED BY	
anthypld add	CHECKED BY	