

| INDEX TO DRAWINGS |                                                     |
|-------------------|-----------------------------------------------------|
| SHEET NO.         | DESCRIPTION                                         |
| 1                 | TITLE SHEET                                         |
| 2                 | STANDARD PLANS SUMMARY                              |
| 3                 | GENERAL NOTES & LEGEND                              |
| 4 - 5             | WATER POLLUTION & EROSION CONTROL NOTES             |
| 6                 | TYPICAL SECTION                                     |
| 7                 | PLAN AND PROFILE                                    |
| 8                 | PLAN AND SUPERELEVATION                             |
| 9 - 16            | ROADWAY PLANS                                       |
| 17 - 26           | GUARDRAIL DETAILS                                   |
| 27                | GUARDRAIL SCHEDULE                                  |
| 28                | SIGN SCHEDULE                                       |
| 29 - 31           | CROSS SECTIONS                                      |
| 32                | HIGH SPEED UNDIVIDED HIGHWAY WORK ZONE SIGNING PLAN |

STATE OF HAWAI'I

DEPARTMENT OF TRANSPORTATION

HIGHWAYS DIVISION

HONOLULU, HAWAI'I

"AS-BUILT"

PLANS FOR

MAMALAHOA HIGHWAY

GUARDRAIL REPAIRS





VICINITY OF KAHUKU

PROJECT NO. 11E-01-10M

DISTRICT OF KA'U

ISLAND OF HAWAI'I

| FED. ROAD DIST. NO. | STATE | PROJ. NO.  | FISCAL YEAR | SHEET NO. | TOTAL SHEETS |
|---------------------|-------|------------|-------------|-----------|--------------|
| HAWAI'I             | HAW.  | 11E-01-10M | 2010        | 1         | 32           |

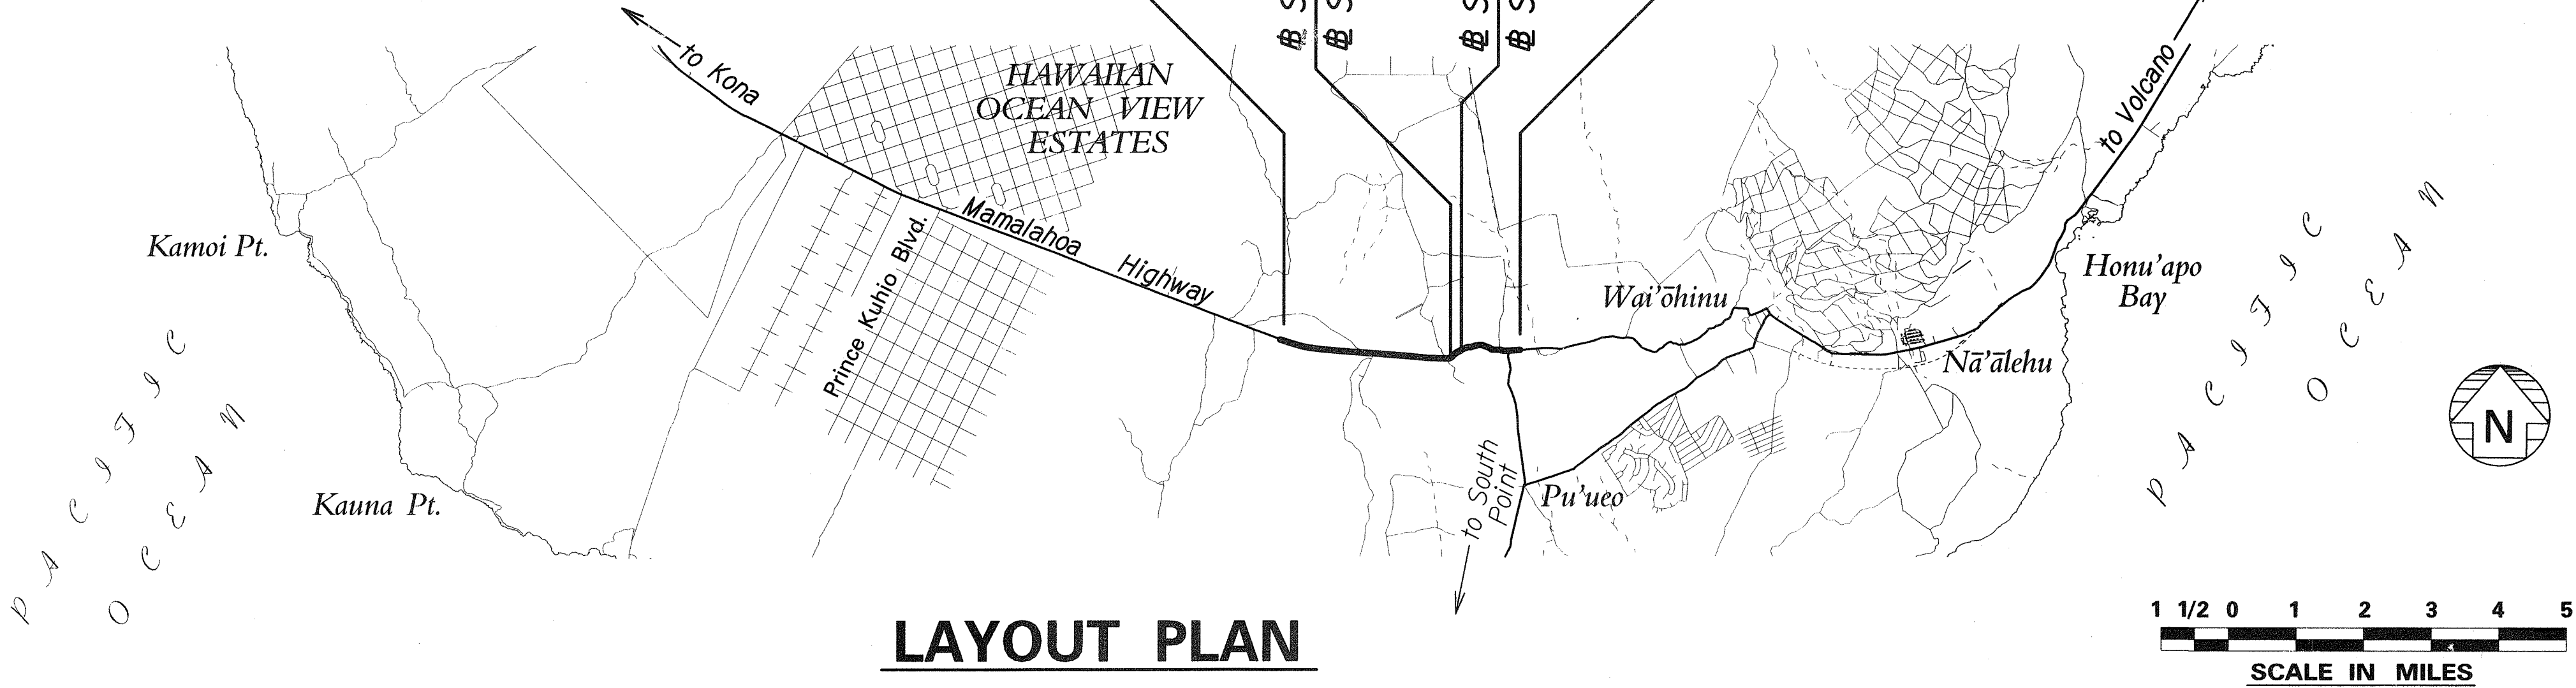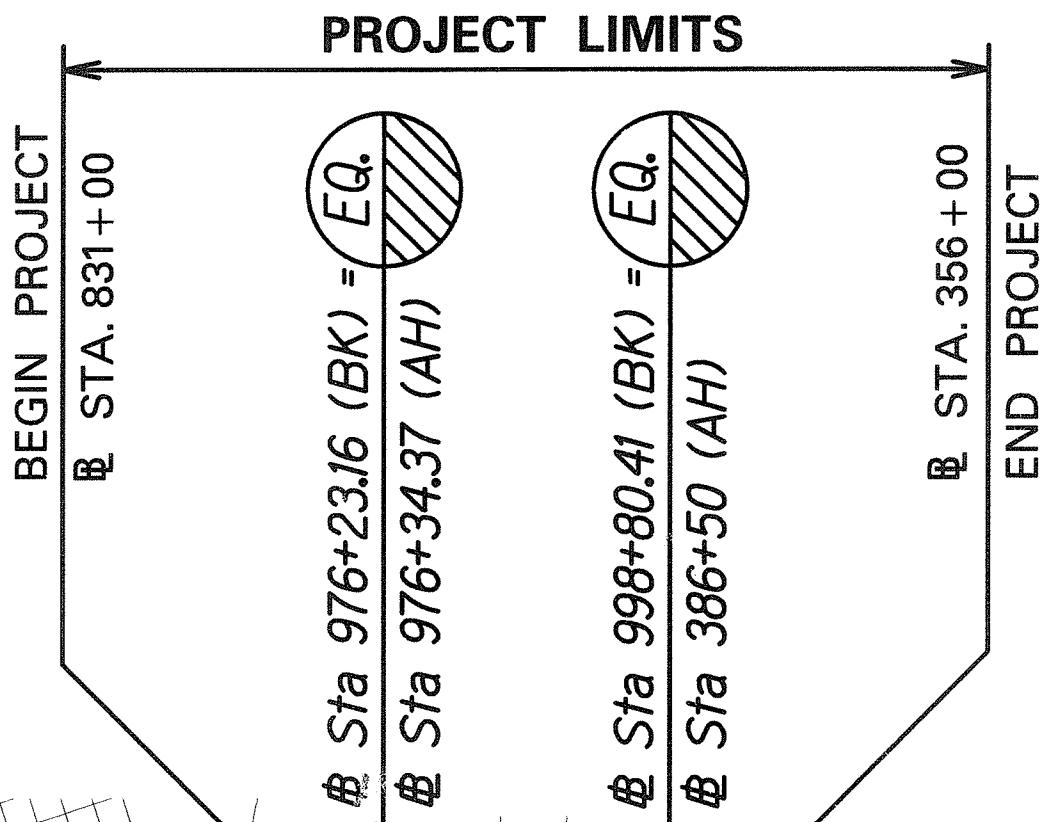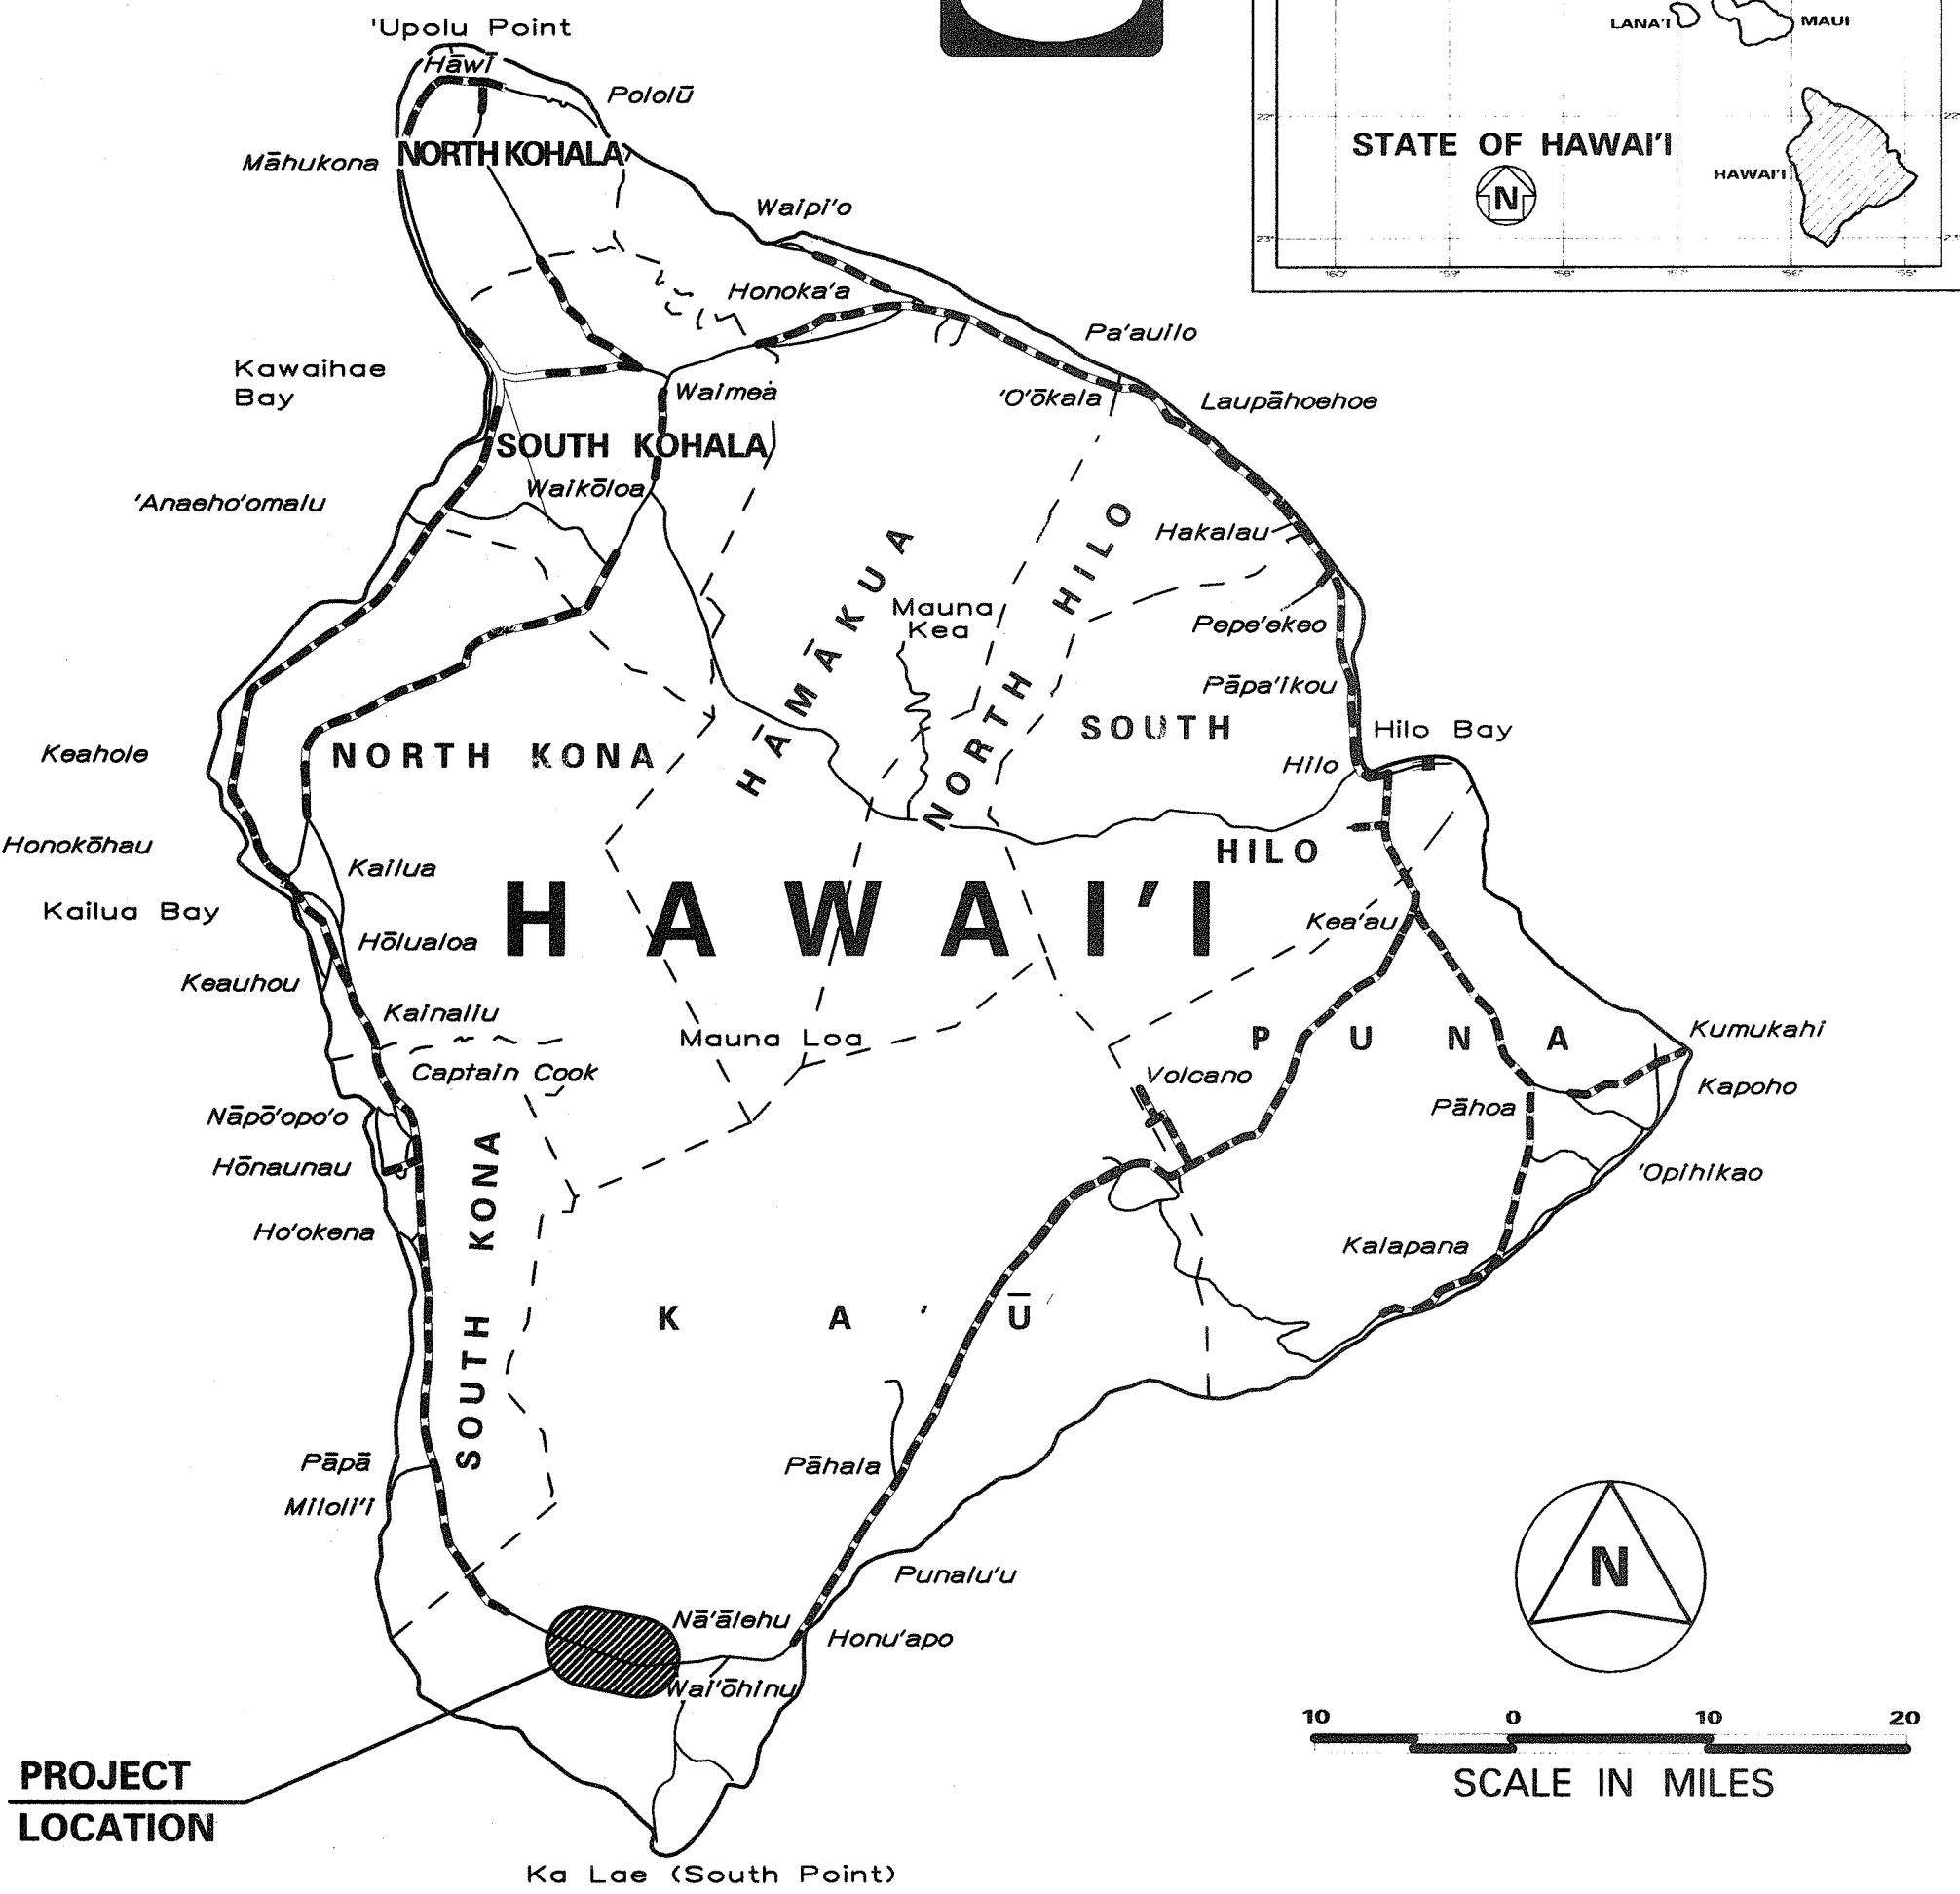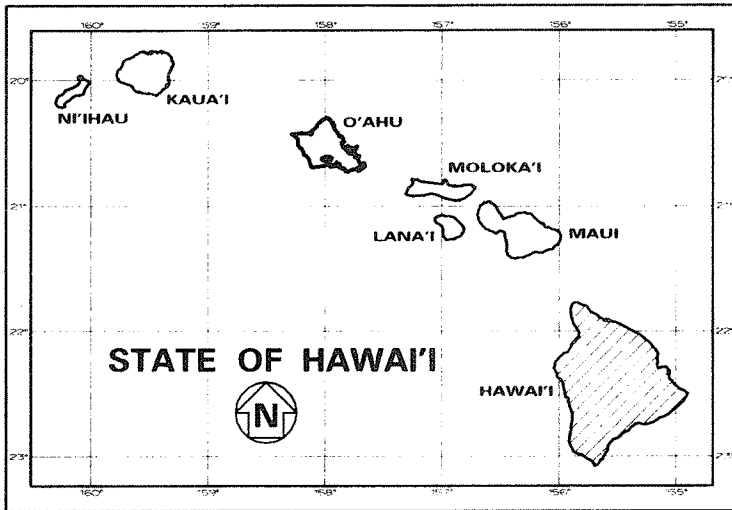

FEDERAL AID PROJECTS PREVIOUSLY CONSTRUCTED OR UNDER CONSTRUCTION

MILE POST 73.00 TO MILE POST 69.00

NO SIGNIFICANT CHANGES WERE MADE DURING CONSTRUCTION ON THESE PLANS EXCEPT CHANGES IN THE ORIGINAL THEORETICAL QUANTITIES. FOR ACTUAL QUANTITIES, REFER TO PROJECT LEDGER AND/OR COMPUTATION BOOK.

DEPARTMENT OF TRANSPORTATION  
STATE OF HAWAI'I

APPROVED:

DIR. OF TRANSPORTATION

DATE

HAWAII DISTRICT DESIGNED BY

HWY-HE

P. S. & E. BY

933-8866

PHONE

MAY, 2010

DATE