


FED. ROAD DIST. NO.	STATE	FED. AID PROJ. NO.	FISCAL YEAR	SHEET NO.	TOTAL SHEETS
HAWAII	HAW.	STP-011-1(026)	2012	7	21

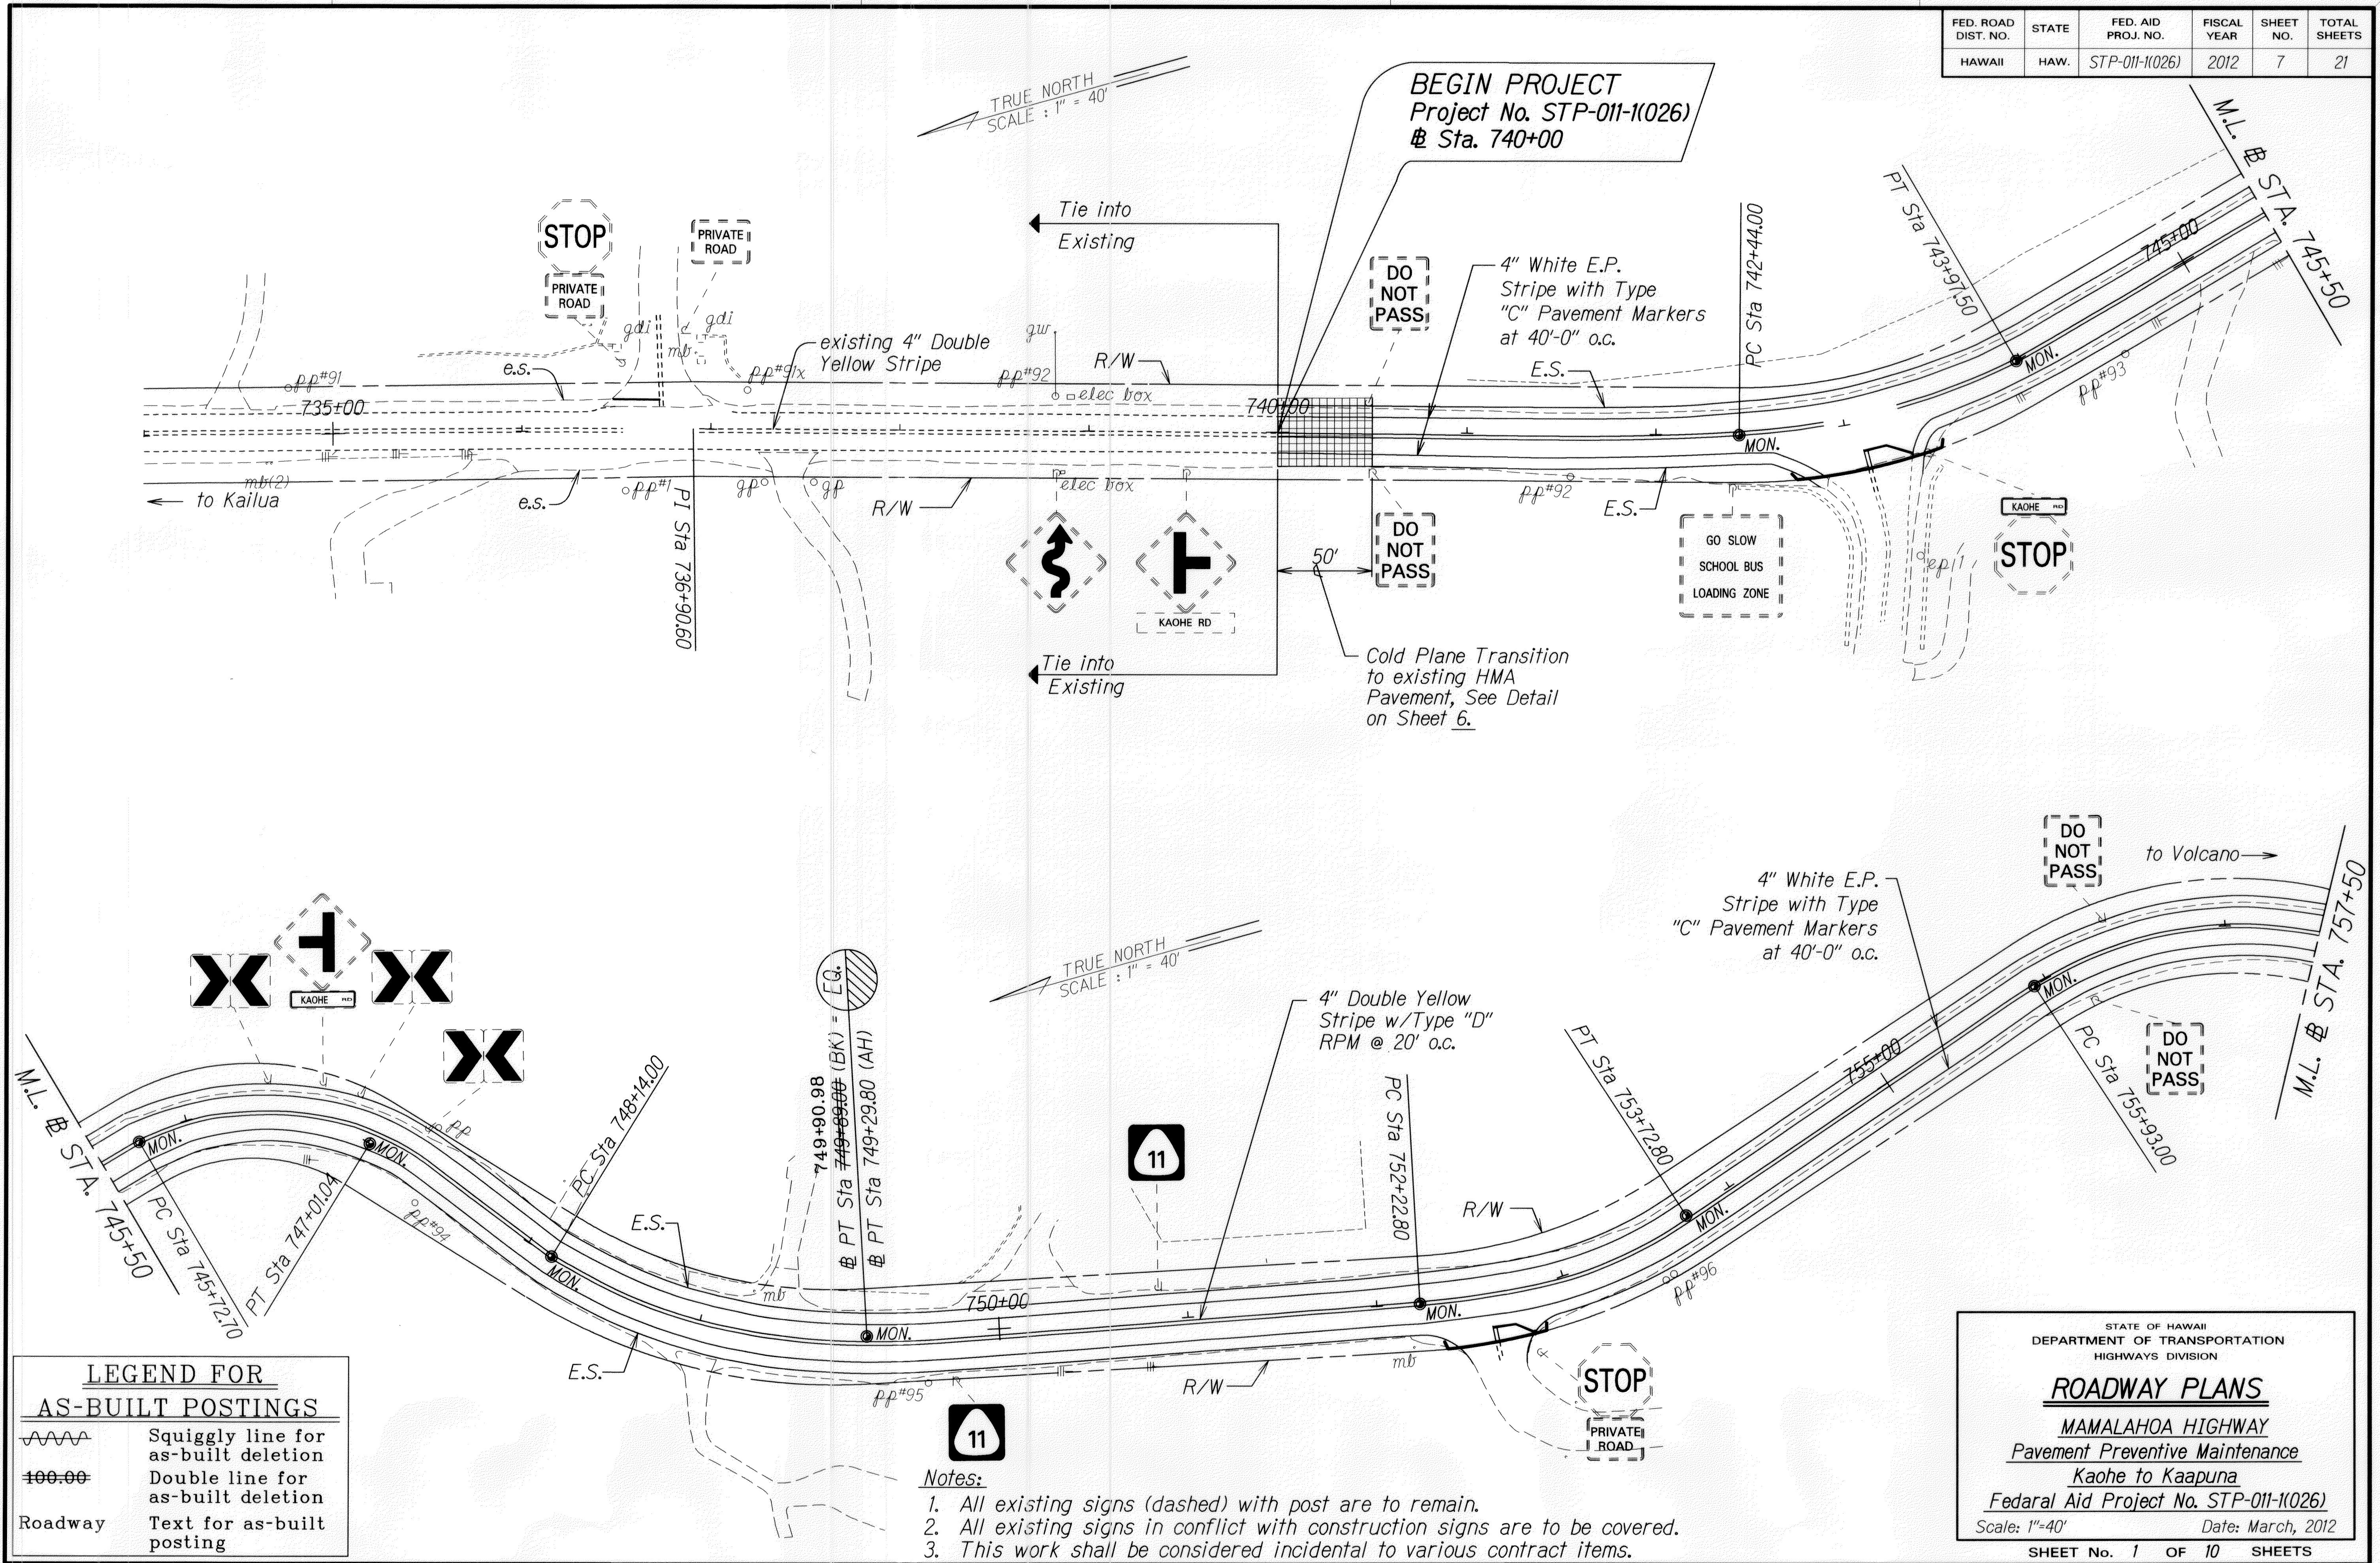

LEGEND FOR AS-BUILT POSTINGS

	Squiggly line for as-built deletion
	Double line for as-built deletion
Roadway	Text for as-built posting

- Notes:**
1. All existing signs (dashed) with post are to remain.
 2. All existing signs in conflict with construction signs are to be covered.
 3. This work shall be considered incidental to various contract items.

STATE OF HAWAII
DEPARTMENT OF TRANSPORTATION
HIGHWAYS DIVISION

ROADWAY PLANS


MAMALAHOA HIGHWAY
Pavement Preventive Maintenance
Kaohe to Kaapuna
Federal Aid Project No. STP-011-1(026)

Scale: 1"=40' Date: March, 2012

SHEET No. 1 OF 10 SHEETS

"AS-BUILT"

FED. ROAD DIST. NO.	STATE	FED. AID PROJ. NO.	FISCAL YEAR	SHEET NO.	TOTAL SHEETS
HAWAII	HAW.	STP-011-110261	2012	8	21

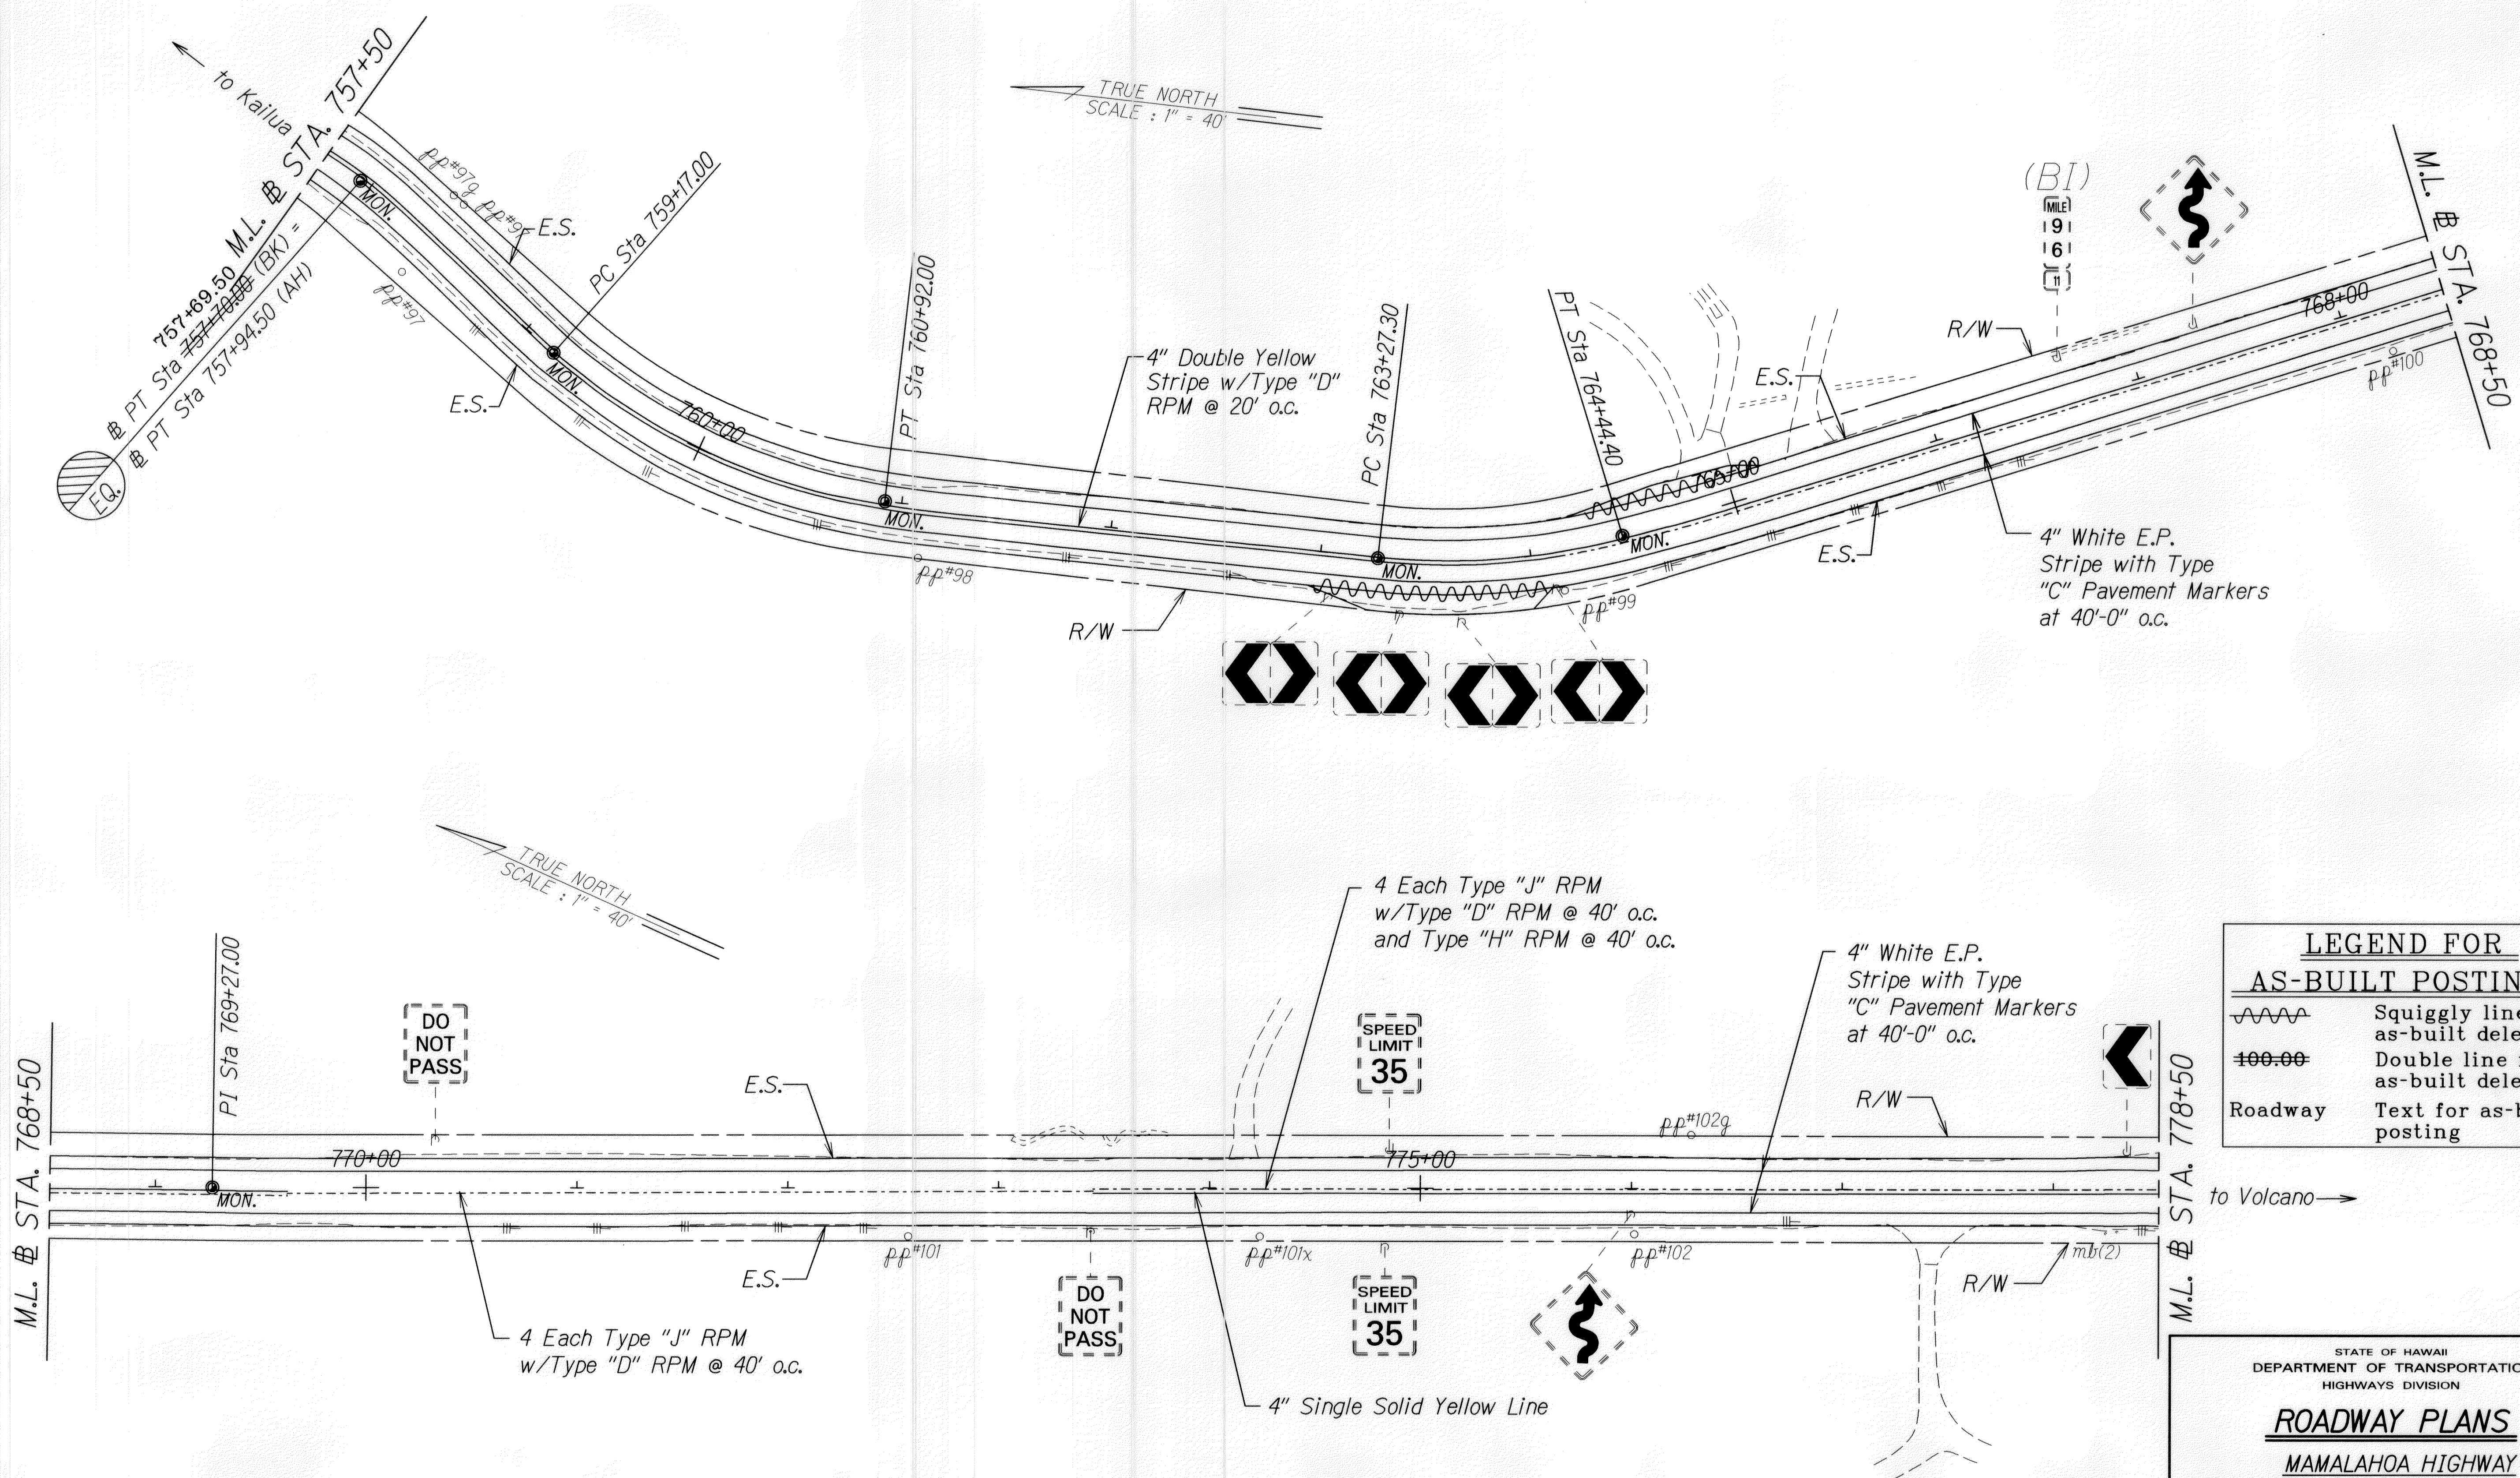

LEGEND FOR AS-BUILT POSTINGS	
	Squiggly line for as-built deletion
	Double line for as-built deletion
Roadway	Text for as-built posting

STATE OF HAWAII
DEPARTMENT OF TRANSPORTATION
HIGHWAYS DIVISION

ROADWAY PLANS
MAMALAHOA HIGHWAY
Pavement Preventive Maintenance
Kaohe to Kaapuna
Federal Aid Project No. STP-011-110261
Scale: 1"=40' Date: March, 2012


SHEET No. 2 OF 10 SHEETS

- Notes:
1. All existing signs (dashed) with post are to remain.
 2. All existing signs in conflict with construction signs are to be covered.
 3. This work shall be considered incidental to various contract items.

ORIGINAL PLAN	SURVEY PLOTTED BY	DATE
NOTE BOOK	DRAWN BY	
DESIGNED BY	NOTED BY	
CHECKED BY	QUANTITIES BY	
	NEP/2012/01/01	


"AS-BUILT"

FED. ROAD DIST. NO.	STATE	FED. AID PROJ. NO.	FISCAL YEAR	SHEET NO.	TOTAL SHEETS
HAWAII	HAW.	STP-011-1(026)	2012	9	21

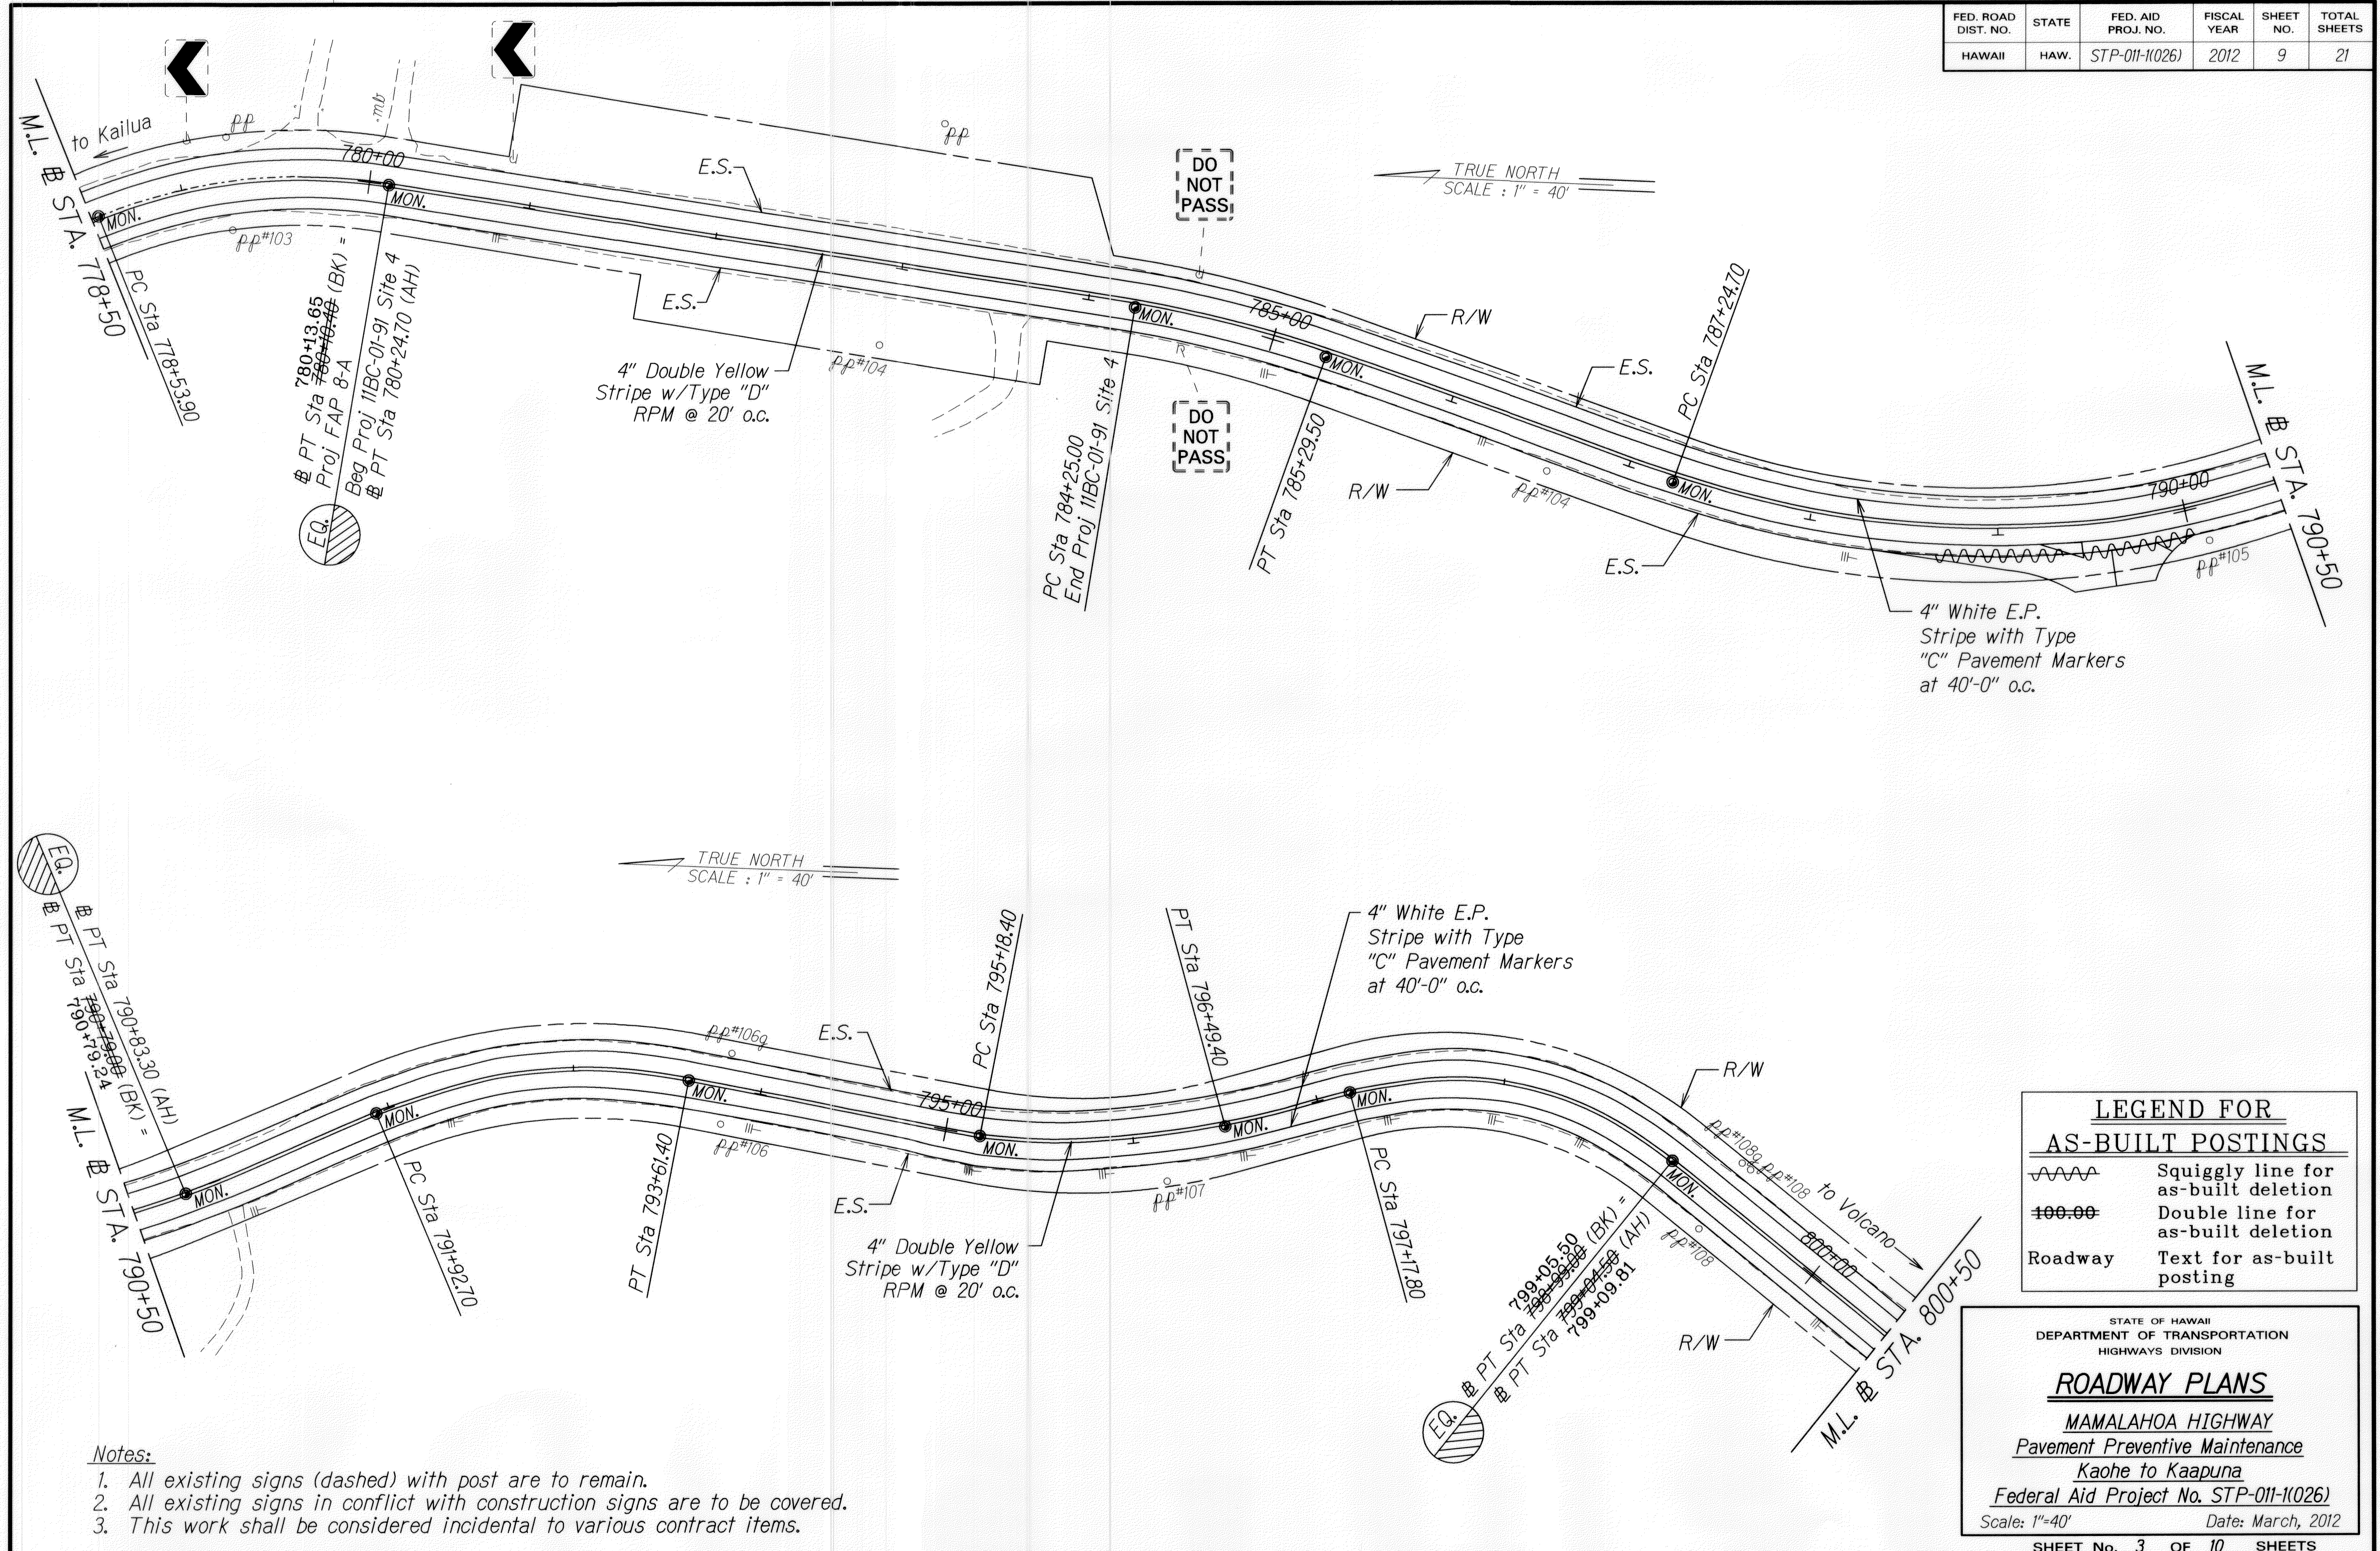

"AS-BUILT"

FED. ROAD DIST. NO.	STATE	FED. AID PROJ. NO.	FISCAL YEAR	SHEET NO.	TOTAL SHEETS
HAWAII	HAW.	STP-011-1(026)	2012	10	21

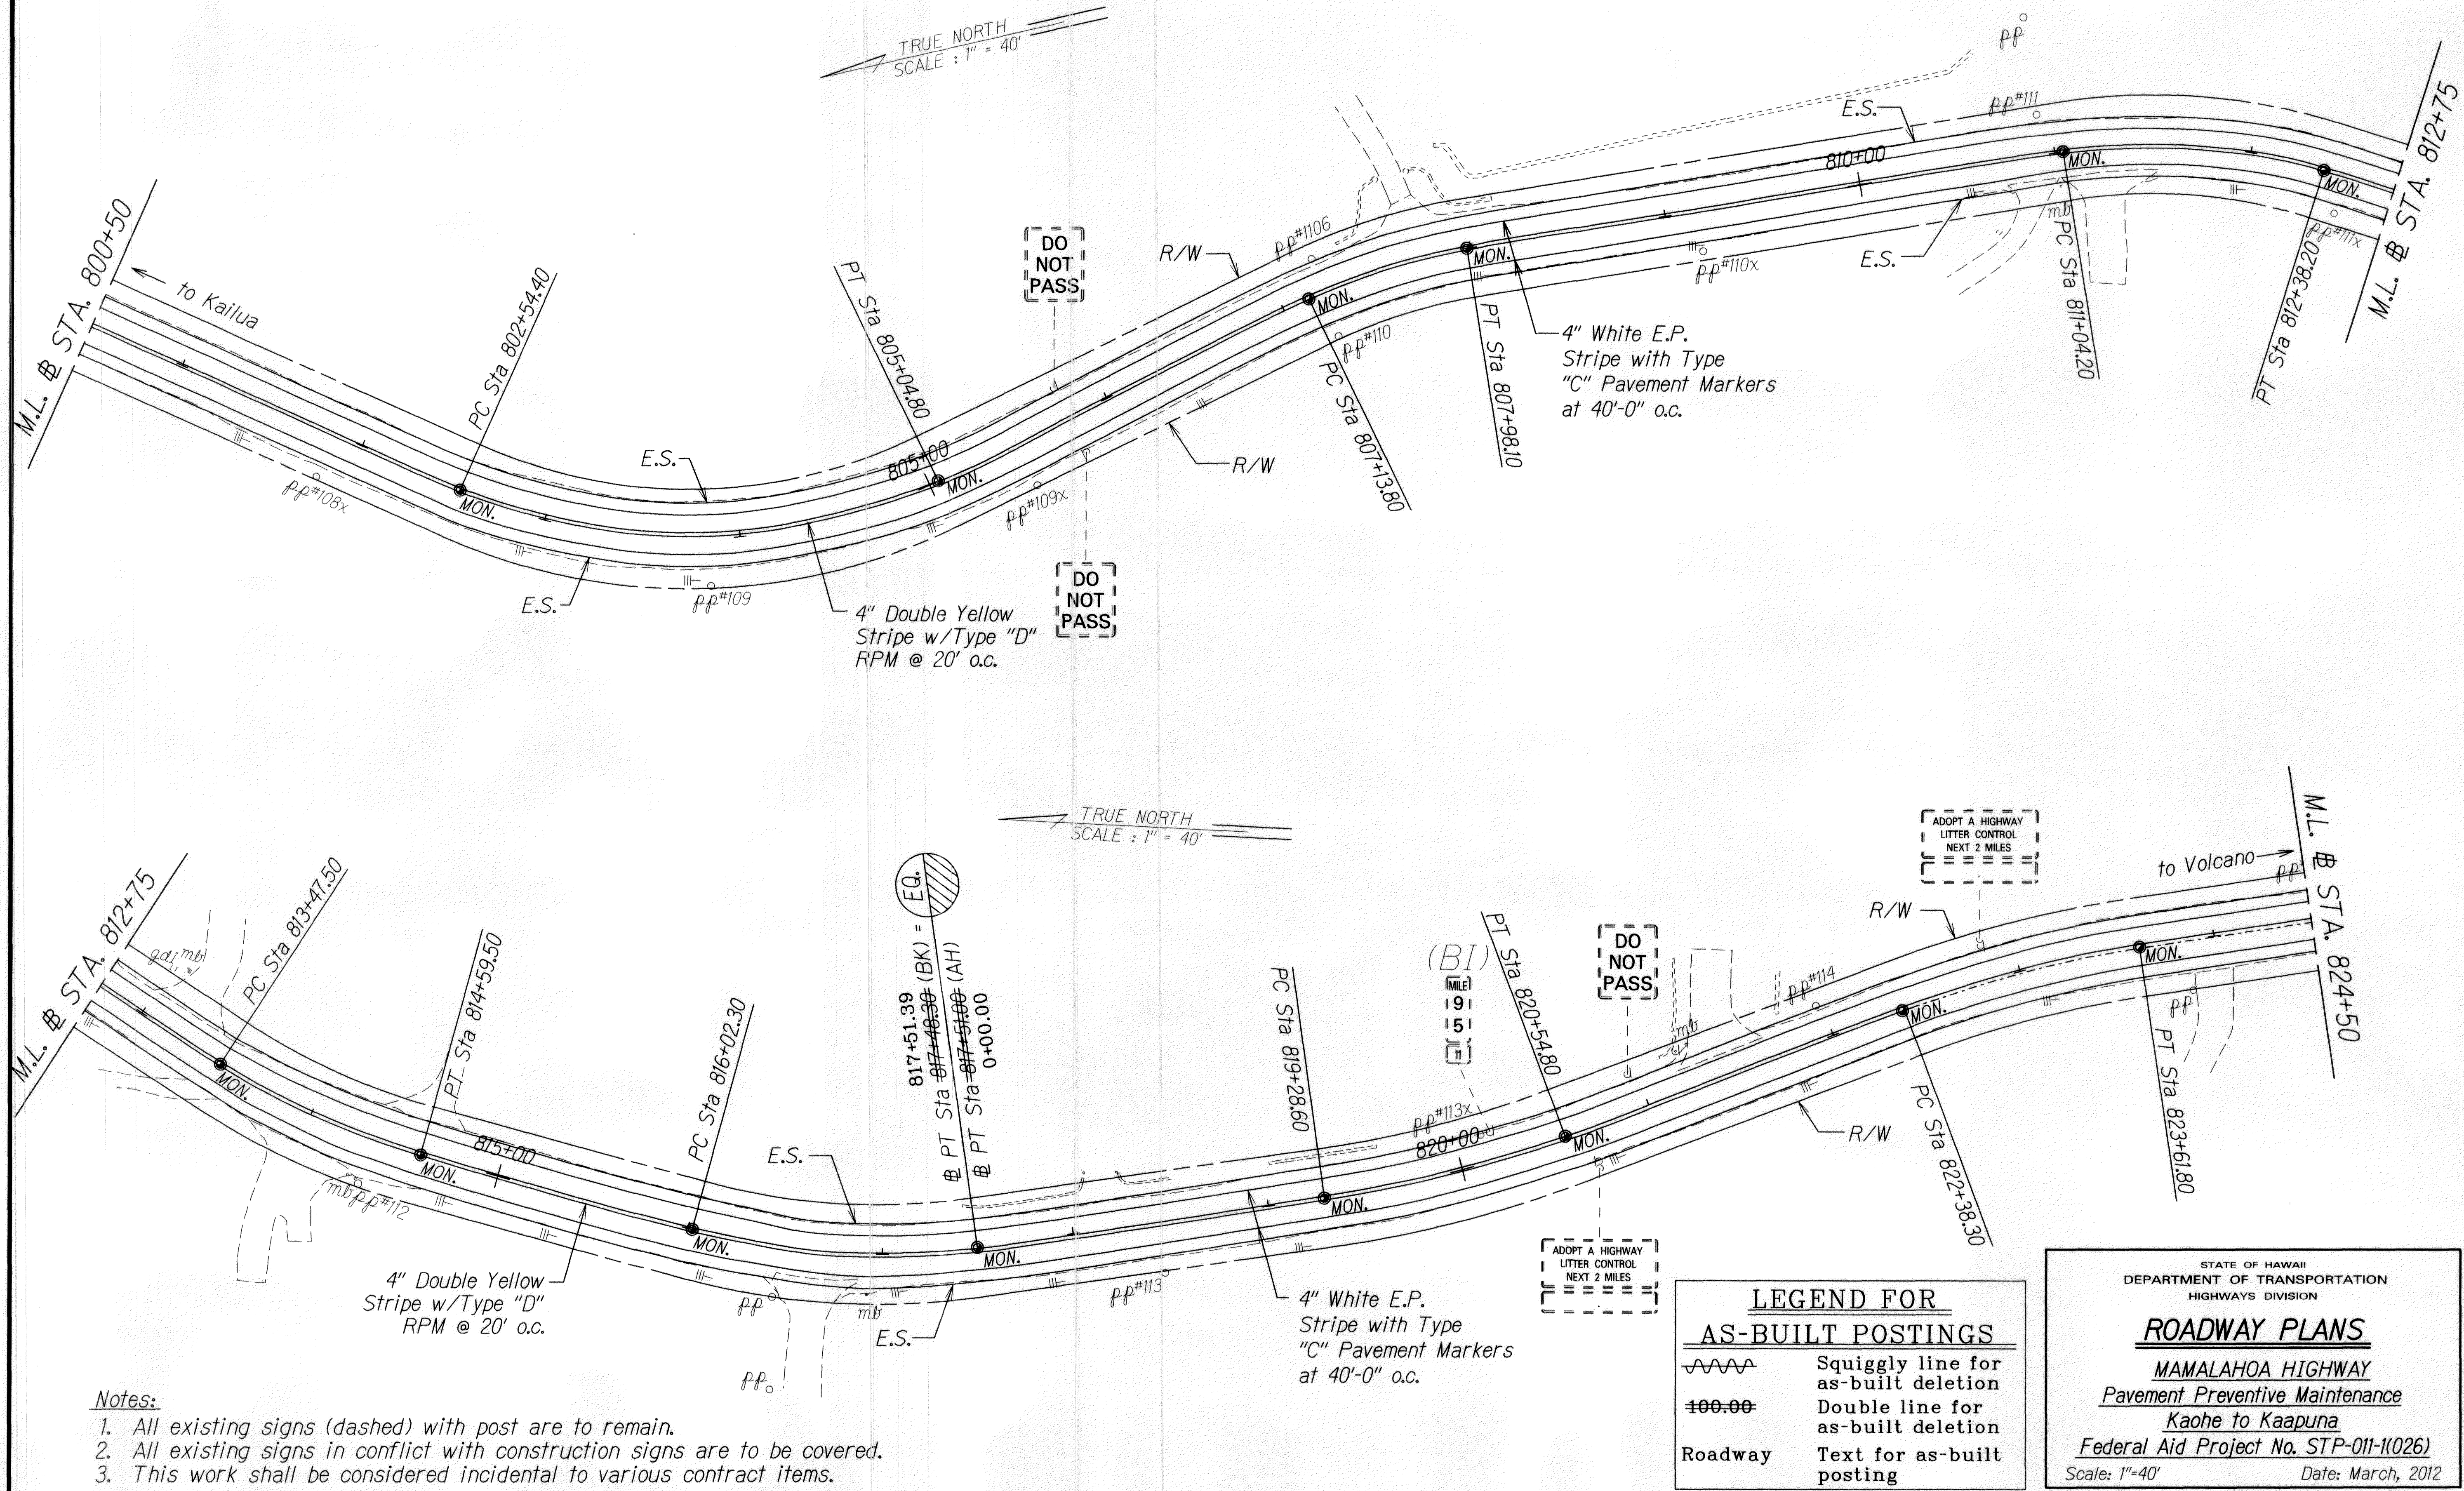

ORIGINAL PLAN	SURVEY PLOTTED BY	DATE
NOTE BOOK	DRAWN BY	
QUANTITIES BY	TRACED BY	
CHECKED BY	NOTED BY	

- Notes:
1. All existing signs (dashed) with post are to remain.
 2. All existing signs in conflict with construction signs are to be covered.
 3. This work shall be considered incidental to various contract items.


LEGEND FOR AS-BUILT POSTINGS	
	Squiggly line for as-built deletion
	Double line for as-built deletion
Roadway	Text for as-built posting

STATE OF HAWAII
DEPARTMENT OF TRANSPORTATION
HIGHWAYS DIVISION

ROADWAY PLANS
MAMALAHOA HIGHWAY
Pavement Preventive Maintenance
Kaohe to Kaapuna
Federal Aid Project No. STP-011-1(026)
Scale: 1"=40' Date: March, 2012
SHEET No. 4 OF 10 SHEETS


"AS-BUILT"

FED. ROAD DIST. NO.	STATE	FED. AID PROJ. NO.	FISCAL YEAR	SHEET NO.	TOTAL SHEETS
HAWAII	HAW.	STP-011-1(026)	2012	11	21

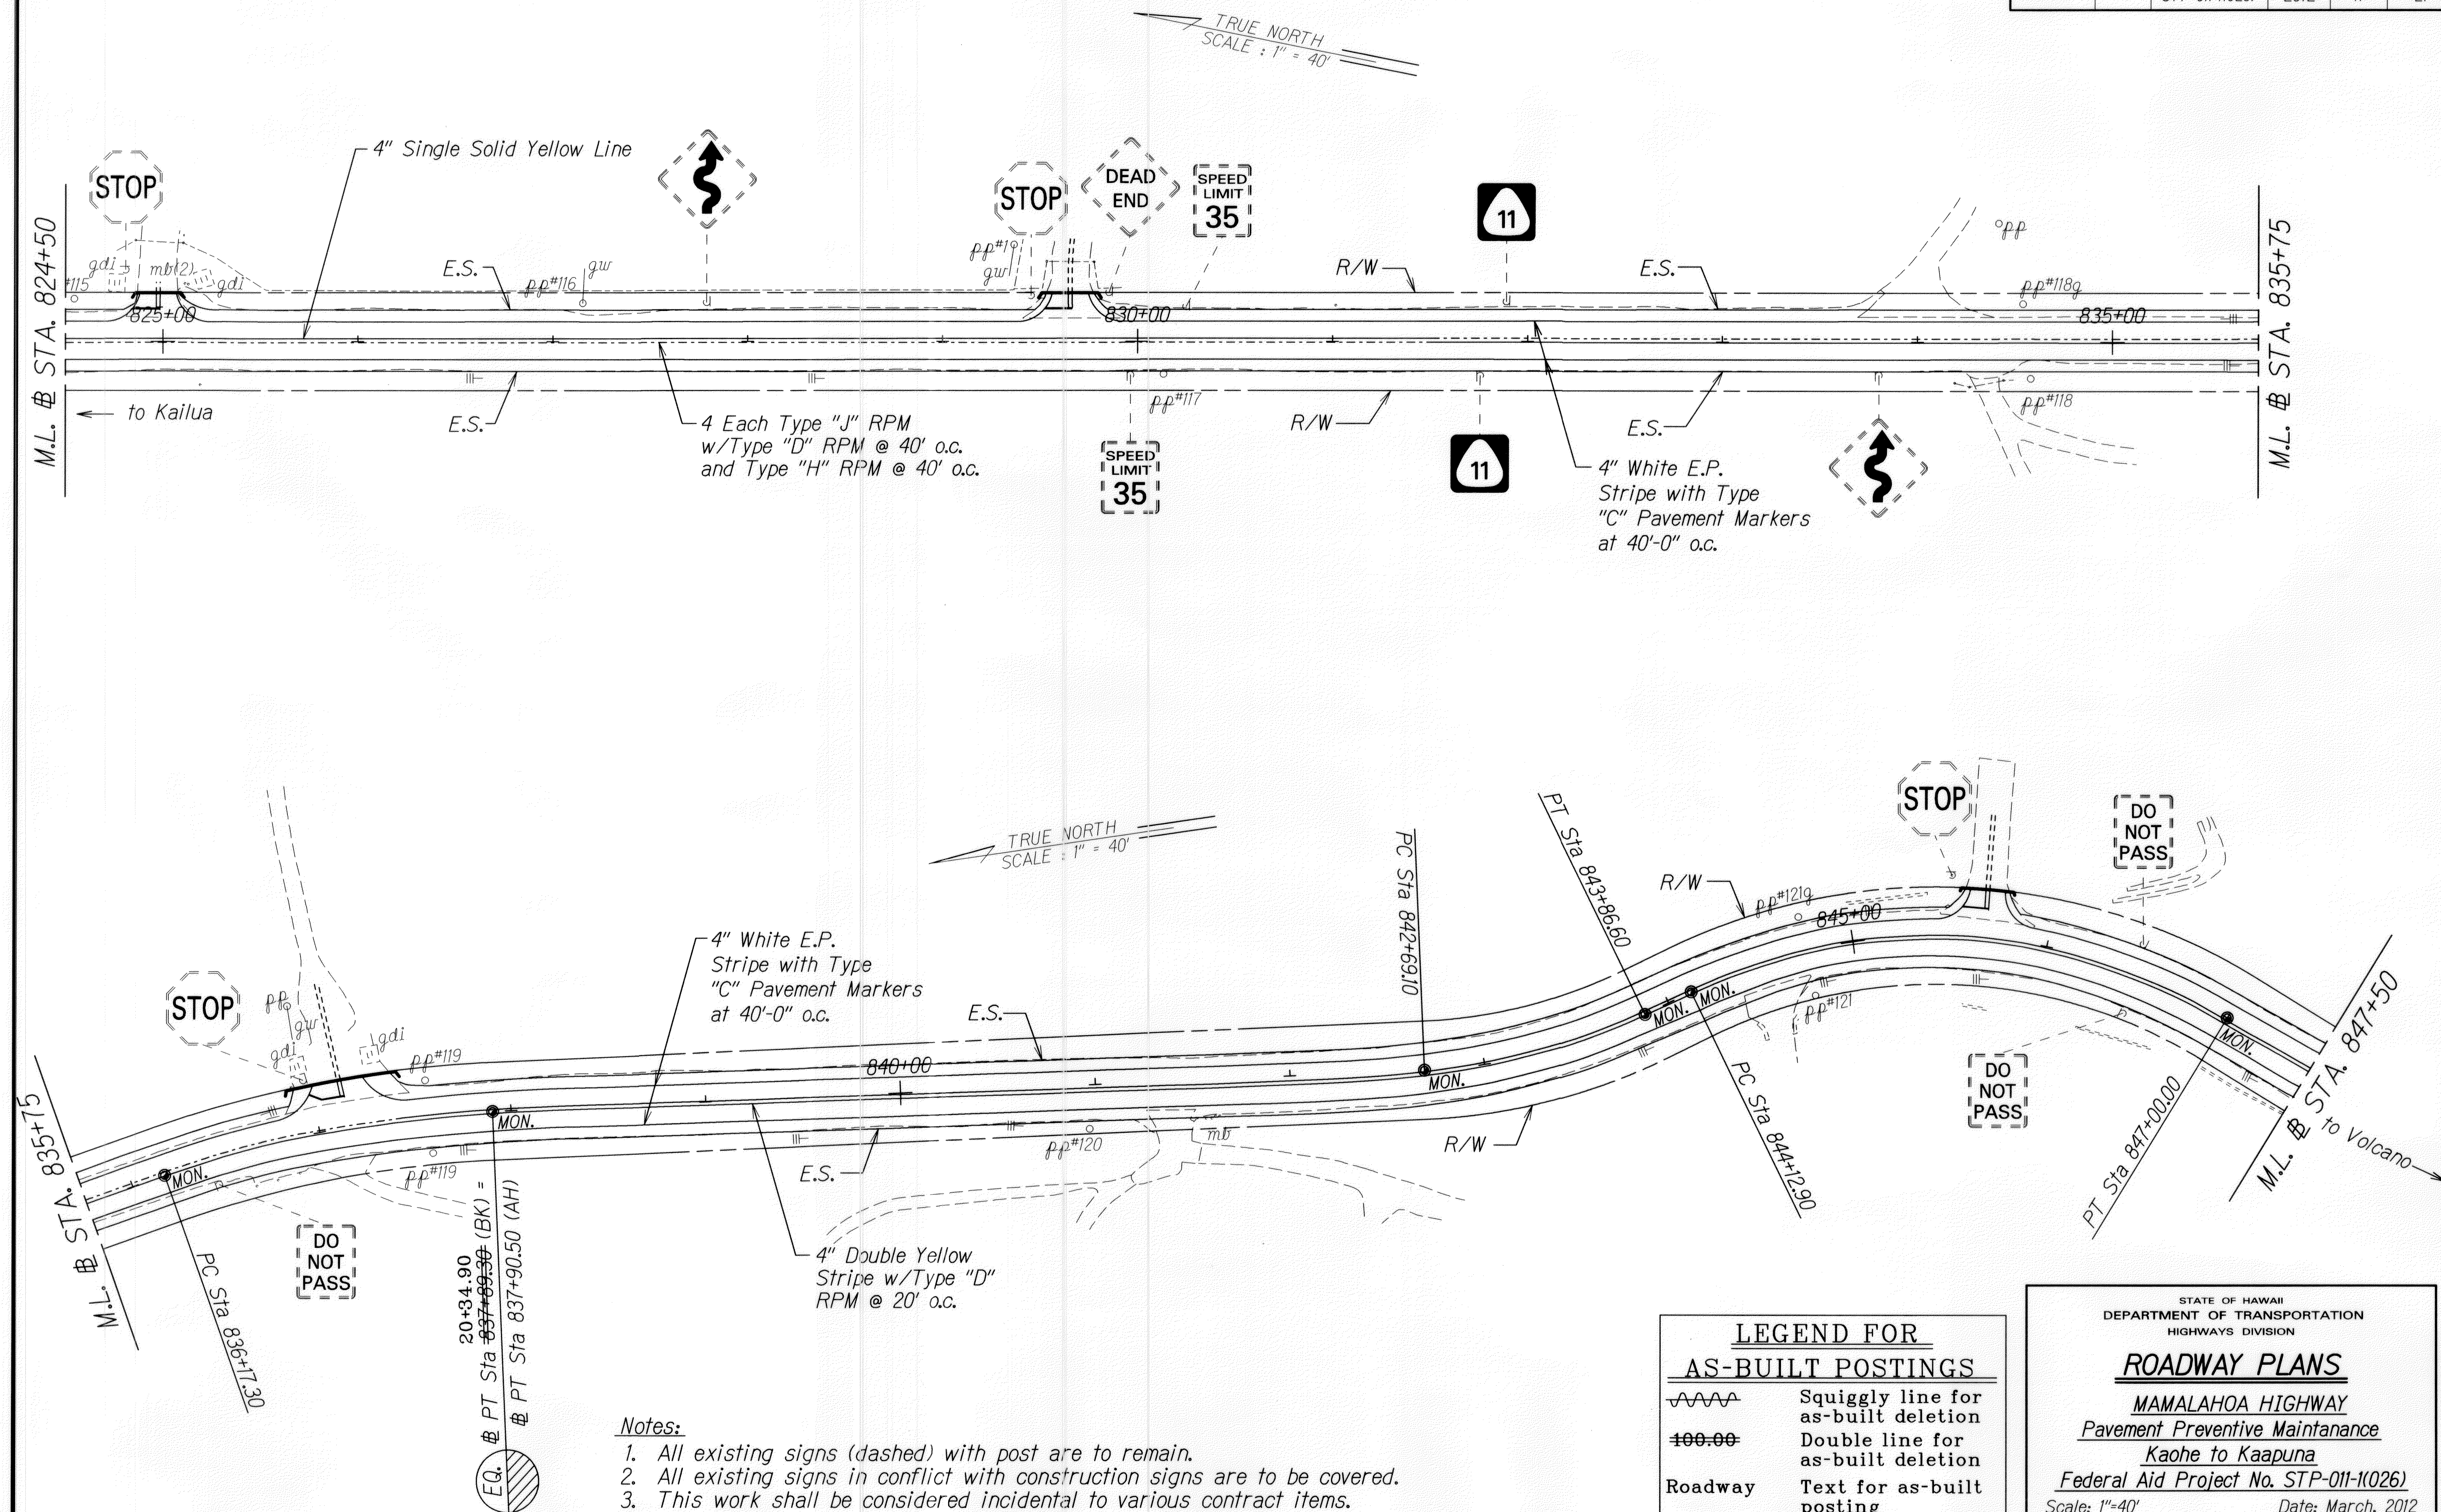

"AS-BUILT"

FED. ROAD DIST. NO.	STATE	FED. AID PROJ. NO.	FISCAL YEAR	SHEET NO.	TOTAL SHEETS
HAWAII	HAW.	STP-011-1(026)	2012	12	21

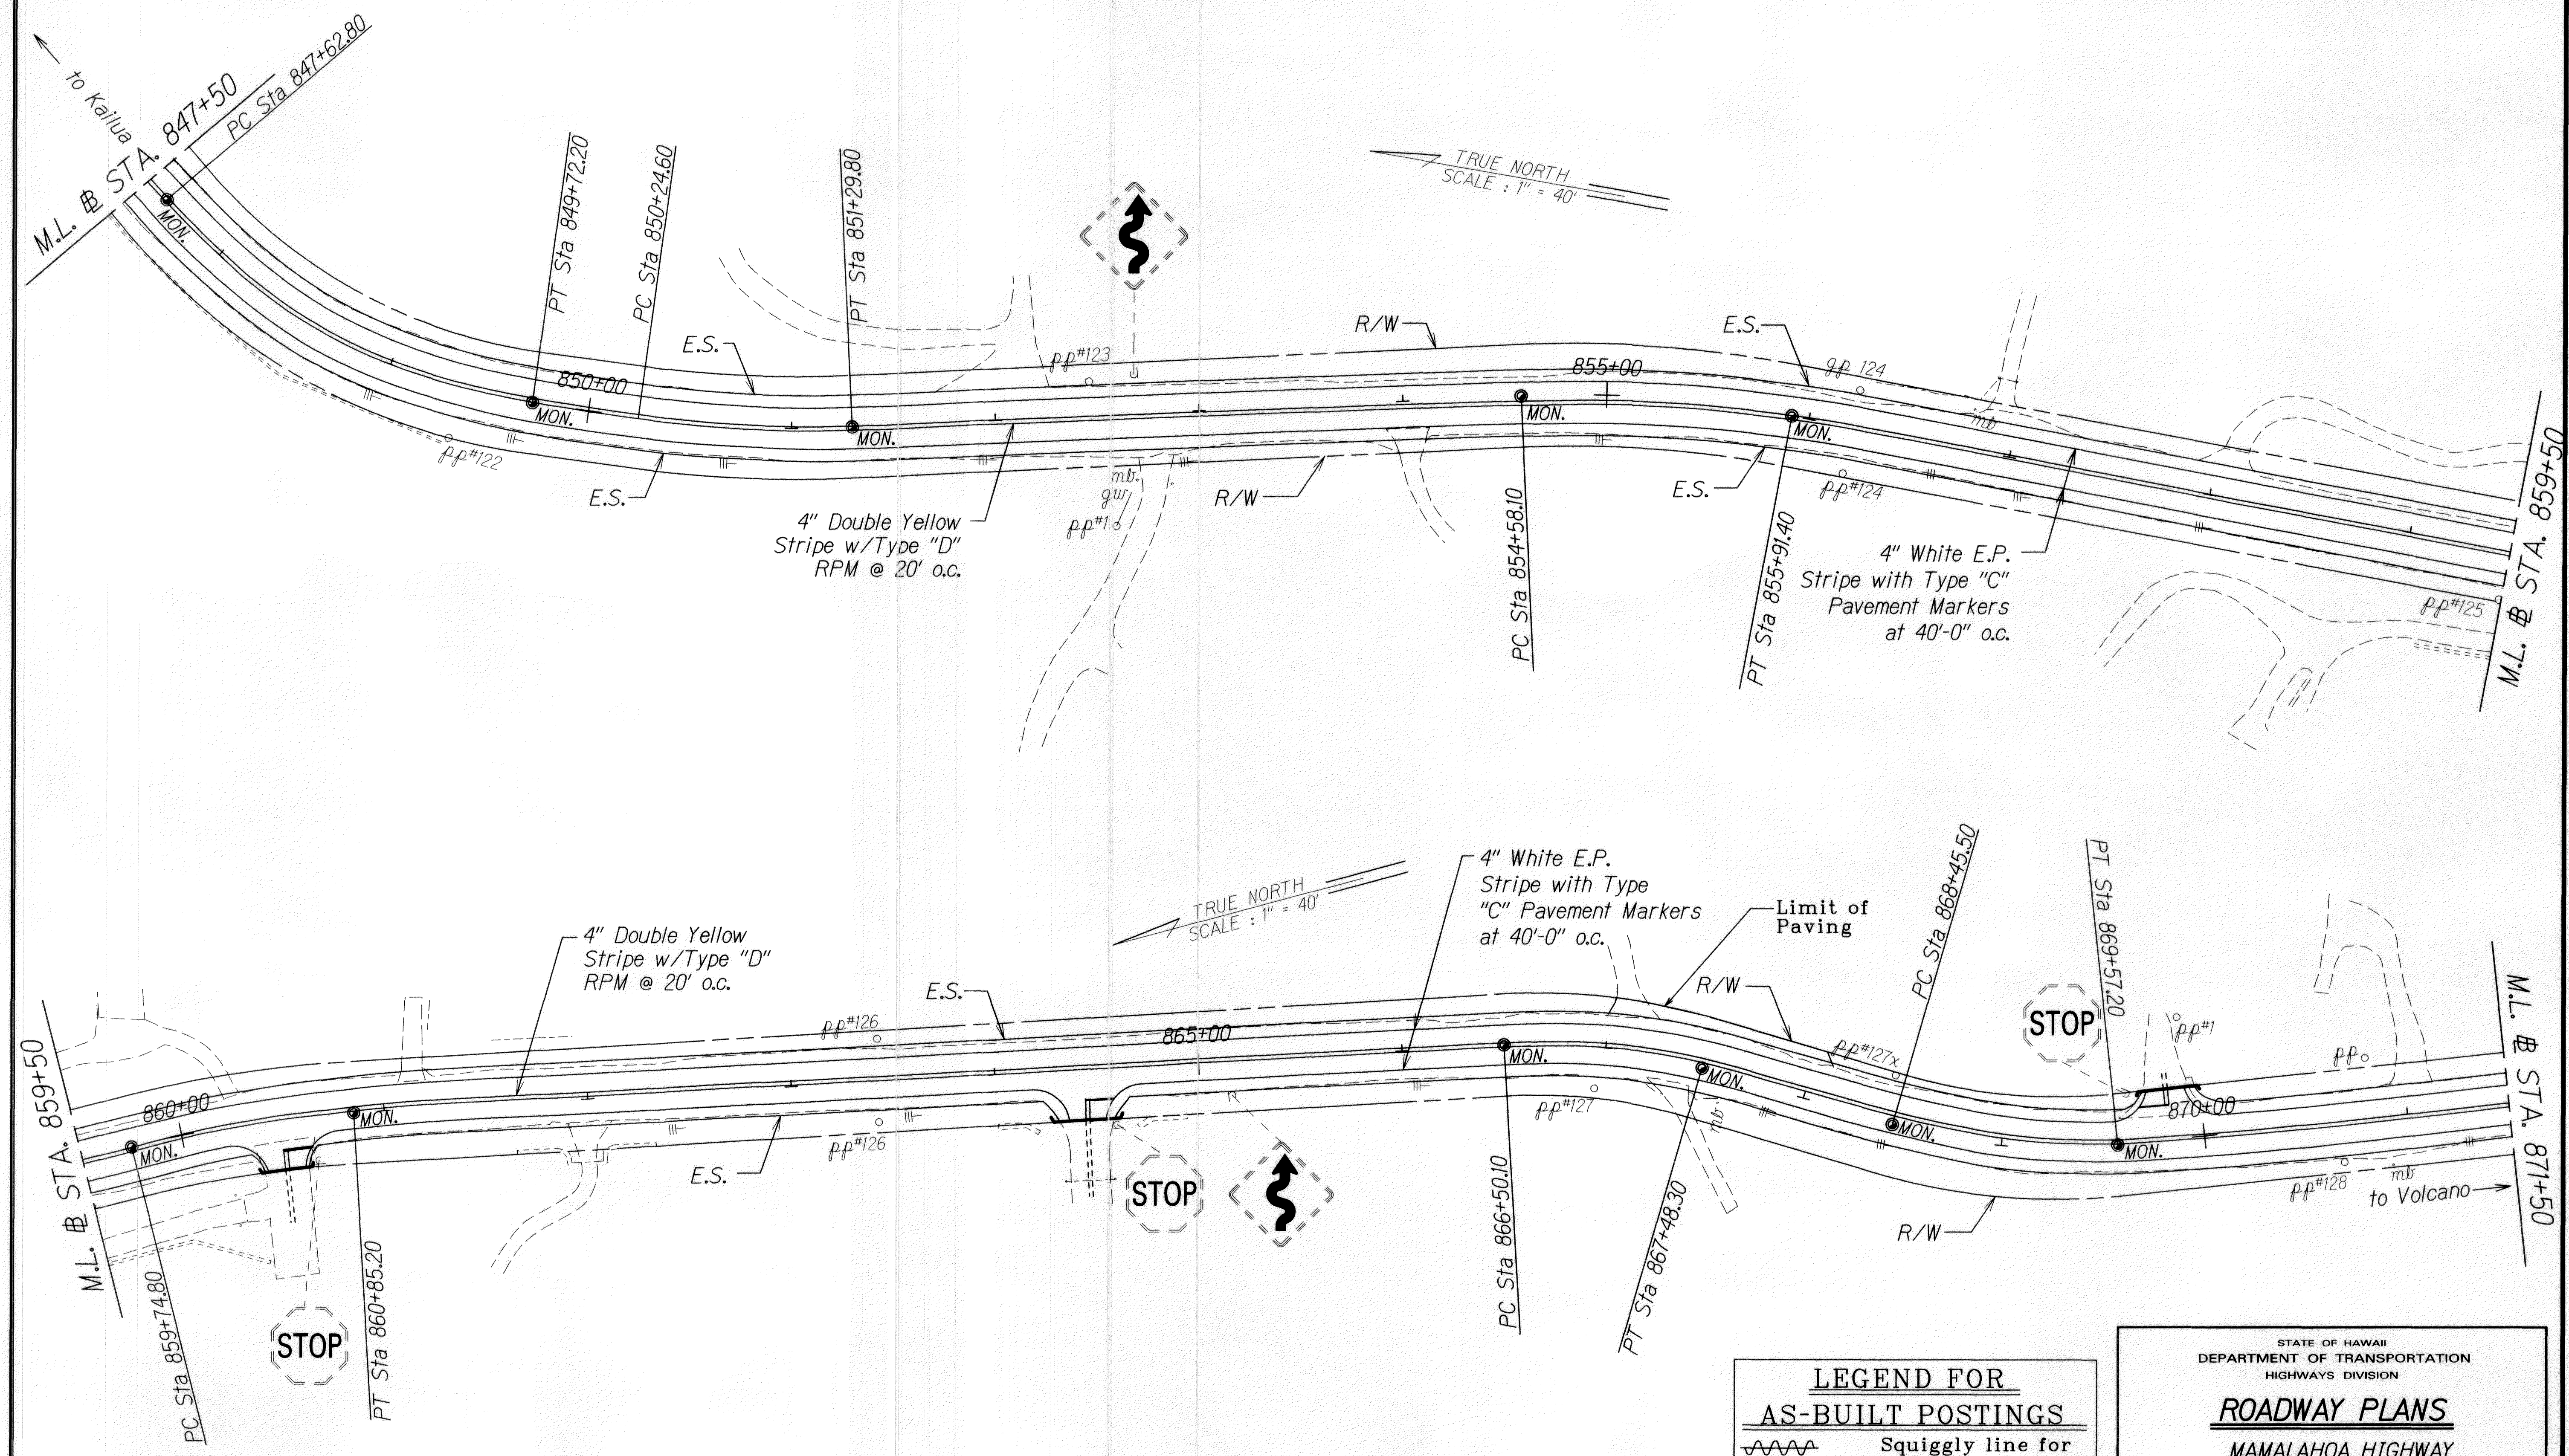

ORIGINAL PLAN	SURVEY PLOTTED BY	DATE
NOTE BOOK	DRAWN BY	
REVISIONS	TRACED BY	
CHECKED BY	QUANTITIES BY	
	NE: mmm/6/09	

- Notes:**
1. All existing signs (dashed) with post are to remain.
 2. All existing signs in conflict with construction signs are to be covered.
 3. This work shall be considered incidental to various contract items.

LEGEND FOR AS-BUILT POSTINGS	
	Squiggly line for as-built deletion
	Double line for as-built deletion
Roadway	Text for as-built posting


STATE OF HAWAII
DEPARTMENT OF TRANSPORTATION
HIGHWAYS DIVISION

ROADWAY PLANS
MAMALAHOA HIGHWAY
Pavement Preventive Maintenance
Kaohe to Kaapuna
Federal Aid Project No. STP-011-1(026)
Scale: 1"=40' Date: March, 2012

SHEET No. 6 OF 10 SHEETS

"AS-BUILT"

FED. ROAD DIST. NO.	STATE	FED. AID PROJ. NO.	FISCAL YEAR	SHEET NO.	TOTAL SHEETS
HAWAII	HAW.	STP-011-11026	2012	14	21

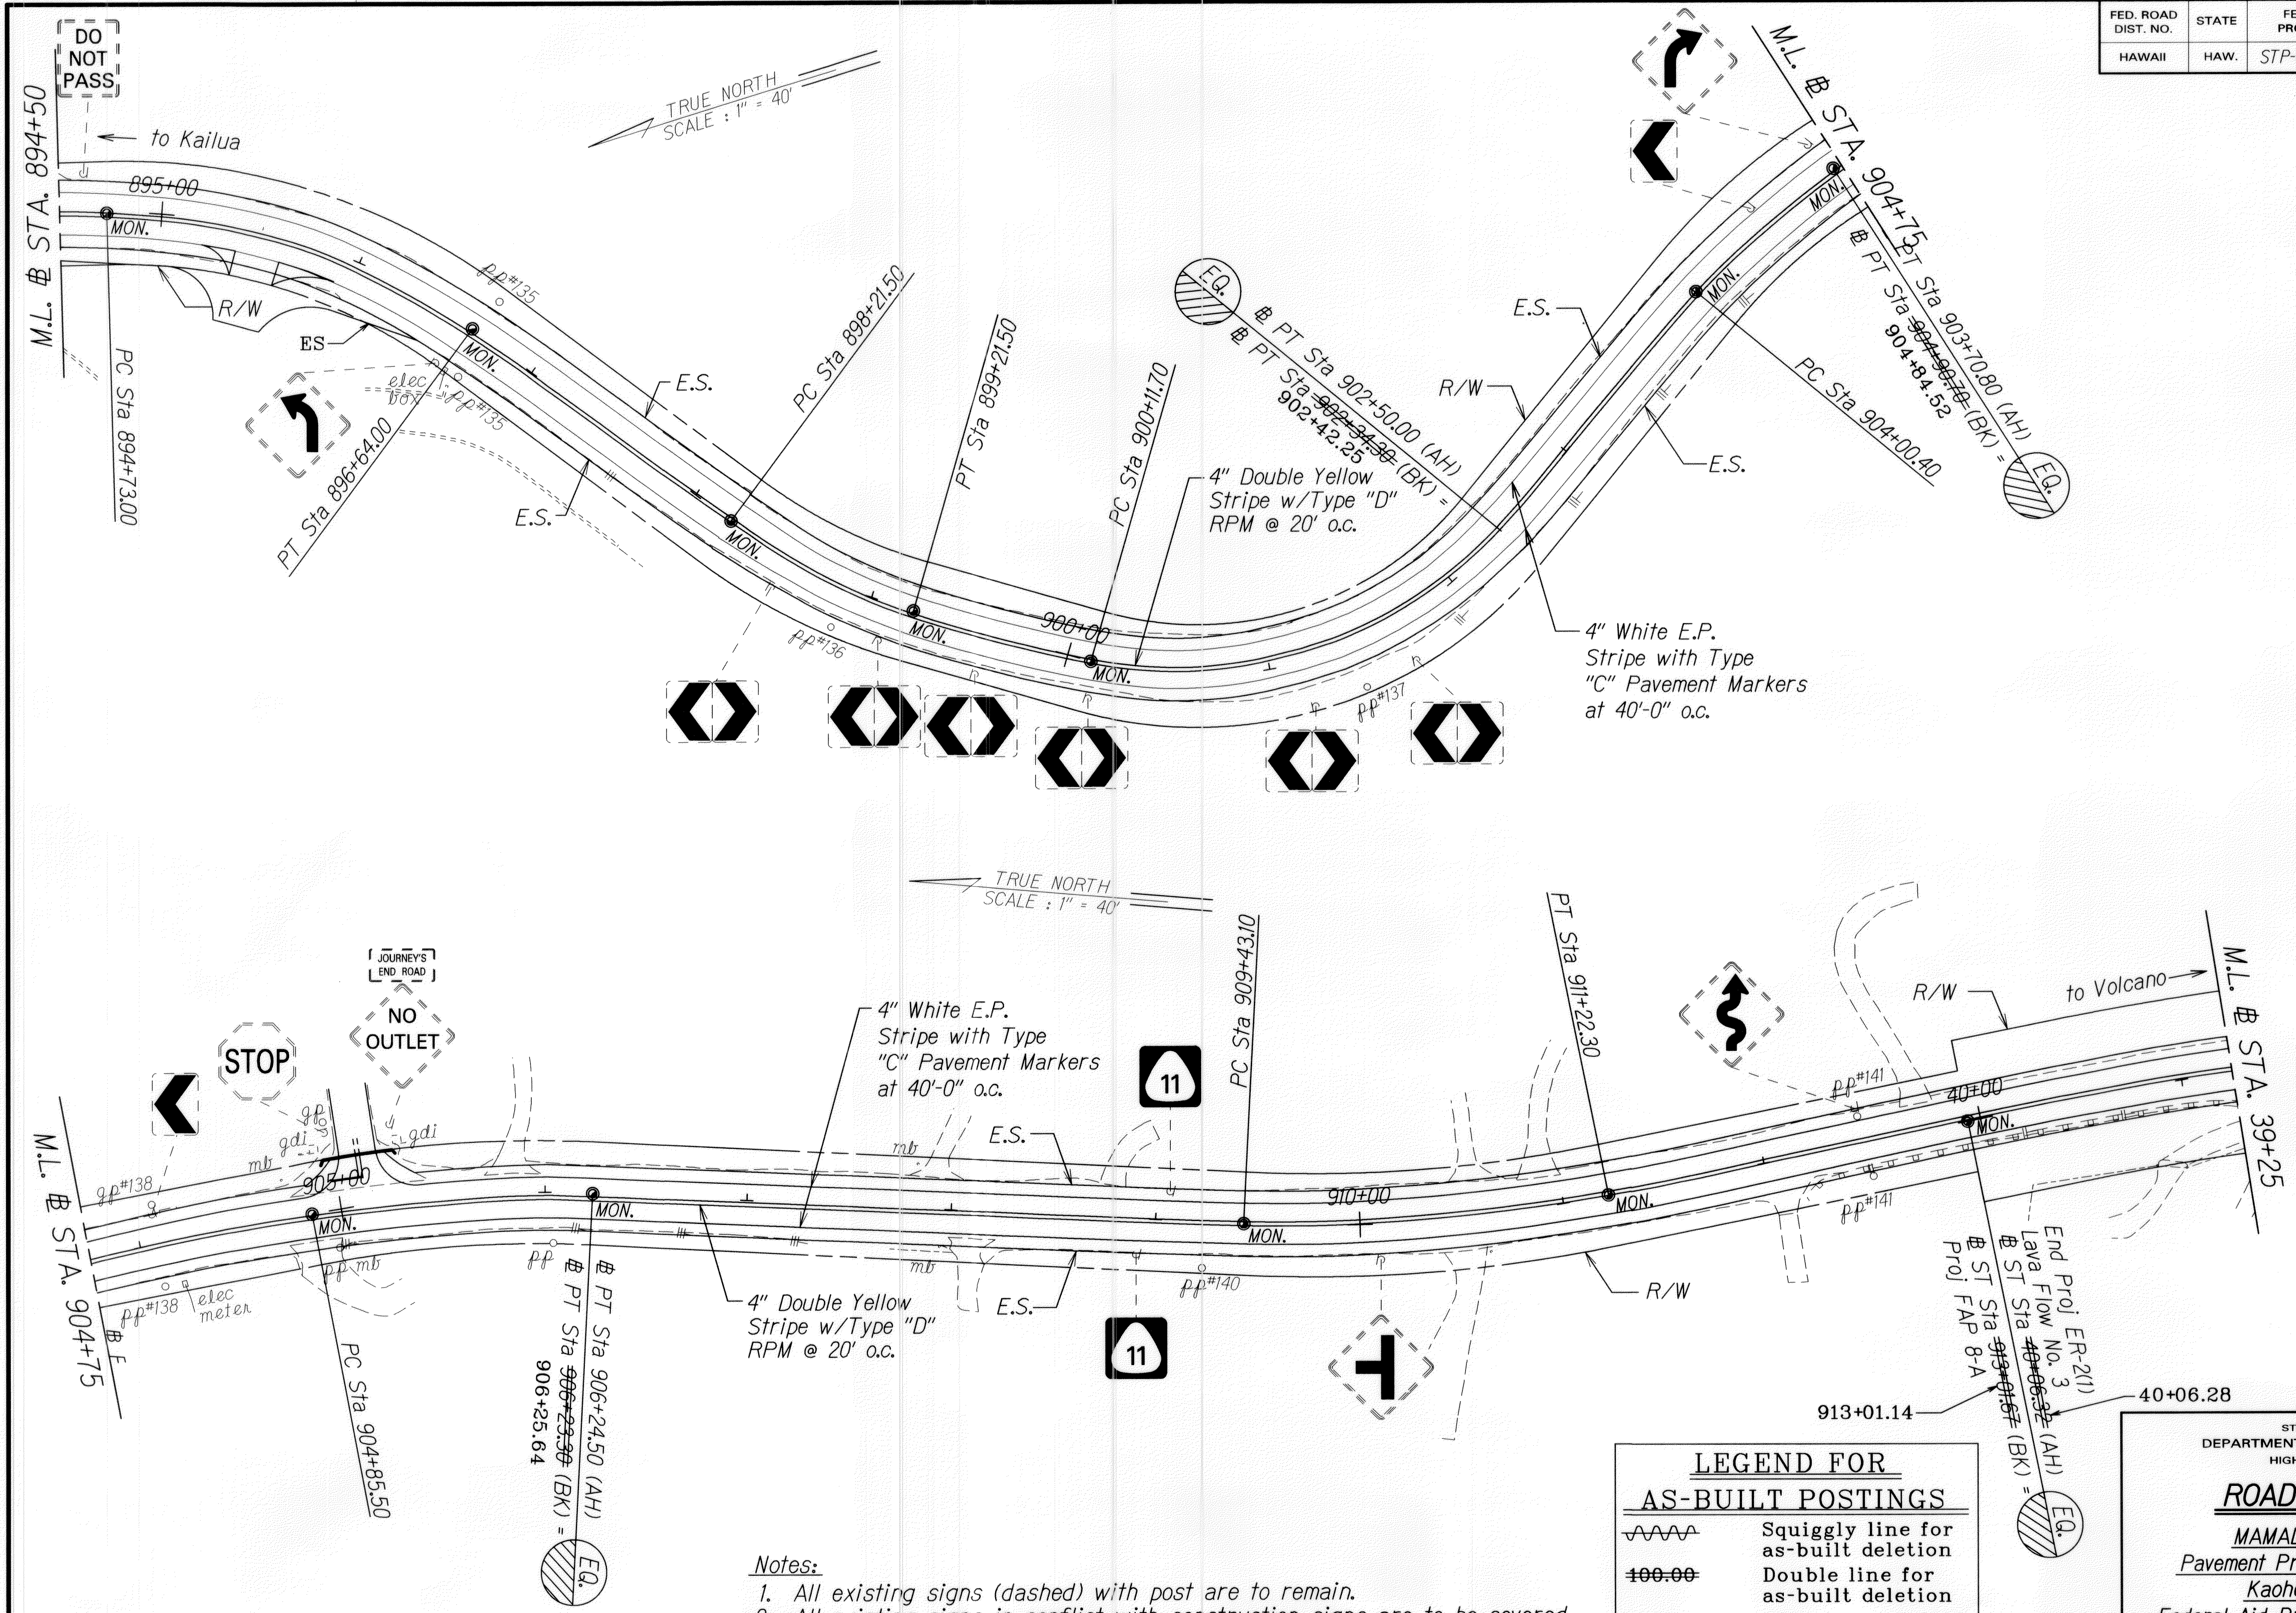

- Notes:
1. All existing signs (dashed) with post are to remain.
 2. All existing signs in conflict with construction signs are to be covered.
 3. This work shall be considered incidental to various contract items.

LEGEND FOR AS-BUILT POSTINGS	
	Squiggly line for as-built deletion
	Double line for as-built deletion
Roadway	Text for as-built posting

STATE OF HAWAII
DEPARTMENT OF TRANSPORTATION
HIGHWAYS DIVISION

ROADWAY PLANS

MAMALAHOA HIGHWAY

Pavement Preventive Maintenance

Kaohoe to Kaapuna

Federal Aid Project No. STP-011-11026



Scale: 1"=40' Date: March, 2012

SHEET No. 8 OF 10 SHEETS

DATE	
SURVEY PLOTTED BY	
DRAWN BY	
CHECKED BY	
NOTE BOOK	
QUANTITIES BY	
CHECKED BY	

"AS-BUILT"

FED. ROAD DIST. NO.	STATE	FED. AID PROJ. NO.	FISCAL YEAR	SHEET NO.	TOTAL SHEETS
HAWAII	HAW.	STP-011-1(026)	2012	15	21

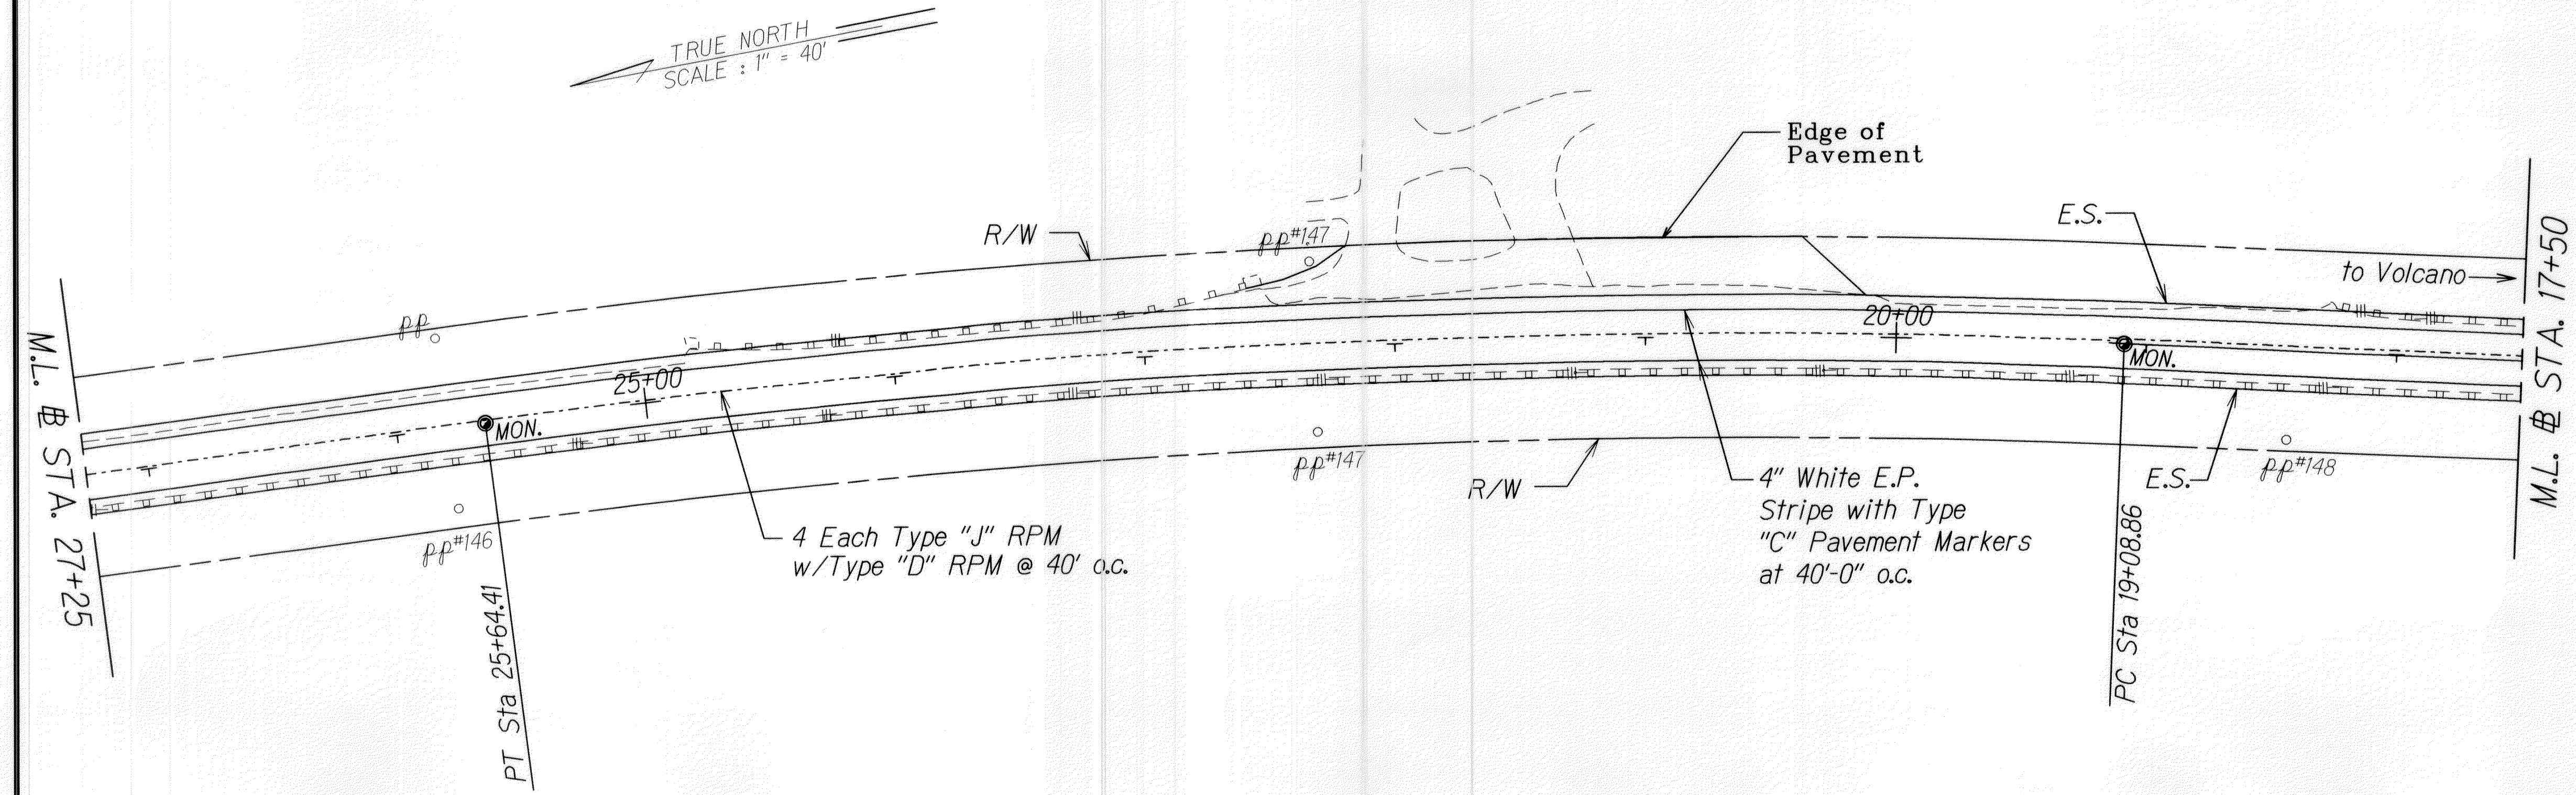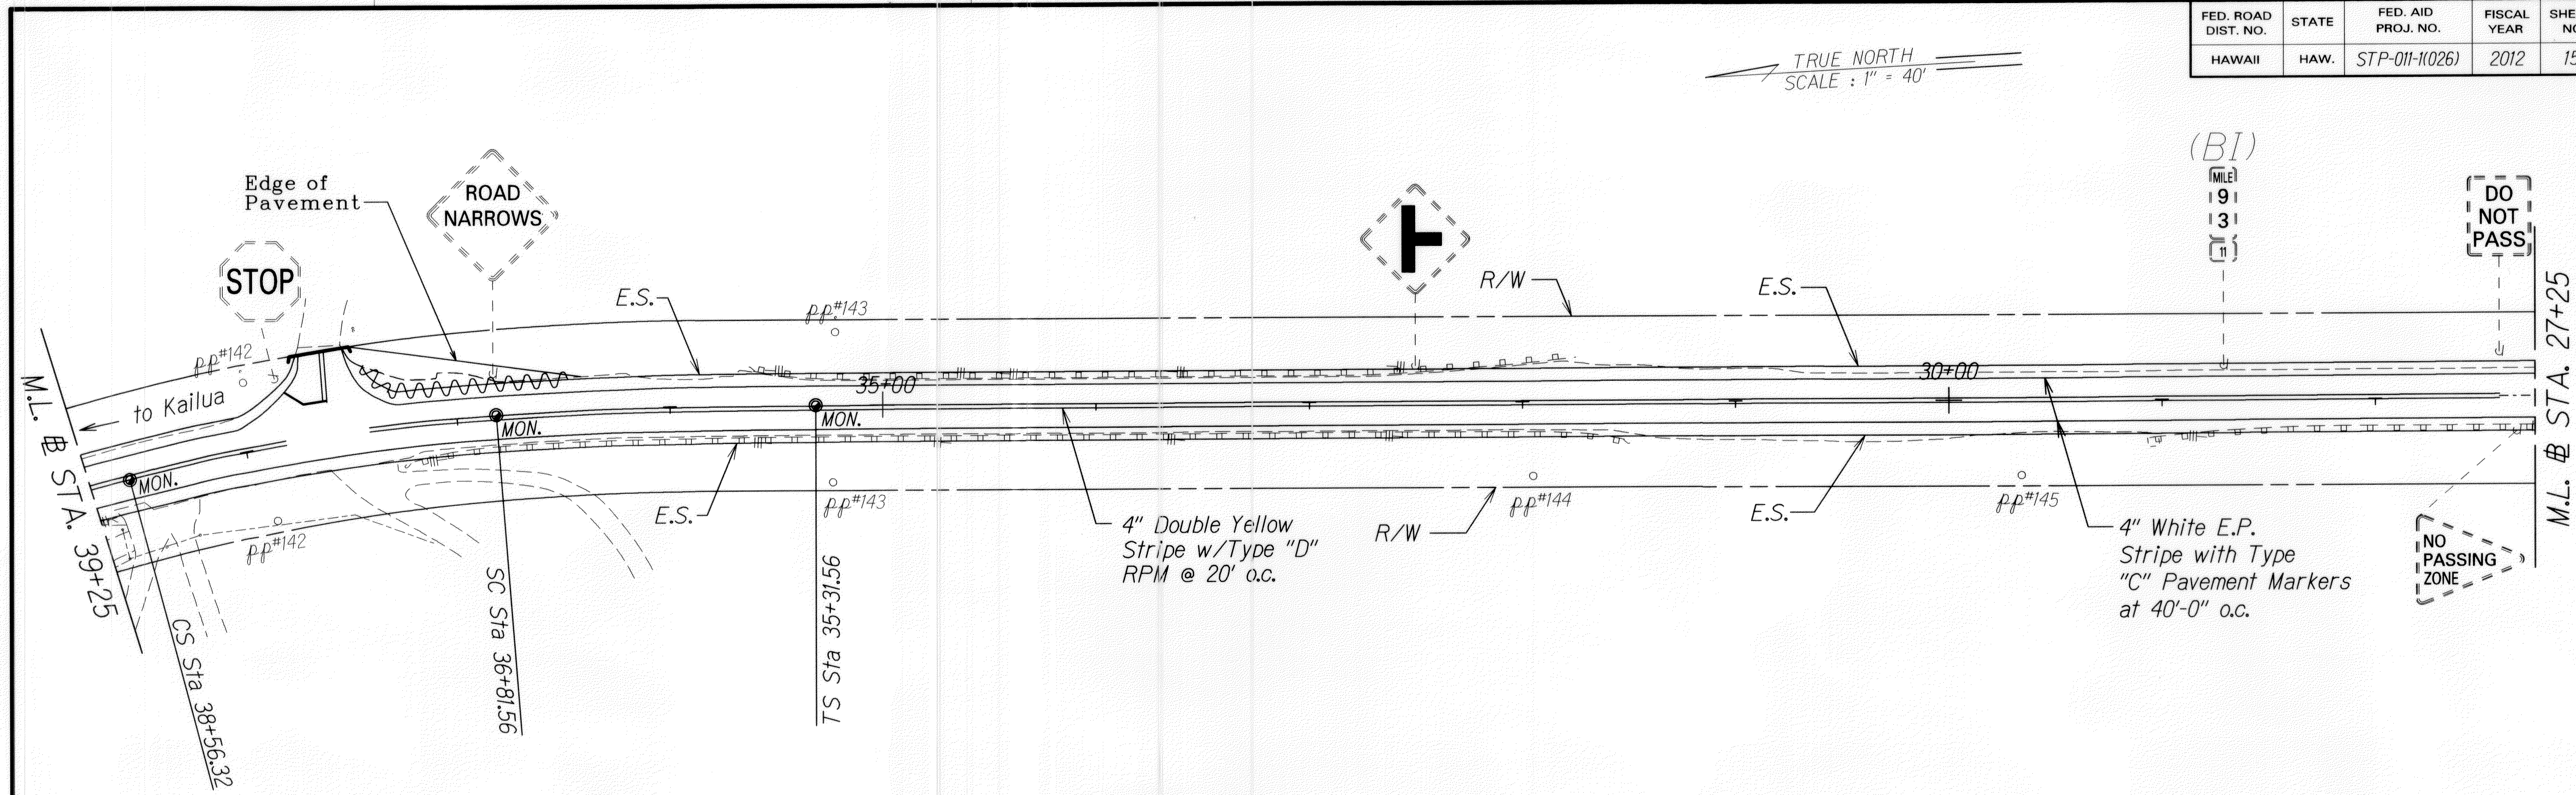

LEGEND FOR AS-BUILT POSTINGS	
	Squiggly line for as-built deletion
	Double line for as-built deletion
Roadway	Text for as-built posting

STATE OF HAWAII
DEPARTMENT OF TRANSPORTATION
HIGHWAYS DIVISION

ROADWAY PLANS
MAMALAHOA HIGHWAY
Pavement Preventive Maintenance
Kaohe to Kaapuna
Federal Aid Project No. STP-011-1(026)
Scale: 1"=40' Date: March, 2012


SHEET No. 9 OF 10 SHEETS

- Notes:
1. All existing signs (dashed) with post are to remain.
 2. All existing signs in conflict with construction signs are to be covered.
 3. This work shall be considered incidental to various contract items.

DATE	
SURVEY PLOTTED BY	
DRAWN BY	
DESIGNED BY	
CHECKED BY	
NOTE BOOK	
FILE	
NAME	

"AS-BUILT"

FED. ROAD DIST. NO.	STATE	FED. AID PROJ. NO.	FISCAL YEAR	SHEET NO.	TOTAL SHEETS
HAWAII	HAW.	STP-011-1(026)	2012	16	21

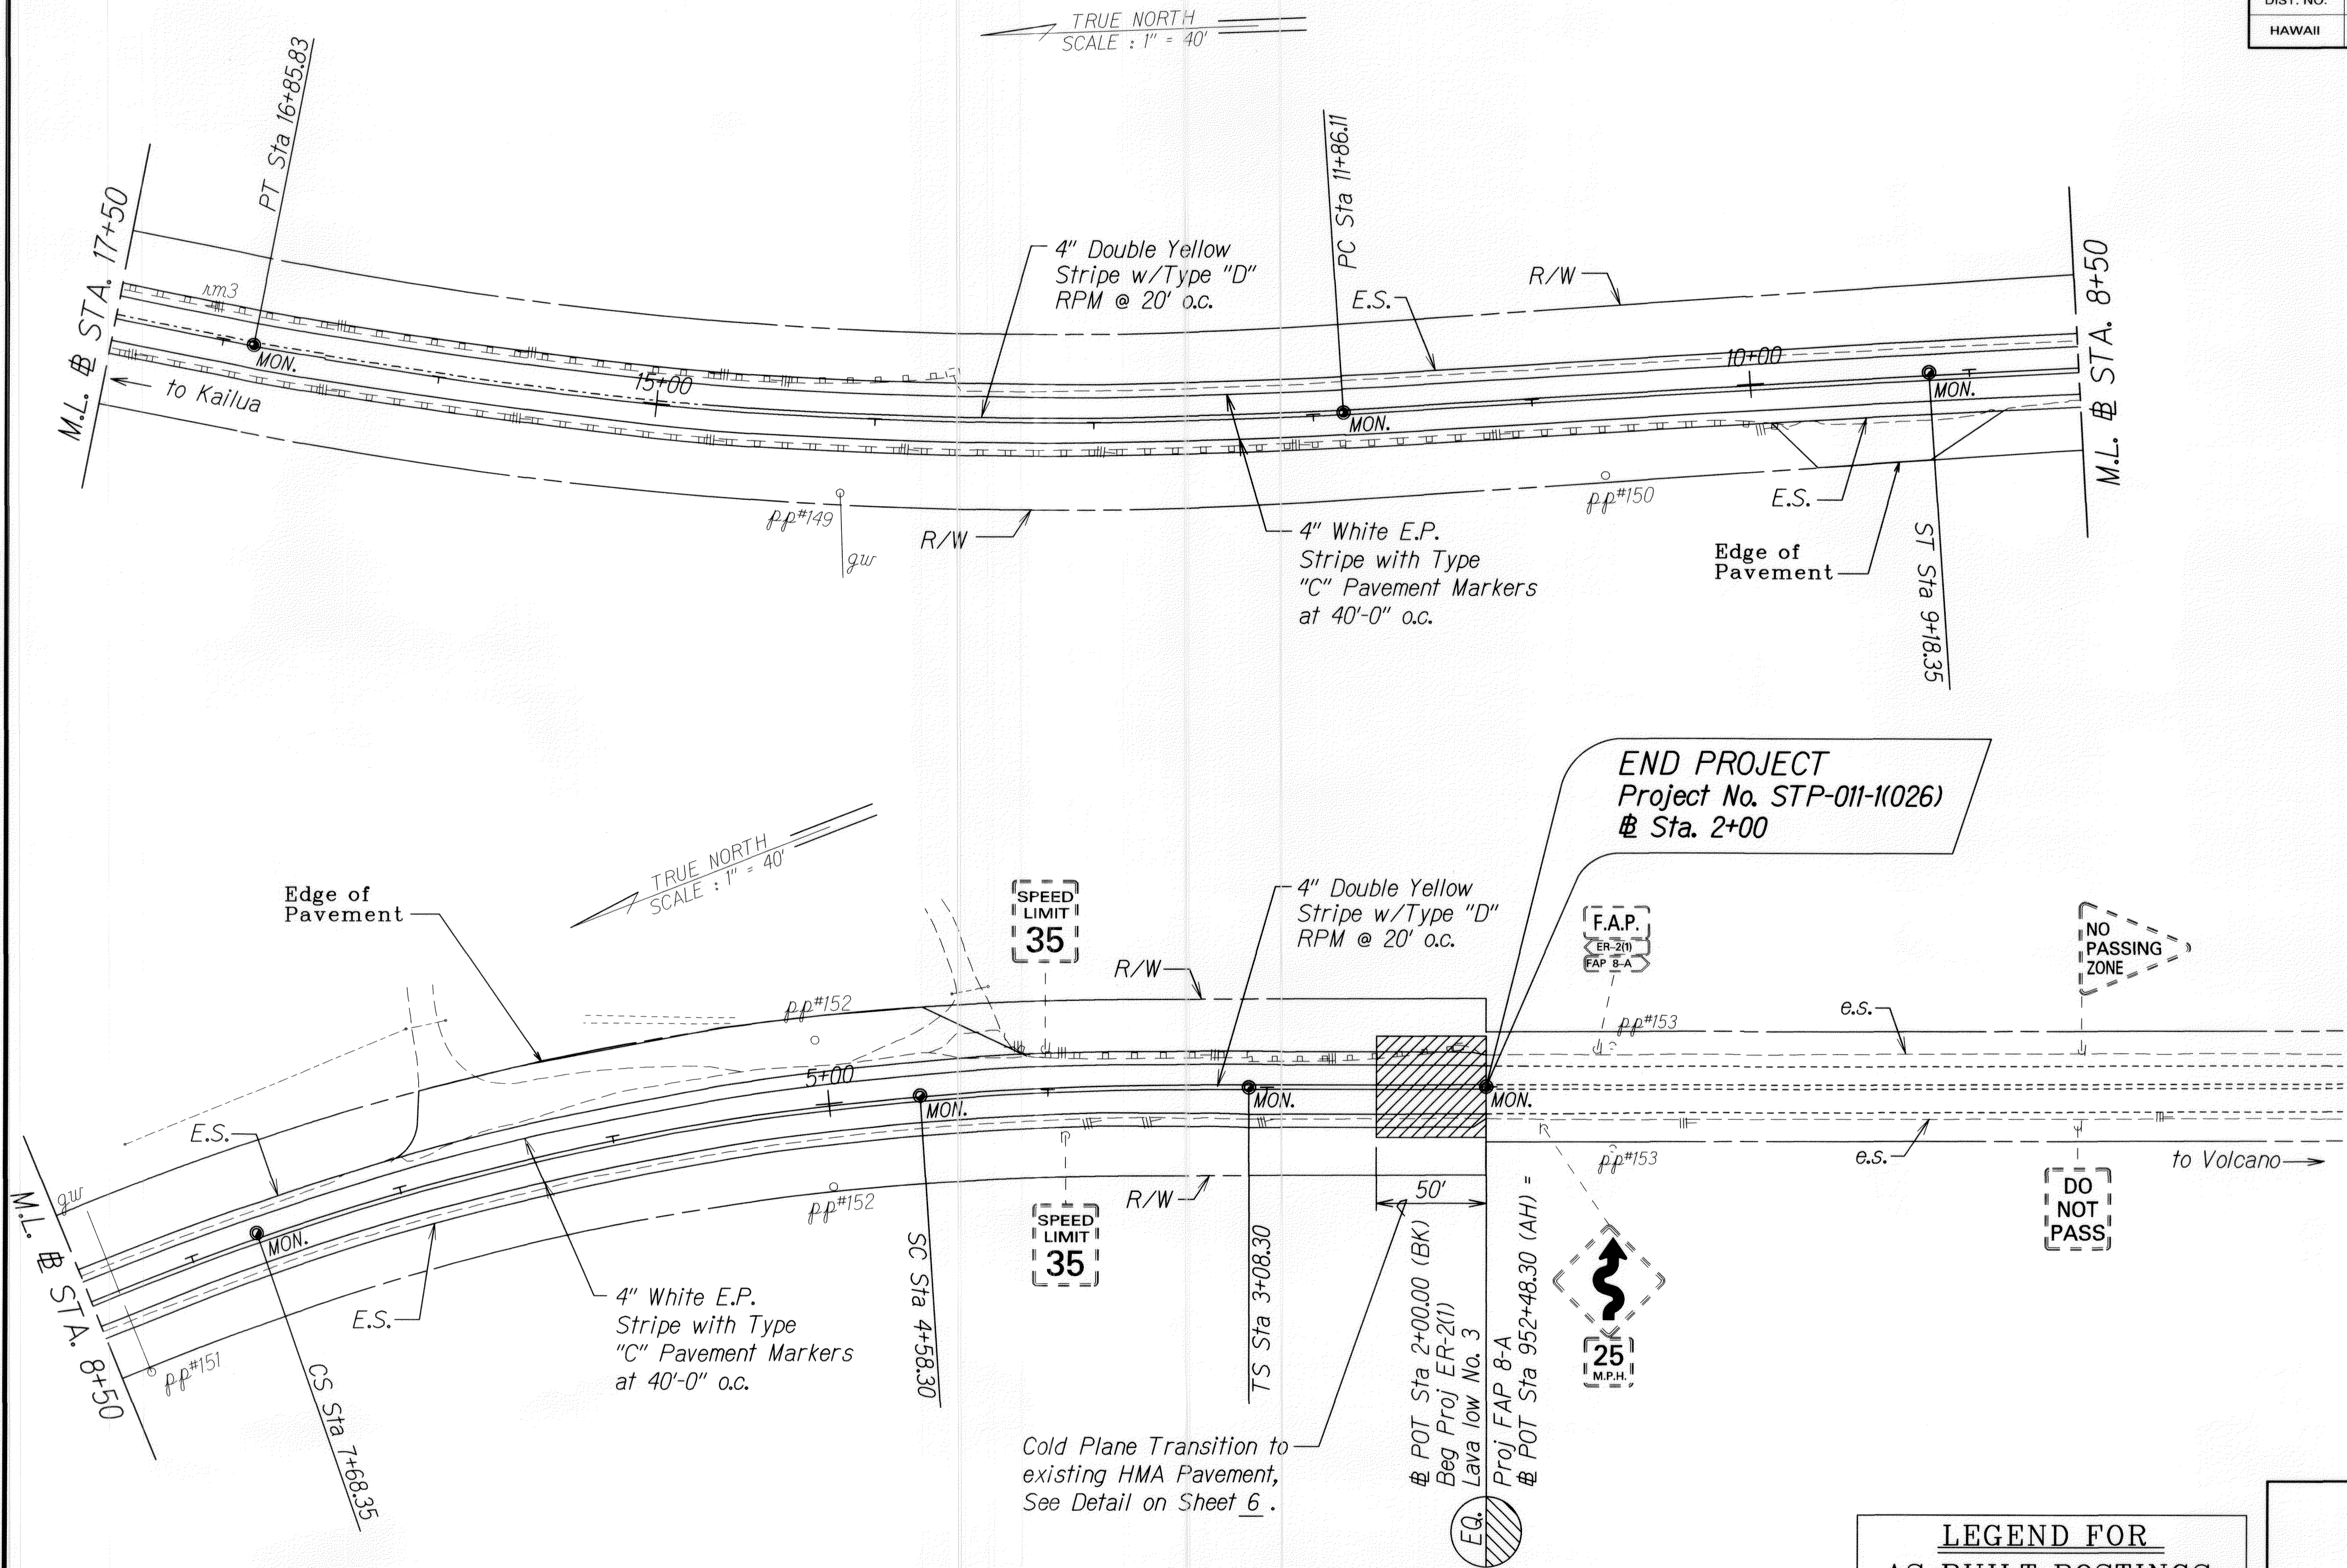

- Notes:
1. All existing signs (dashed) with post are to remain.
 2. All existing signs in conflict with construction signs are to be covered.
 3. This work shall be considered incidental to various contract items.

LEGEND FOR AS-BUILT POSTINGS	
	Squiggly line for as-built deletion
	Double line for as-built deletion
Roadway	Text for as-built posting

STATE OF HAWAII
DEPARTMENT OF TRANSPORTATION
HIGHWAYS DIVISION

ROADWAY PLANS

MAMALAHOA HIGHWAY
Pavement Preventive Maintenance
Kaohe to Kaapuna
Federal Aid Project No. STP-011-1(026)

Scale: 1"=40' Date: March, 2012

SHEET No. 10 OF 10 SHEETS

"AS-BUILT"