
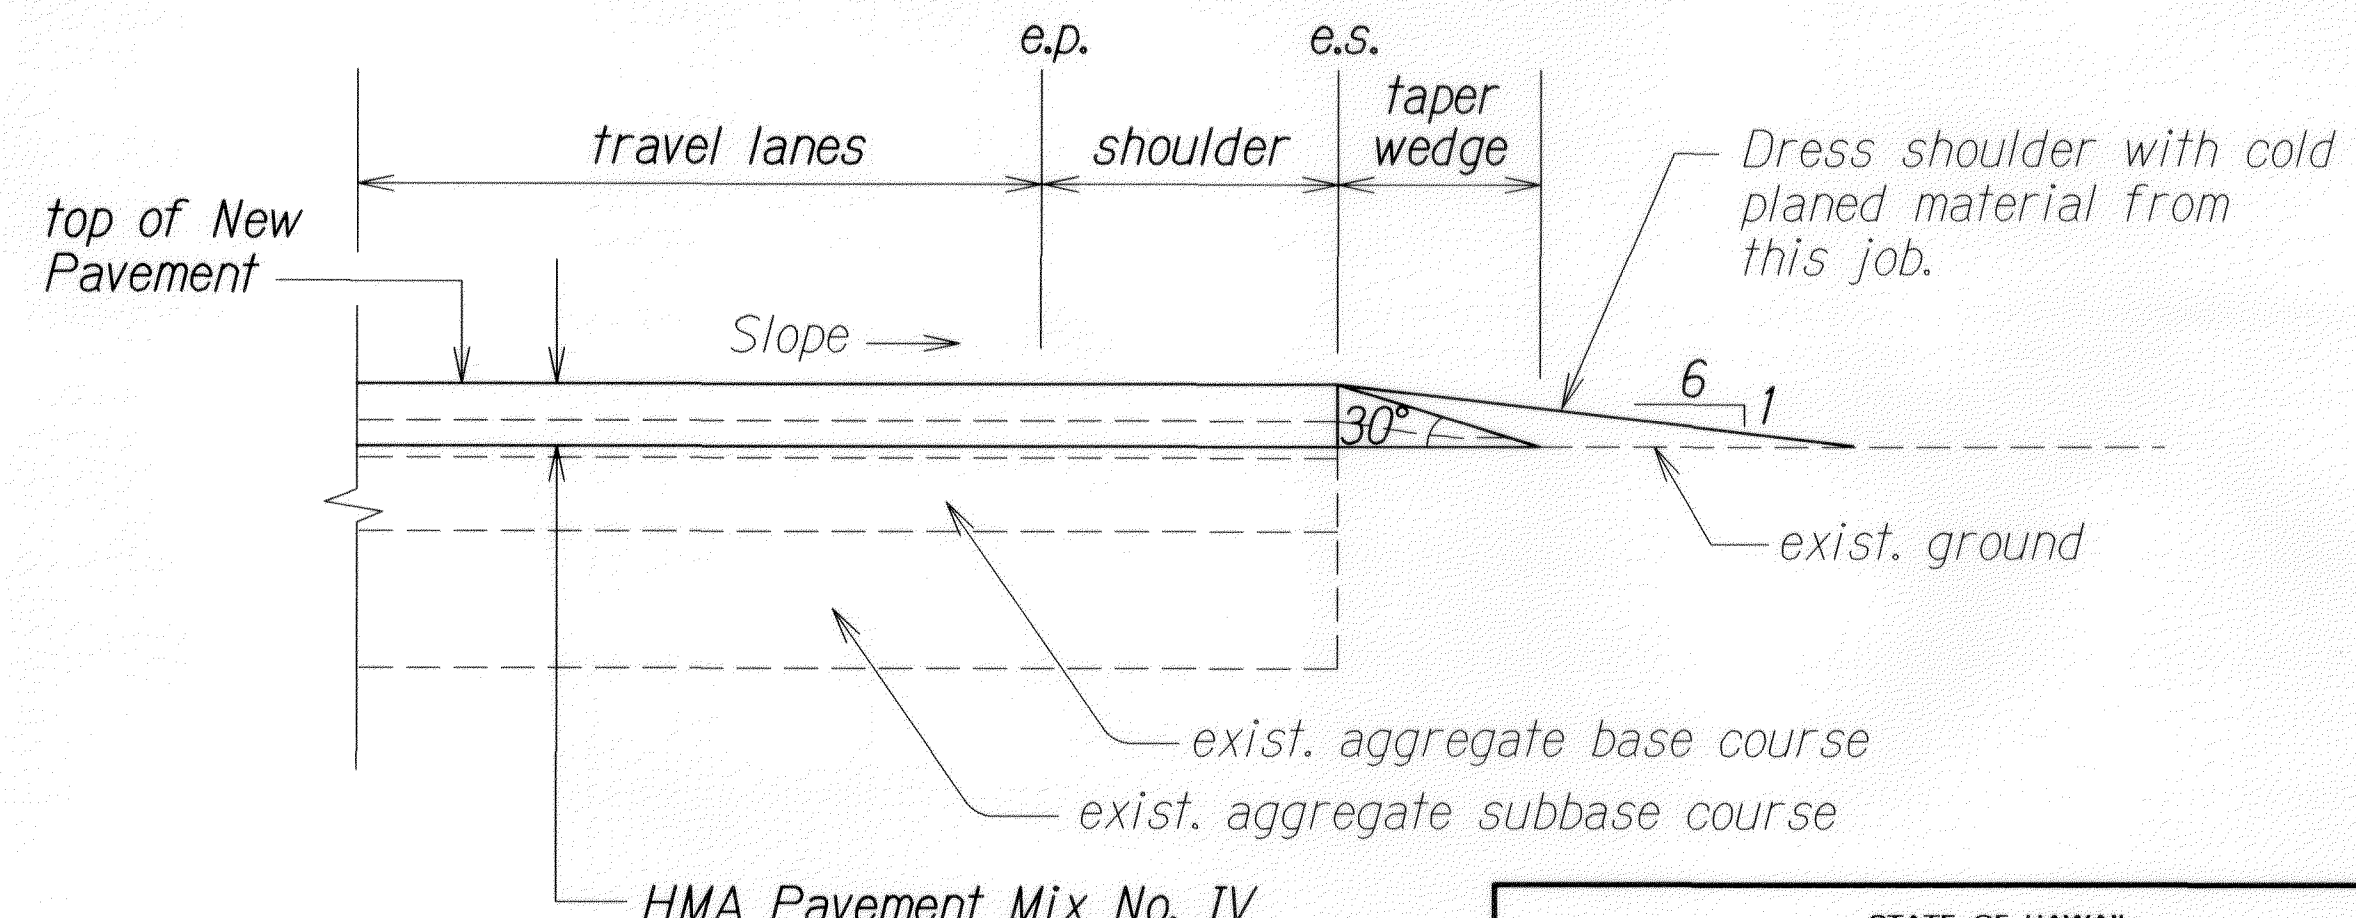
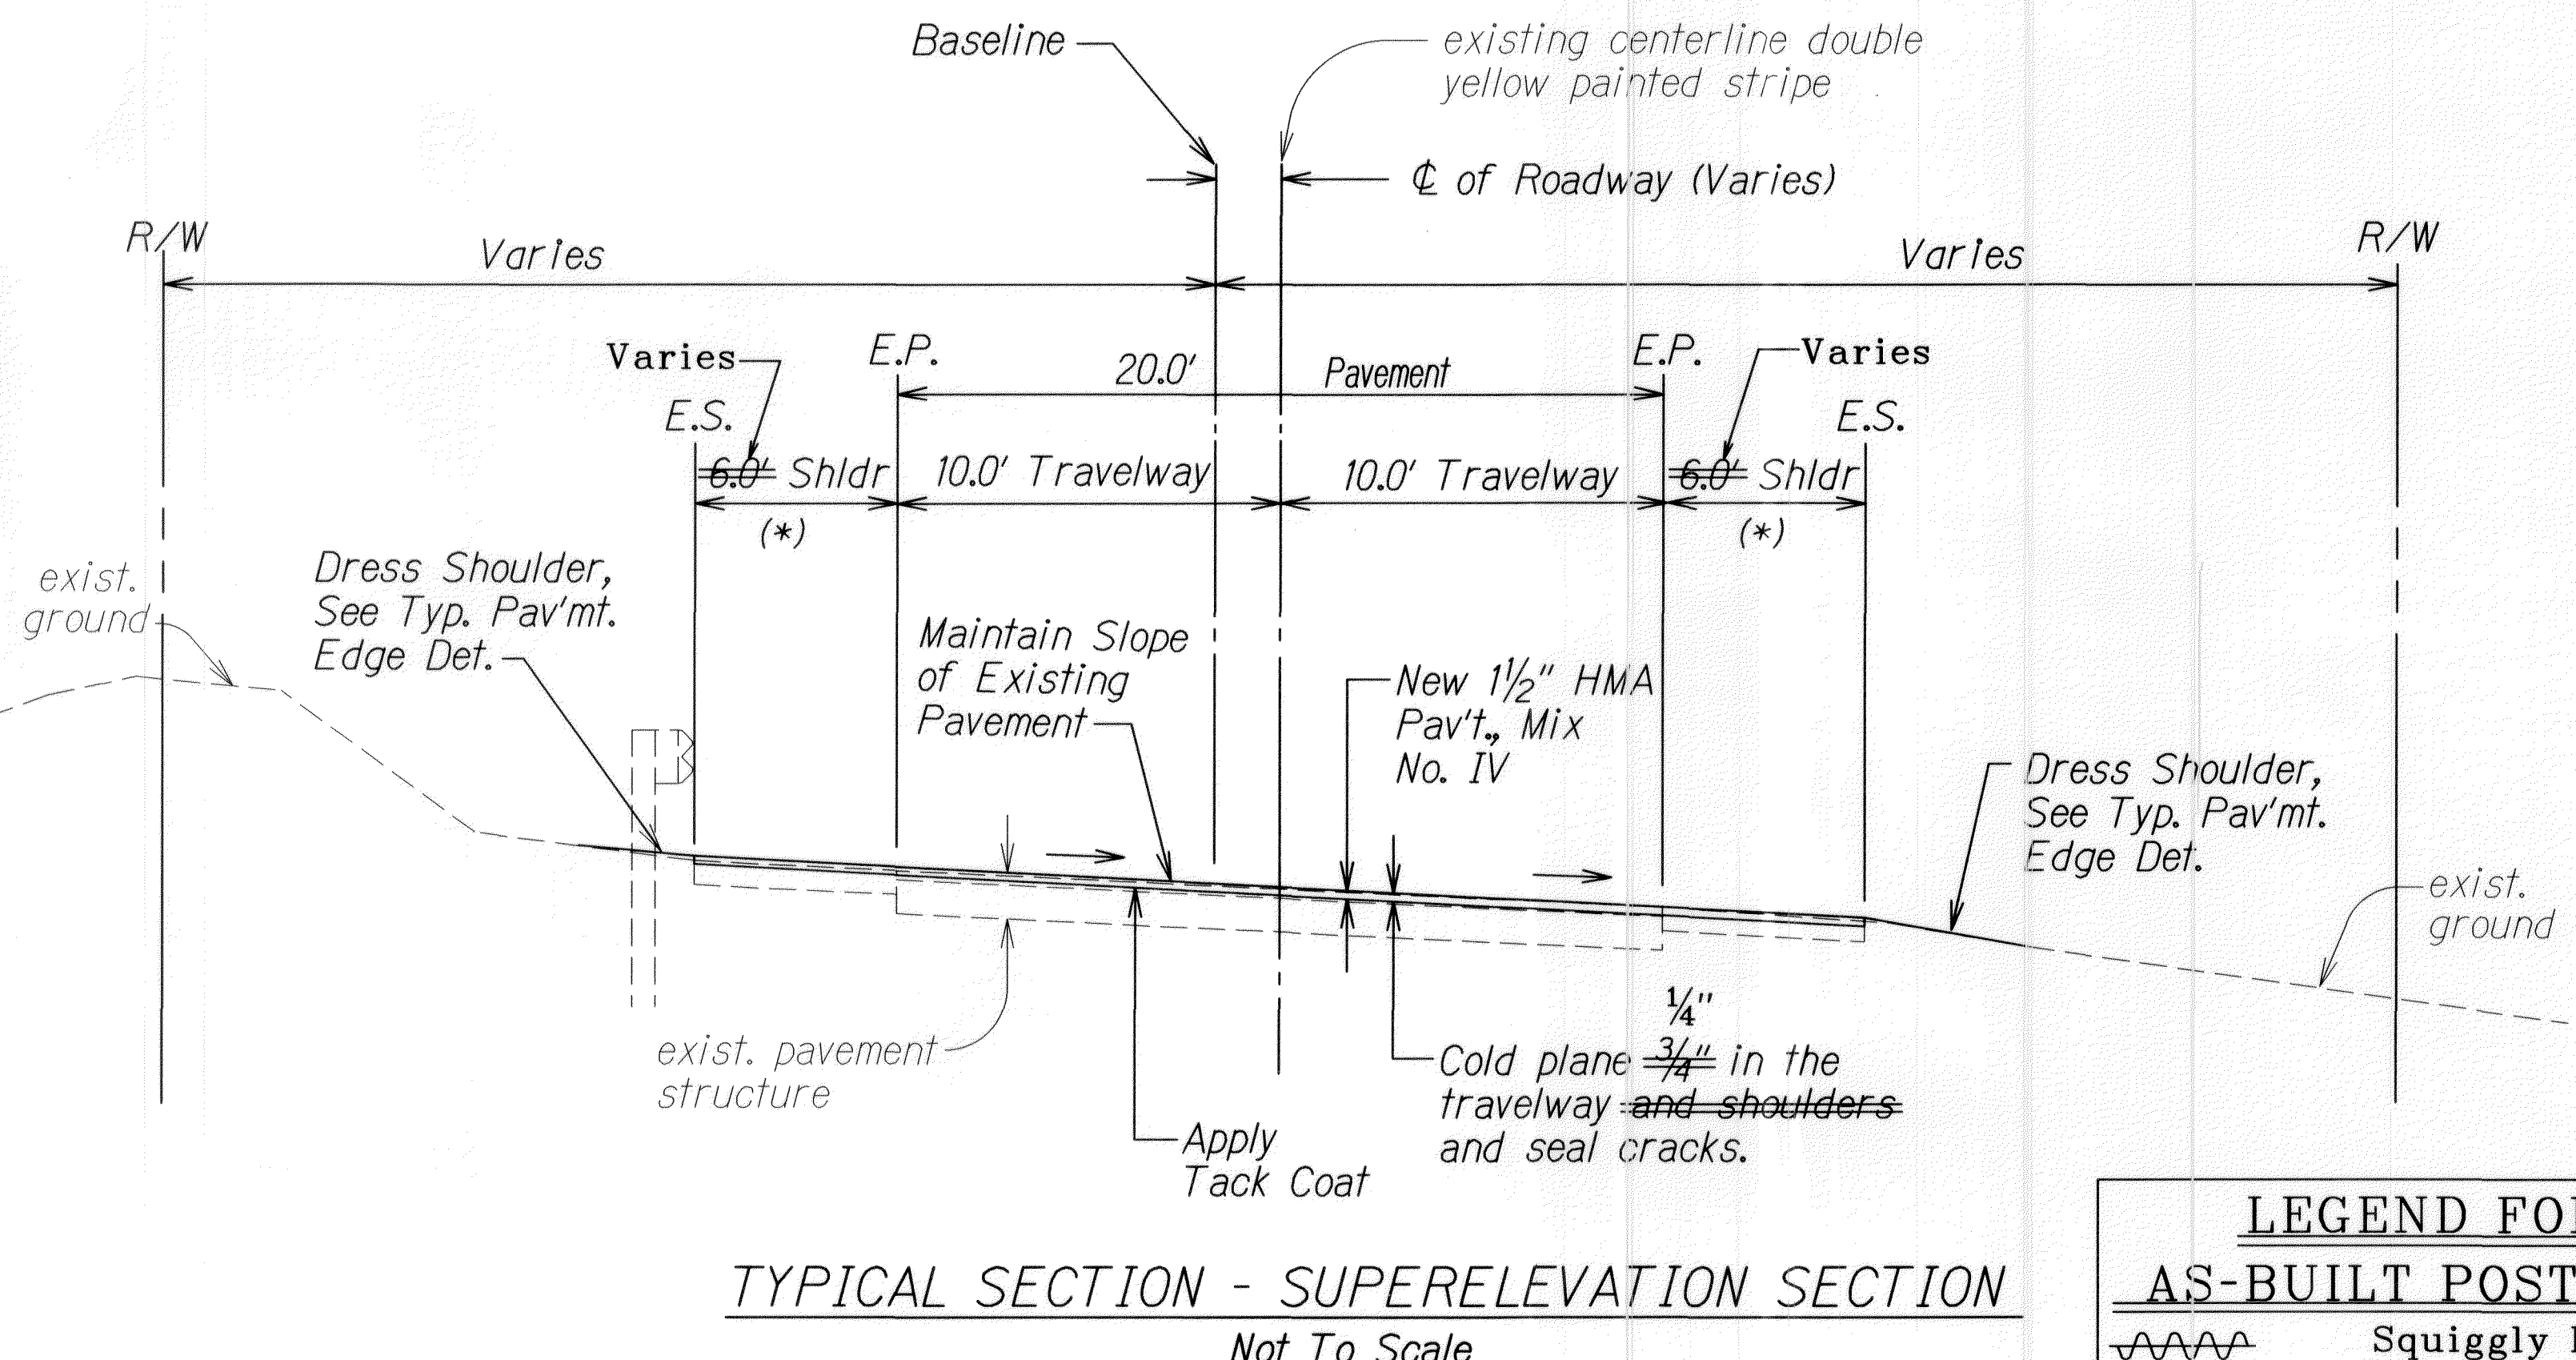
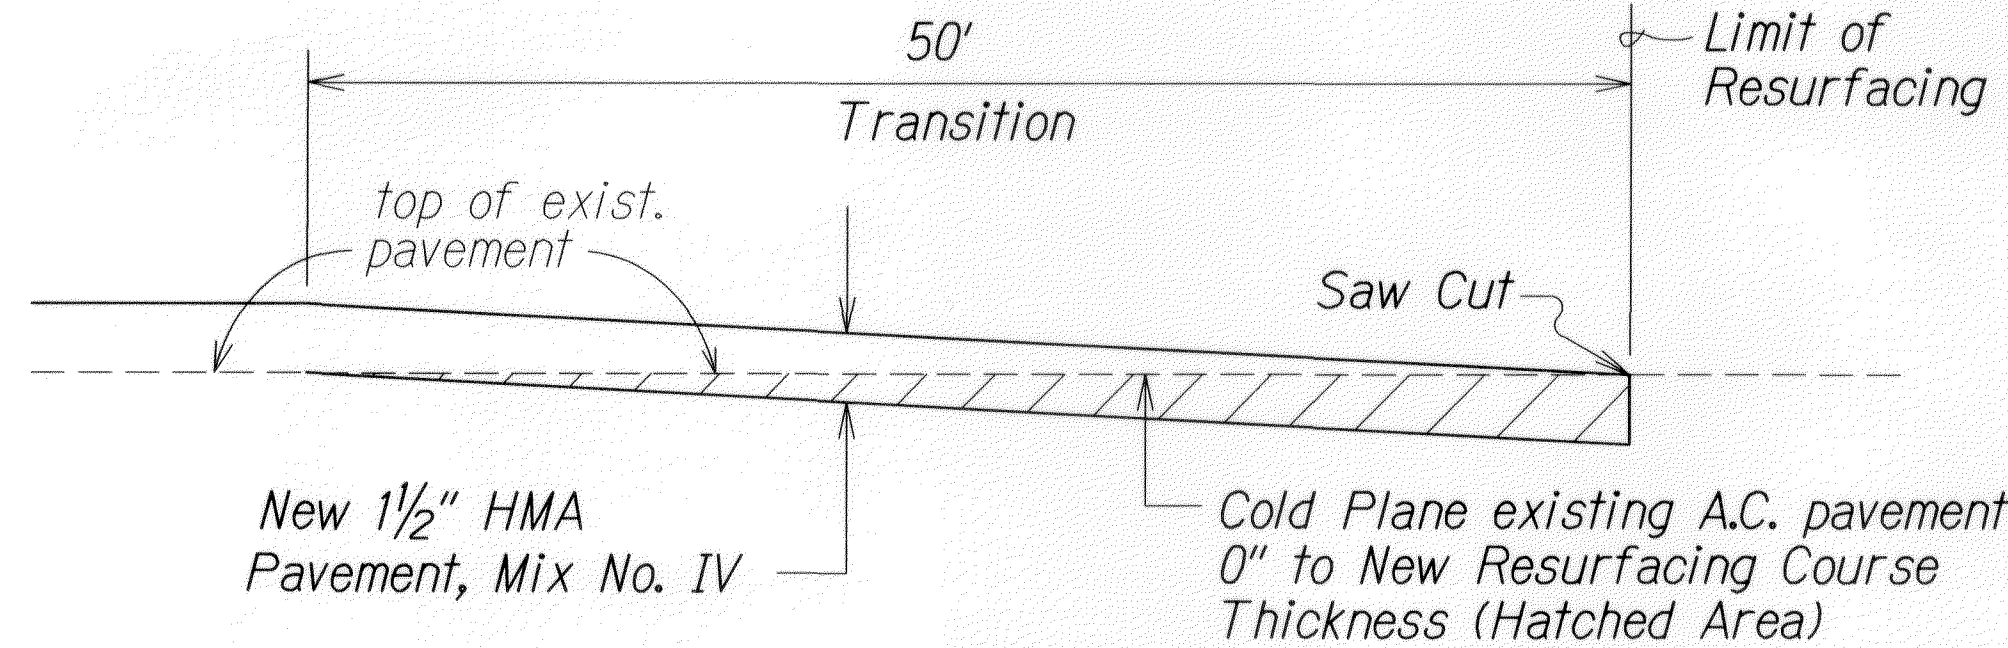
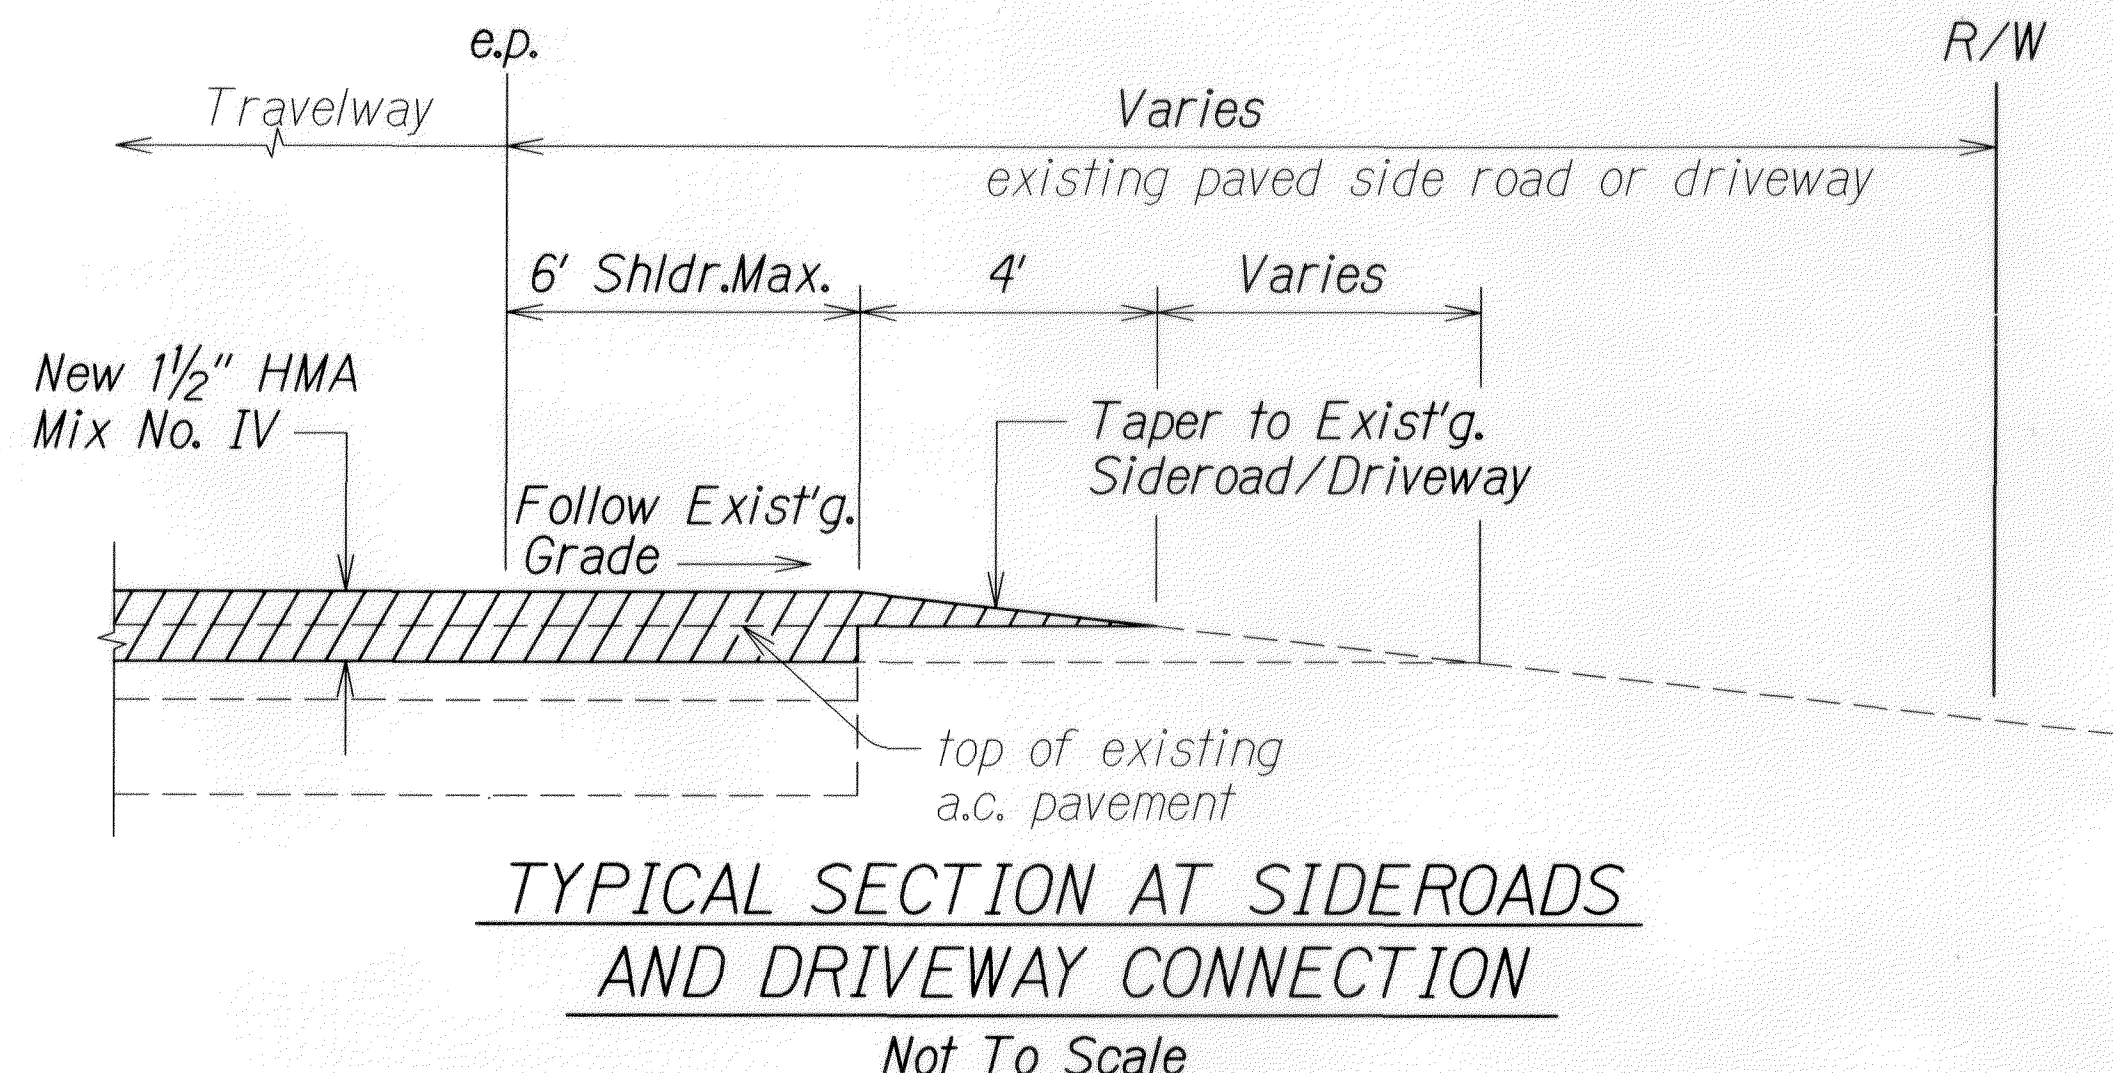


DIST. NO.	STATE	FED. AID PROJ. NO.	FISCAL YEAR	SHEET NO.	TOTAL SHEETS
HAWAII	HAW.	STP-011-1(026)	2012	6	21

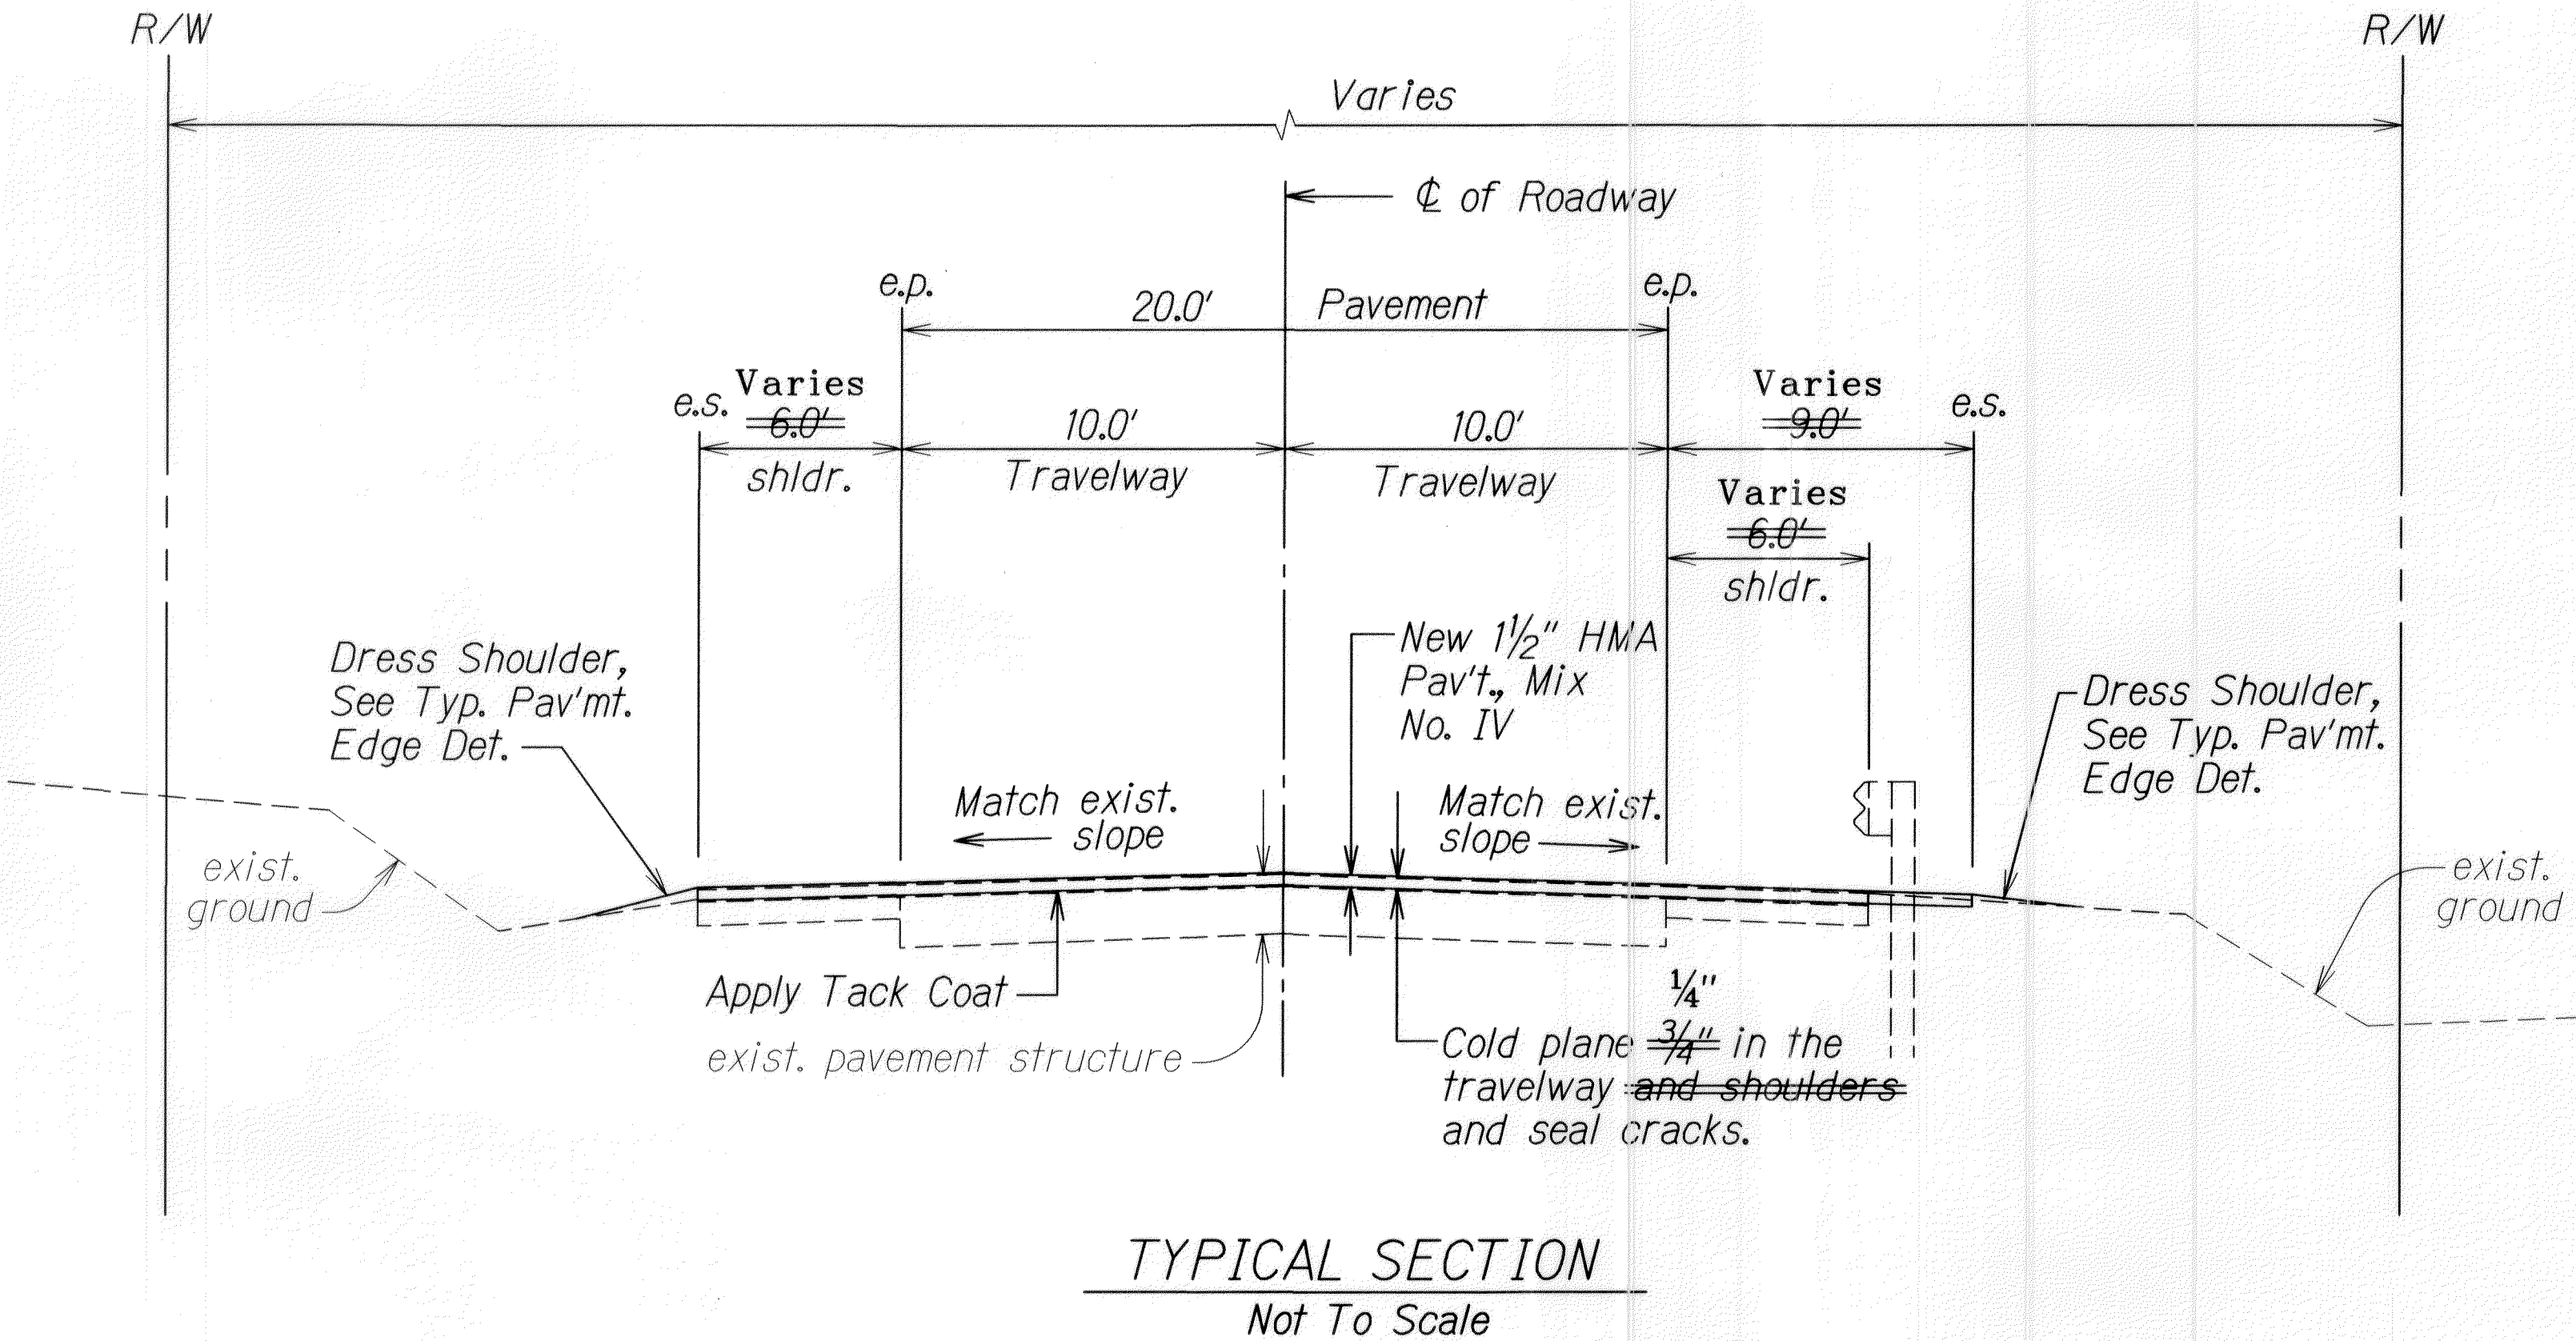

LEGEND FOR AS-BUILT POSTINGS

Squiggly line for as-built deletion

Double line for as-built deletion

Text for as-built posting

TYPICAL PAVEMENT EDGE DETAIL
Not To Scale

Note:
Contractor shall mount a device directly on the paver screed extension to provide a 30° beveled shoulder edge.

STATE OF HAWAII
DEPARTMENT OF TRANSPORTATION
HIGHWAYS DIVISION

TYPICAL SECTION AND DETAILS

MAMALAHOA HIGHWAY
Pavement Preventive Maintenance
Kaohe to Kaapuna
Federal Aid Project No. STP-011-1(026)

Scale: N.T.S. Date: March, 2012

SHEET No. 1 OF 1 SHEETS

(*) Finish shoulder slopes shall be modified as needed to achieve a 6% maximum arithmetic type difference in slopes between the shoulder and travelway.

ORIGINAL PLAN	DATE
DESIGNED BY	3/2012
DESIGNED BY	
QUANTITIES BY	
CHECKED BY	