

ORIGINAL PLAN	SURVEY PLOTTED BY	DATE	
		DRAWN BY	X
		DESIGNED BY	X
		CHECKED BY	Naivolacms09
NOTE BOOK	DRAWN BY	DATE	
		CHECKED BY	Naivolacms09

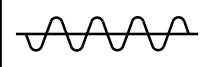
FED. ROAD DIST. NO.	STATE	FED. AID PROJECT	FISCAL YEAR	SHEET NO.	TOTAL SHEETS
HAWAII	HAW.	STP-011-2(041)	2012	23	24

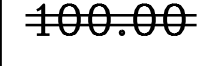
CENTERLINE MONUMENT SCHEDULE (REVISED)					
EXISTING PROJECT	STATION	RECONSTRUCT (Item No. 613.0300)	ADJUST EXISTING (Item No. 613.0300)	CENTERLINE OFFSET (FT.)	CENTERLINE OFFSET (FT.)
F-2(4)	P.C. Sta. 752+05.8 752+04.01 $\triangle$	1 $\triangle$	$\neq$	0.00	0.20 $\triangle$
	P.T. Sta. 769+39.22 (BK) P.T. Sta. 770+12.48 (AH)	1	$\neq$	0.00	0.25 $\triangle$
	P.C. Sta. 781+42.22 781+40.60	1	$\neq$	$\triangle$ 0.00 0.10 Rt	0.30 $\triangle$
	P.T. Sta. 791+76.30 (BK) P.T. Sta. 791+77.40 (AH)	1	$\neq$	0.00	0.27 $\triangle$
	P.O.T. Sta. 813+99.78	1	1	$\triangle$ 0.00 0.20 Rt	0.00 $\triangle$
	P.C. Sta. 823+03.12 823+01.09	1 $\triangle$	$\neq$	$\triangle$ 0.00 0.20 Rt	0.27 $\triangle$
	P.T. Sta. 837+91.10 (BK) P.T. Sta. 837+95.43 (AH)	1	$\neq$	$\triangle$ 0.00 0.10 Lt	0.25 $\triangle$
	P.C. Sta. 847+66.26	1	$\neq$	0.00	0.20 $\triangle$
	P.T. Sta. 864+00.31 (BK) P.T. Sta. 864+04.24 (AH)	1	$\neq$	0.00	0.27 $\triangle$
	P.C. Sta. 875+05.60	1	$\neq$	$\triangle$ 0.00 0.10 Rt	0.30 $\triangle$
	P.T. Sta. 883+24.73	1	$\neq$	$\triangle$ 0.00 0.15 Rt	0.20 $\triangle$
	T.S. Sta. 894+21.09		1	$\triangle$ 0.00 5.50 Lt	0.00 $\triangle$
	S.C. Sta. 896+71.09 $\triangle$		$\neq$	$\triangle$ 0.00	0.00 $\triangle$
	C.S. Sta. 906+40.99 $\triangle$		$\neq$	$\triangle$ 0.00	0.00 $\triangle$
	P.O.C. Sta. 907+82.24		1	0.00	0.00 $\triangle$
	S.T. Sta. 908+90.99		1	0.00	0.00 $\triangle$
	T.S. Sta. 916+53.48		1	0.00	0.00 $\triangle$
	S.C. Sta. 919+03.48 $\triangle$		$\neq$ $\triangle$	$\triangle$ 0.00	0.00 $\triangle$
	C.S. Sta. 929+79.61 $\triangle$		$\neq$ $\triangle$	$\triangle$ 0.00	0.00 $\triangle$
	S.T. Sta. 932+29.61		1	0.00	0.00 $\triangle$
	P.C. Sta. 945+27.87		1	$\triangle$ 0.00 8.00 Lt	0.00 $\triangle$
	P.T. Sta. 954+48.92		1	$\triangle$ 0.00 0.20 Rt	0.00 $\triangle$
	P.C. Sta. 966+42.16 966+55.42 $\triangle$	1 $\triangle$	$\neq$ $\triangle$	0.00	0.00 $\triangle$
	P.T. Sta. 972+08.40		1	$\triangle$ 0.00 0.10 Rt	0.00 $\triangle$
	P.C. Sta. 974+92.64 974+89.77 $\triangle$	1 $\triangle$	$\neq$ $\triangle$	0.00	0.00 $\triangle$
	P.T. Sta. 990+59.64		1	$\triangle$ 0.00 4.25 Lt	0.00 $\triangle$
	P.C. Sta. 999+24.42 999+30.30 $\triangle$		1 $\triangle$	$\triangle$ 0.00 0.15 Rt	0.00 $\triangle$
TOTAL		$\triangle$ $\neq$ 12	$\triangle$ 27 11		

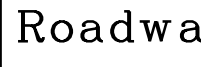
$\triangle$	08/05/13	Revised Centerline Monument Schedule
DATE	REVISION	

LEGEND FOR

AS-BUILT POSTINGS

 Squiggly line for as-built deletion

 Double line for as-built deletion

 Text for as-built posting

STATE OF HAWAII
DEPARTMENT OF TRANSPORTATION
HIGHWAYS DIVISION

CENTERLINE MONUMENT
SCHEDULE

VOLCANO HIGHWAY
Pavement Preventive Maintenance
Mountain View to Kea'au
Federal Aid Project No. STP-011-2(041)

Date: March, 2012

SHEET No. 1 OF 1 SHEETS