


FED. ROAD DIST. NO.	STATE	FED. AID PROJECT	FISCAL YEAR	SHEET NO.	TOTAL SHEETS
HAWAII	HAW.	STP-011-2(041)	2012	9	24

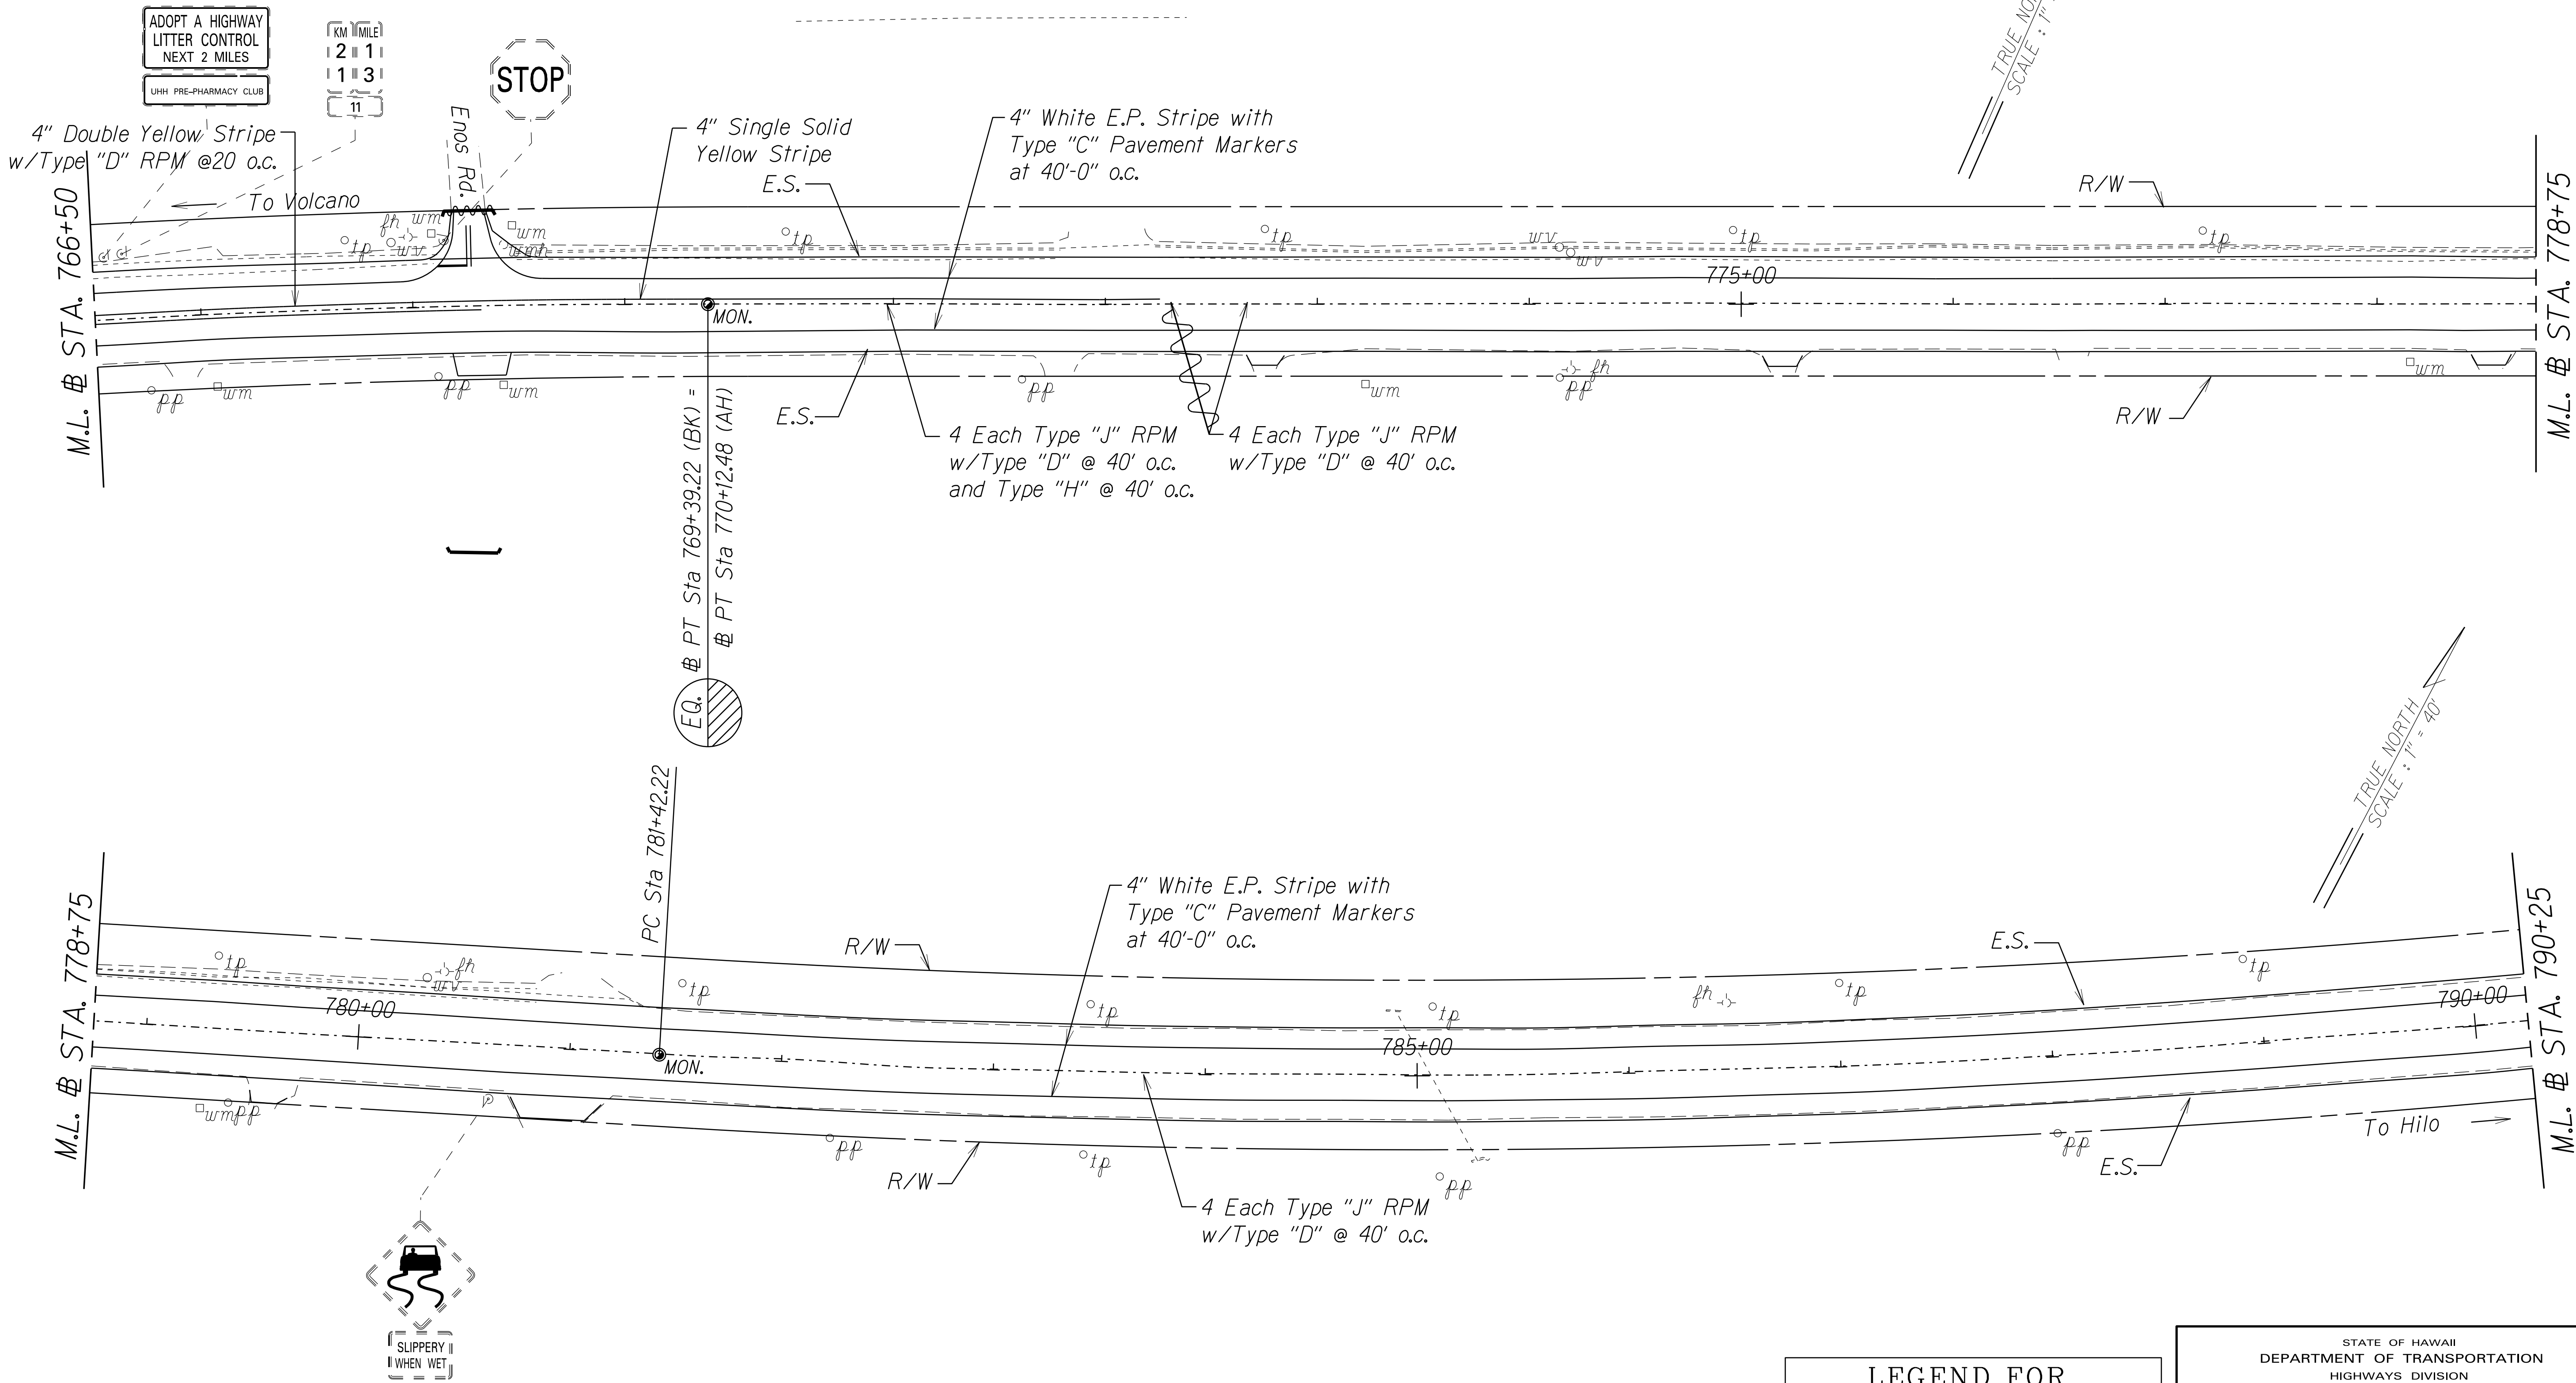

Notes:

1. All existing signs (dashed) with post are to remain.
2. All existing signs in conflict with construction signs are to be covered.
3. This work shall be considered incidental to various contract items.

LEGEND FOR AS-BUILT POSTINGS	
	Squiggly line for as-built deletion
	Double line for as-built deletion
Roadway	Text for as-built posting

STATE OF HAWAII
DEPARTMENT OF TRANSPORTATION
HIGHWAYS DIVISION

ROADWAY PLAN

VOLCANO ROAD



Pavement Preventive Maintenance
Mountain View to Kea'au

Federal Aid Project No. STP-011-2(041)

Scale: 1"=40' Date: March, 2012

SHEET No. 2 OF 12 SHEETS

FED. ROAD DIST. NO.	STATE	FED. AID PROJECT	FISCAL YEAR	SHEET NO.	TOTAL SHEETS
HAWAII	HAW.	STP-011-2(041)	2012	10	24

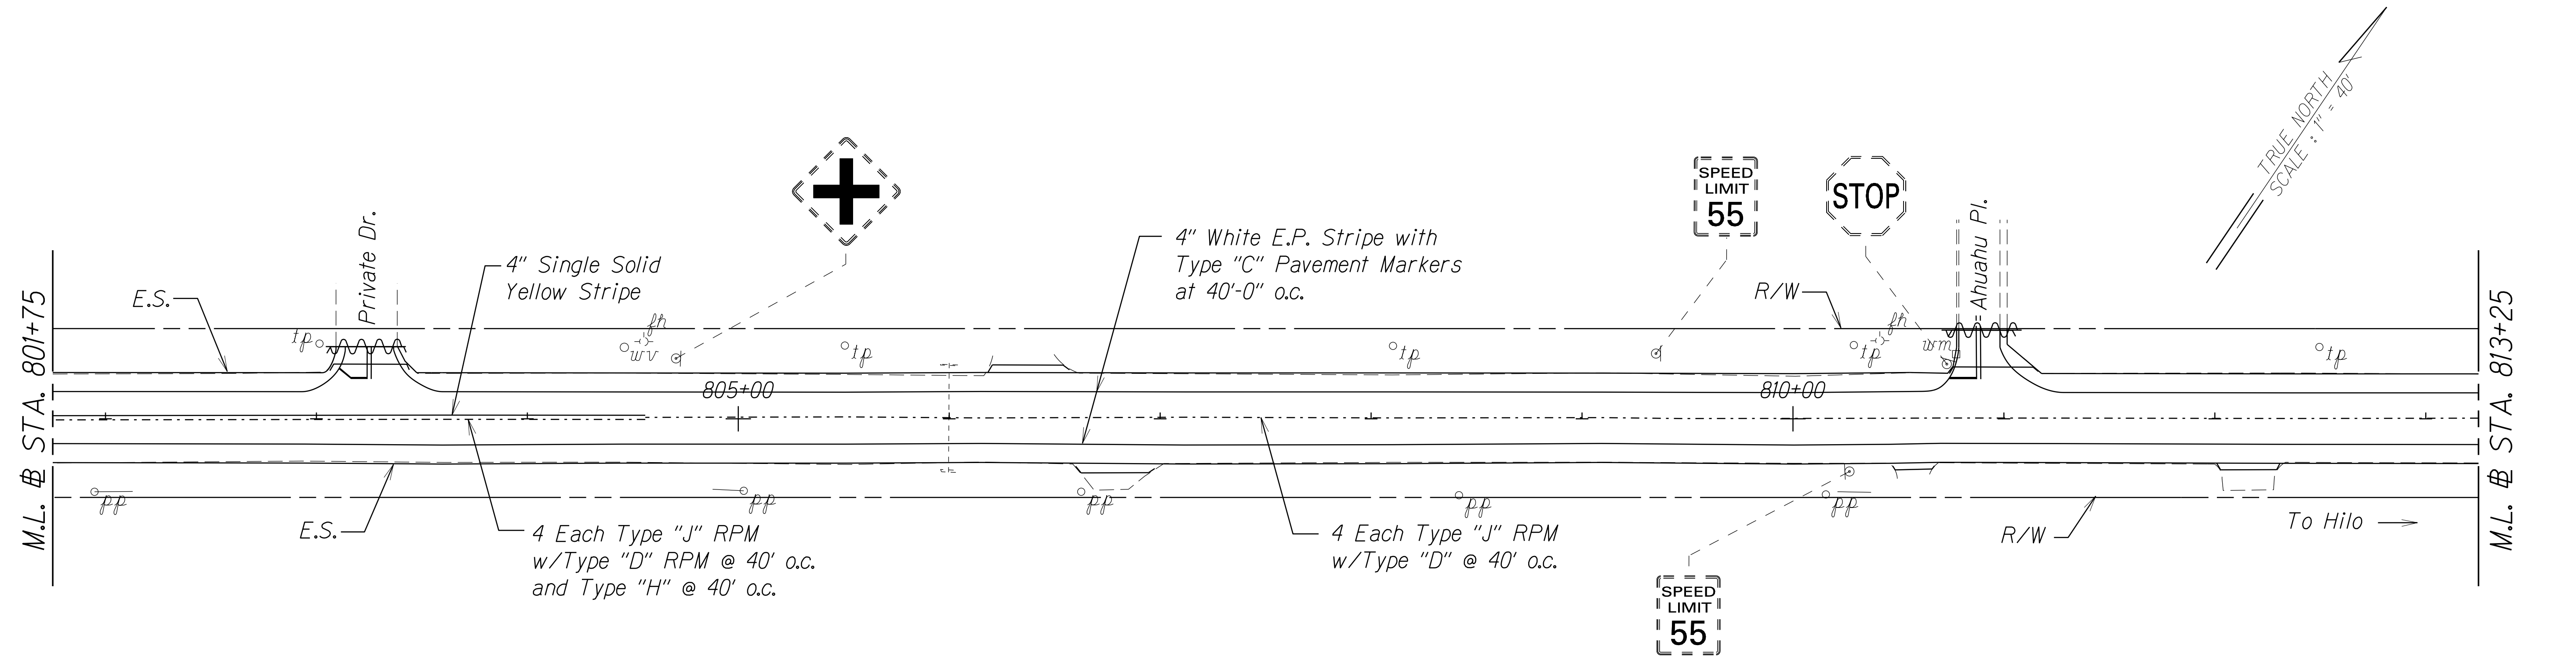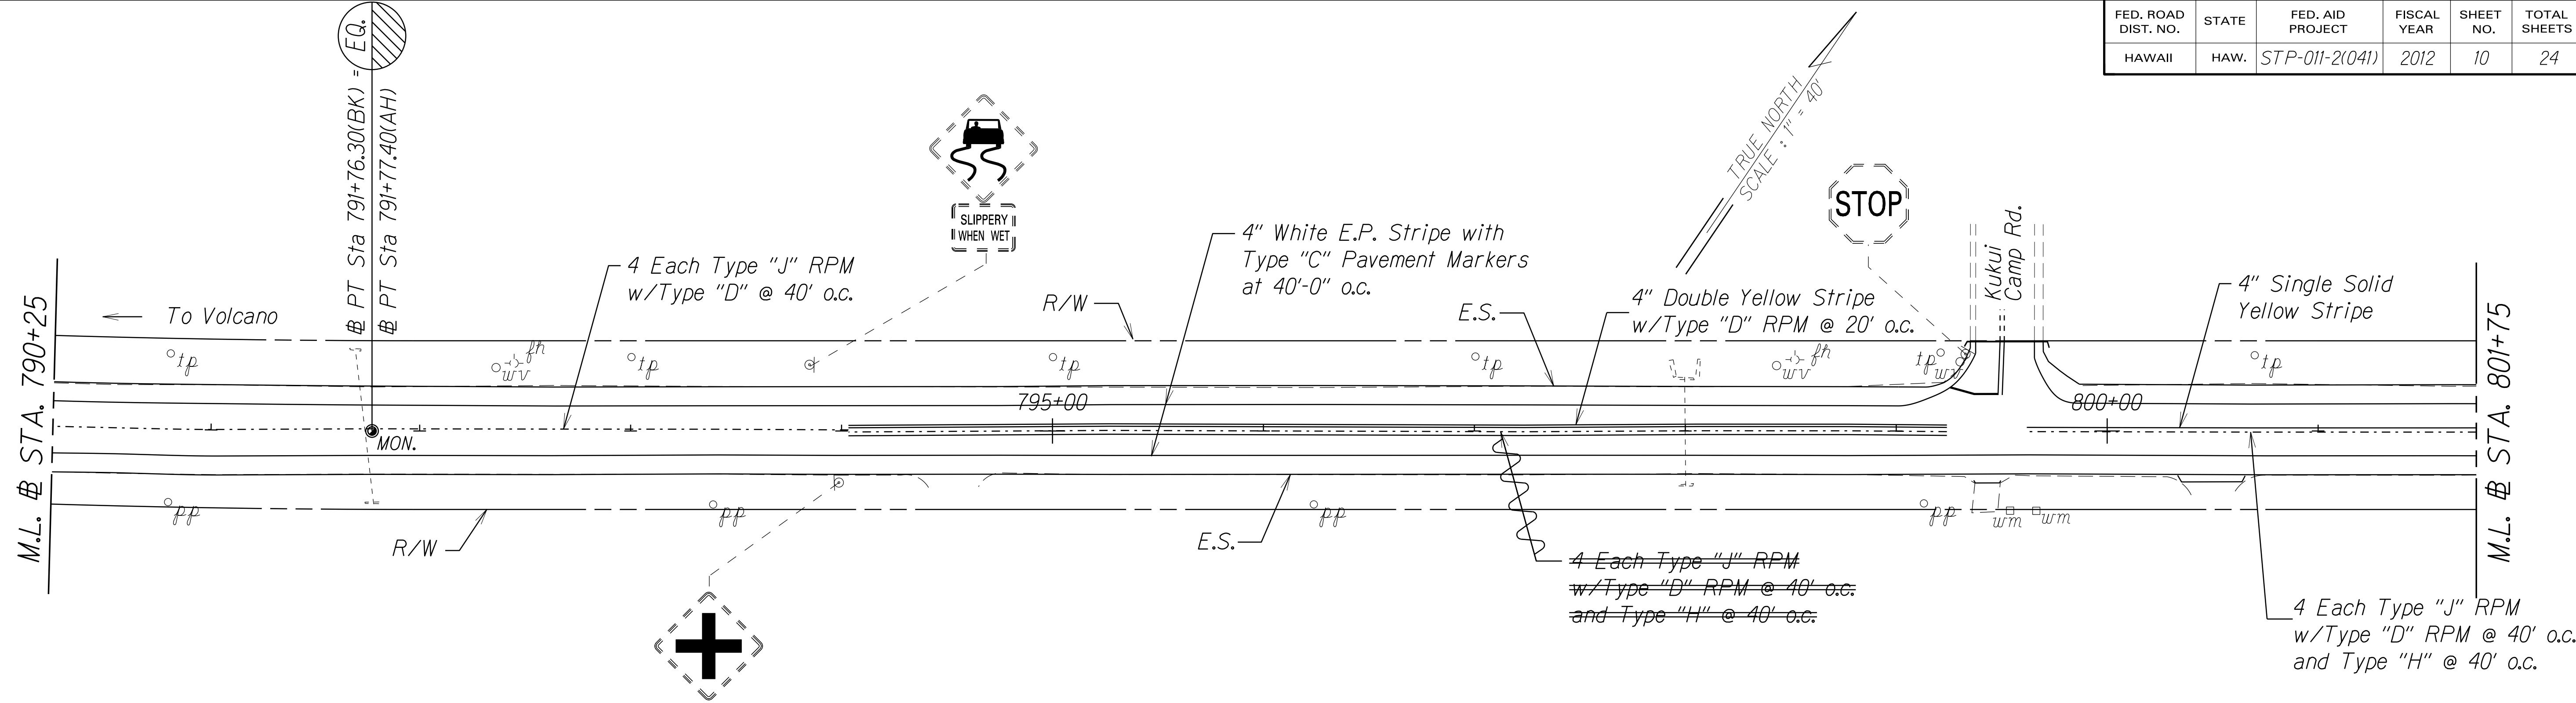

ORIGINAL PLAN	SURVEY PLOTTED BY	DATE
NOTE BOOK	DRAWN BY	...
...	TRACED BY	...
...	DESIGNED BY	...
...	CHECKED BY	...

- Notes:
1. All existing signs (dashed) with post are to remain.
 2. All existing signs in conflict with construction signs are to be covered.
 3. This work shall be considered incidental to various contract items.

LEGEND FOR AS-BUILT POSTINGS	
	Squiggly line for as-built deletion
	Double line for as-built deletion
Roadway	Text for as-built posting

STATE OF HAWAII
DEPARTMENT OF TRANSPORTATION
HIGHWAYS DIVISION

ROADWAY PLAN

VOLCANO ROAD

Pavement Preventive Maintenance


Mountain View to Kea'au

Federal Aid Project No. STP-011-2(041)

Scale: 1"=40' Date: March, 2012

SHEET No. 3 OF 12 SHEETS

FED. ROAD DIST. NO.	STATE	FED. AID PROJ. NO.	FISCAL YEAR	SHEET NO.	TOTAL SHEETS
HAWAII	HAW.	STP-011-2(041)	2012	11	24

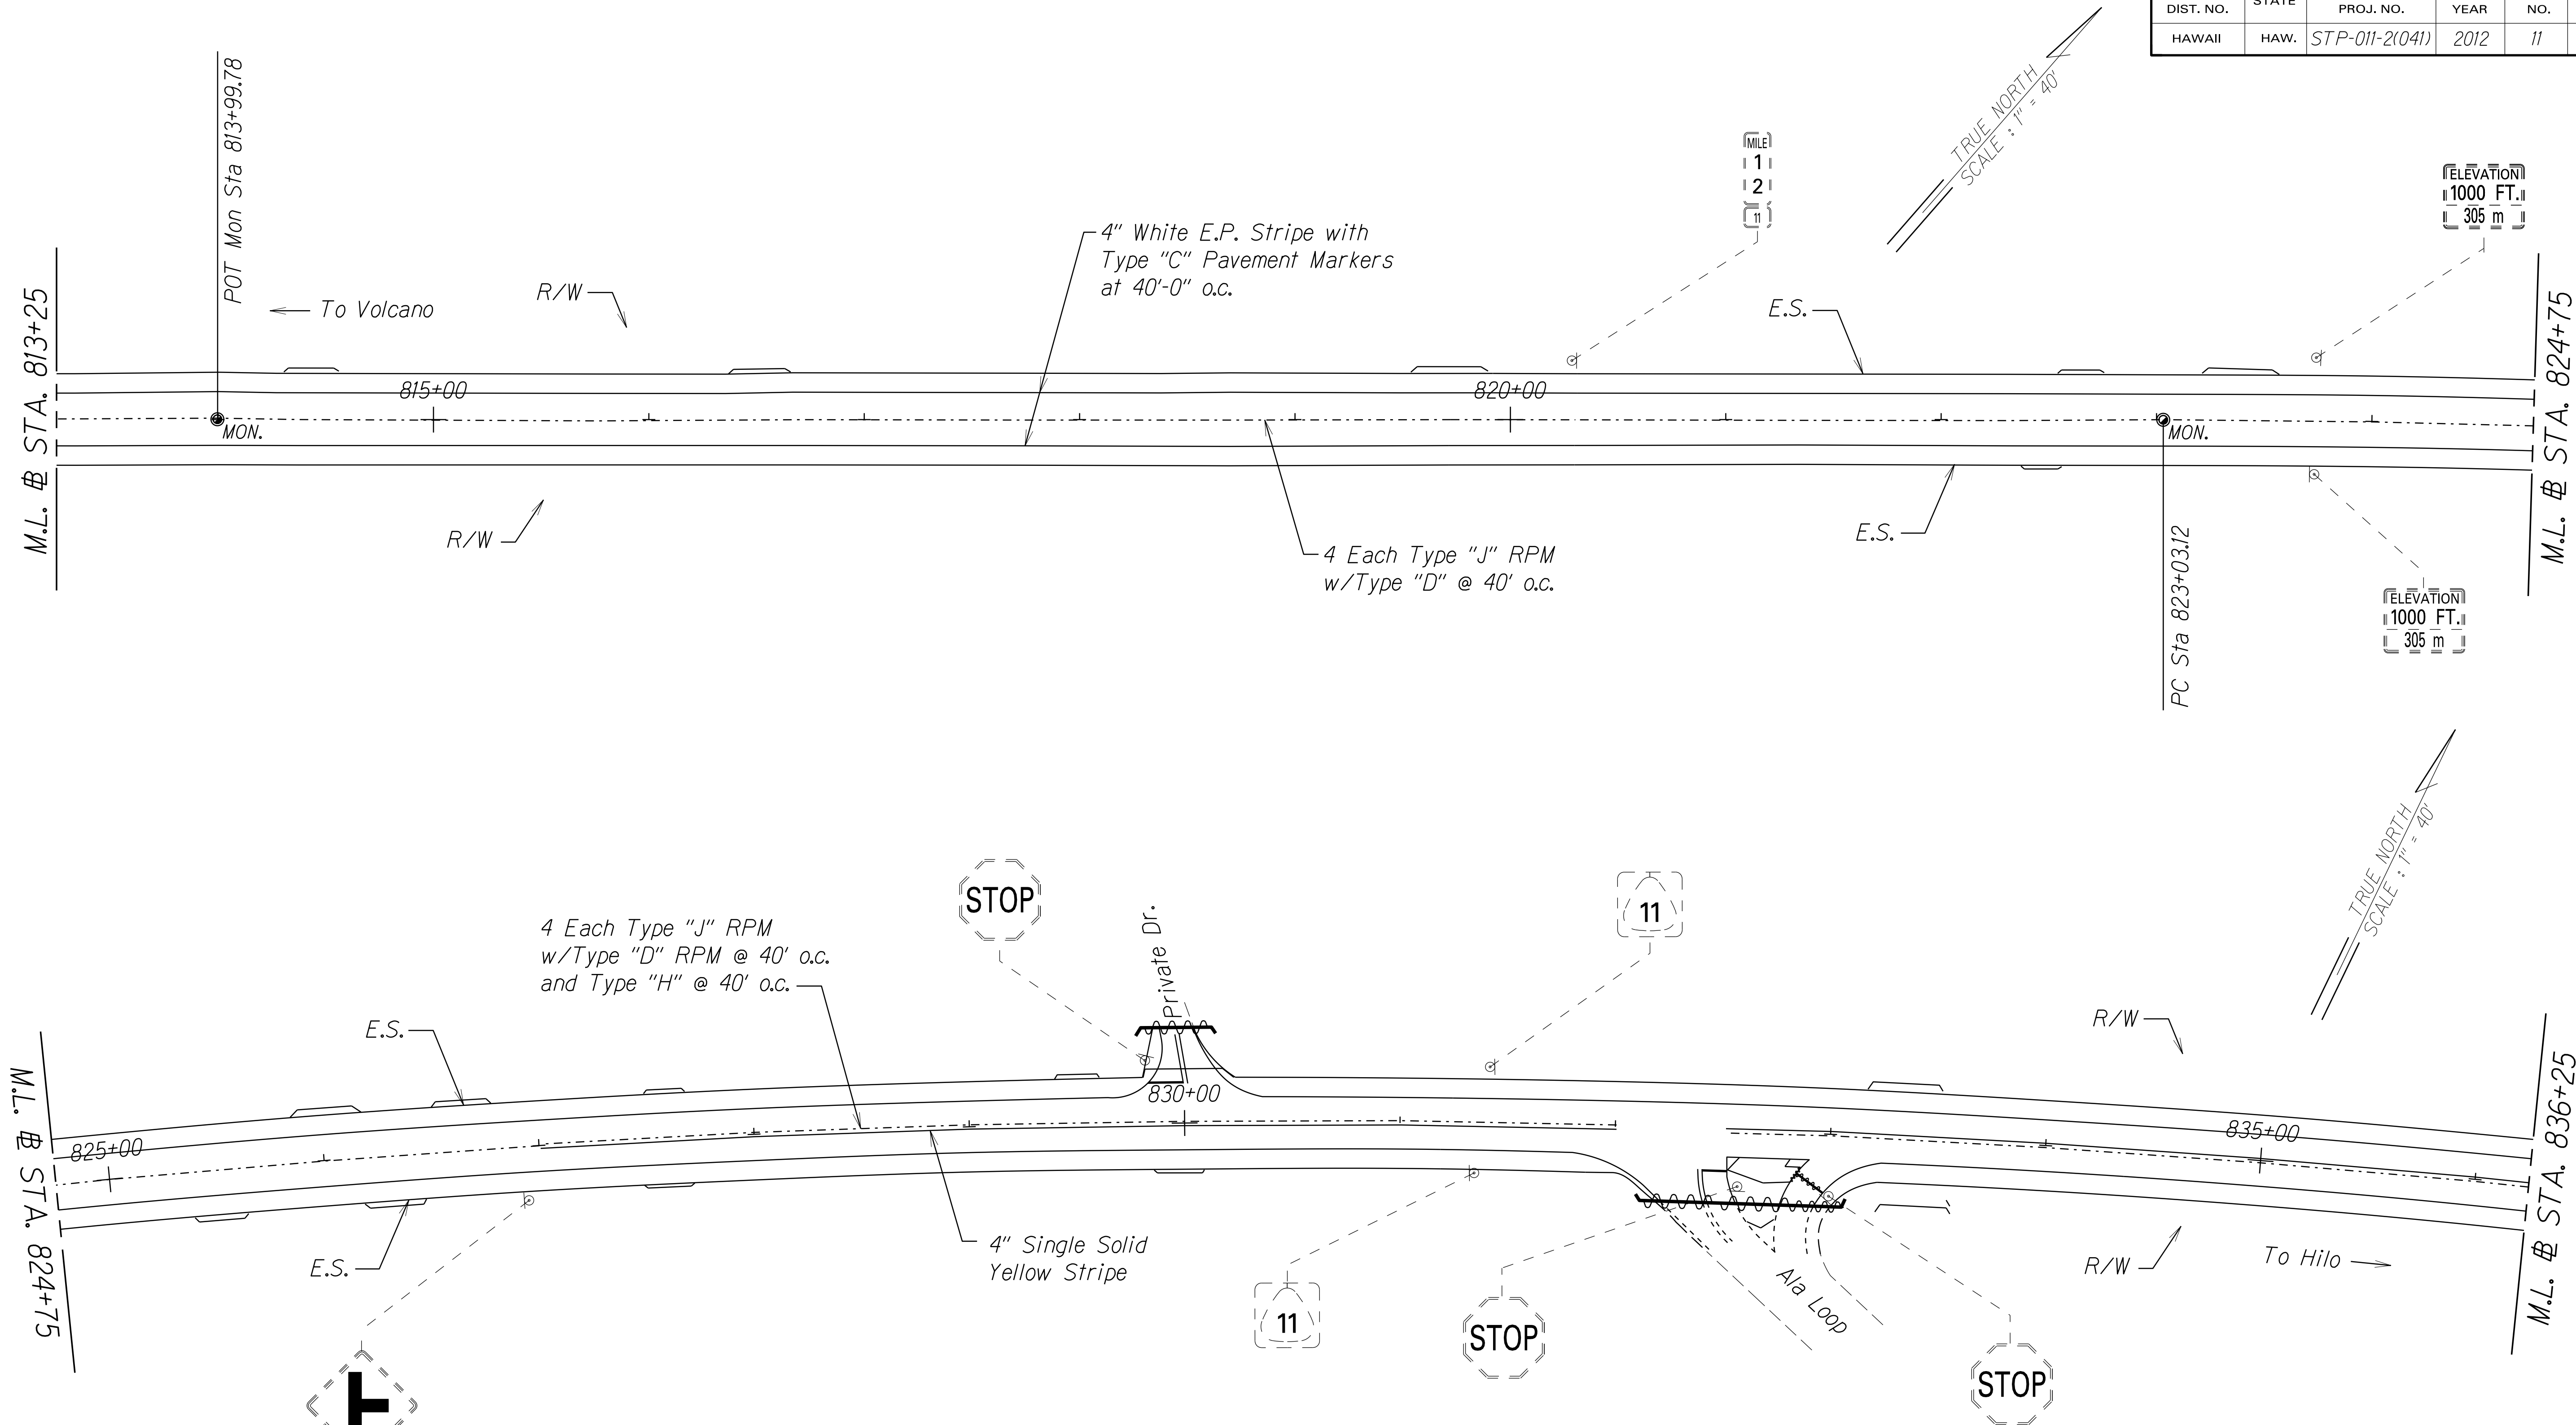

Notes:

1. All existing signs (dashed) with post are to remain.
2. All existing signs in conflict with construction signs are to be covered.
3. This work shall be considered incidental to various contract items.

ORIGINAL PLAN	SURVEY PLOTTED BY	DATE
NOTE BOOK	DRAWN BY	
DESIGNED BY	TRACED BY	
CHECKED BY	CHECKED BY	

LEGEND FOR AS-BUILT POSTINGS	
	Squiggly line for as-built deletion
	Double line for as-built deletion
Roadway	Text for as-built posting

STATE OF HAWAII
DEPARTMENT OF TRANSPORTATION
HIGHWAYS DIVISION

ROADWAY PLAN

VOLCANO ROAD

Pavement Preventive Maintenance


Mountain View to Kea'au

Federal Aid Project No. STP-011-2(041)

Scale: 1"=40' Date: March, 2012

SHEET No. 4 OF 12 SHEETS

FED. ROAD DIST. NO.	STATE	FED. AID PROJ. NO.	FISCAL YEAR	SHEET NO.	TOTAL SHEETS
HAWAII	HAW.	STP-011-2(041)	2012	12	24

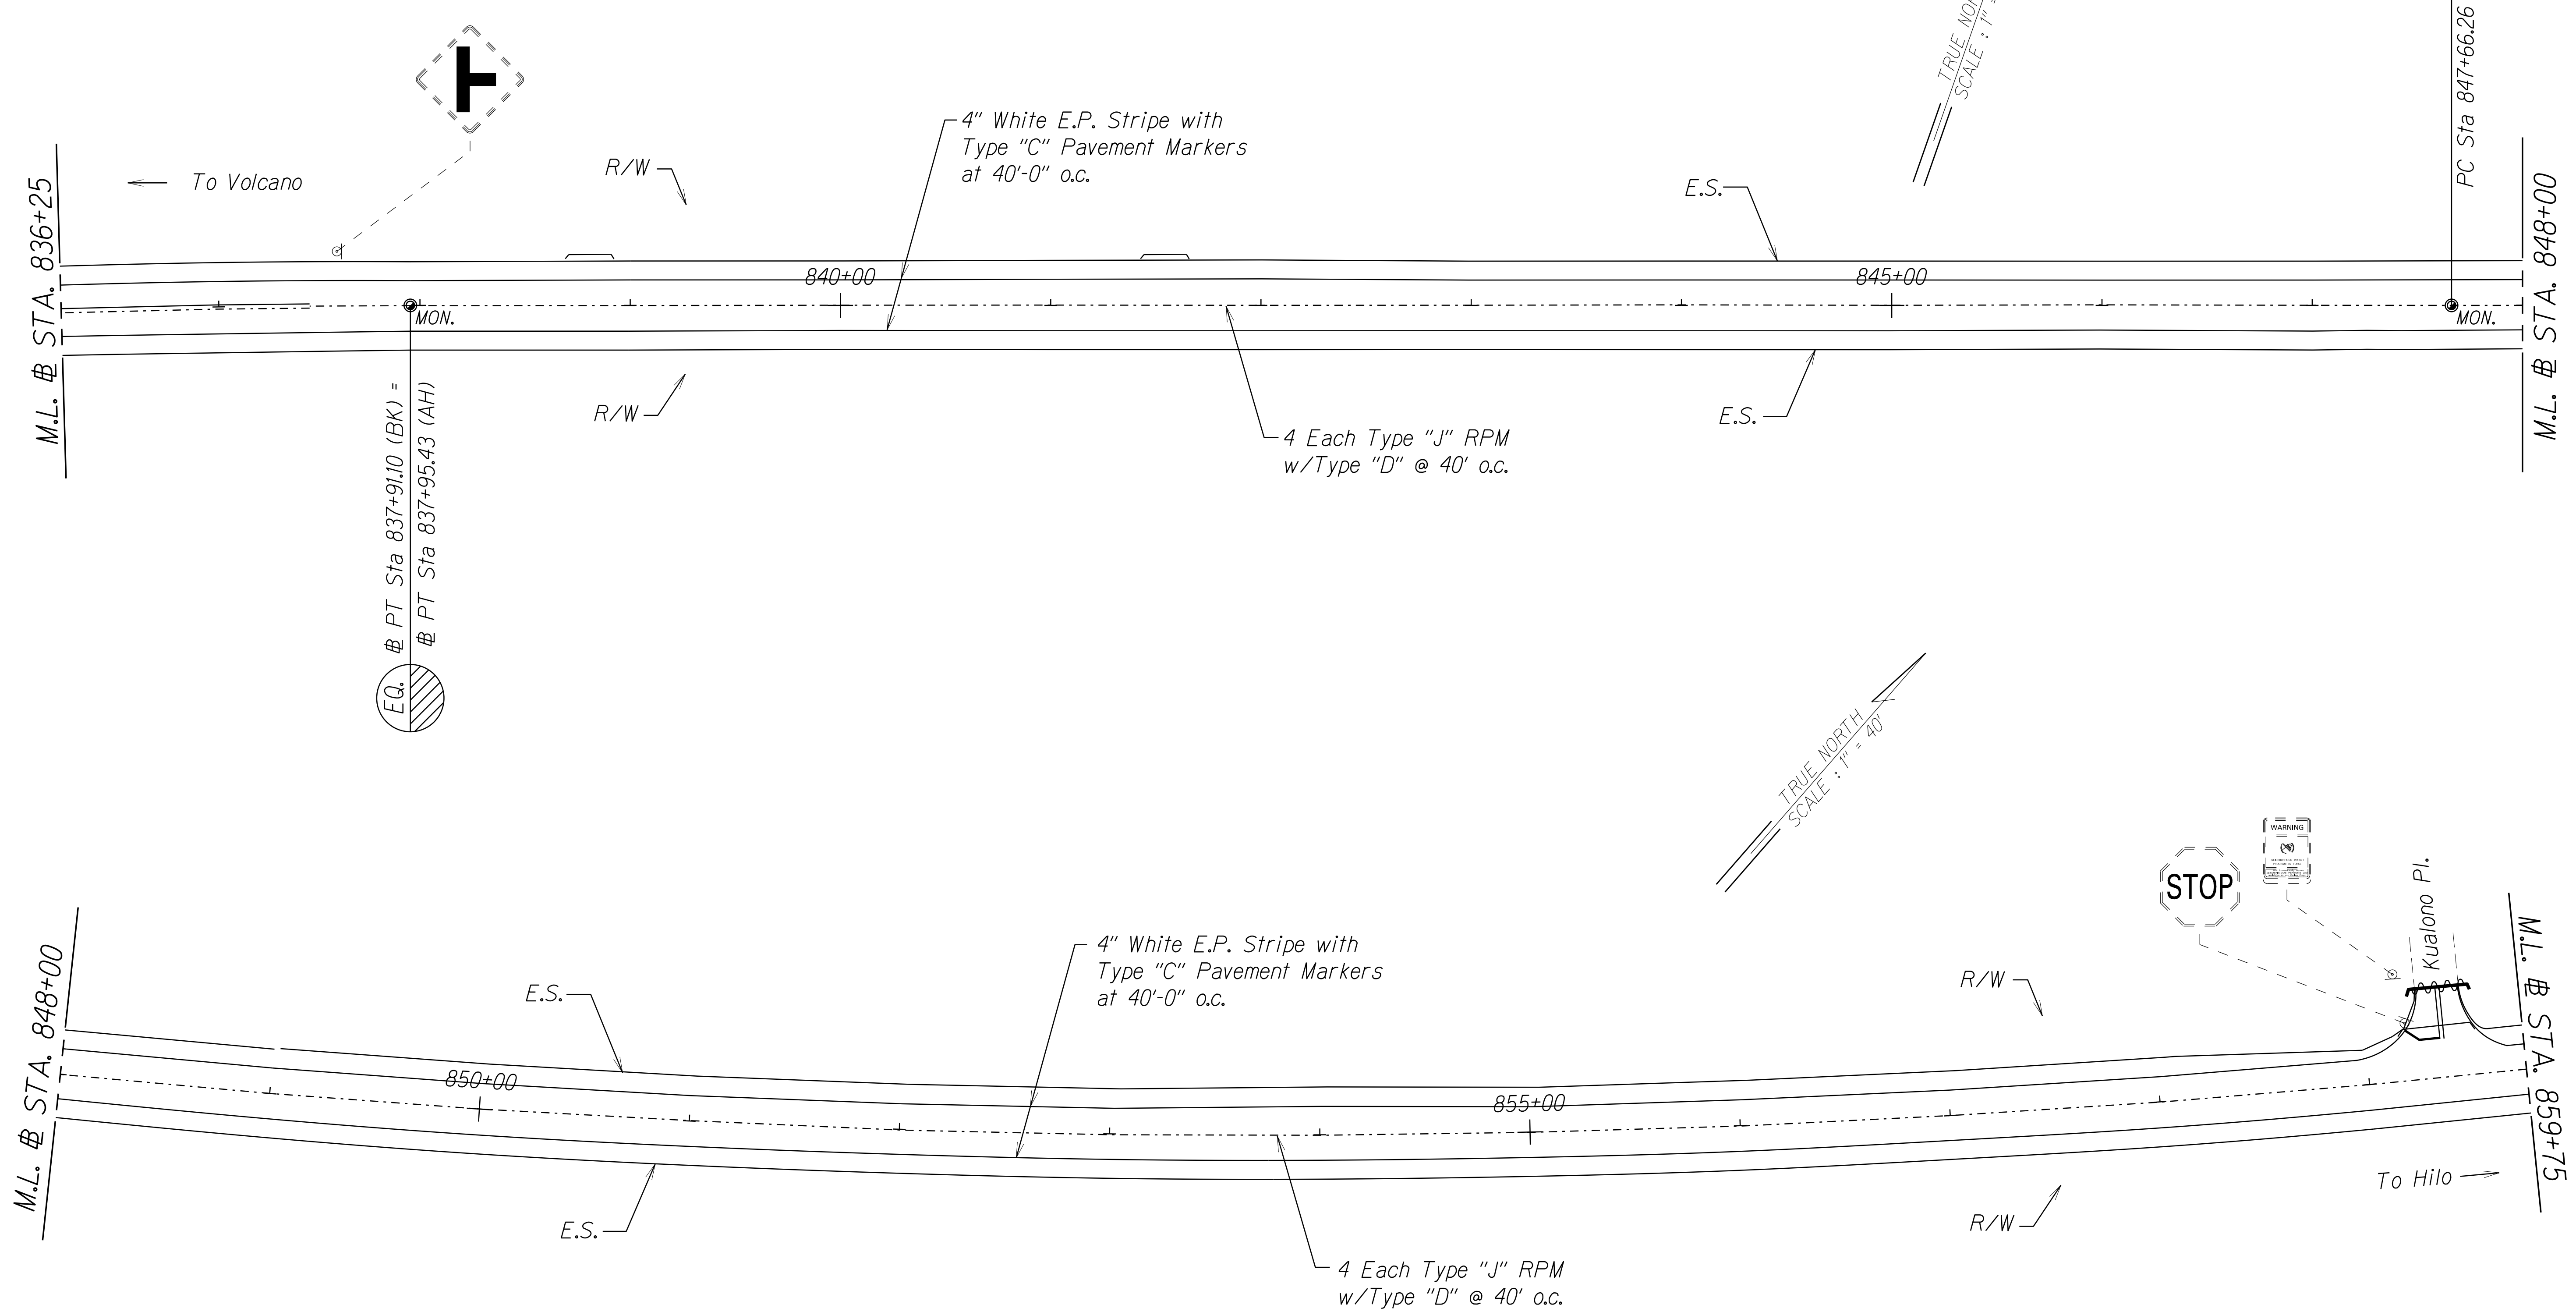

ORIGINAL PLAN	SURVEY PLOTTED BY	DATE
NOTE BOOK	DRAWN BY	
DESIGNED BY	TRACED BY	
CHECKED BY	DESIGNED BY	
	CHECKED BY	

Notes:

1. All existing signs (dashed) with post are to remain.
2. All existing signs in conflict with construction signs are to be covered.
3. This work shall be considered incidental to various contract items.

LEGEND FOR AS-BUILT POSTINGS	
	Squiggly line for as-built deletion
	Double line for as-built deletion
Roadway	Text for as-built posting

STATE OF HAWAII
DEPARTMENT OF TRANSPORTATION
HIGHWAYS DIVISION

ROADWAY PLAN

VOLCANO ROAD

Pavement Preventive Maintenance


Mountain View to Kea'au

Federal Aid Project No. STP-011-2(041)

Scale: 1"=40' Date: March, 2012

SHEET No. 5 OF 12 SHEETS

FED. ROAD DIST. NO.	STATE	FED. AID PROJ. NO.	FISCAL YEAR	SHEET NO.	TOTAL SHEETS
HAWAII	HAW.	STP-011-2(041)	2012	13	24

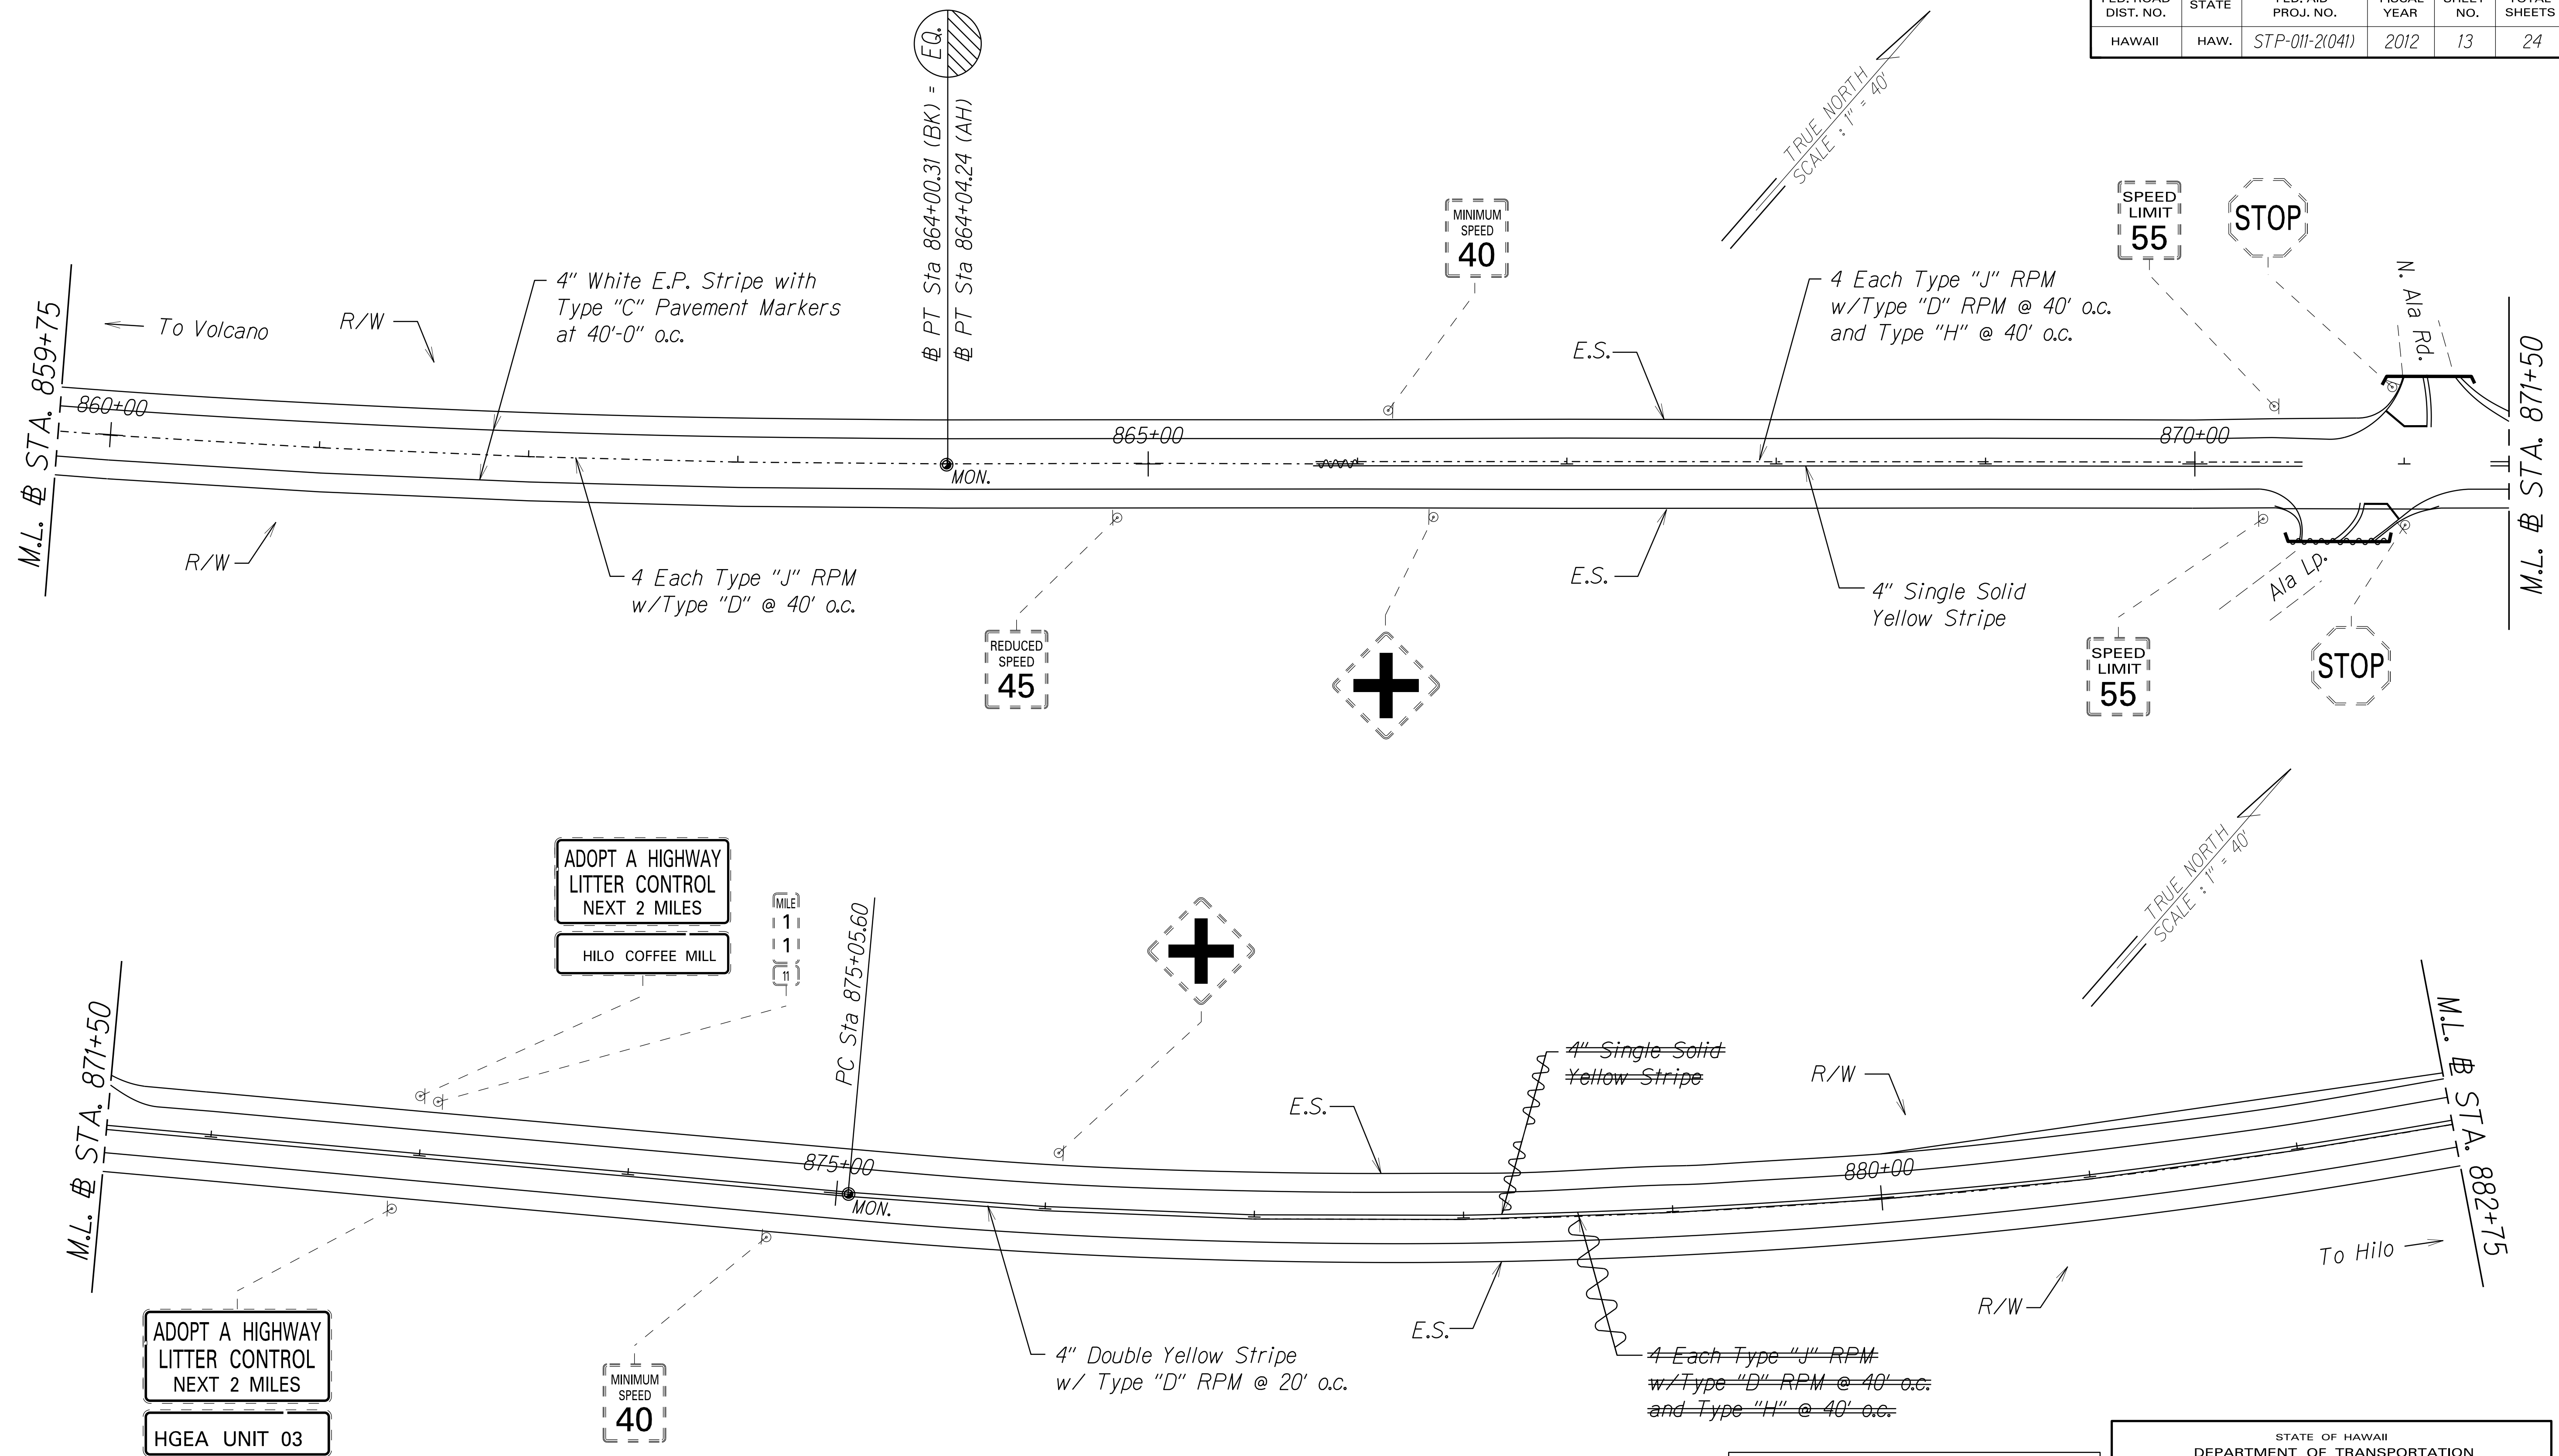

- Notes:
1. All existing signs (dashed) with post are to remain.
 2. All existing signs in conflict with construction signs are to be covered.
 3. This work shall be considered incidental to various contract items.

LEGEND FOR AS-BUILT POSTINGS	
	Squiggly line for as-built deletion
	Double line for as-built deletion
Roadway	Text for as-built posting

STATE OF HAWAII
DEPARTMENT OF TRANSPORTATION
HIGHWAYS DIVISION

ROADWAY PLAN

VOLCANO ROAD

Pavement Preventive Maintenance

Mountain View to Kea'au


Federal Aid Project No. STP-011-2(041)

Scale: 1"=40' Date: March, 2012

SHEET No. 6 OF 12 SHEETS

"AS-BUILT"

FED. ROAD DIST. NO.	STATE	FED. AID PROJ. NO.	FISCAL YEAR	SHEET NO.	TOTAL SHEETS
HAWAII	HAW.	STP-011-2(041)	2012	14	24

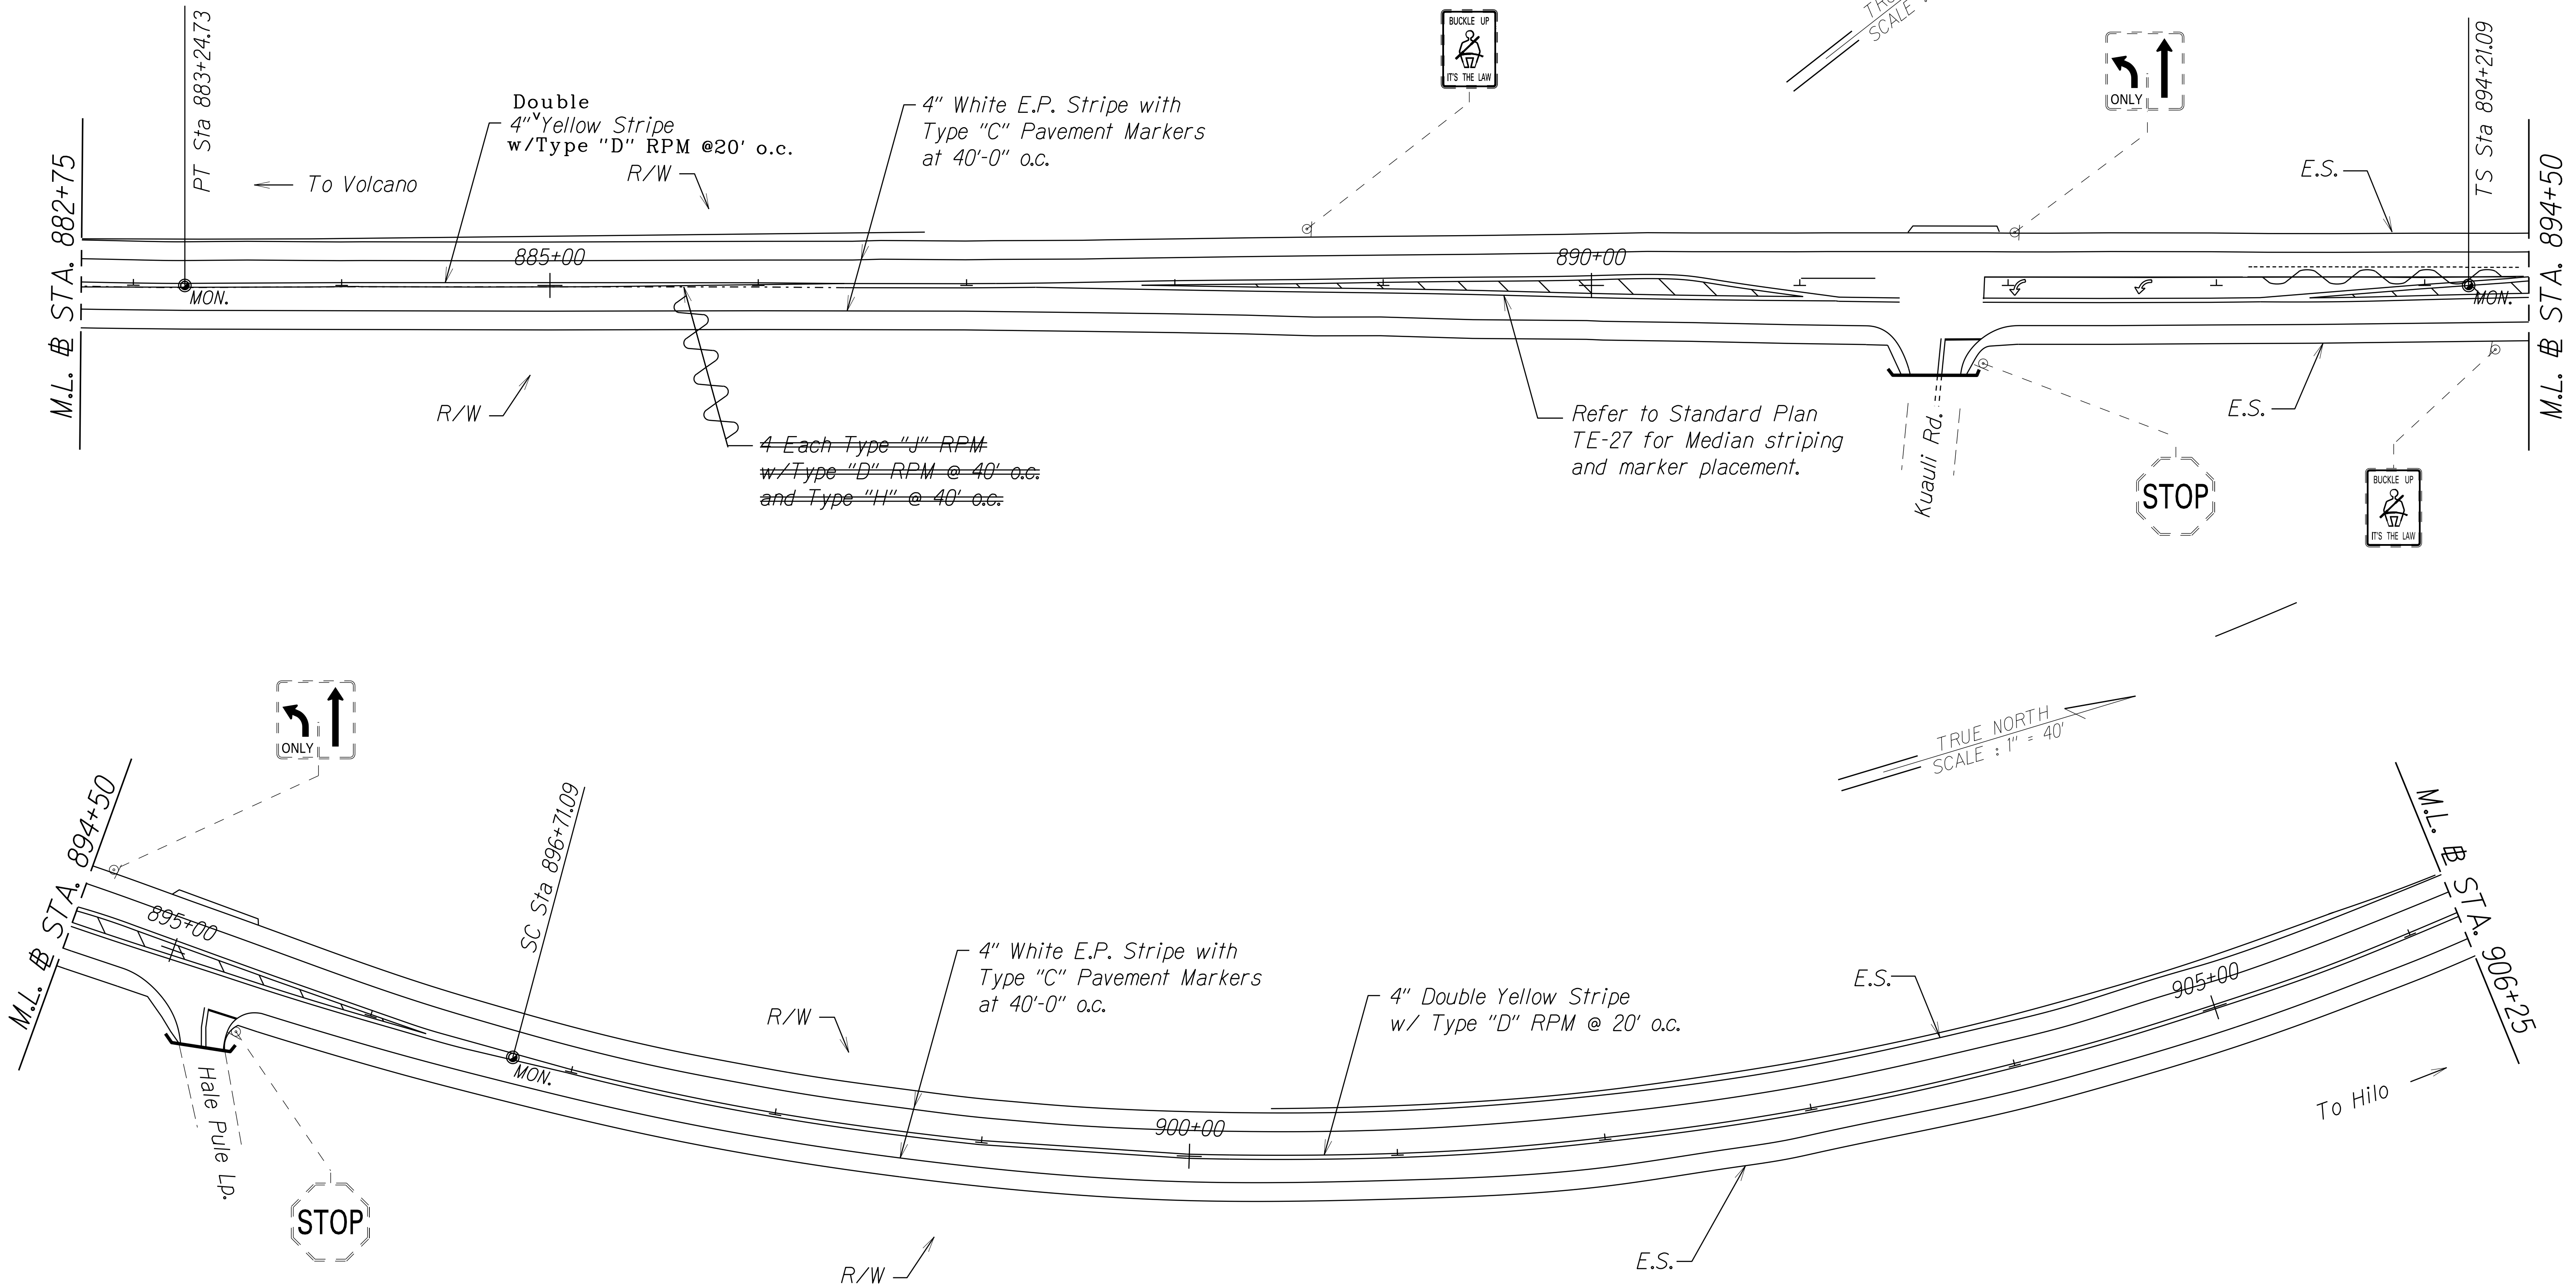

ORIGINAL PLAN	SURVEY PLOTTED BY	DATE
NOTE BOOK	DRAWN BY	
DESIGNED BY	TRACED BY	
CHECKED BY	DESIGNED BY	
	CHECKED BY	

Notes:

1. All existing signs (dashed) with post are to remain.
2. All existing signs in conflict with construction signs are to be covered.
3. This work shall be considered incidental to various contract items.

LEGEND FOR AS-BUILT POSTINGS	
	Squiggly line for as-built deletion
	Double line for as-built deletion
Roadway	Text for as-built posting

STATE OF HAWAII
DEPARTMENT OF TRANSPORTATION
HIGHWAYS DIVISION

ROADWAY PLANS

VOLCANO ROAD

Pavement Preventive Maintenance


Mountain View to Kea'au

Federal Aid Project No. STP-011-2(041)

Scale: 1"=40' Date: March, 2012

SHEET No. 7 OF 13 SHEETS

FED. ROAD DIST. NO.	STATE	FED. AID PROJ. NO.	FISCAL YEAR	SHEET NO.	TOTAL SHEETS
HAWAII	HAW.	STP-011-2(041)	2012	15	24

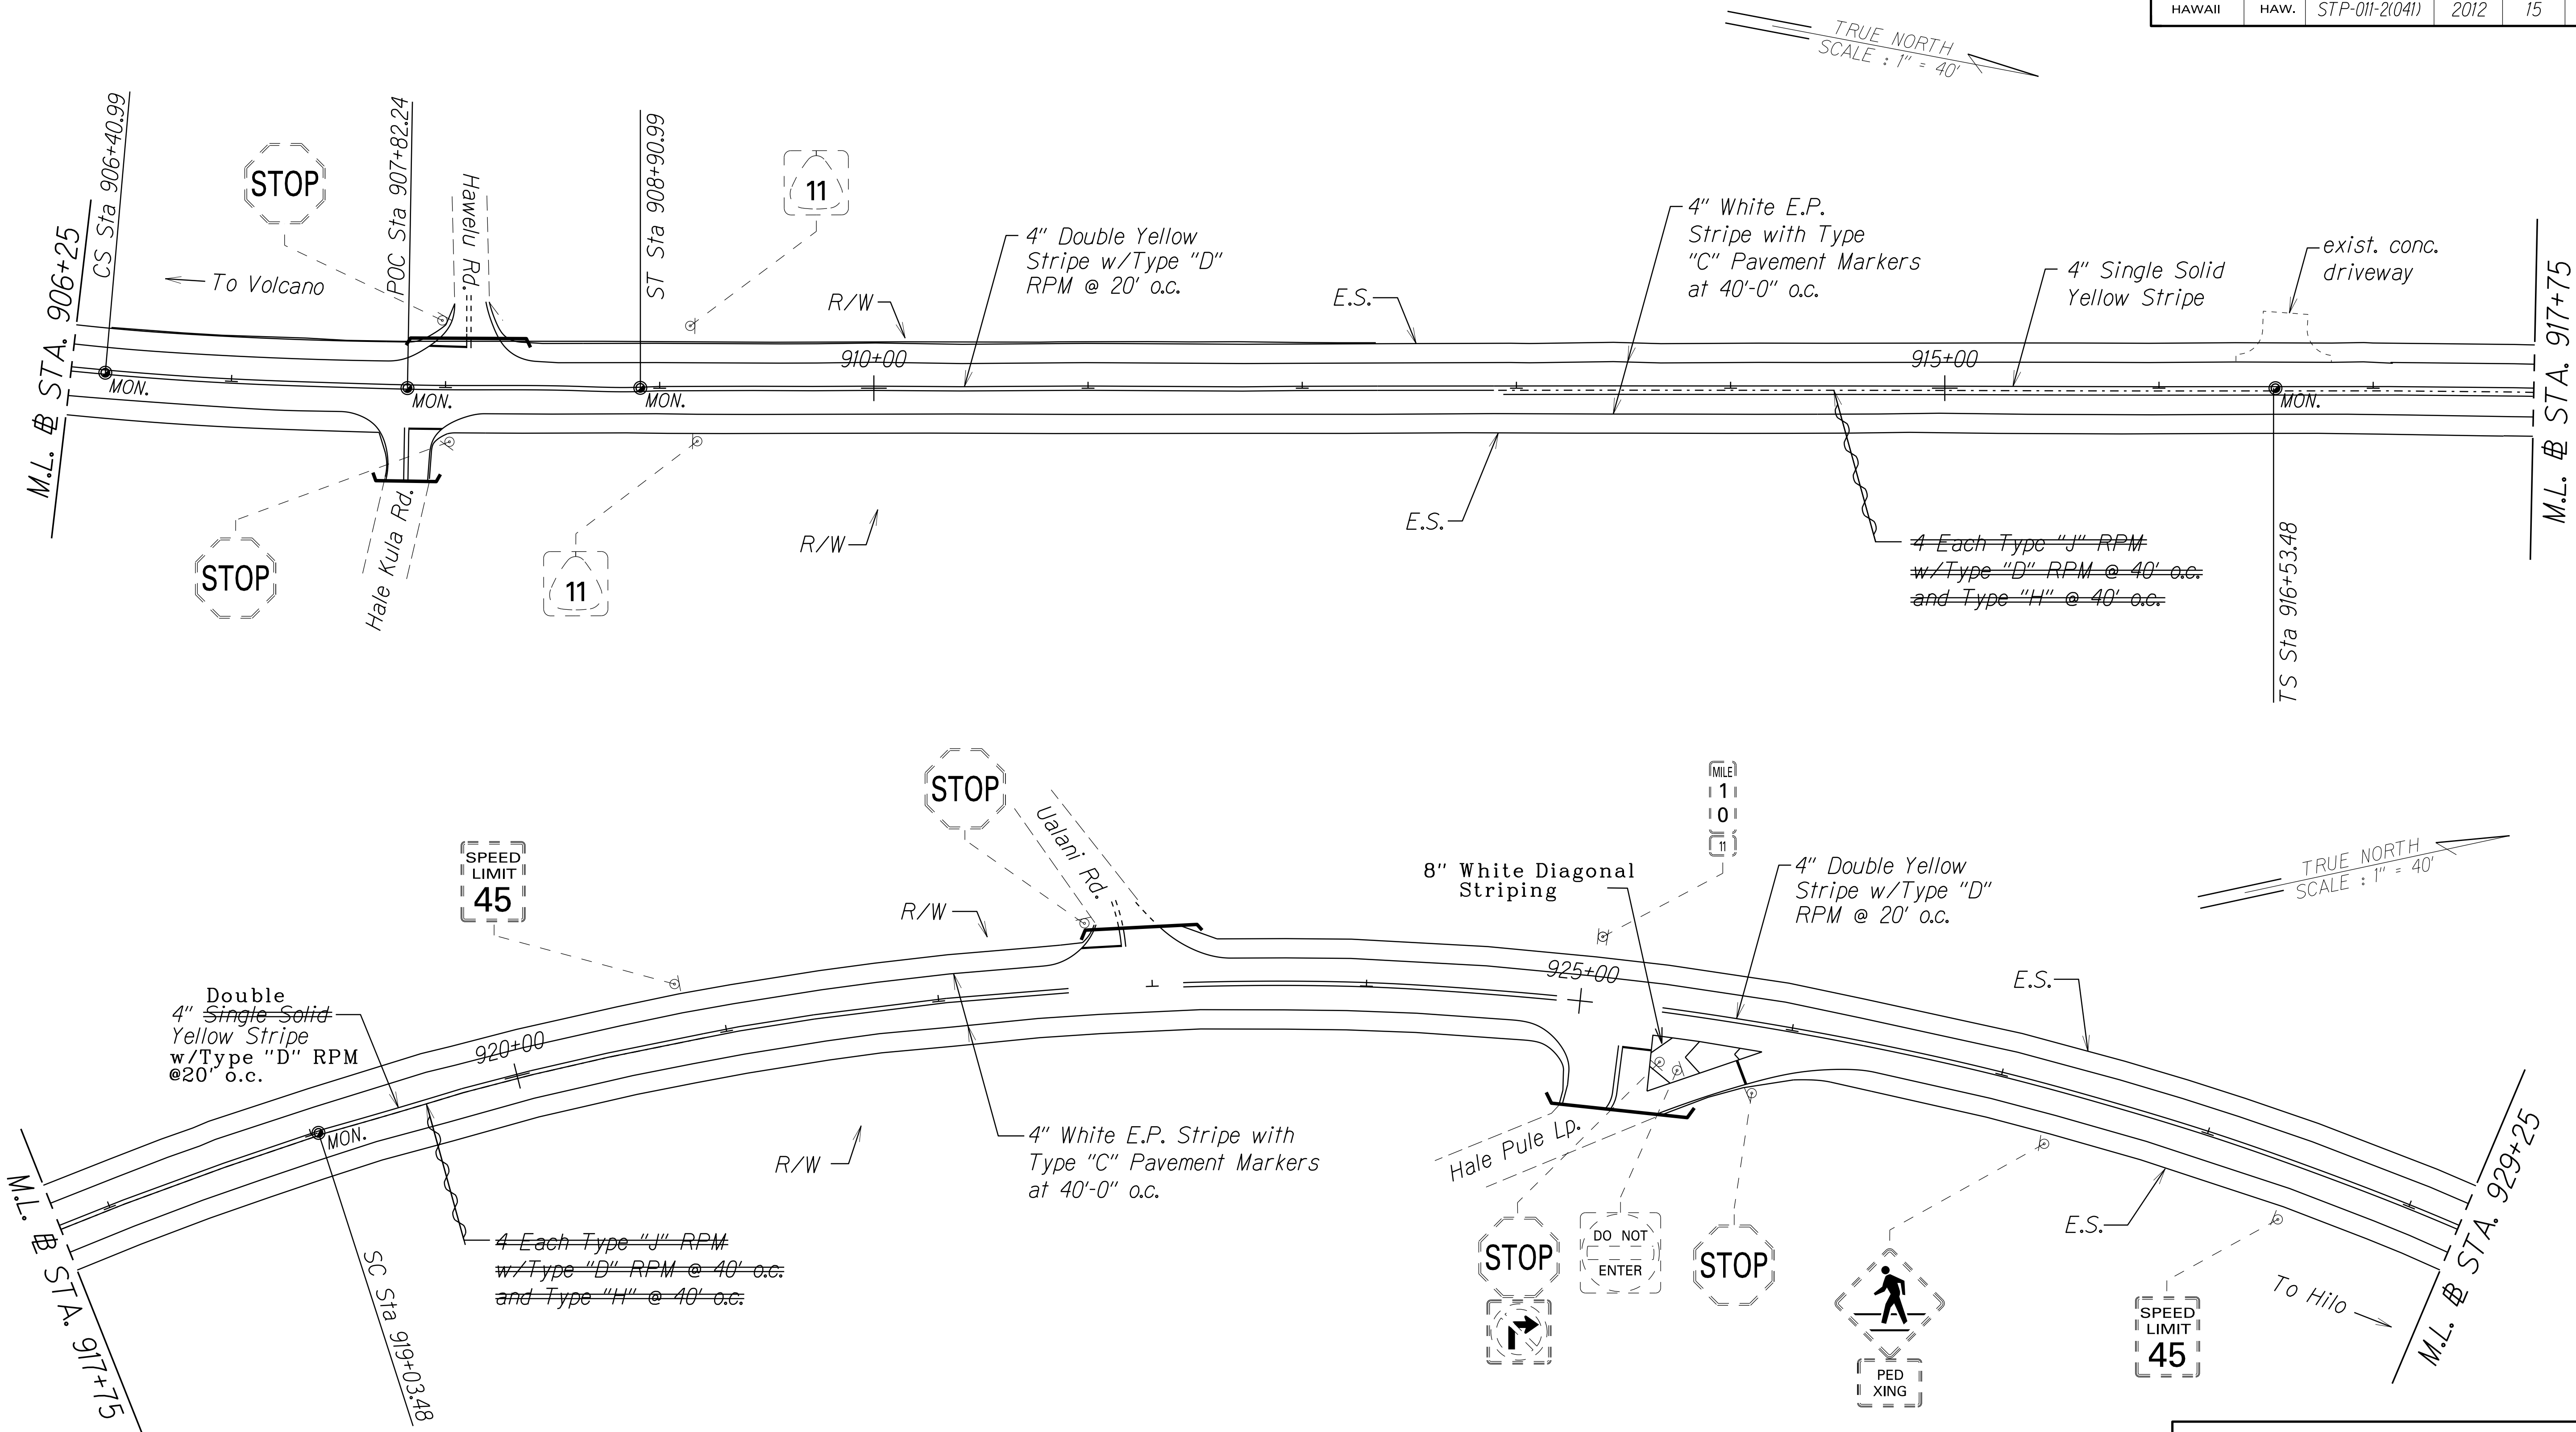

Notes:

1. All existing signs (dashed) with post are to remain.
2. All existing signs in conflict with construction signs are to be covered.
3. This work shall be considered incidental to various contract items.

LEGEND FOR
AS-BUILT POSTINGS

	Squiggly line for as-built deletion
	Double line for as-built deletion
Roadway	Text for as-built posting

STATE OF HAWAII
DEPARTMENT OF TRANSPORTATION
HIGHWAYS DIVISION

ROADWAY PLAN

VOLCANO ROAD

Pavement Preventive Maintenance

Mountain View to Kea'au

Federal Aid Project No. STP-011-2(041)


Scale: 1"=40' Date: March, 2012

SHEET No. 8 OF 12 SHEETS

"AS-BUILT"

15

FED. ROAD DIST. NO.	STATE	FED. AID PROJ. NO.	FISCAL YEAR	SHEET NO.	TOTAL SHEETS
HAWAII	HAW.	STP-011-2(041)	2012	17	24

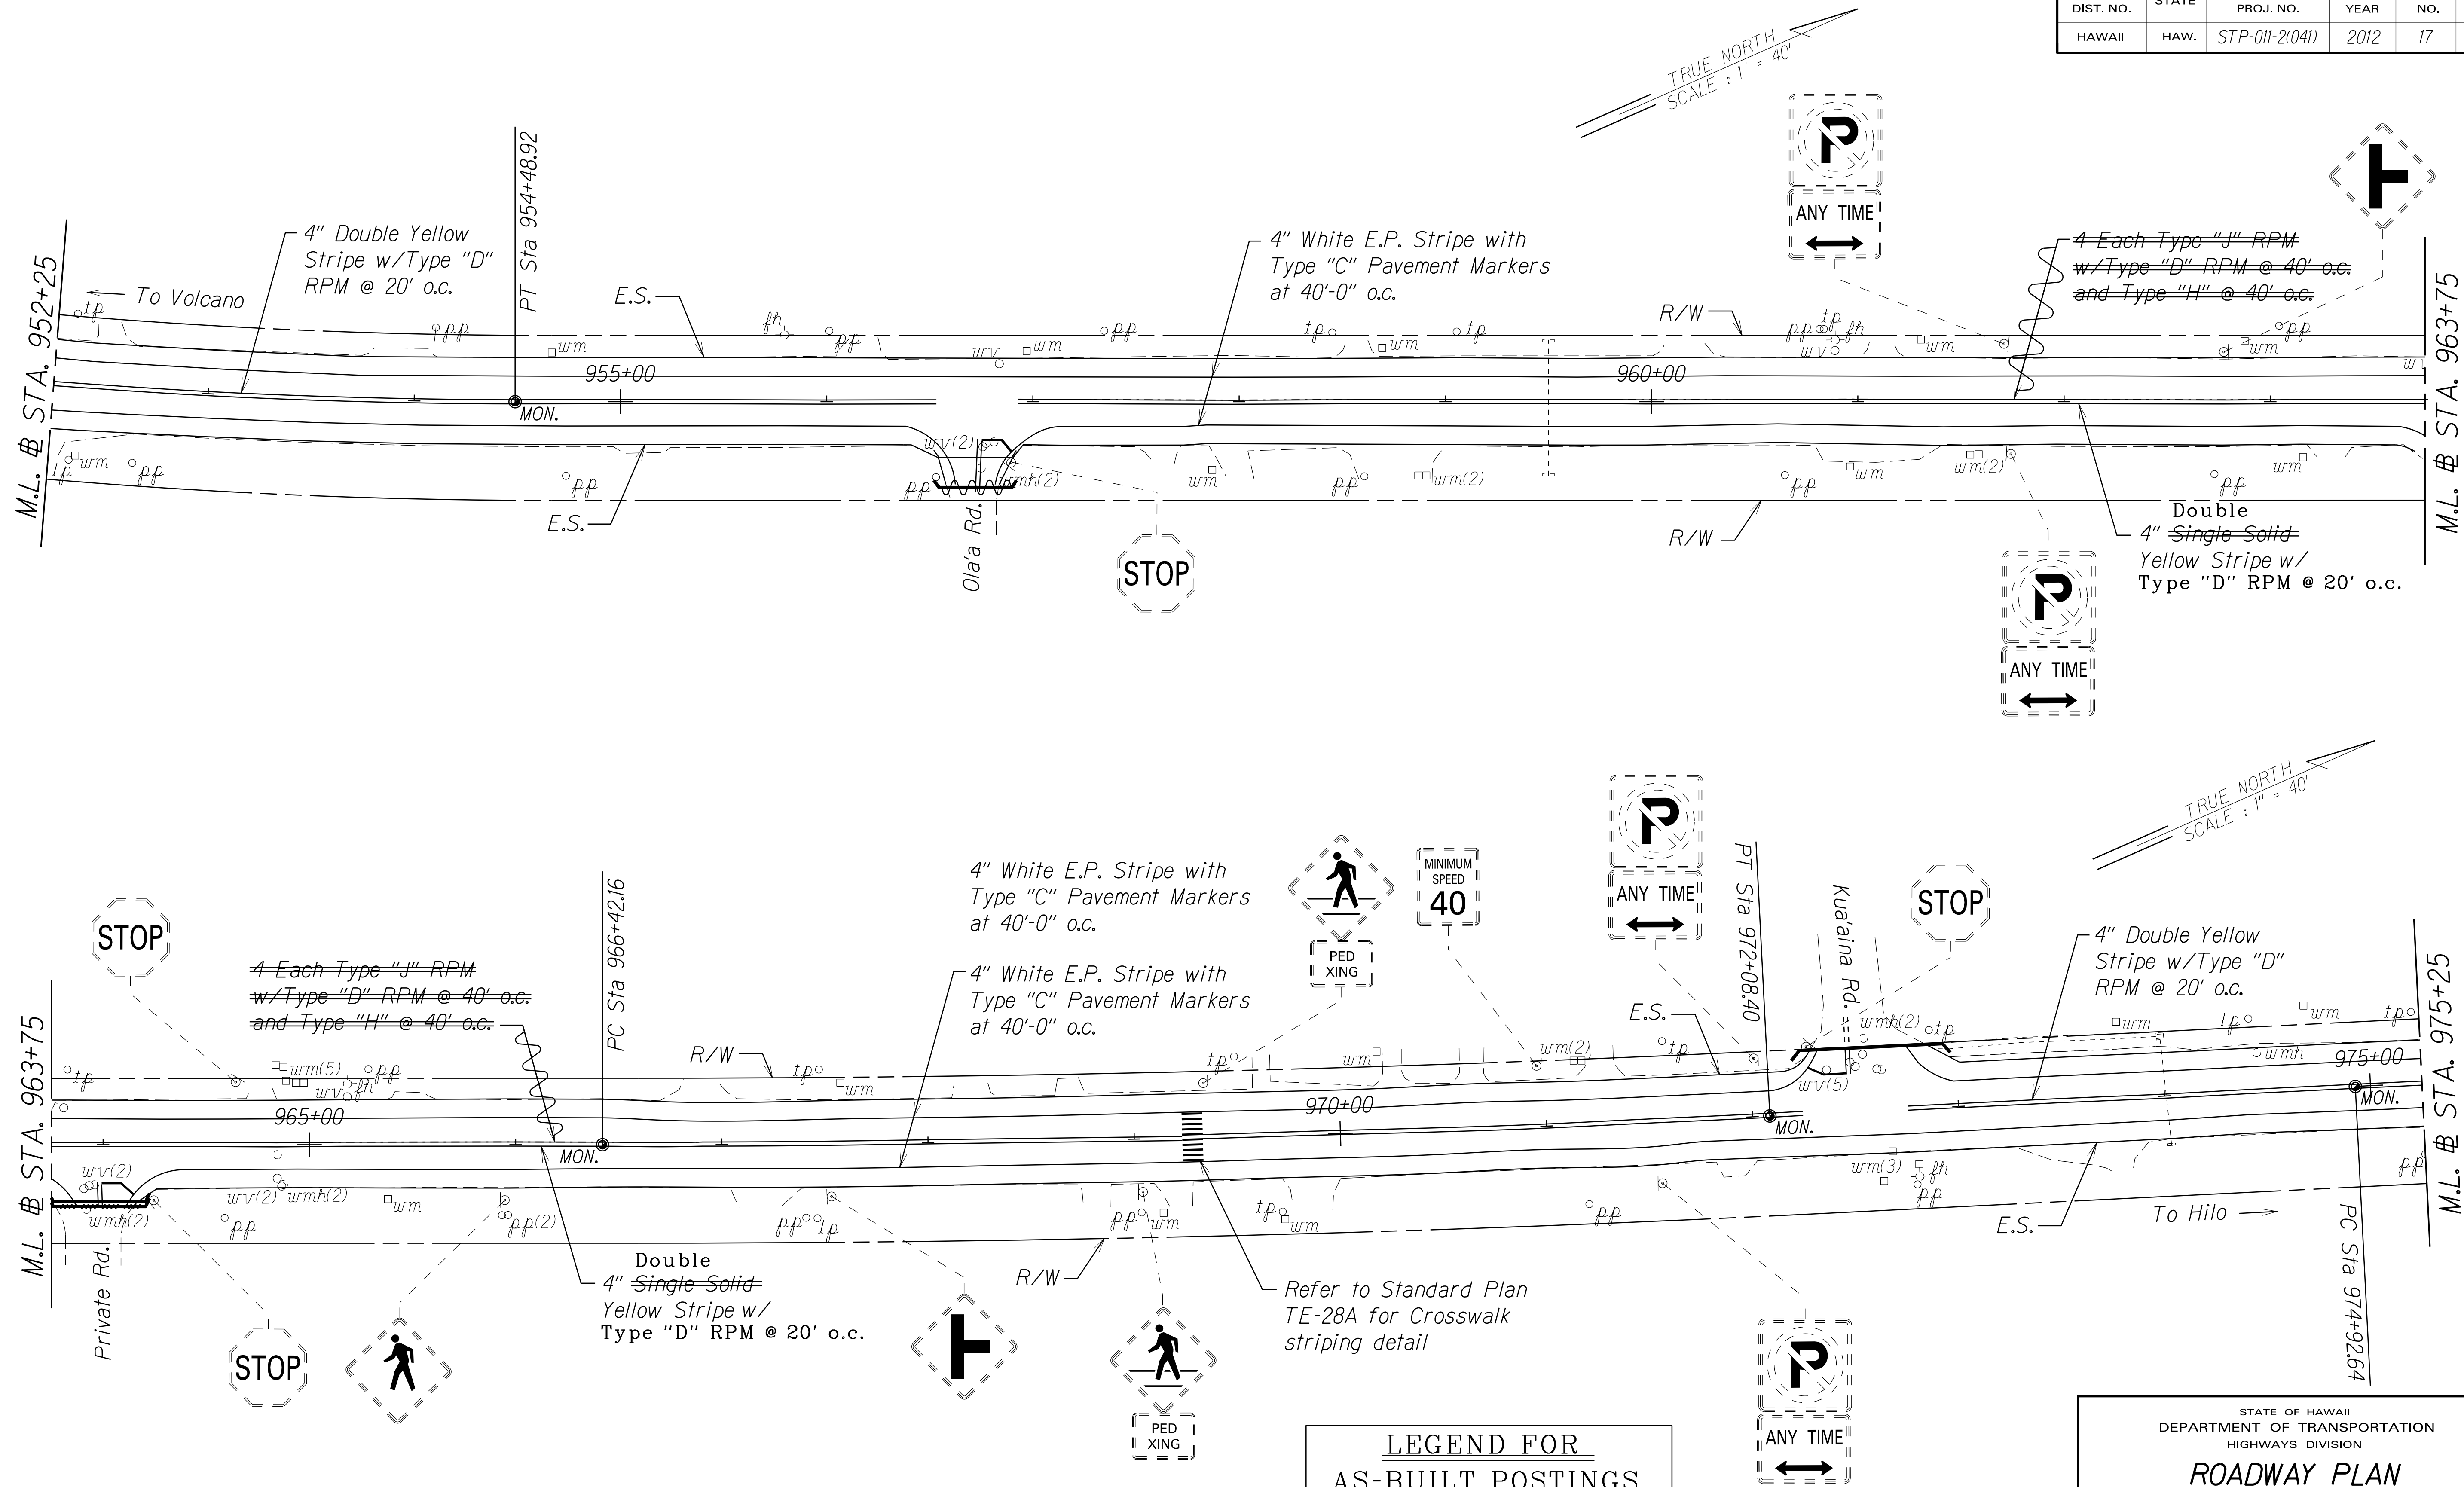

- Notes:
1. All existing signs (dashed) with post are to remain.
 2. All existing signs in conflict with construction signs are to be covered.
 3. This work shall be considered incidental to various contract items.

LEGEND FOR AS-BUILT POSTINGS	
	Squiggly line for as-built deletion
	Double line for as-built deletion
Roadway	Text for as-built posting

STATE OF HAWAII
DEPARTMENT OF TRANSPORTATION
HIGHWAYS DIVISION

ROADWAY PLAN

VOLCANO ROAD

*Pavement Preventive Maintenance
Mountain View to Kea'au*

Federal Aid Project No. STP-011-2(041)

Scale: 1"=40' Date: March, 2012

SHEET No. 10 OF 12 SHEETS

"AS-BUILT"

