

INDEX TO DRAWINGS	
SHEET NO.	DESCRIPTION
1	TITLE SHEET
2	STANDARD PLANS SUMMARY
3	GENERAL NOTES AND LEGEND
4-5	WATER POLLUTION AND EROSION CONTROL NOTES
6	TYPICAL SECTION AND DETAILS
7	TYPICAL SUPERELEVATION SECTION
8-19	ROADWAY PLANS
20	PAVEMENT MARKING LEGEND AND NOTES
21-22	STRIPING AND PAVEMENT MARKING SCHEDULE
23	CENTERLINE MONUMENT SCHEDULE
24	HIGH SPEED UNDIVIDED HIGHWAYS WORK ZONE SIGNING PLAN, NOTES AND DETAILS

STATE OF HAWAII

DEPARTMENT OF TRANSPORTATION

HIGHWAYS DIVISION

HONOLULU, HAWAII

"AS-BUILT"

PLANS FOR

VOLCANO ROAD

PAVEMENT PREVENTIVE MAINTENANCE




MOUNTAIN VIEW TO KEA'AU

FEDERAL AID PROJECT NO. STP-011-2(041)

DISTRICT OF PUNA

ISLAND OF HAWAII

DIST. NO.	STATE	FED. AID PROJ. NO.	FISCAL YEAR	SHEET NO.	TOTAL SHEETS
HAWAII	HAW.	STP-011-2(041)	2012	1	24

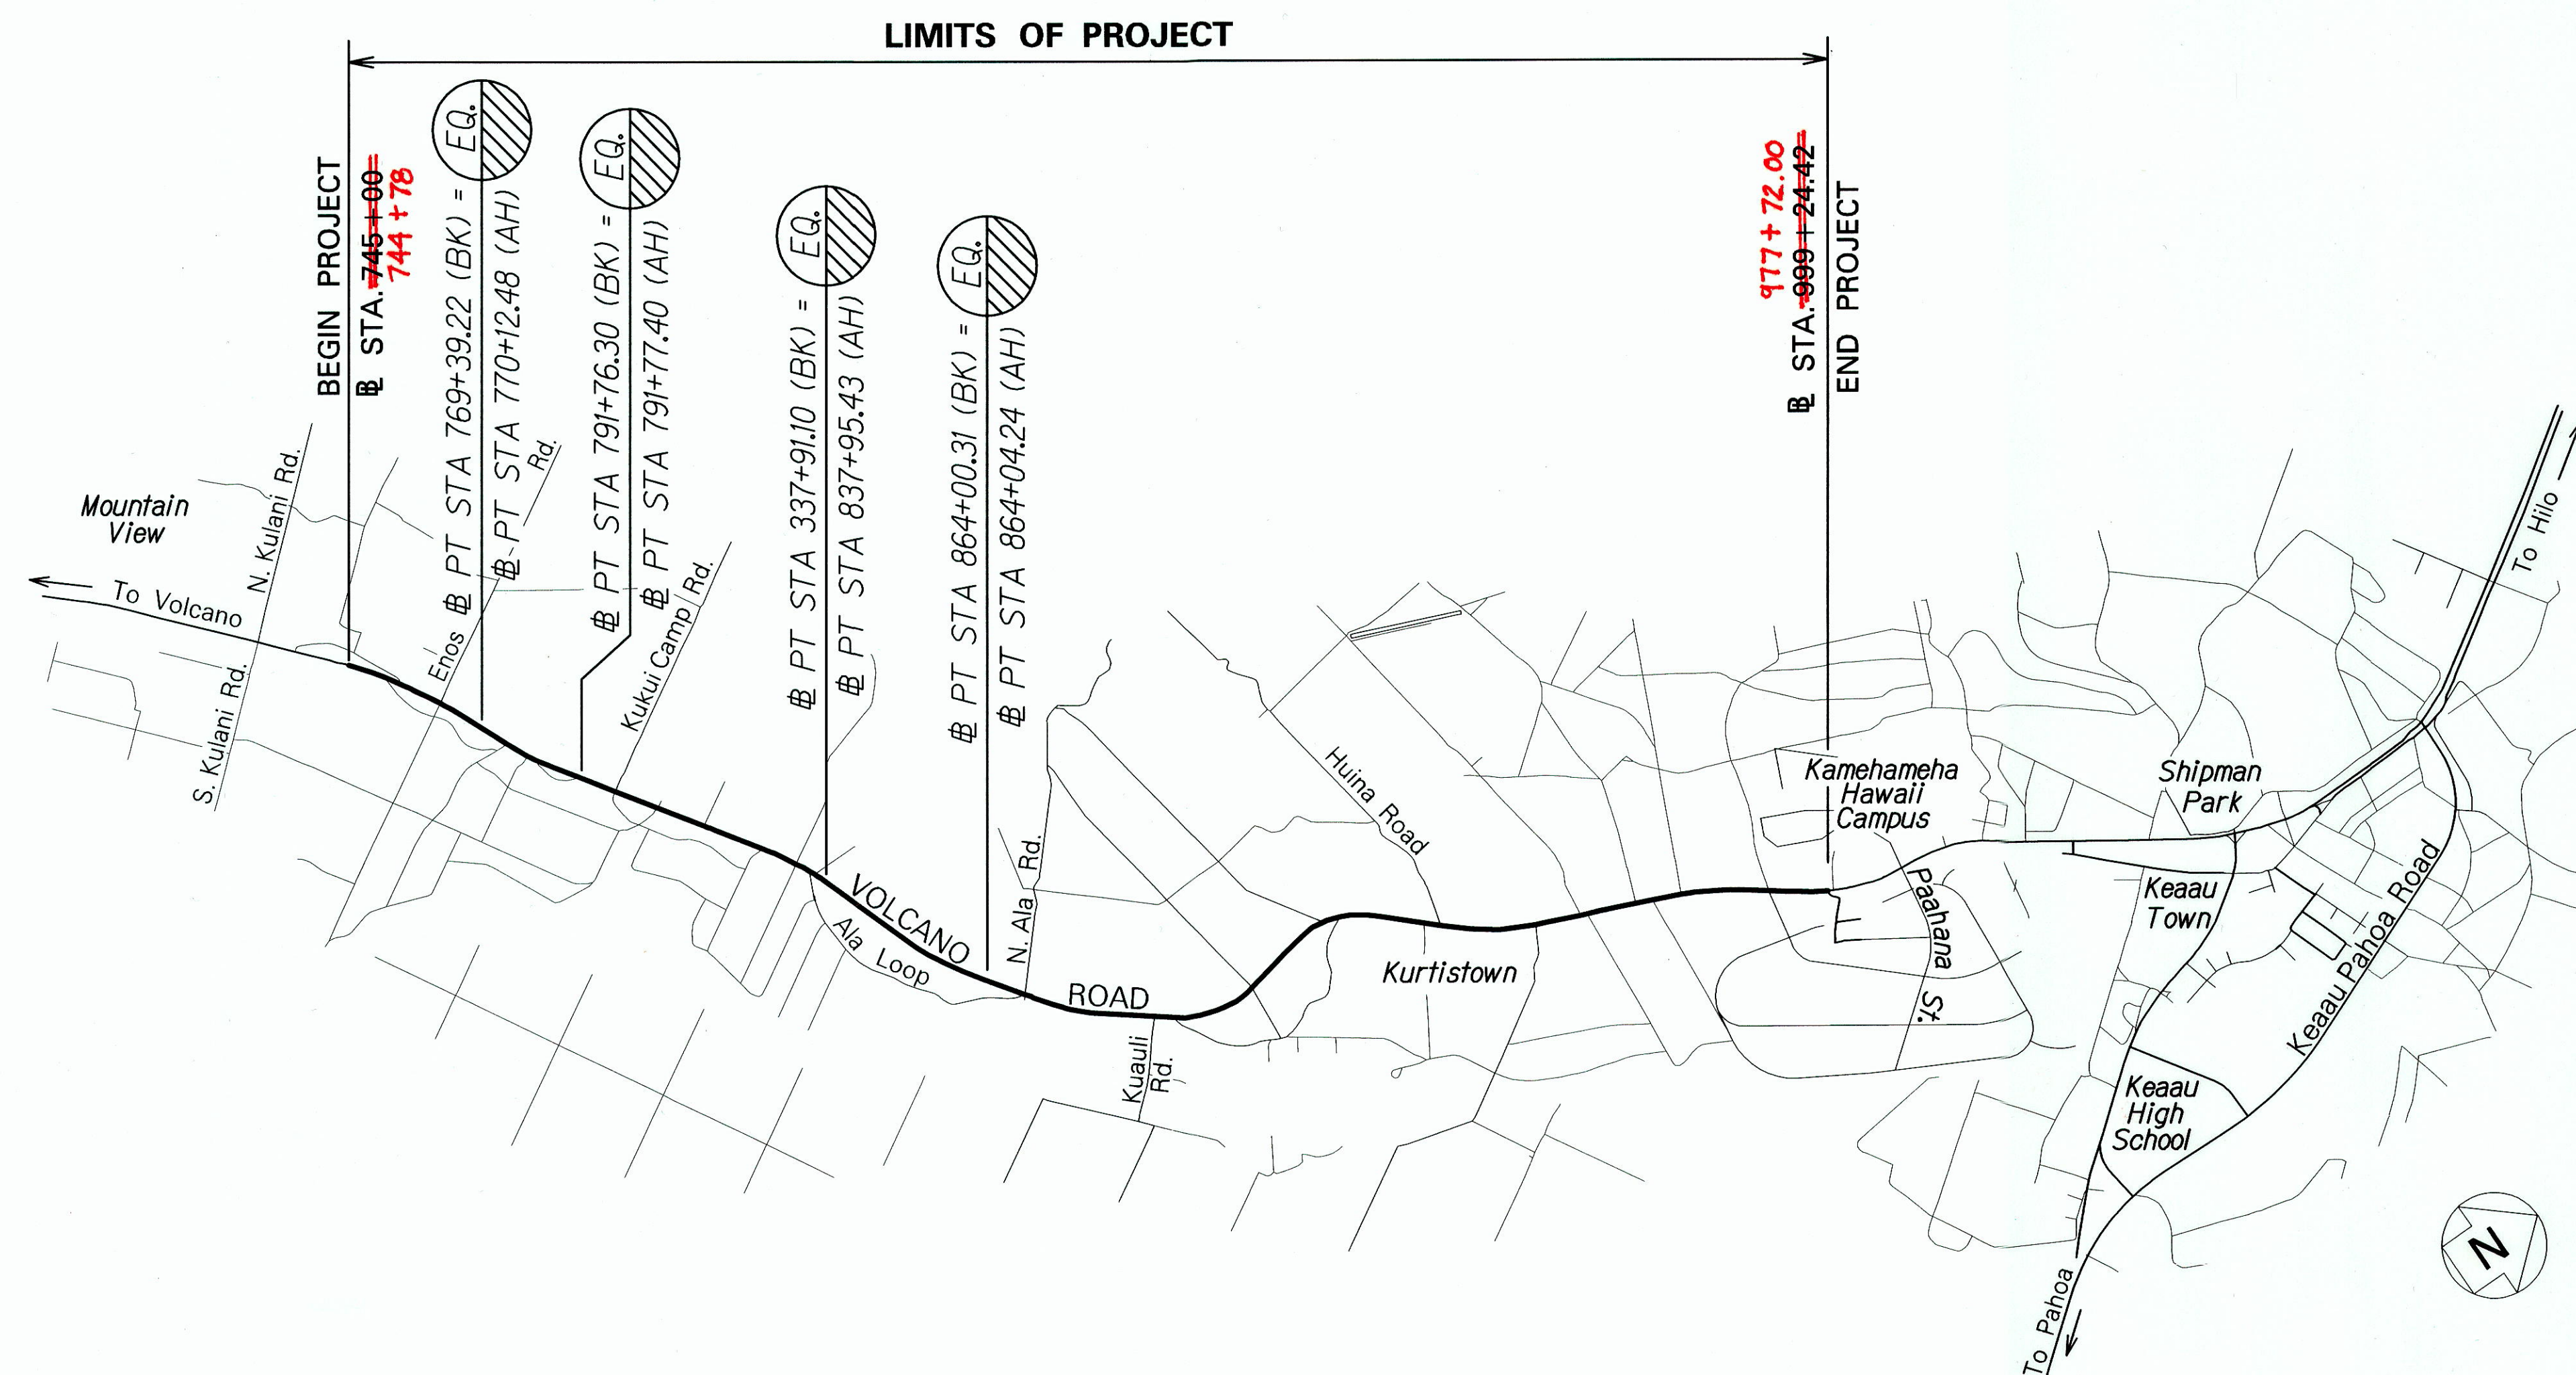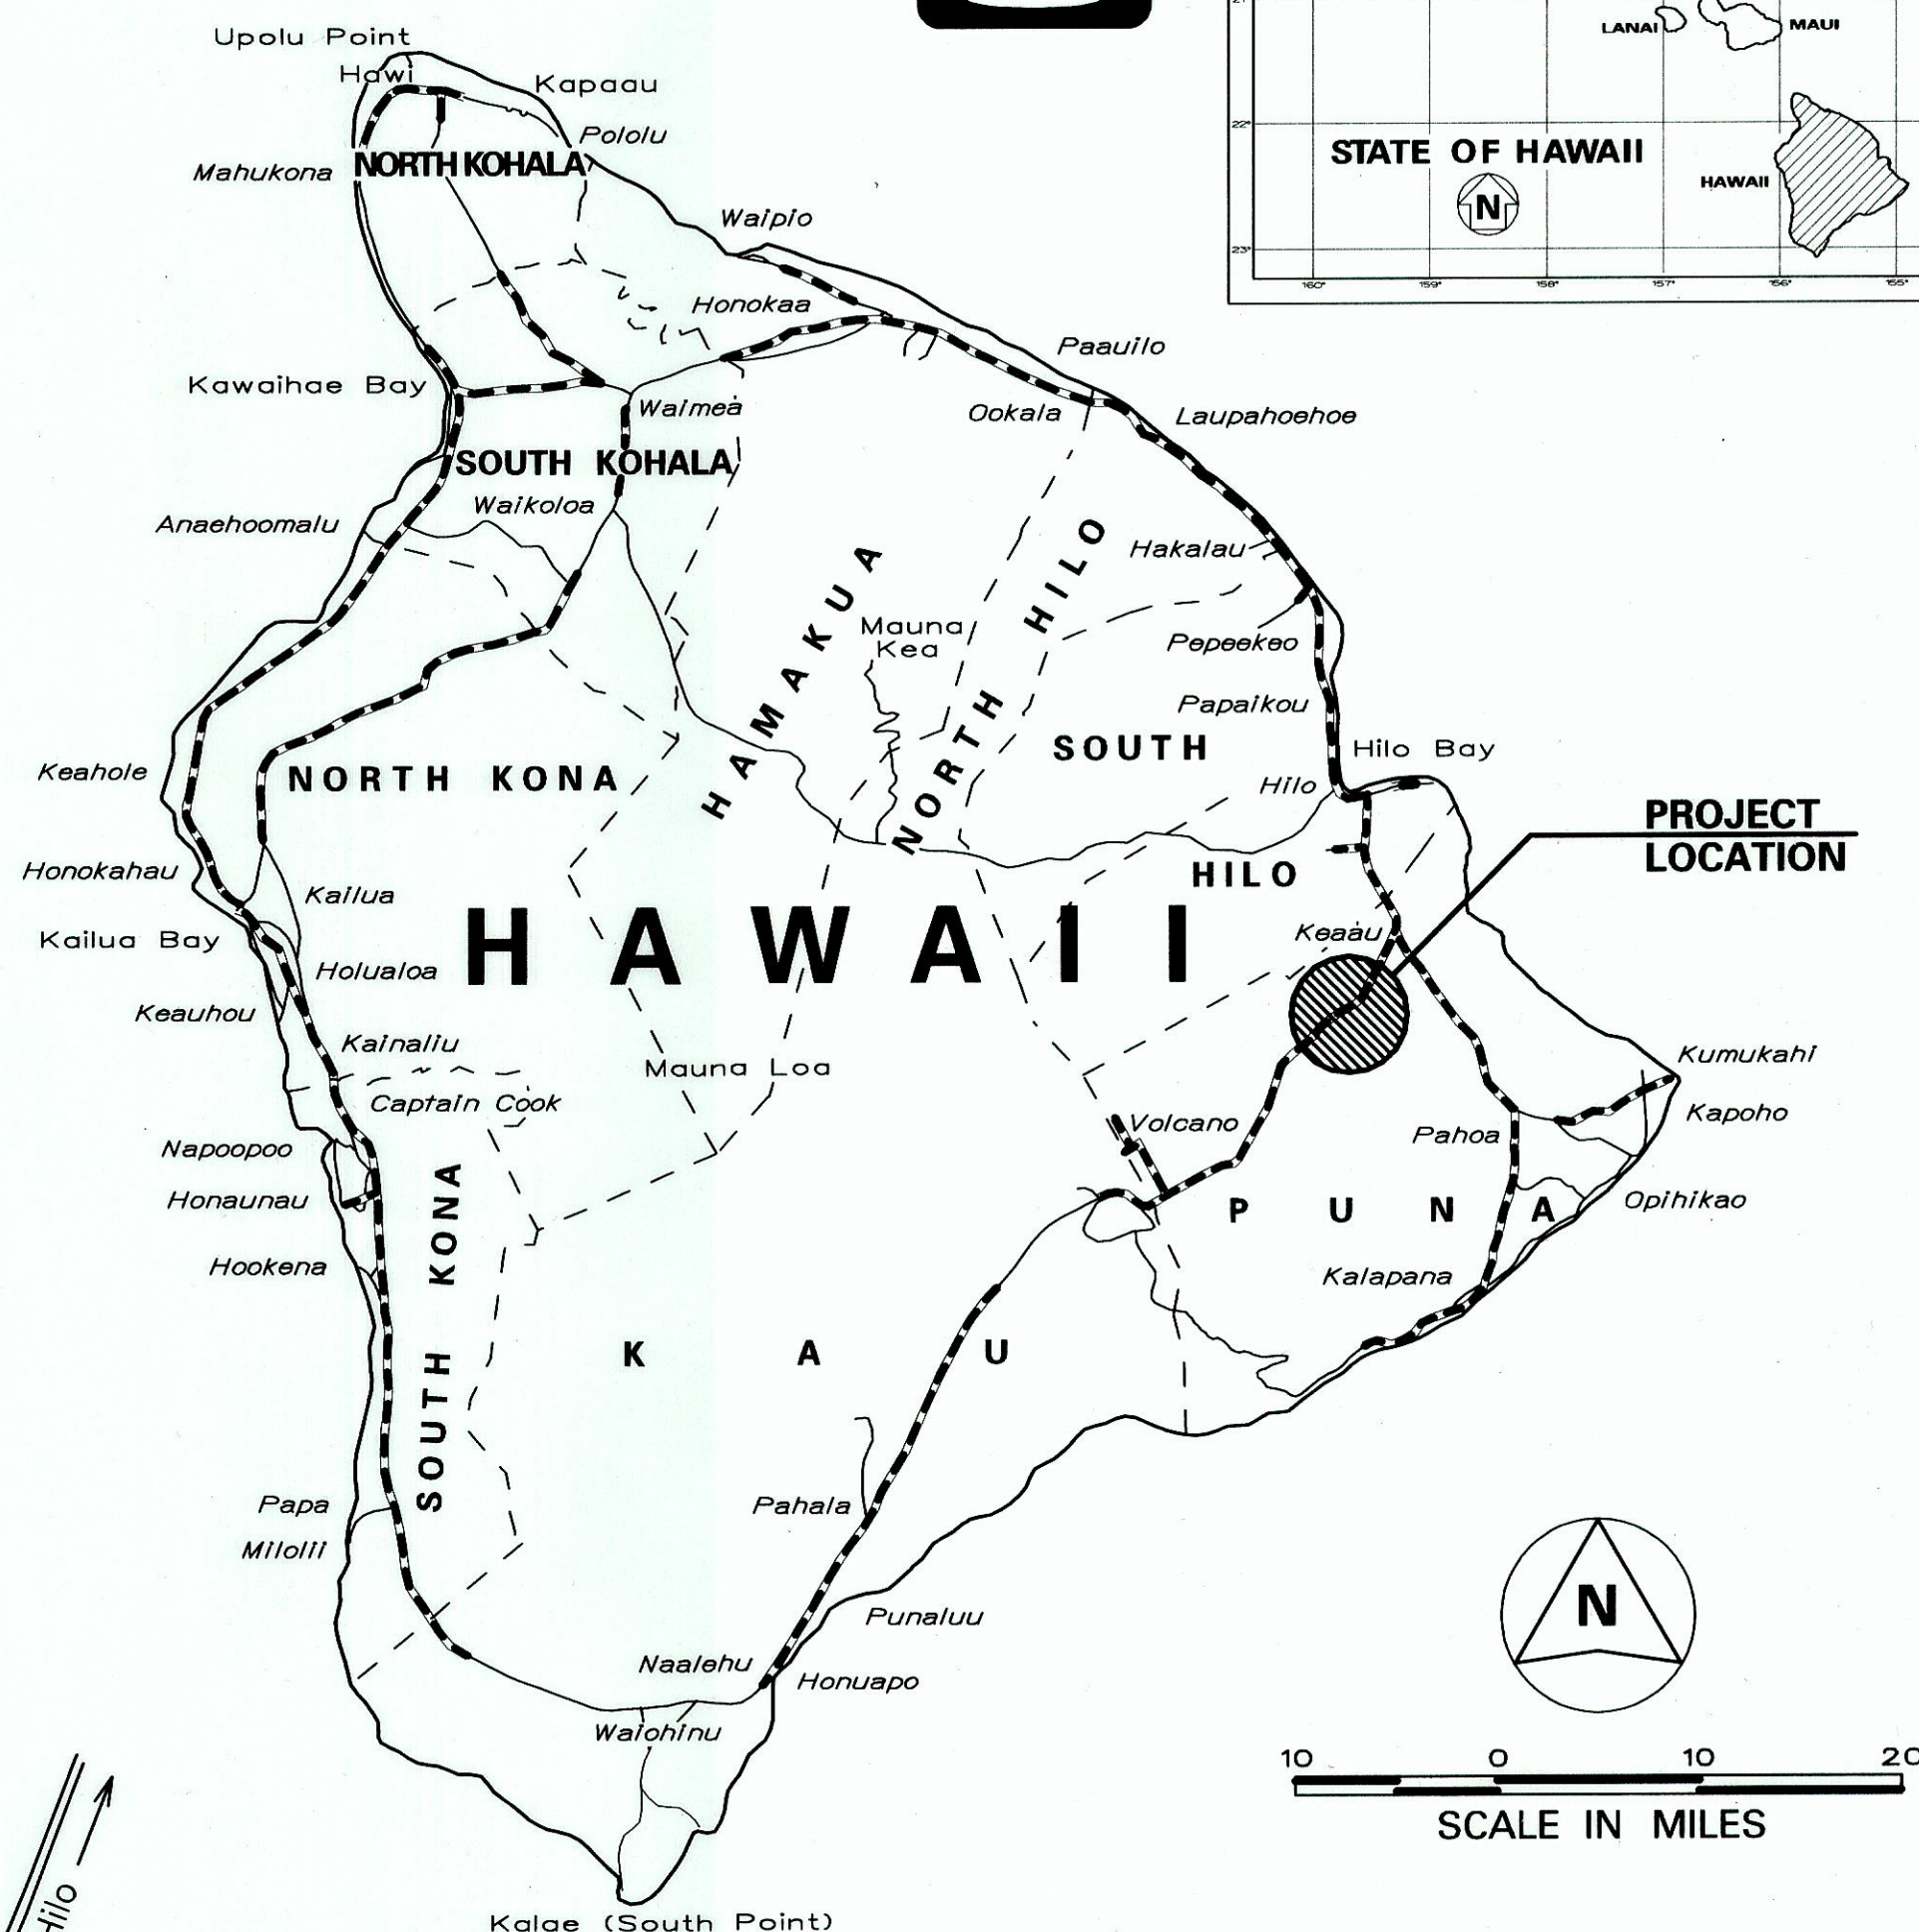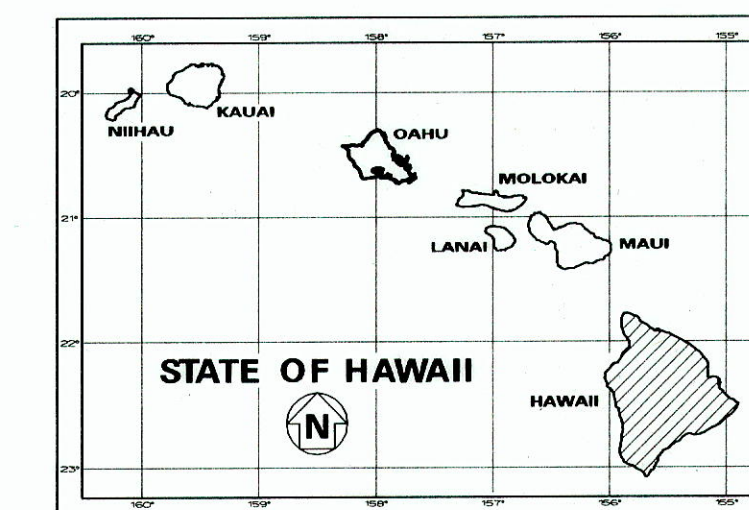

933-8866

MARCH, 2012

DATE

933-8866

PHONE

933-8866


MANAGED BY

933-8866

DESIGNED BY

933-8866

HAWAII DISTRICT

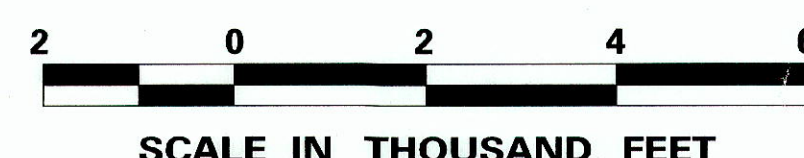

LAYOUT PLAN

LENGTH OF PROJECT.....~~4.80~~ MILES

4.40

CHANGES MADE DURING CONSTRUCTION HAVE BEEN INCORPORATED ON THESE PLANS EXCEPT CHANGES IN THE ORIGINAL THEORETICAL QUANTITIES. FOR ACTUAL QUANTITIES, REFER TO PROJECT LEDGER AND/OR COMPUTATION BOOK.

4/12/12

8/12/12

DATE

DESIGN DESIGNATION

ADT (2012).....19,200

ADT (2022).....23,800

DHV.....2,260

D.....75/25

T.....4.5 %

V.....60 M.P.H.

DEPARTMENT OF TRANSPORTATION

STATE OF HAWAII

APPROVED:

APR 12 2012

5/08/12

for DIR. OF TRANSPORTATION

DATE