




DIST. NO.	STATE	FED. AID PROJ. NO.	FISCAL YEAR	SHEET NO.	TOTAL SHEETS
HAWAII	HAW.	STP-011-2(041)	2012	6	24

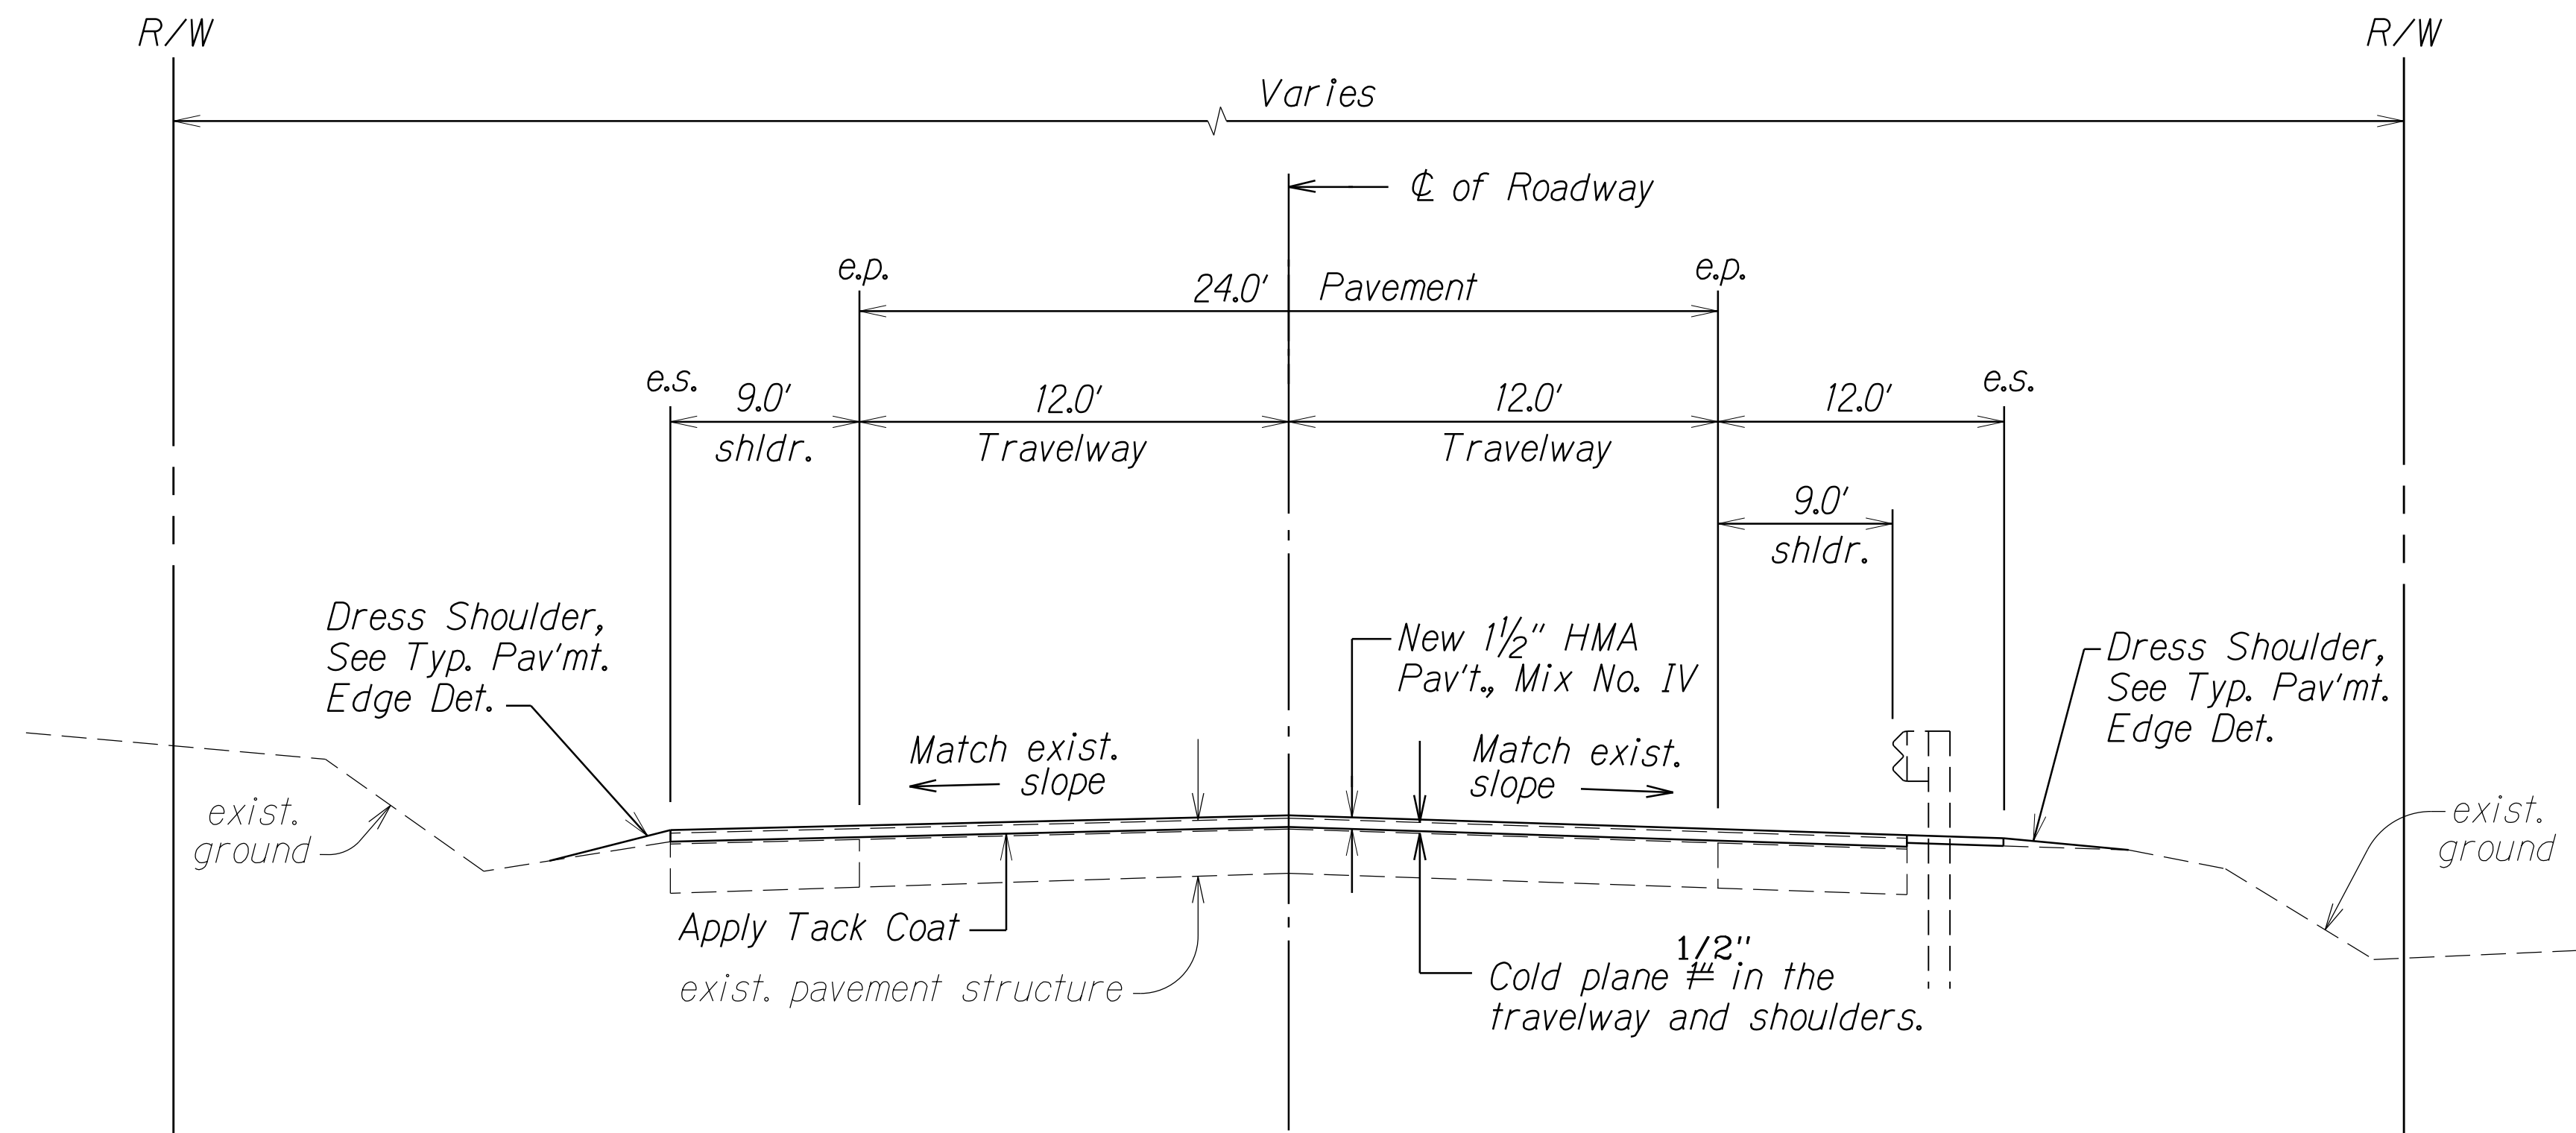


TYPICAL SECTION
Not To Scale

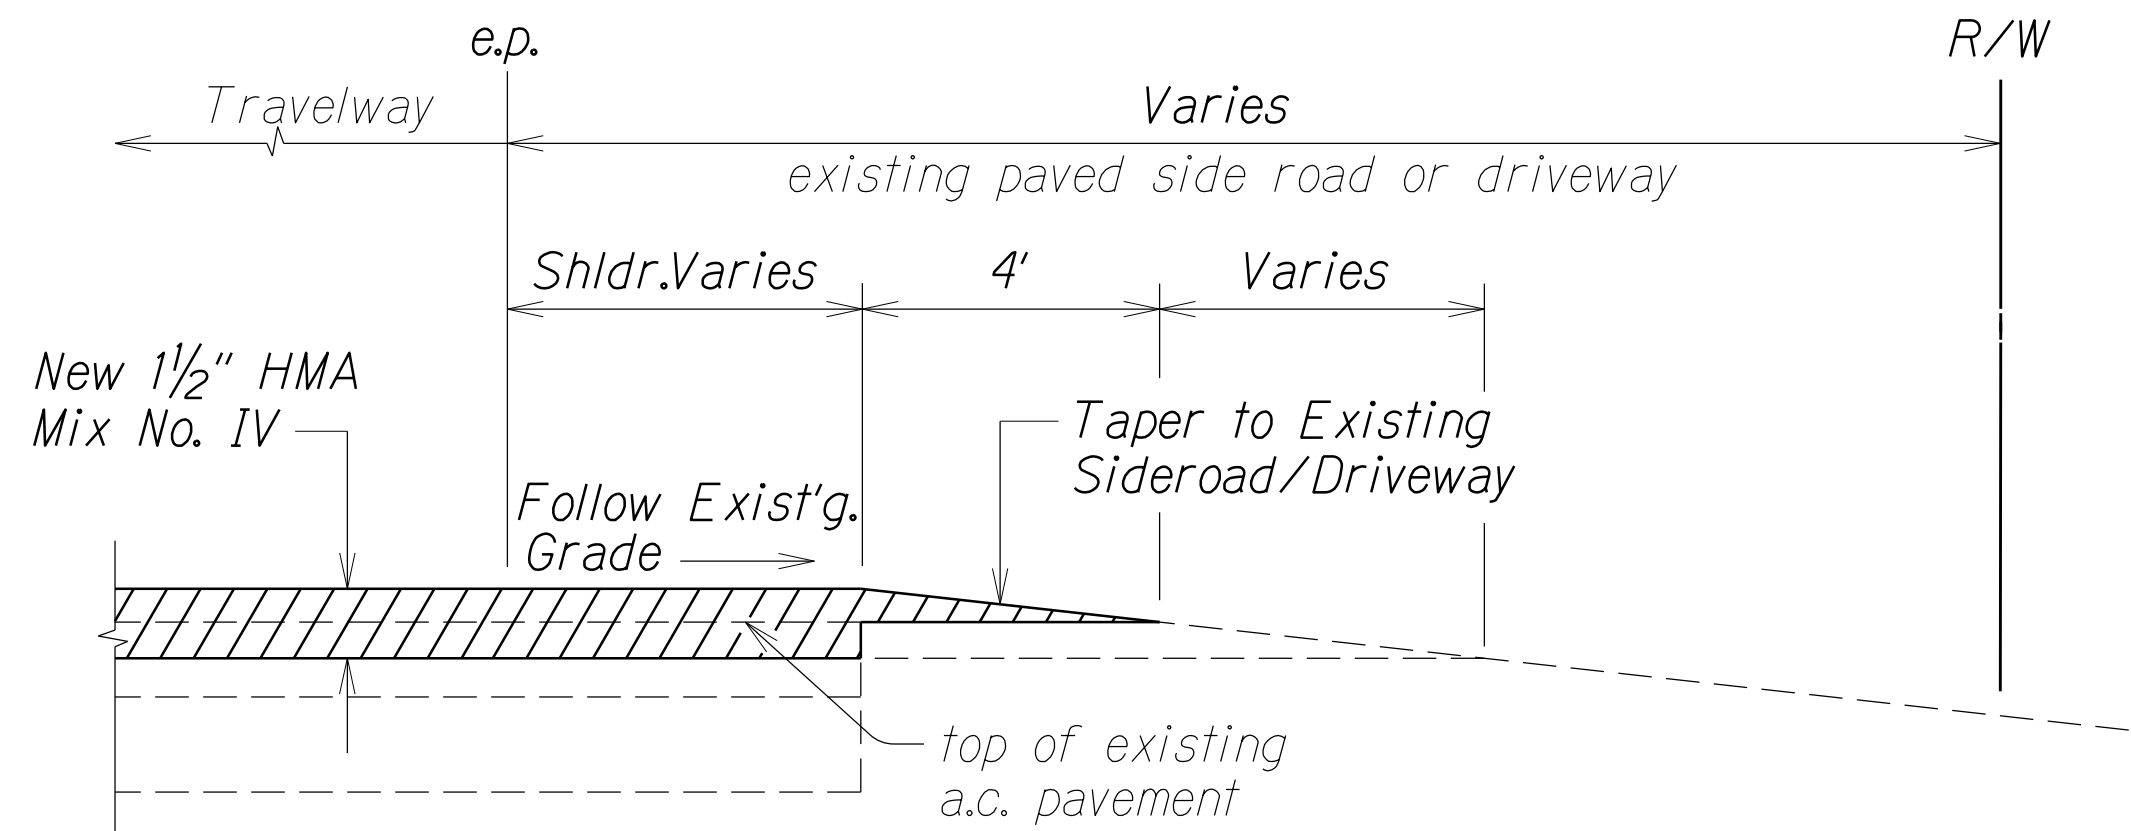

TYPICAL SECTION AT SIDEROADS
AND DRIVEWAY CONNECTION
Not To Scale

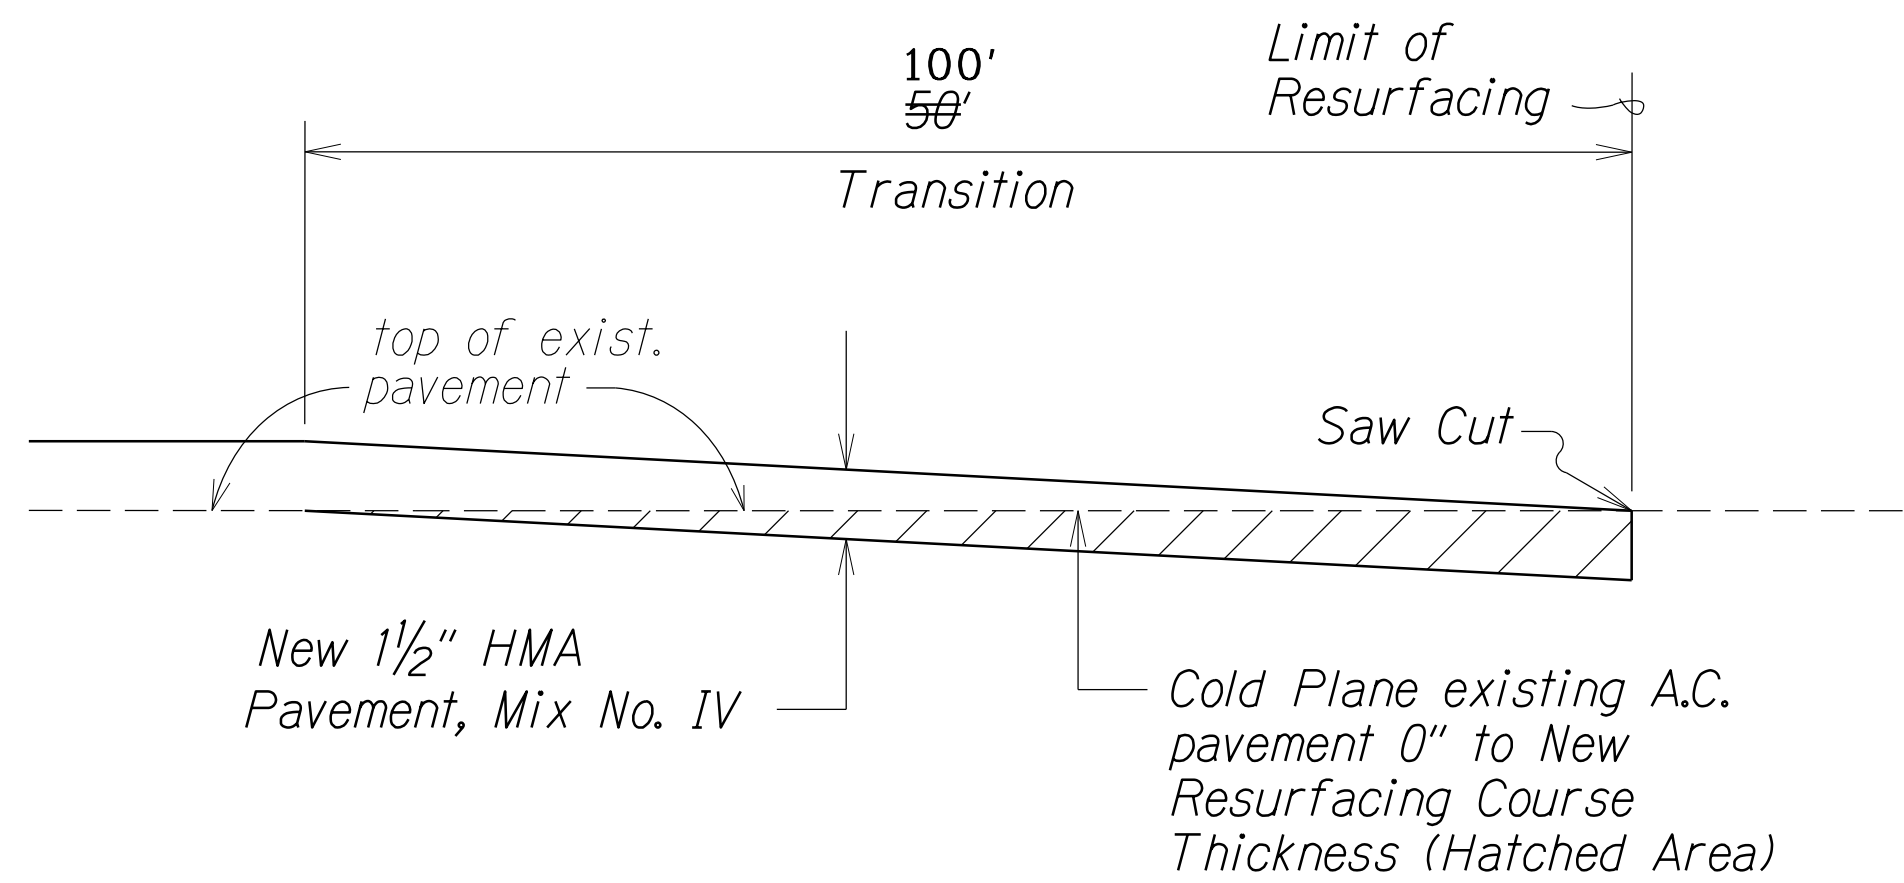

COLD PLANED TRANSITION
AT BEGINNING AND END OF PROJECT
Not To Scale

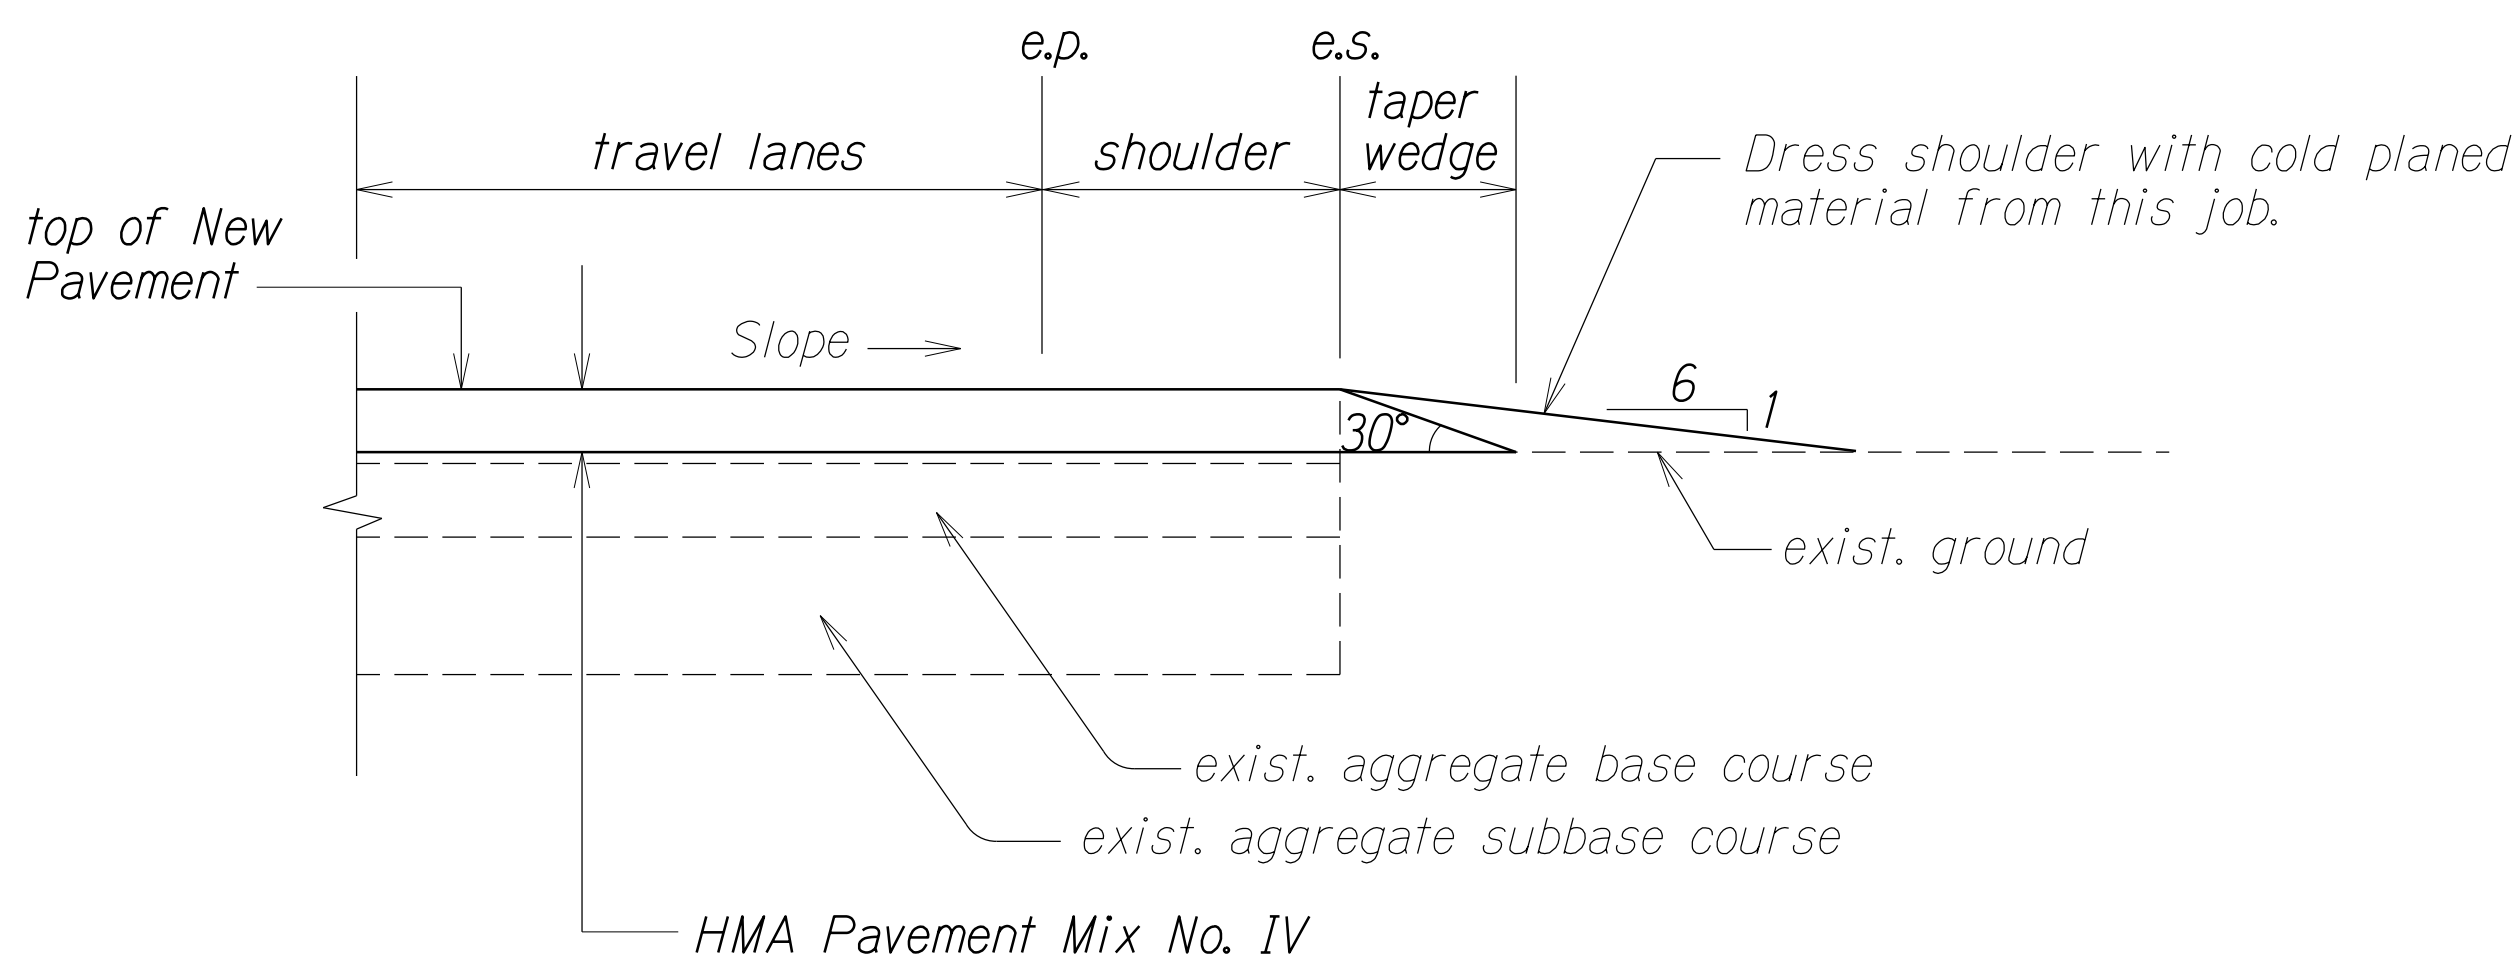

TYPICAL PAVEMENT EDGE DETAIL
Not To Scale

Note: Contractor shall mount a device directly on the paver screed extension to provide a 30° beveled shoulder edge.

ORIGINAL PLAN	SURVEY PLOTTED BY	DATE
NOTE BOOK	DRAWN BY	
DESIGNED BY	TRACED BY	
CHECKED BY	DESIGNED BY	
NOTED BY	CHECKED BY	

LEGEND FOR AS-BUILT POSTINGS	
	Squiggly line for as-built deletion
	Double line for as-built deletion
Roadway	Text for as-built posting

STATE OF HAWAII DEPARTMENT OF TRANSPORTATION HIGHWAYS DIVISION
<u>TYPICAL SECTION AND DETAILS</u>
<u>VOLCANO ROAD</u>
<u>Pavement Preventive Maintenance</u>
<u>Mountain View to Kea'au</u>
<u>Federal Aid Project No. STP-011-2(041)</u>
Scale: N.T.S. Date: March, 2012
SHEET No. 1 OF 2 SHEETS