


DIST. NO.	STATE	FED. AID PROJ. NO.	FISCAL YEAR	SHEET NO.	TOTAL SHEETS
HAWAII	HAW.	STP-011-2(041)	2012	7	24

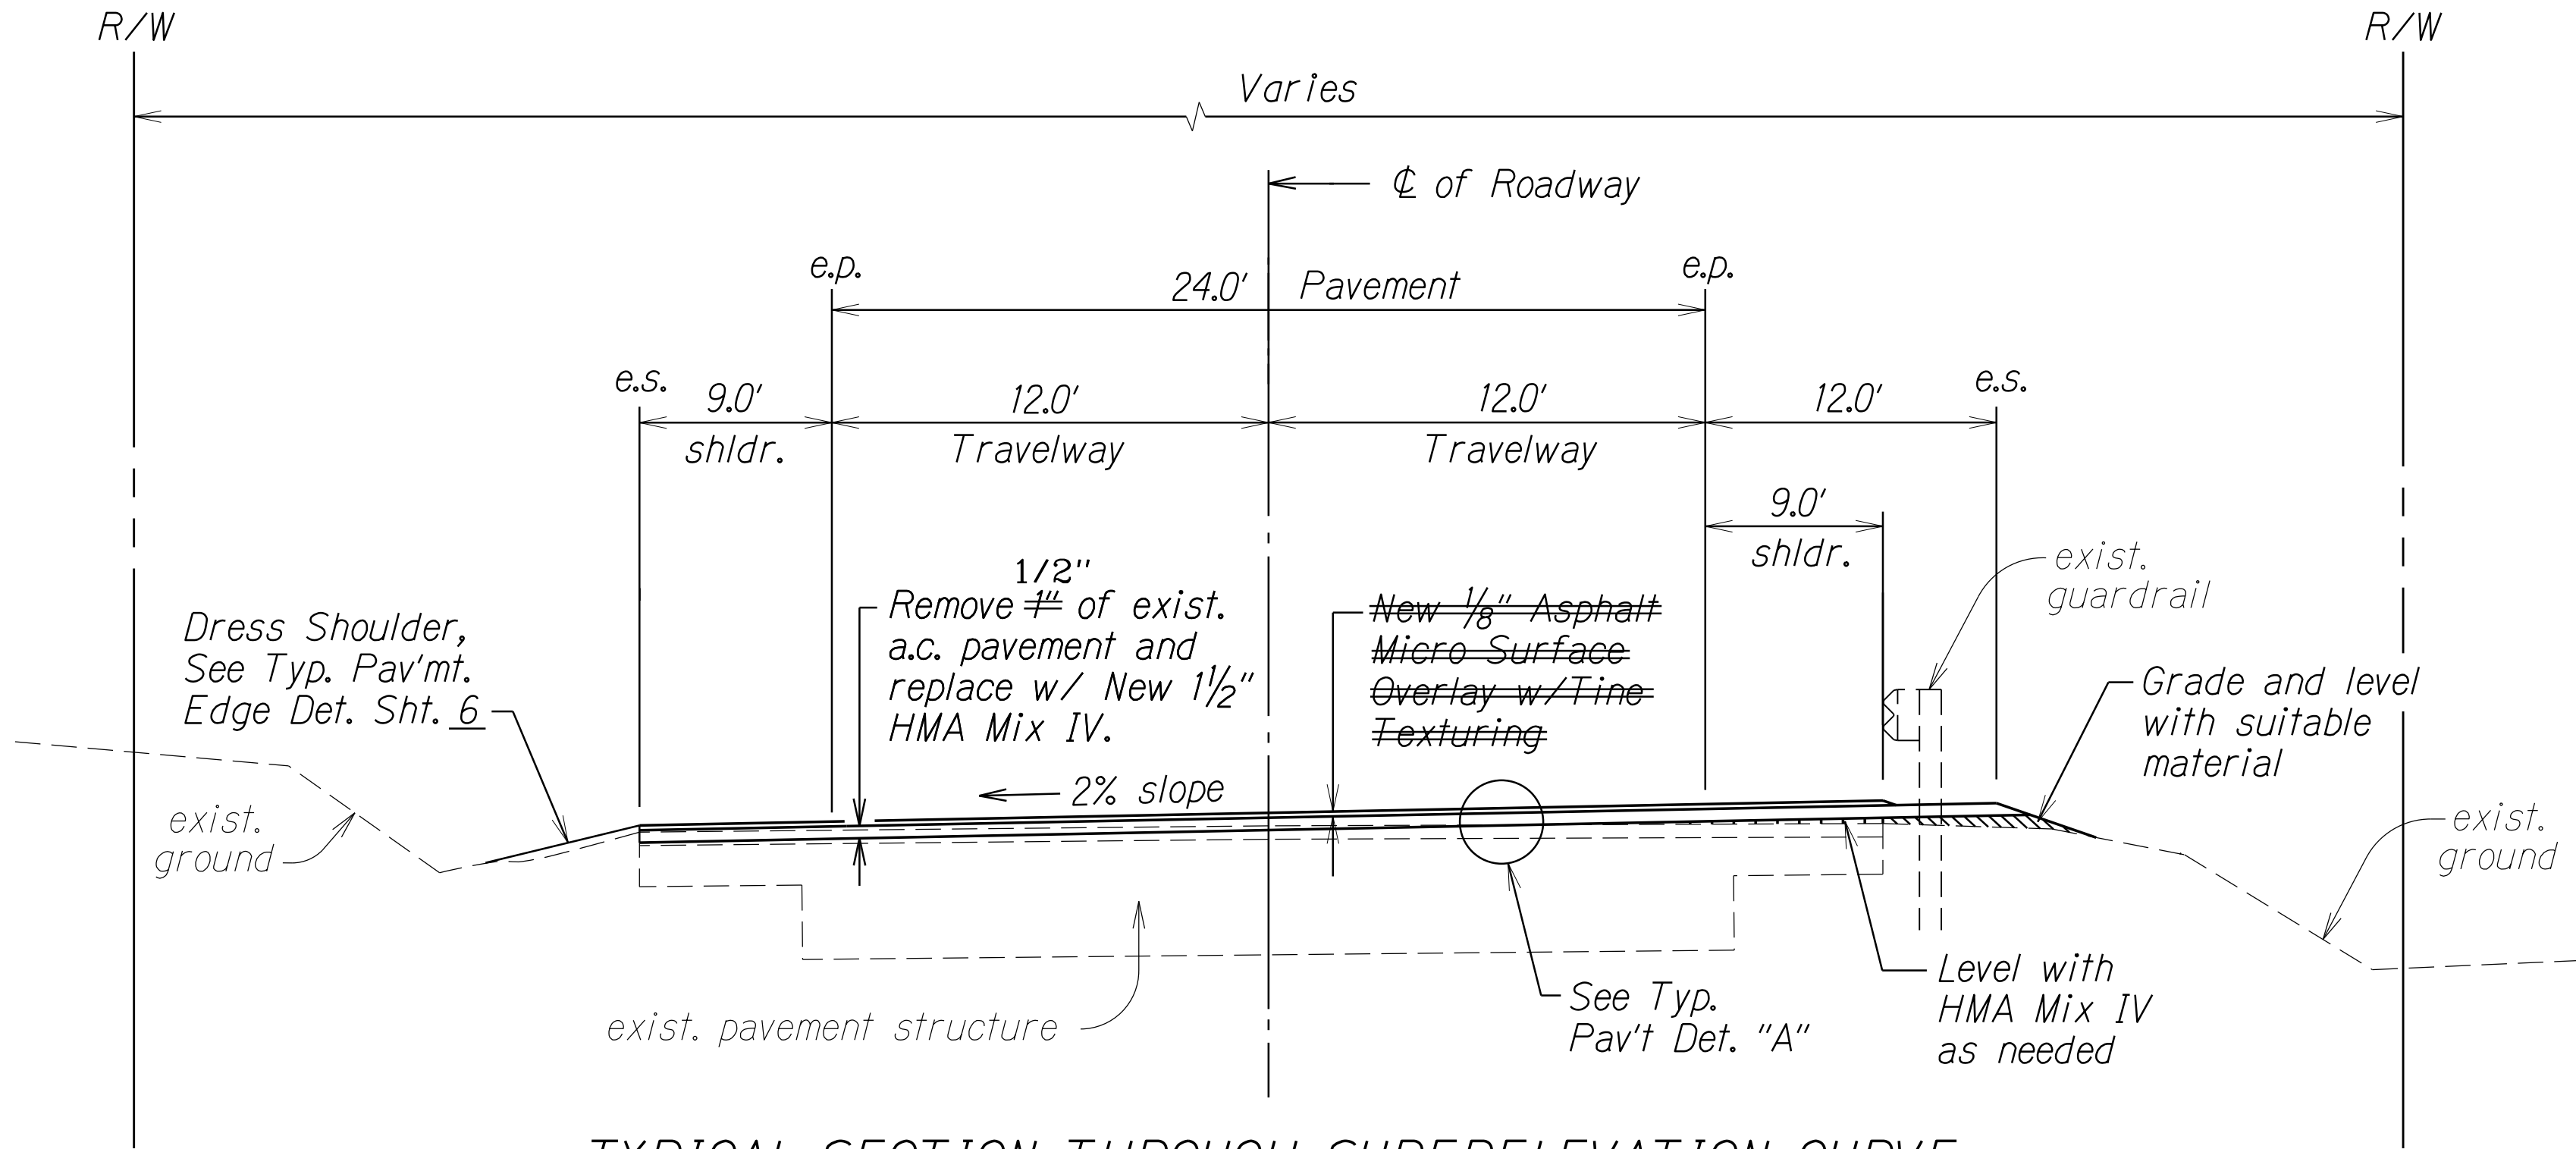


TYPICAL SECTION THROUGH SUPERELEVATION CURVE

P.C. Sta. 781+42.22 to P.T. Sta. 791+76.30


P.C. Sta. 847+66.26 to P.T. Sta. 864+00.31

Not To Scale

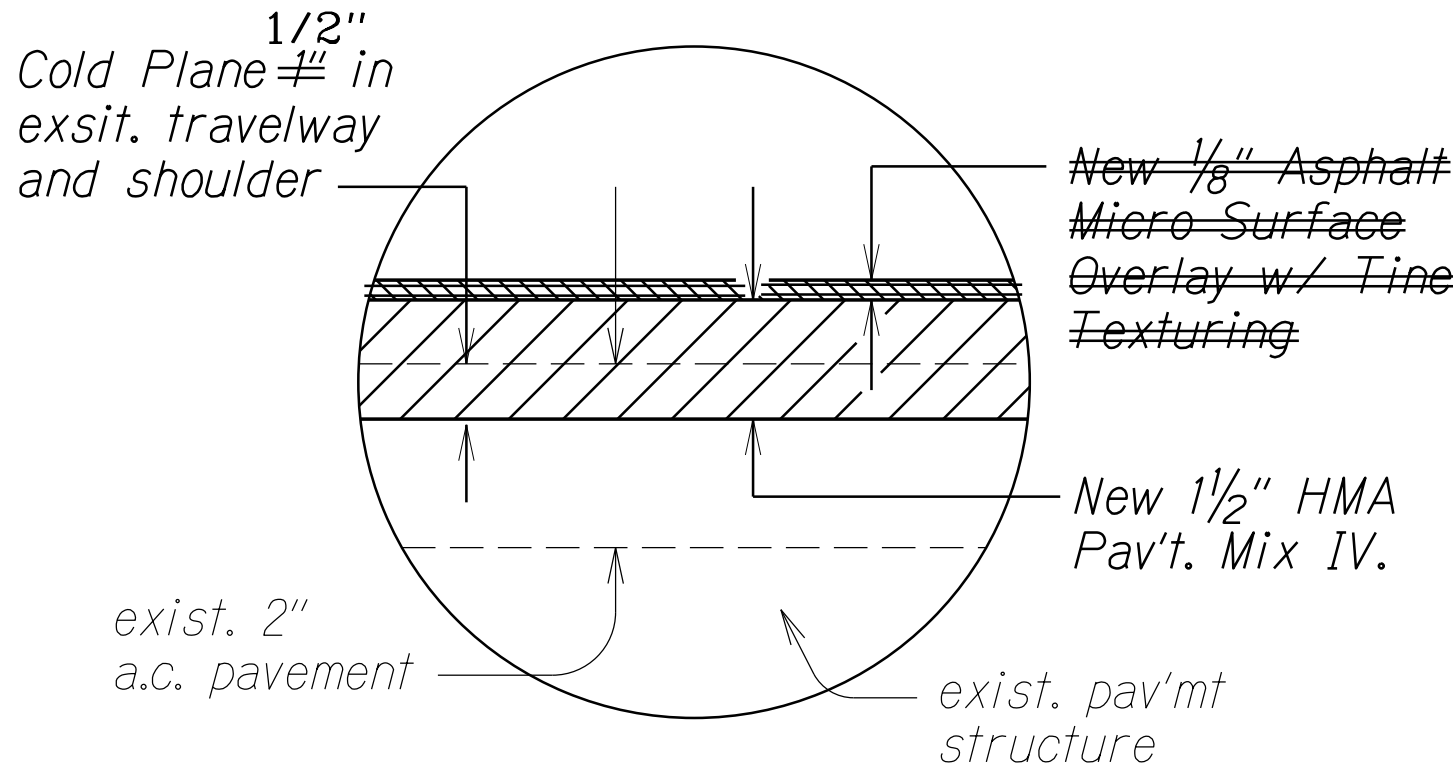

TYPICAL PAVEMENT DETAIL "A"


Not To Scale

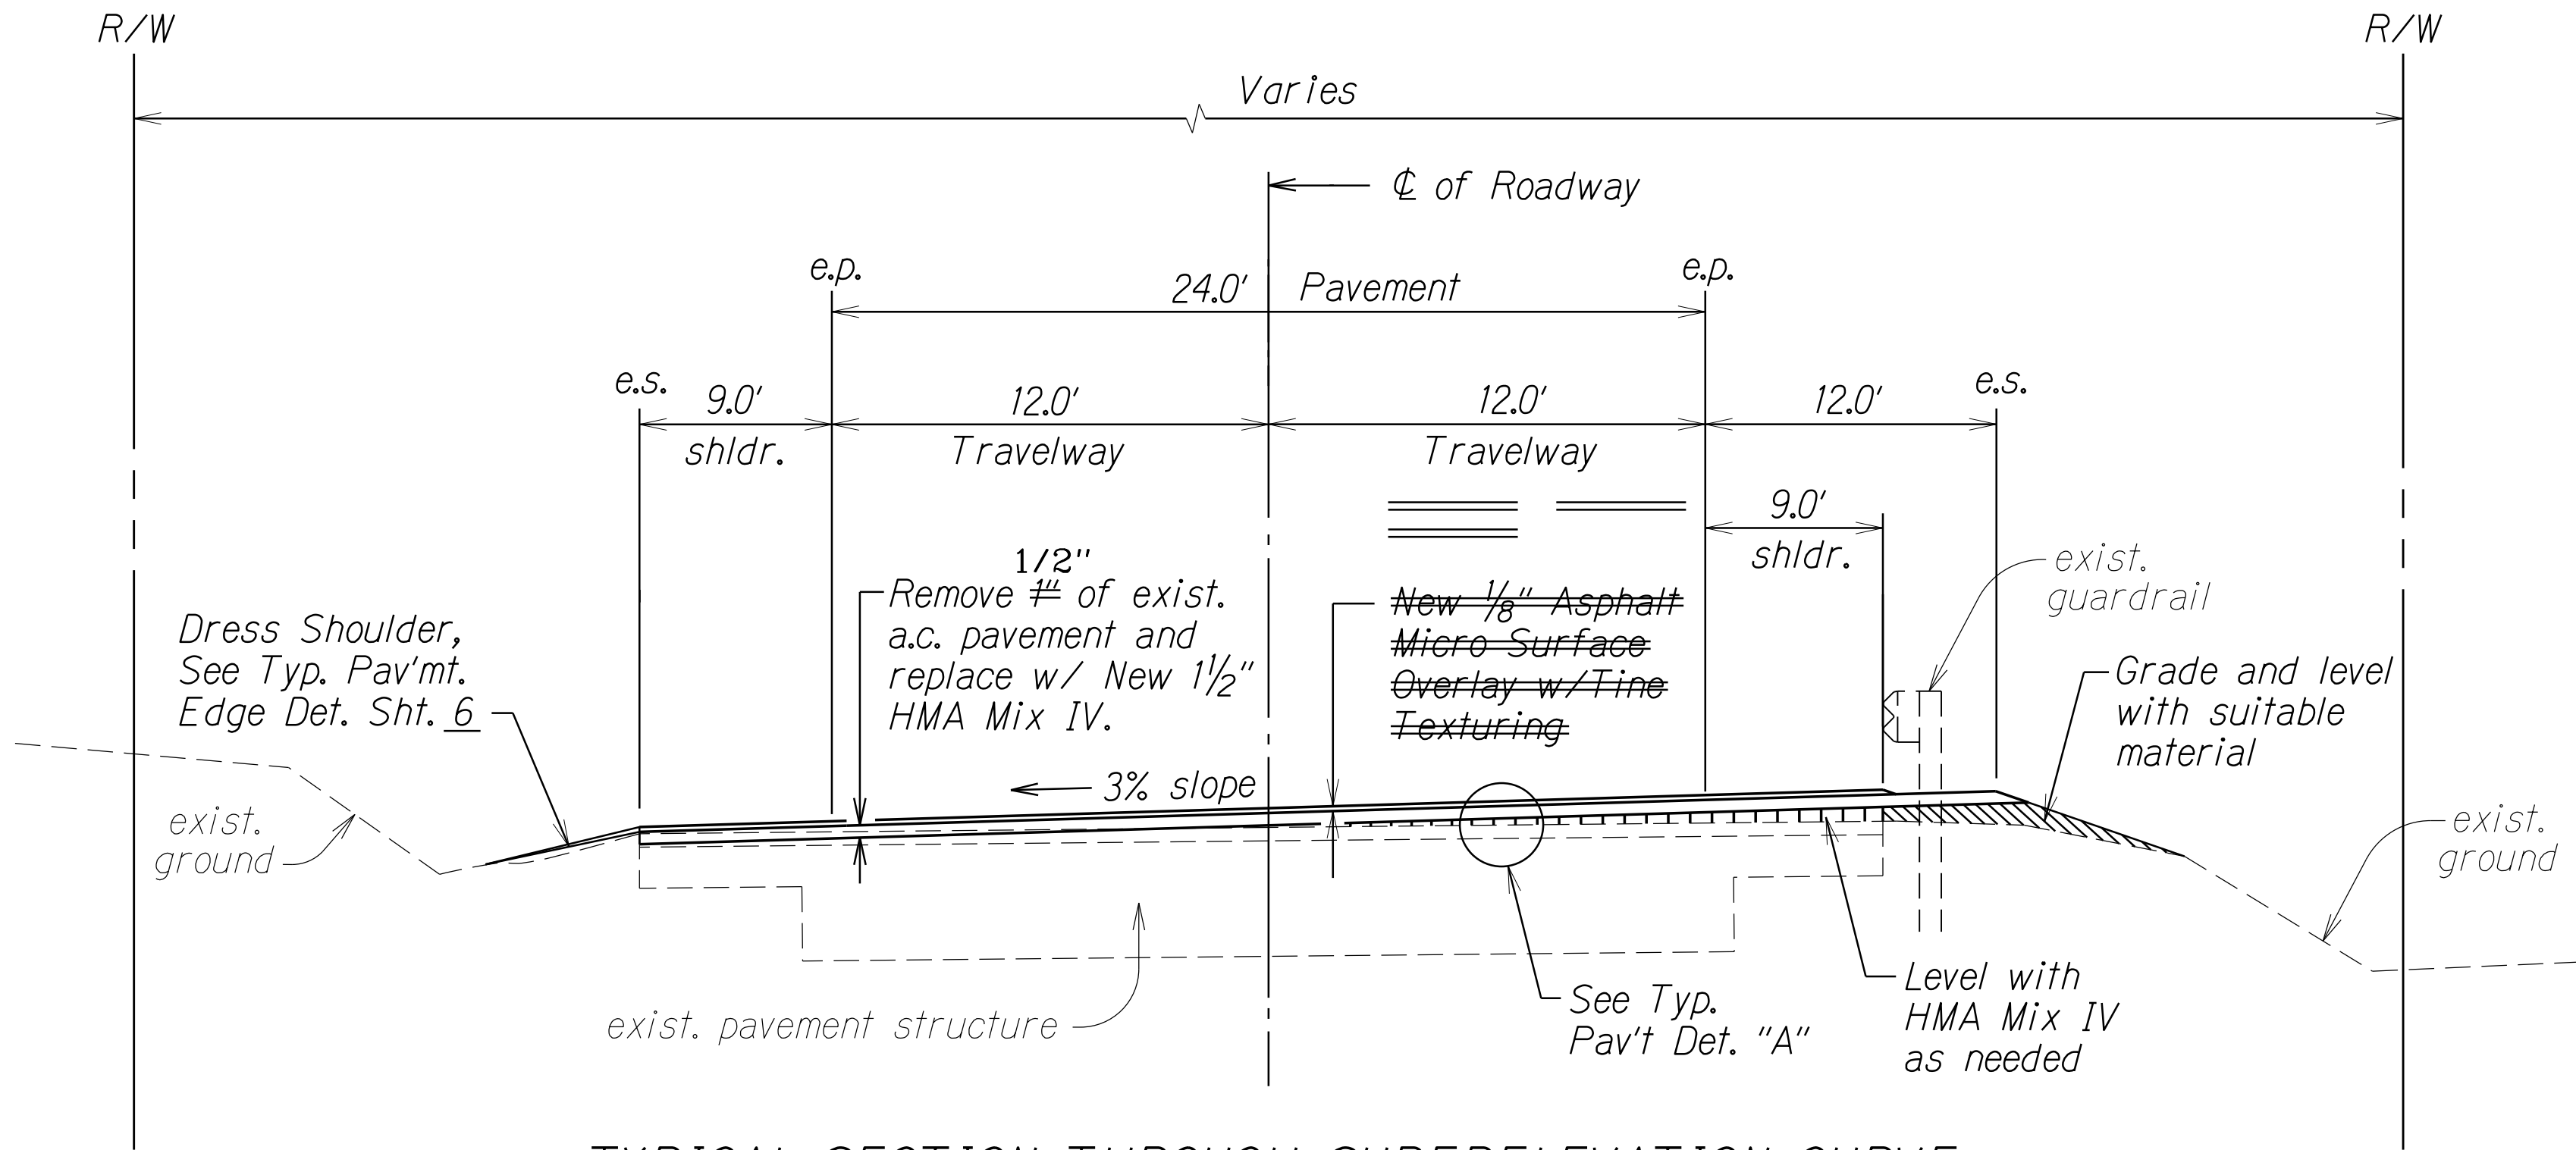

TYPICAL SECTION THROUGH SUPERELEVATION CURVE

P.C. Sta. 875+05.60 to P.T. Sta. 883+24.73

Not To Scale

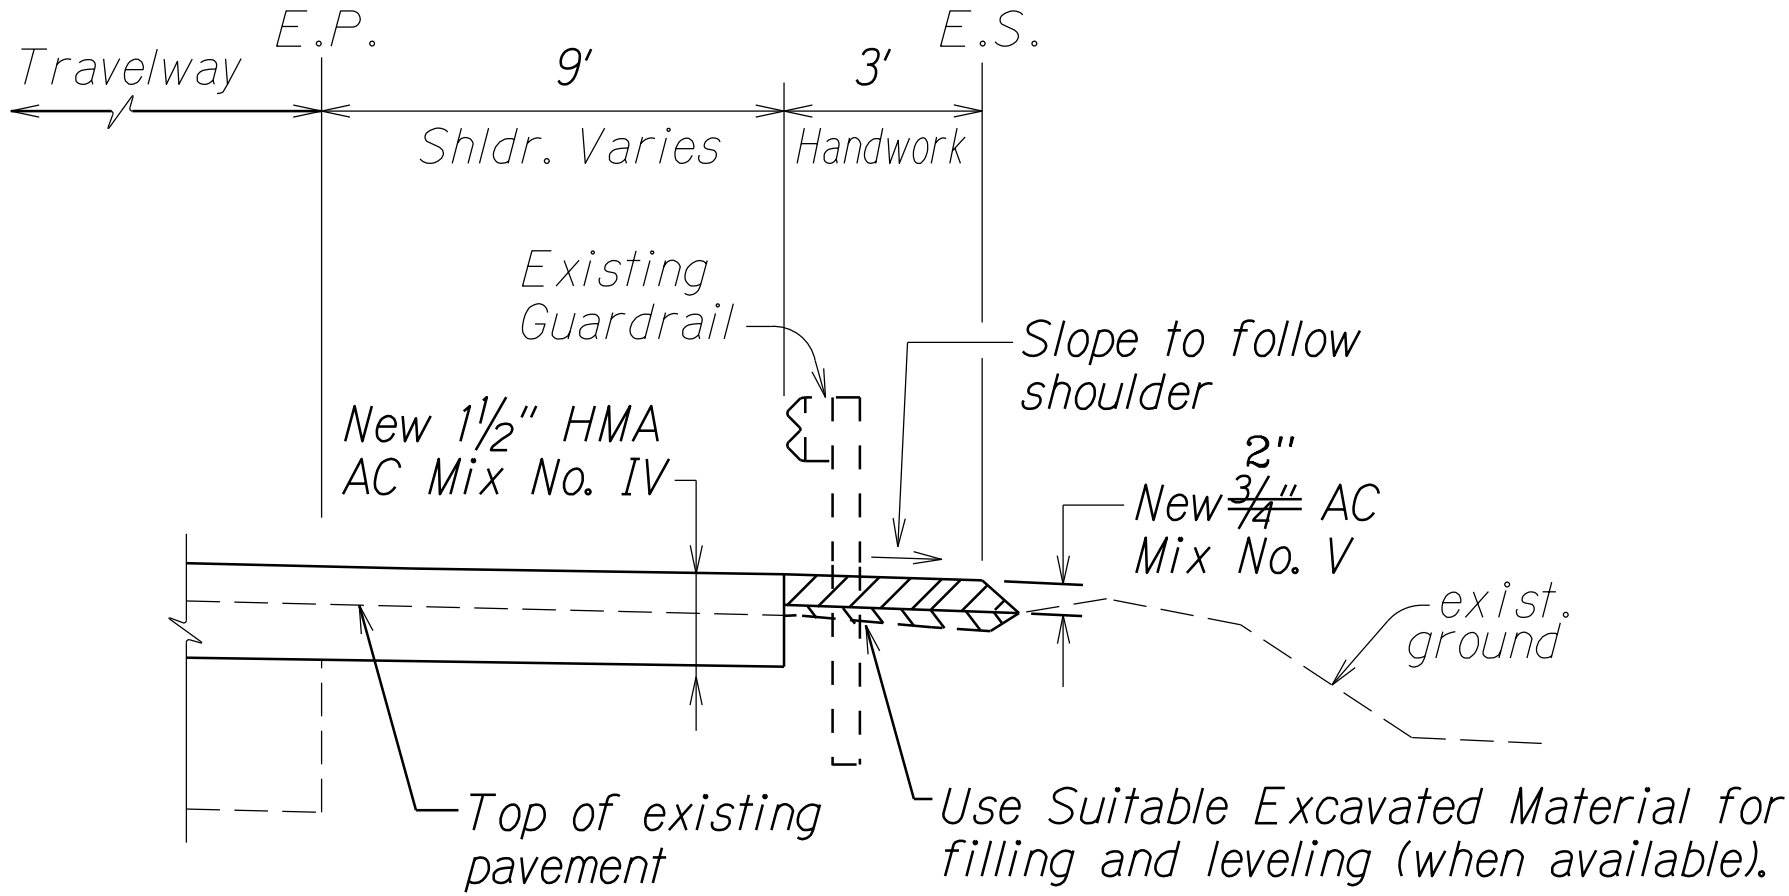

TYPICAL PAVING UNDER EXISTING GUARDRAIL

Not To Scale

ORIGINAL PLAN	SURVEY PLOTTED BY	DATE
NOTE BOOK	DRAWN BY	
TRACED BY	DESIGNED BY	
CHECKED BY	CHECKED BY	

LEGEND FOR AS-BUILT POSTINGS	
	Squiggly line for as-built deletion
	Double line for as-built deletion
Roadway	Text for as-built posting

STATE OF HAWAII DEPARTMENT OF TRANSPORTATION HIGHWAYS DIVISION	
<u>TYPICAL SUPERELEVATION SECTION</u>	
VOLCANO ROAD	
Pavement Preventive Maintenance	
Mountain View to Kea'au	
Federal Aid Project No. STP-011-2(041)	
Scale: N.T.S.	Date: March, 2012
SHEET No. 2 OF 2 SHEETS	