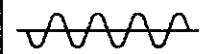
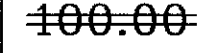


DIST. NO.	STATE	FED. AID PROJ. NO.	FISCAL YEAR	SHEET NO.	TOTAL SHEETS
HAWAII	HAW.	STP-011-2(042)	2013	22	23

STRIPING AND PAVEMENT MARKING SCHEDULE									
STATION		TRAFFIC REGIME		THERMOPLASTIC EXTRUSION (Lin. Ft.)		PAVEMENT MARKERS (Each)			
				4" Single Yellow Stripe	4" Single White Stripe (EP)				
FROM	TO	LEFT	RIGHT			C	D	H	J
0+00	11+30	N	P	1,130	2,260	56 59	28	28	112 #3
11+30	324+50	P	P	--	62,640 62,590	1,567.6	783		3,130.2
Estimated Totals				1,130	64,900 64,850	1,626.2	811	28	3,243.4
Item No.				629.1013	629.1012	629.2030	629.2040	629.2070	629.2080

CENTERLINE MONUMENT SCHEDULE						
STATION	DESCRIPTION	RECONSTRUCT (613.0300)	ADJUST (613.0200)	DEPTH NOTE	B/L OFFSET (Ft.)	NOTE
8+11.20	P.T.		1	0.12	0.00	No Sleeve
10+44.88	P.C.	1		0.12	0.30 Rt.	No Sleeve
38+63.49	P.T.		1	0.10	0.00	No Sleeve
68+53.44	P.C.	1		0.07	0.00	No Sleeve
141+79.86	P.T.		1	0.07	0.01 Rt.	No Sleeve
236+68.13	P.C.		1	0.08	0.27 Rt.	No Sleeve
314+08.82	P.O.C.	1		0.08	0.27 Rt.	No Sleeve
324+30.70	P.C.C.		1	0.15	0.00	Sleeve
TOTALS	--	3	5	--	--	--

ORIGINAL PLAN	DATE
NOTED	
DESIGNED BY	
QUANTITIES BY	
CHECKED BY	

LEGEND FOR AS-BUILT POSTINGS	
	Squiggly line for as-built deletion
	Double line for as-built deletion
Roadway	Text for as-built posting

STATE OF HAWAII
DEPARTMENT OF TRANSPORTATION
HIGHWAYS DIVISION

MISCELLANEOUS SCHEDULES

MAMALAHOA HIGHWAY

PAVEMENT PREVENTIVE MAINTENANCE

Kapapala Ranch To
Hawai'i Volcanoes National Park

Federal Aid Project No. STP-011-2(042)

Scale: None

Date: February, 2013

SHEET No. 1 OF 1 SHEETS