




FED. ROAD DIST. NO.	STATE	FED. AID PROJ. NO.	FISCAL YEAR	SHEET NO.	TOTAL SHEETS
HAWAII	HAW.	STP-011-2(042)	2013	6	23

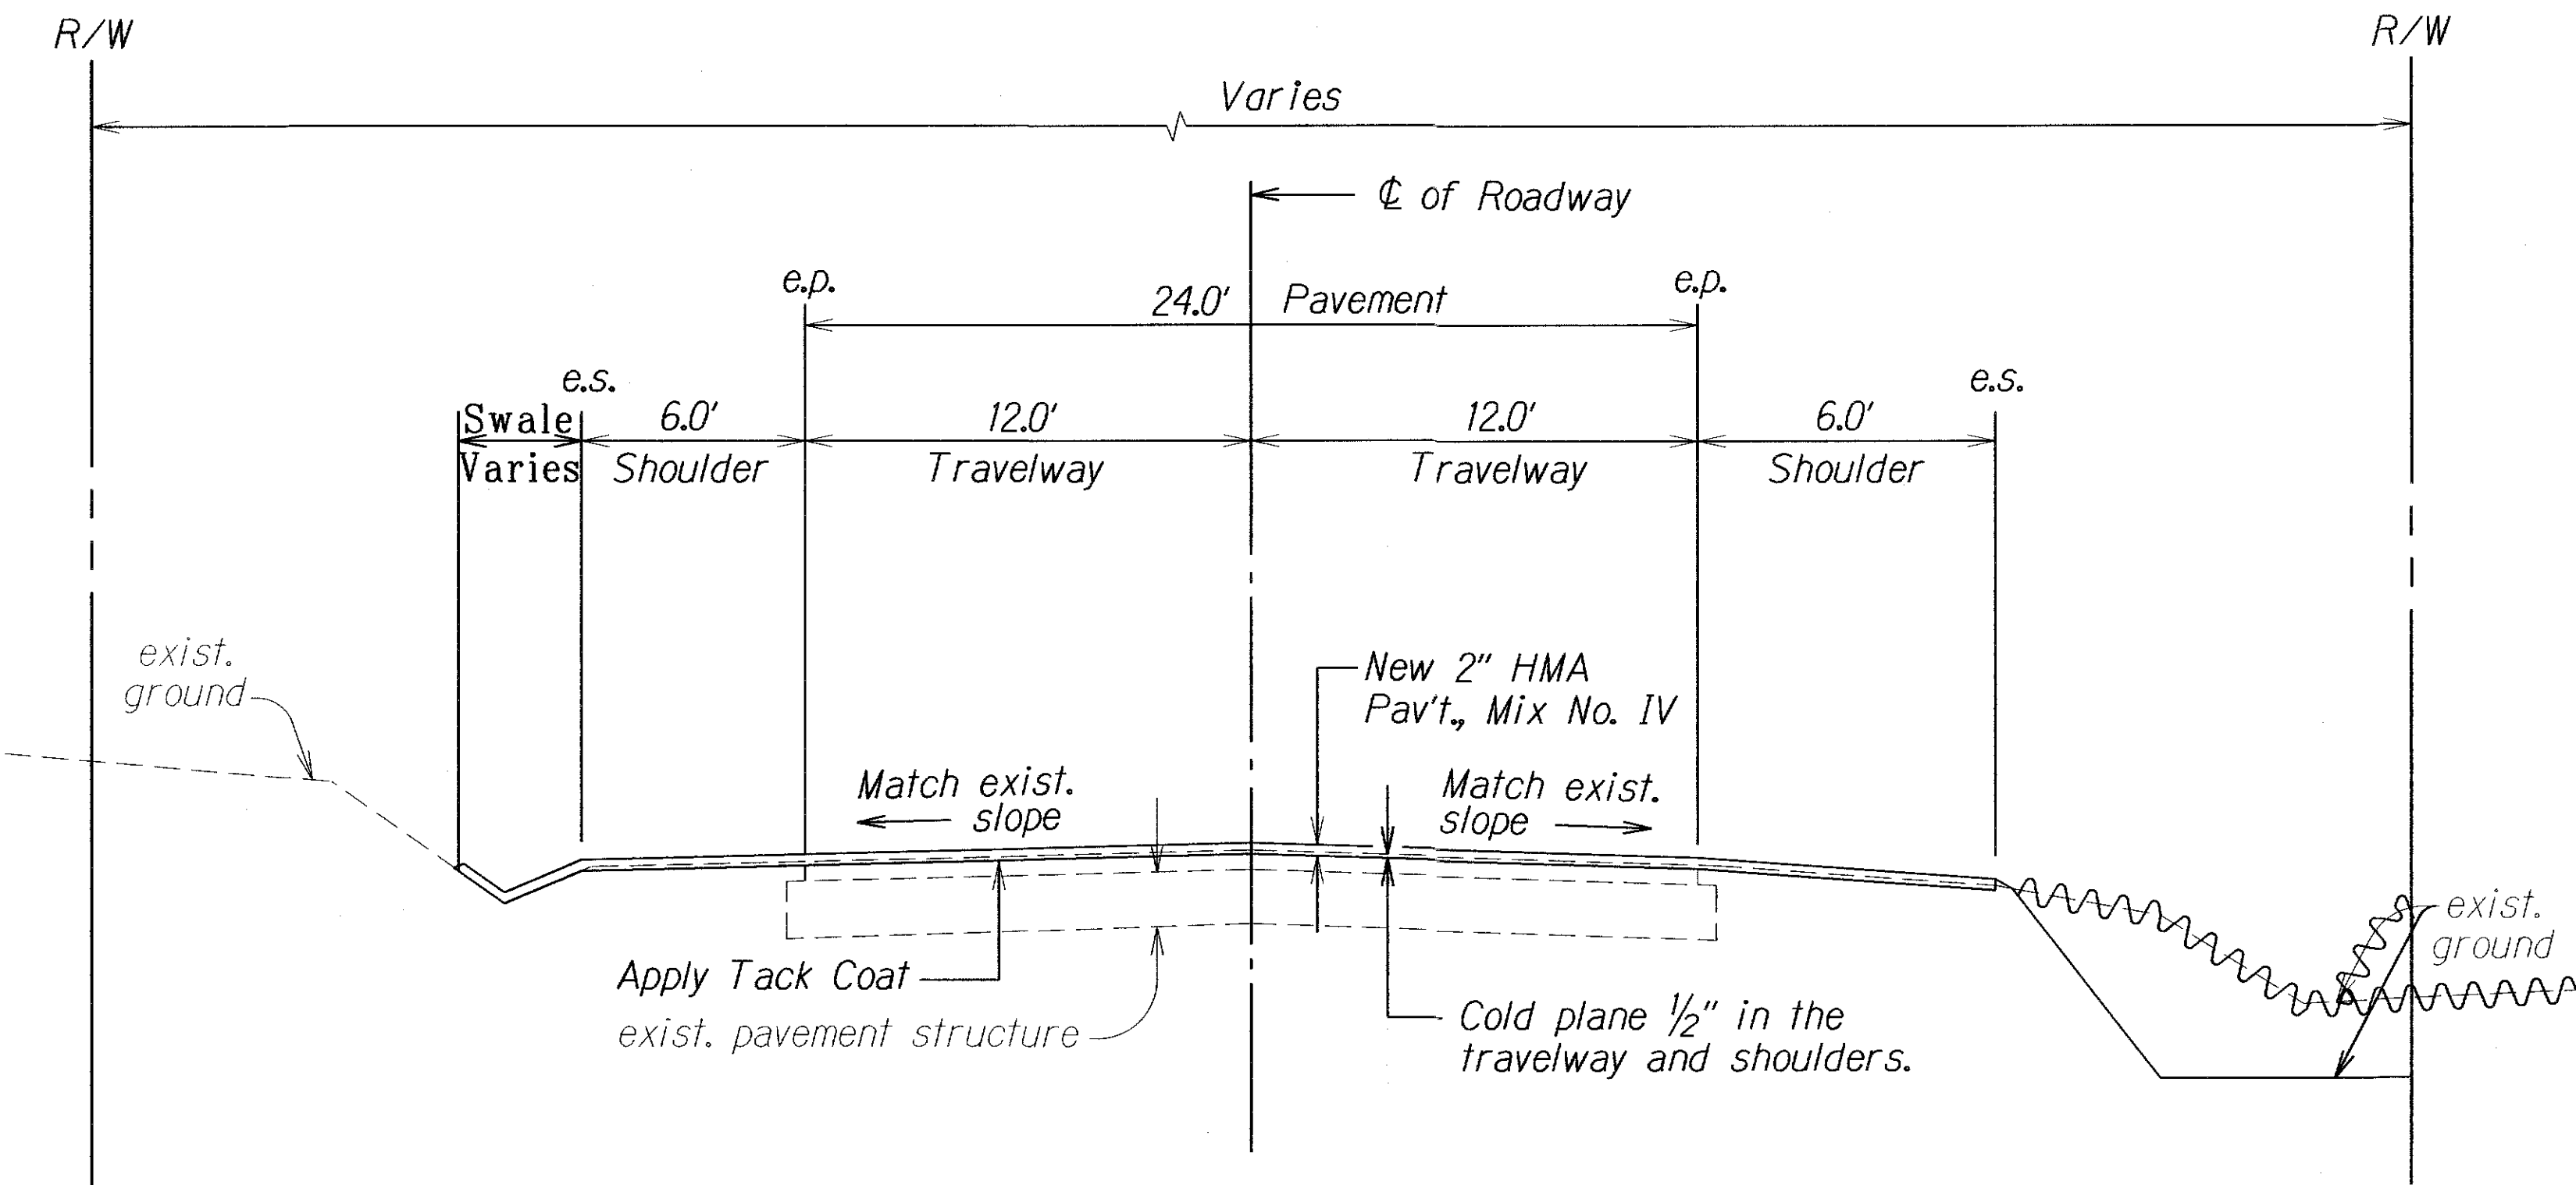

TYPICAL SECTION  
Not To Scale

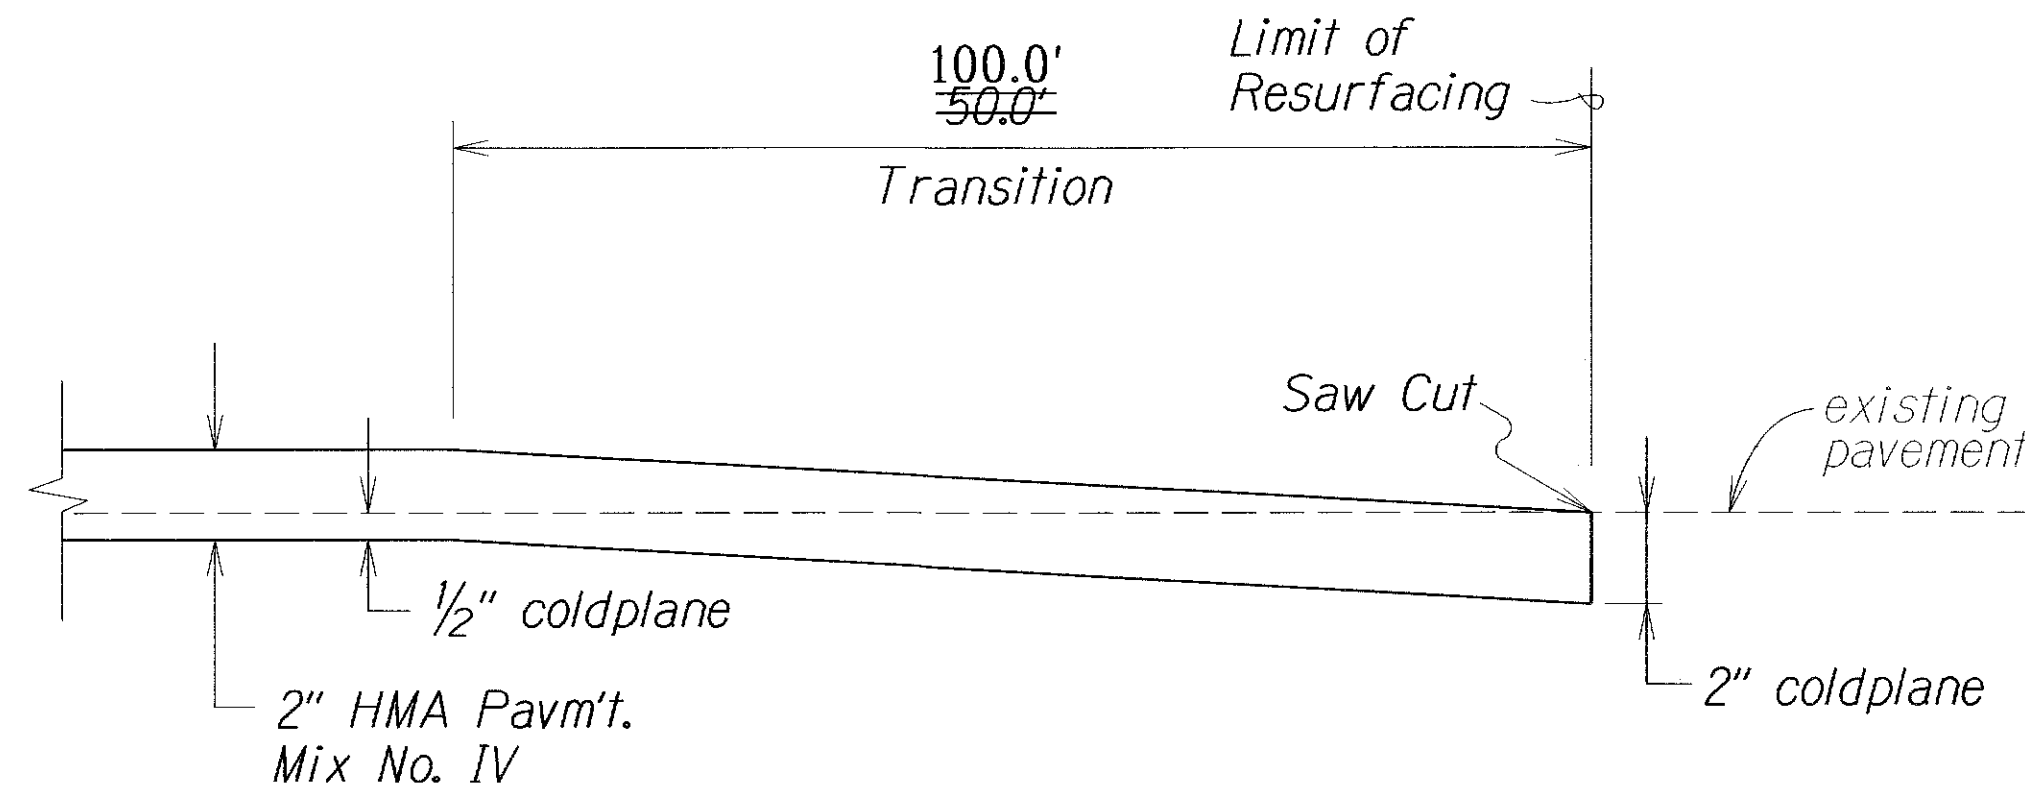

COLD PLANED TRANSITION  
AT BEGINNING AND END OF PROJECT  
Not To Scale

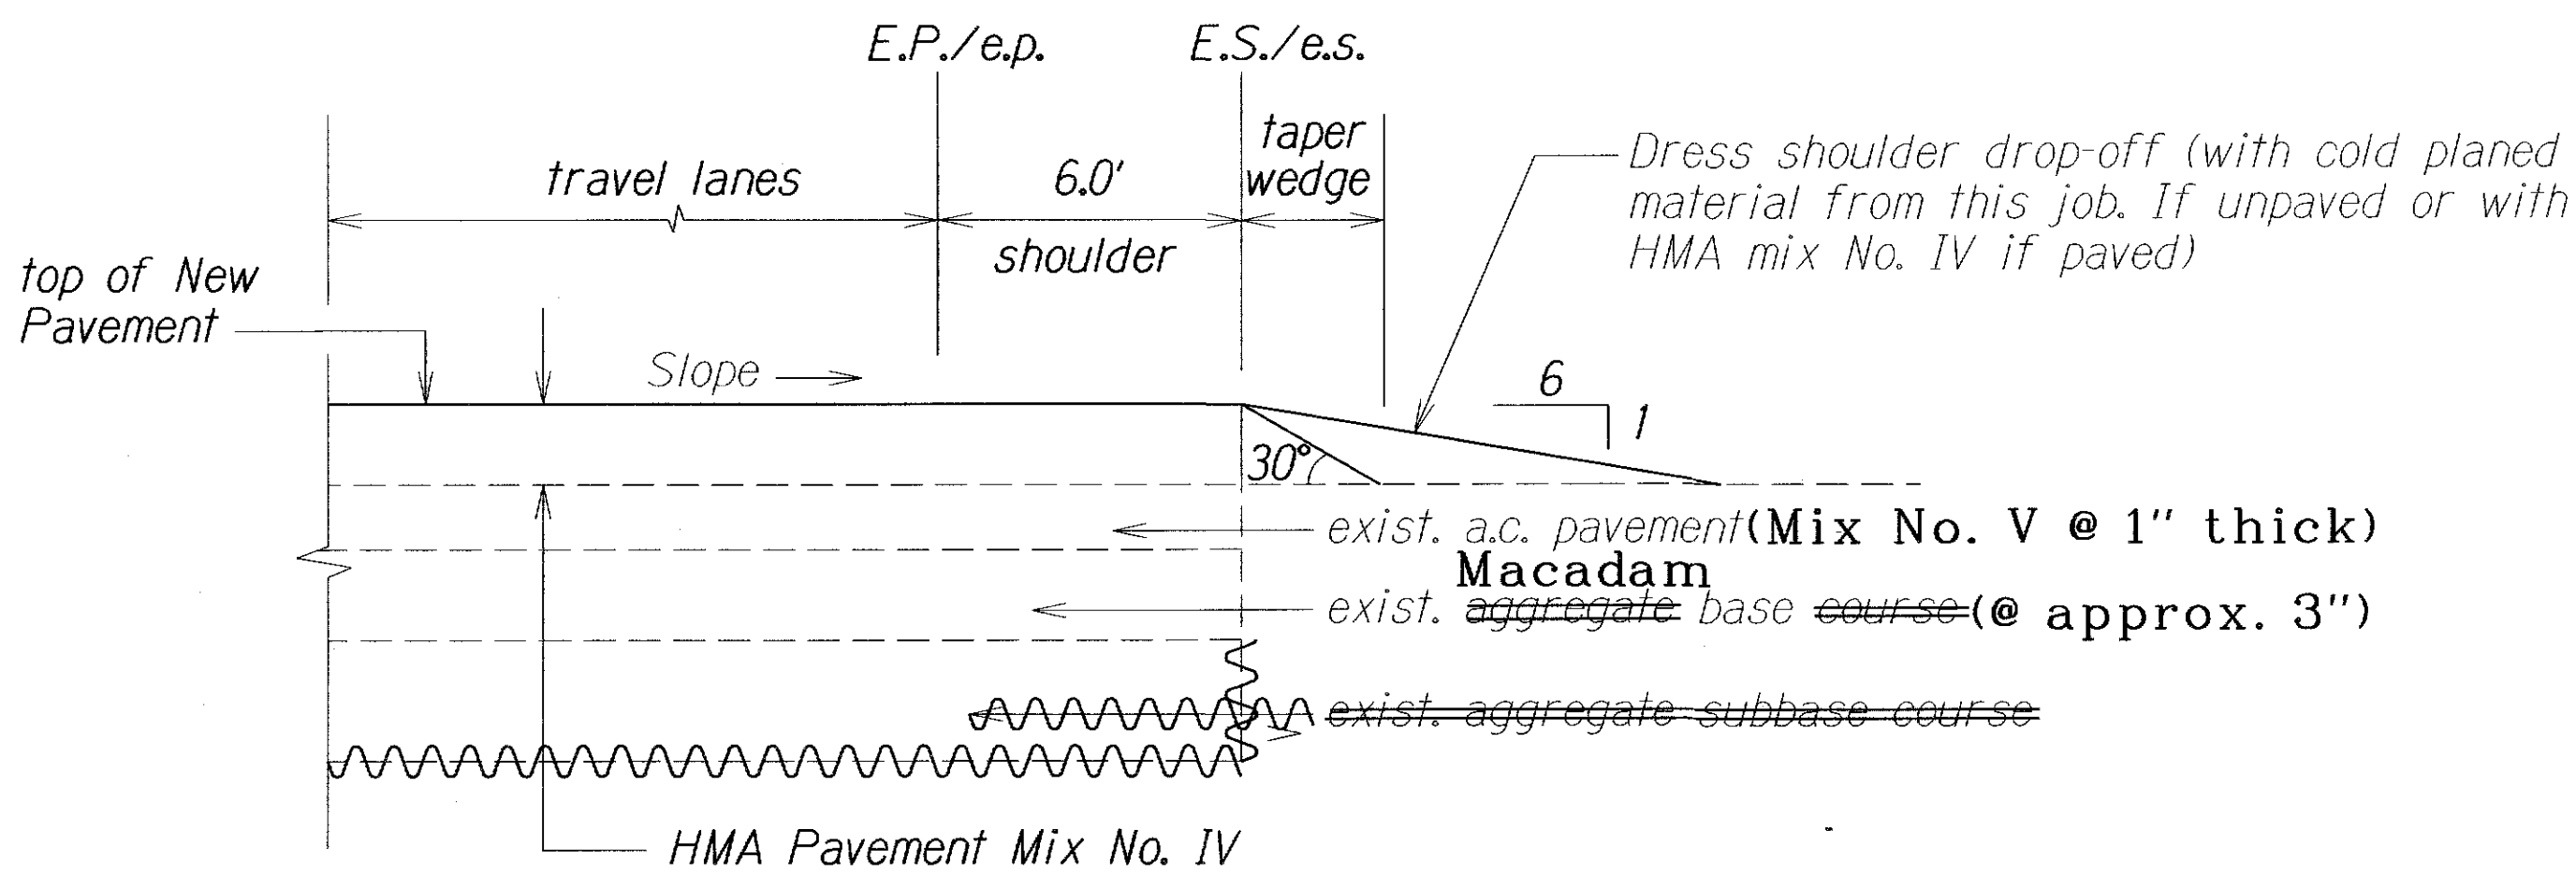

TYPICAL PAVEMENT EDGE DETAIL  
Not To Scale

Note: Contractor shall mount a device directly on the paver screed extension to provide a 30° beveled shoulder edge.

ORIGINAL PLAN	SURVEY PLOTTED BY	DATE
NOTE BOOK	DRAWN BY	
DESIGNED BY	CHECKED BY	
QUANTITIES BY		
SA/maui/2013		

LEGEND FOR AS-BUILT POSTINGS	
	Squiggly line for as-built deletion
	Double line for as-built deletion
Roadway	Text for as-built posting

STATE OF HAWAII DEPARTMENT OF TRANSPORTATION HIGHWAYS DIVISION	
TYPICAL SECTION AND DETAILS	
MAMALAHOA HIGHWAY	
PAVEMENT PREVENTIVE MAINTENANCE	
Kapapala Ranch To	
Hawai'i Volcanoes National Park	
Federal Aid Project No. STP-011-2(042)	
Scale: N.T.S.	Date: February, 2013
SHEET No. 1 OF 1 SHEETS	