


M:\2015\2015_160.004 HDOT KIPIMANA TRAFFIC SIGNAL\3 DWG\CIVIL\00 CAD DWG\FINAL BID SET\01 CE DWG\01 TITLE SHEET.DWG 4/23/2019 8:08 AM SRODELAS




SSFM INTL. DESIGNED BY
HWY-H MANAGED BY
692-7559 PHONE
MAY 2019 DATE

INDEX TO DRAWINGS	
SHEET NO.	DESCRIPTION
1	TITLE SHEET
2	STANDARD PLANS SUMMARY
3 - 4	GENERAL NOTES, LEGEND AND ABBREVIATIONS
5 - 7	WATER POLLUTION AND EROSION CONTROL NOTES
8 - 9	EXISTING CONDITION, DEMOLITION AND EROSION CONTROL PLAN AND DETAILS
10	INTERSECTION PLAN
11	SITE DETAILS
12 - 14	PAVEMENT MARKING AND SIGNING LEGEND, NOTES AND PLAN
15 - 20	TRAFFIC SIGNAL NOTES, PLAN AND DETAILS
21 - 25	ELECTRICAL NOTES, PLAN AND DETAILS

STATE OF HAWAII
DEPARTMENT OF TRANSPORTATION
HIGHWAYS DIVISION
HONOLULU, HAWAII
"AS-BUILT"
PLANS FOR
**VOLCANO ROAD
TEMPORARY SIGNAL INSTALLATION
AT KIPIMANA STREET**
PROJECT NO. 11N-01-19M
DISTRICT OF PUNA
ISLAND OF HAWAII

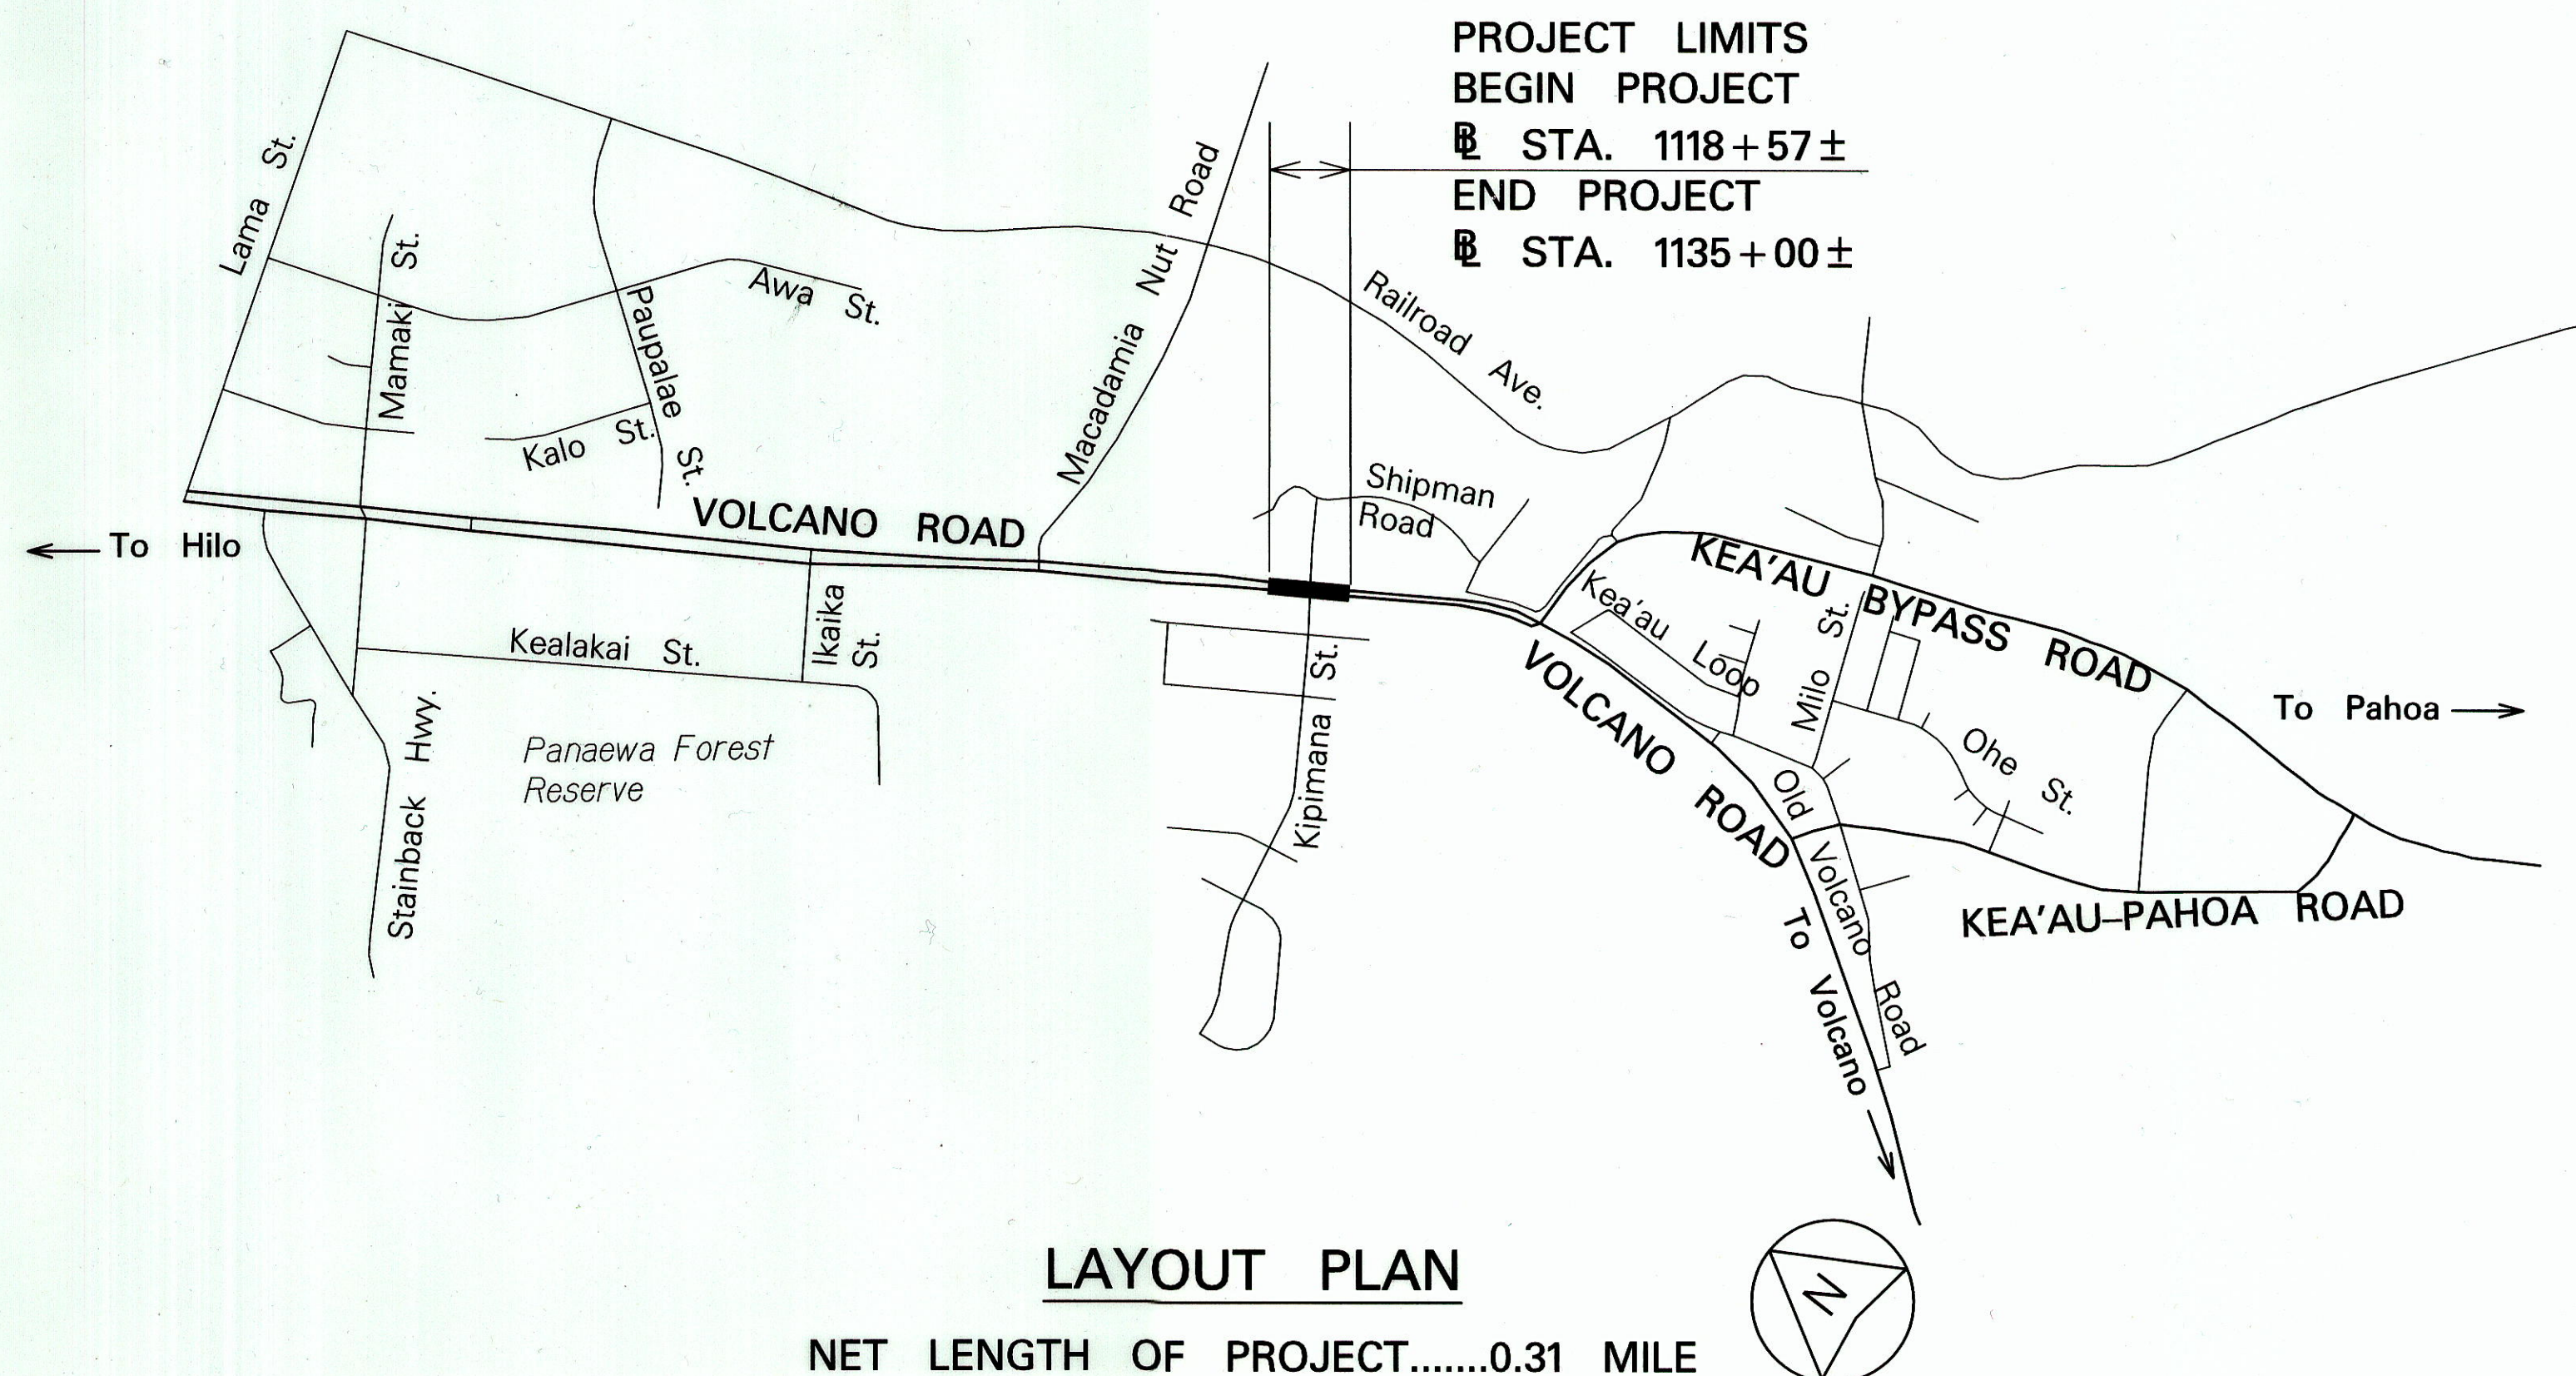

FED. ROAD DIST. NO.	STATE	PROJ. NO.	FISCAL YEAR	SHEET NO.	TOTAL SHEETS
HAWAII	HAW.	11N-01-19M	2019	ADD.1	25

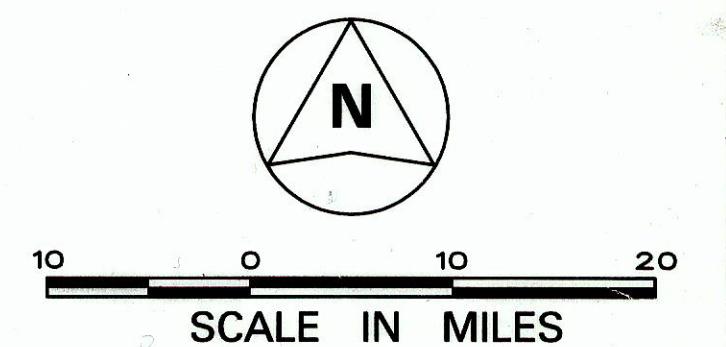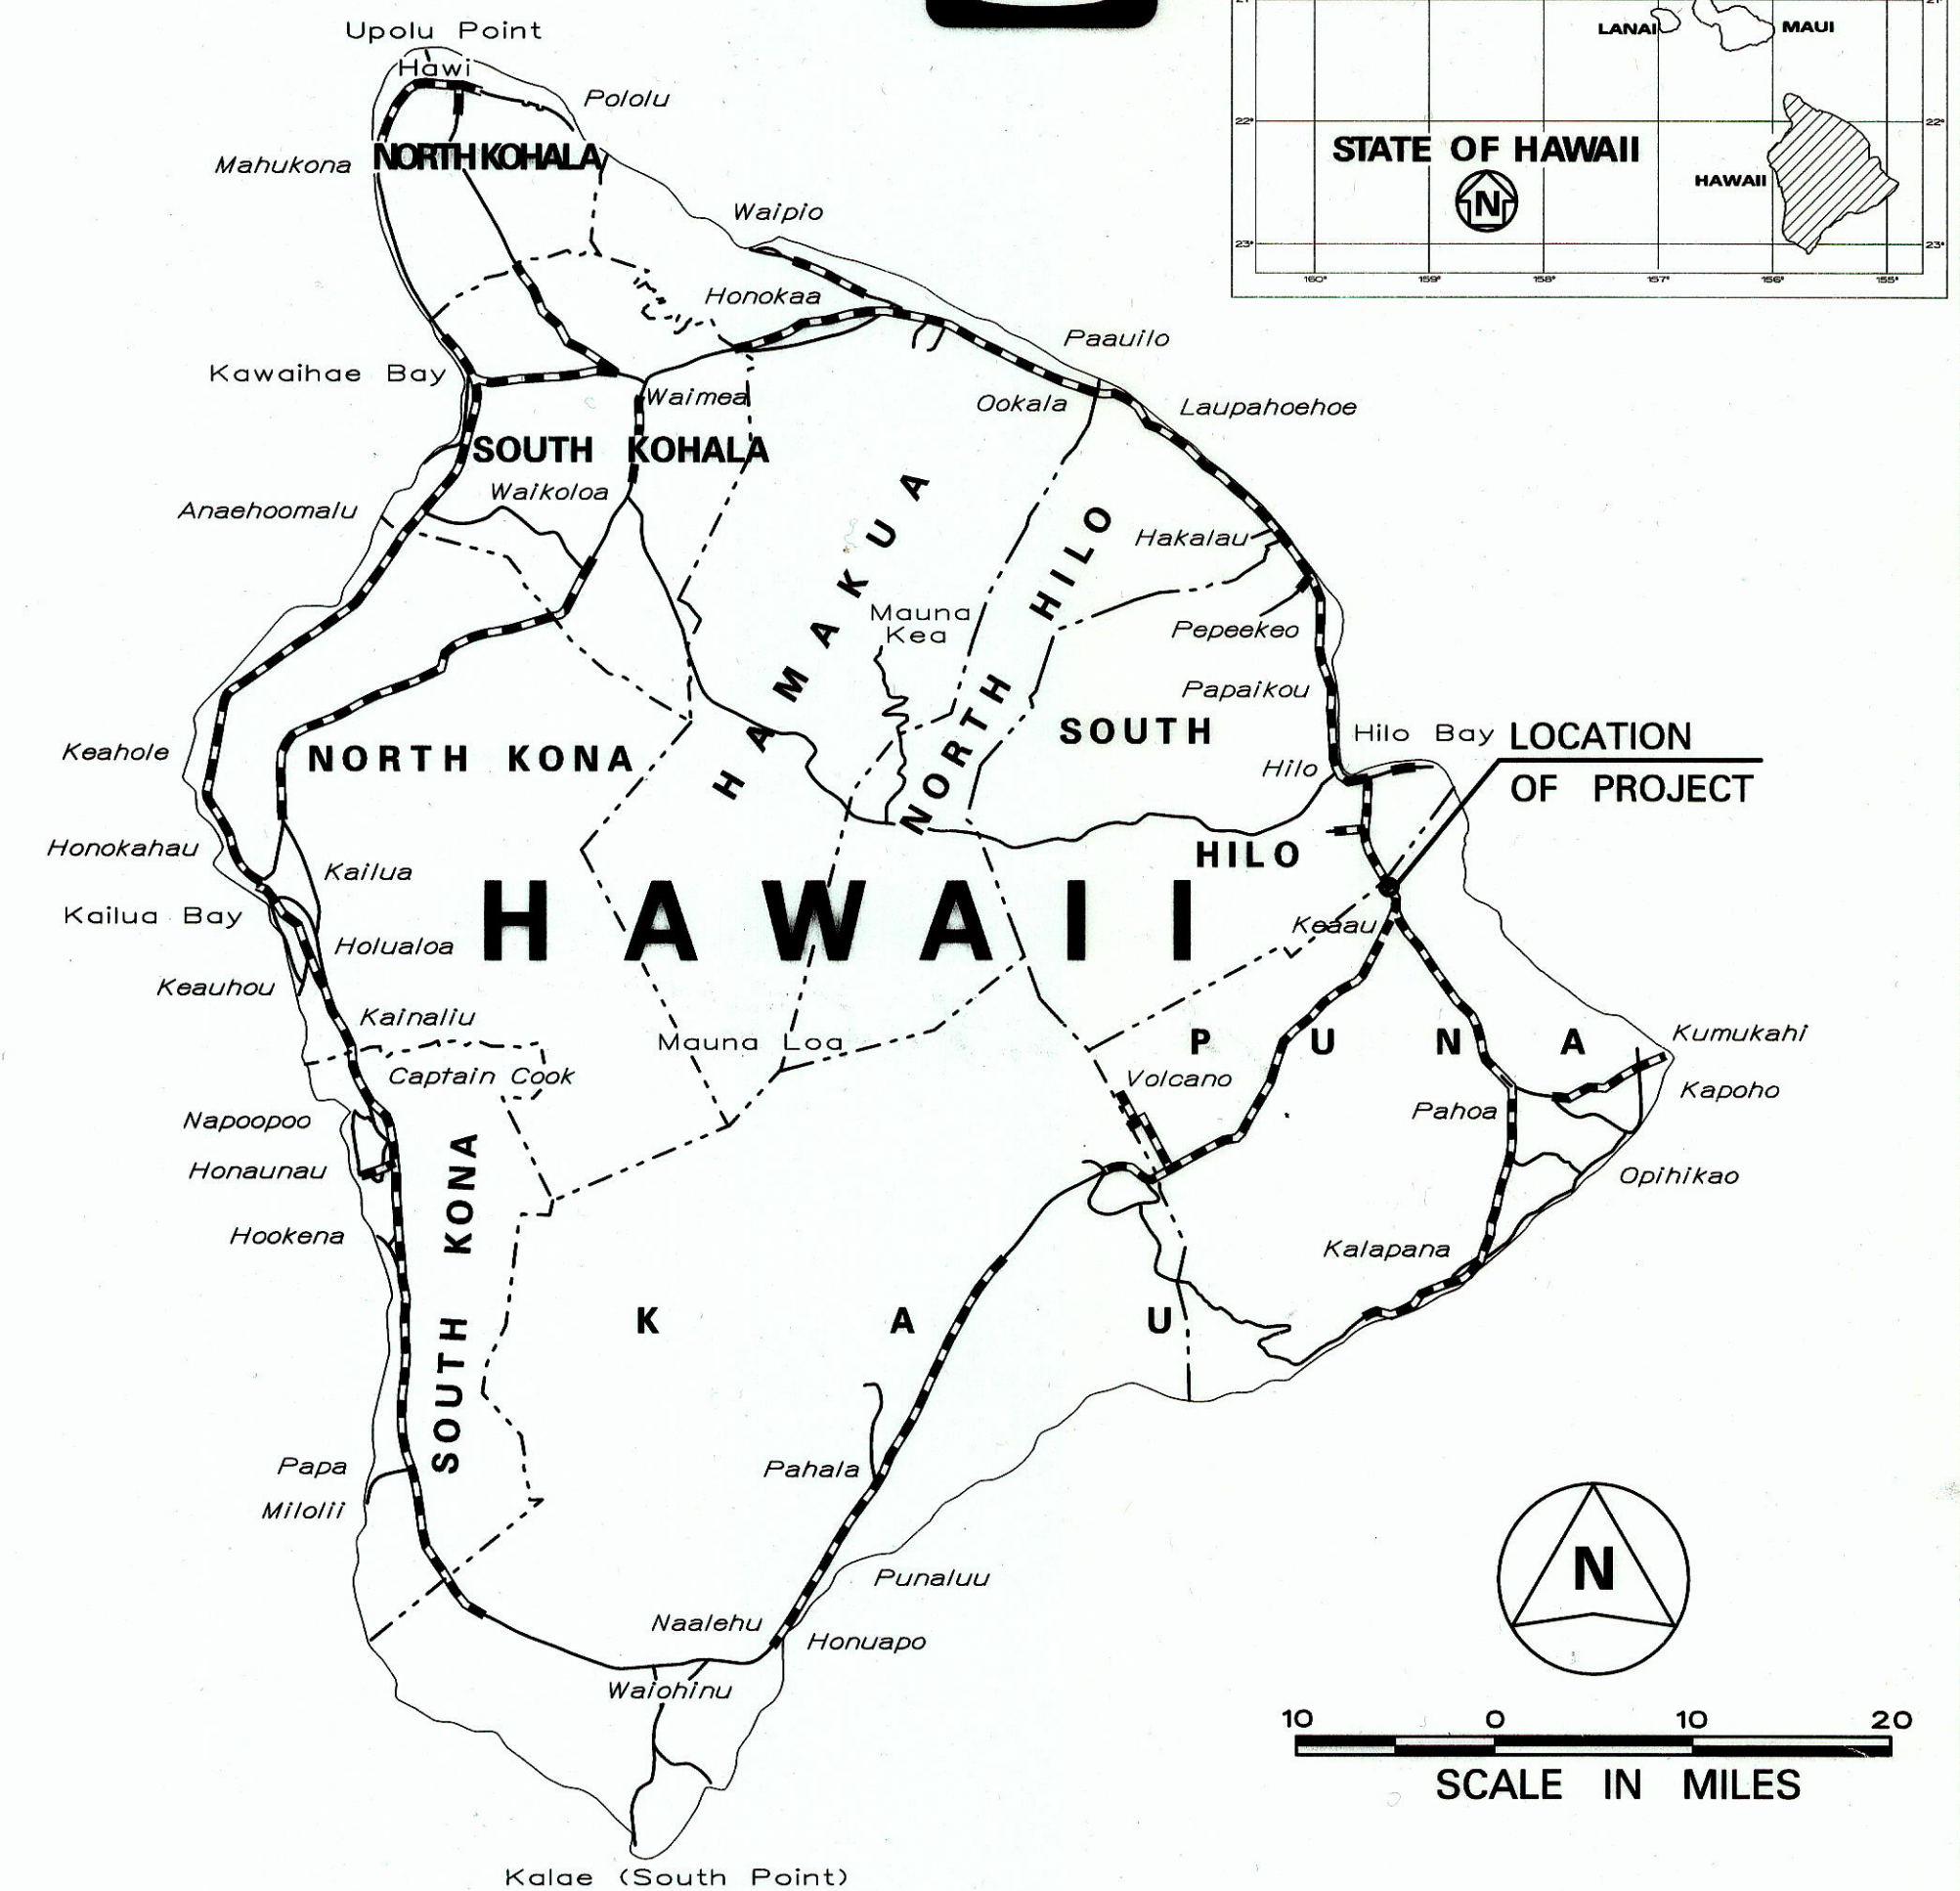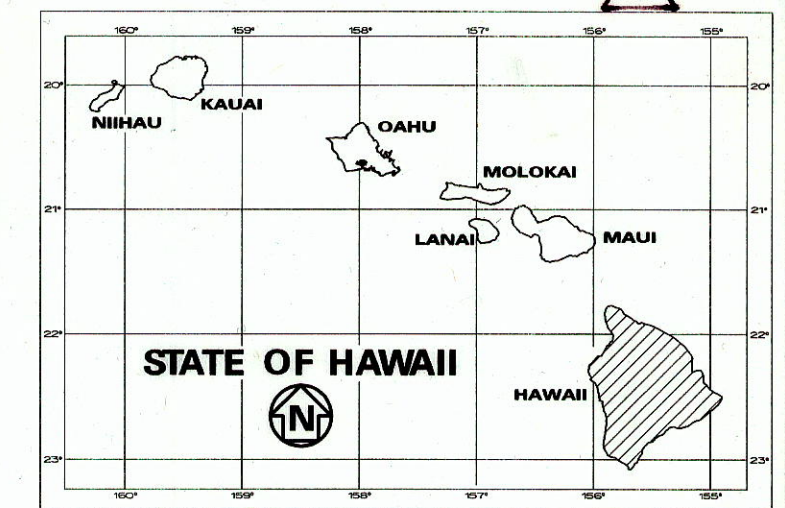

FEDERAL AID INTERSTATE PROJECTS PREVIOUSLY CONSTRUCTED OR UNDER CONSTRUCTION

MILE POST 6.18

CHANGES MADE DURING CONSTRUCTION HAVE BEEN INCORPORATED ON THESE PLANS EXCEPT CHANGES IN THE ORIGINAL THEORETICAL QUANTITIES. FOR ACTUAL QUANTITIES, REFER TO PROJECT LEDGER AND/OR COMPUTATION BOOK.

4/8/2021
DATE

6/10/19	△ CORRECTED TOTAL SHEET COUNT
DATE	REVISION
DEPARTMENT OF TRANSPORTATION STATE OF HAWAII	
APPROVED:	
5/29/19	DATE
DIR. OF TRANSPORTATION	

ADD. 1