


FED. ROAD DIST. NO.	STATE	PROJ. NO.	FISCAL YEAR	SHEET NO.	TOTAL SHEETS
HAWAII	HAW.	11B-01-20	2022	C.O. 22	34

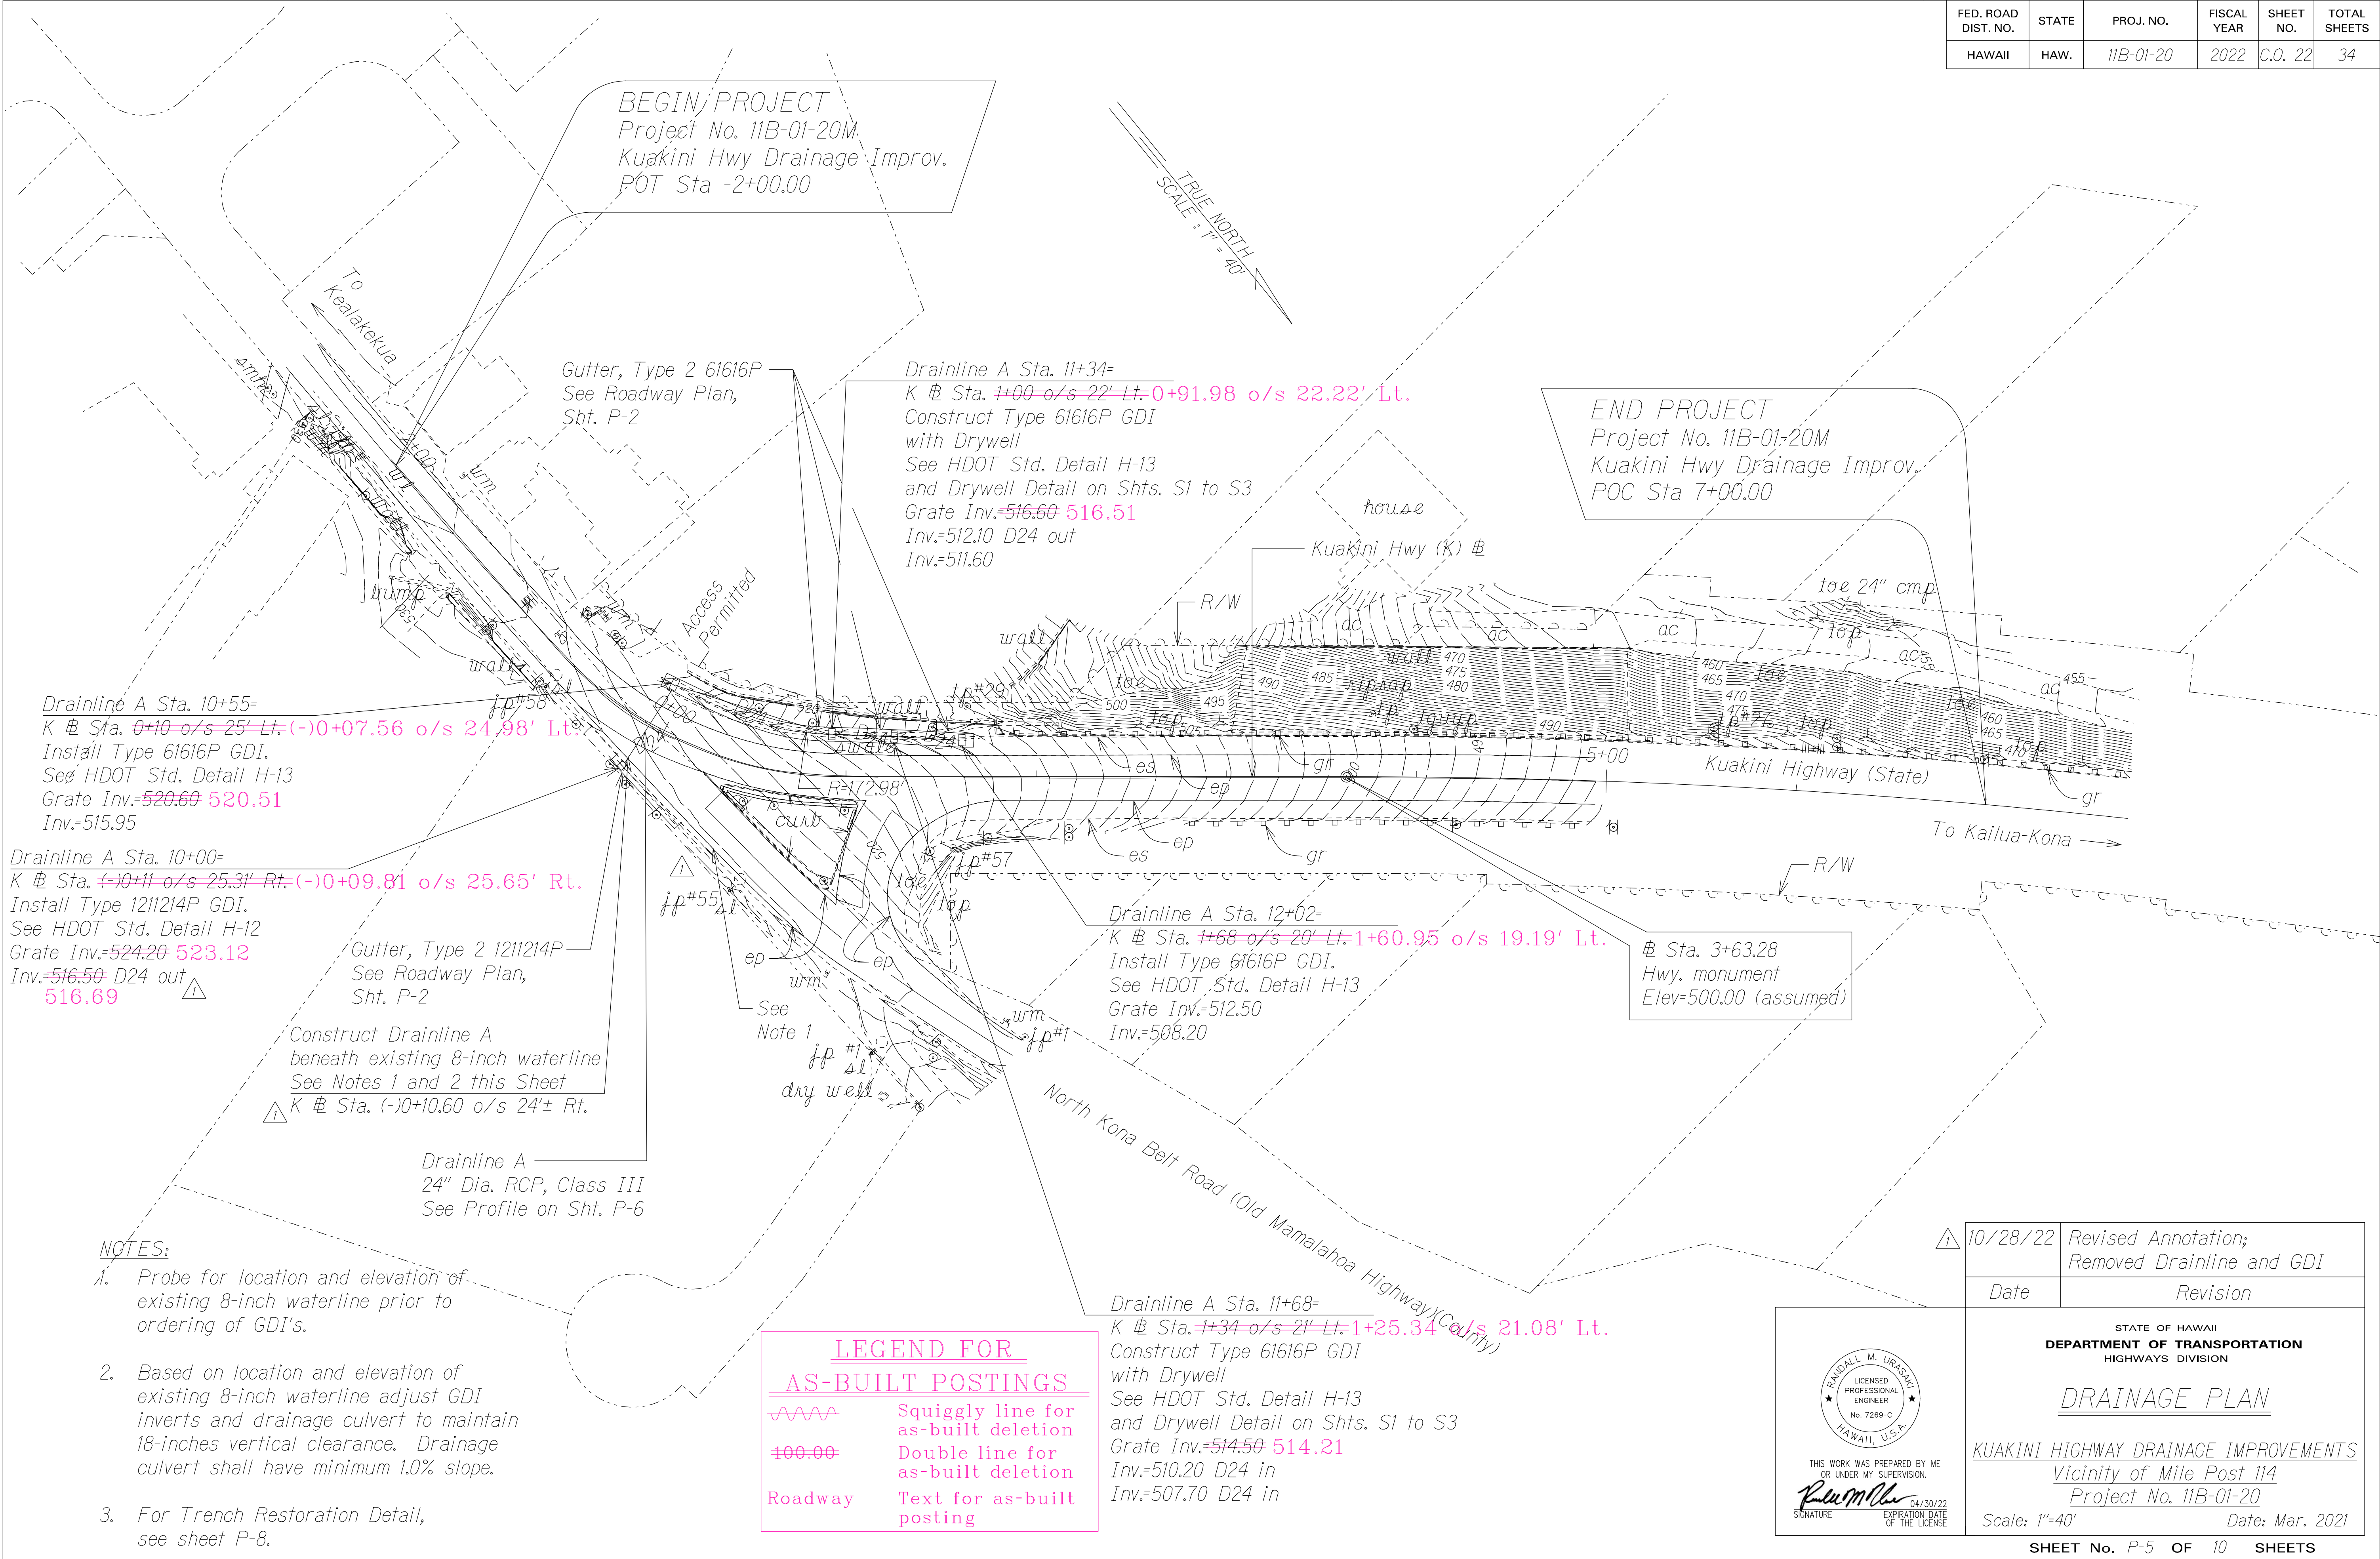

DATE	
SURVEY PLOTTED BY	
ORIGINAL PLAN	
DESIGNED BY	
TRACED BY	
NOTE BOOK	
QUANTITIES BY	
CHECKED BY	
No.	

NOTES:

1. Probe for location and elevation of existing 8-inch waterline prior to ordering of GDI's.
2. Based on location and elevation of existing 8-inch waterline adjust GDI inverts and drainage culvert to maintain 18-inches vertical clearance. Drainage culvert shall have minimum 1.0% slope.
3. For Trench Restoration Detail, see sheet P-8.

LEGEND FOR
AS-BUILT POSTINGS

Squiggly line for
as-built deletion


Double line for
as-built deletion

Text for as-built
posting

"AS-BUILT"


C.O. 22

FED. ROAD DIST. NO.	STATE	PROJ. NO.	FISCAL YEAR	SHEET NO.	TOTAL SHEETS
HAWAII	HAW.	11B-01-20	2022	C.O. 23	34

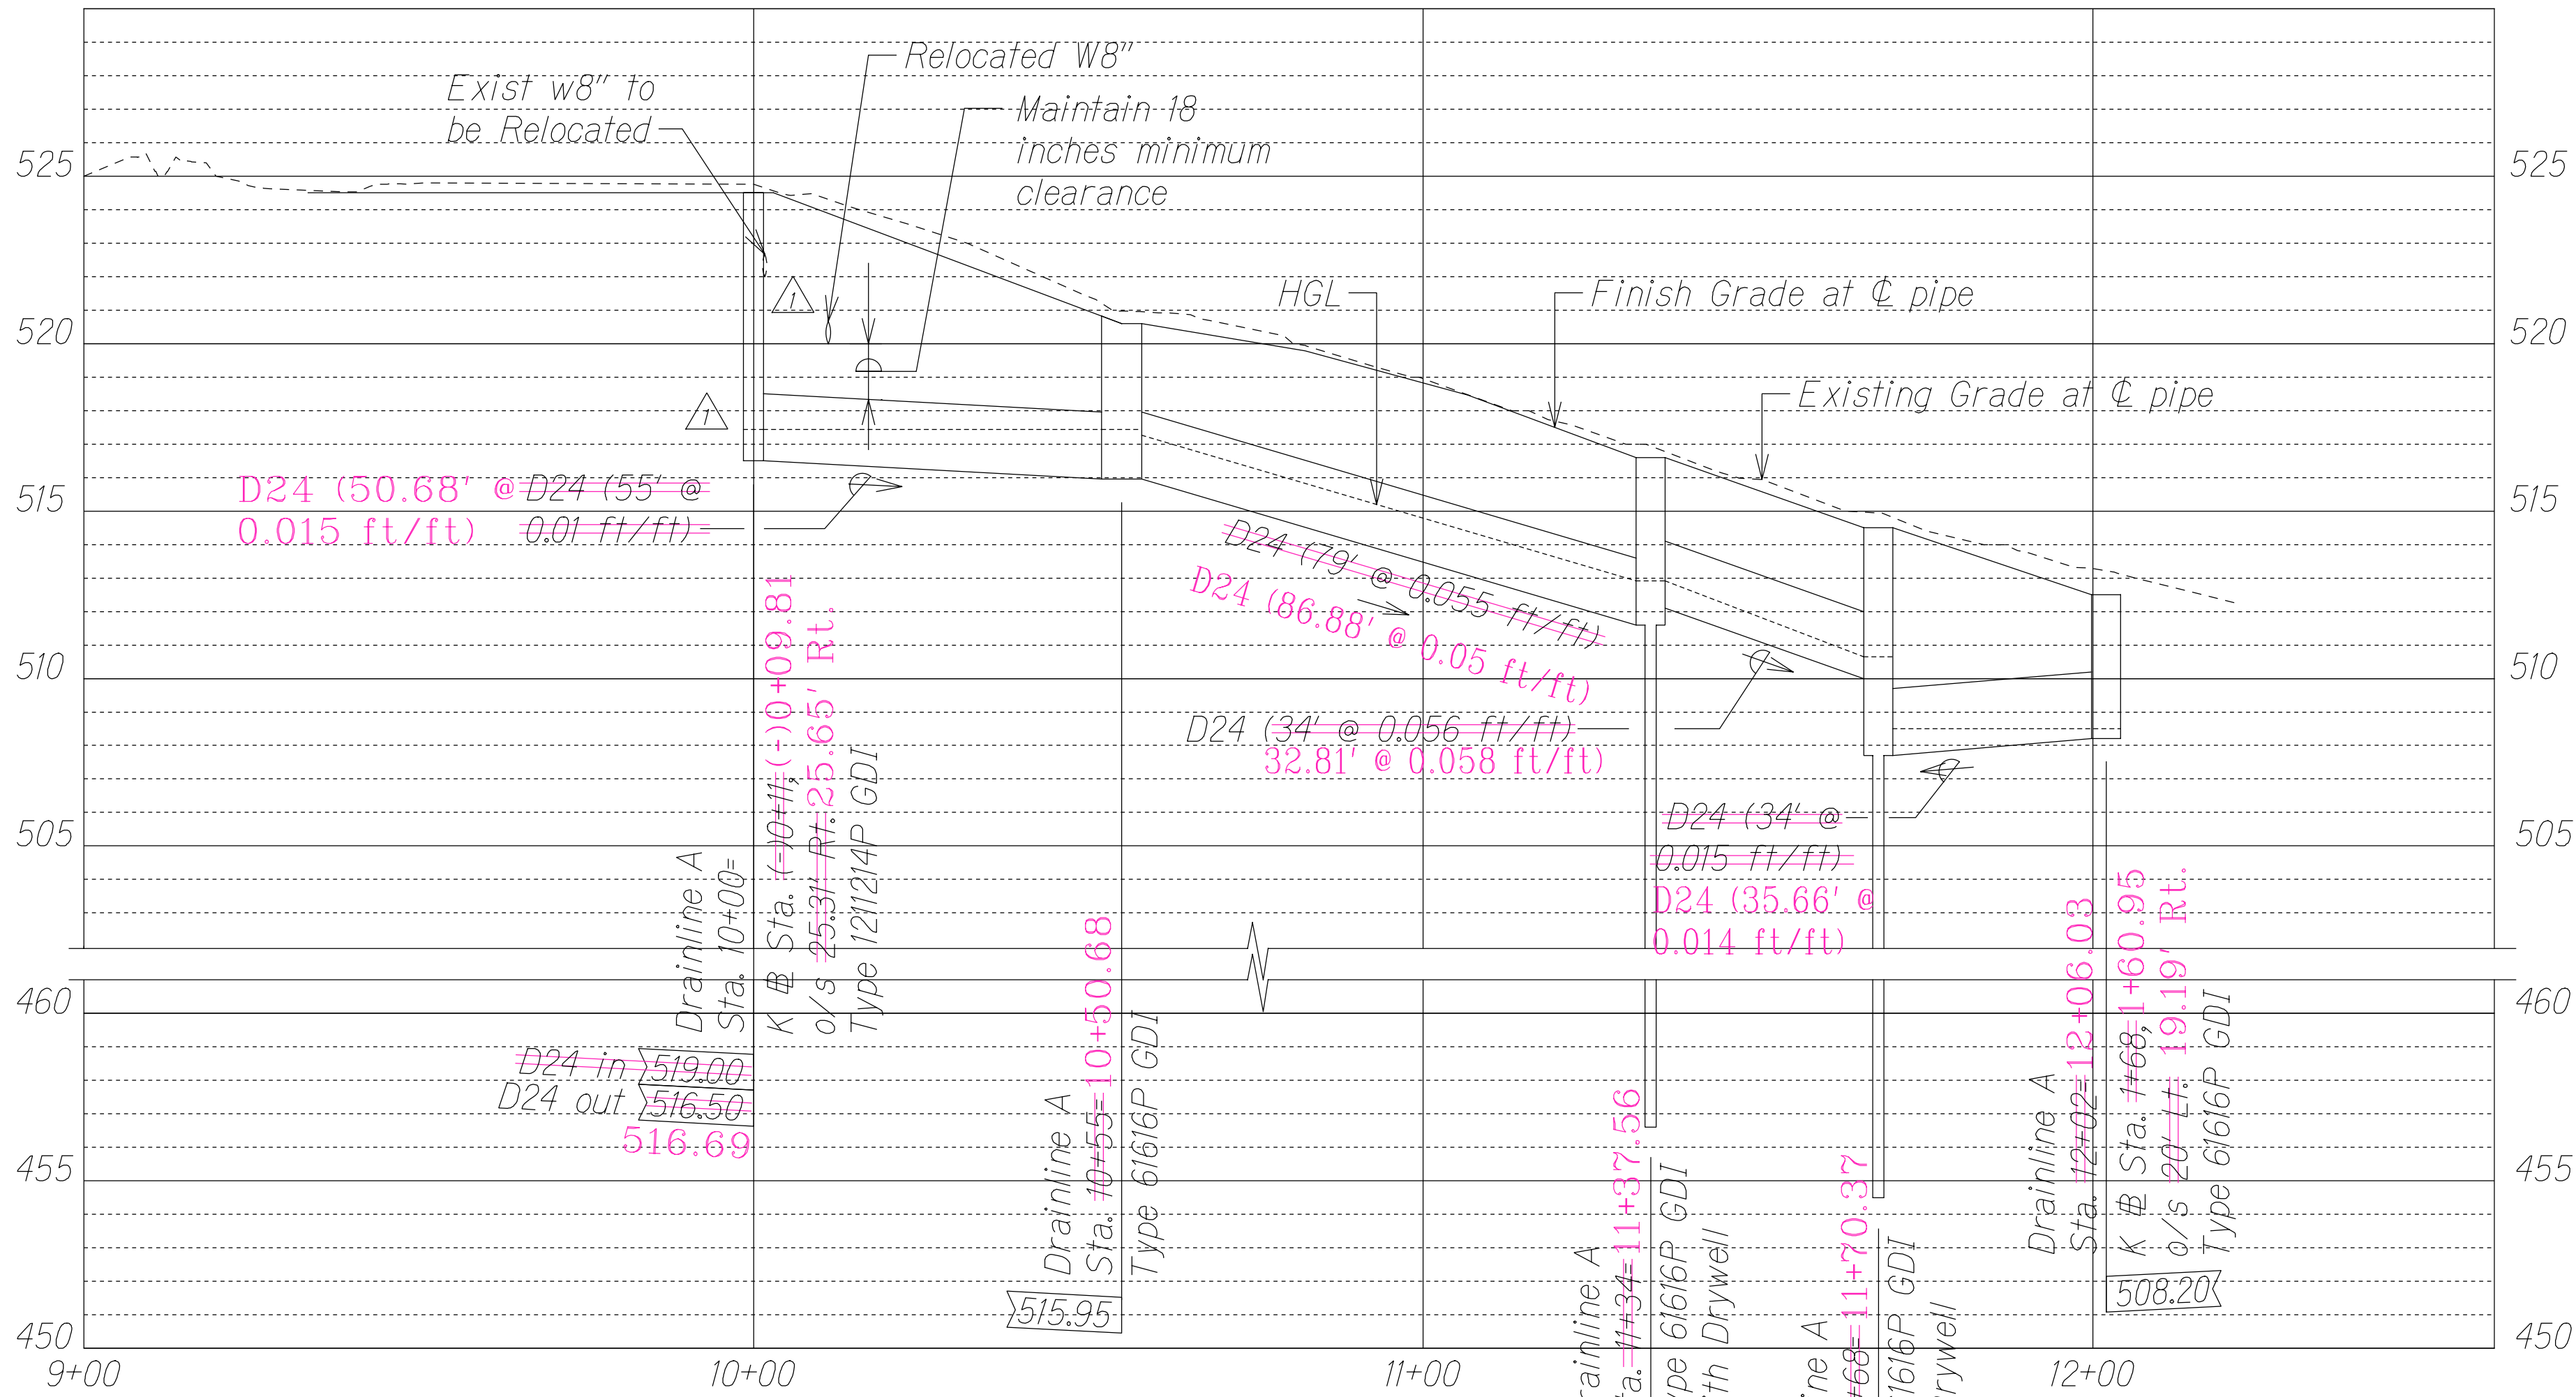

△ PROFILE - DRAINLINE A


Scale: Horiz. 1"=20'
Vert. 1"=4'

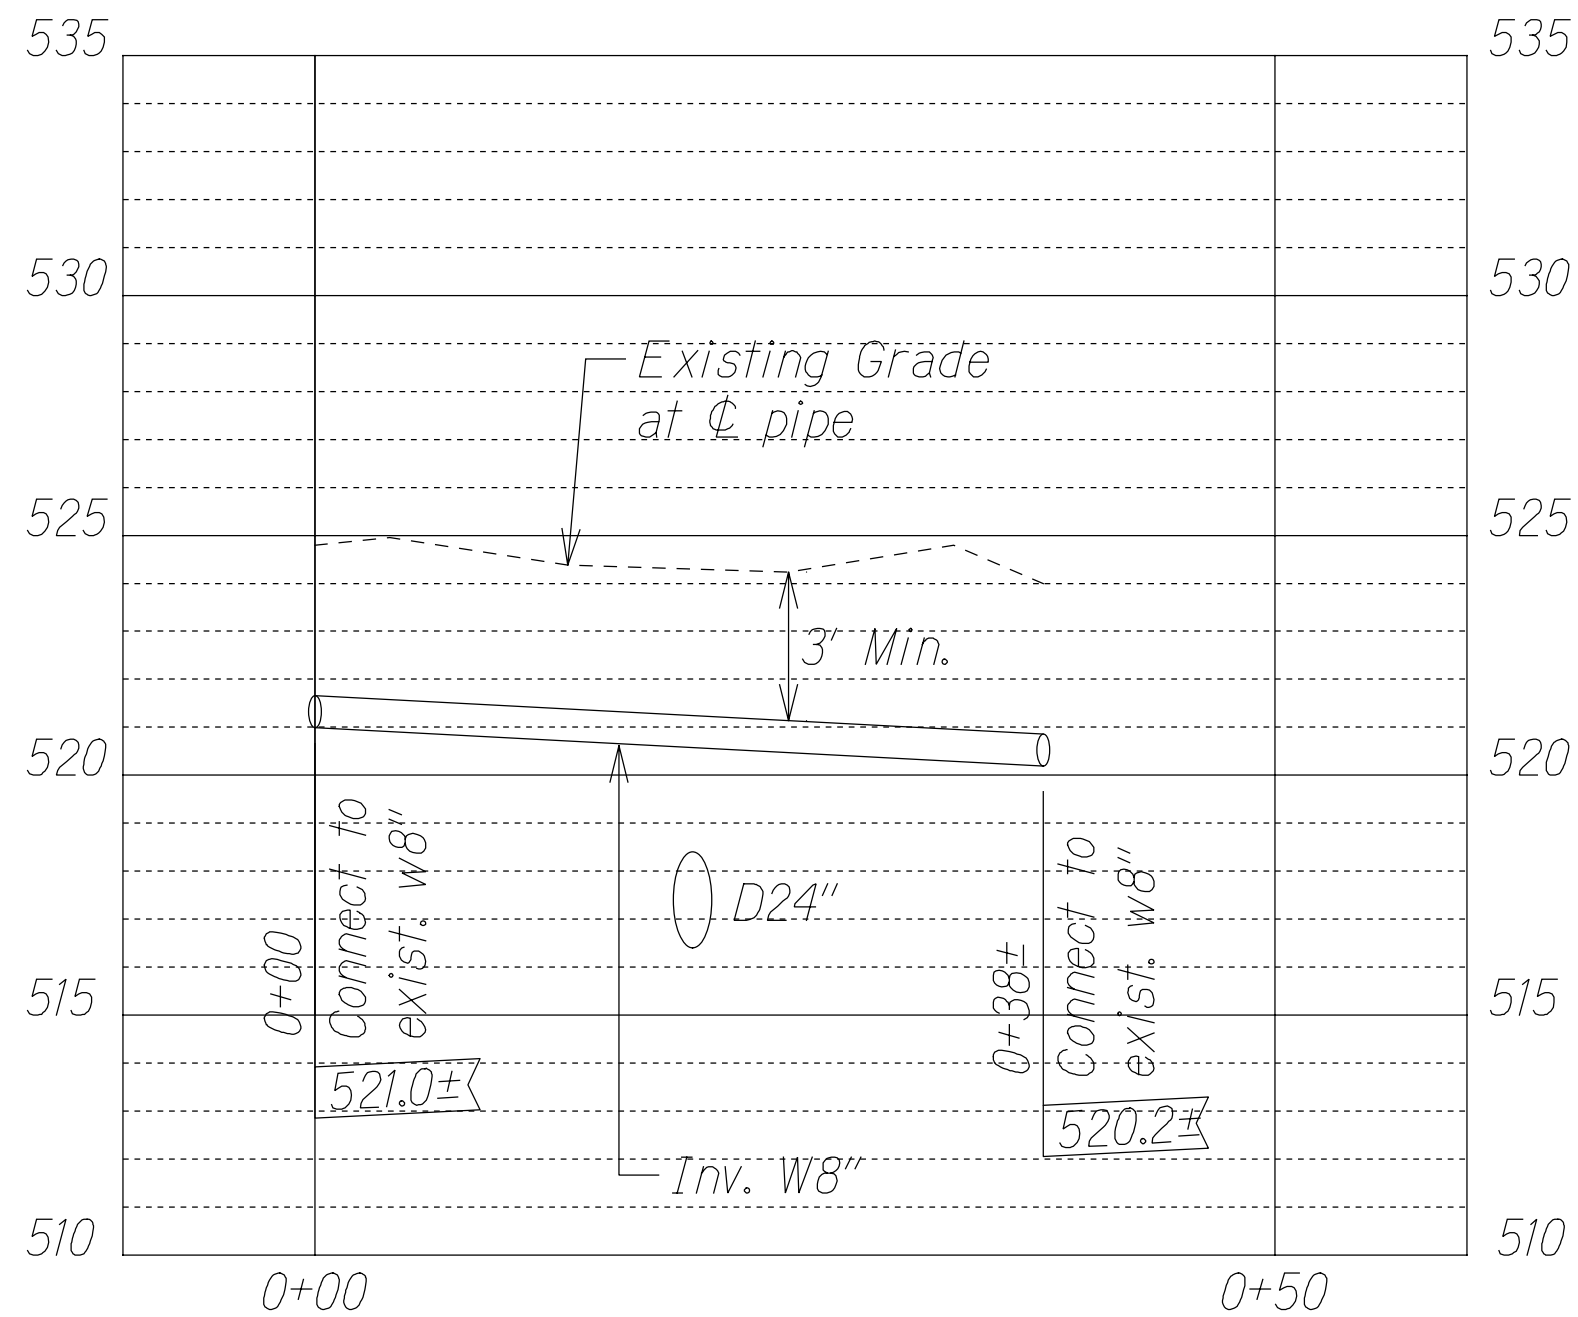

△ RELOCATED WATERLINE PROFILE


Scale: Horiz. 1"=10'
Vert. 1"=4'

△ 10/28/22	Added Relocated Waterline Profile; Revised Profile Drainline A
△ 06/08/23	Revised Gutter Profile
Date	Revision

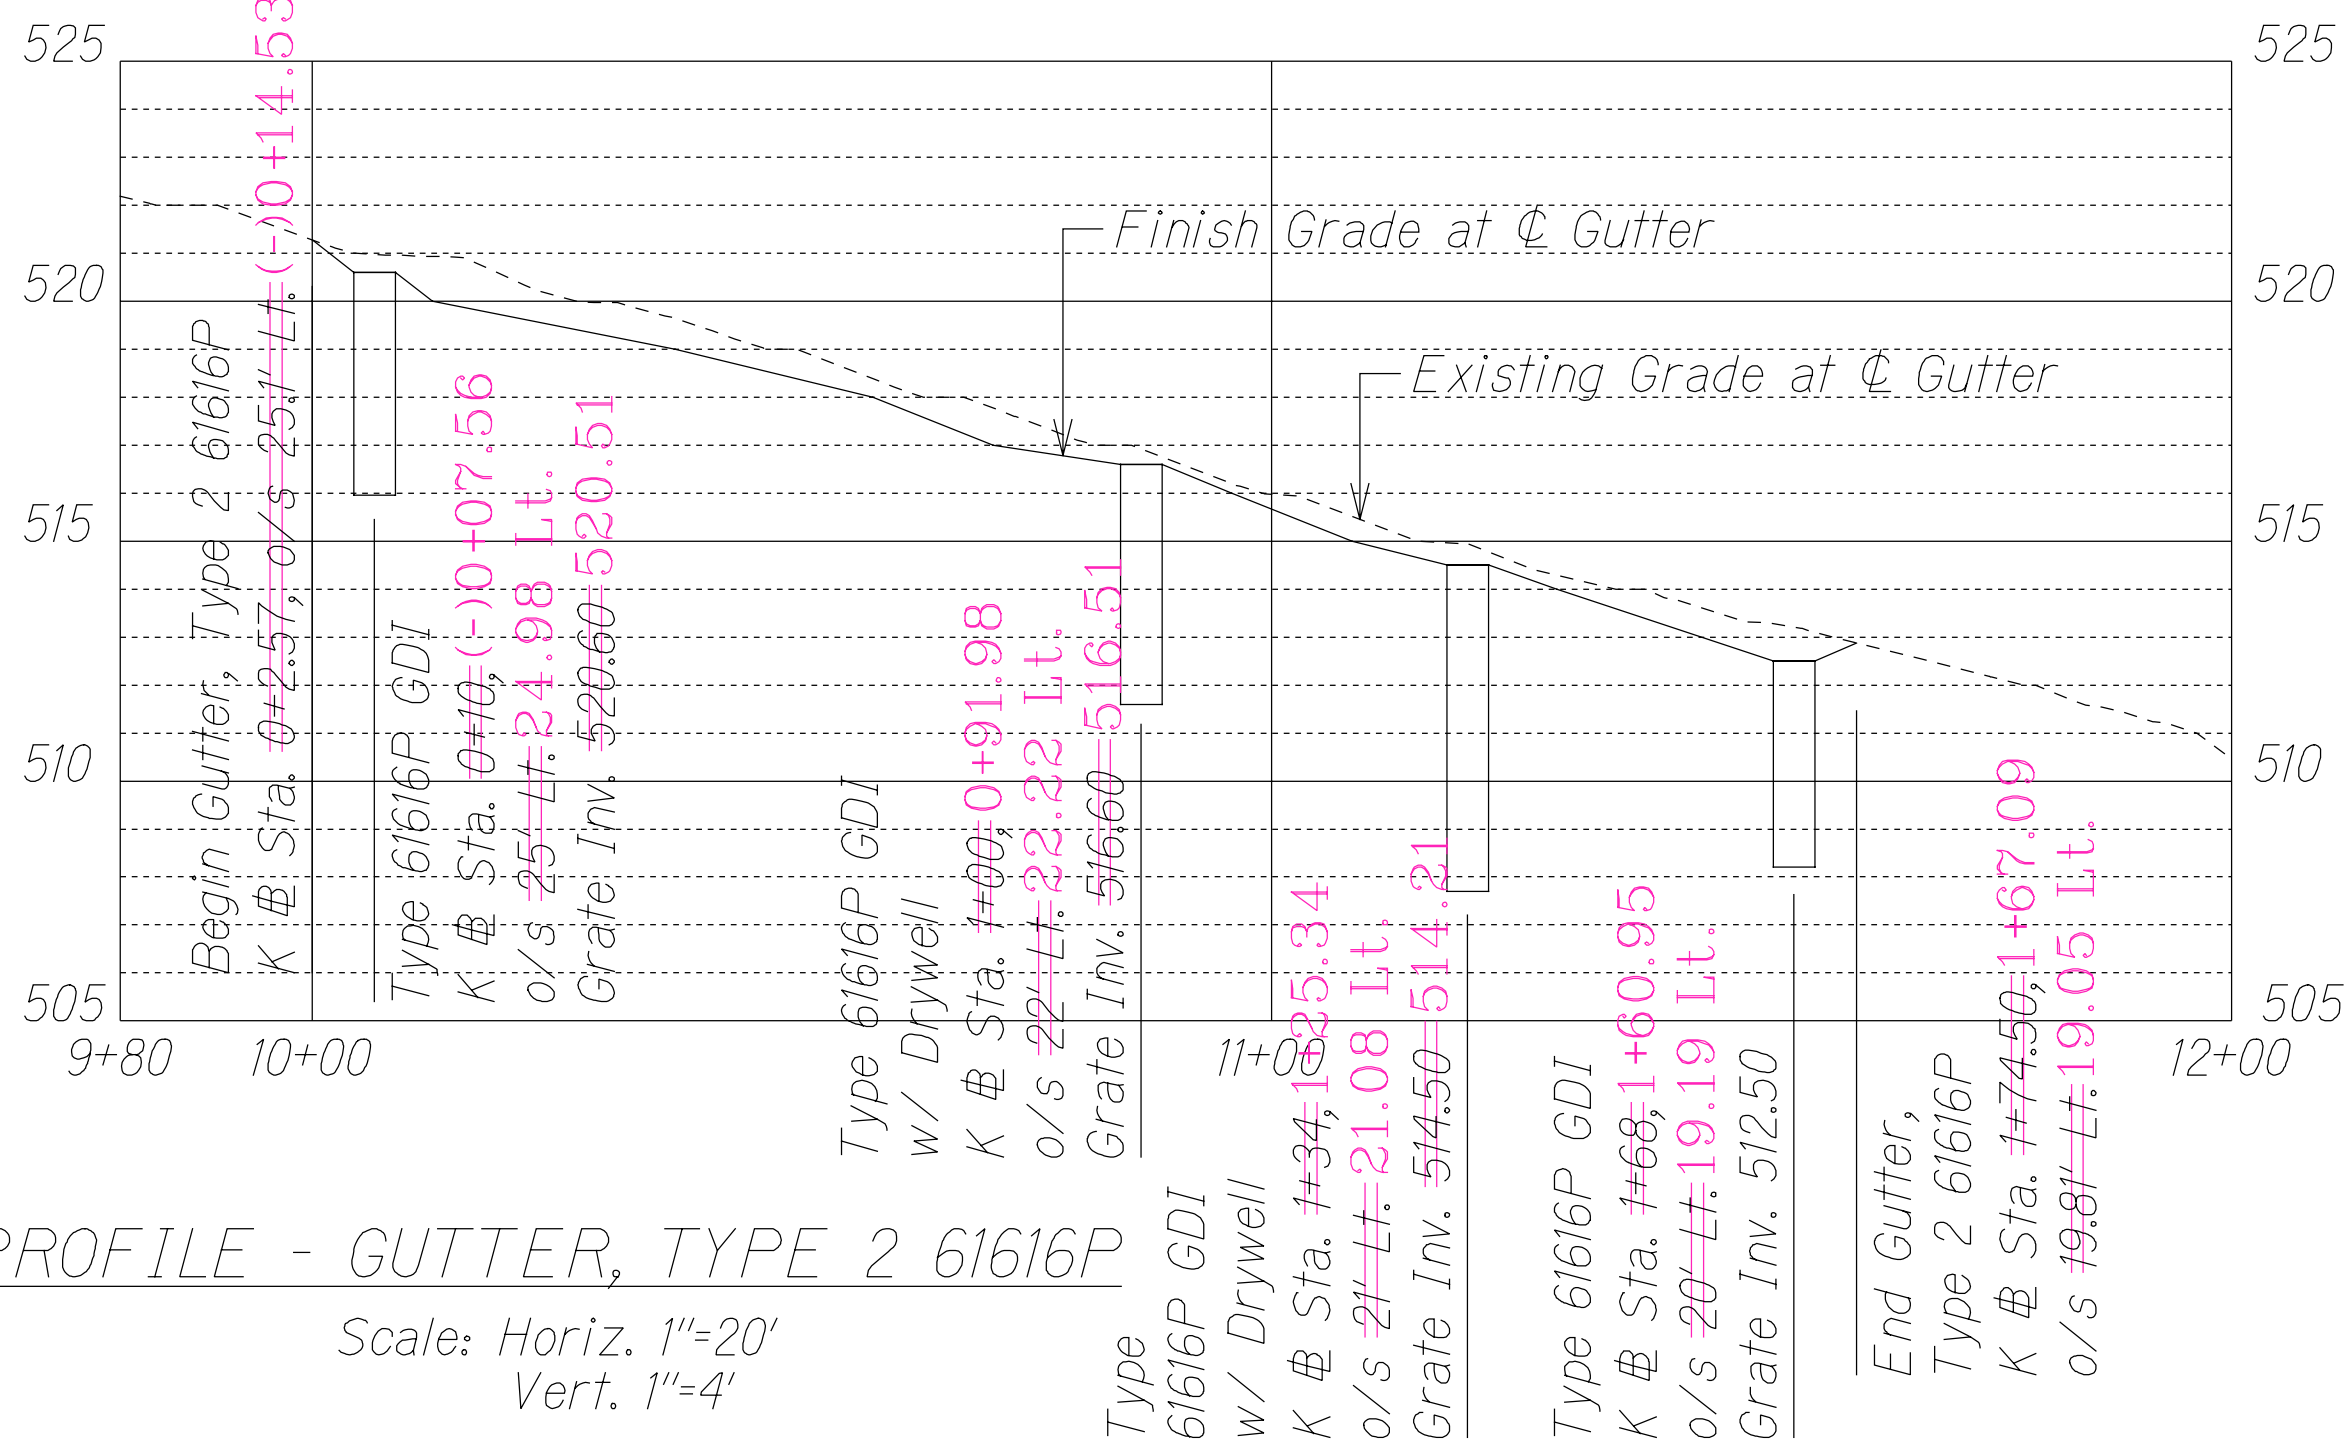

PROFILE - GUTTER, TYPE 2 61616P

Scale: Horiz. 1"=20'
Vert. 1"=4'

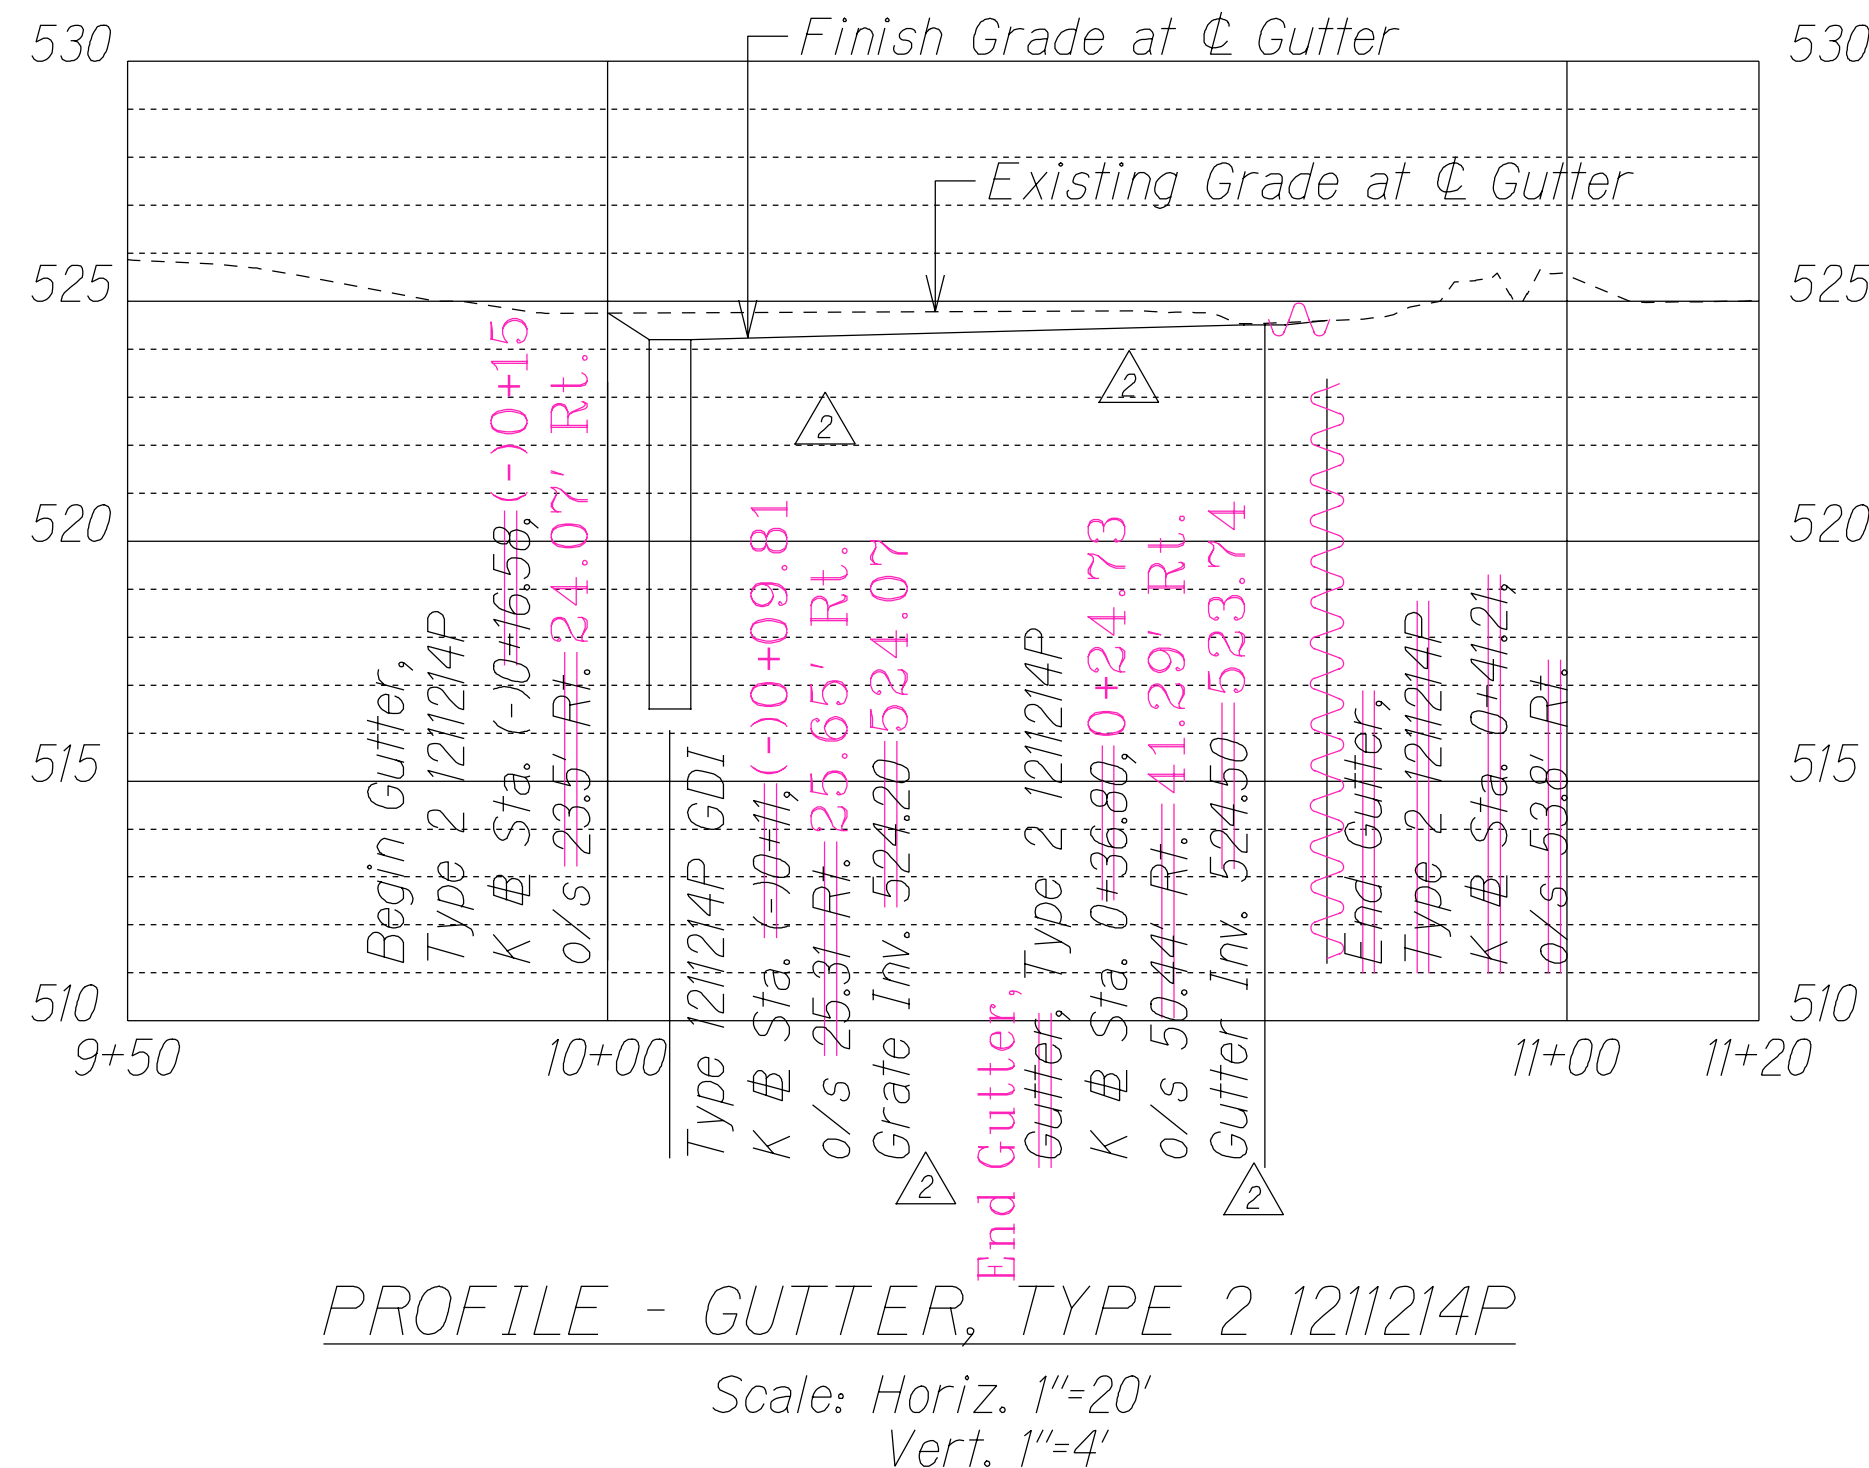

PROFILE - GUTTER, TYPE 2 1211214P


Scale: Horiz. 1"=20'
Vert. 1"=4'

LEGEND FOR AS-BUILT POSTINGS

Squiggly line for as-built deletion

Double line for as-built deletion

Text for as-built posting

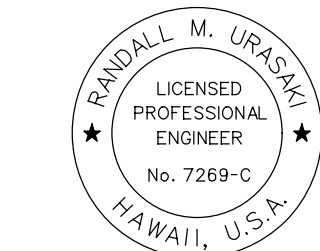

THIS WORK WAS PREPARED BY ME OR UNDER MY SUPERVISION.
SIGNATURE: *Randall M. Uraski* 04/30/22
EXPIRATION DATE OF THE LICENSE

STATE OF HAWAII
DEPARTMENT OF TRANSPORTATION
HIGHWAYS DIVISION

DRAINAGE PROFILE

KUAKINI HIGHWAY DRAINAGE IMPROVEMENTS
Vicinity of Mile Post 114
Project No. 11B-01-20

Scale: As Shown Date: Mar. 2021

SHEET No. P-6 OF 10 SHEETS

"AS-BUILT"

C.O. 23