


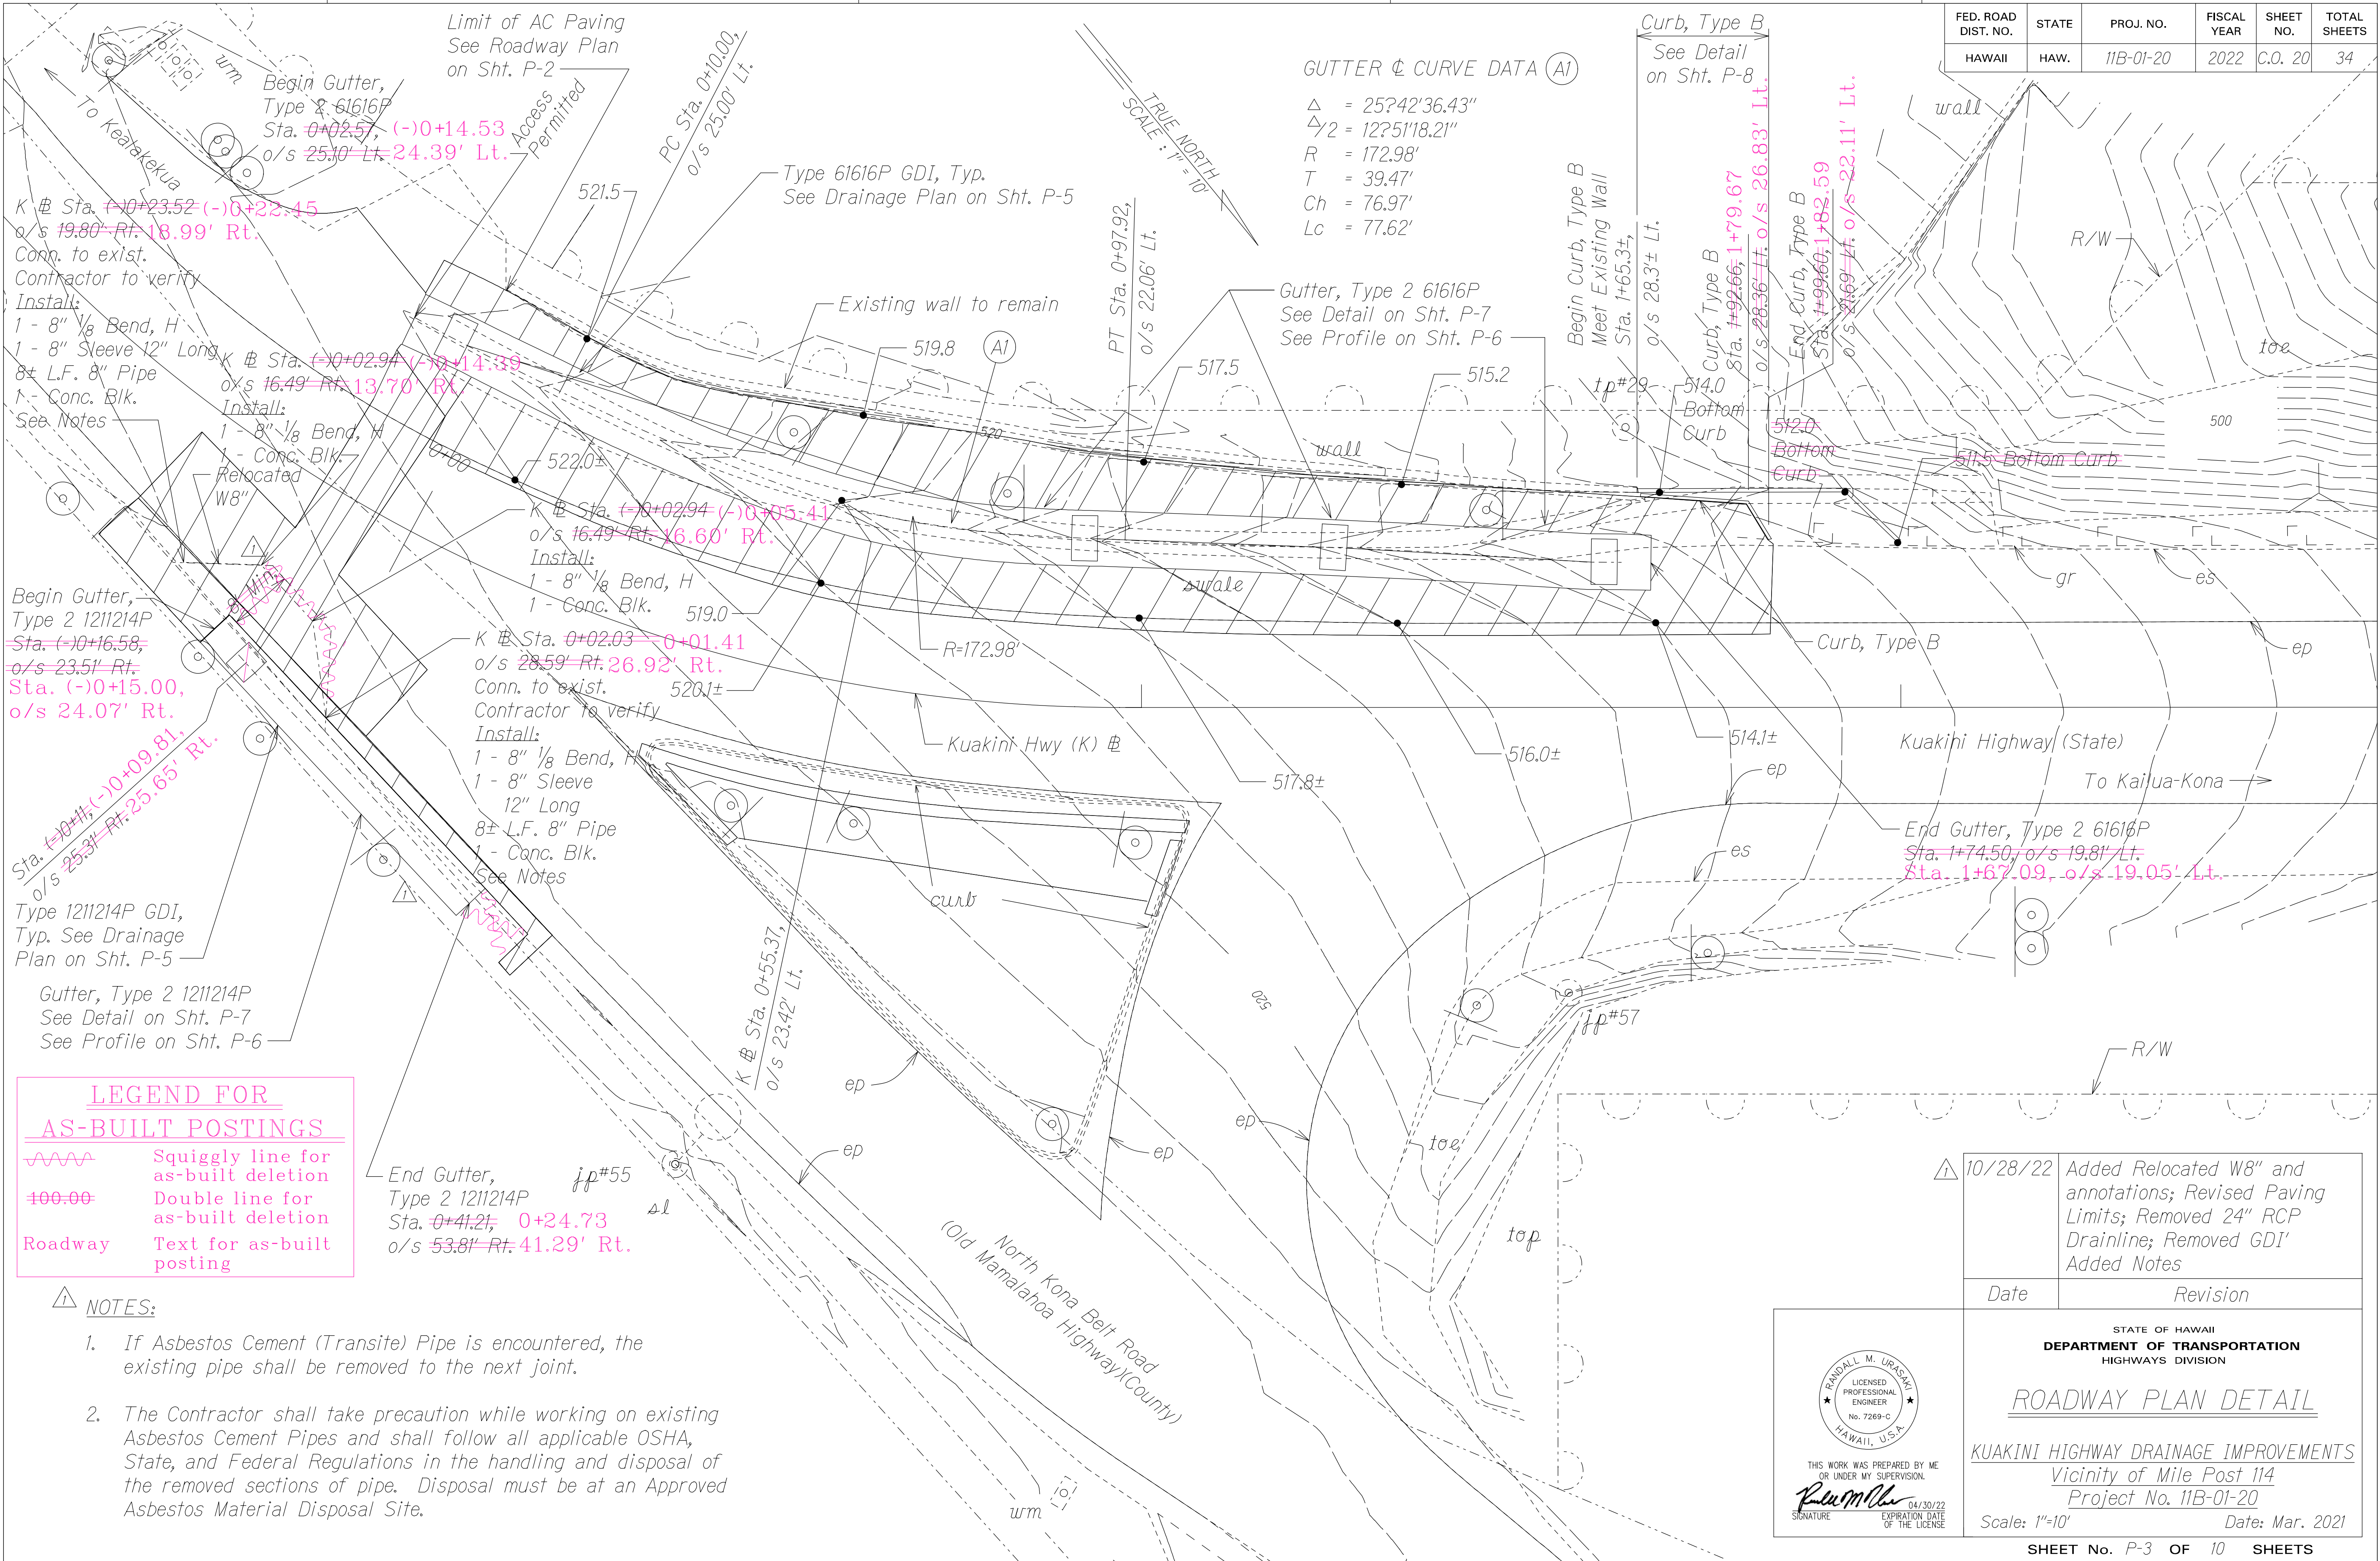

FED. ROAD DIST. NO.	STATE	PROJ. NO.	FISCAL YEAR	SHEET NO.	TOTAL SHEETS
HAWAII	HAW.	11B-01-20	2022	C.O. 20	34

LEGEND FOR
AS-BUILT POSTINGS

Squiggly line for as-built deletion

Double line for as-built deletion

Text for as-built posting

- NOTES:
1.

If Asbestos Cement (Transite) Pipe is encountered, the existing pipe shall be removed to the next joint.
2.

The Contractor shall take precaution while working on existing Asbestos Cement Pipes and shall follow all applicable OSHA, State, and Federal Regulations in the handling and disposal of the removed sections of pipe. Disposal must be at an Approved Asbestos Material Disposal Site.

GUTTER & CURVE DATA (A1)

Δ	= 25°42'36.43"
$\Delta/2$	= 12°51'18.21"
R	= 172.98'
T	= 39.47'
Ch	= 76.97'
Lc	= 77.62'

RANDALL M. URASAKI

LICENSED PROFESSIONAL ENGINEER

No. 7269-C

HAWAII, U.S.A.

THIS WORK WAS PREPARED BY ME OR UNDER MY SUPERVISION.

SIGNATURE

04/30/22

EXPIRATION DATE OF THE LICENSE

10/28/22	Added Relocated W8" and annotations; Revised Paving Limits; Removed 24" RCP Drainline; Removed GDI' Added Notes
Date	Revision

STATE OF HAWAII
DEPARTMENT OF TRANSPORTATION
HIGHWAYS DIVISION

ROADWAY PLAN DETAIL

KUAKINI HIGHWAY DRAINAGE IMPROVEMENTS
Vicinity of Mile Post 114
Project No. 11B-01-20

Scale: 1"=10'

Date: Mar. 2021

SHEET No. P-3 OF 10 SHEETS

"AS-BUILT"

C.O. 20