

INDEX TO DRAWINGS	
SHEET NO.	DESCRIPTION
1	TITLE SHEET
2	STANDARD PLANS SUMMARY
3	TYPICAL SECTIONS & DETAILS
4-6	ROADWAY RECONSTRUCTION PLANS
* 7-9	MISC. ROADWAY DETAILS

* NOTE:
 PLAN SHT. NO. 7 DELETED
 DURING "AS-BUILT" POSTING

STATE OF HAWAII

DEPARTMENT OF TRANSPORTATION

HIGHWAYS DIVISION

"AS-BUILT"

PLANS FOR

HAWAII BELT ROAD RESURFACING

KEALIA TO PAHOEHOE


PROJ. NO. IIBC-01-89M

DISTRICT OF SOUTH KONA




ISLAND OF HAWAII

CONTRACT NO.: 25838

CONTRACTOR: GRACE PACIFIC CORP.

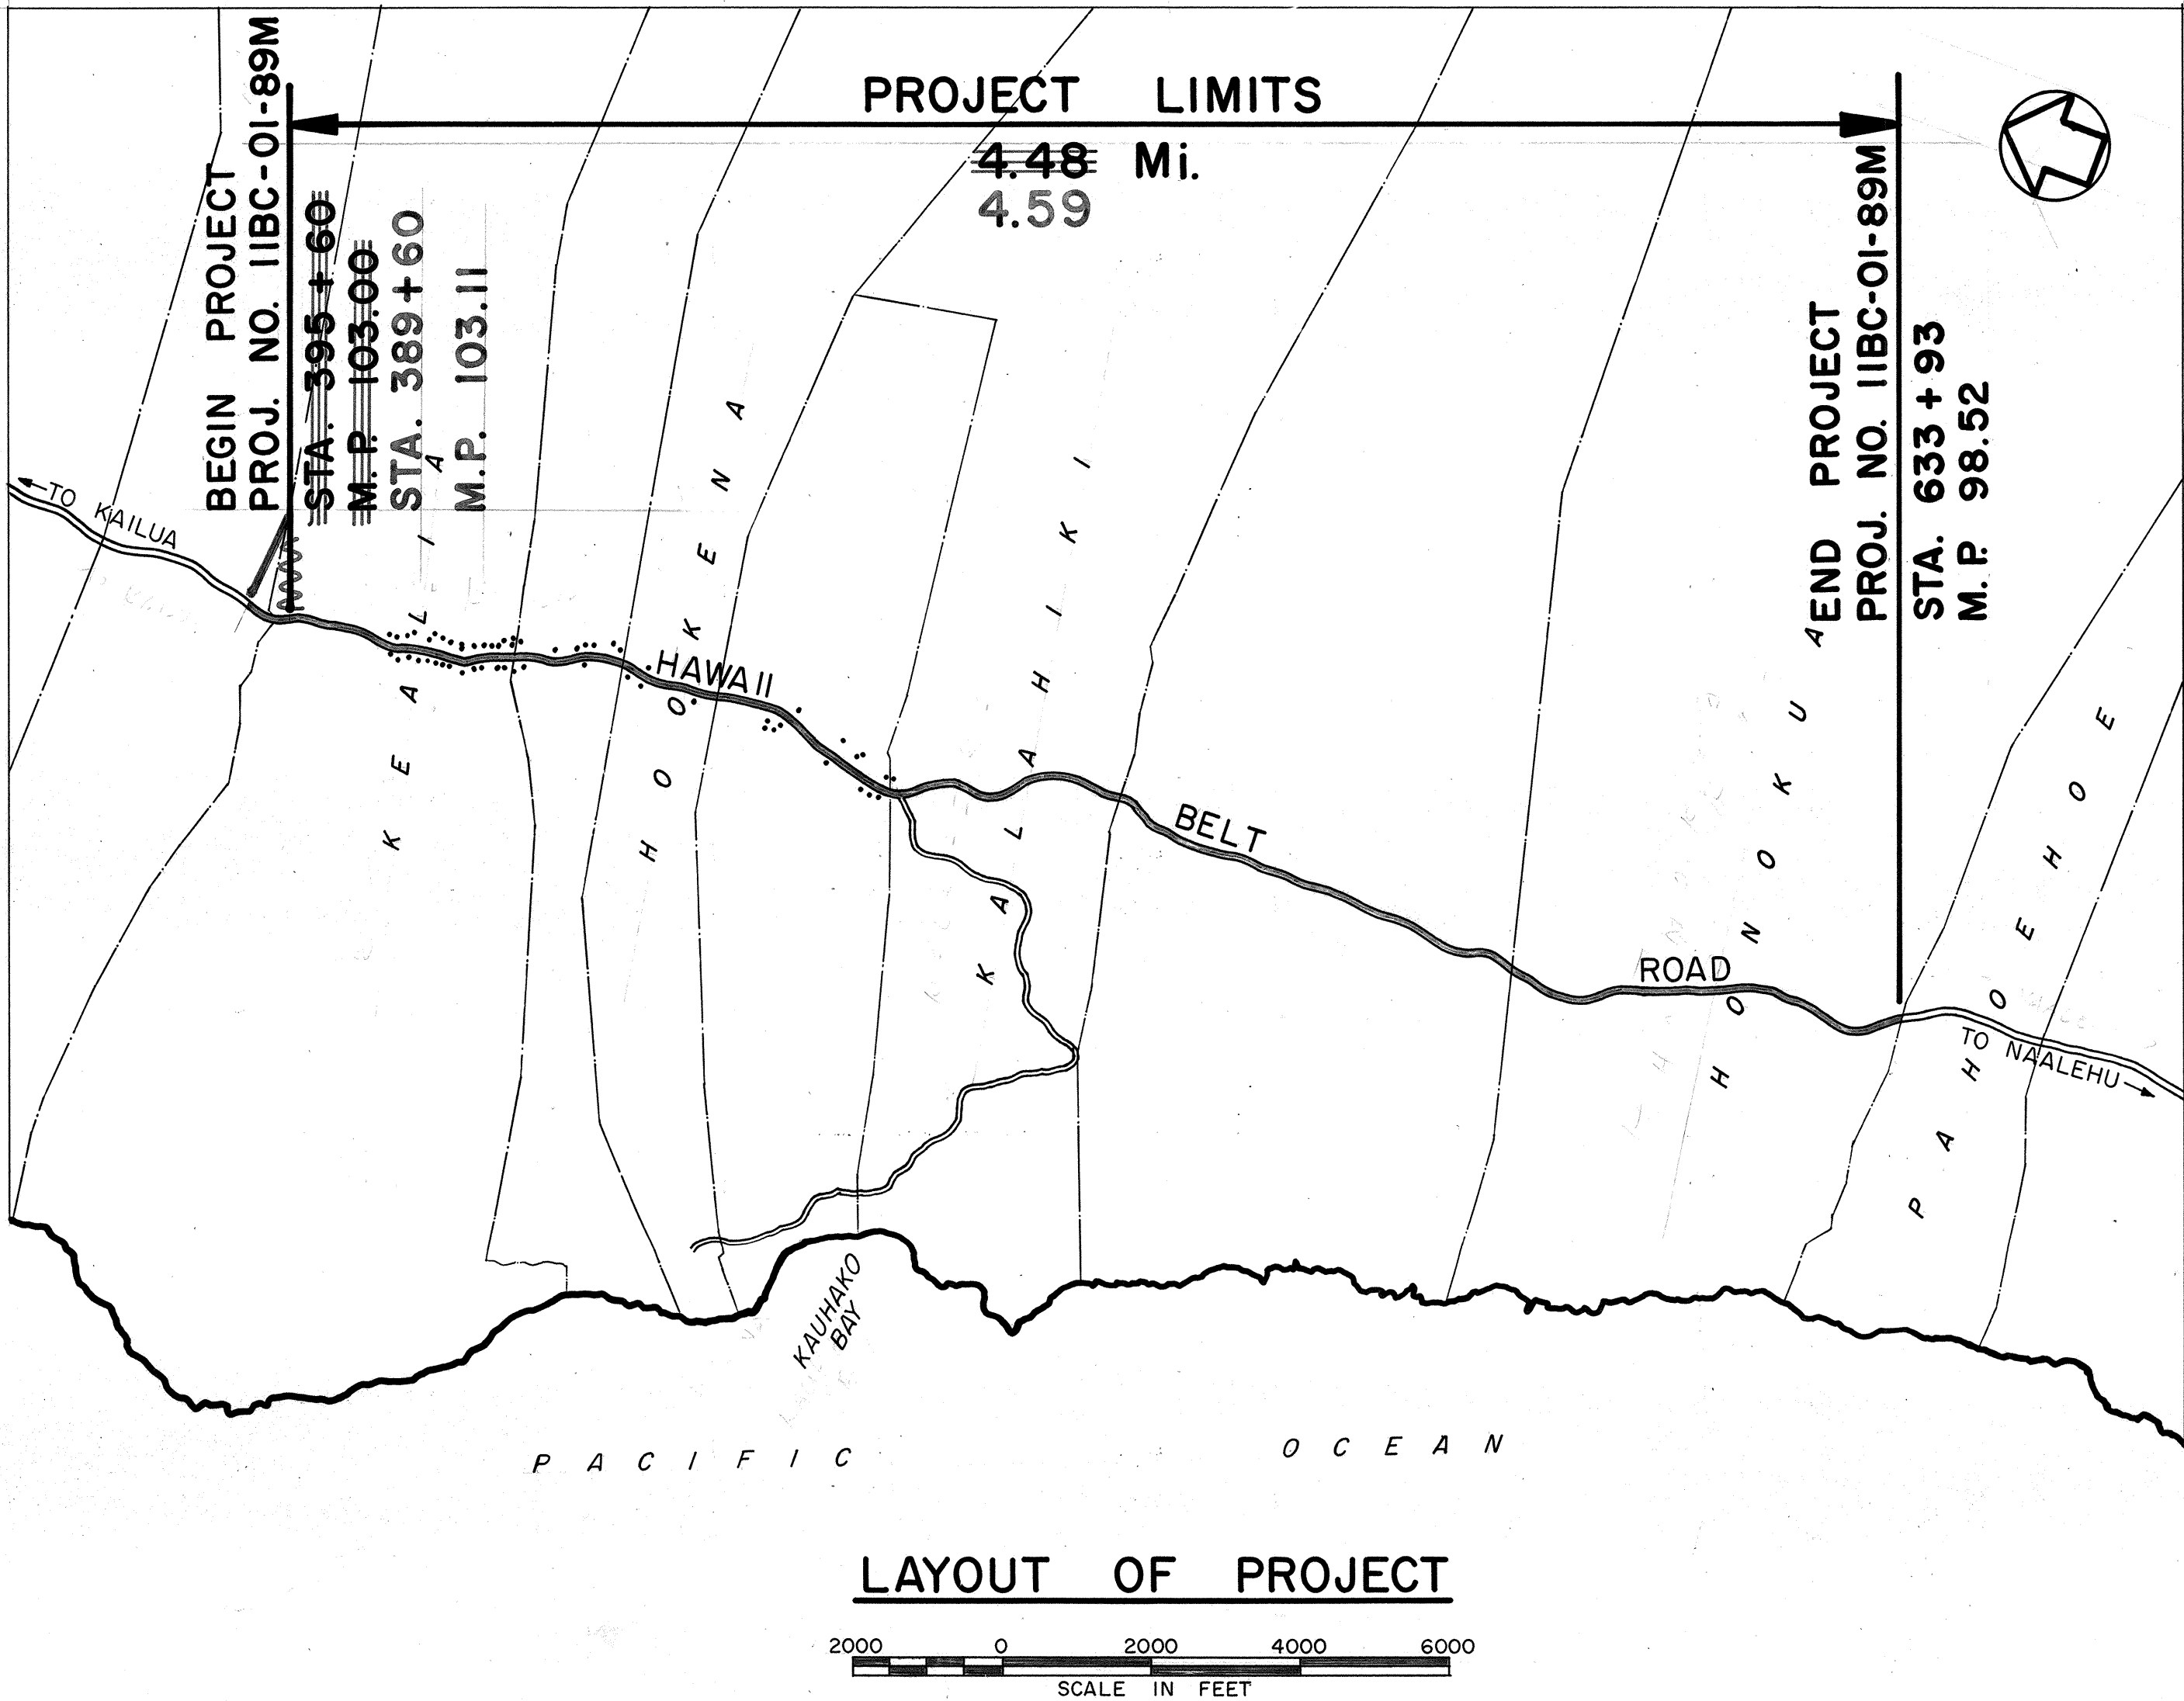

FED. ROAD DIST. NO.	STATE	PROJ. NO.	FISCAL YEAR	SHEET NO.	TOTAL SHEETS
HAWAII	HAW.	IIBC-01-89M	1989	1	9

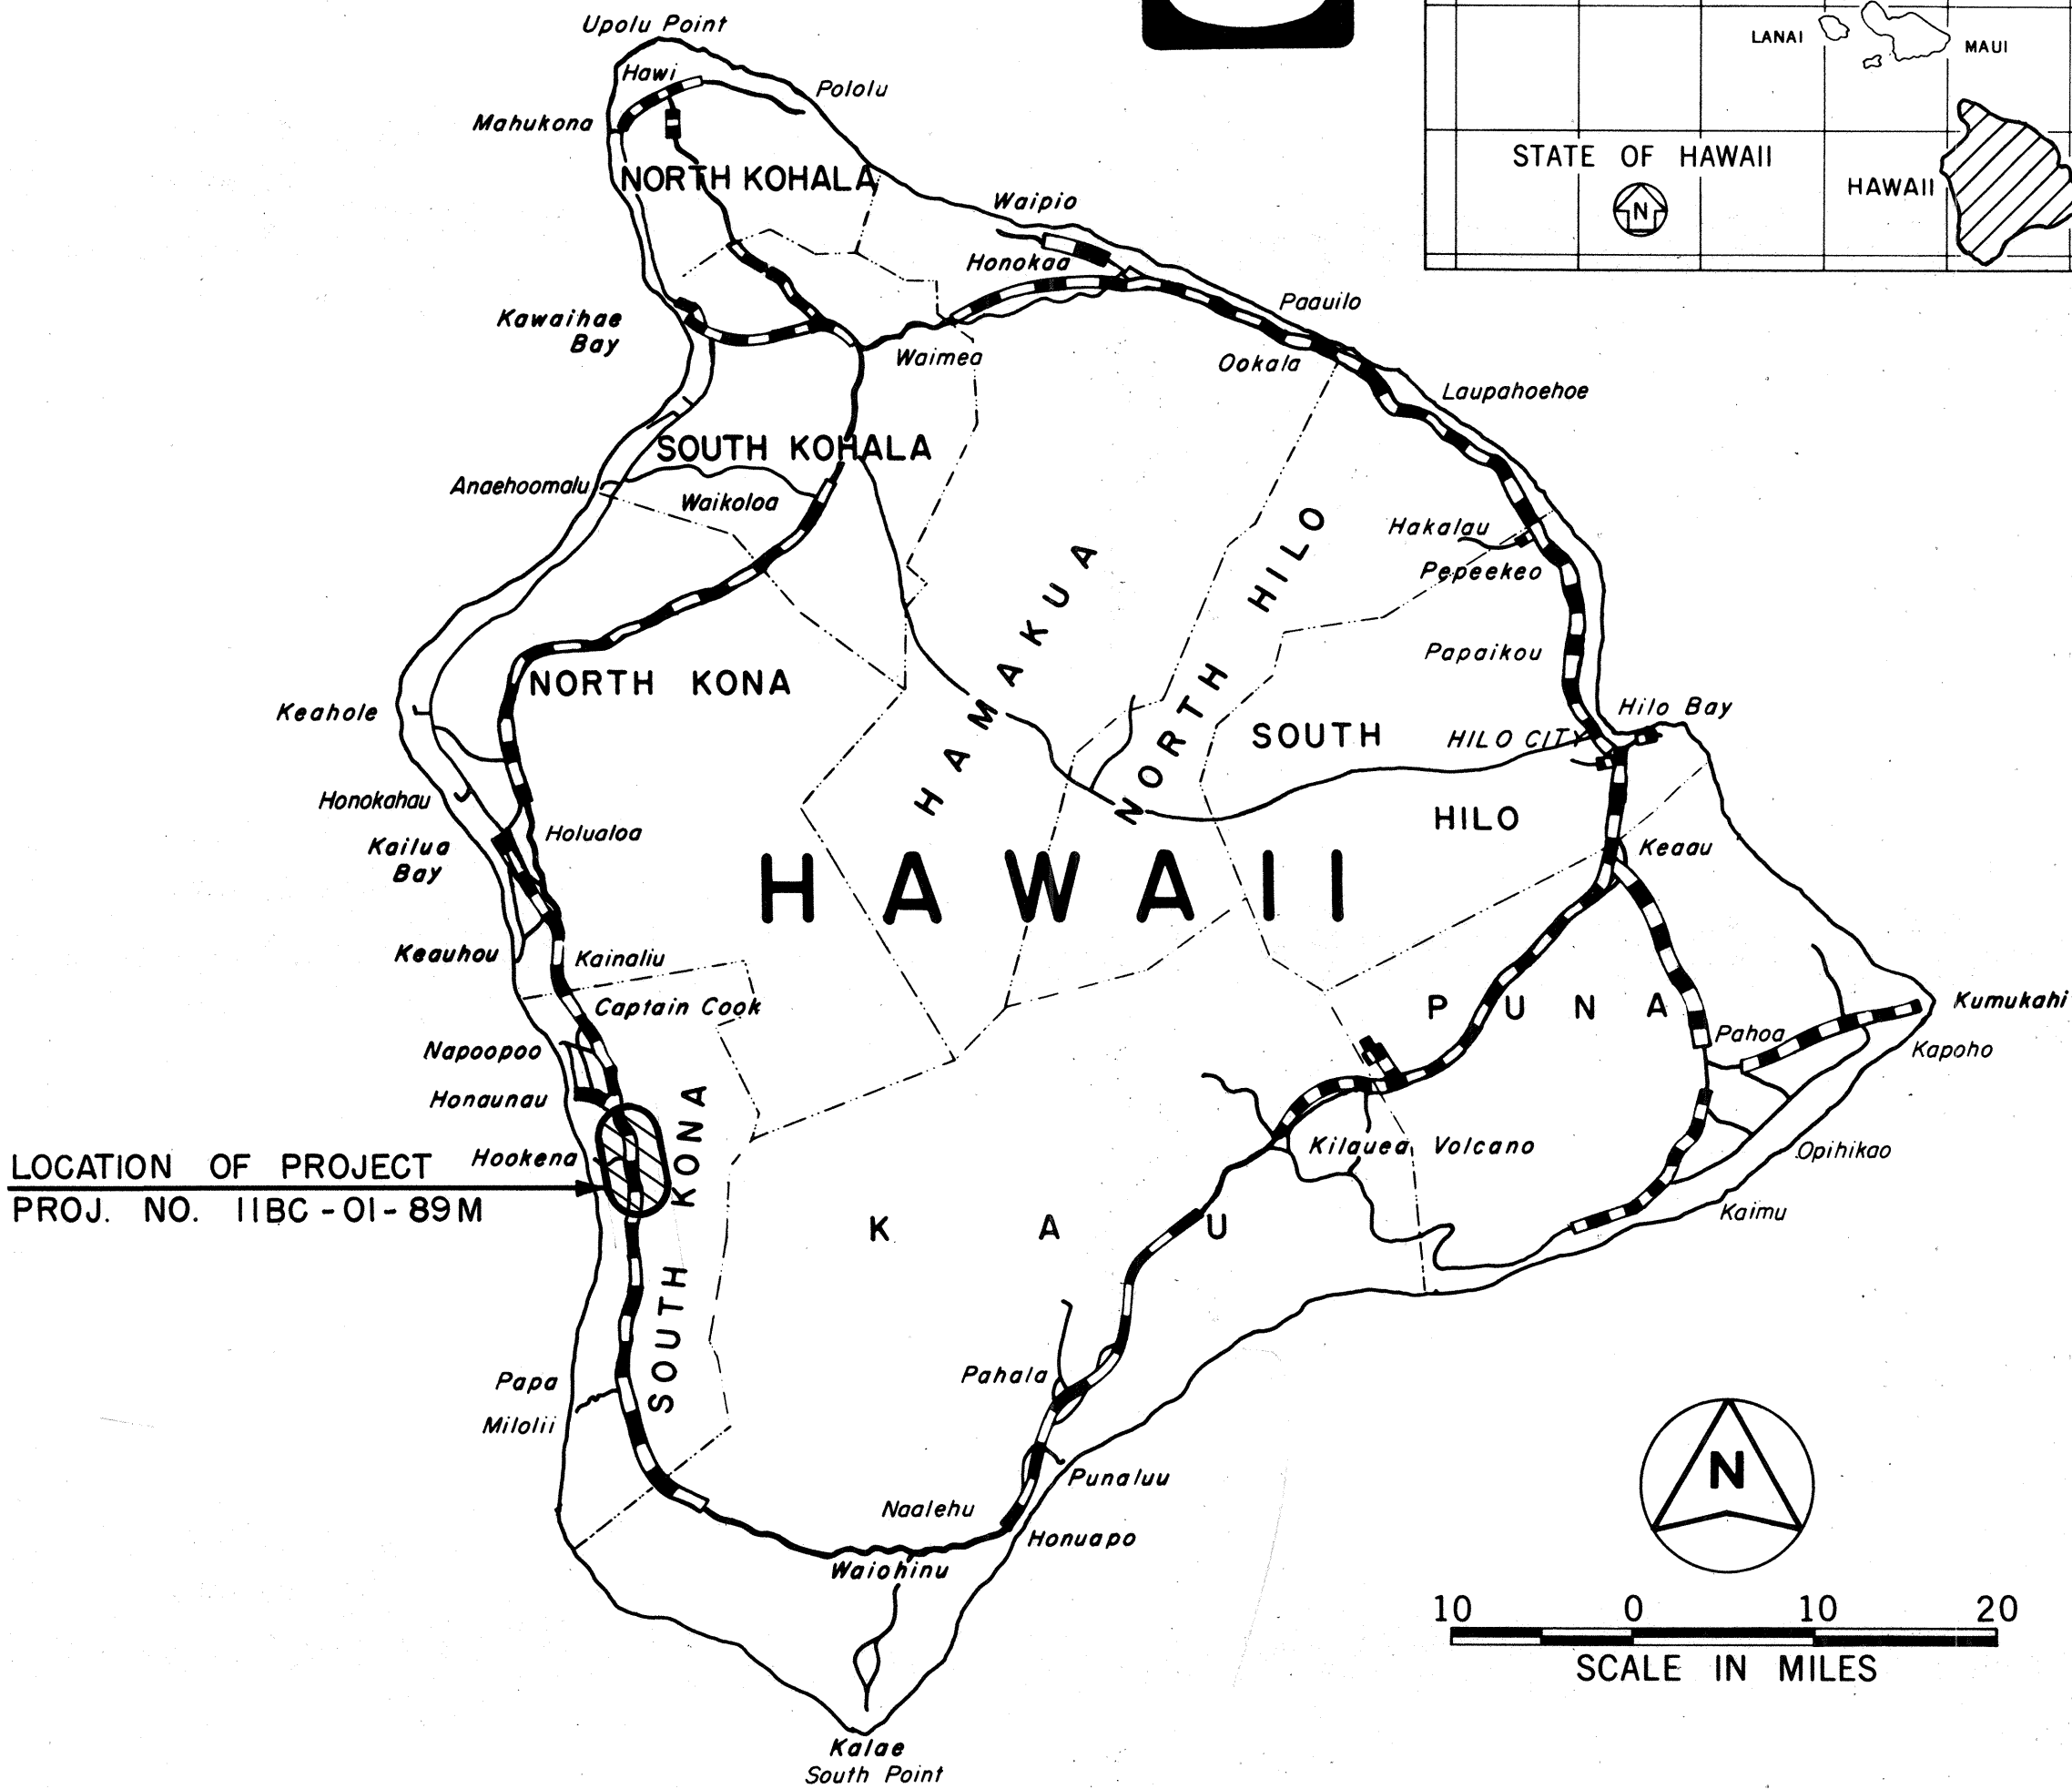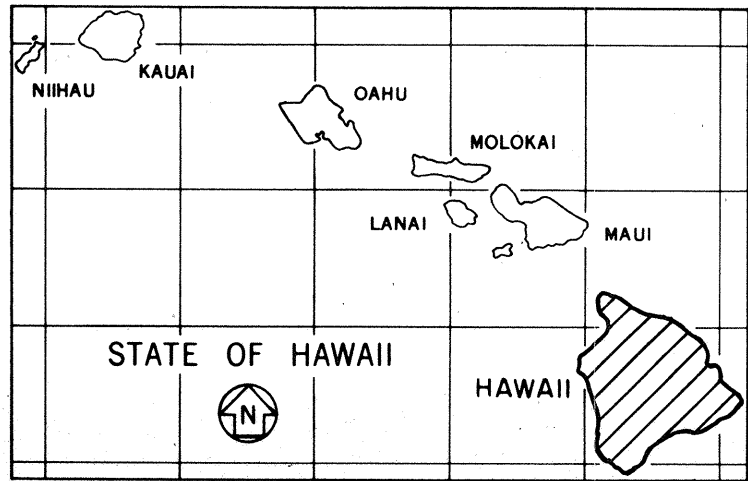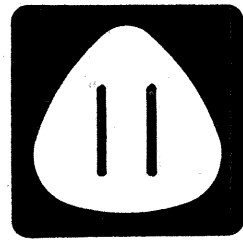

FEDERAL AID PROJECTS PREVIOUSLY CONSTRUCTED
 OR UNDER CONSTRUCTION

CHANGES MADE DURING CONSTRUCTION HAVE
 BEEN INCORPORATED ON THESE PLANS EXCEPT
 CHANGES IN THE ORIGINAL THEORETICAL
 QUANTITIES. FOR ACTUAL QUANTITIES, REFER TO
 PROJECT LEDGER AND/OR COMPUTATION BOOK.

Robert W. Lee, Jr.
 RESIDENT ENGINEER

6/6/90
 DATE

DEPARTMENT OF TRANSPORTATION STATE OF HAWAII	
APPROVED:	
Edmund J. Smith	2/14/89
DIR. OF TRANSPORTATION	DATE

HAWAII DISTRICT
 DESIGNED BY

ALVIN TAKESHITA
 P. S. & E. BY

548-7537
 PHONE

JANUARY, 1989
 DATE