


FED. ROAD DIST. NO.	STATE	PROJ. NO.	FISCAL YEAR	SHEET NO.	TOTAL SHEETS
HAWAII	HAW.	11A-01-89	1989	5	6

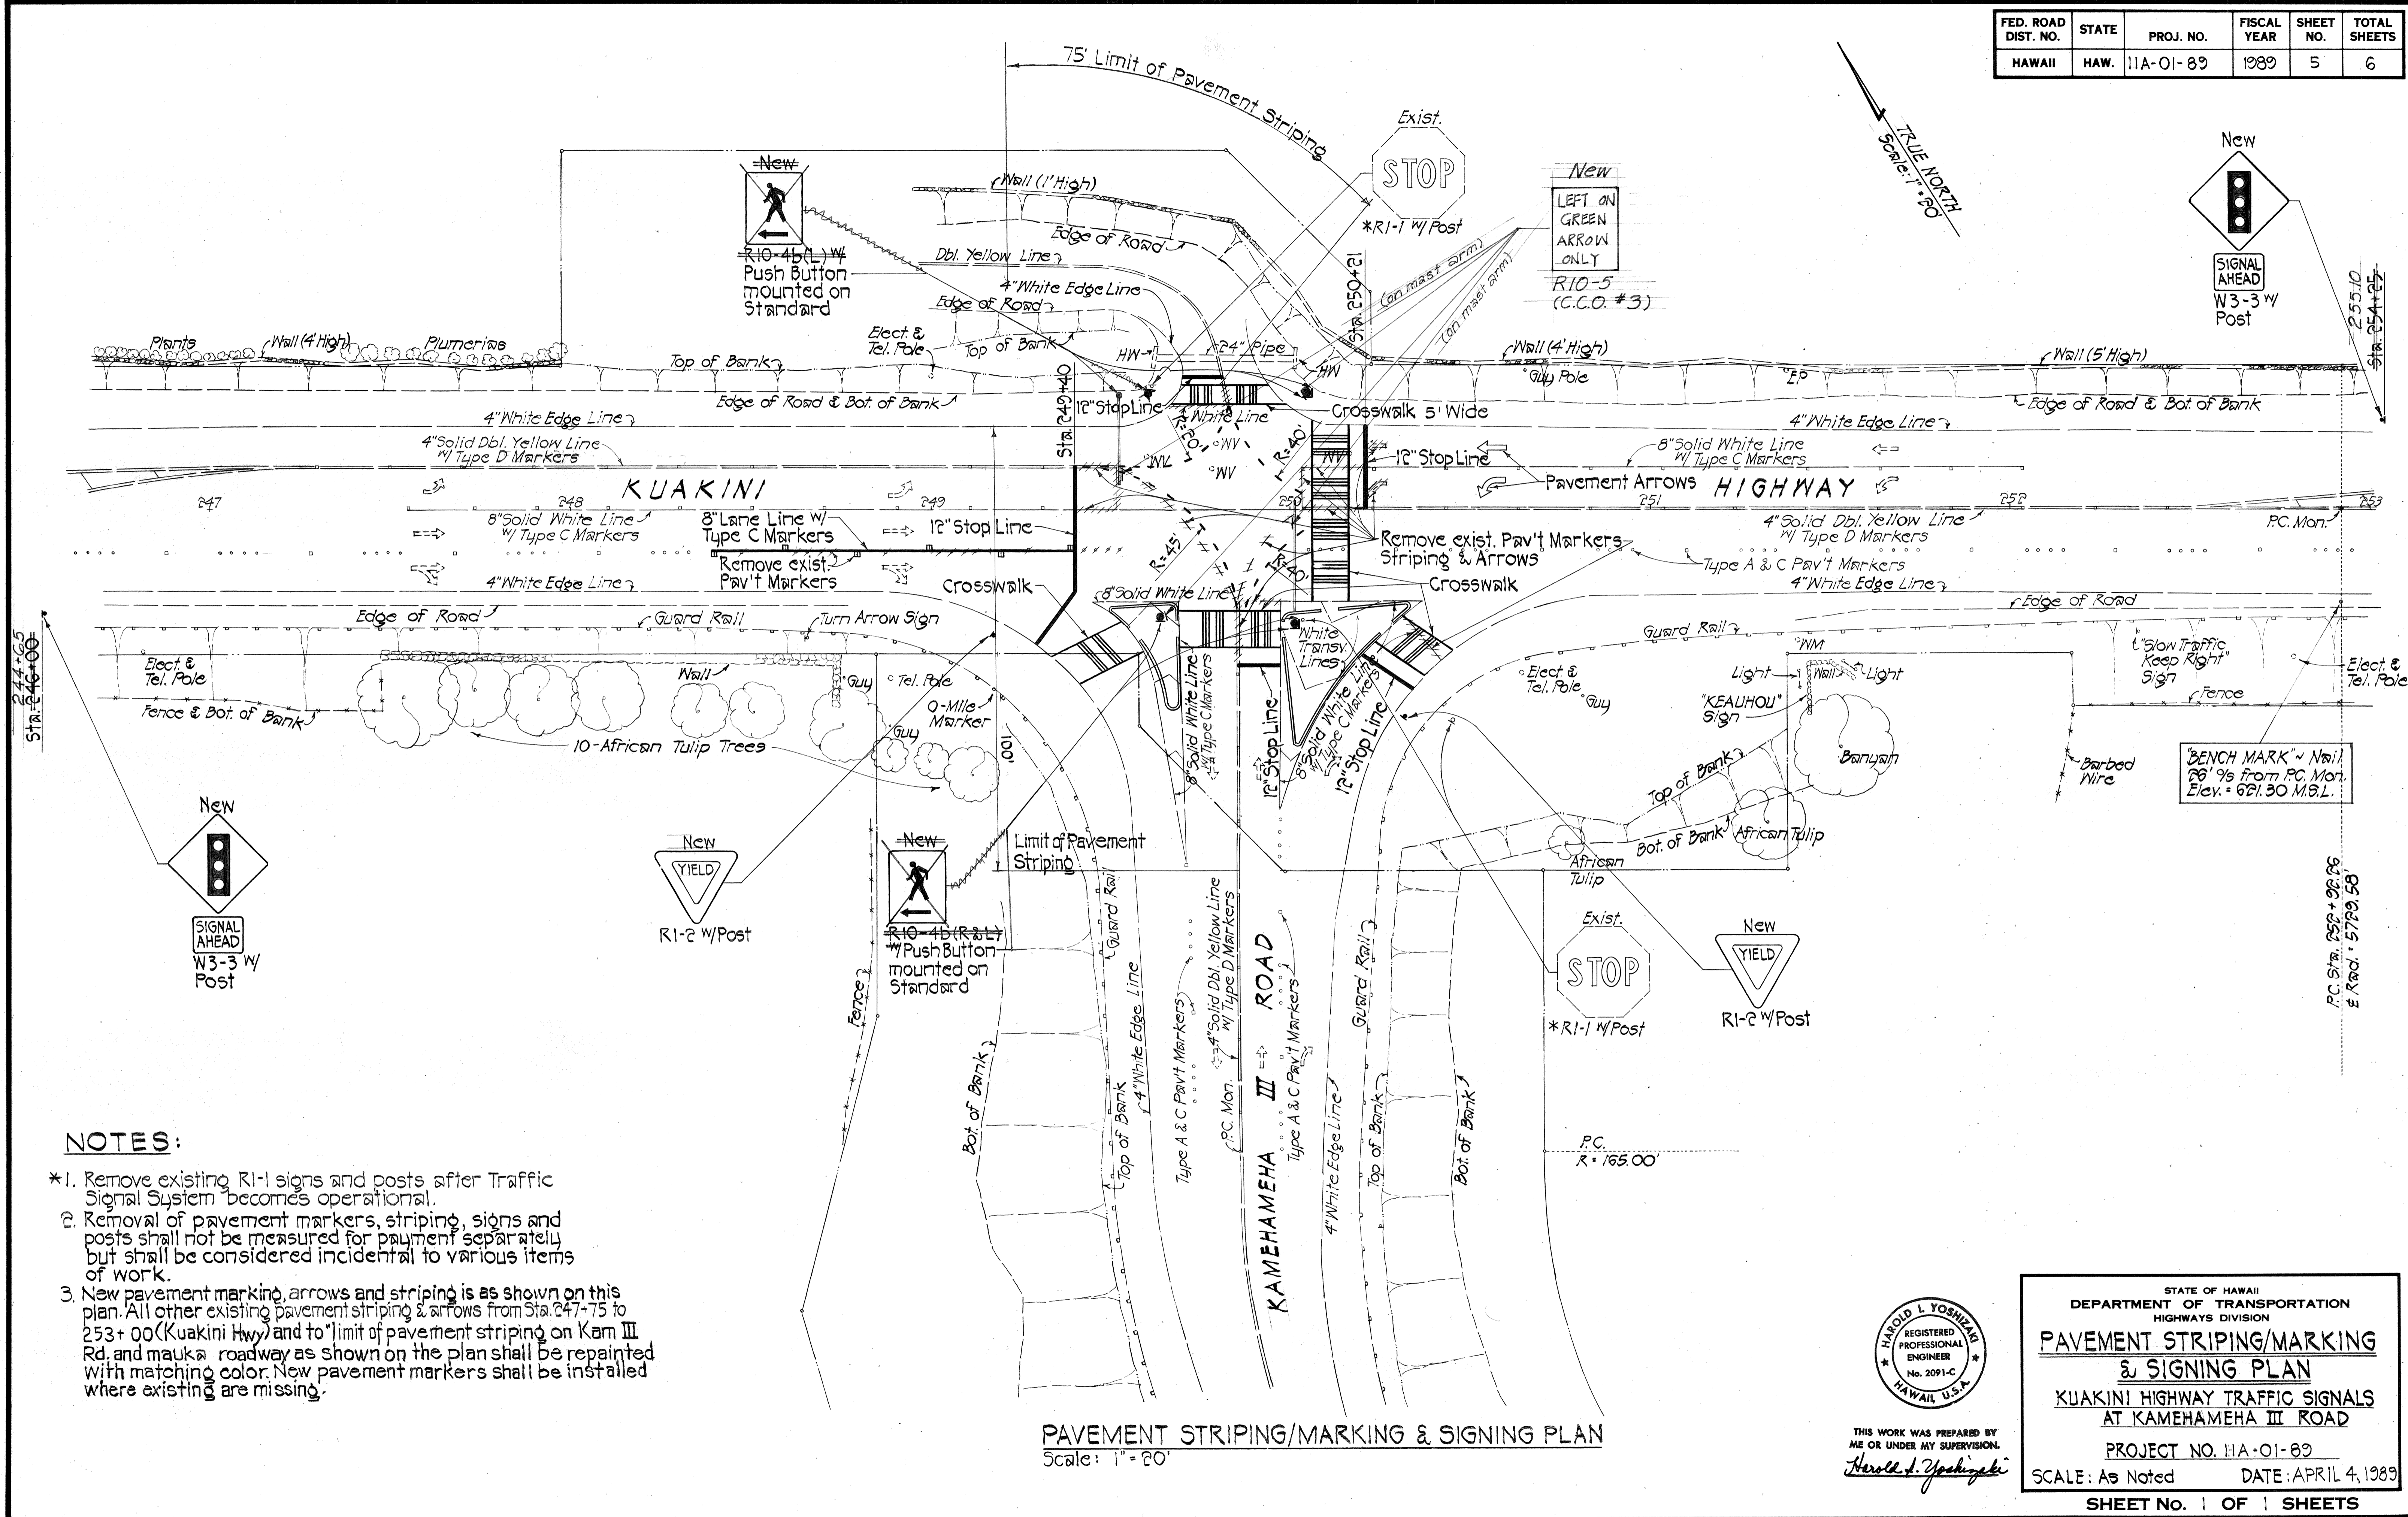


NOTES:

- *1. Remove existing R1-1 signs and posts after Traffic Signal System becomes operational.
2. Removal of pavement markers, striping, signs and posts shall not be measured for payment separately but shall be considered incidental to various items of work.
3. New pavement marking, arrows and striping is as shown on this plan. All other existing pavement striping & arrows from Sta. 247+75 to 253+00 (Kuakini Hwy) and to "limit of pavement striping on Kam III Rd. and mauka roadway as shown on the plan shall be repainted with matching color. New pavement markers shall be installed where existing are missing.

DATE	_____
DESIGNED BY	_____
DRAWN BY	_____
CHECKED BY	_____
NO.	_____

PAVEMENT STRIPING/MARKING & SIGNING PLAN
Scale: 1" = 20'

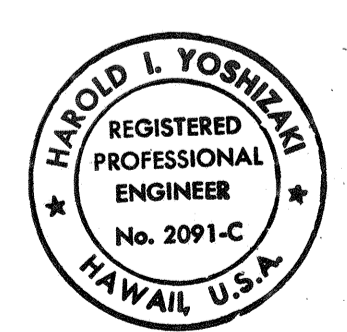

THIS WORK WAS PREPARED BY ME OR UNDER MY SUPERVISION.
Harold I. Yoshizaki

STATE OF HAWAII
DEPARTMENT OF TRANSPORTATION
HIGHWAYS DIVISION

PAVEMENT STRIPING/MARKING & SIGNING PLAN

KUAKINI HIGHWAY TRAFFIC SIGNALS
AT KAMEHAMEHA III ROAD

PROJECT NO. 11A-01-89
SCALE: As Noted DATE: APRIL 4, 1989

SHEET No. 1 OF 1 SHEETS