

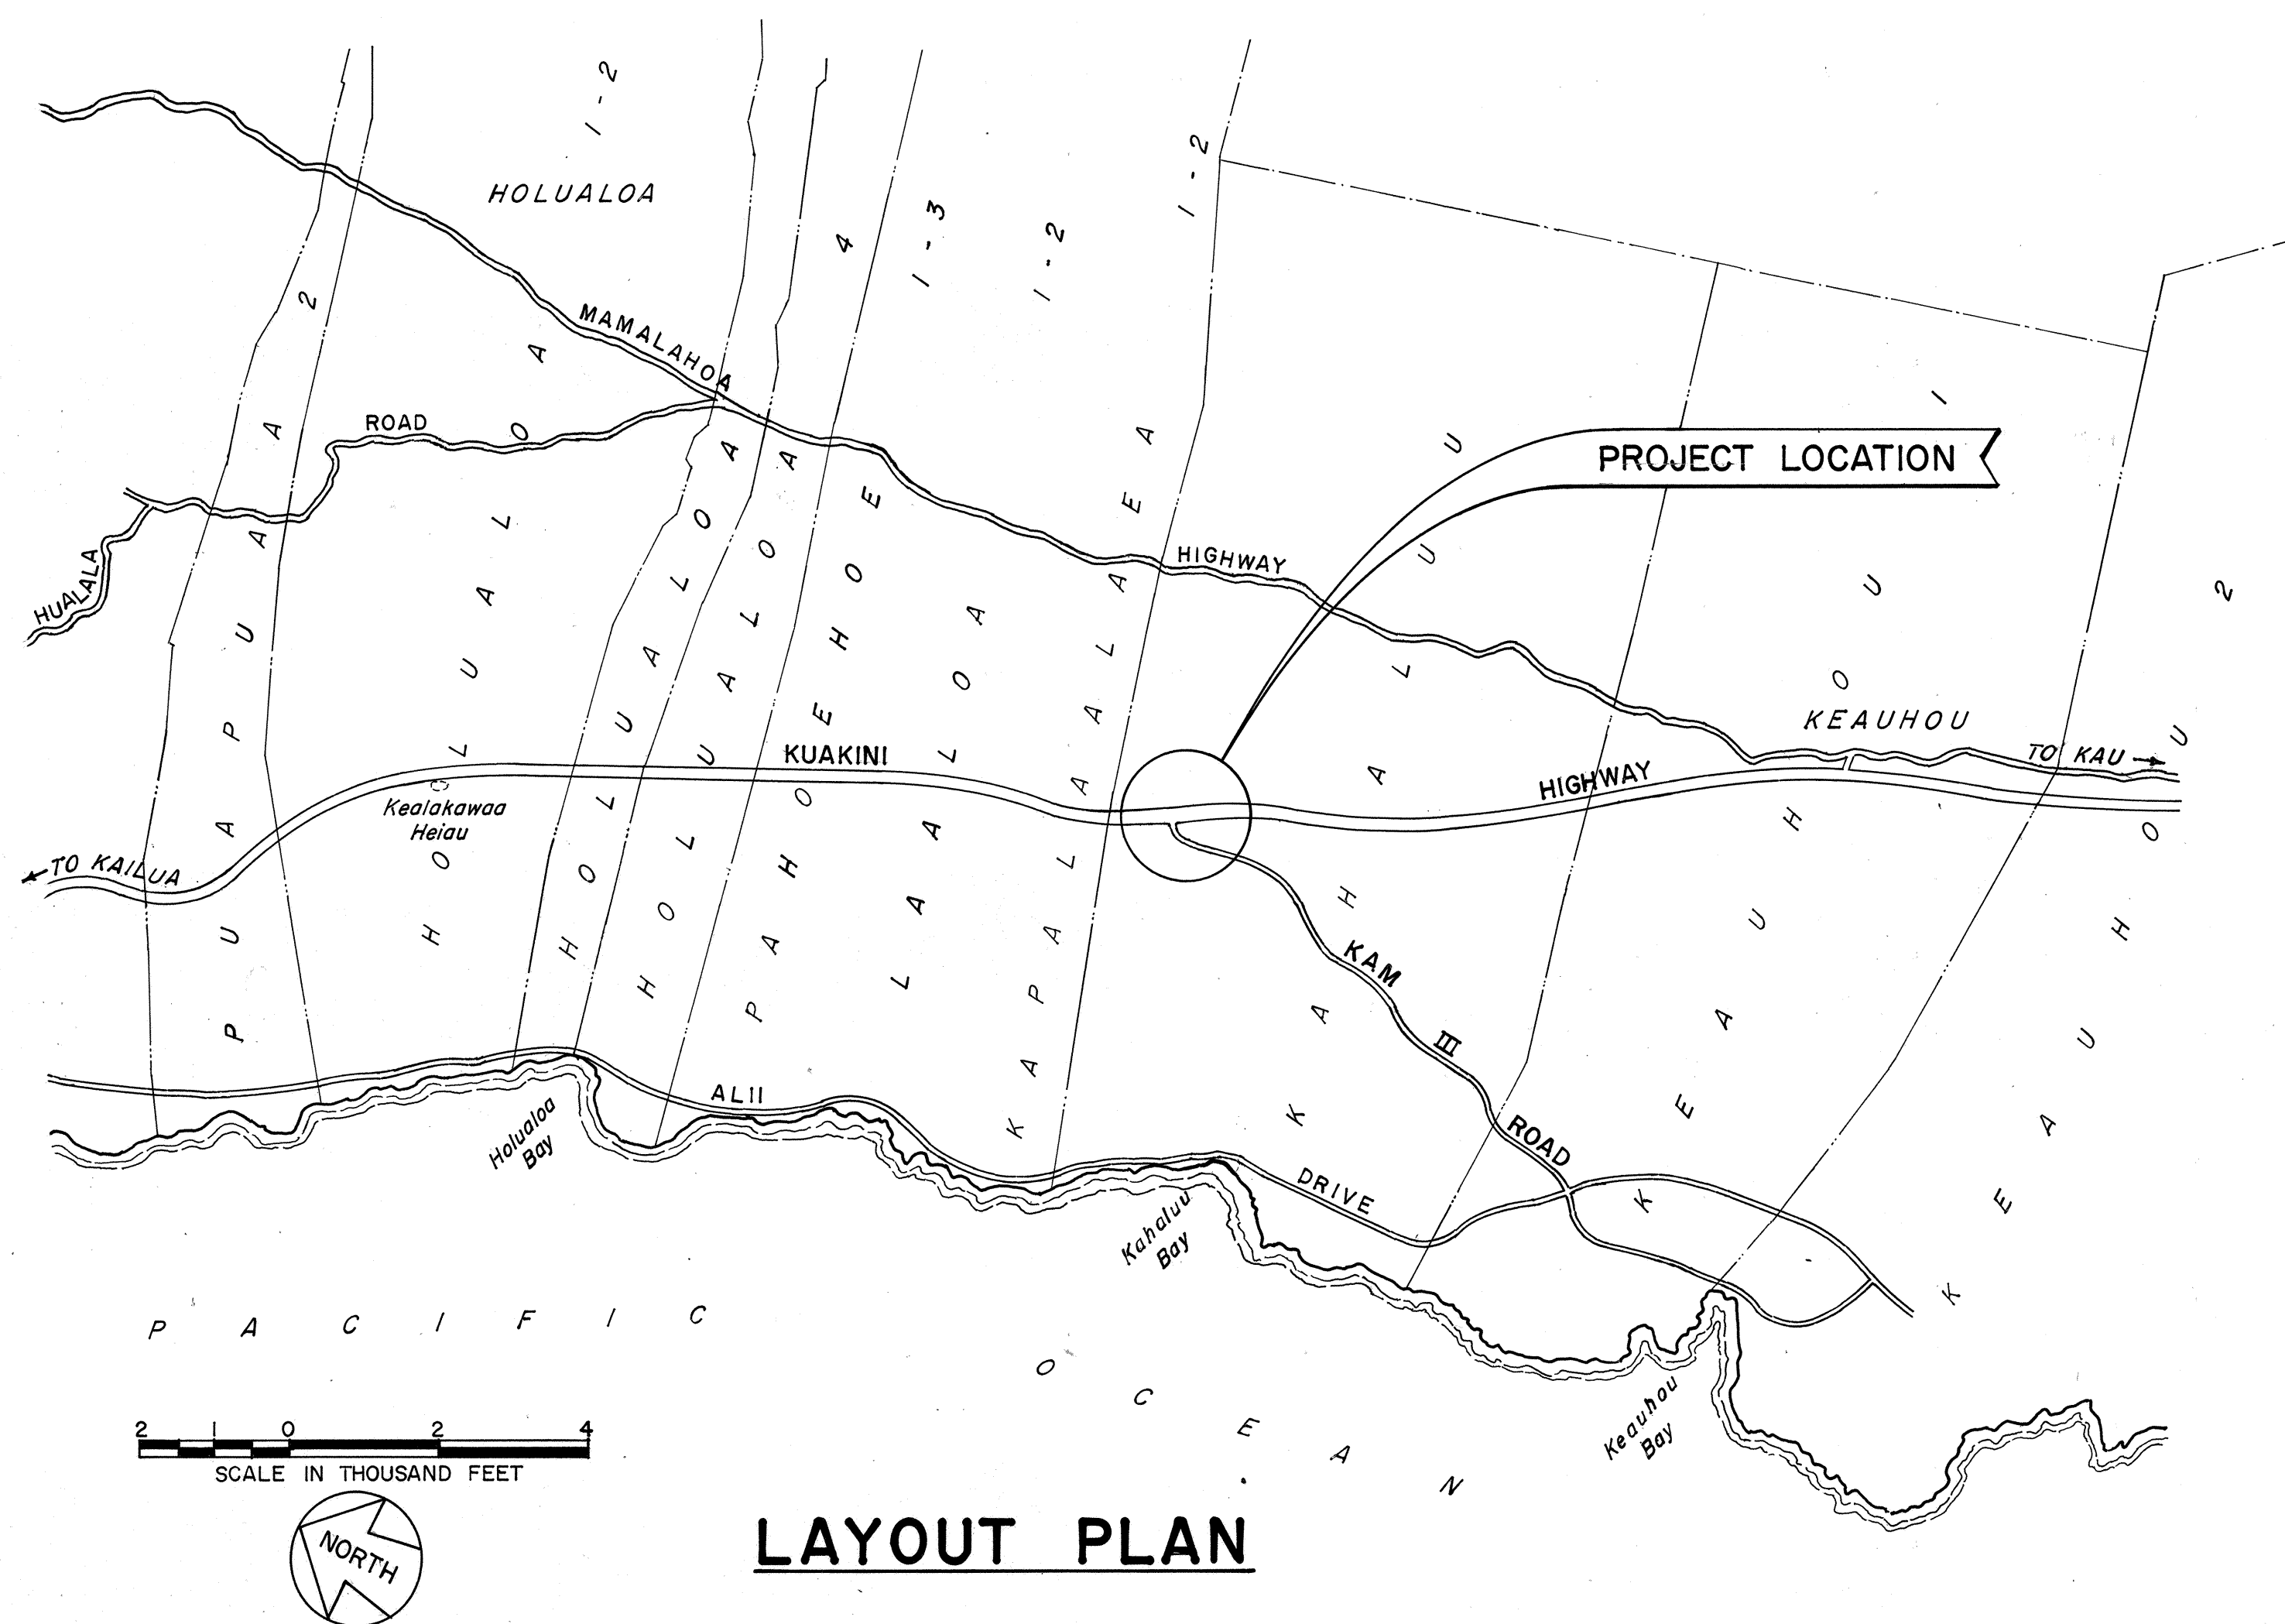


[illegible]

STATE OF HAWAII
DEPARTMENT OF TRANSPORTATION
HIGHWAYS DIVISION
HONOLULU, HAWAII
"AS-BUILT"
PLANS FOR
KUAKINI HIGHWAY TRAFFIC SIGNALS
AT KAMEHAMEHA III ROAD
PROJECT NO. IIA-01-89

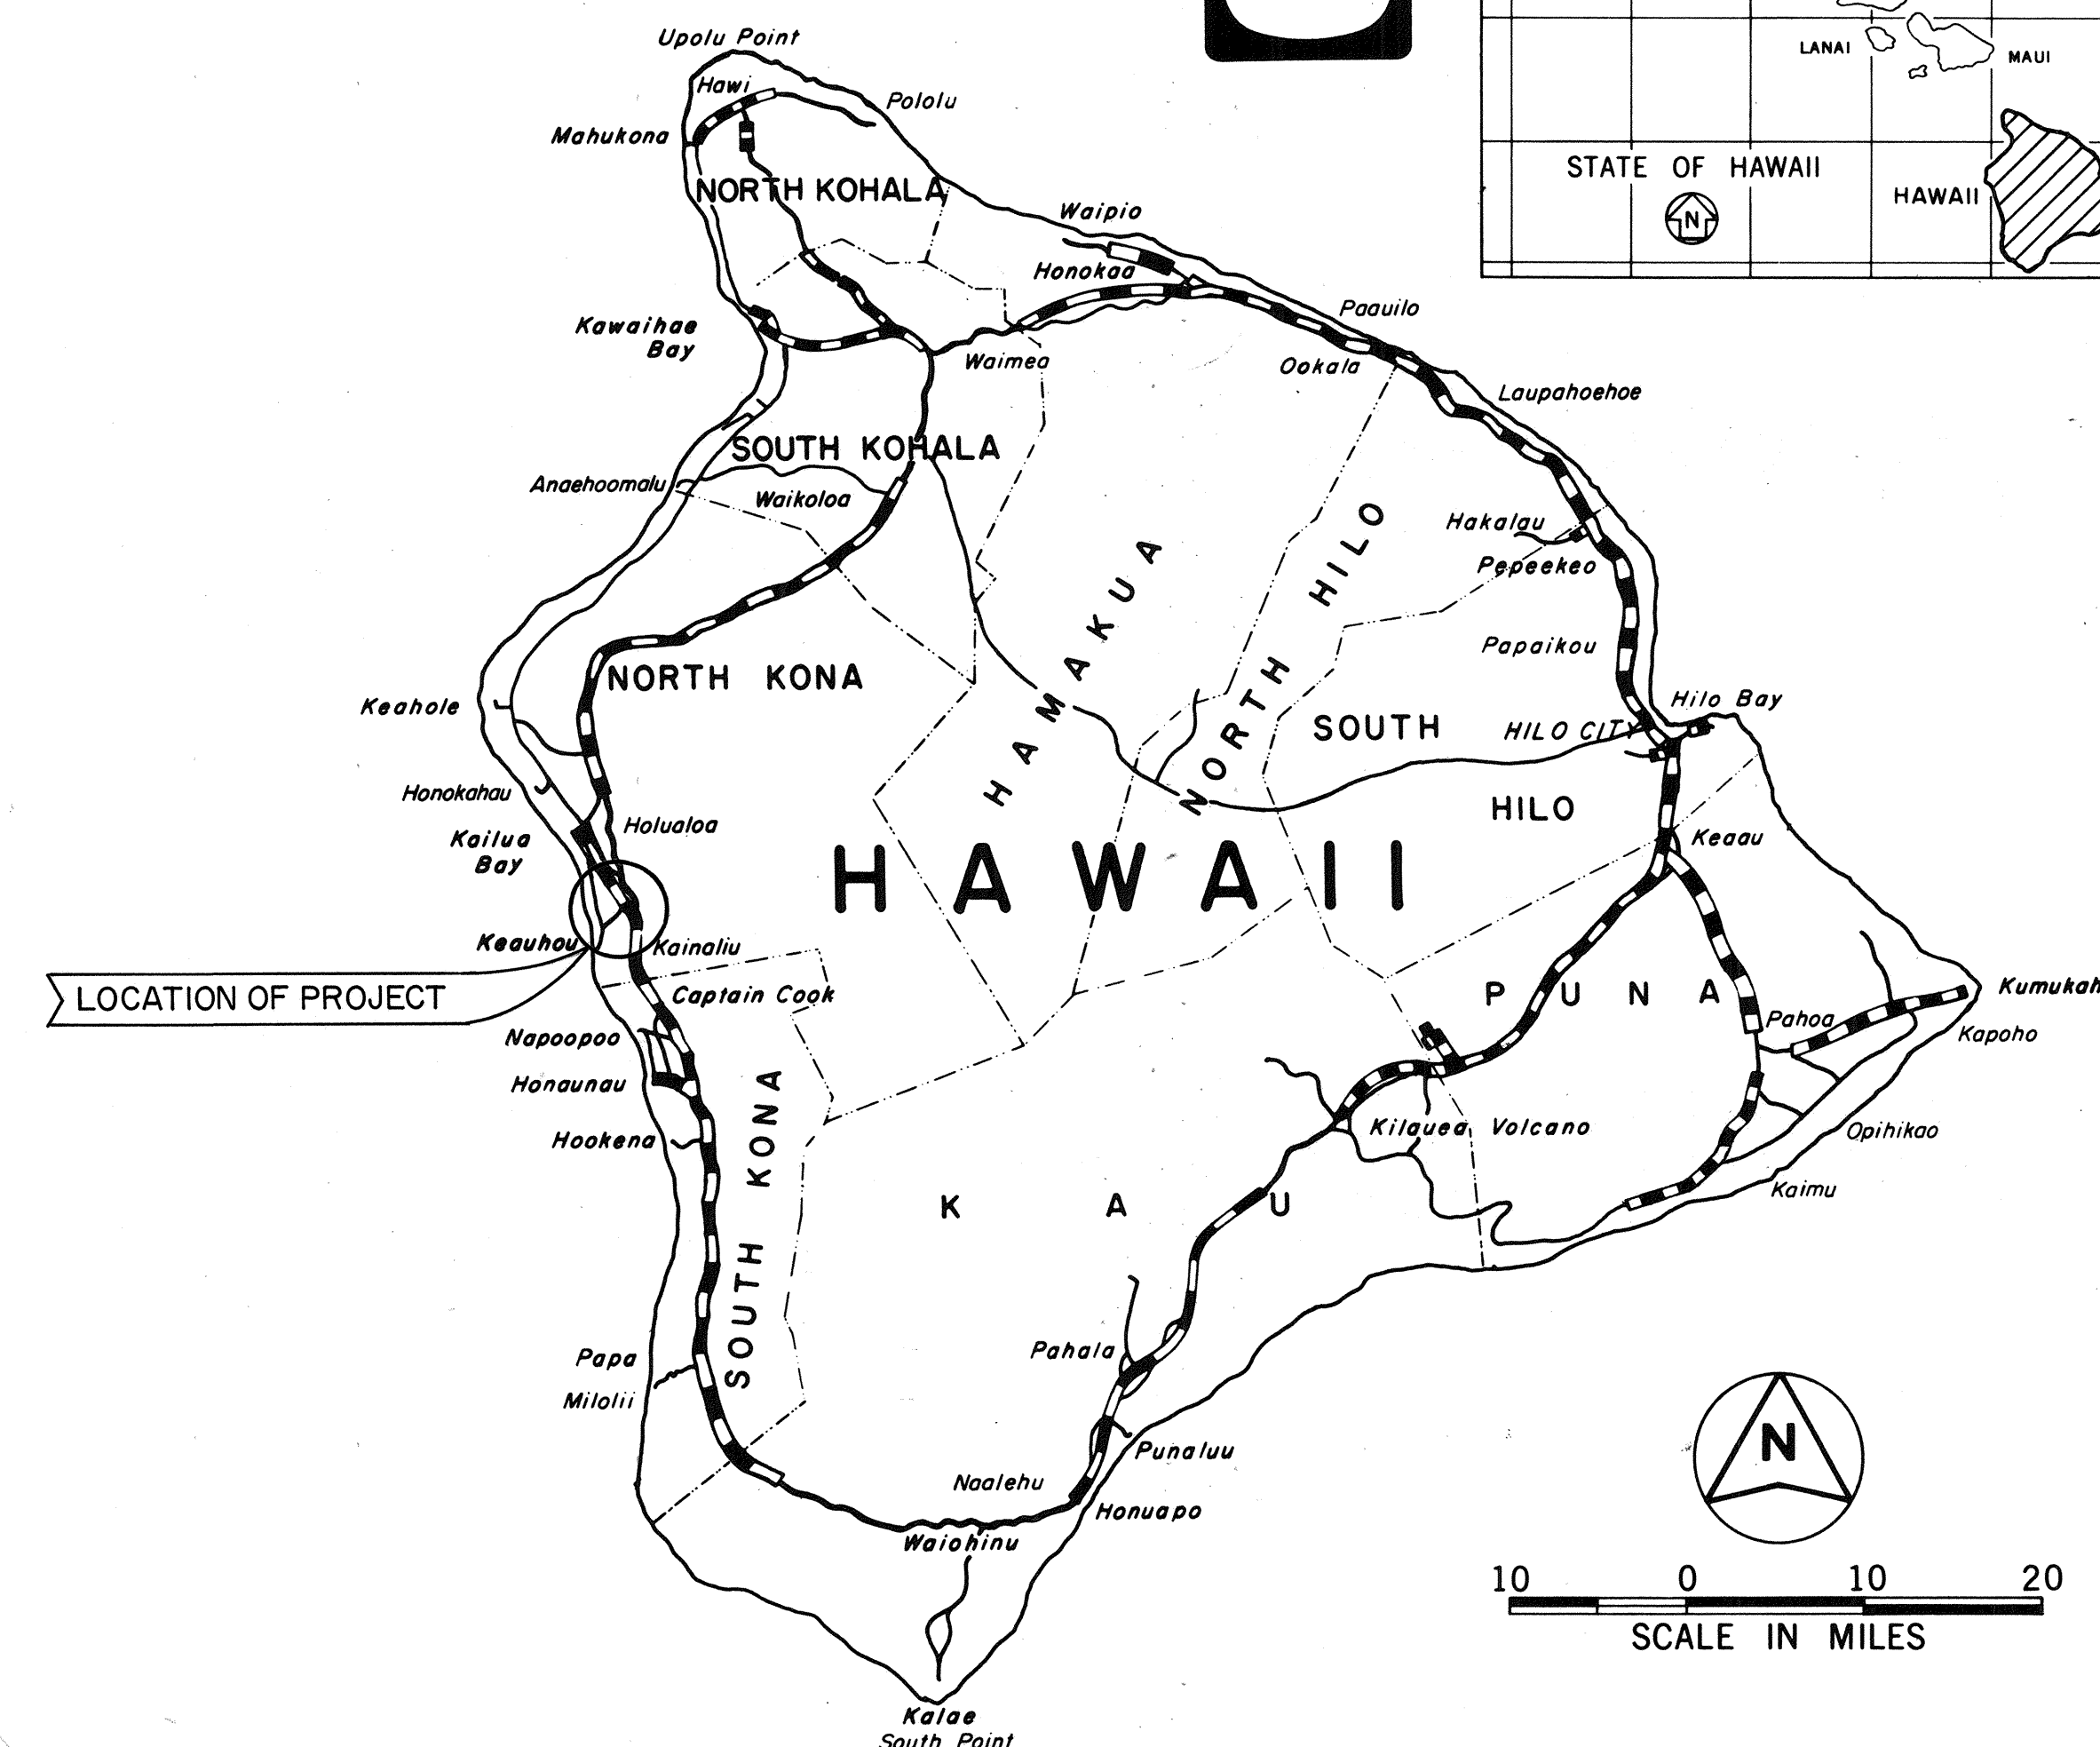

FED. ROAD DIST. NO.	STATE	PROJ. NO.	FISCAL YEAR	SHEET NO.	TOTAL SHEETS
HAWAII	HAW.	11A-01-89	1989	1	6

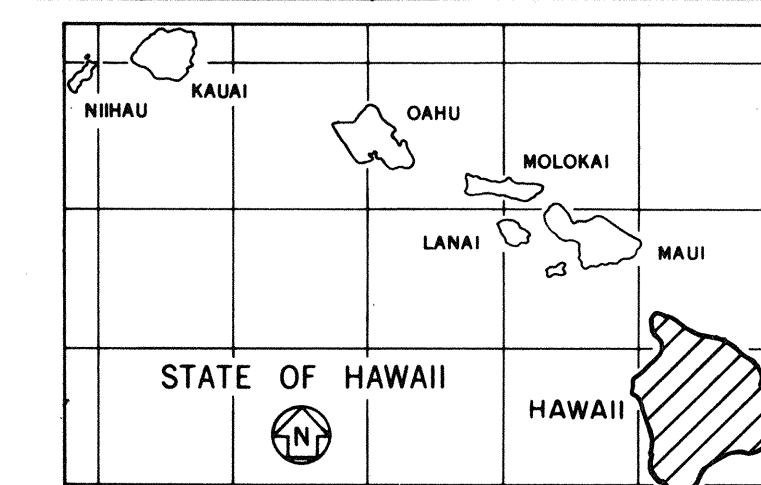

 FEDERAL AID PROJECTS PREVIOUSLY CONSTRUCTED
OR UNDER CONSTRUCTION

CHANGES MADE DURING CONSTRUCTION HAVE
BEEN INCORPORATED ON THESE PLANS EXCEPT
CHANGES IN THE ORIGINAL THEORETICAL
QUANTITIES. FOR ACTUAL QUANTITIES, REFER TO
PROJECT LEDGER AND/OR COMPUTATION BOOK.

Joseph W. Kaplan
RESIDENT ENGINEER

3-13-9
DATE

DEPARTMENT OF TRANSPORTATION
STATE OF HAWAII

APPROVED:

Edmund Burke 4/12/88
DIR. OF TRANSPORTATION DAT