


FED. ROAD DIST. NO.	STATE	PROJ. NO.	FISCAL YEAR	SHEET NO.	TOTAL SHEETS
HAWAII	HAW.	11B-02-89	1989	9	15

LEGEND (PHASE I & II)

- Portable Concrete Guardrails with Steady Burning Amber Lights
- Delineators @ 25' o.c. (on curve) and 50' o.c. (on tangent)
- ▨ Work to be done (Phases I or II)

NOTE

- Excavating and laying of A.C.B. for new pavement shoulder and gutter will be completed each day. Provide smooth riding transition to exist. pavt.
- Steady Burning Amber Lights shall be incidental to Portable Concrete Guardrails.

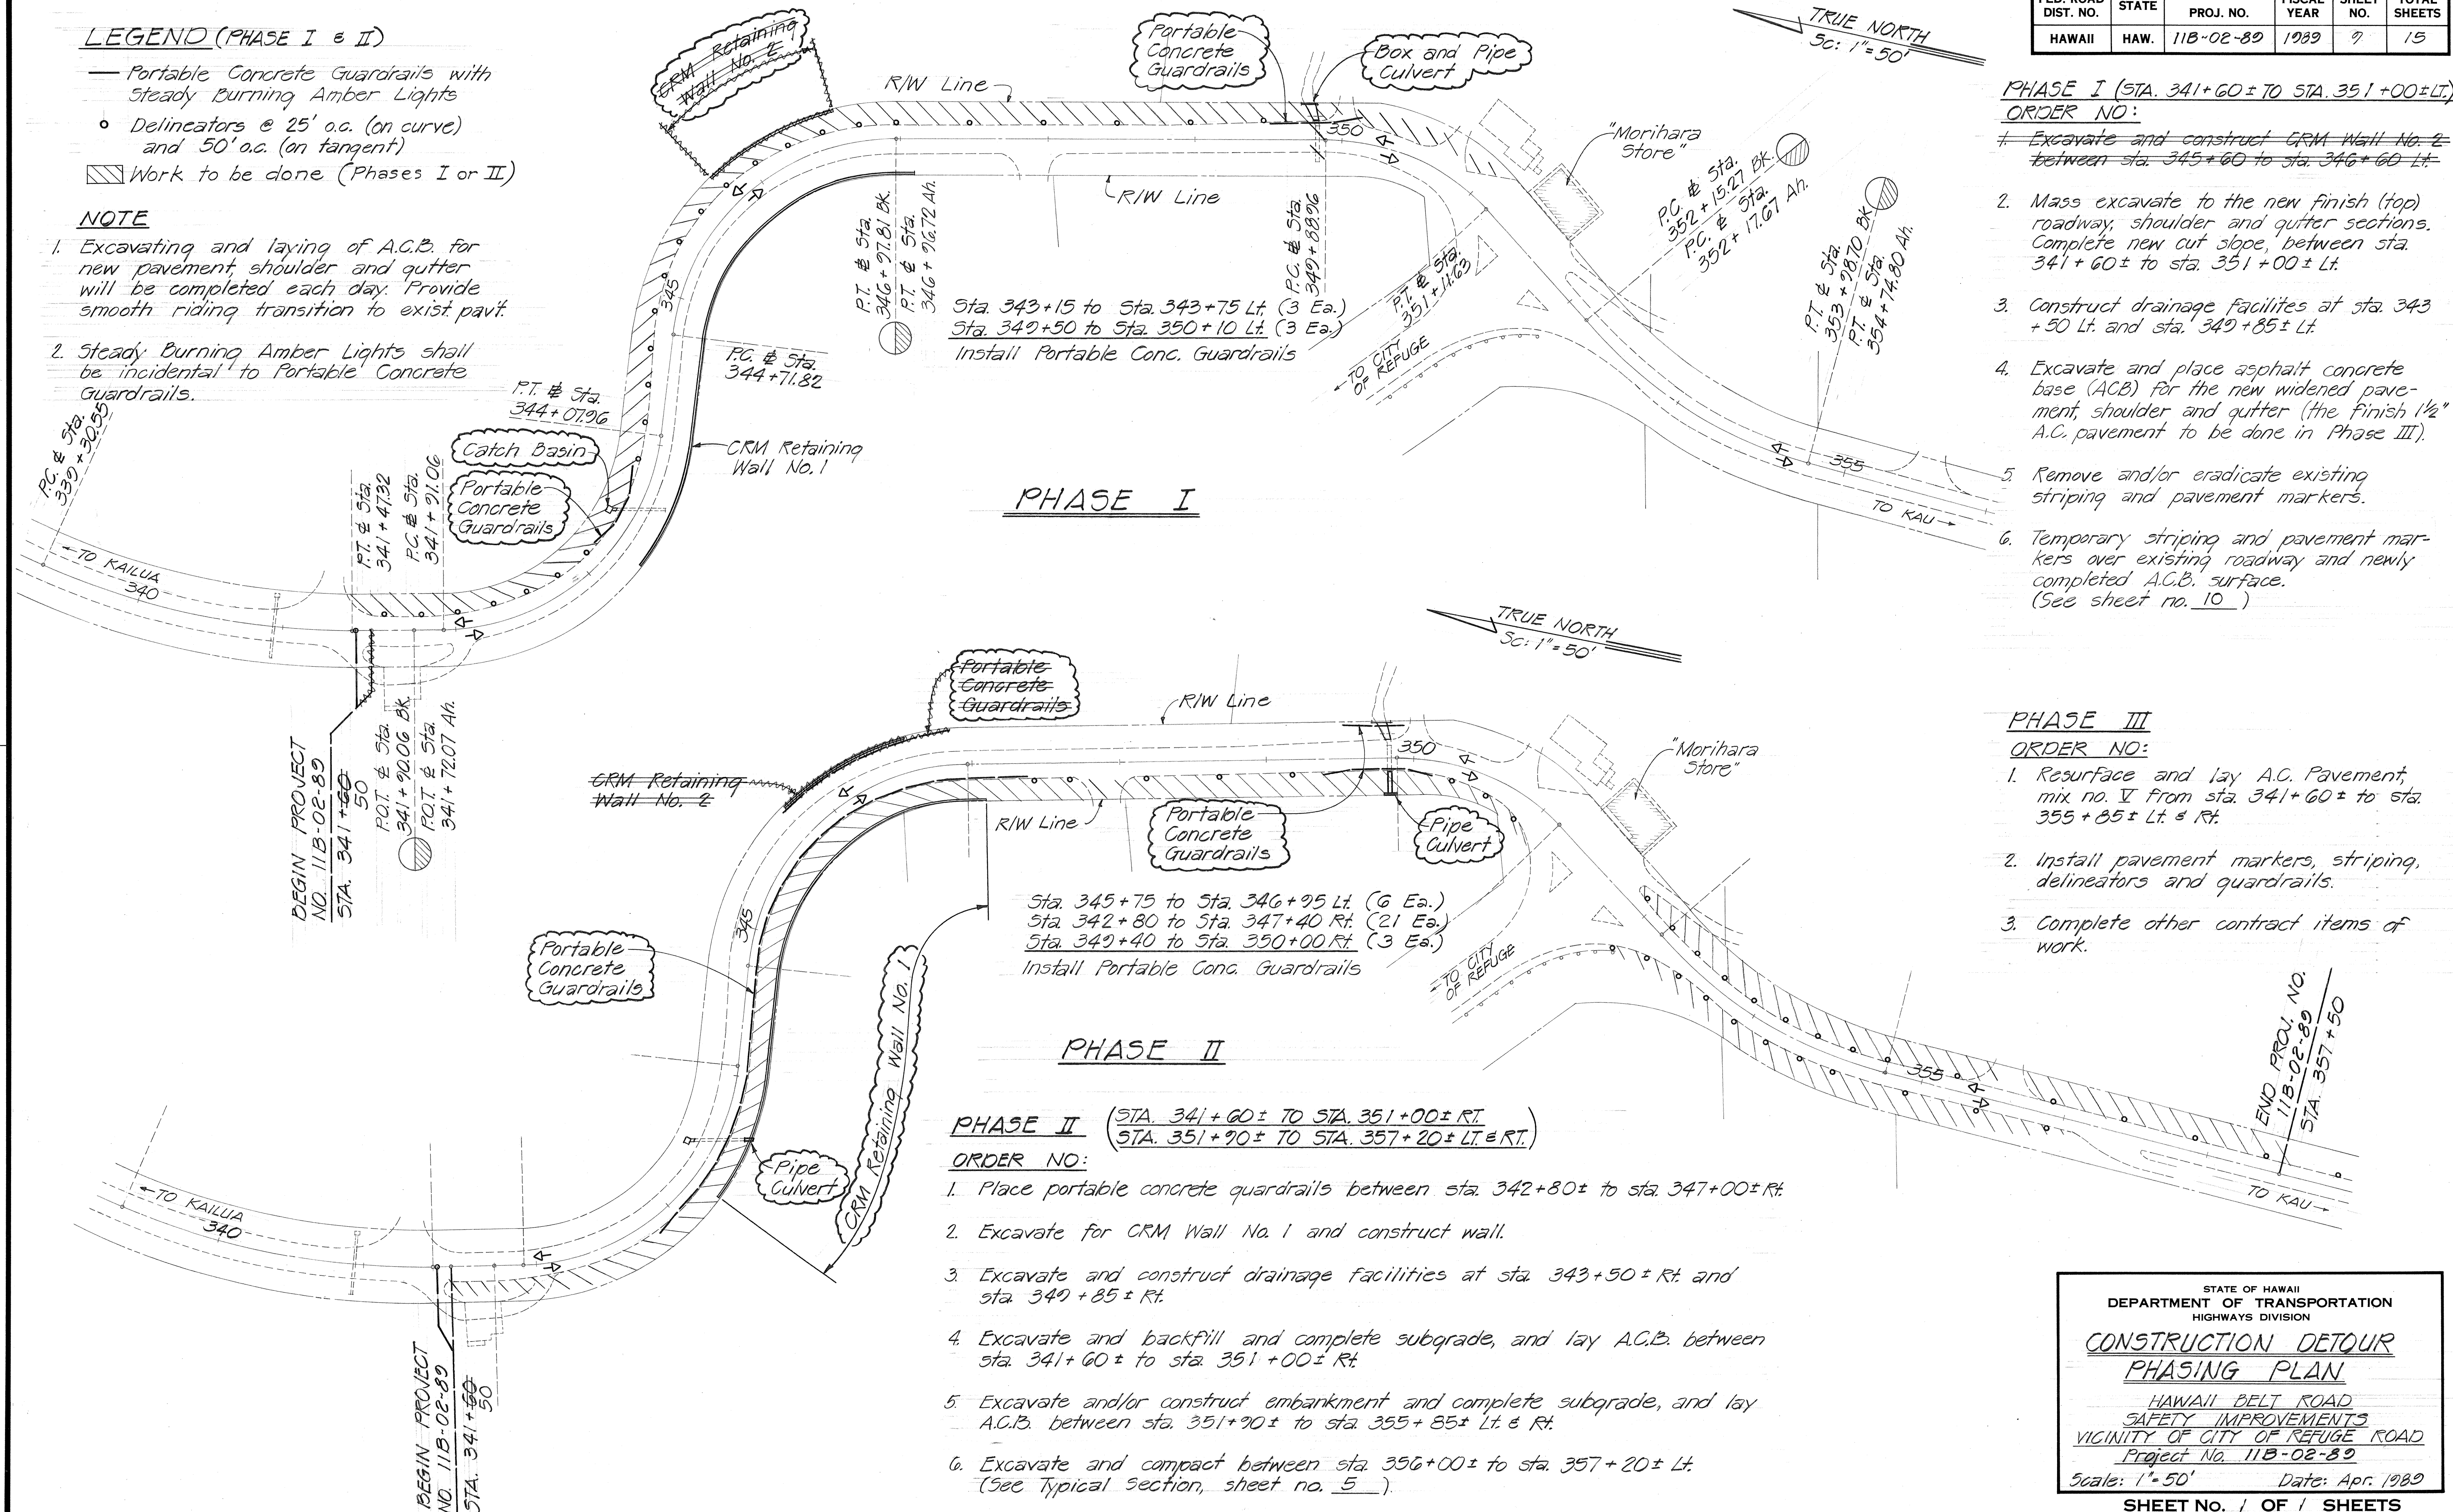

ORIGINAL PLAN	DATE	BY
SURVEY PLOTTED BY	8/22	
DRAWN BY		
DESIGNED BY		
QUANTITIES BY		
CHECKED BY		
NO.		

STATE OF HAWAII DEPARTMENT OF TRANSPORTATION HIGHWAYS DIVISION
CONSTRUCTION DETOUR PHASING PLAN
HAWAII BELT ROAD SAFETY IMPROVEMENTS VICINITY OF CITY OF REFUGE ROAD Project No. 11B-02-89
Scale: 1"=50' Date: Apr. 1989
SHEET NO. 1 OF 1 SHEETS