	INDEX TO DRAWINGS
SHEET NO.	DESCRIPTION
1	TITLE SHEET
2	STANDARD PLAN SUMMARY
3	LEGEND AND NOTES
4	TRAFFIC SIGNAL PLAN
5	LOOP DETECTOR DETAILS

STATE OF HAWAII

DEPARTMENT OF TRANSPORTATION
HIGHWAYS DIVISION

HONOLULU, HAWAII


"AS-BUILT"


PLANS FOR

KANOELEHUA AVENUE TRAFFIC SIGNAL SYSTEM AT KAWAILANI STREET

FEDERAL AID PROJECT NO. HES-011-2 (21)

DISTRICT OF HILO
ISLAND OF HAWAII

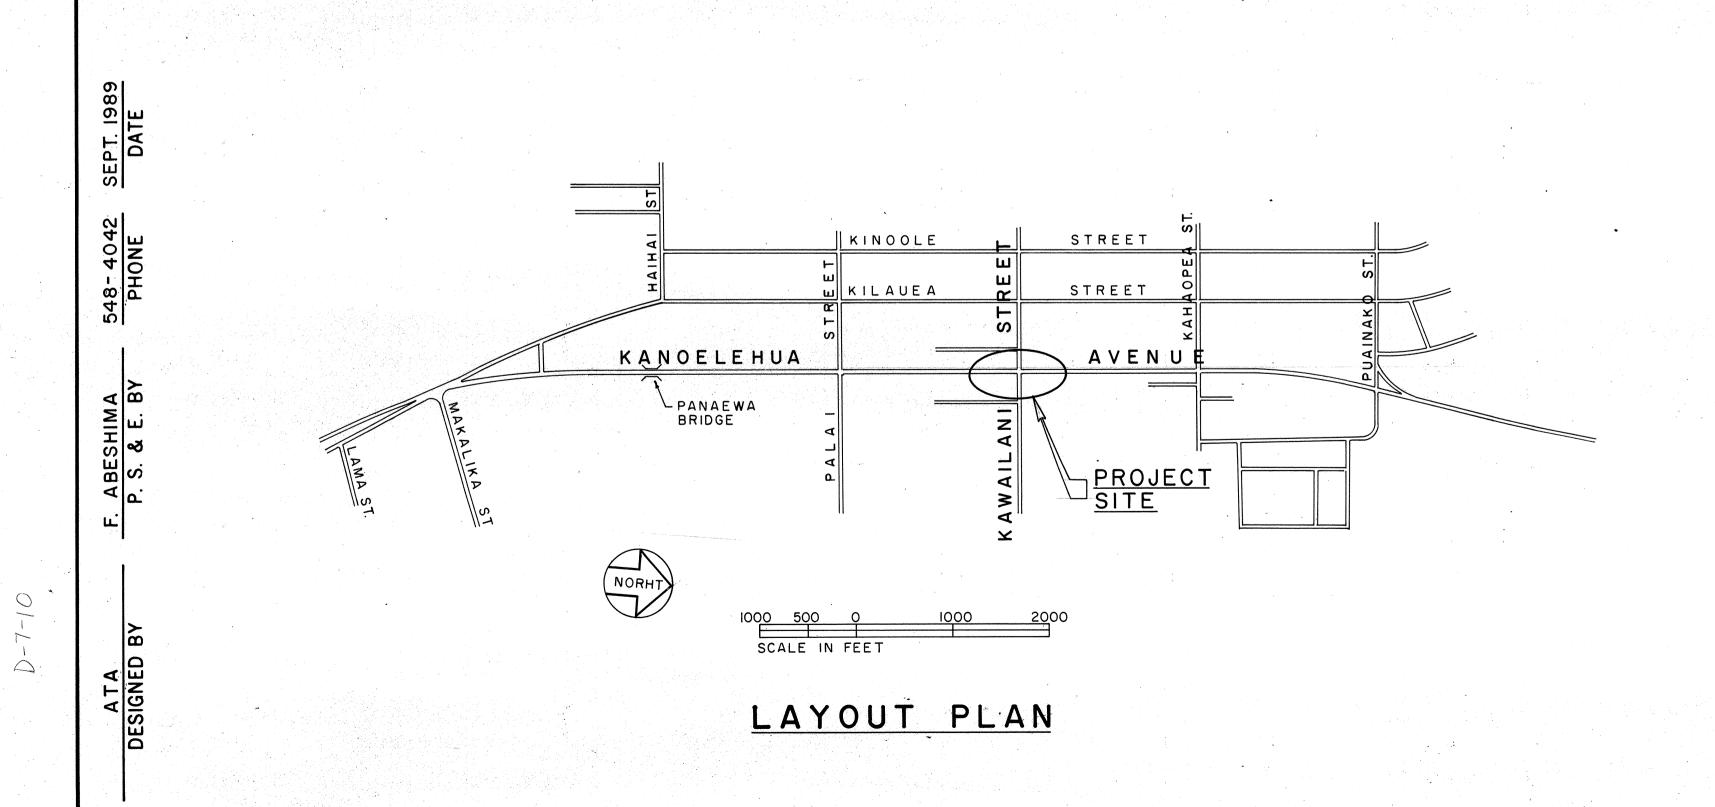

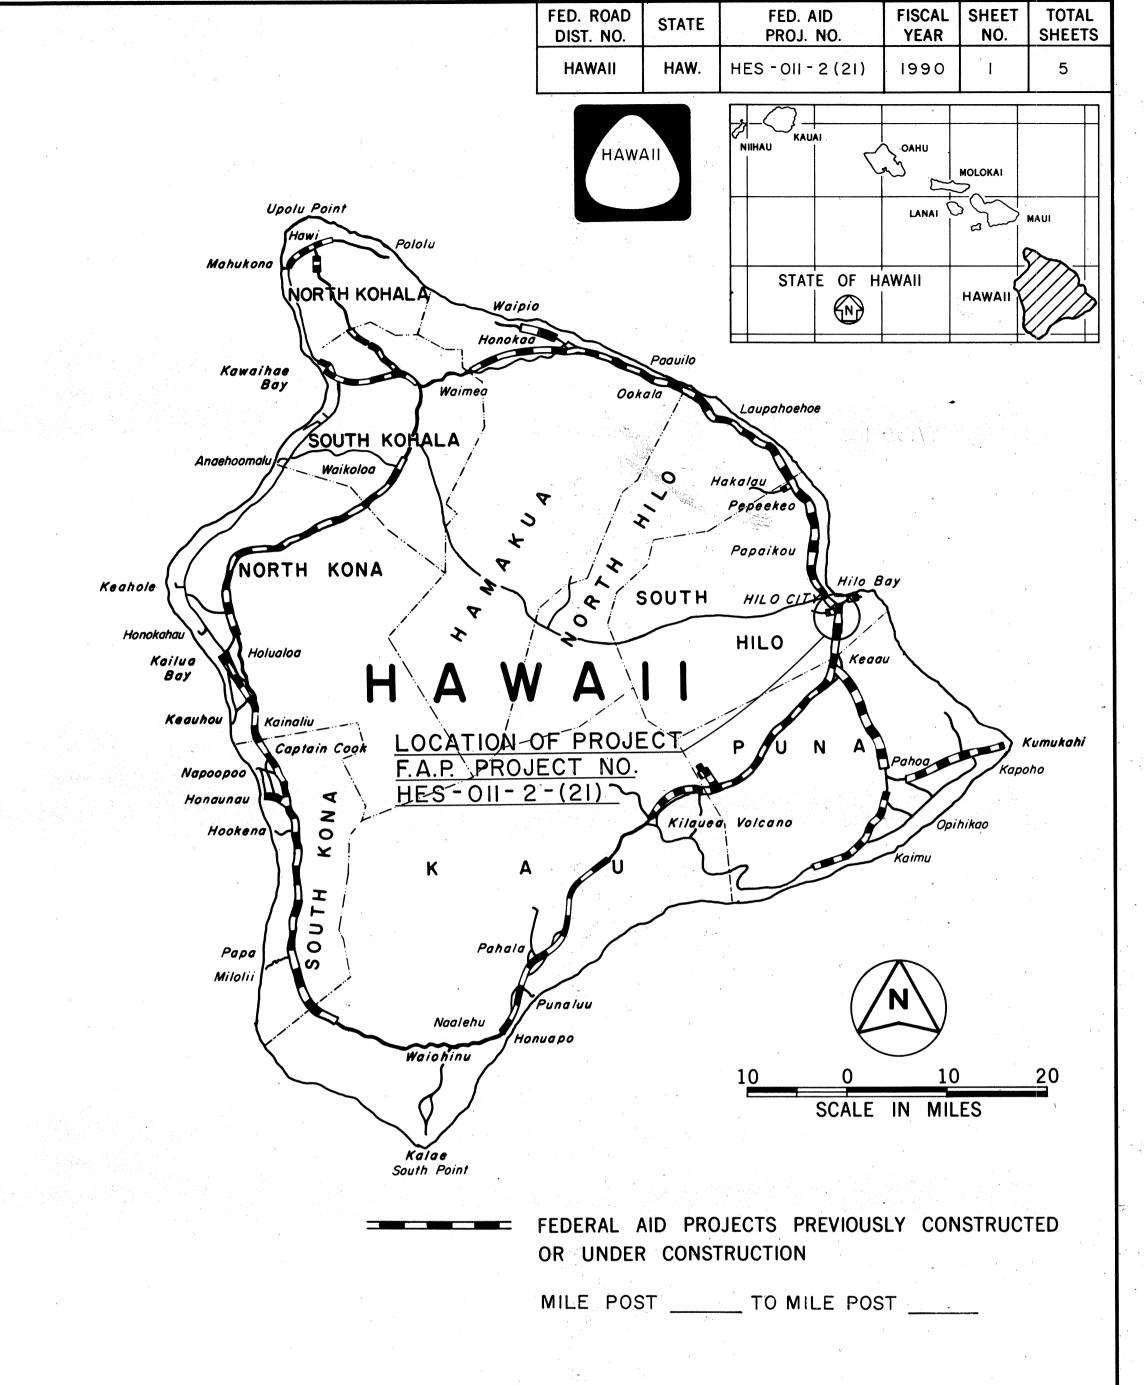

CHANGES MADE DURING CONSTRUCTION HAVE BEEN INCORPORATED ON THESE PLANS EXCEPT CHANGES IN THE ORIGINAL THEORETICAL QUANTITIES, REFER TO PROJECT LEDGER AND/OR COMPUTATION BOOK.

Relief W. Jus fran RESIDENT ENGINEER

12 05 20 DATE

DEPARTMENT OF TRANSPORTATION
FEDERAL HIGHWAY ADMINISTRATION
APPROVED:

DIVISION ADMINISTRATOR

DATE

DEPARTMENT OF TRANSPORTATION
STATE OF HAWAII

APPROVED:

Lluck | June 19/20/89

DIR. OF FRANSPORTATION DATE