

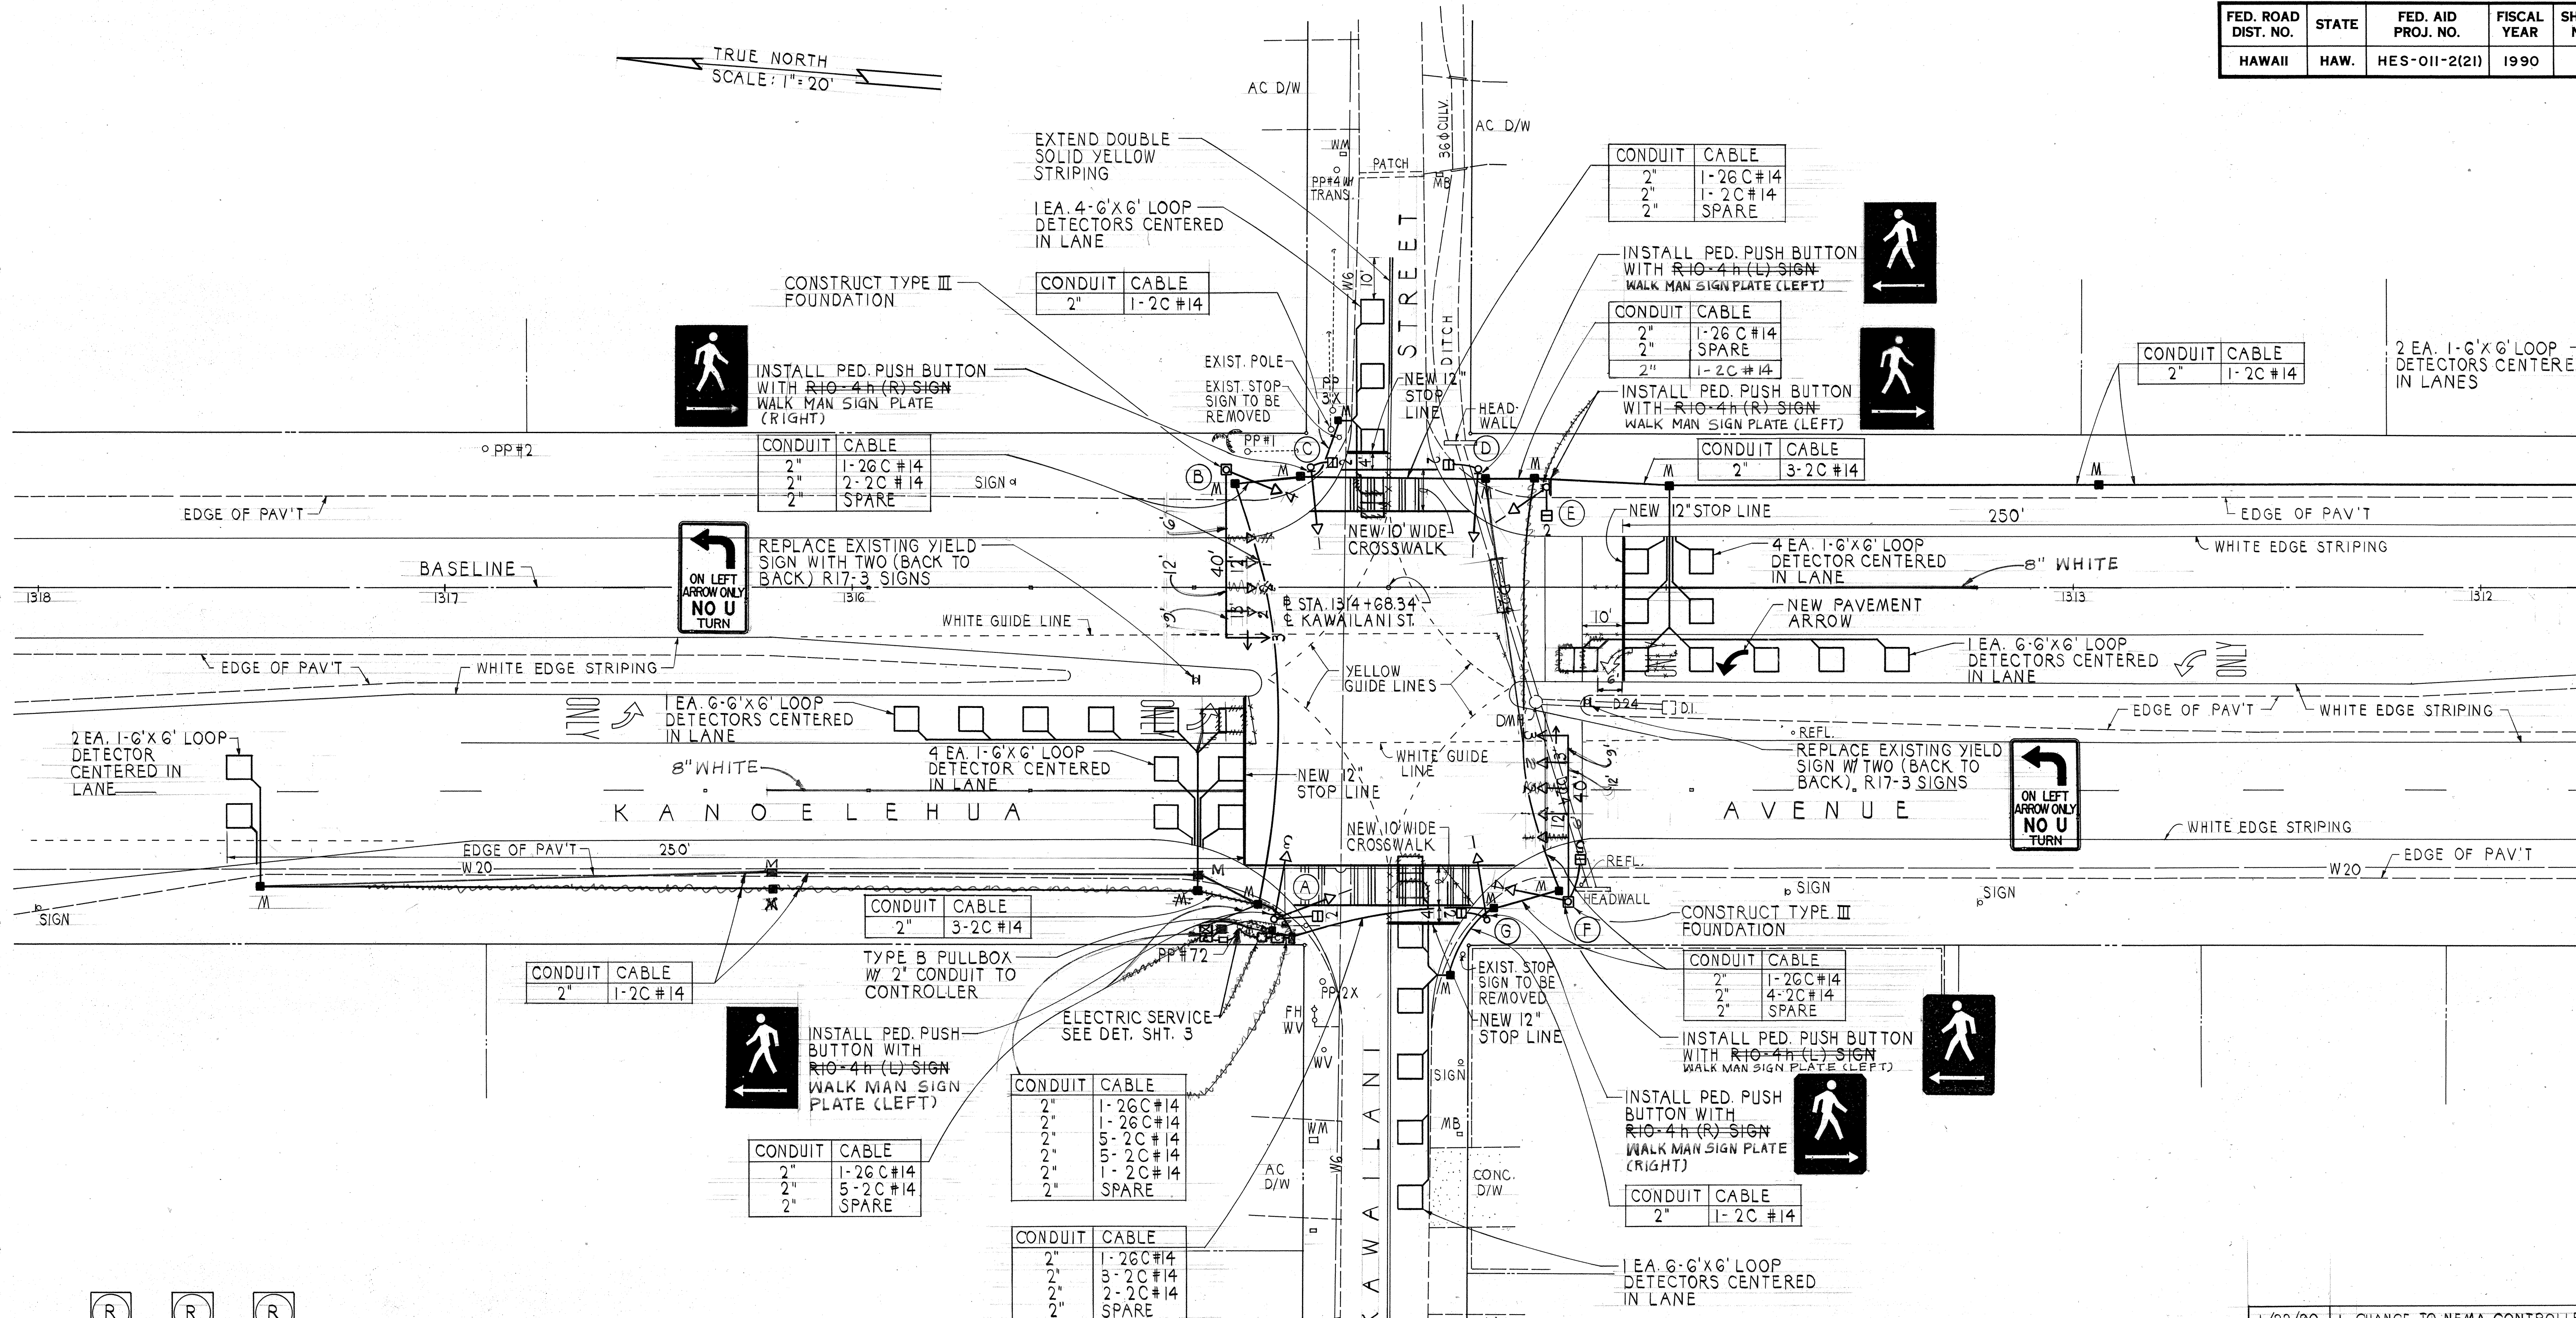


FED. ROAD DIST. NO.	STATE	FED. AID PROJ. NO.	FISCAL YEAR	SHEET NO.	TOTAL SHEETS
HAWAII	HAW.	HES-011-2(21)	1990	4	5

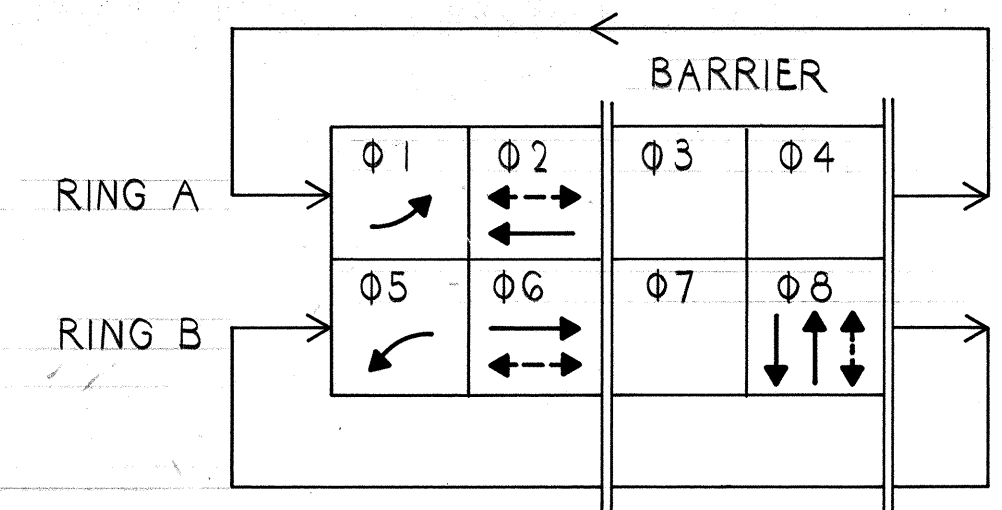

SURVEY PLOTTED BY	DATE
DRAWN BY	
CHECKED BY	
ORIGINAL PLAN	
NOTE BOOK	
NO.	

(R)	(R)	(R)	
(Y)	(Y)	(Y)	
(G)	(↑)	(←)	
A-3	B-2	A-1	A-2
B-1	F-2	*B-3	C-2
B-4		E-1	D-2
C-1		*F-3	E-2
D-1			F-5
F-1			G-2
F-4			
G-1			

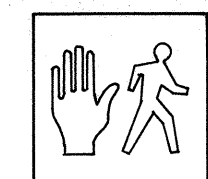

PHASE DIAGRAM


NEMA 2 TO 8 PHASE CONTROLLER

SIGNAL INDICATIONS

* PROGRAMMABLE VISIBILITY HEADS

NOTES:

- PEDESTRIAN SIGNAL HEADS SHALL BE SOLID STATE NEON TYPE.
- EXISTING STOP SIGNS IN KAWAILANI ST TO BE REMOVED AFTER THE TRAFFIC SIGNAL BECOME OPERATIONAL. STREET SIGNS TO REMAIN.

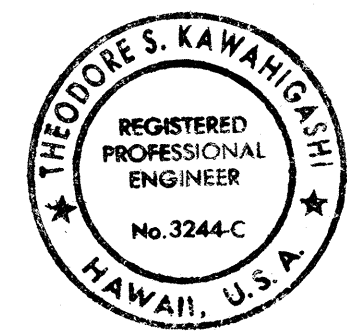

THIS WORK WAS PREPARED BY ME OR UNDER MY SUPERVISION
Theodore S. Kawahigashi

1/22/90	1. CHANGE TO NEMA CONTROLLER 2. REPOSITION POLE F & G 3. ADD SPARE 2" CONDUIT 4. ADD TYPE B PULLBOX 5. CHANGE TO TYPE III FOUNDATION
DATE	REVISION

STATE OF HAWAII
DEPARTMENT OF TRANSPORTATION
HIGHWAYS DIVISION

TRAFFIC SIGNAL PLAN

KANOELEHUA AVENUE
TRAFFIC SIGNAL SYSTEM
AT KAWAILANI STREET
F.A. PROJECT NO. HES-011-2 (21)

SCALE: 1"=20' DATE 9/89