


FED. ROAD DIST. NO.	STATE	PROJ. NO.	FISCAL YEAR	SHEET NO.	TOTAL SHEETS
HAWAII	HAW.	11C-01-20M	1990	7	7

± AND REFERENCE SURVEY MONUMENT SCHEDULE **			
PROJ. NO.	STATION	DEPTH	REMARKS
8B	633+93	0.6"	Proj. 8B
	20+00		End Proj. ER2(1)
	P.T. 16+96	1.2"	R/W
	P.C. 10+44	1.2"	R/W
ER 2(1)	1+50	0.8"	Beg. Proj. ER2(1)
	652+62.68		Proj. 8B
	P.O.T. 654+14.00	0.6"	± Mon.
	P.C. 656+09.40	1.1"	
8B	P.T. 657+46.40	1.2"	
	P.C. 660+00.00	1.4"	
	P.T. 661+00.00	1.4"	
	P.C. 666+66.70	1.4"	
8A	P.T. 668+00.20	1.2"	
	P.C. 669+91.50	1.2"	2.5' Rt. offset
	676+07.00	0.6"	± Mon.
	677+97.00	0.8"	± Mon.
	683+07.00	1.2"	± Mon.
	684+03.00	1.0"	± Mon.
	684+67.00	1.2"	± Mon.
	687+18.00	1.0"	
	689+92.00	0.6"	
	P.T. 691+23.70	1.2"	
	698+97.32	1.0"	Proj. 8A
	27+50.06		End Proj. ER2(1)
ER 2(1)	26+85.00	2.2"	± Mon.
	P.O.T. 14+00.00	1.2"	± Mon.
	P.T. 9+35.00	1.2"	R/W
	P.C. 4+58.00	1.2"	
8A	0+00.00	0.0"	Beg. Proj. ER2(1)
	727+12.00		Proj. 8A
	728+68	0.0"	
	736+23 (±)	0.0"	
	737+44 (±)	0.0"	
	739+75 (±)	0.0"	
TOTAL			30 26 Each

** - See 'Standard Plan D-06' for details.

CONSTRUCTION SIGN SCHEDULE ***		
PROJ. NO.	STATION	Item No. 621.7120 'Construction Sign with Two Posts'
8B	629±20 R	CW20-1d
	629±20 L	CG20-2(60"x24")
	633±90 R	CG20-1(1.8)(60"x36")
8A	727±60 L	CG20-1(1.8)(60"x36")
	732±60 R	CG20-2(60"x24")
	732±60 L	CW20-1d
TOTAL		6 - Each

*** - See 'Standard Plans TE-01, TE-02, TE-03 and TE-08' for details.

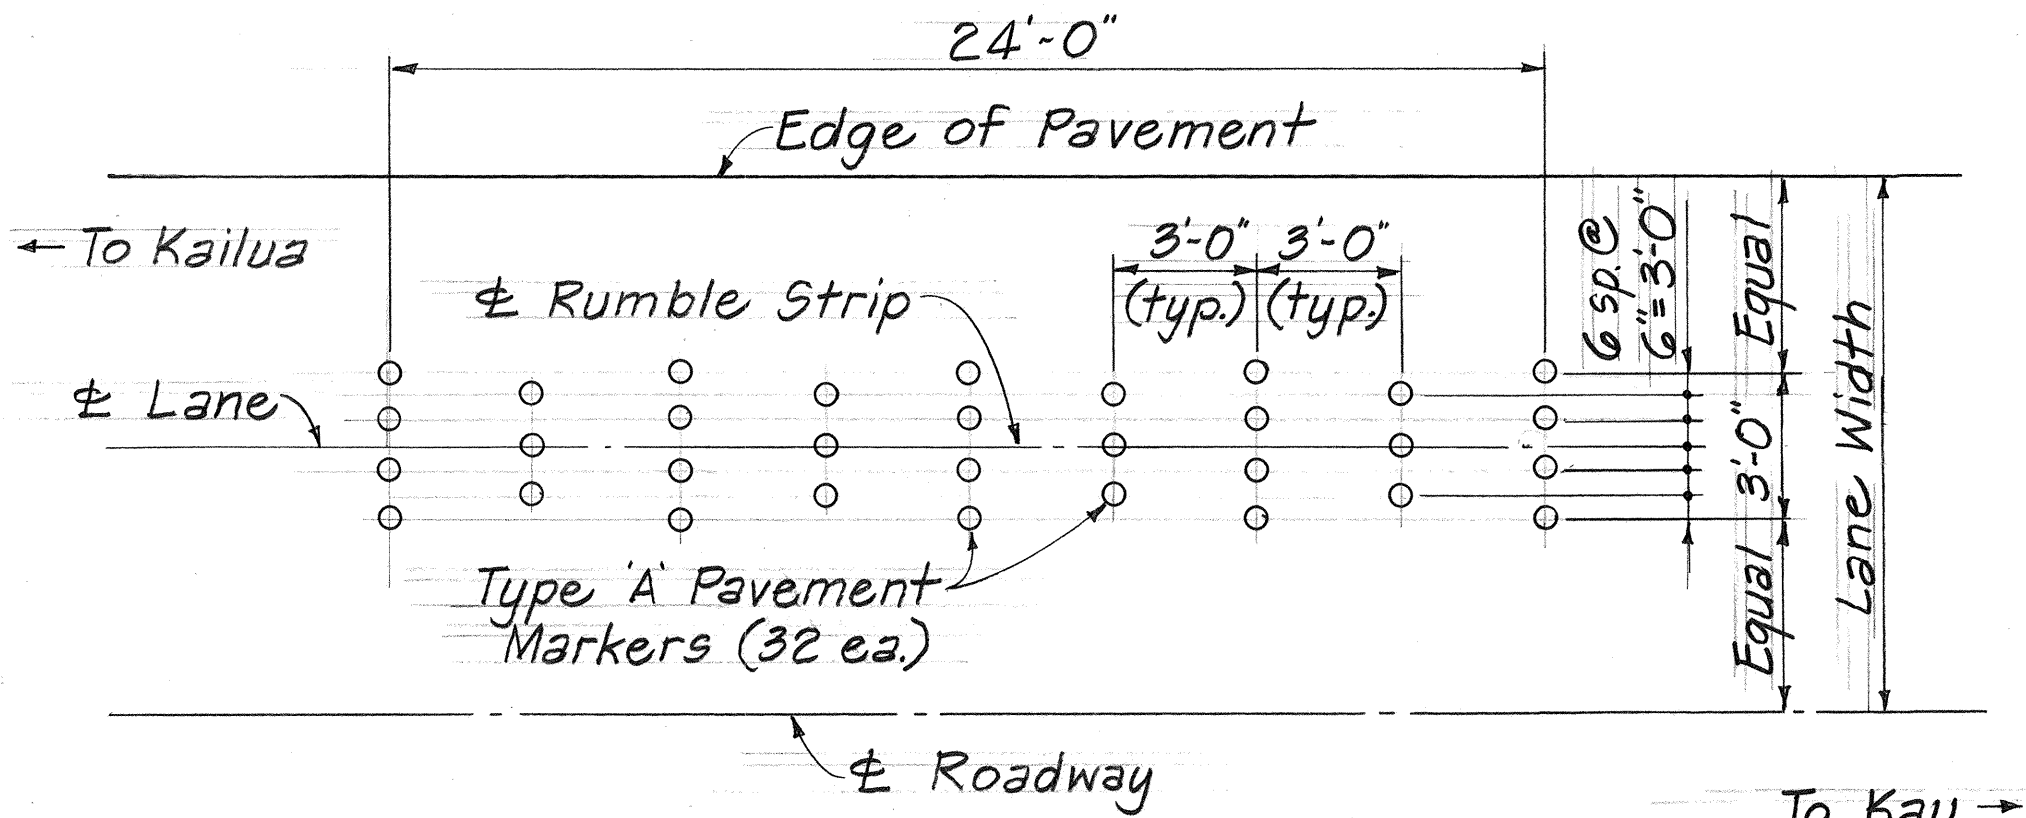

RUMBLE STRIP DETAIL
Not To Scale

STATE OF HAWAII
DEPARTMENT OF TRANSPORTATION
HIGHWAYS DIVISION

± MON. ± CONSTR. SIGN SCHEDULE

RUMBLE STRIP DETAIL

HAWAII BELT ROAD RESURFACING
HONOKUA TO KAOHE

PROJECT N^o 11C-01-20M

Scale: As Shown Date: August 1989

SHEET NO. 1 OF 1 SHEETS

DATE	_____
SURVEY PLOTTED BY	_____
DRAWN BY	_____
DESIGNED BY	_____
QUANTITIES BY	_____
CHECKED BY	_____
ORIGINAL PLAN	_____
NOTE BOOK	_____
No.	_____