

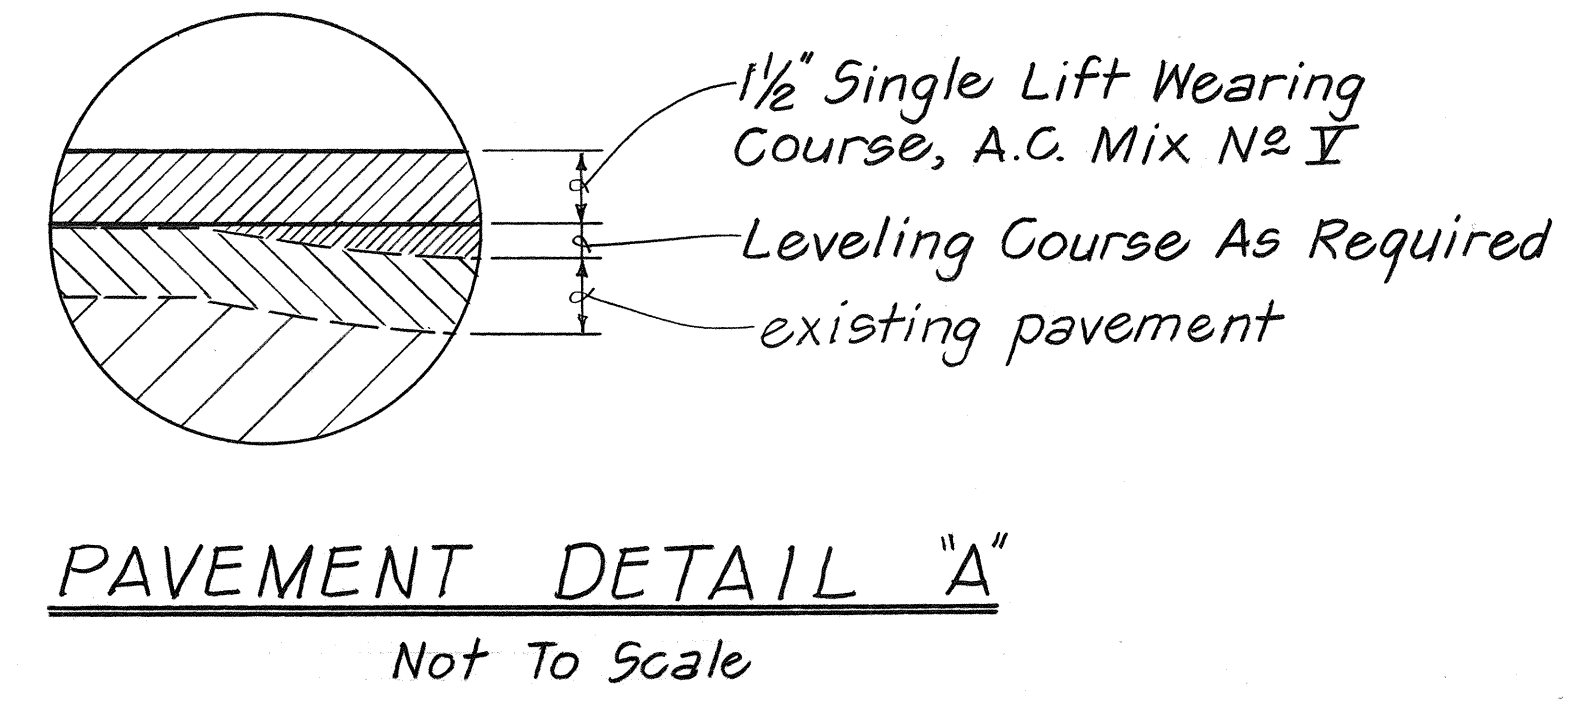
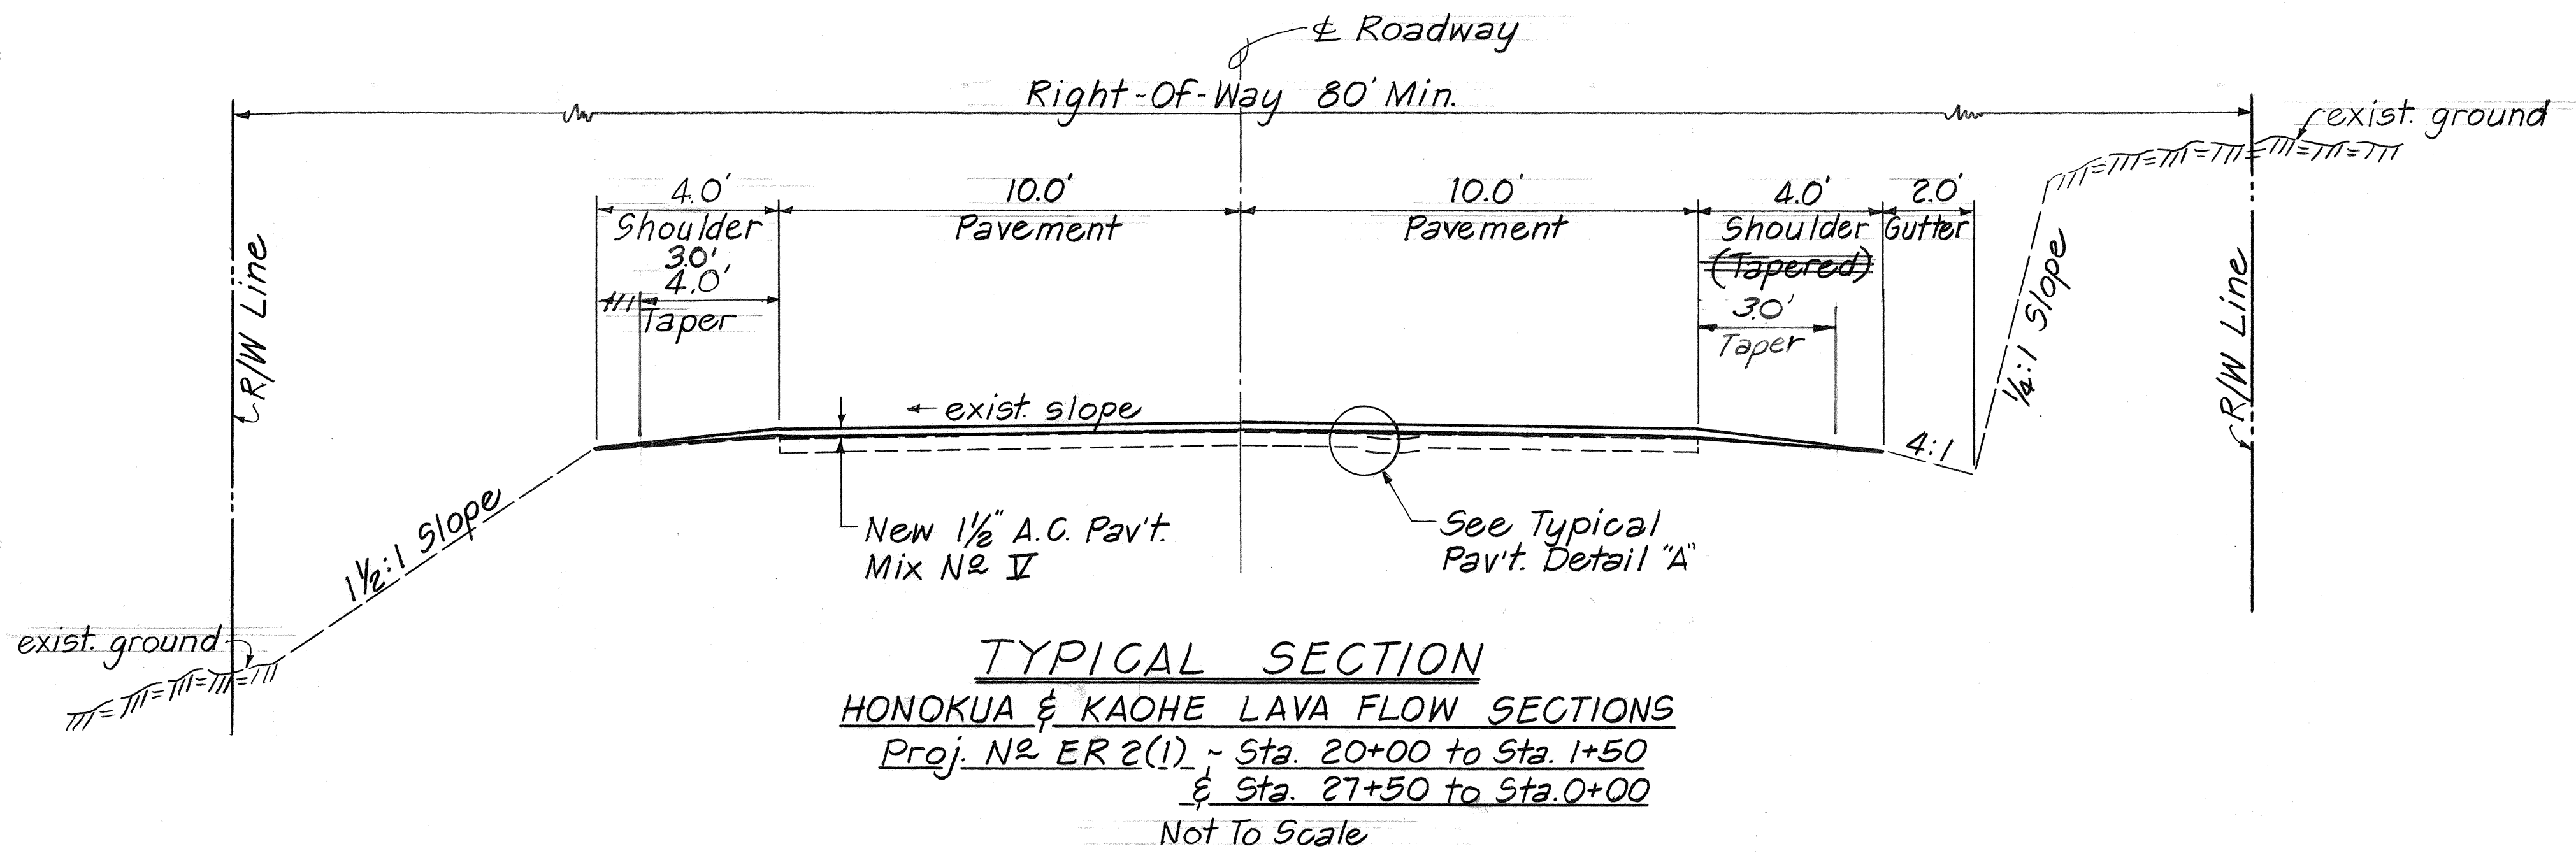


FED. ROAD DIST. NO.	STATE	PROJ. NO.	FISCAL YEAR	SHEET NO.	TOTAL SHEETS
HAWAII	HAW.	11C-01-90M	1990	3	7

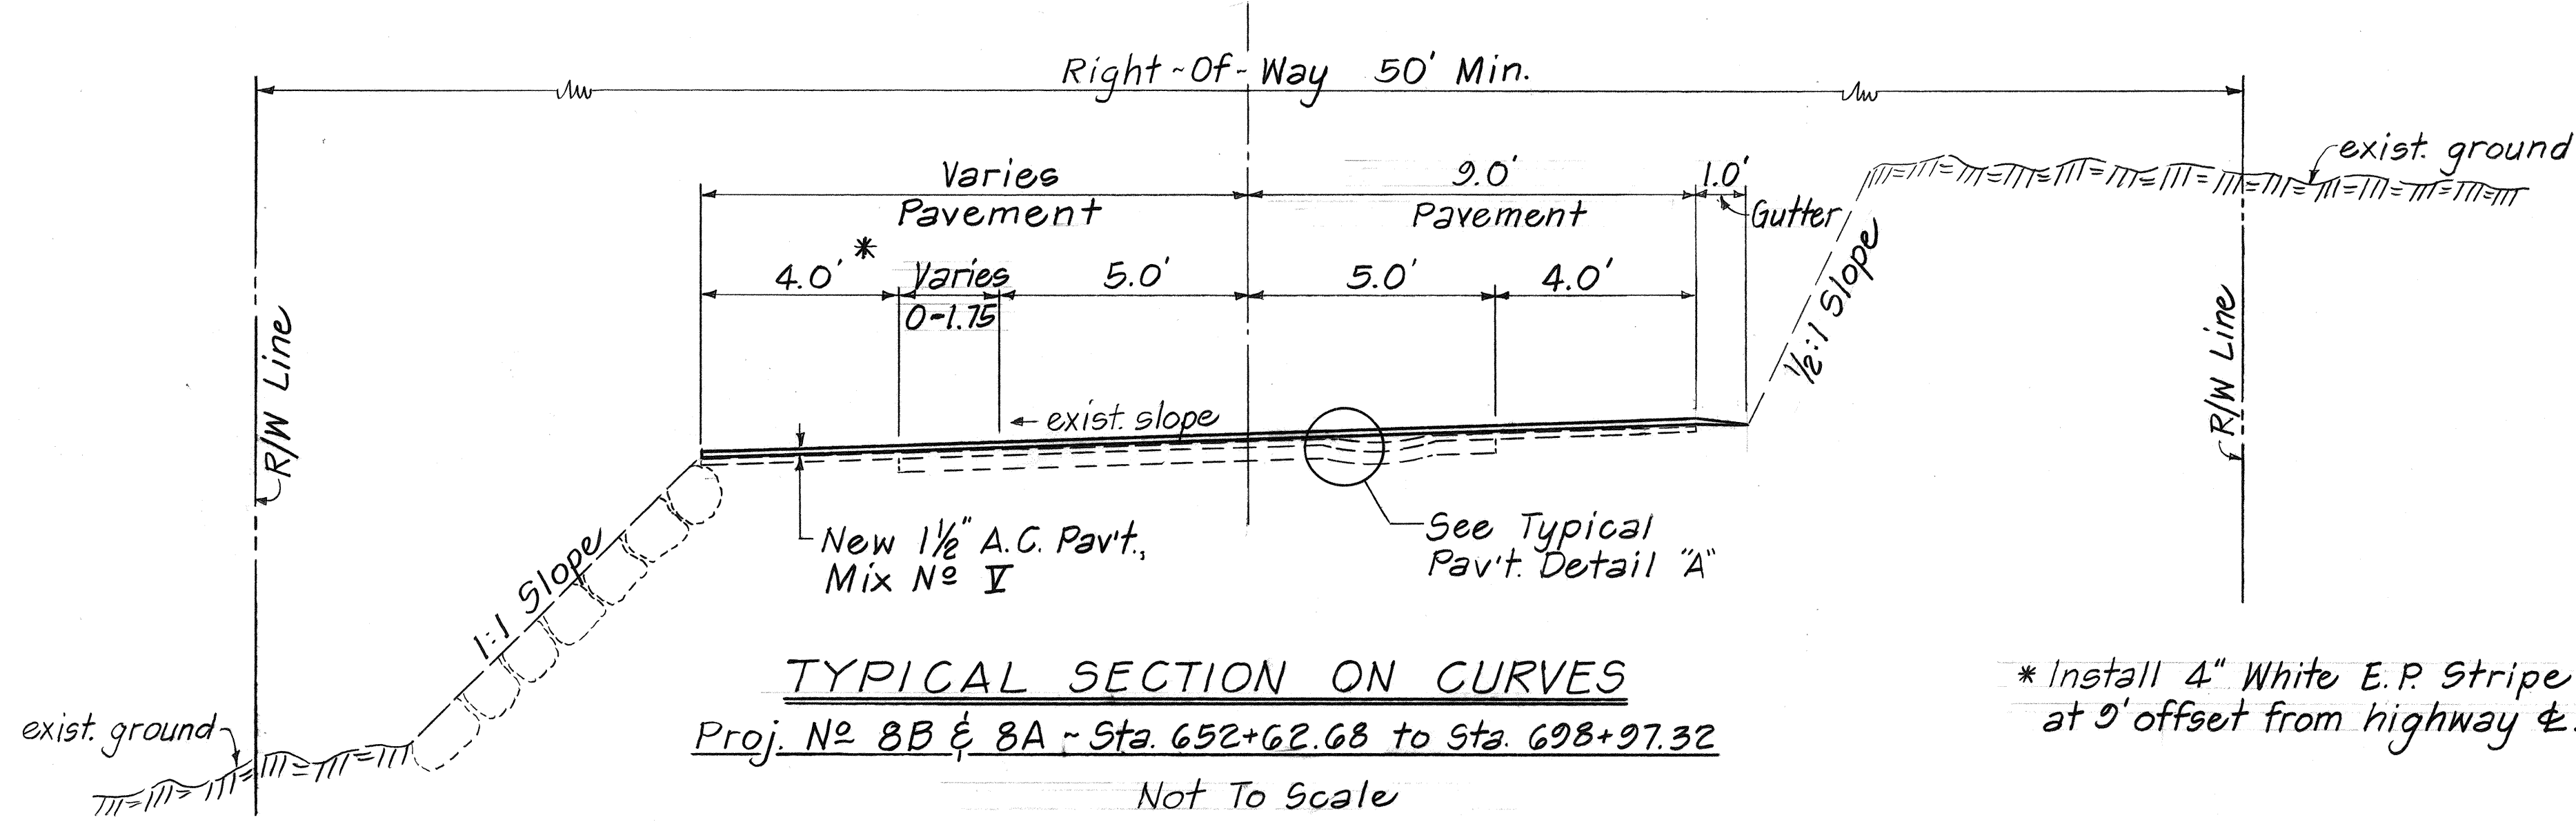

- GENERAL NOTES:**
- Improvements consist of Reconstructing weakened pavement areas, Resurfacing the existing pavement, Installing Pavement Markers and Adjusting Centerline and Reference Survey Monument.
 - Asphalt Concrete for Leveling Course shall be Paid for under Item No. 401.0500-Asphalt Concrete Pavement, Mix No. V.
 - Tack Coat shall be Incidental to Item No. 401.0500-Asphalt Concrete Pavement, Mix No. V.
 - All Construction Signs shall be Reflectorized with High Intensity Reflective Sheeting.
 - Pavement Areas to be Striped shall be Broomed Off By Contractor Prior to Striping By the State.
 - Construct Smooth and Easy Riding Connections to existing roadway at Beginning and End of Project.
 - Existing pavement surface variable. Surface indicated here is not intended to represent any specific location.
 - Preparation of Shoulder Areas for Paving shall be done by the State. Contractor shall be responsible for finish rolling of the shoulders as necessary to prepare for paving of Asphalt Concrete Pavement Mix No. V. This work shall be considered incidental to Item No. 401.0500, Asphalt Concrete Pavement Mix No. V.
 - The Contractor shall restore all sign and RM Marker damaged as a result of his resurfacing work. This work shall be considered incidental to Item No. 401.0500, Asphalt Concrete Pavement Mix No. V.

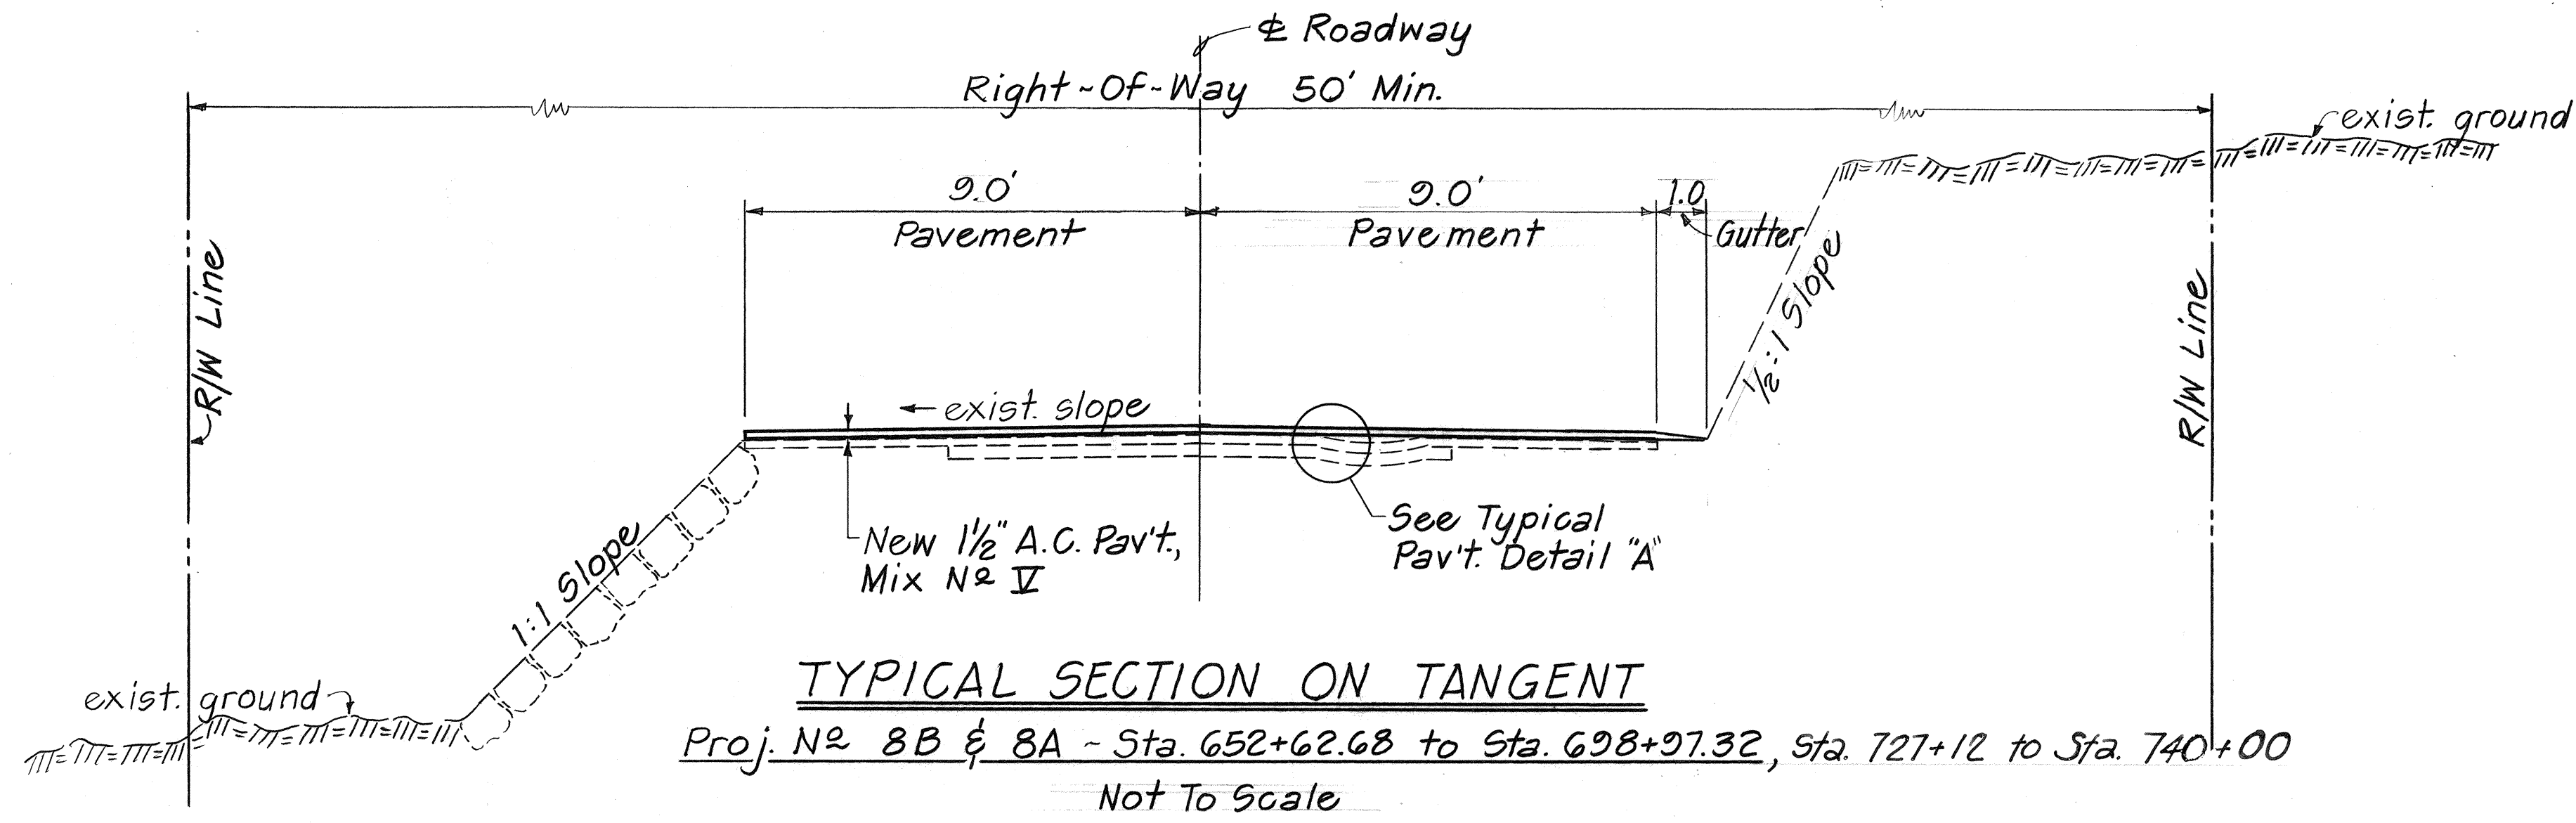

* Install 4" White E.P. Stripe at 9' offset from highway &.

ORIGINAL PLAN	DATE
SURVEY PLOTTED BY	
DRAWN BY	
DESIGNED BY	
CHECKED BY	
NO.	

STATE OF HAWAII
DEPARTMENT OF TRANSPORTATION
HIGHWAYS DIVISION

TYPICAL SECTION
HAWAII BELT ROAD RESURFACING
HONOKUA TO KAOHE
PROJECT N2 11C-01-90M
Scale: As Shown Date: August 1989
SHEET NO. 1 OF 1 SHEETS