

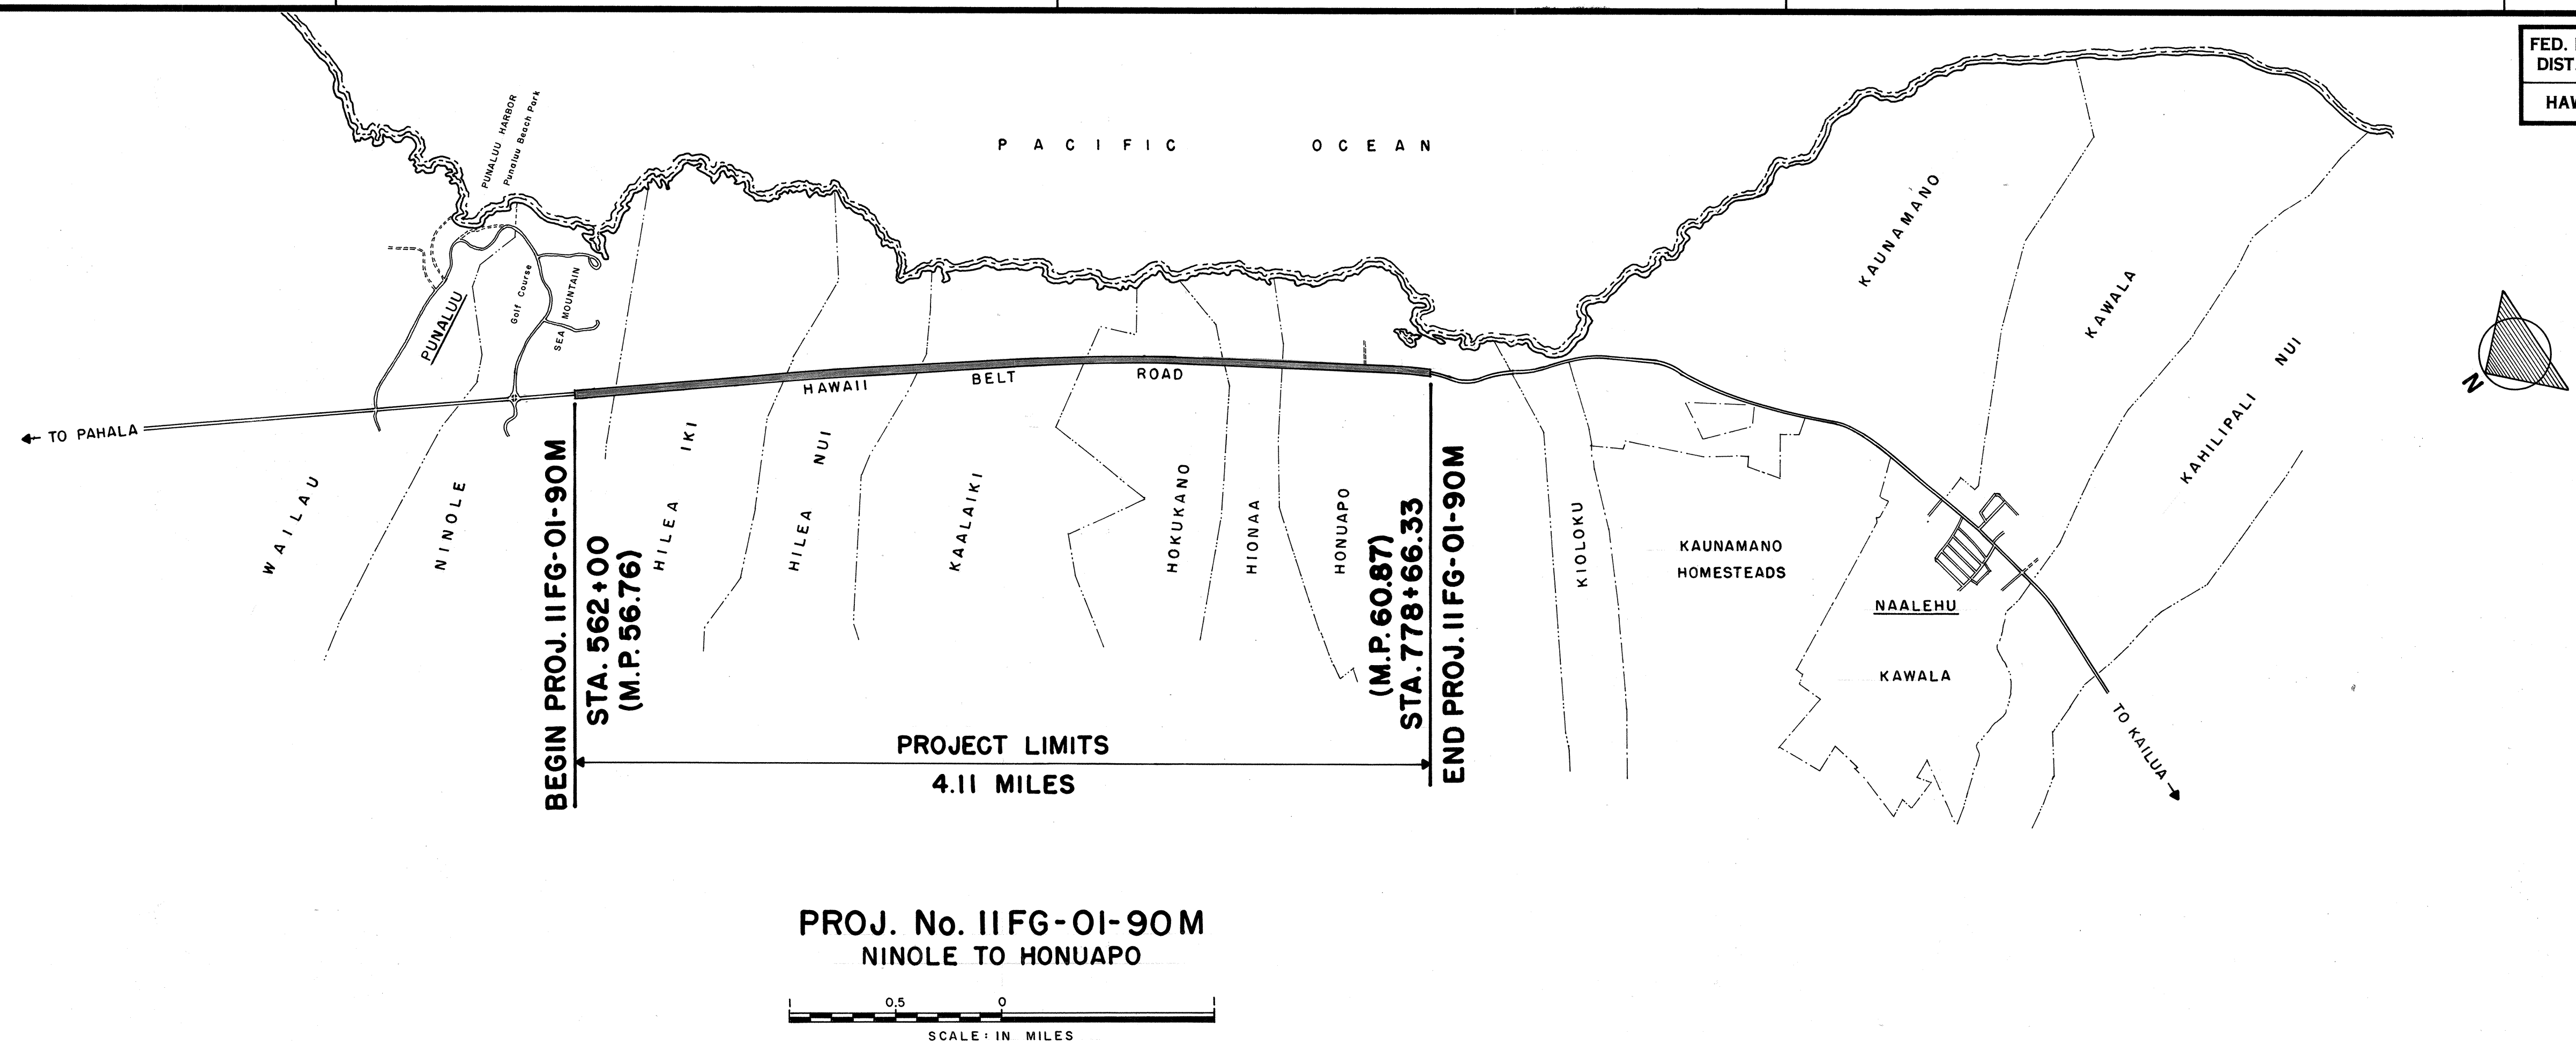


FED. ROAD DIST. NO.	STATE	FED. AID PROJ. NO.	FISCAL YEAR	SHEET NO.	TOTAL SHEETS
HAWAII	HAW.	11 FG-01-90M 11 JK-01-90M	1990	3	14

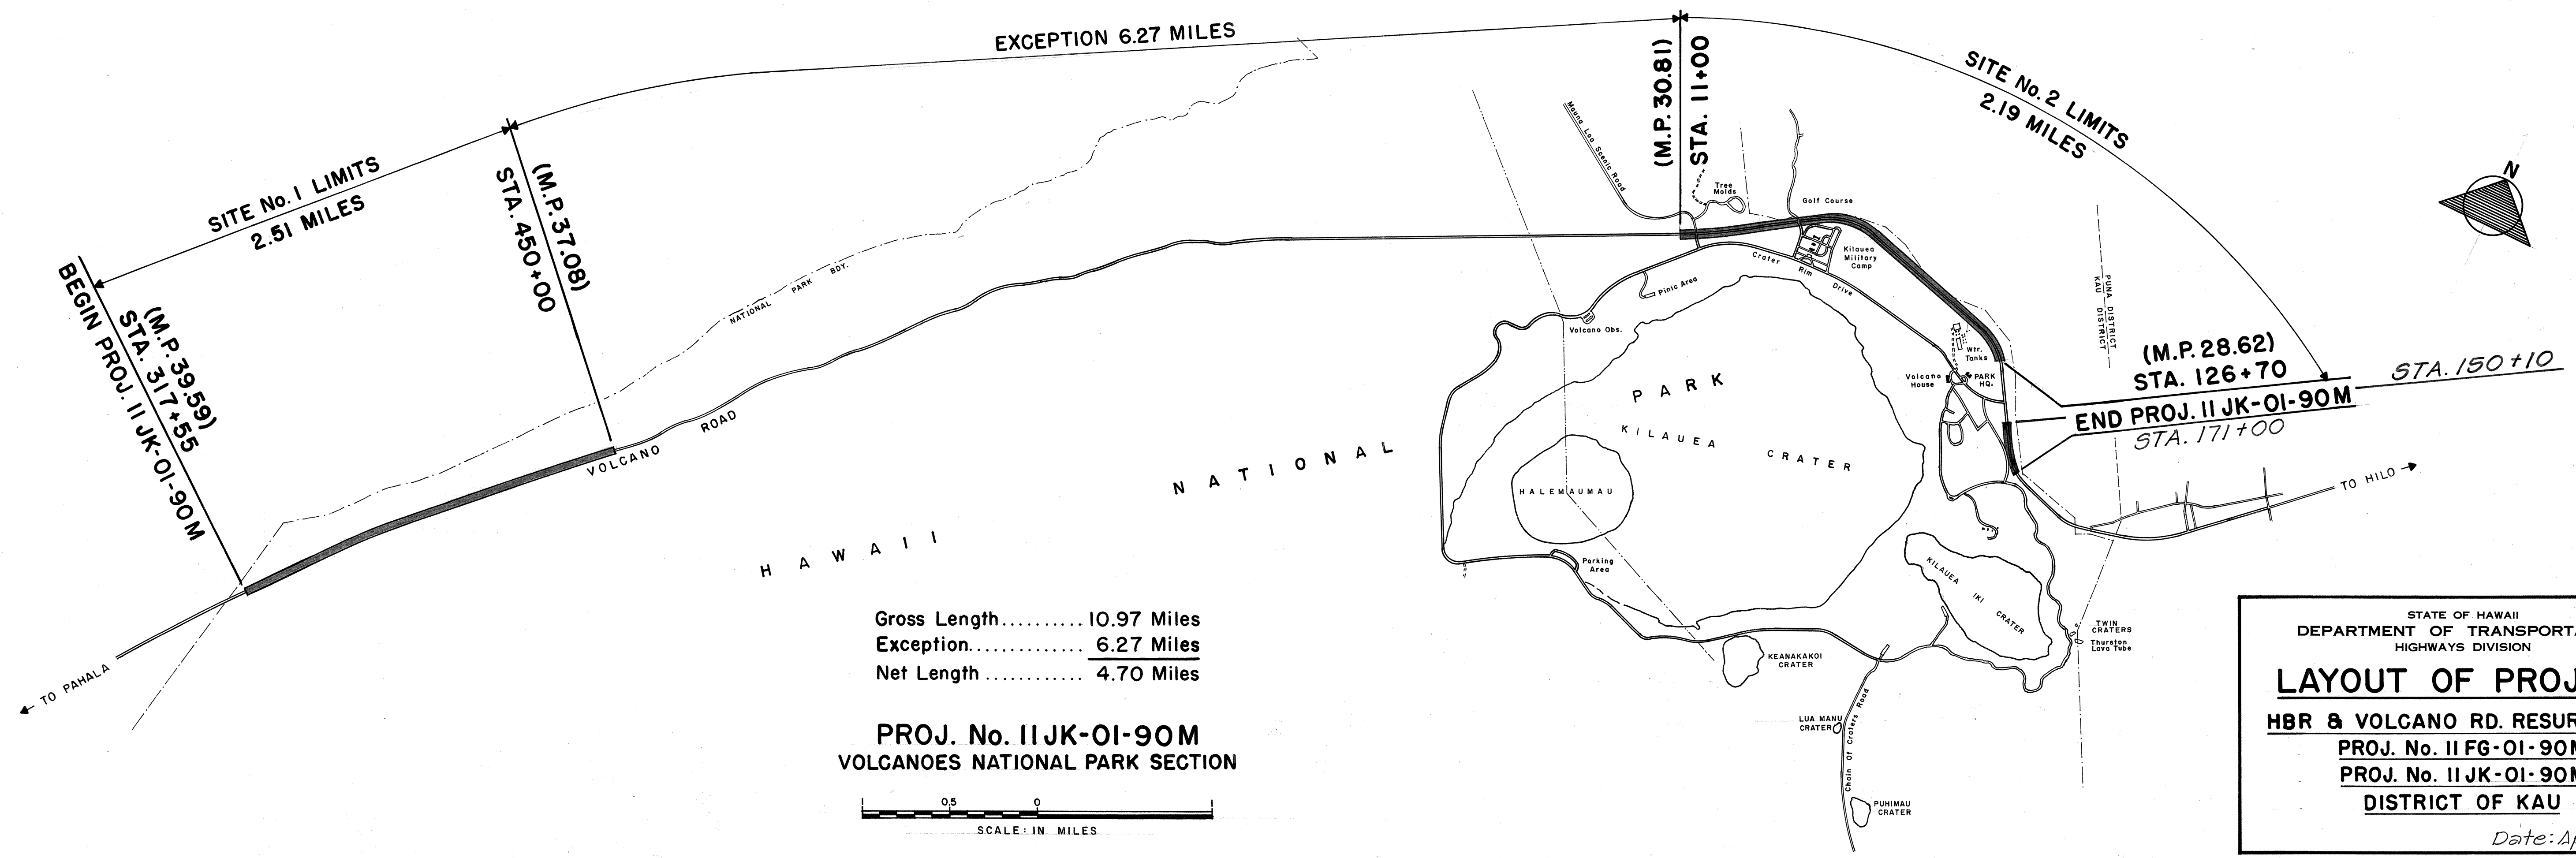


PROJ. No. 11FG-01-90M
NINOLE TO HONUAPO

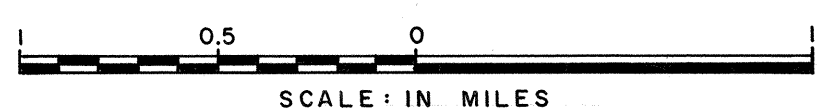

Gross Length..... 10.97 Miles
Exception..... 6.27 Miles
Net Length..... 4.70 Miles

PROJ. No. 11JK-01-90M
VOLCANOES NATIONAL PARK SECTION

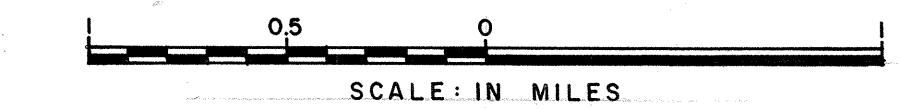

STATE OF HAWAII
DEPARTMENT OF TRANSPORTATION
HIGHWAYS DIVISION

LAYOUT OF PROJECT
HBR & VOLCANO RD. RESURFACING
PROJ. No. 11FG-01-90M
PROJ. No. 11JK-01-90M
DISTRICT OF KAU

Date: April 1989
SHEET No. 1 OF 1 SHEETS

SURVEY PLOTTED BY	DATE
DRAWN BY	
DESIGNED BY	
CHECKED BY	
NOTE BOOK	
No.	