


FED. ROAD DIST. NO.	STATE	FED. AID PROJ. NO.	FISCAL YEAR	SHEET NO.	TOTAL SHEETS
HAWAII	HAW.	11FG-01-20M	1990	6	14

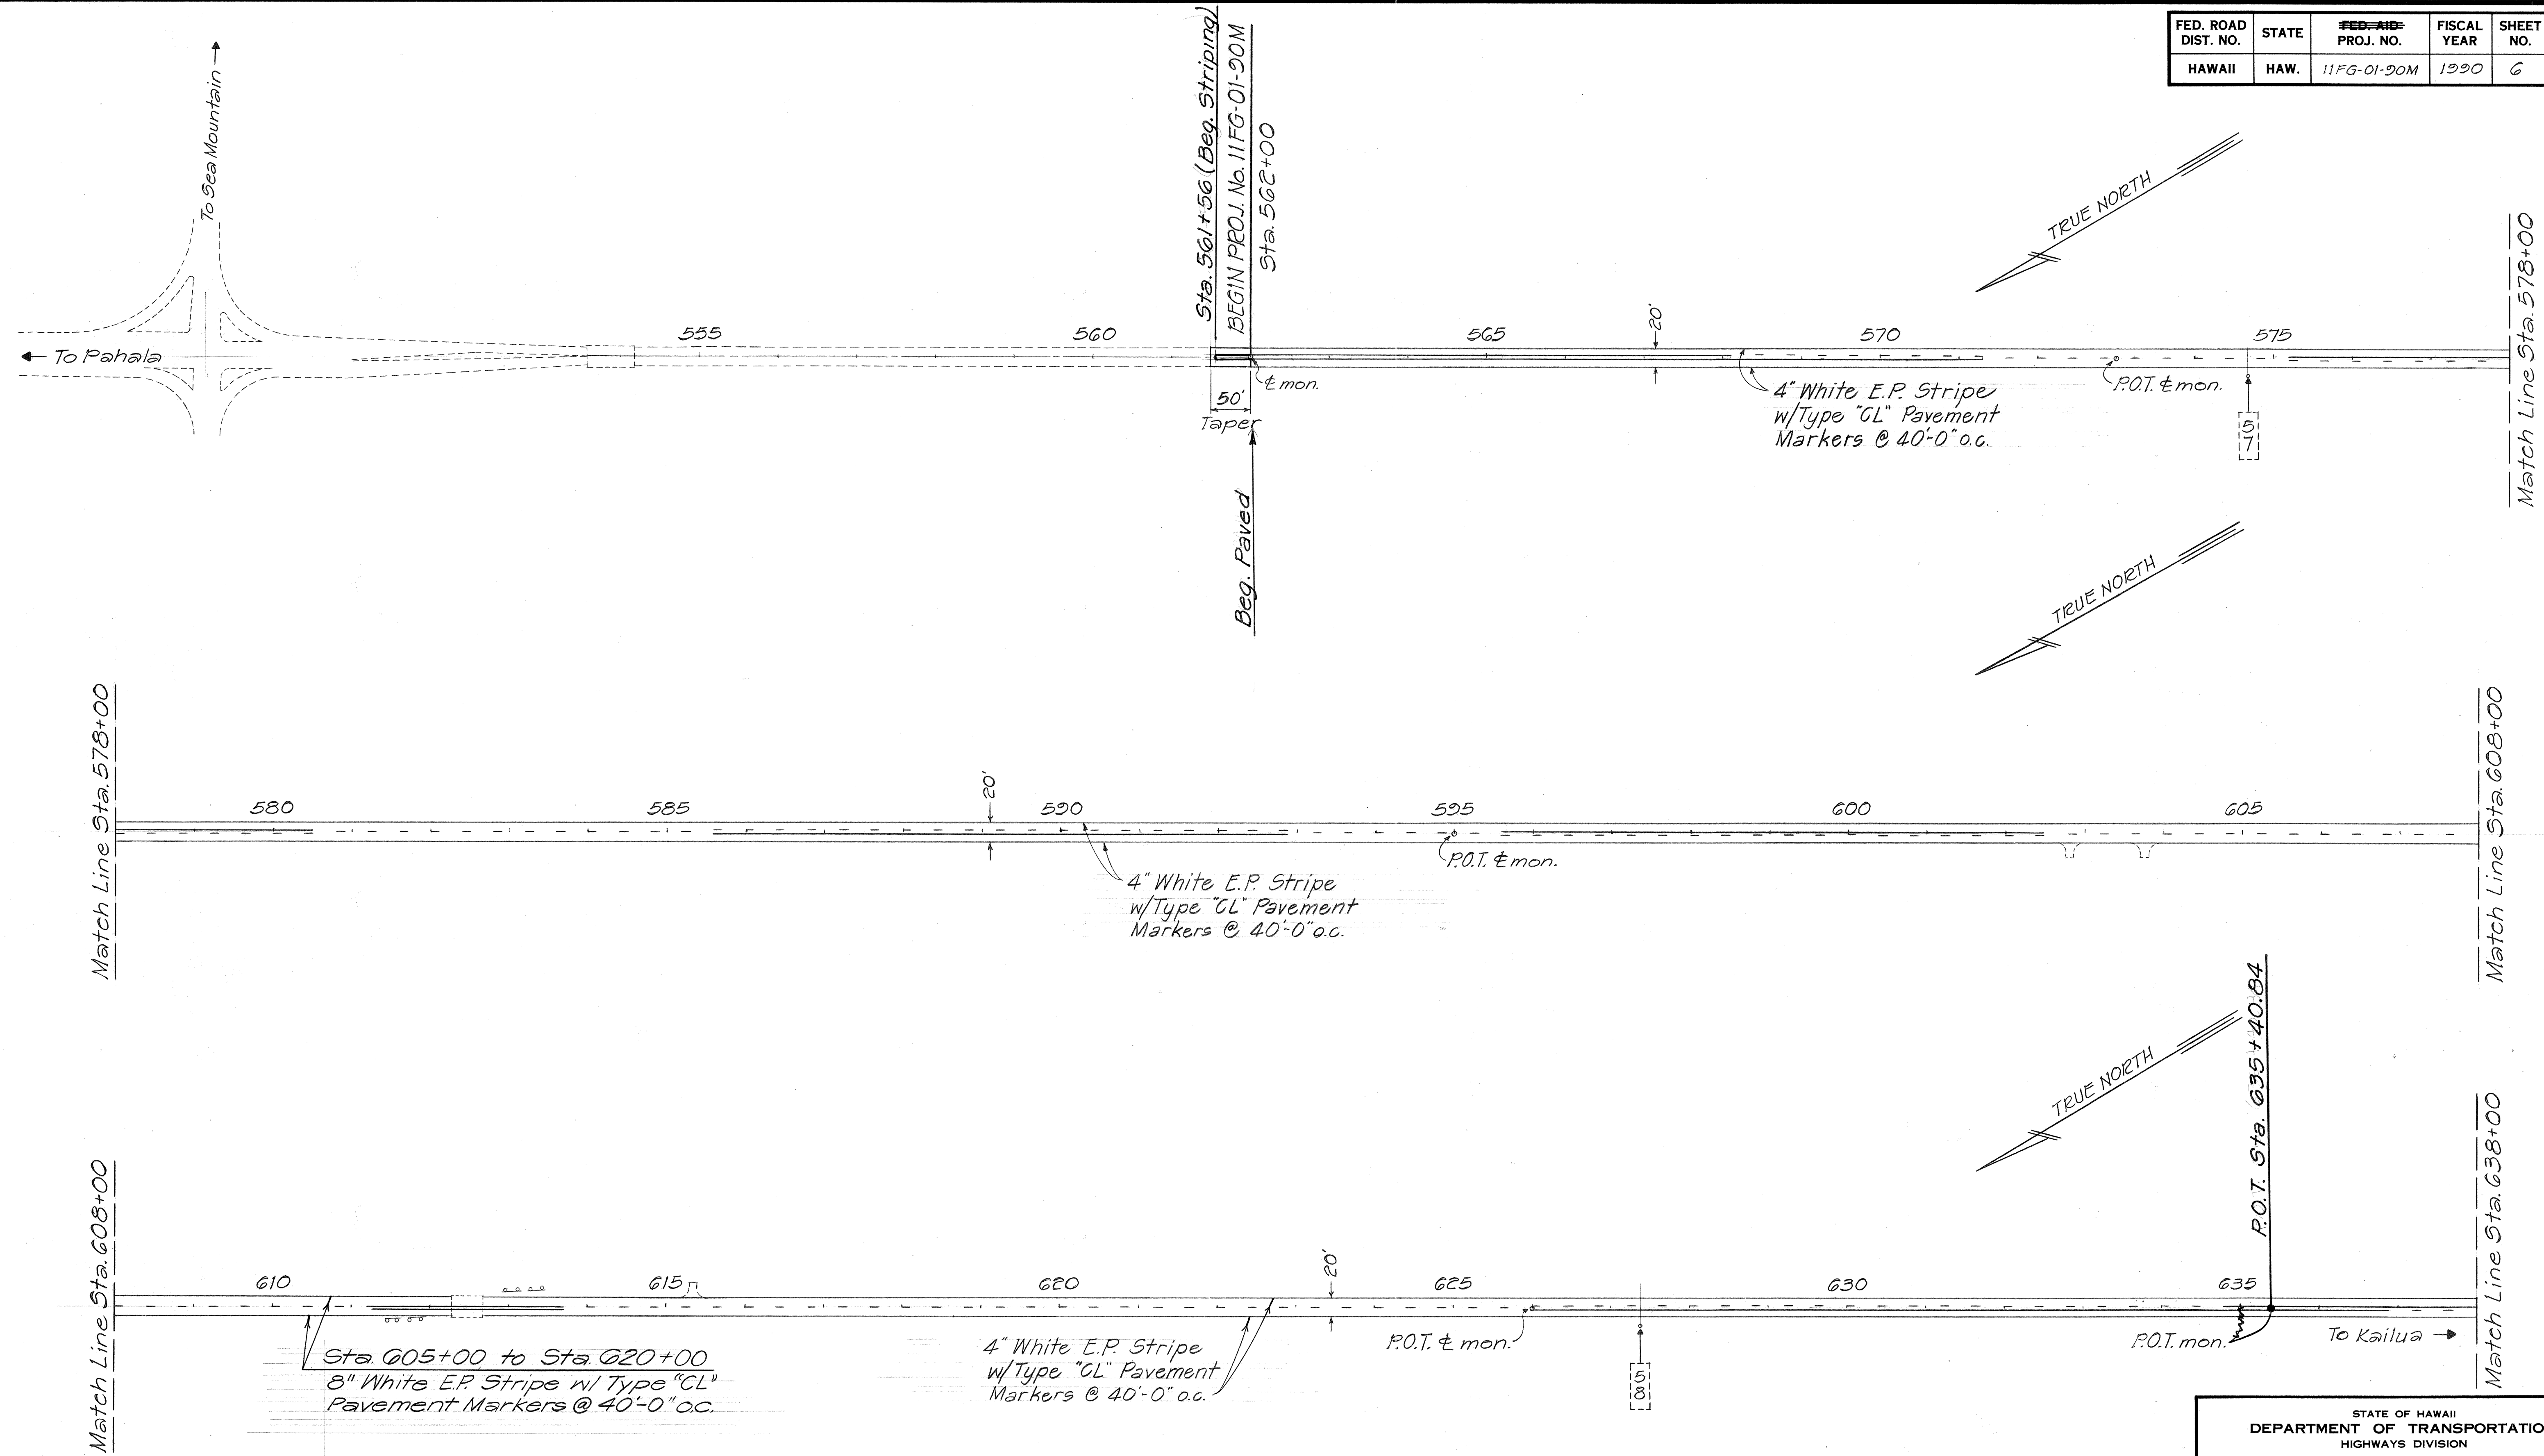

ORIGINAL PLAN	SURVEY PLOTTED BY	DATE
NOTE BOOK	DRAWN BY	
	DESIGNED BY	
	QUANTITIES BY	
	CHECKED BY	


STATE OF HAWAII
DEPARTMENT OF TRANSPORTATION
HIGHWAYS DIVISION

ROADWAY AND STRIPING PLAN
HAWAII BELT ROAD RESURFACING
NINOLE TO HONUAPO
PROJ. No. 11FG-01-20M

Scale: 1" = 100' Date: April 1989

SHEET No. 1 OF 3 SHEETS

FED. ROAD DIST. NO.	STATE	FED. AID PROJ. NO.	FISCAL YEAR	SHEET NO.	TOTAL SHEETS
HAWAII	HAW.	11FG-01-20M	1990	7	14

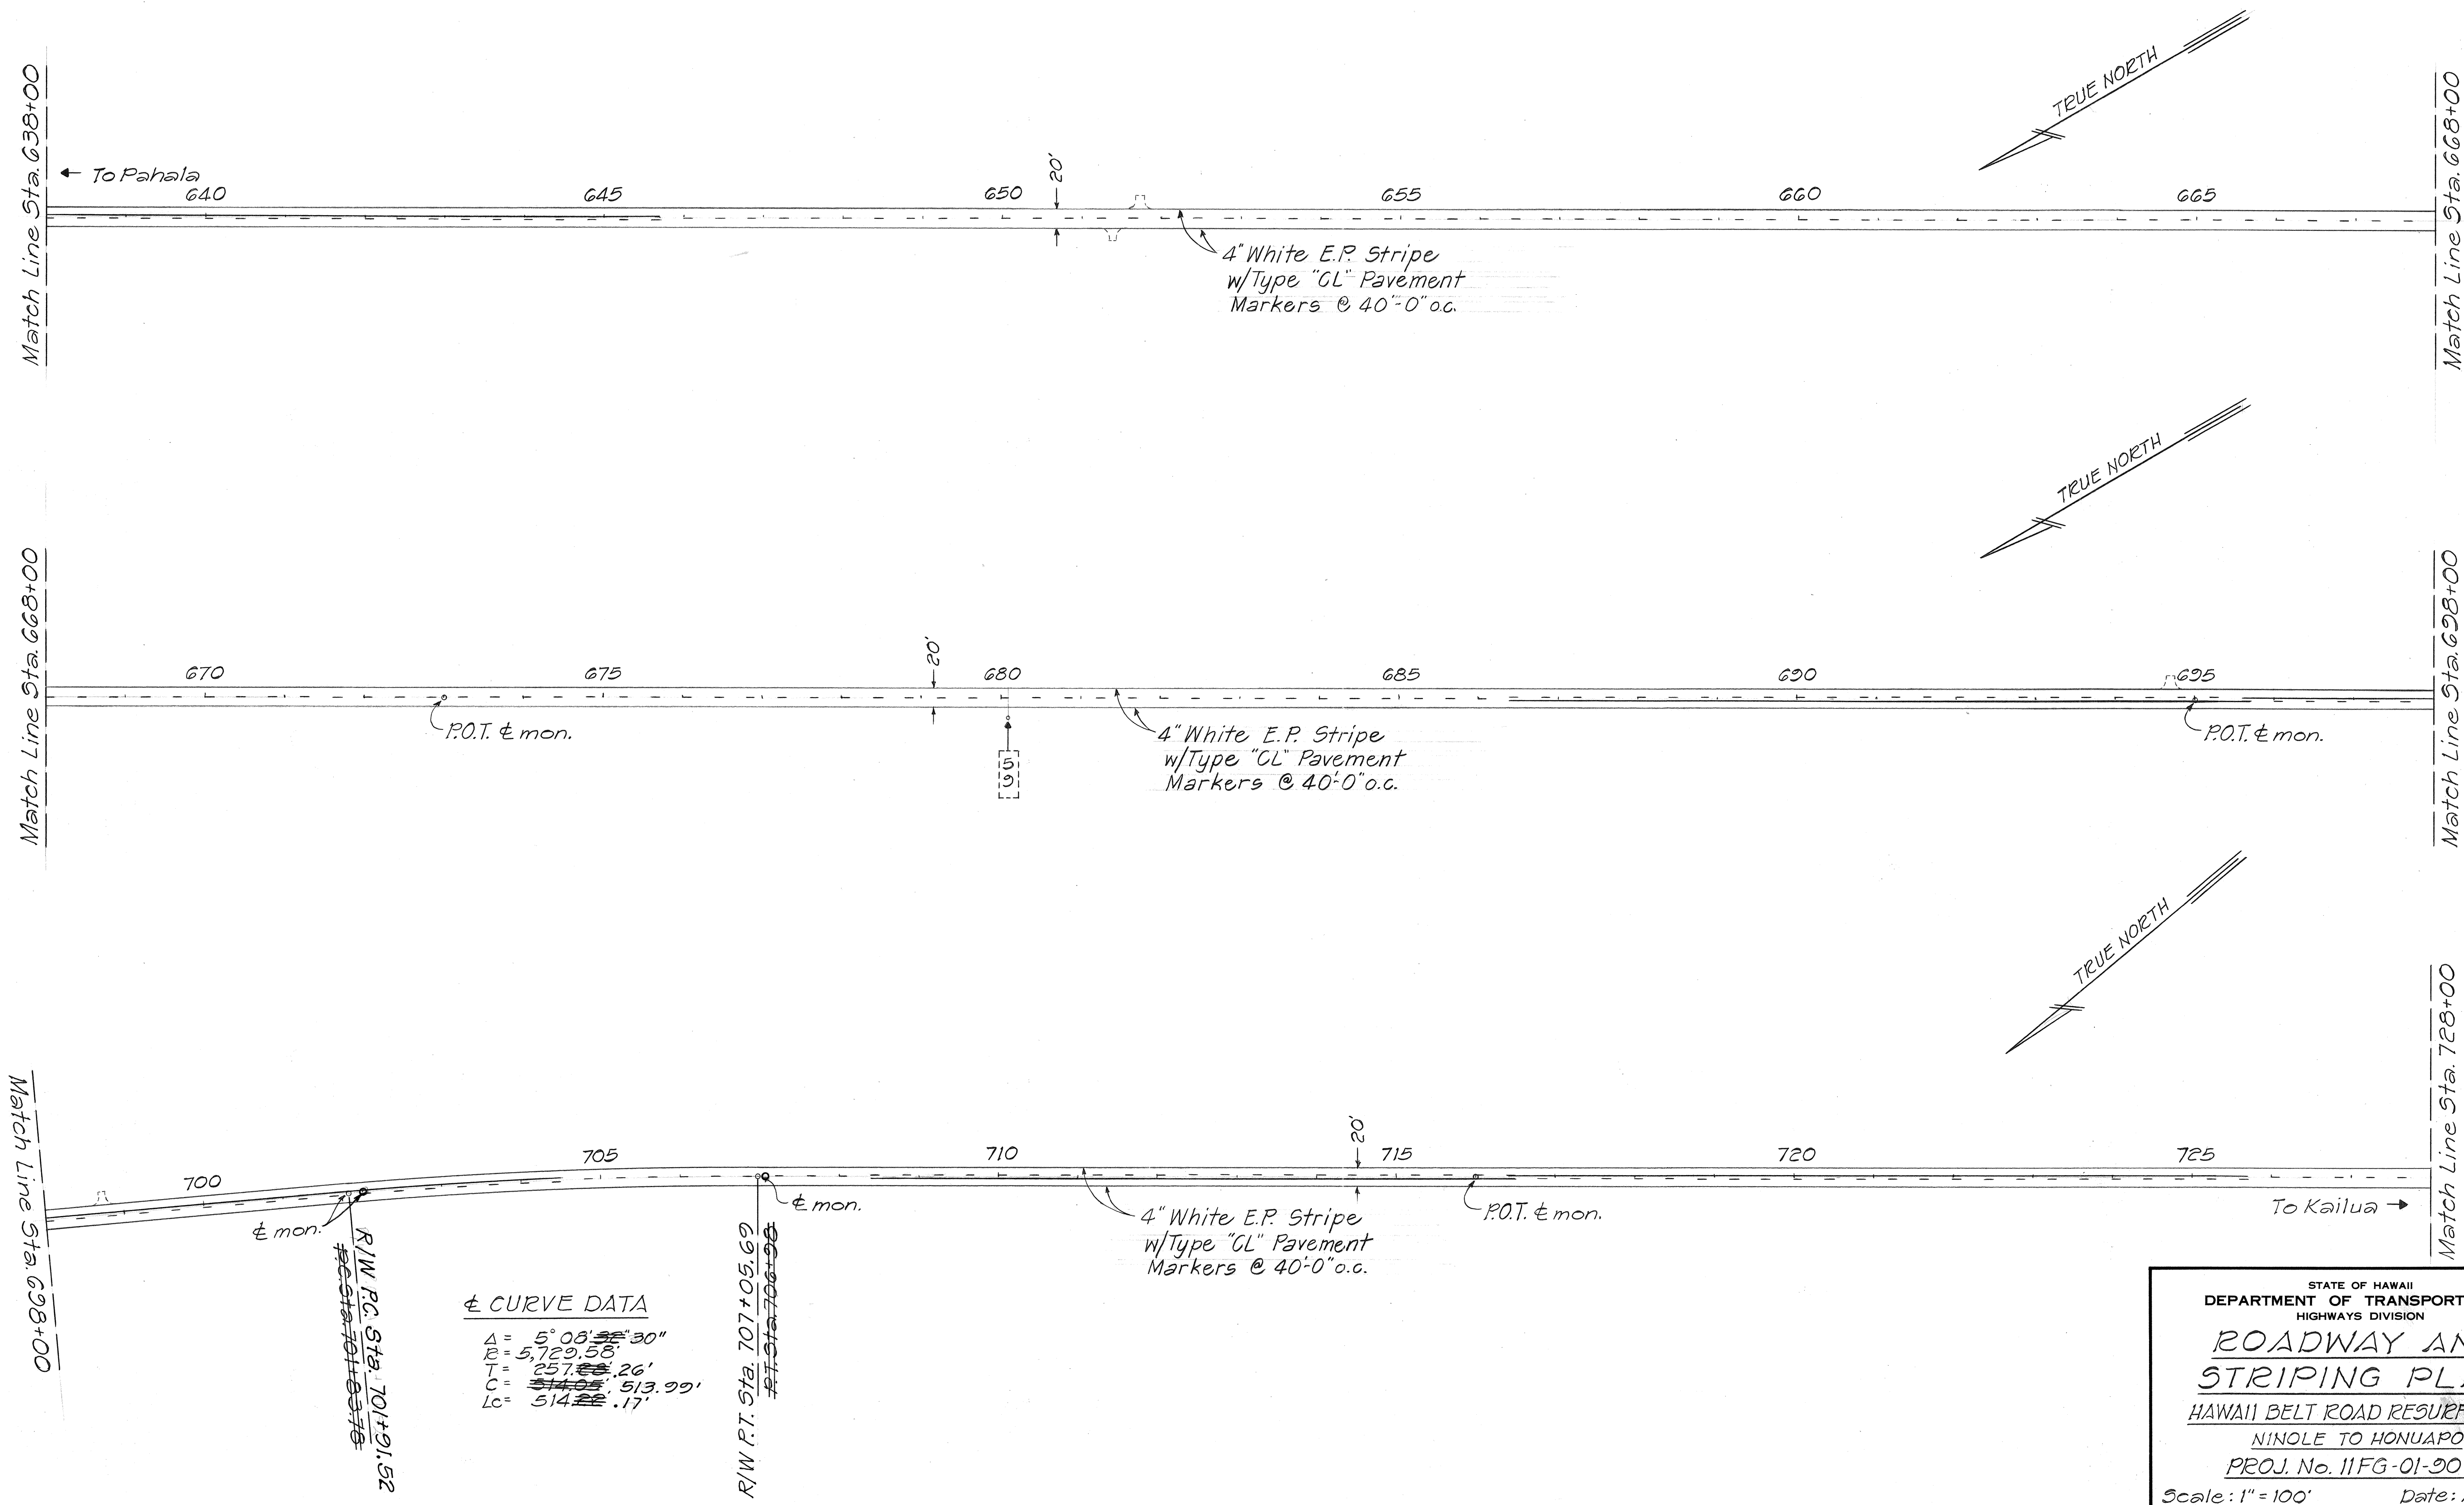


$\Delta = 5^{\circ} 03' 30''$
 $R = 5,729.58'$
 $T = 257.88'$
 $C = 514.05'$
 $Lc = 514.22'$

STATE OF HAWAII
 DEPARTMENT OF TRANSPORTATION
 HIGHWAYS DIVISION
ROADWAY AND STRIPING PLAN
 HAWAII BELT ROAD RESURFACING
 NINOLE TO HONUAPO
 PROJ. No. 11FG-01-20M
 Scale: 1" = 100' Date: April 1989
SHEET No. 2 OF 3 SHEETS

ORIGINAL PLAN	DATE
SURVEY PLOTTED BY	
DRAWN BY	
DESIGNED BY	
QUANTITIES BY	
CHECKED BY	
NOTE BOOK	
NO.	

FED. ROAD DIST. NO.	STATE	FED. AID PROJ. NO.	FISCAL YEAR	SHEET NO.	TOTAL SHEETS
HAWAII	HAW.	11FG-01-20M	1990	8	14

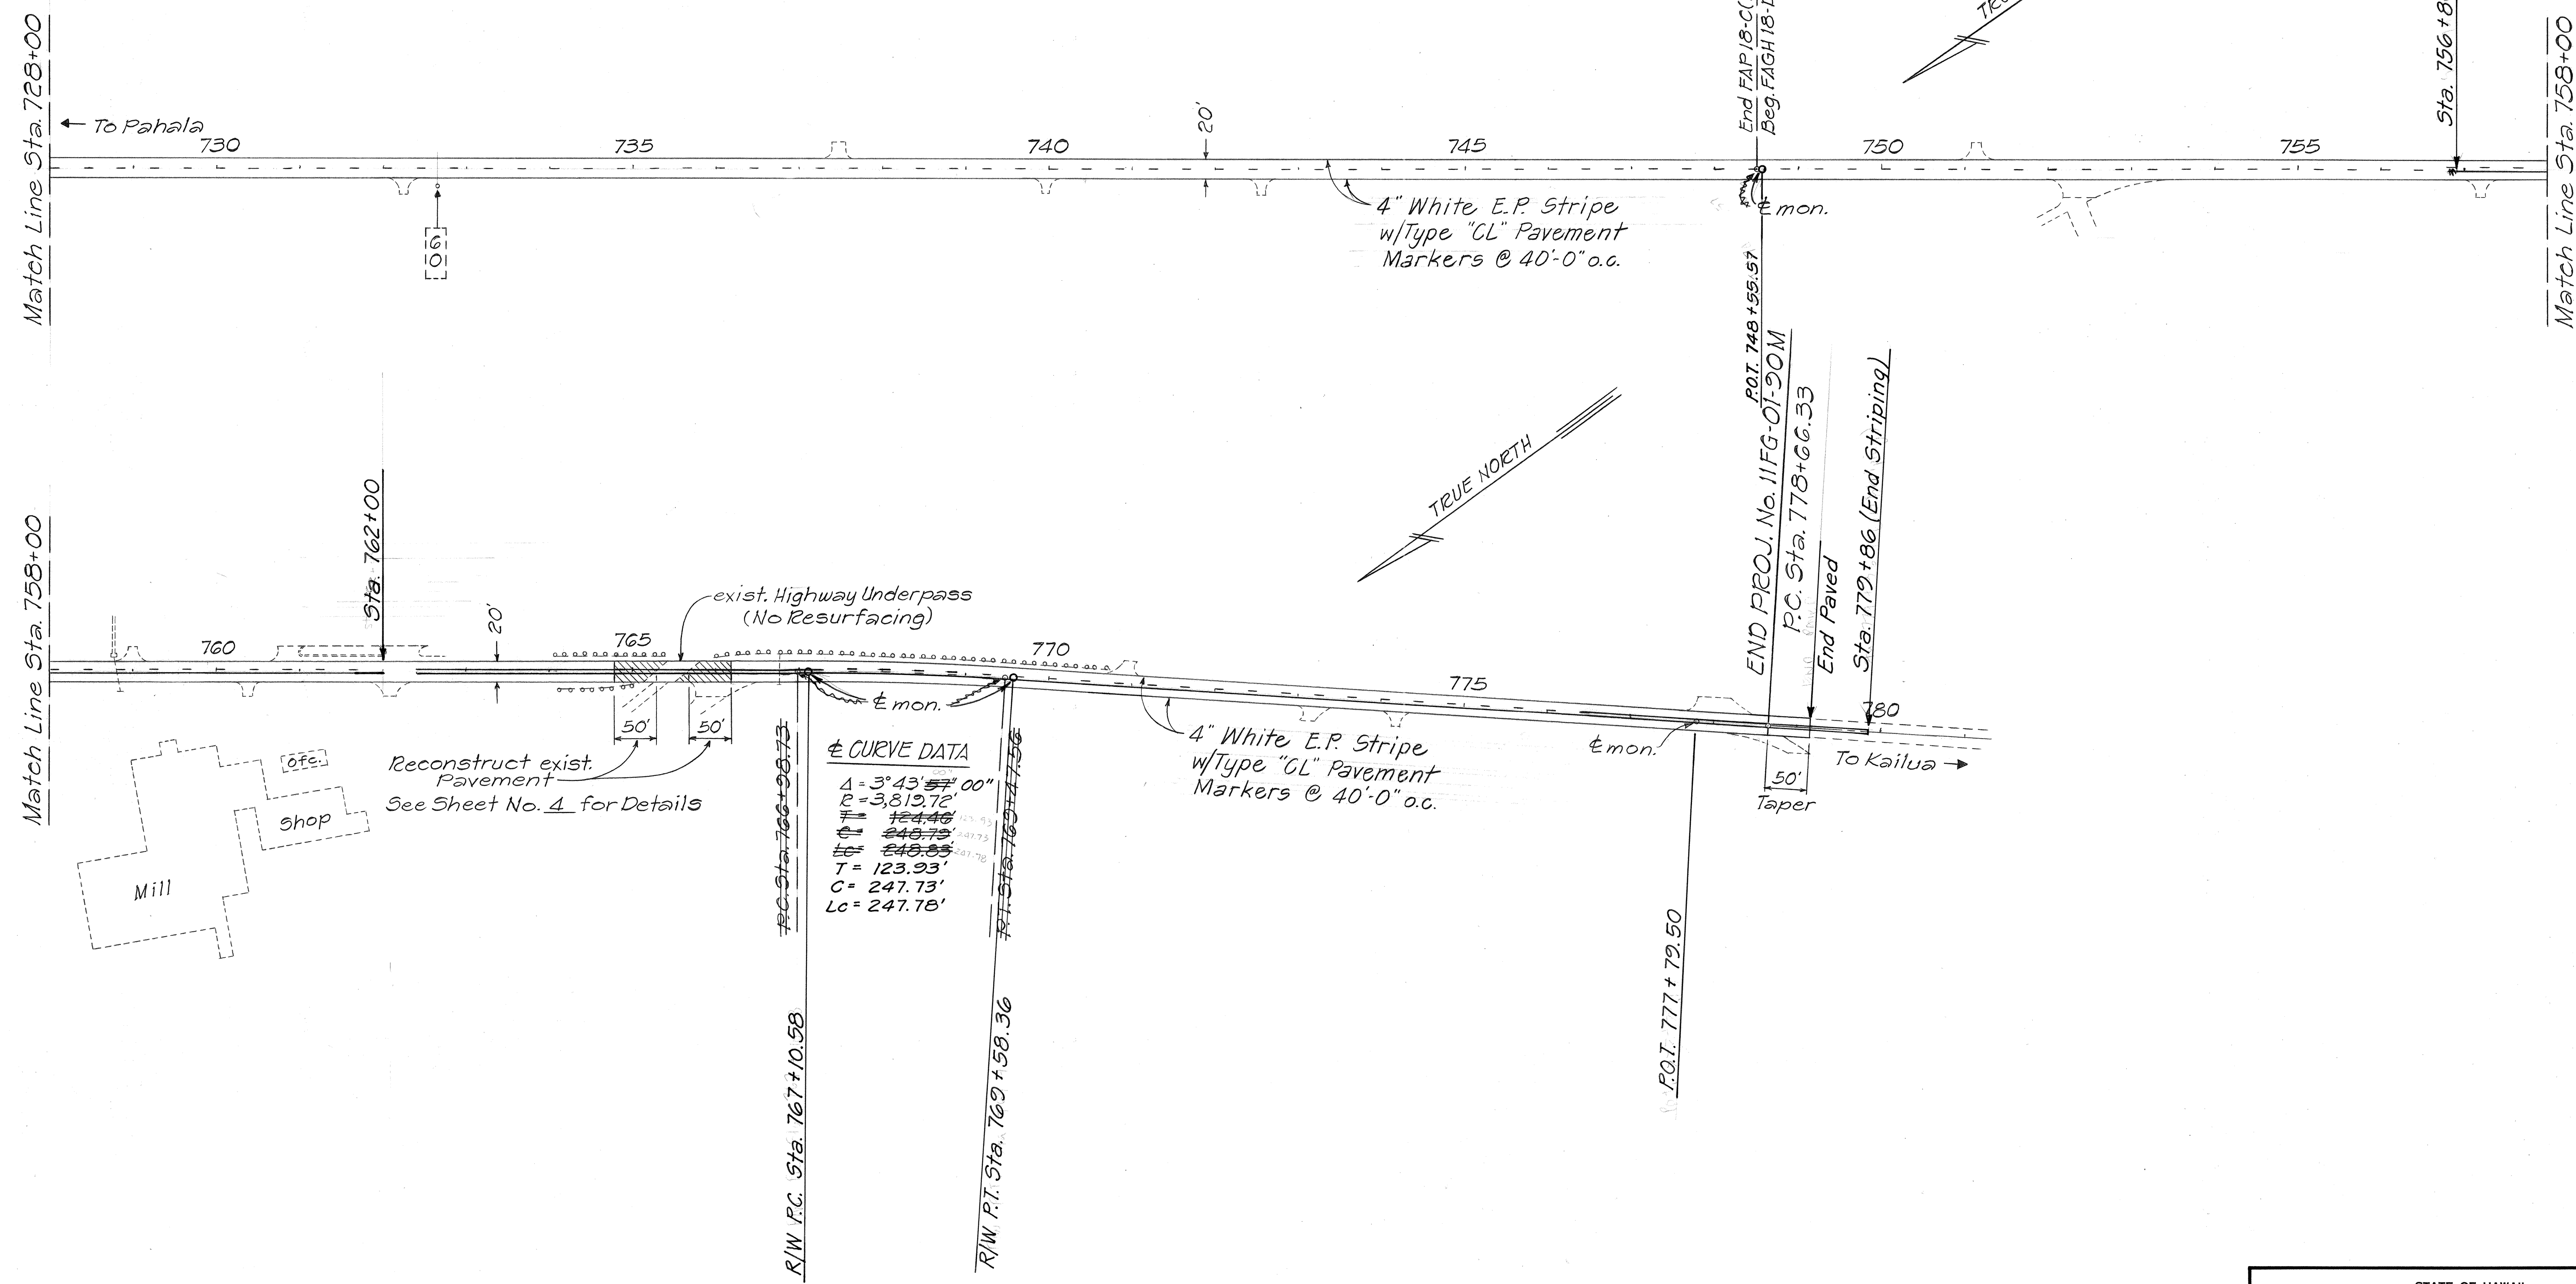

ORIGINAL PLAN	SURVEY PLOTTED BY	DATE
NOTE BOOK	DRAWN BY	
No.	DESIGNED BY	
	QUANTITIES BY	
	CHECKED BY	

STATE OF HAWAII
DEPARTMENT OF TRANSPORTATION
HIGHWAYS DIVISION

ROADWAY AND STRIPING PLAN

HAWAII BELT ROAD RESURFACING
NINOLE TO HONUAPO
PROJ. No. 11FG-01-20M
Scale: 1" = 100' Date: April 1989
SHEET No. 3 OF 3 SHEETS