	INDEX TO DRAWINGS
SHEET NO.	DESCRIPTION
	TITLE SHEET
2	STANDARD PLANS SUMMARY
3	LAYOUT OF PROJECTS
4	TYPICAL SECTIONS (IIFG-01-90M)
5	TYPICAL SECTIONS (IIJK-01-90M)
6-8	ROADWAY PLANS (IIFG-01-90M)
9-12	ROADWAY PLANS (IIJK-01-90M)
13	MISC. SCHEDULES (IIFG-01-90M)
14	MISC. SCHEDULES (IIJK-01-90M)
	e de la companya del companya de la companya del companya de la co
•	

STATE OF HAWAII


DEPARTMENT OF TRANSPORTATION
HIGHWAYS DIVISION
HONOLULU, HAWAII

"AS-BUILT"

PLANS FOR

HAWAII BELT ROAD RESURFACING
NINOLE TO HONUAPO
PROJECT NO. IIFG-01-90 M
DISTRICT OF KAU
ISLAND OF HAWAII

VOLCANO ROAD RESURFACING
VOLCANOES NATIONAL PARK SECTION
PROJECT NO. IIJK-OI-90 M
DISTRICT OF KAU
ISLAND OF HAWAII

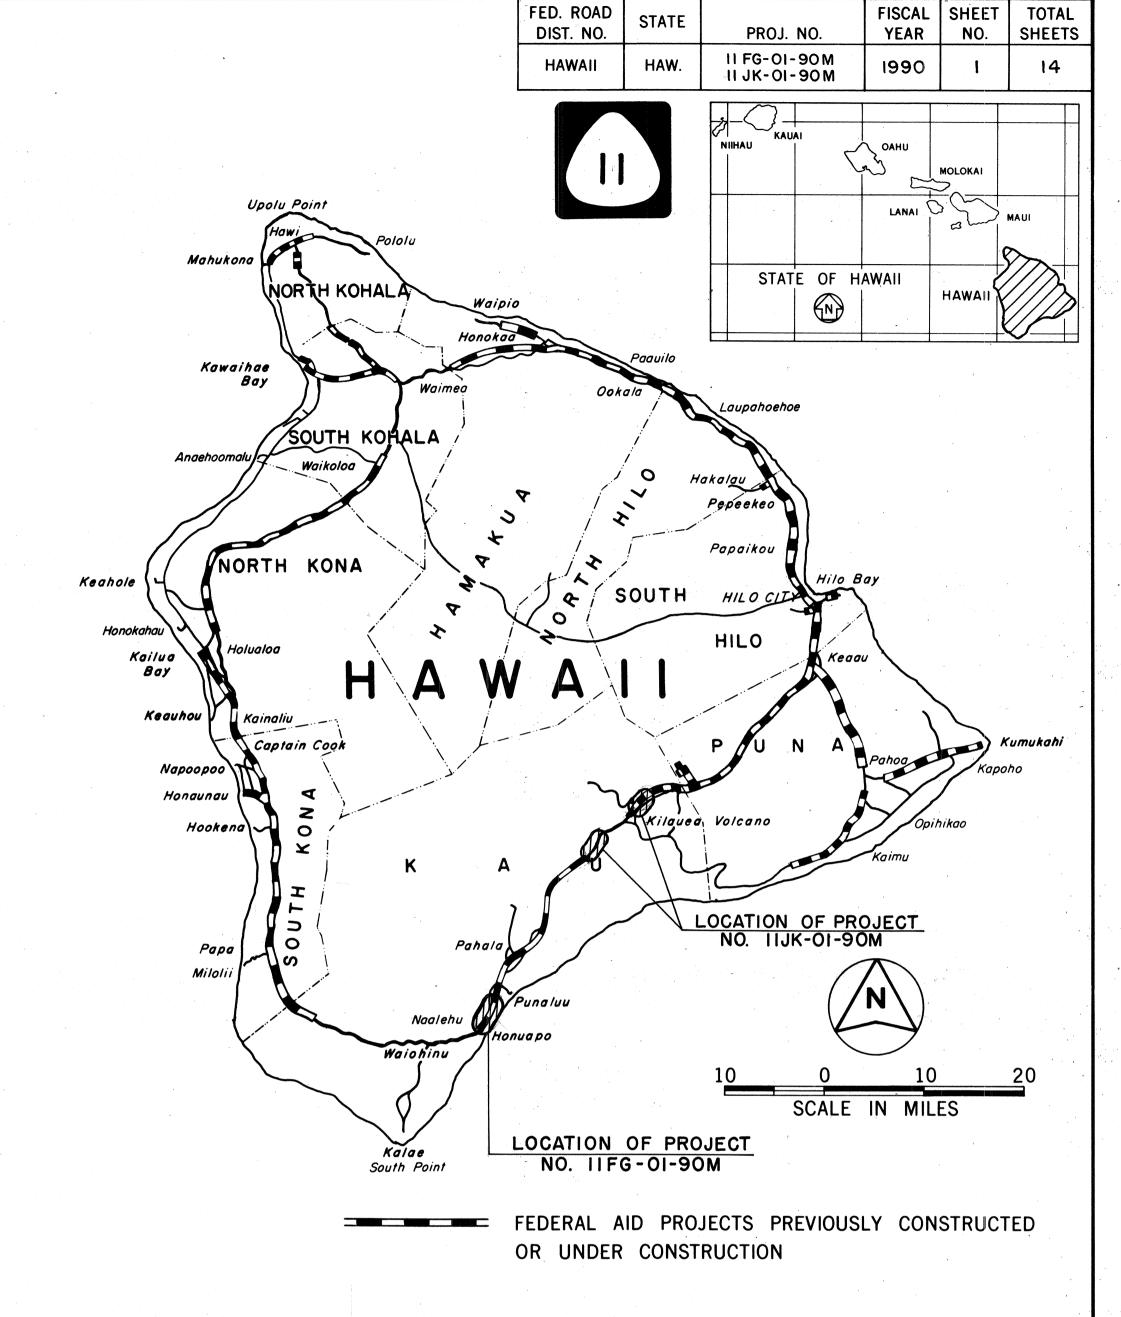

CHANGES MADE DURING CONSTRUCTION HAVE BEEN INCORPORATED ON THESE PLANS EXCEPT CHANGES IN THE ORIGINAL THEORETICAL QUANTITIES. FOR ACTUAL QUANTITIES, REFER TO PROJECT LEDGER AND/OR COMPUTATION BOOK.



<u>/-29-93</u> DATE

DEPARTMENT OF TRANSPORTATION
STATE OF HAWAII

APPROVED:

Signature | 3/19/90
DIR. OF TRANSPORTATION DATE

548-7534 FEB, 1990 PHONE DATE

A. YAMAGUCHI 548-75
P. S. & E. BY PHON

DESIGNED BY

A. YAMA

P. S. &