	INDEX TO DRAWINGS
SHEET NO.	DESCRIPTION
Į.	TITLE SHEET
2	STANDARD PLANS SUMMARY
3	PLAN AND PROFILE
4-5	DRAINAGE DETAILS
6	CROSS SECTIONS
1 (2)	
•	
· <u>x</u>	

STATE OF HAWAII

DEPARTMENT OF TRANSPORTATION

HIGHWAYS DIVISION HONOLULU, HAWAII


"AS-BUILT"
PLANS FOR

HAWAII BELT ROAD DRAINAGE IMPROVEMENTS

VICINITY OF OLD HONAUNAU POST OFFICE

PROJECT NO. II B-01-89

DISTRICT OF SOUTH KONA
ISLAND OF HAWAII

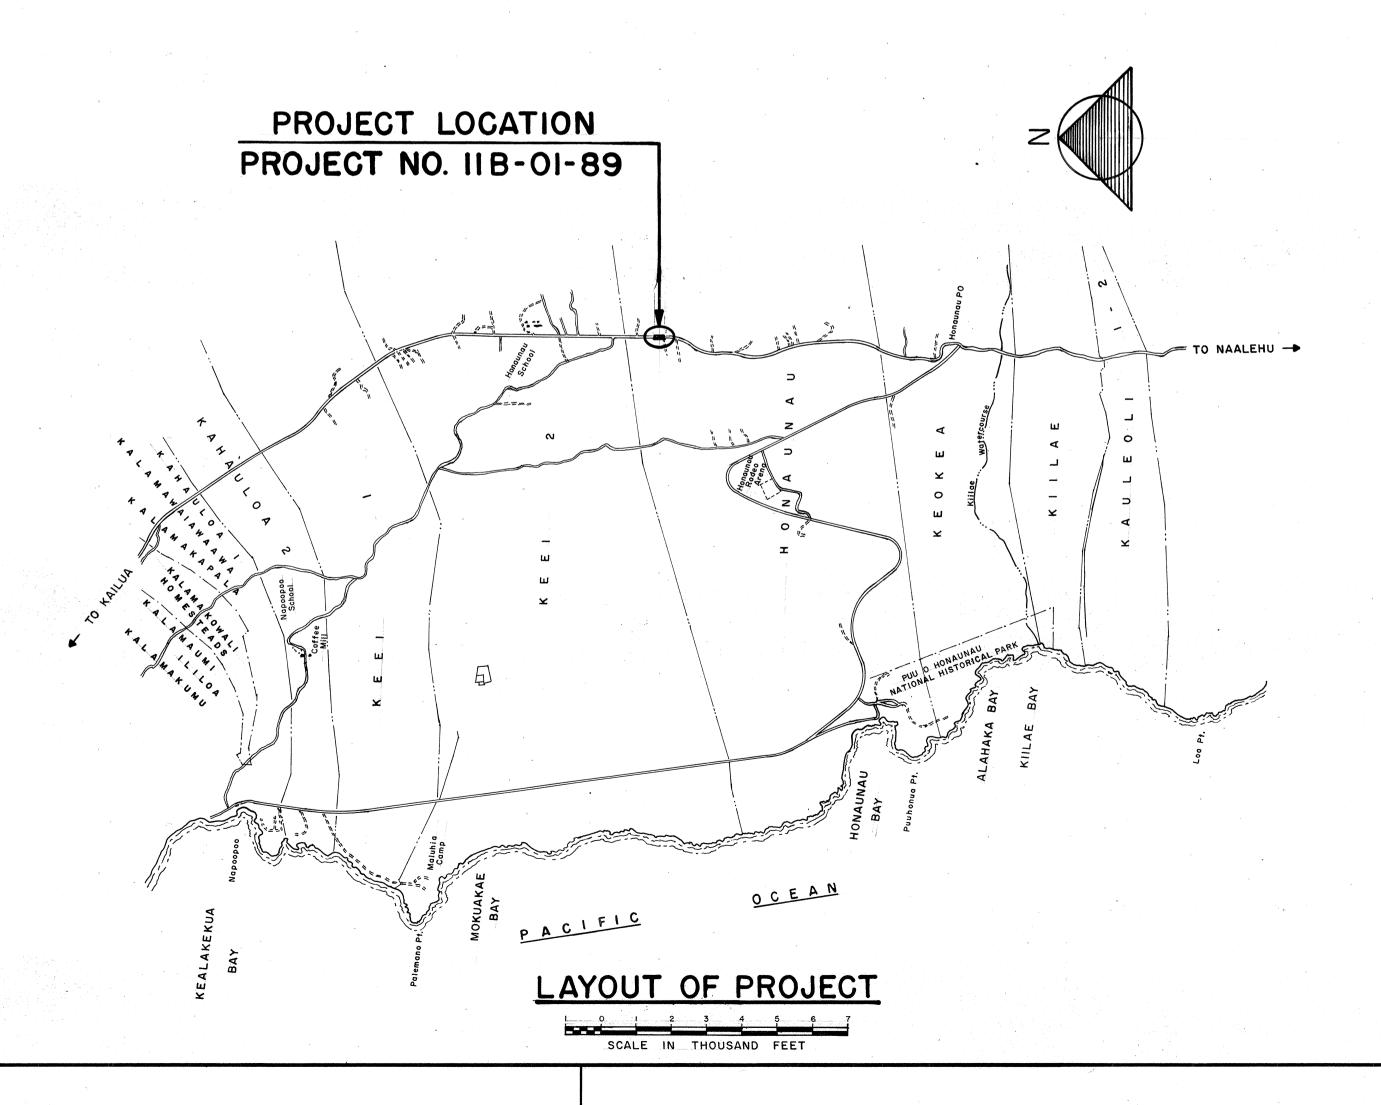

NTS

NORTH KOHALA

Mondation

North Kohala

North Mondation

North

FED. ROAD DIST. NO. FISCAL SHEET TOTAL YEAR NO. SHEETS

PROJ. NO.

IIB-01-89

MILE POST 105.51 TO MILE POST 105.57

CHANGES MADE DURING CONSTRUCTION HAVE BEEN INCORPORATED ON THESE PLANS EXCEPT CHANGES IN THE ORIGINAL THEORETICAL QUANTITIES.

OR UNDER CONSTRUCTION

Robert & 2-11-91
RESIDENT ENGINEER DATE

DEPARTMENT OF TRANSPORTATION
STATE OF HAWAII

APPROVED:

Llus / 1/30/90

DIR. OF TRANSPORTATION DATE

A. YAMAGUCHI 548-7534 APRIL,199
P. S. & E. BY PHONE DATE

HAWAII DISTRICT

A. YAMAGUCHI

DESIGNED BY

P. S. & E. BY

F