



FED. ROAD DIST. NO.	STATE	PROJ. NO.	FISCAL YEAR	SHEET NO.	TOTAL SHEETS
HAWAII	HAW.	11BC-01-90	1989	7	36

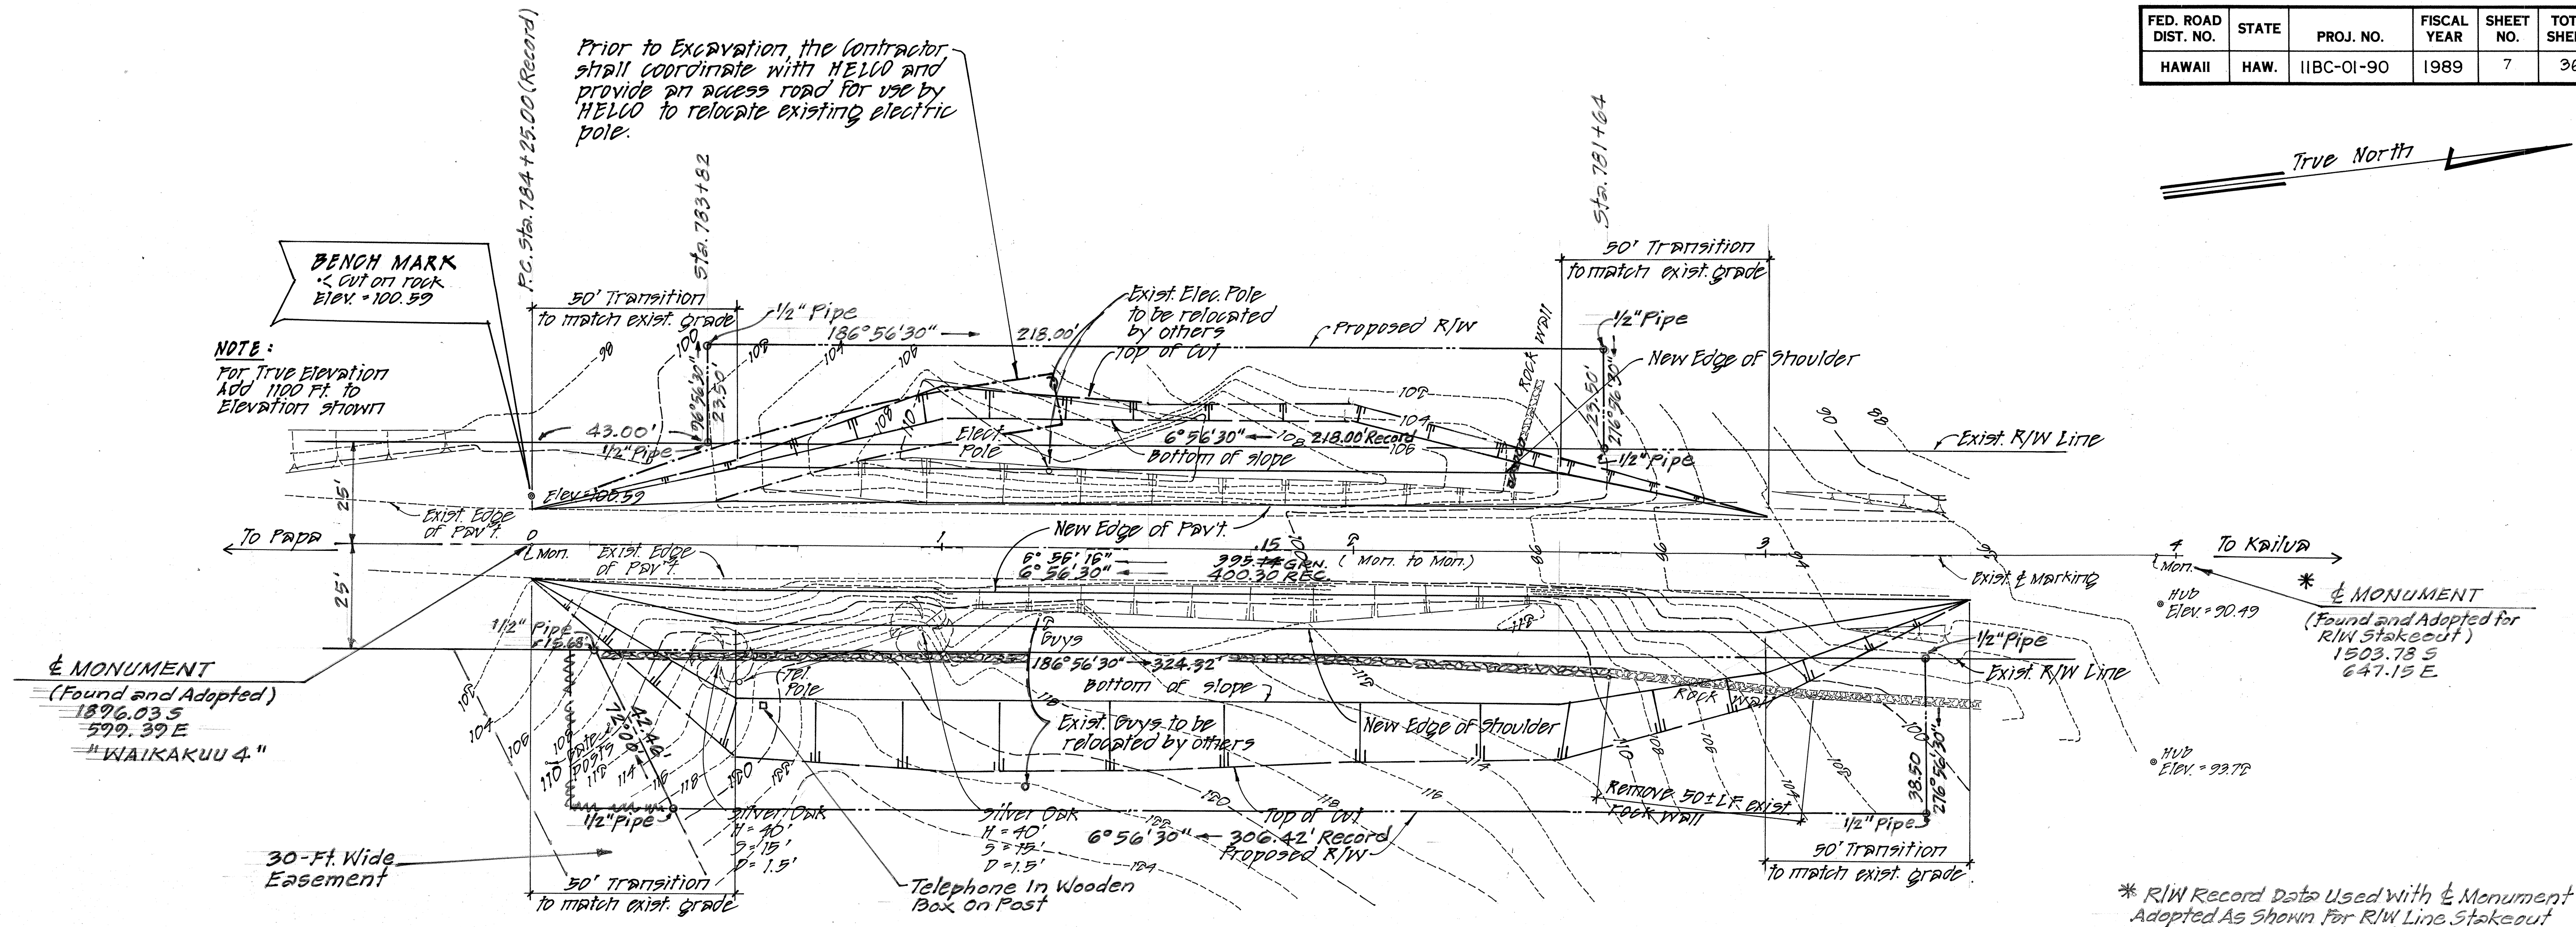

PLAN ~ SITE 4 SHOULDER WIDENING
SCALE: 1" = 20'

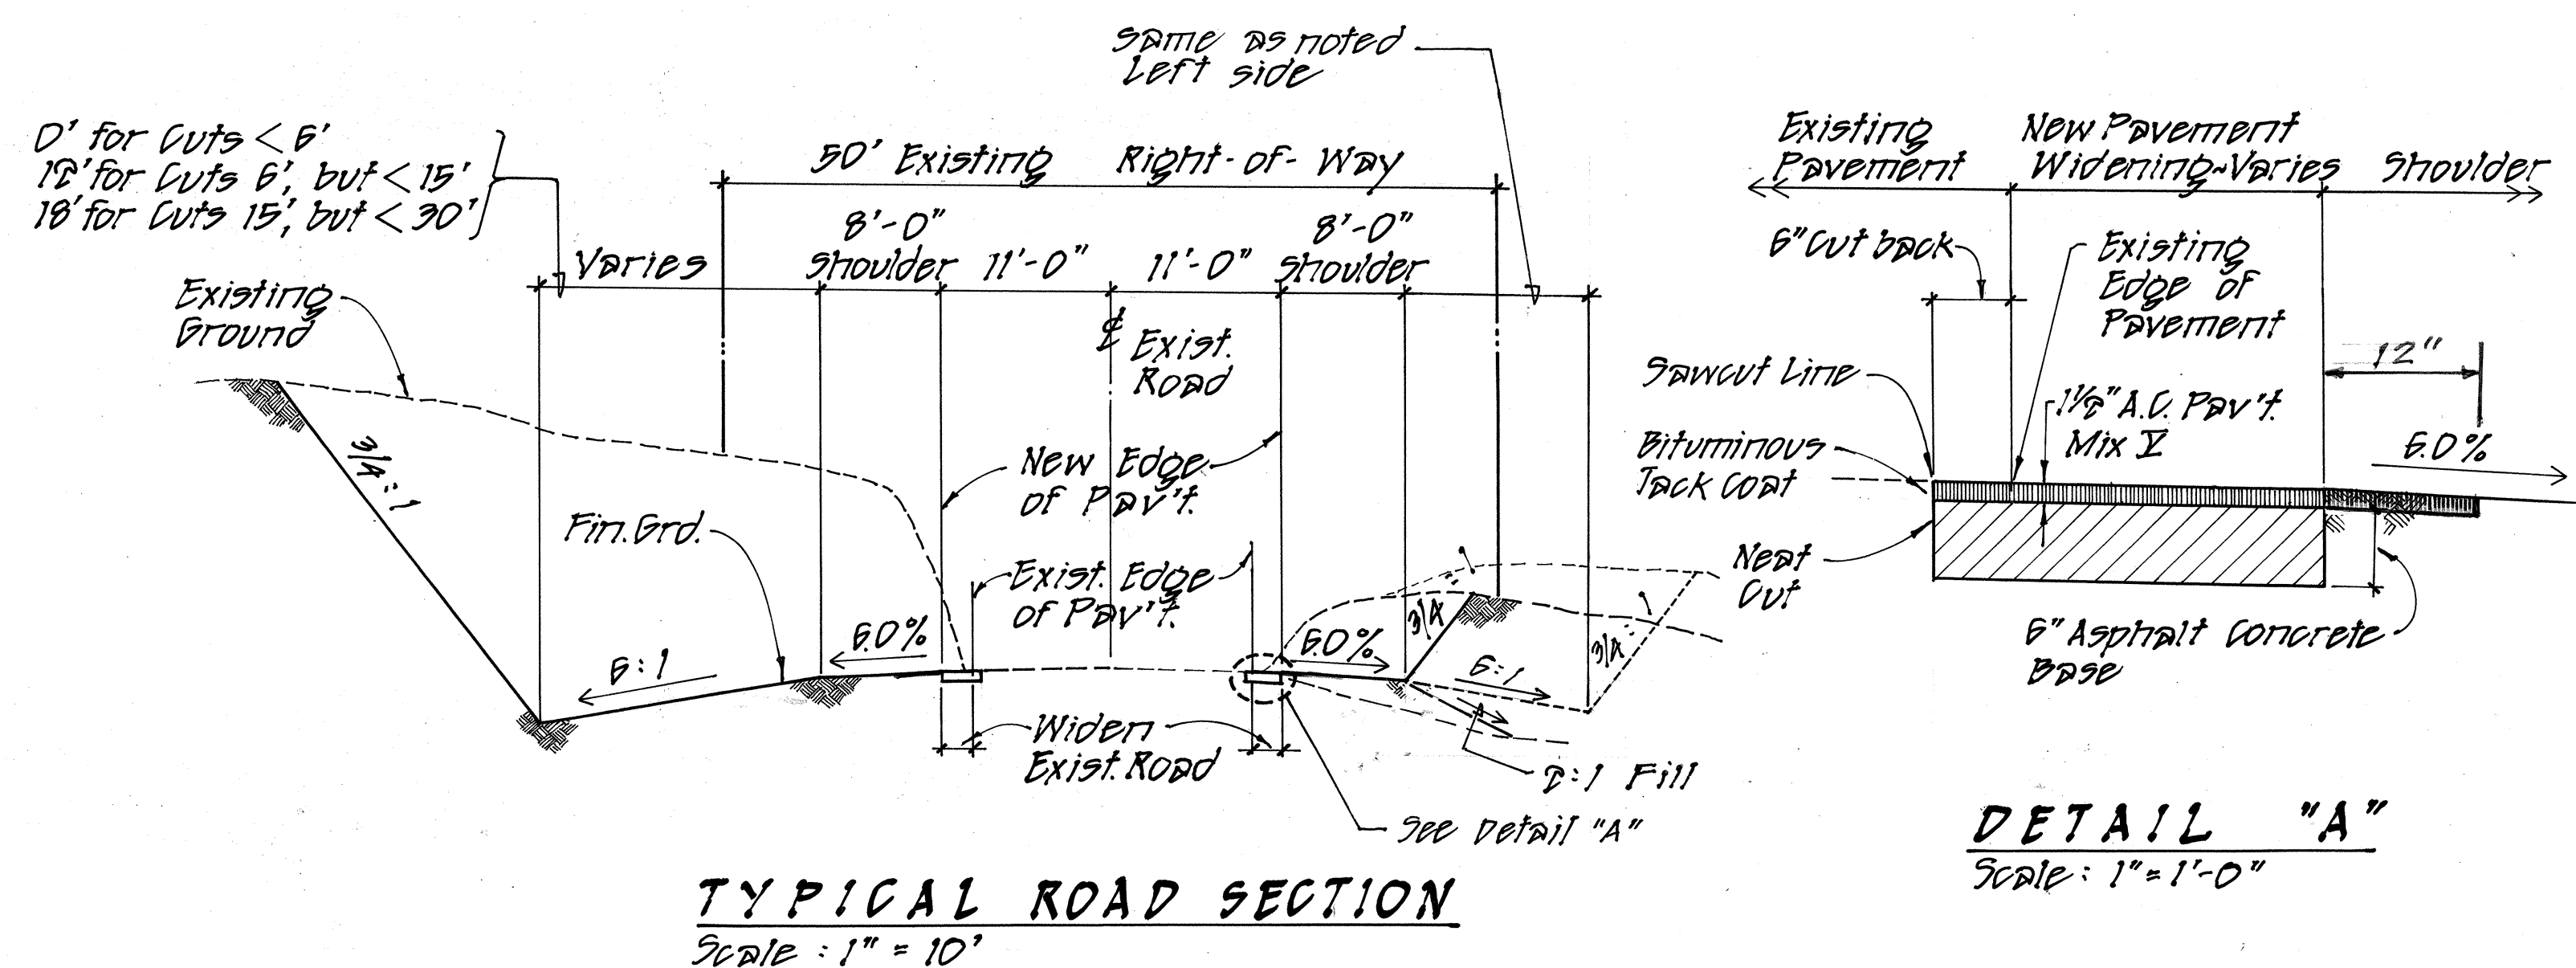

DETAIL "A"
Scale: 1" = 1'-0"



ROBERT I. ITAGAKI
REGISTERED
PROFESSIONAL
ENGINEER
No. 1584-C
HAWAII, U.S.A.

Robert I. Itagaki
THIS WORK WAS PREPARED
BY ME OR UNDER MY SUPERVISION

STATE OF HAWAII
DEPARTMENT OF TRANSPORTATION
HIGHWAYS DIVISION
SITE 4
SHOULDER WIDENING
HAWAII BELT ROAD
SPOT IMPROVEMENTS
PAPA TO HONAUNAU - UNIT I
PROJECT NO. IIBC-01-90

SHEET No. / OF / SHEETS