



FED. ROAD DIST. NO.	STATE	PROJ. NO.	FISCAL YEAR	SHEET NO.	TOTAL SHEETS
HAWAII	HAW.	11BC-01-90	1989	8	36

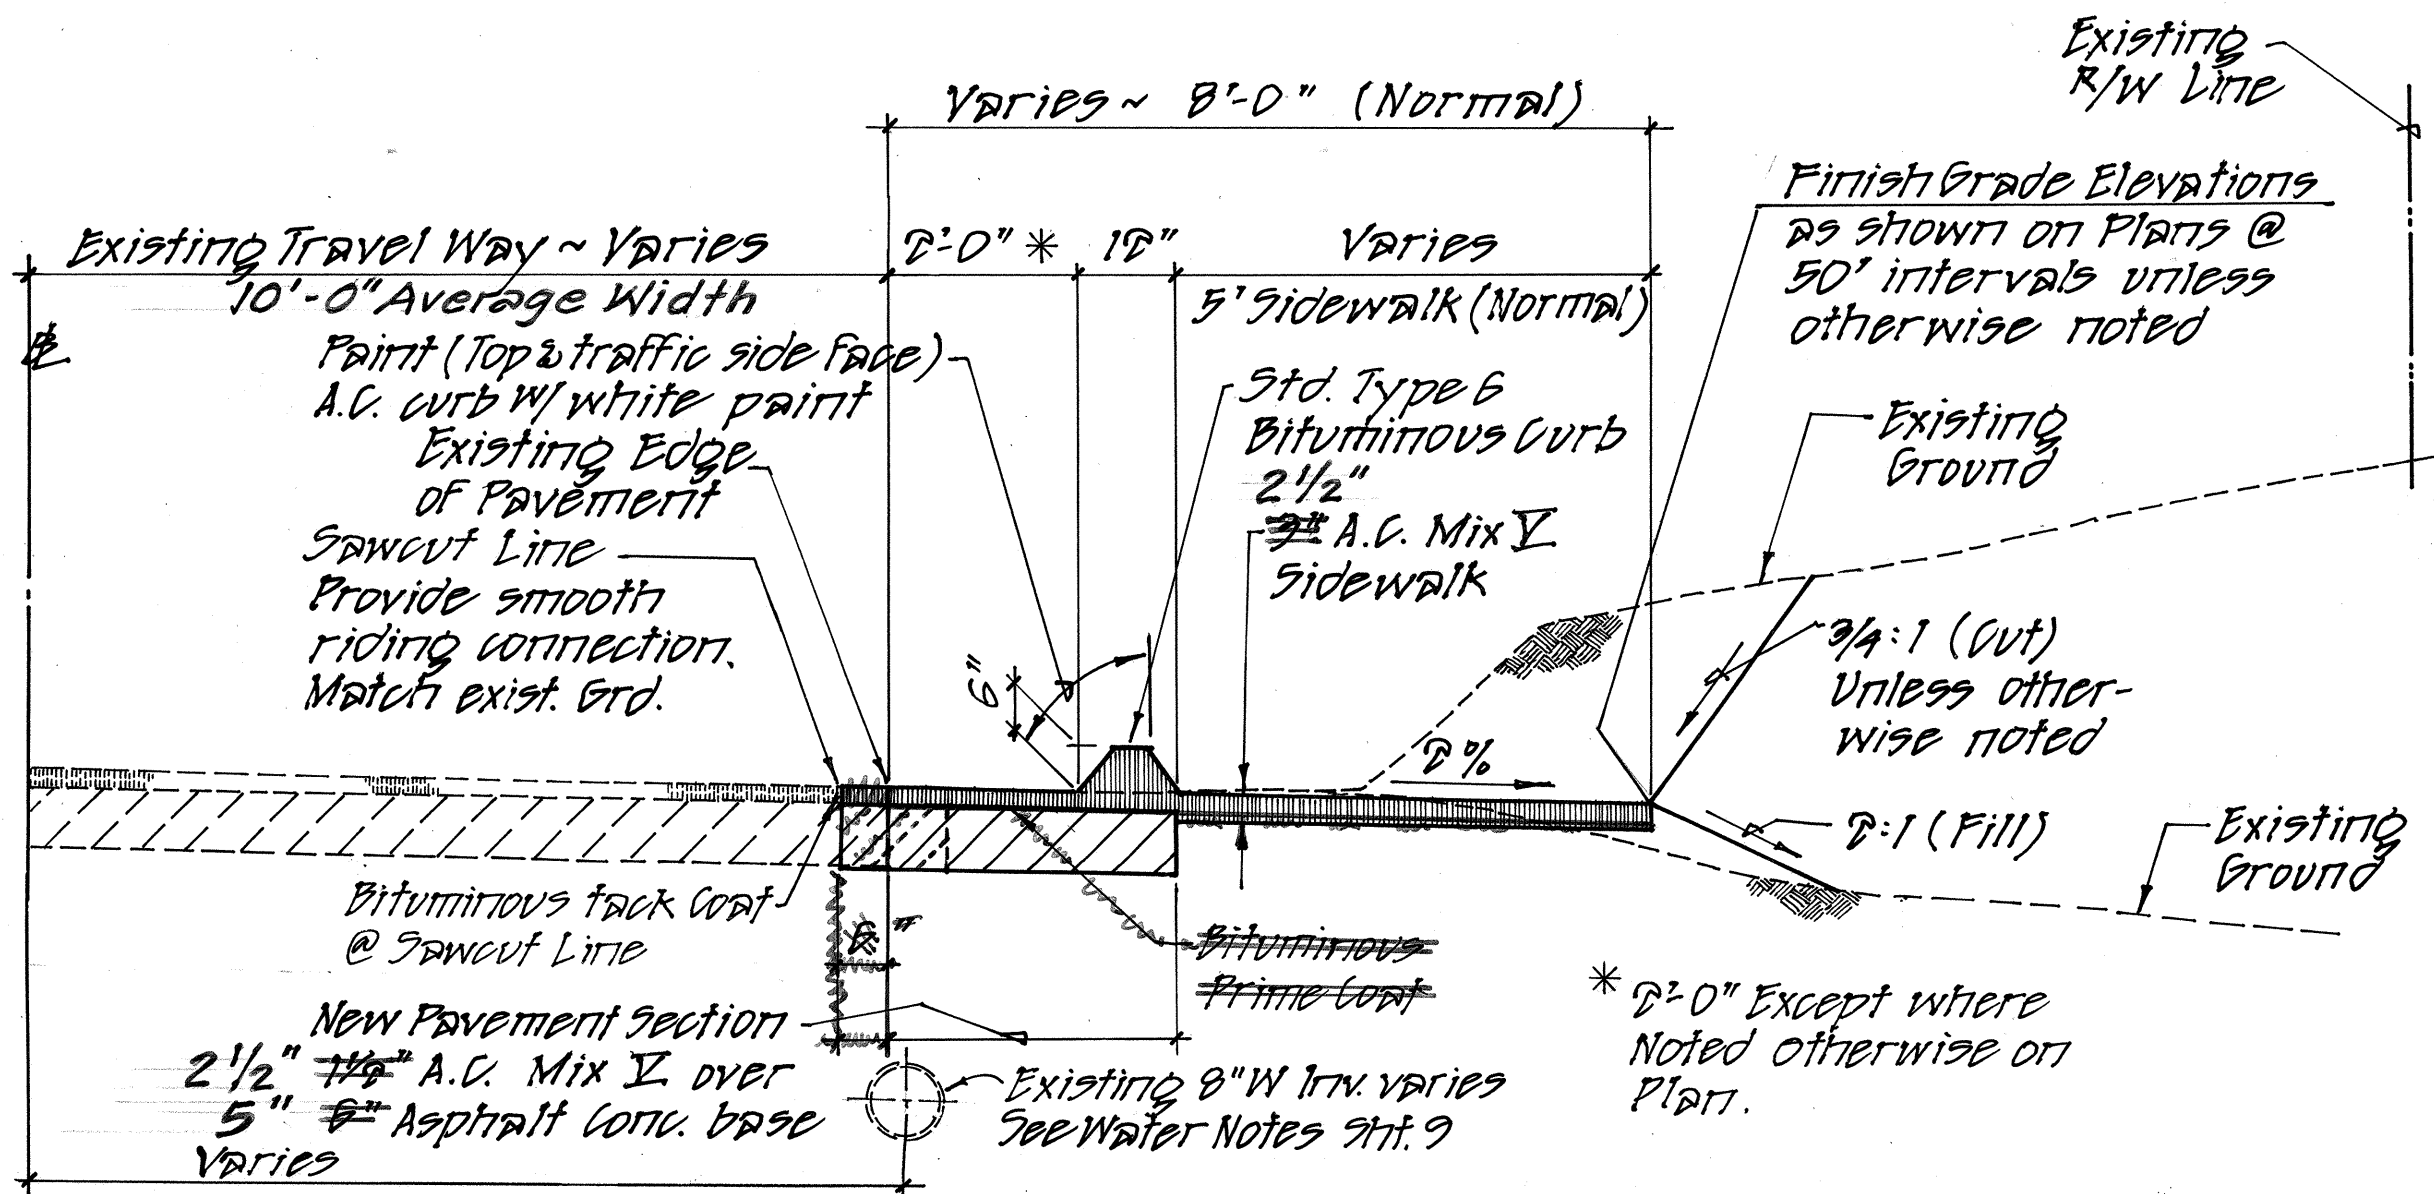


TYPICAL WALKWAY SECTION
Scale: 1/8" = 1'-0"

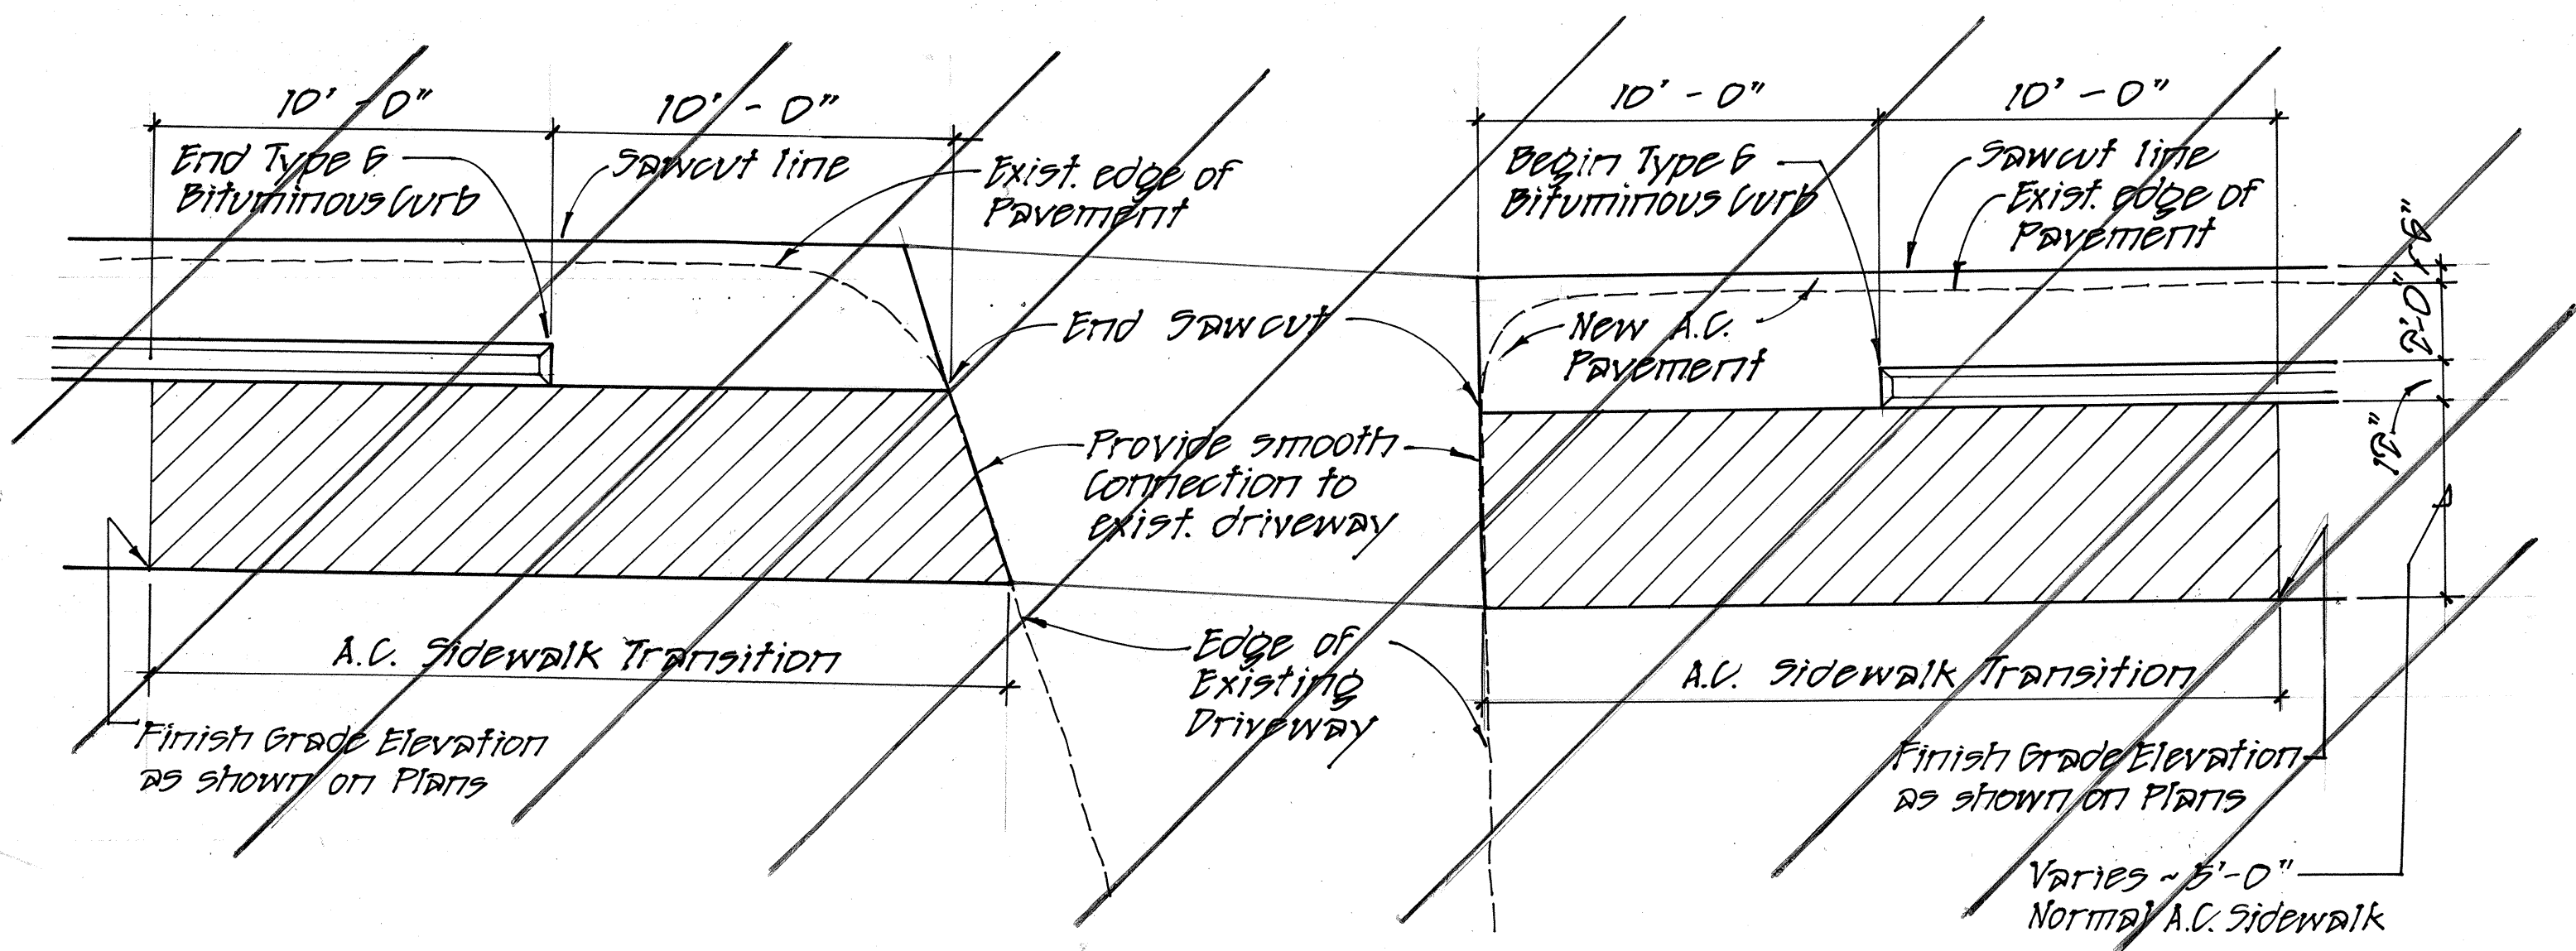

TYPICAL SIDEWALK CONNECTION @ EXISTING DRIVEWAYS
Scale: 1/4" = 1'-0" (Reconstructed All Existing Driveways)

ORIGINAL PLAN	DATE
SURVEY PLOTTED BY	
DRAWN BY	
DESIGNED BY	
NOTE BOOK	
QUANTITIES BY	
CHECKED BY	
No.	

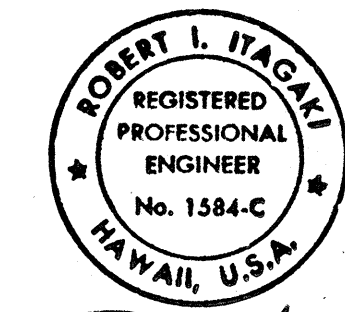

THIS WORK WAS PREPARED BY
ME OR UNDER MY SUPERVISION.

STATE OF HAWAII
DEPARTMENT OF TRANSPORTATION
HIGHWAYS DIVISION

SITE 5
WALKWAY - MISCELLANEOUS DETAILS
HAWAII BELT ROAD
SPOT IMPROVEMENTS
PAPA TO HONAUNAU - UNIT 1
PROJECT NO. 11BC-01-90