


FED. ROAD DIST. NO.	STATE	PROJ. NO.	FISCAL YEAR	SHEET NO.	TOTAL SHEETS
HAWAII	HAW.	IIBC-01-90	1989	12	36

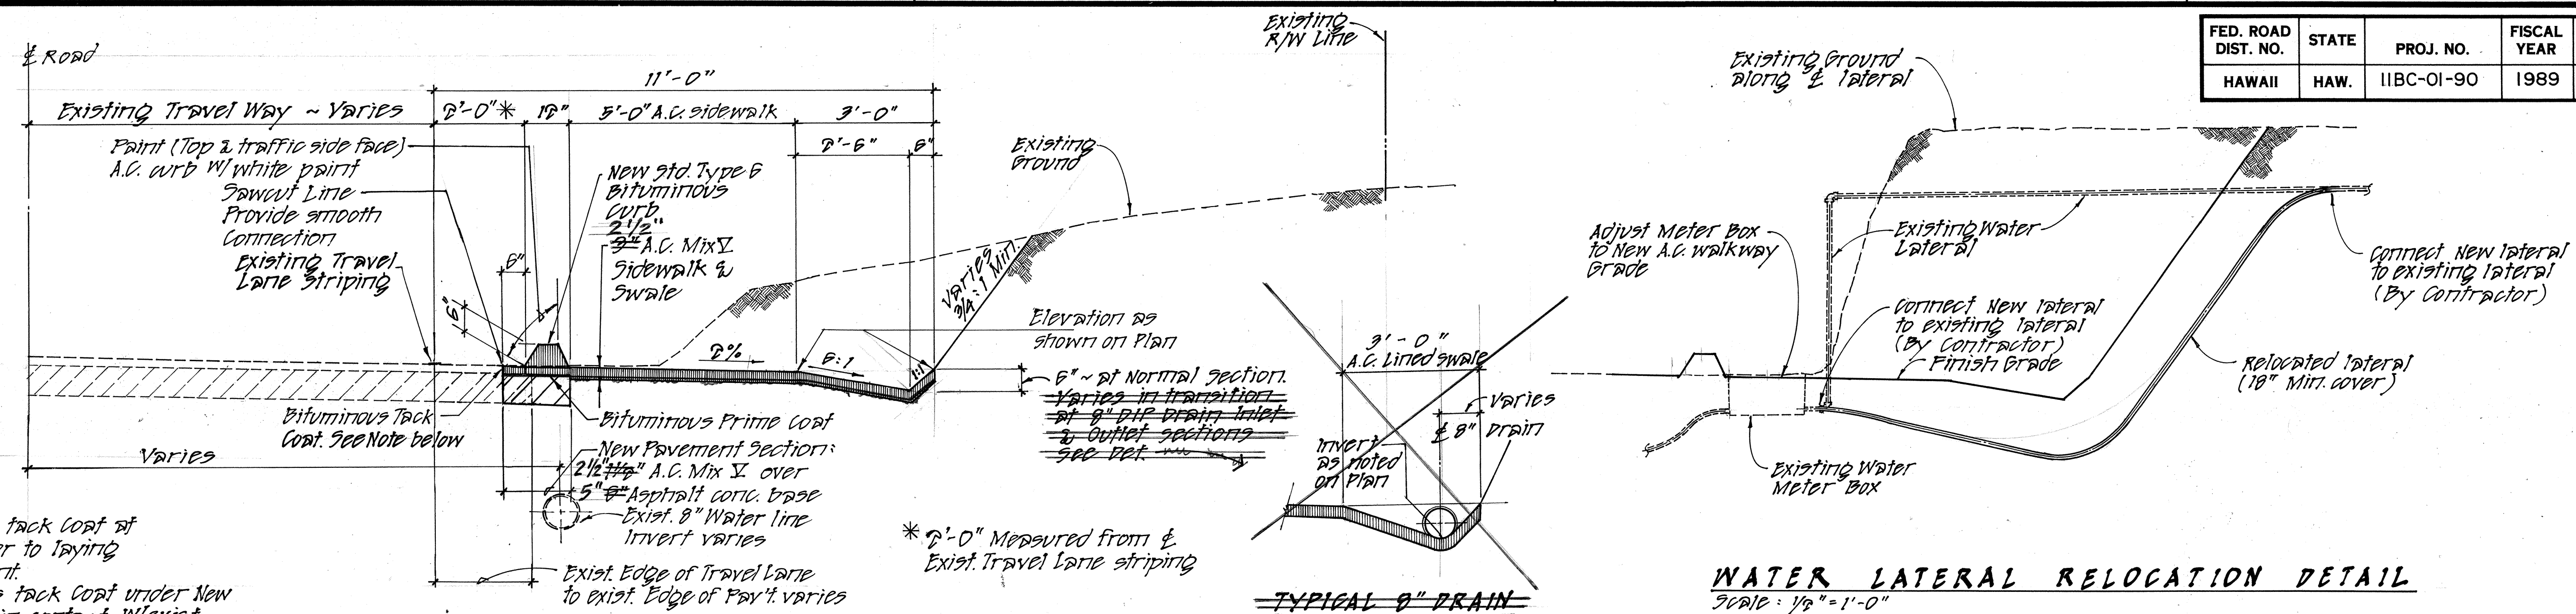


NOTE:
1. Apply Bituminous tack coat at Sawcut Line prior to laying New A.C. pavement.
2. Apply Bituminous tack coat under New Bituminous Curb in contact w/exist. pavement.


TYPICAL WALKWAY SECTION
Scale: 1/2" = 1'-0"

TYPICAL 8" DRAIN INLET/OUTLET DETAIL
Scale: 1/4" = 1'-0"


WATER LATERAL RELOCATION DETAIL
Scale: 1/2" = 1'-0"

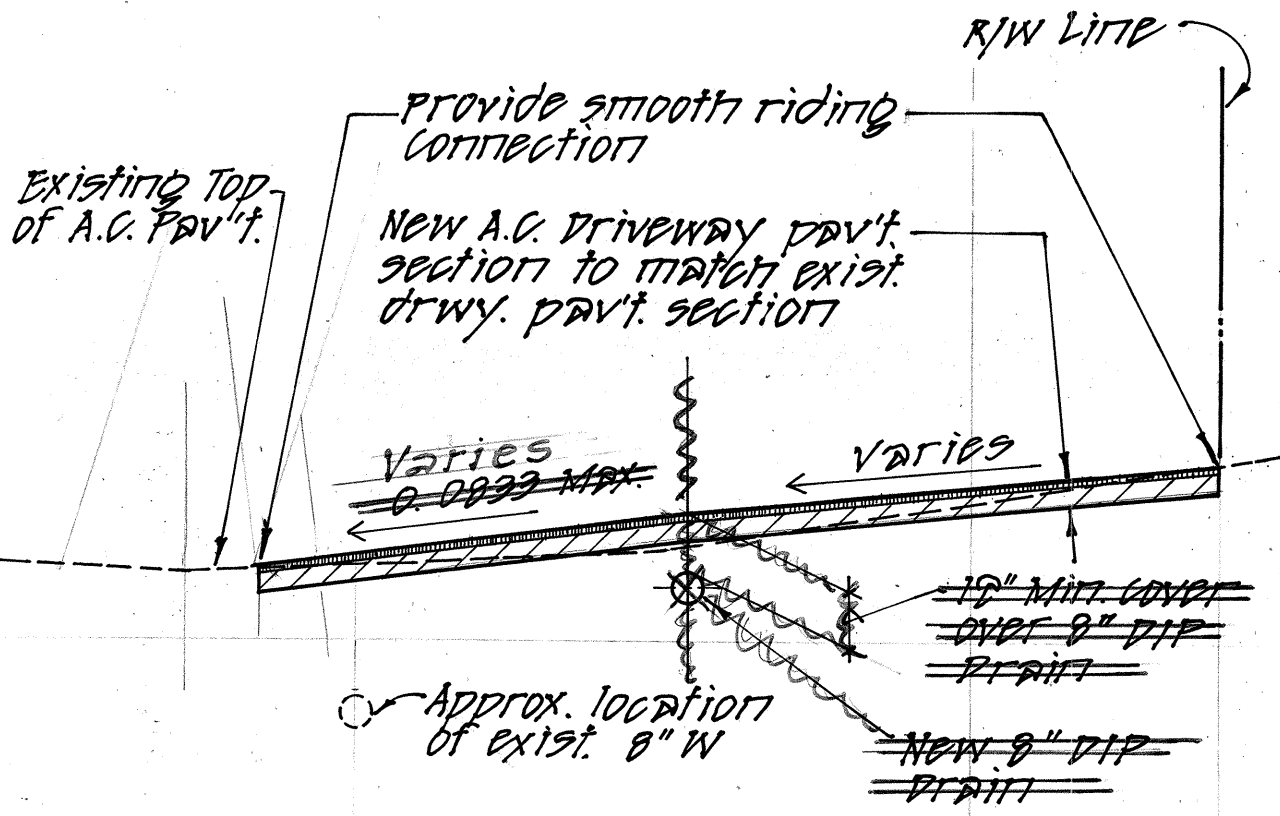


TYP RECONSTRUCTED DRWY. SECTION
Scale: 1/4" = 1'-0"

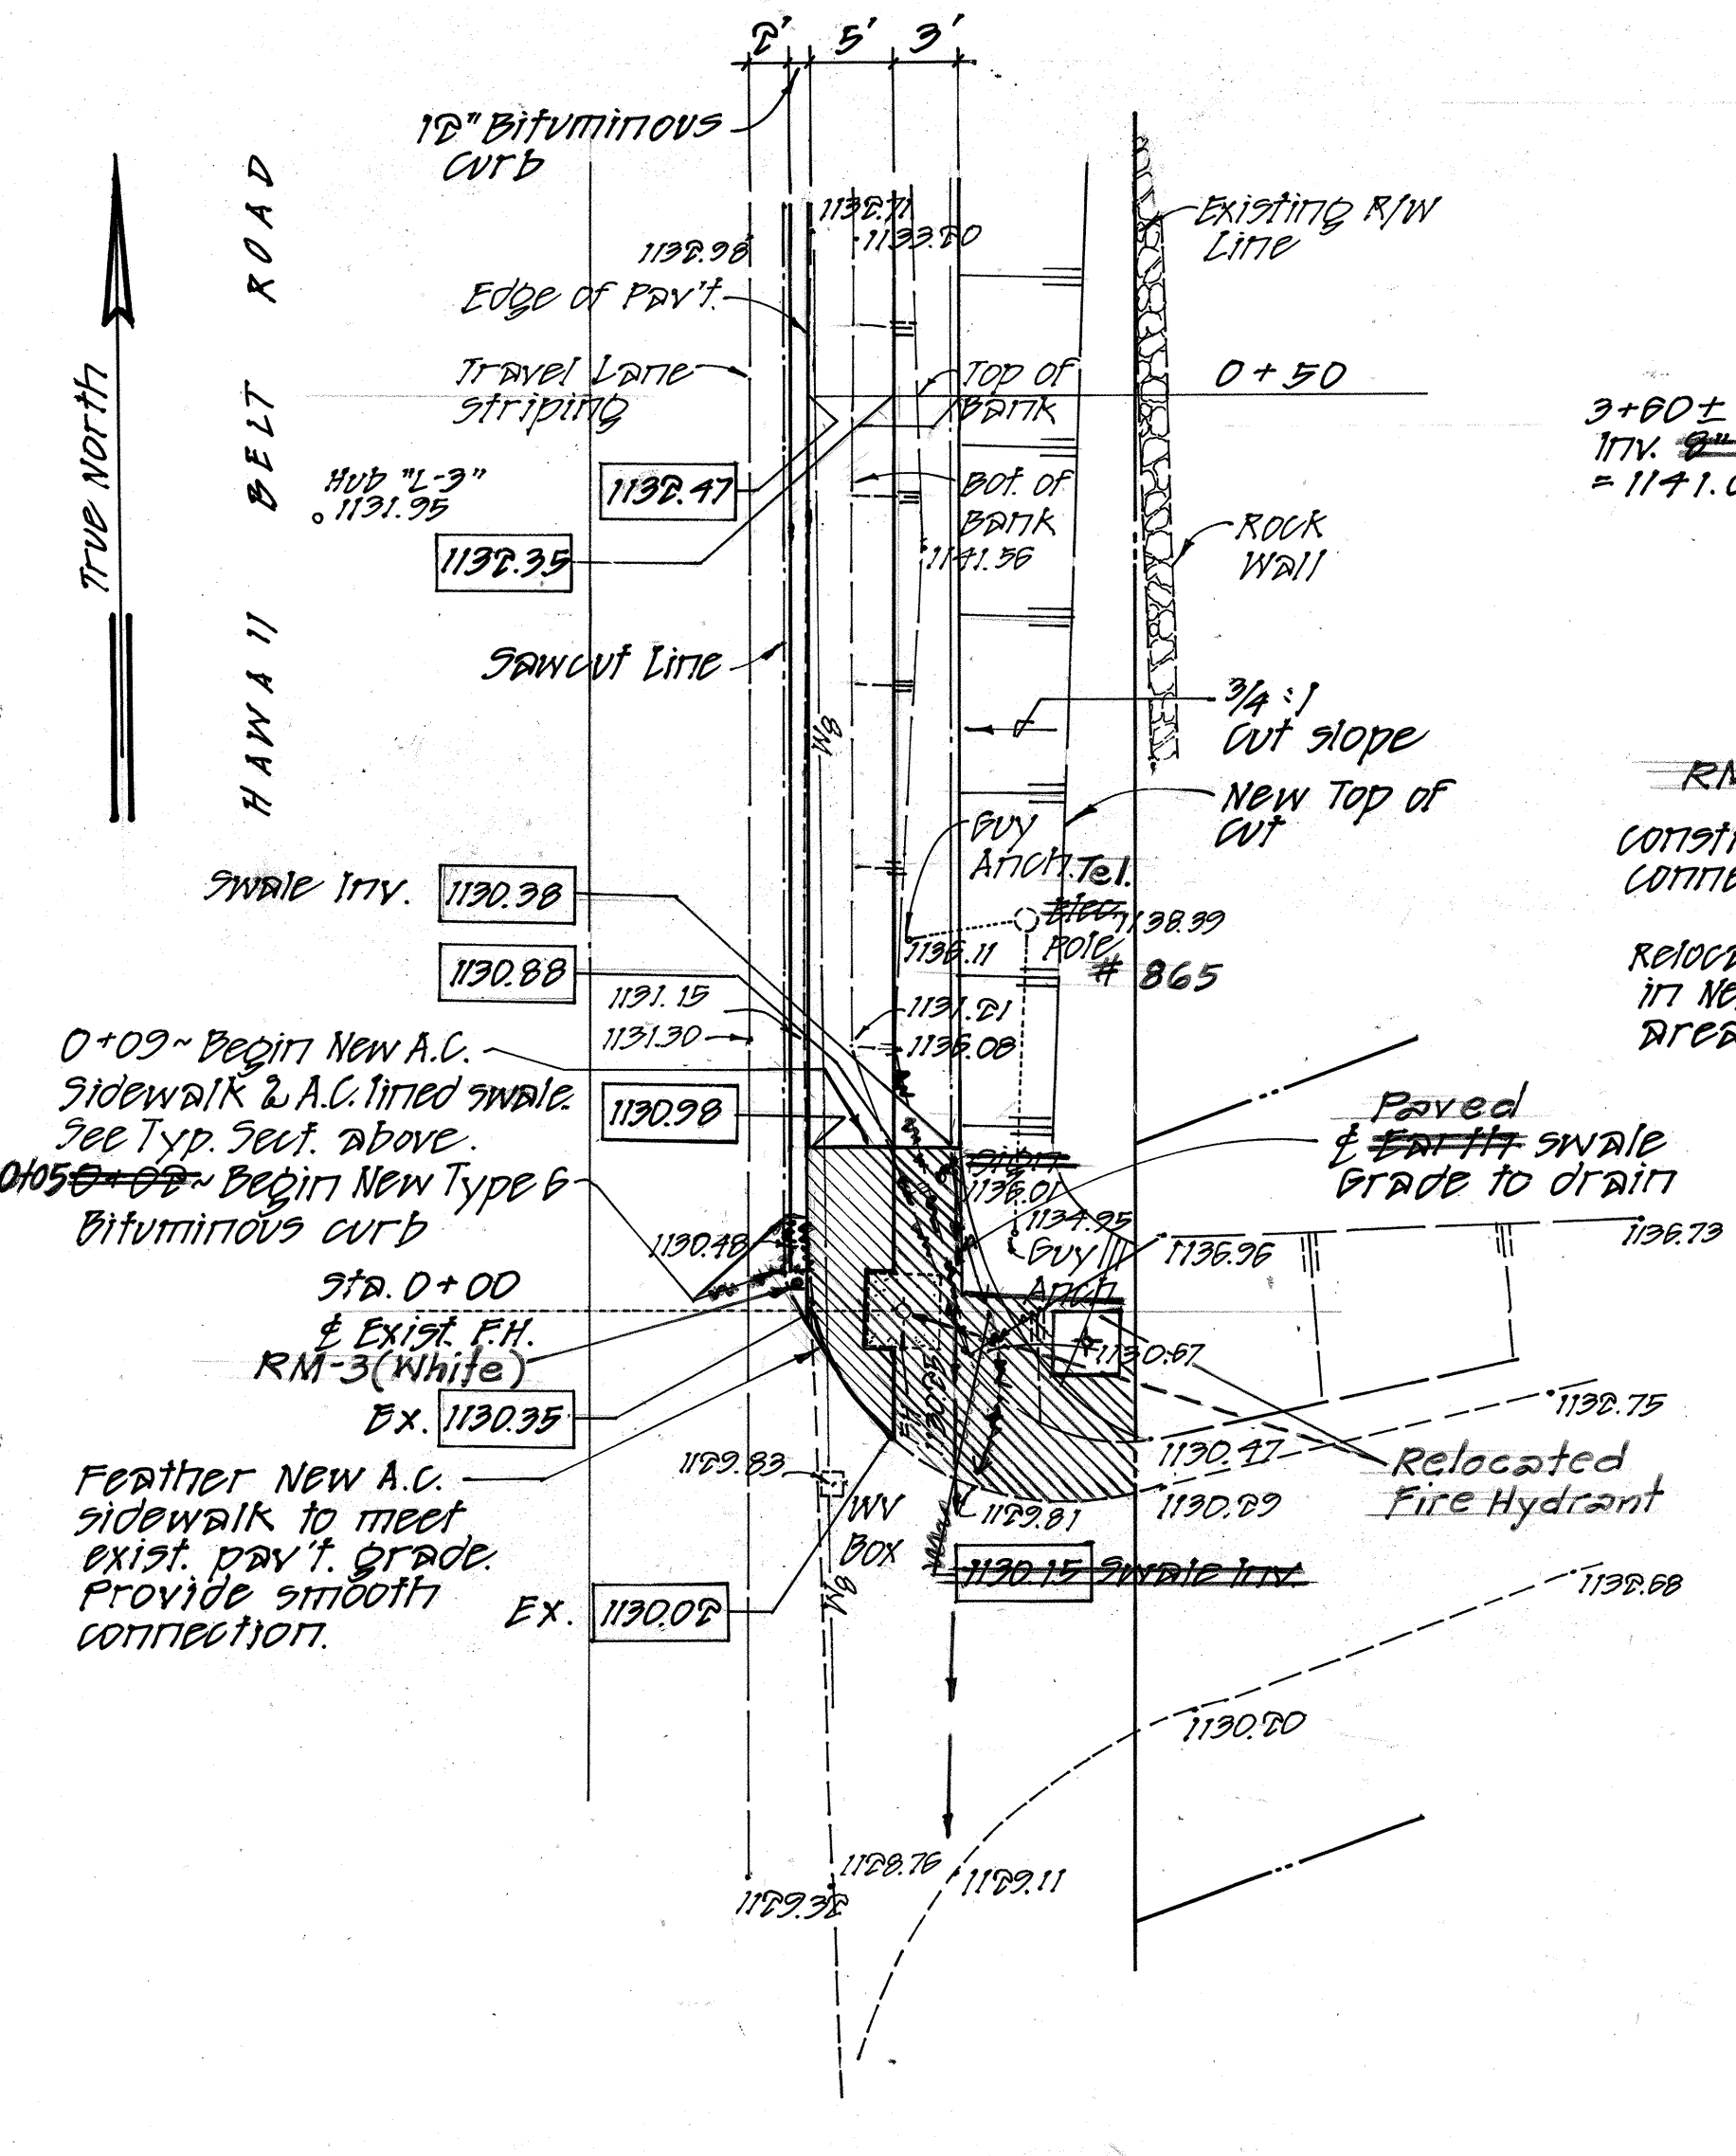


PLAN ~ DRIVEWAY @ STA. 0+00
Scale: 1" = 10'

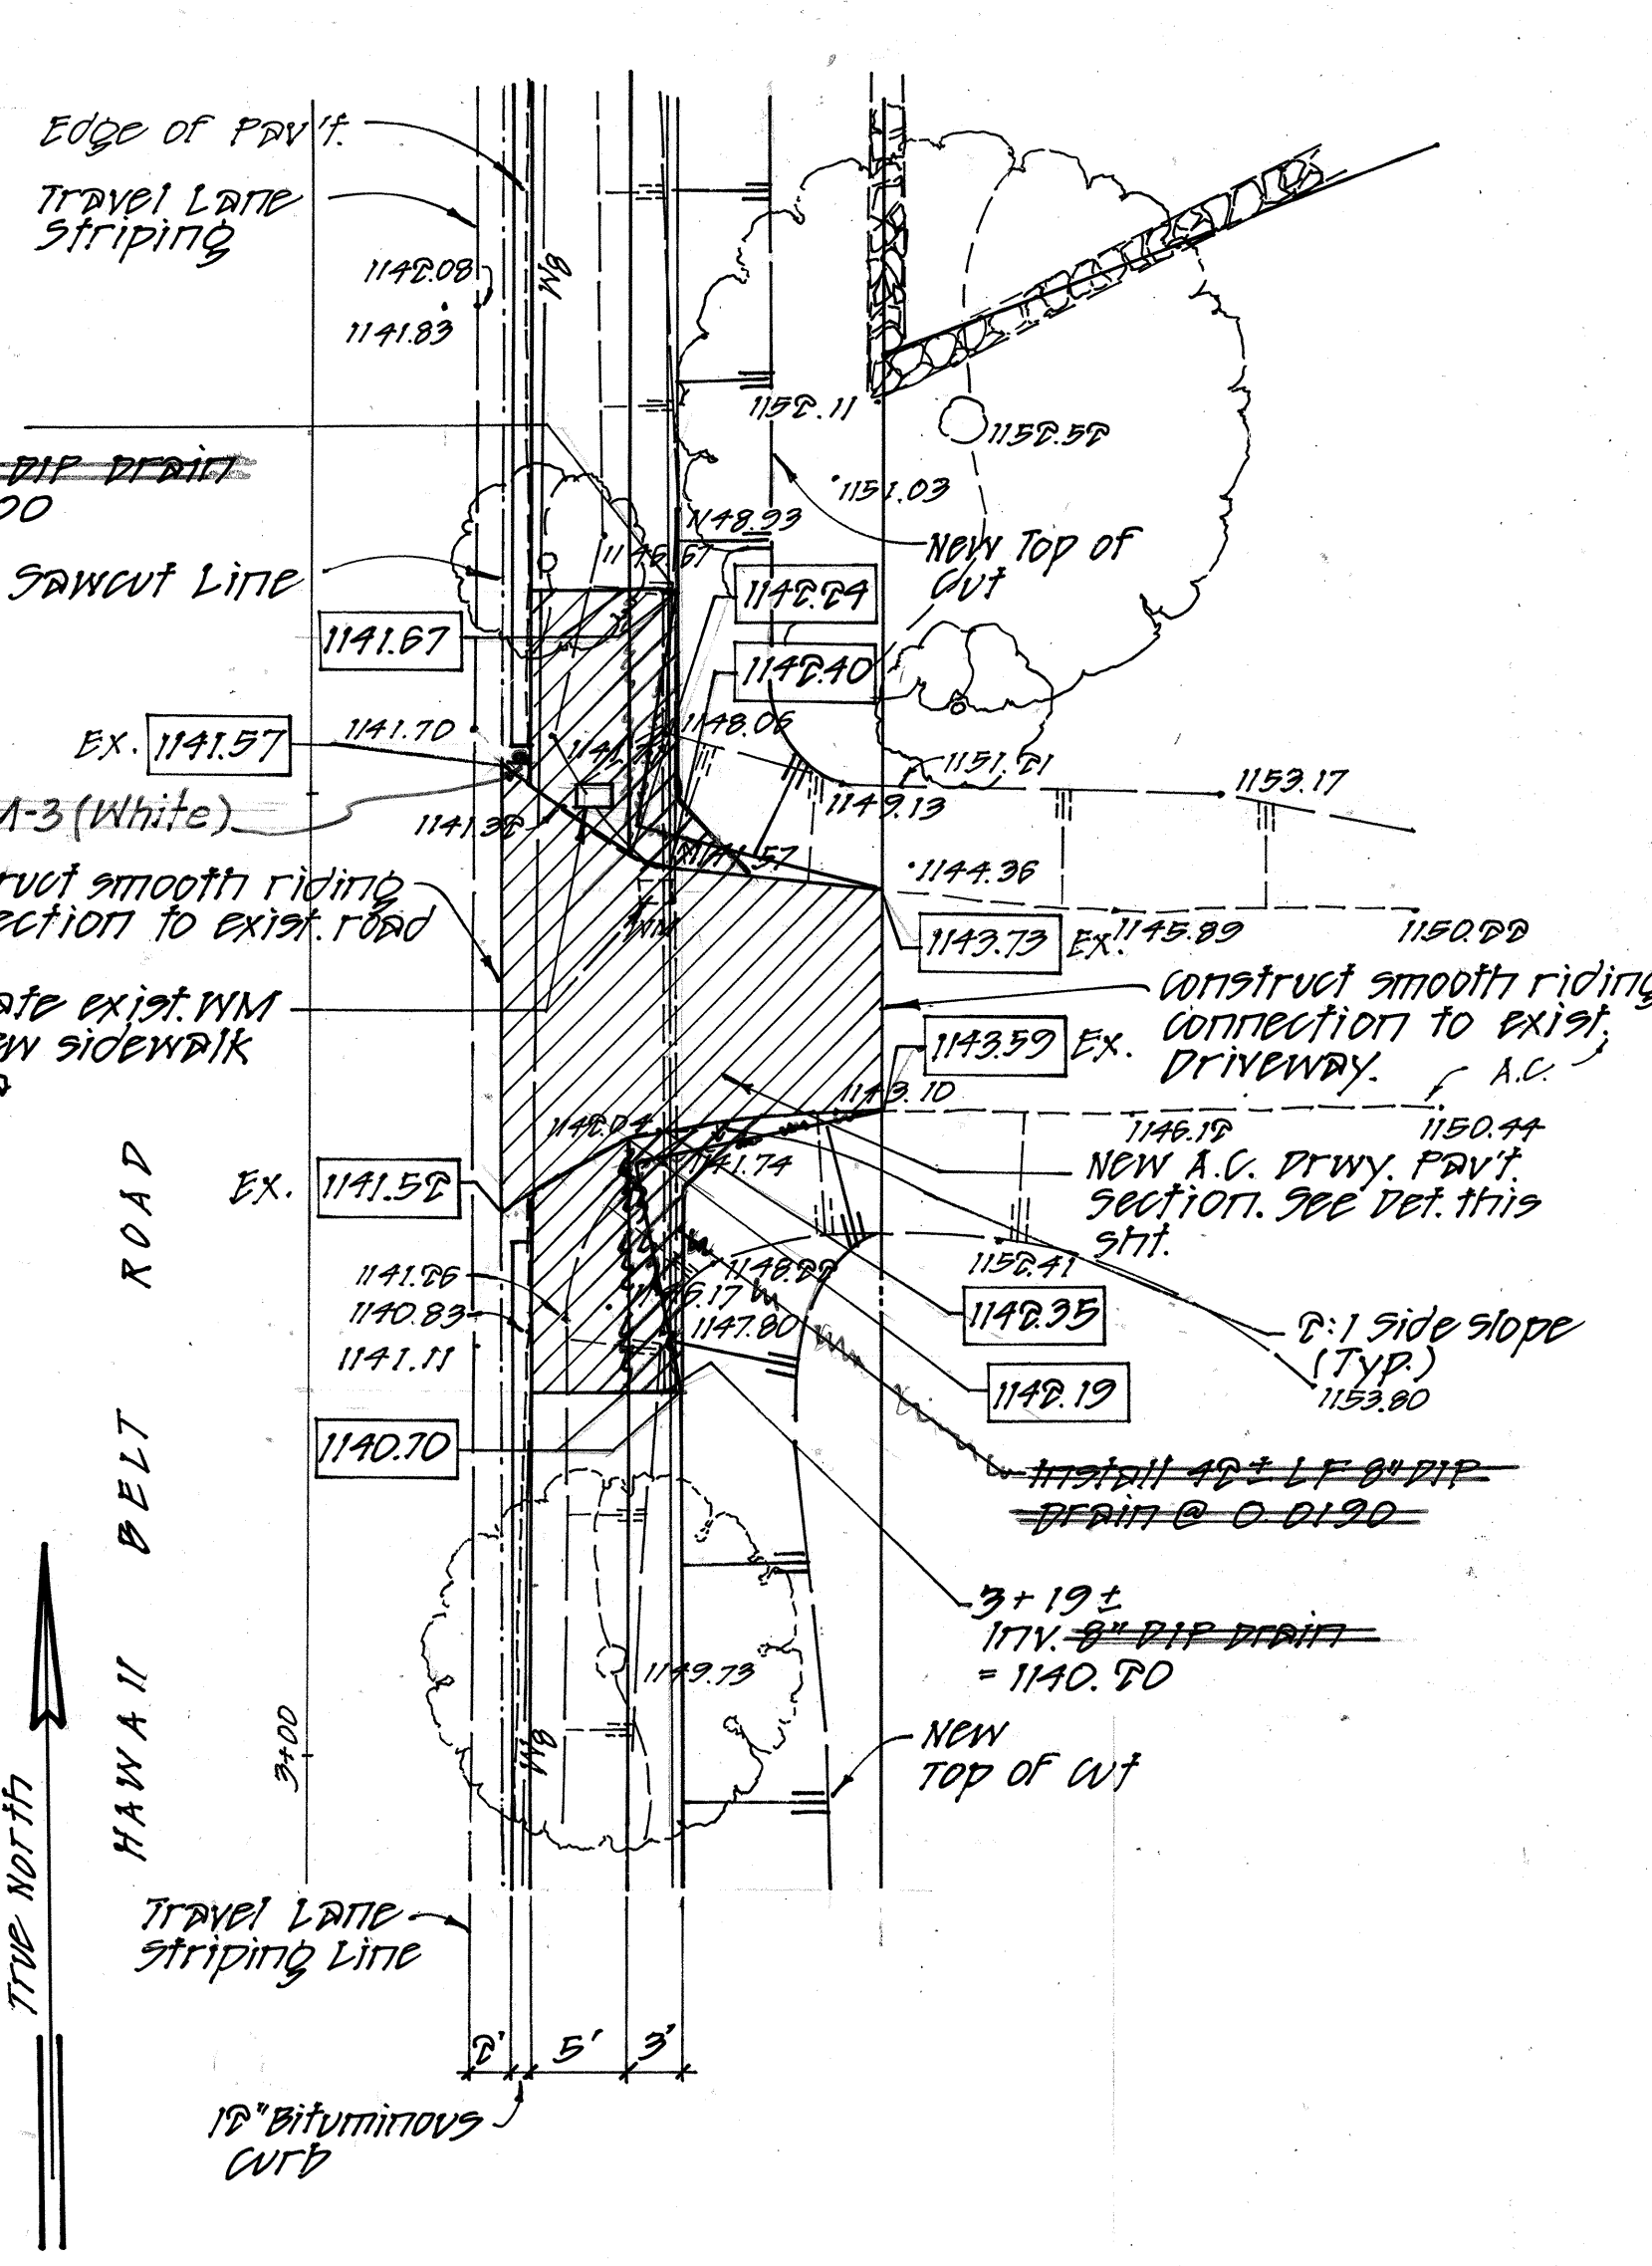

PLAN ~ DRIVEWAY @ STA. 3+39±
Scale: 1" = 10'

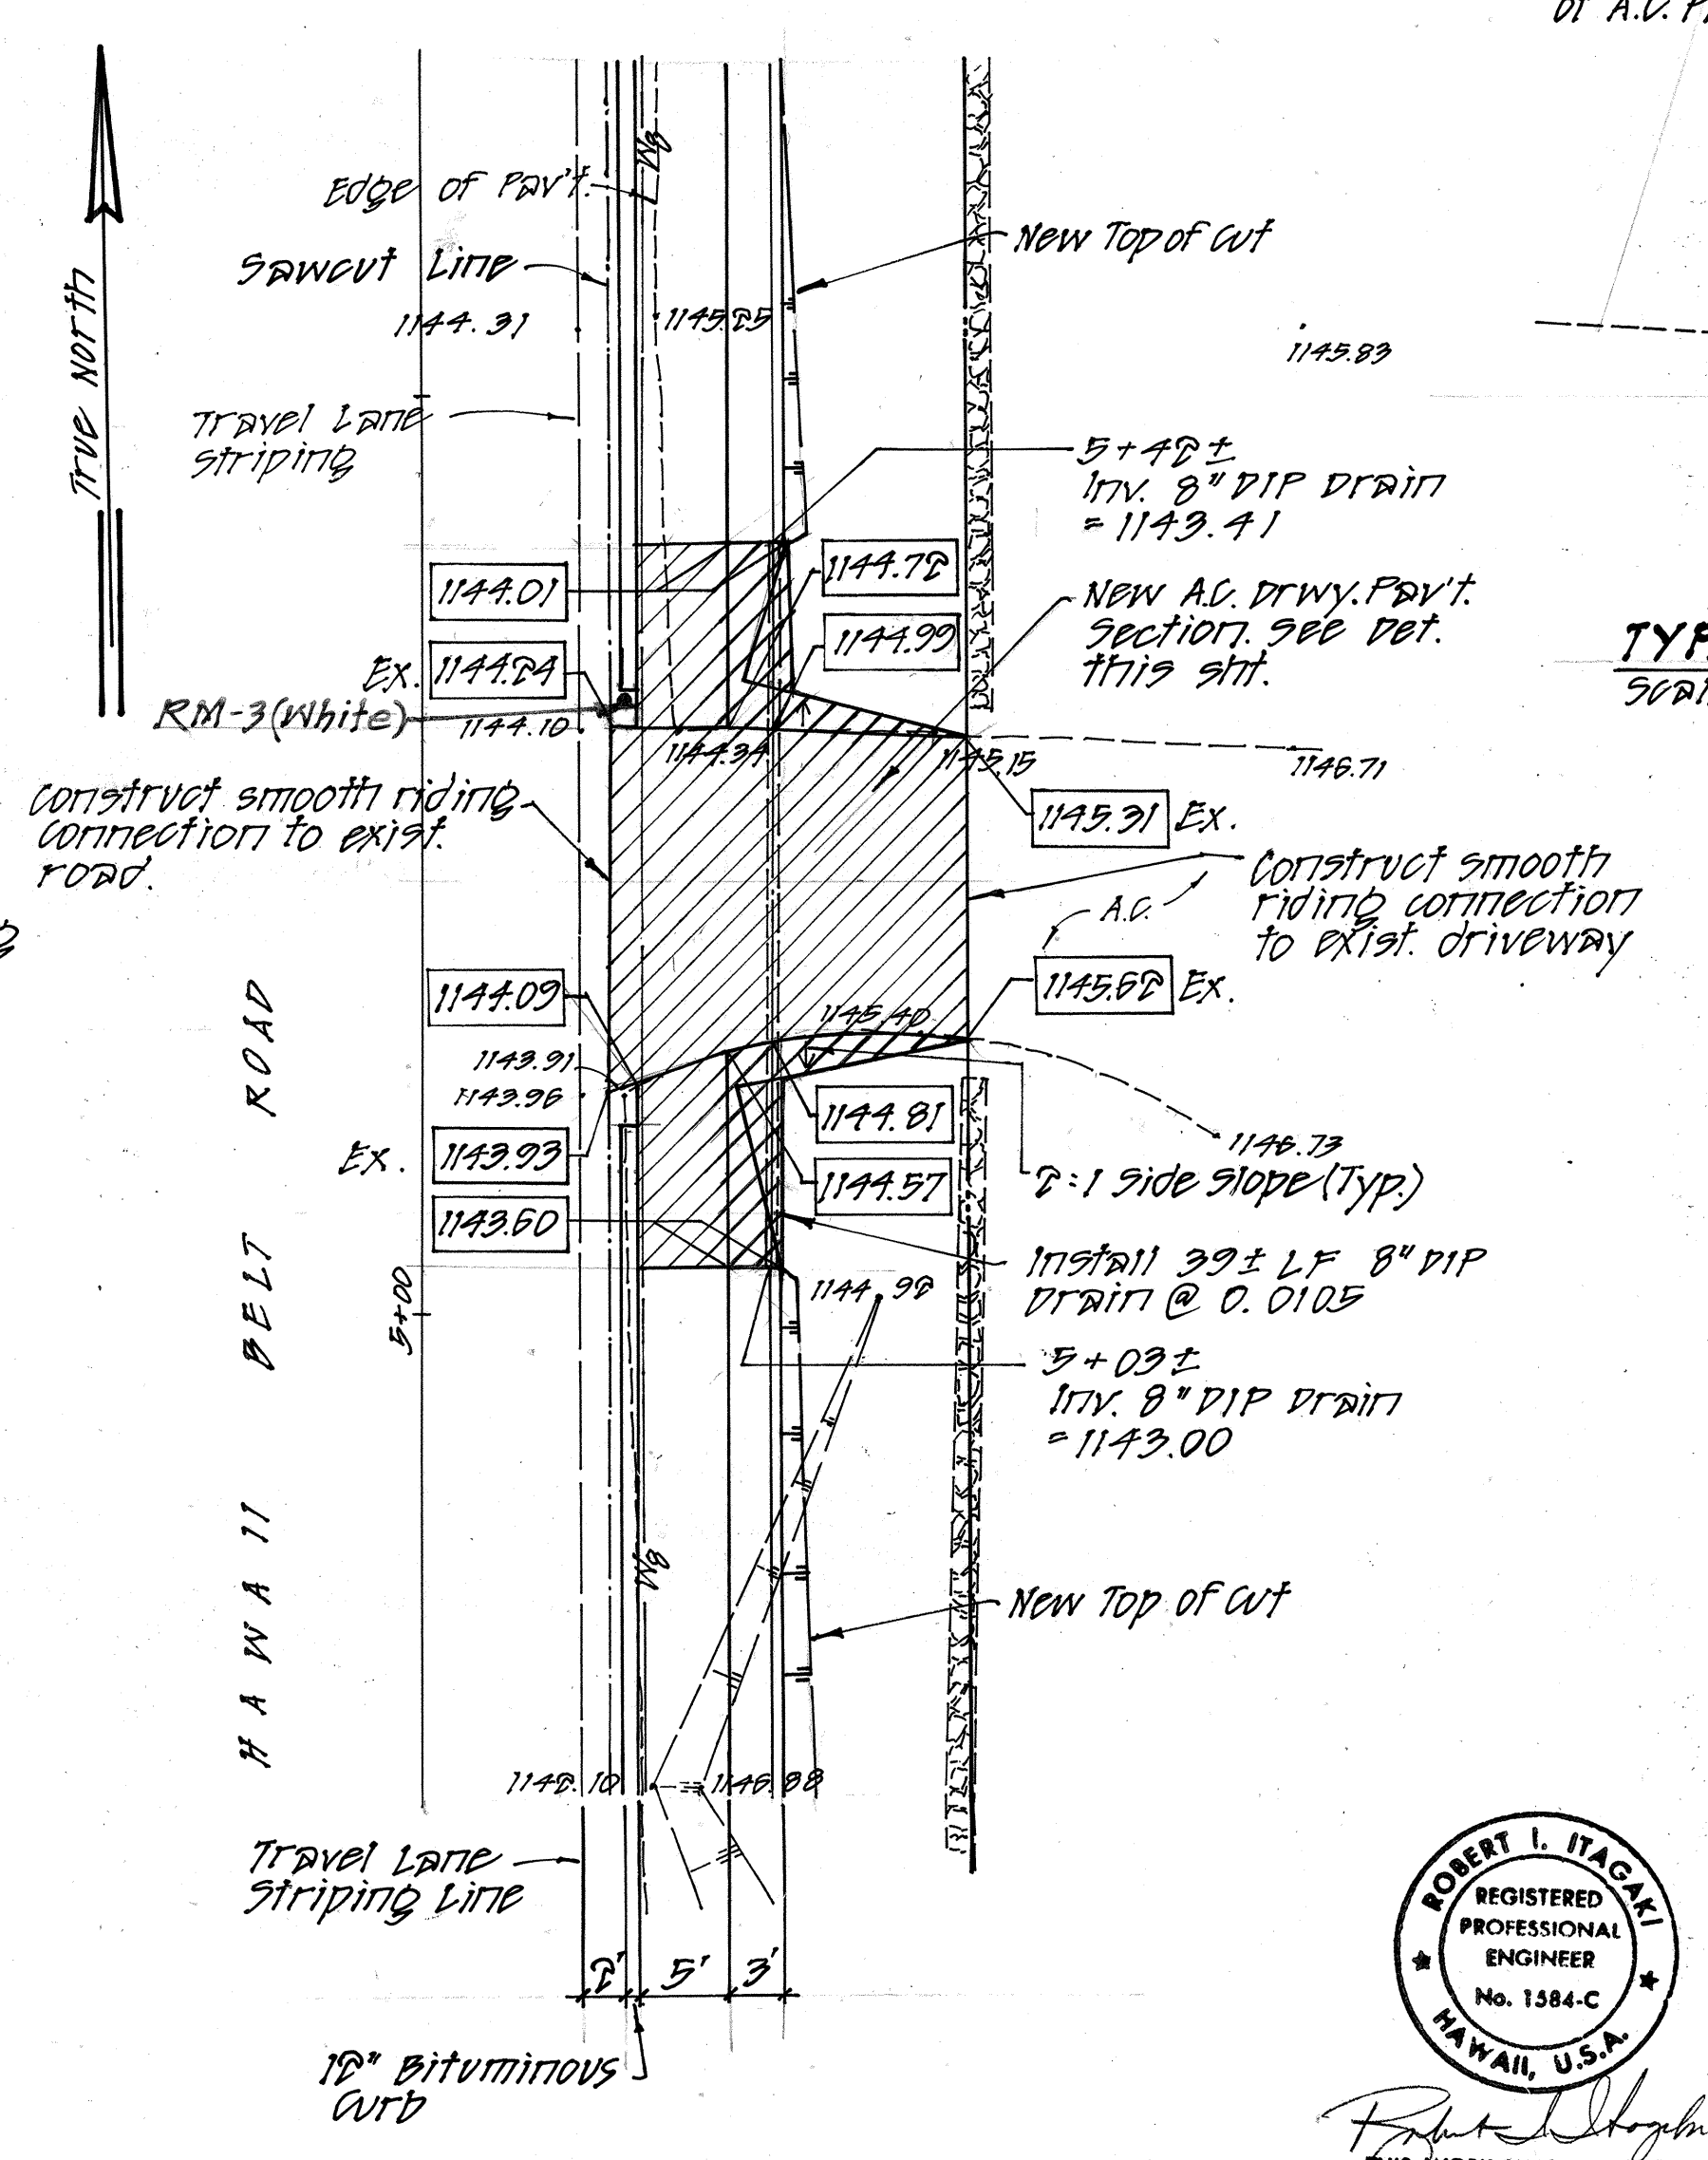

PLAN ~ DRIVEWAY @ STA. 5+24±
Scale: 1" = 10'

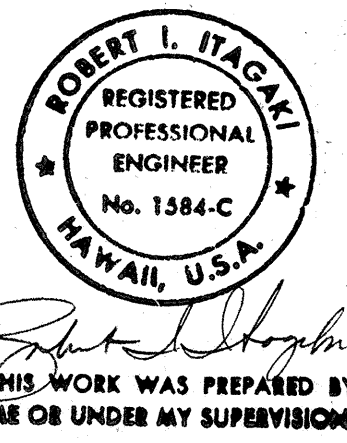

STATE OF HAWAII
DEPARTMENT OF TRANSPORTATION
HIGHWAYS DIVISION
SITE 7
WALKWAY - MISCELLANEOUS DETAILS
HAWAII BELT ROAD
SPOT IMPROVEMENTS
PAPA TO HONAUNAU - UNIT I
PROJECT NO. IIBC-01-90