	INDEX TO DRAWINGS
SHEET NO.	DESCRIPTION
1	TITLE SHEET
2	STANDARD PLAN SUMMARY
3	NOTES, TRAFFIC CONTROL PLAN
4-6	SITE LOCATION PLAN
7	SITE 4 SHOULDER WIDENING
8	SITE 5 MISC. DETAILS
9-18	SITE 5 WALKWAY
19	SITE 7 MISC. DETAILS
20	SITE 7 WALKWAY
21-23	SITE 8 INSTALLATION OF NEW CULVERT
24-26	SITE 9 MARKING PLAN
27	SITE 9 DETAILS
28	SITE 4 CROSS SECTIONS
29-35	SITE 5 CROSS SECTIONS
36	SITE 7 CROSS SECTIONS
,	

STATE OF HAWAII

DEPARTMENT OF TRANSPORTATION
HIGHWAYS DIVISION
HONOLULU, HAWAII

"AS BUILT "

CONSTRUCTION PLANS FOR


HAWAII BELT ROAD IMPROVEMENTS


FROM PAPA TO HONAUNAU

UNIT I

PROJECT NO. IIBC - OI - 90

SOUTH KONA, ISLAND OF HAWAII

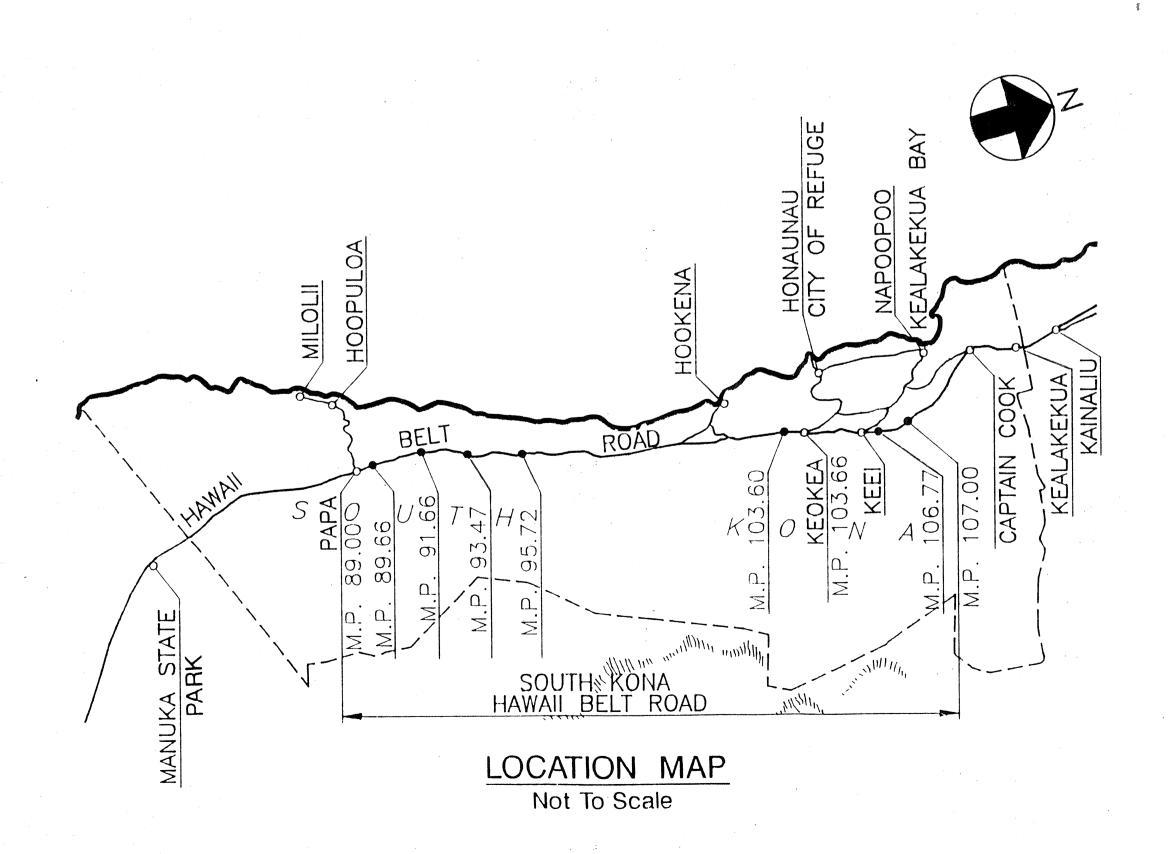

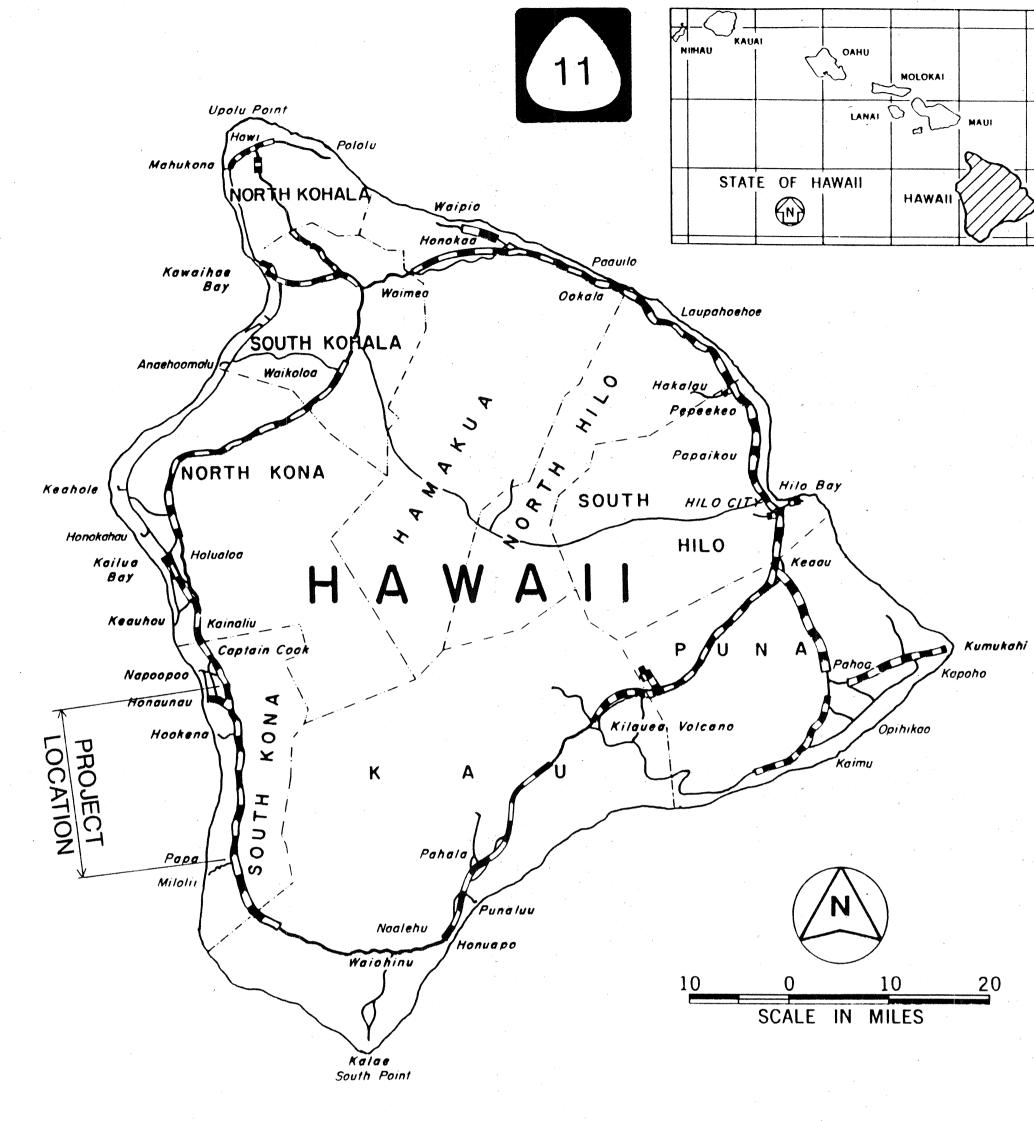

FED. ROAD DIST. NO. FISCAL SHEET TOTAL YEAR NO. SHEETS

11BC-01-90

FEDERAL AID PROJECTS PREVIOUSLY CONSTRUCTED OR UNDER CONSTRUCTION

MILE POST 89.0 TO MILE POST 107.0

CHANGES MADE DURING CONSTRUCTION HAVE
BEEN INCORPORATED ON THESE PLANS EXCEPT
CHANGES IN THE ORIGINAL THEORETICAL
QUANTITIES. FOR ACTUAL QUANTITIES, REFER TO
PROJECT LEDGER AND/OR COMPUTATION BOOK.

Resident Engineer

0ct: 7, 1996 DATE

DEPARTMENT OF TRANSPORTATION
STATE OF HAWAII

APPROVED:

#/8/90
DIR. OF TRANSPORTATION DATE

548-7532 APRIL 1990
PHONE DATE

c. Lincoln Char 54

1-4-2