



ORIGINAL
PLAN
DATE
SERVEY PLOTTED BY
DESIGNED BY
NOTE BOOK
QUANTITIES BY
CHECKED BY
N.

FED. ROAD DIST. NO.	STATE	FED. AID PROJ. NO.	FISCAL YEAR	SHEET NO.	TOTAL SHEETS
HAWAII	HAW.	FLH-011-2(22)	1991	12	18

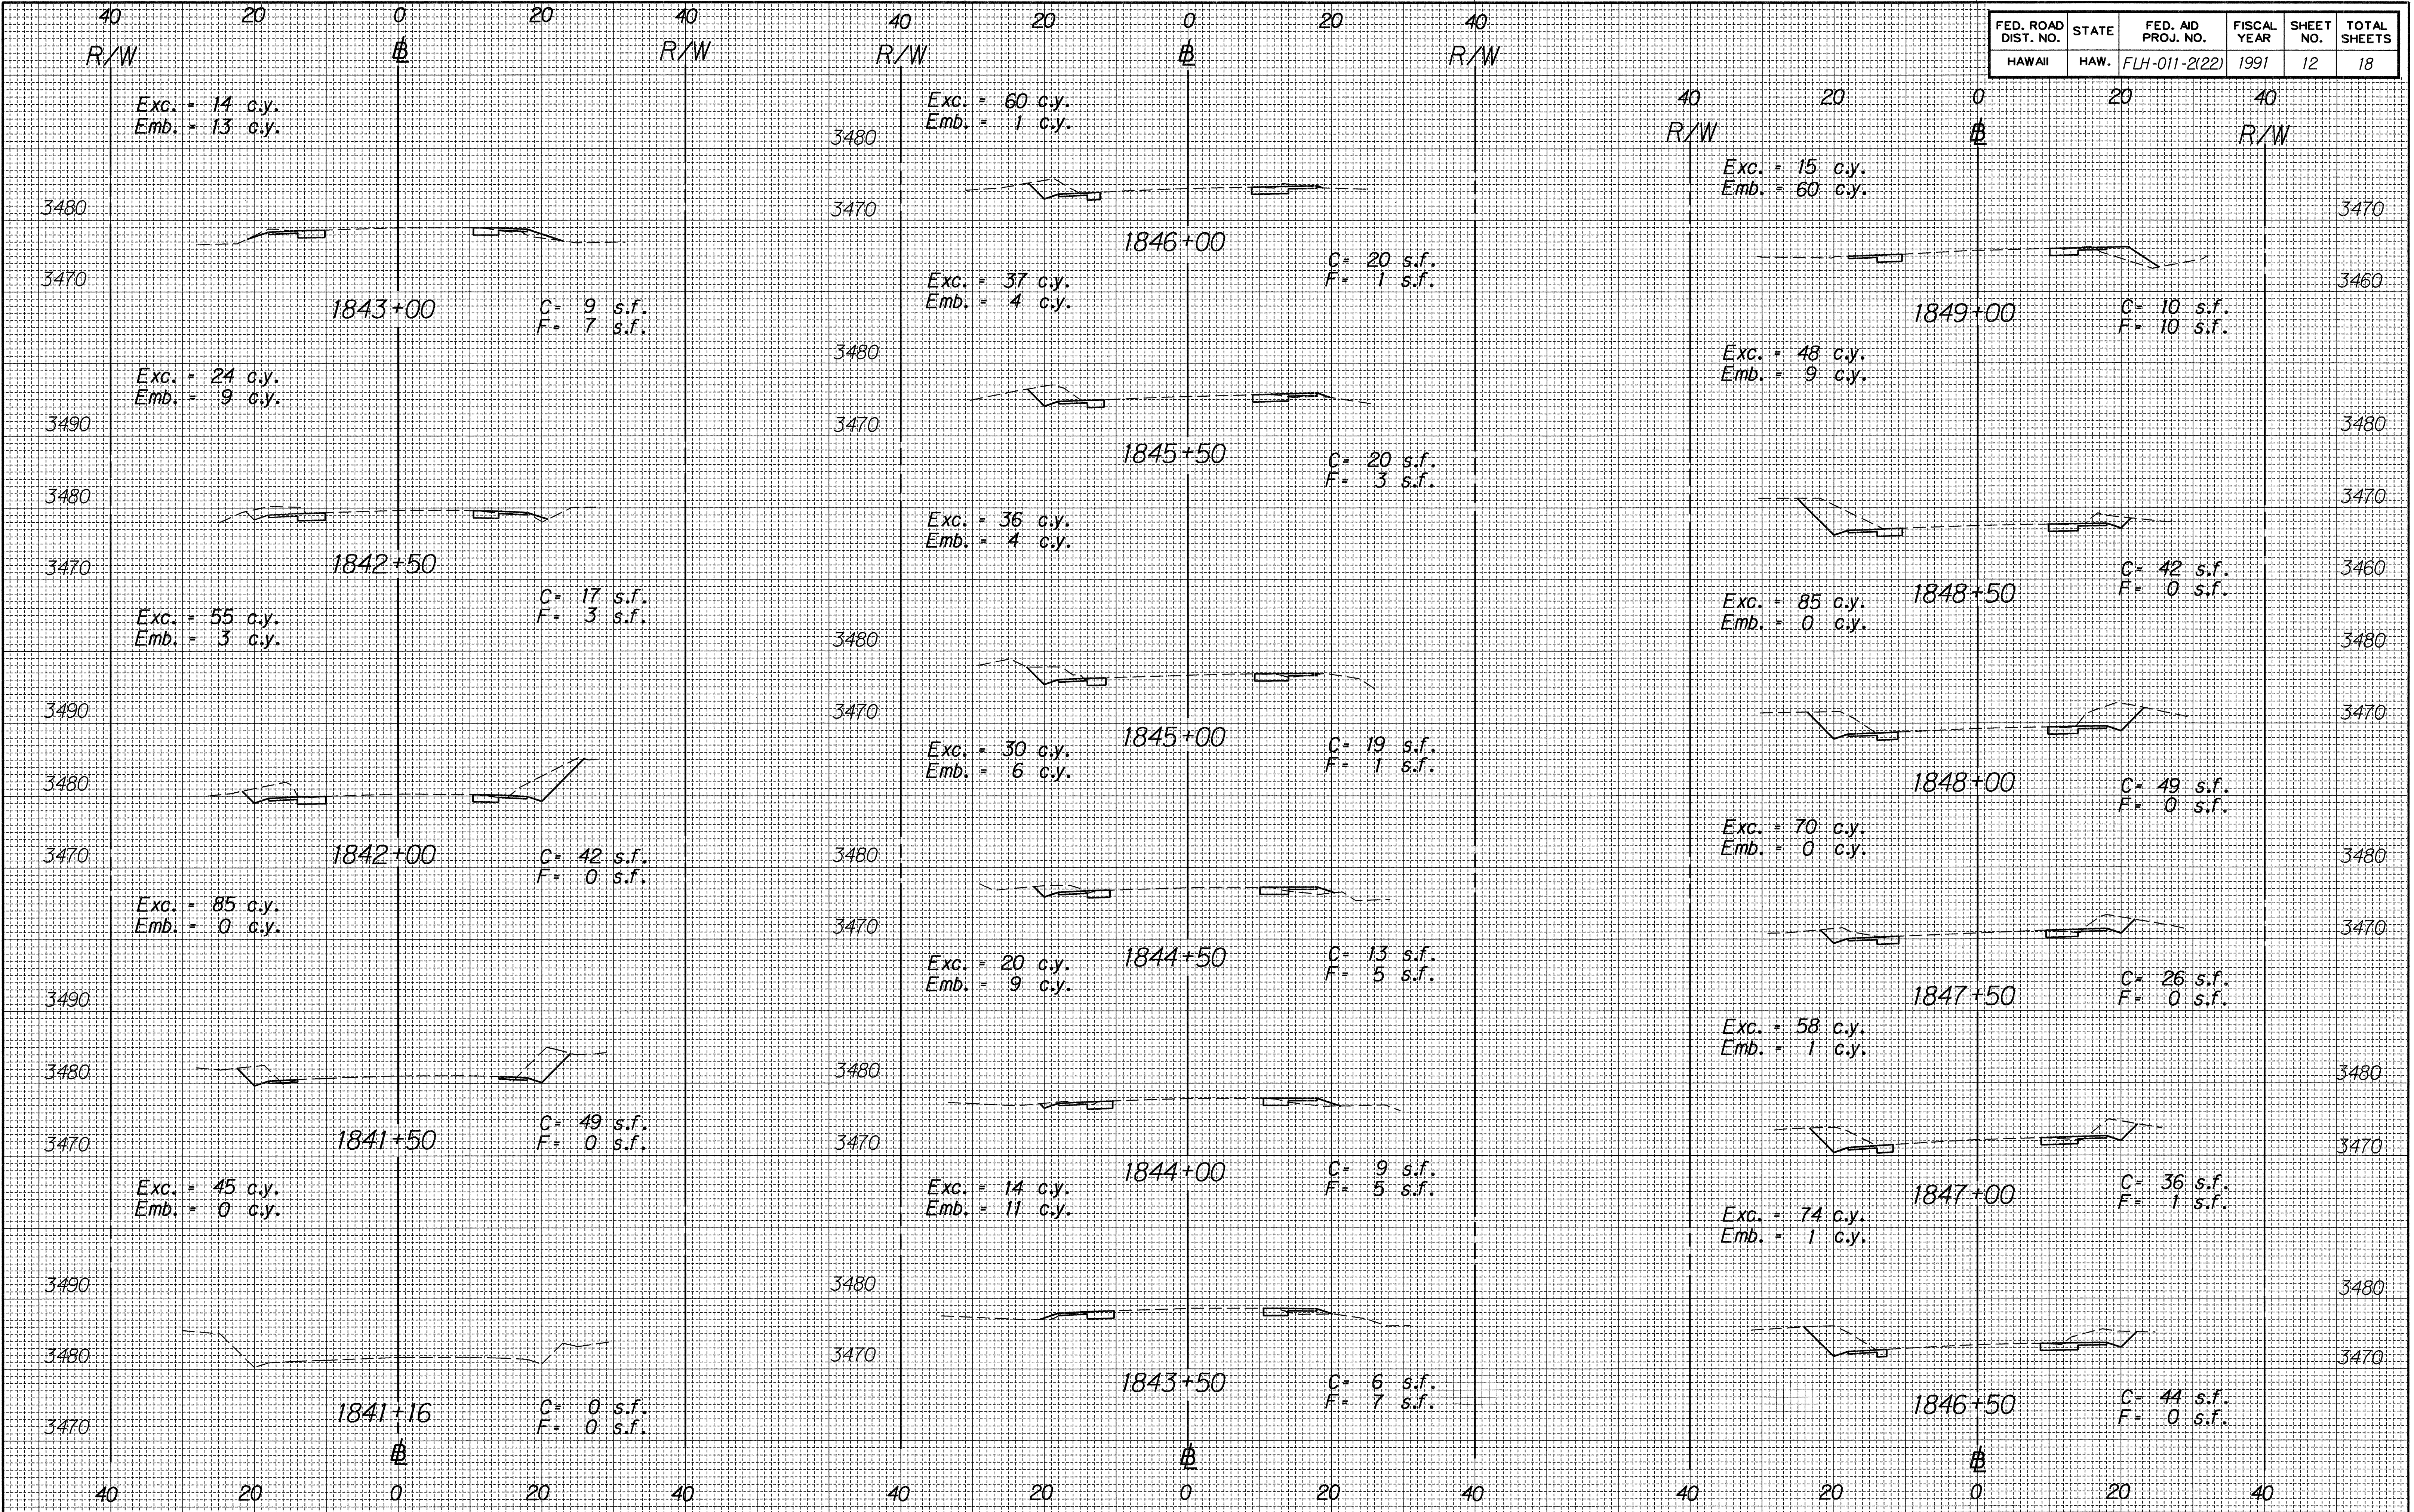


DATE
SURVEY PLOTTED BY
DESIGNED BY
NOTES BOOK
QUANTITIES BY
CHECKED BY

FED. ROAD DIST. NO.	STATE	FED. AID PROJ. NO.	FISCAL YEAR	SHEET NO.	TOTAL SHEETS
HAWAII	HAW.	FLH-011-2(22)	1991	13	18

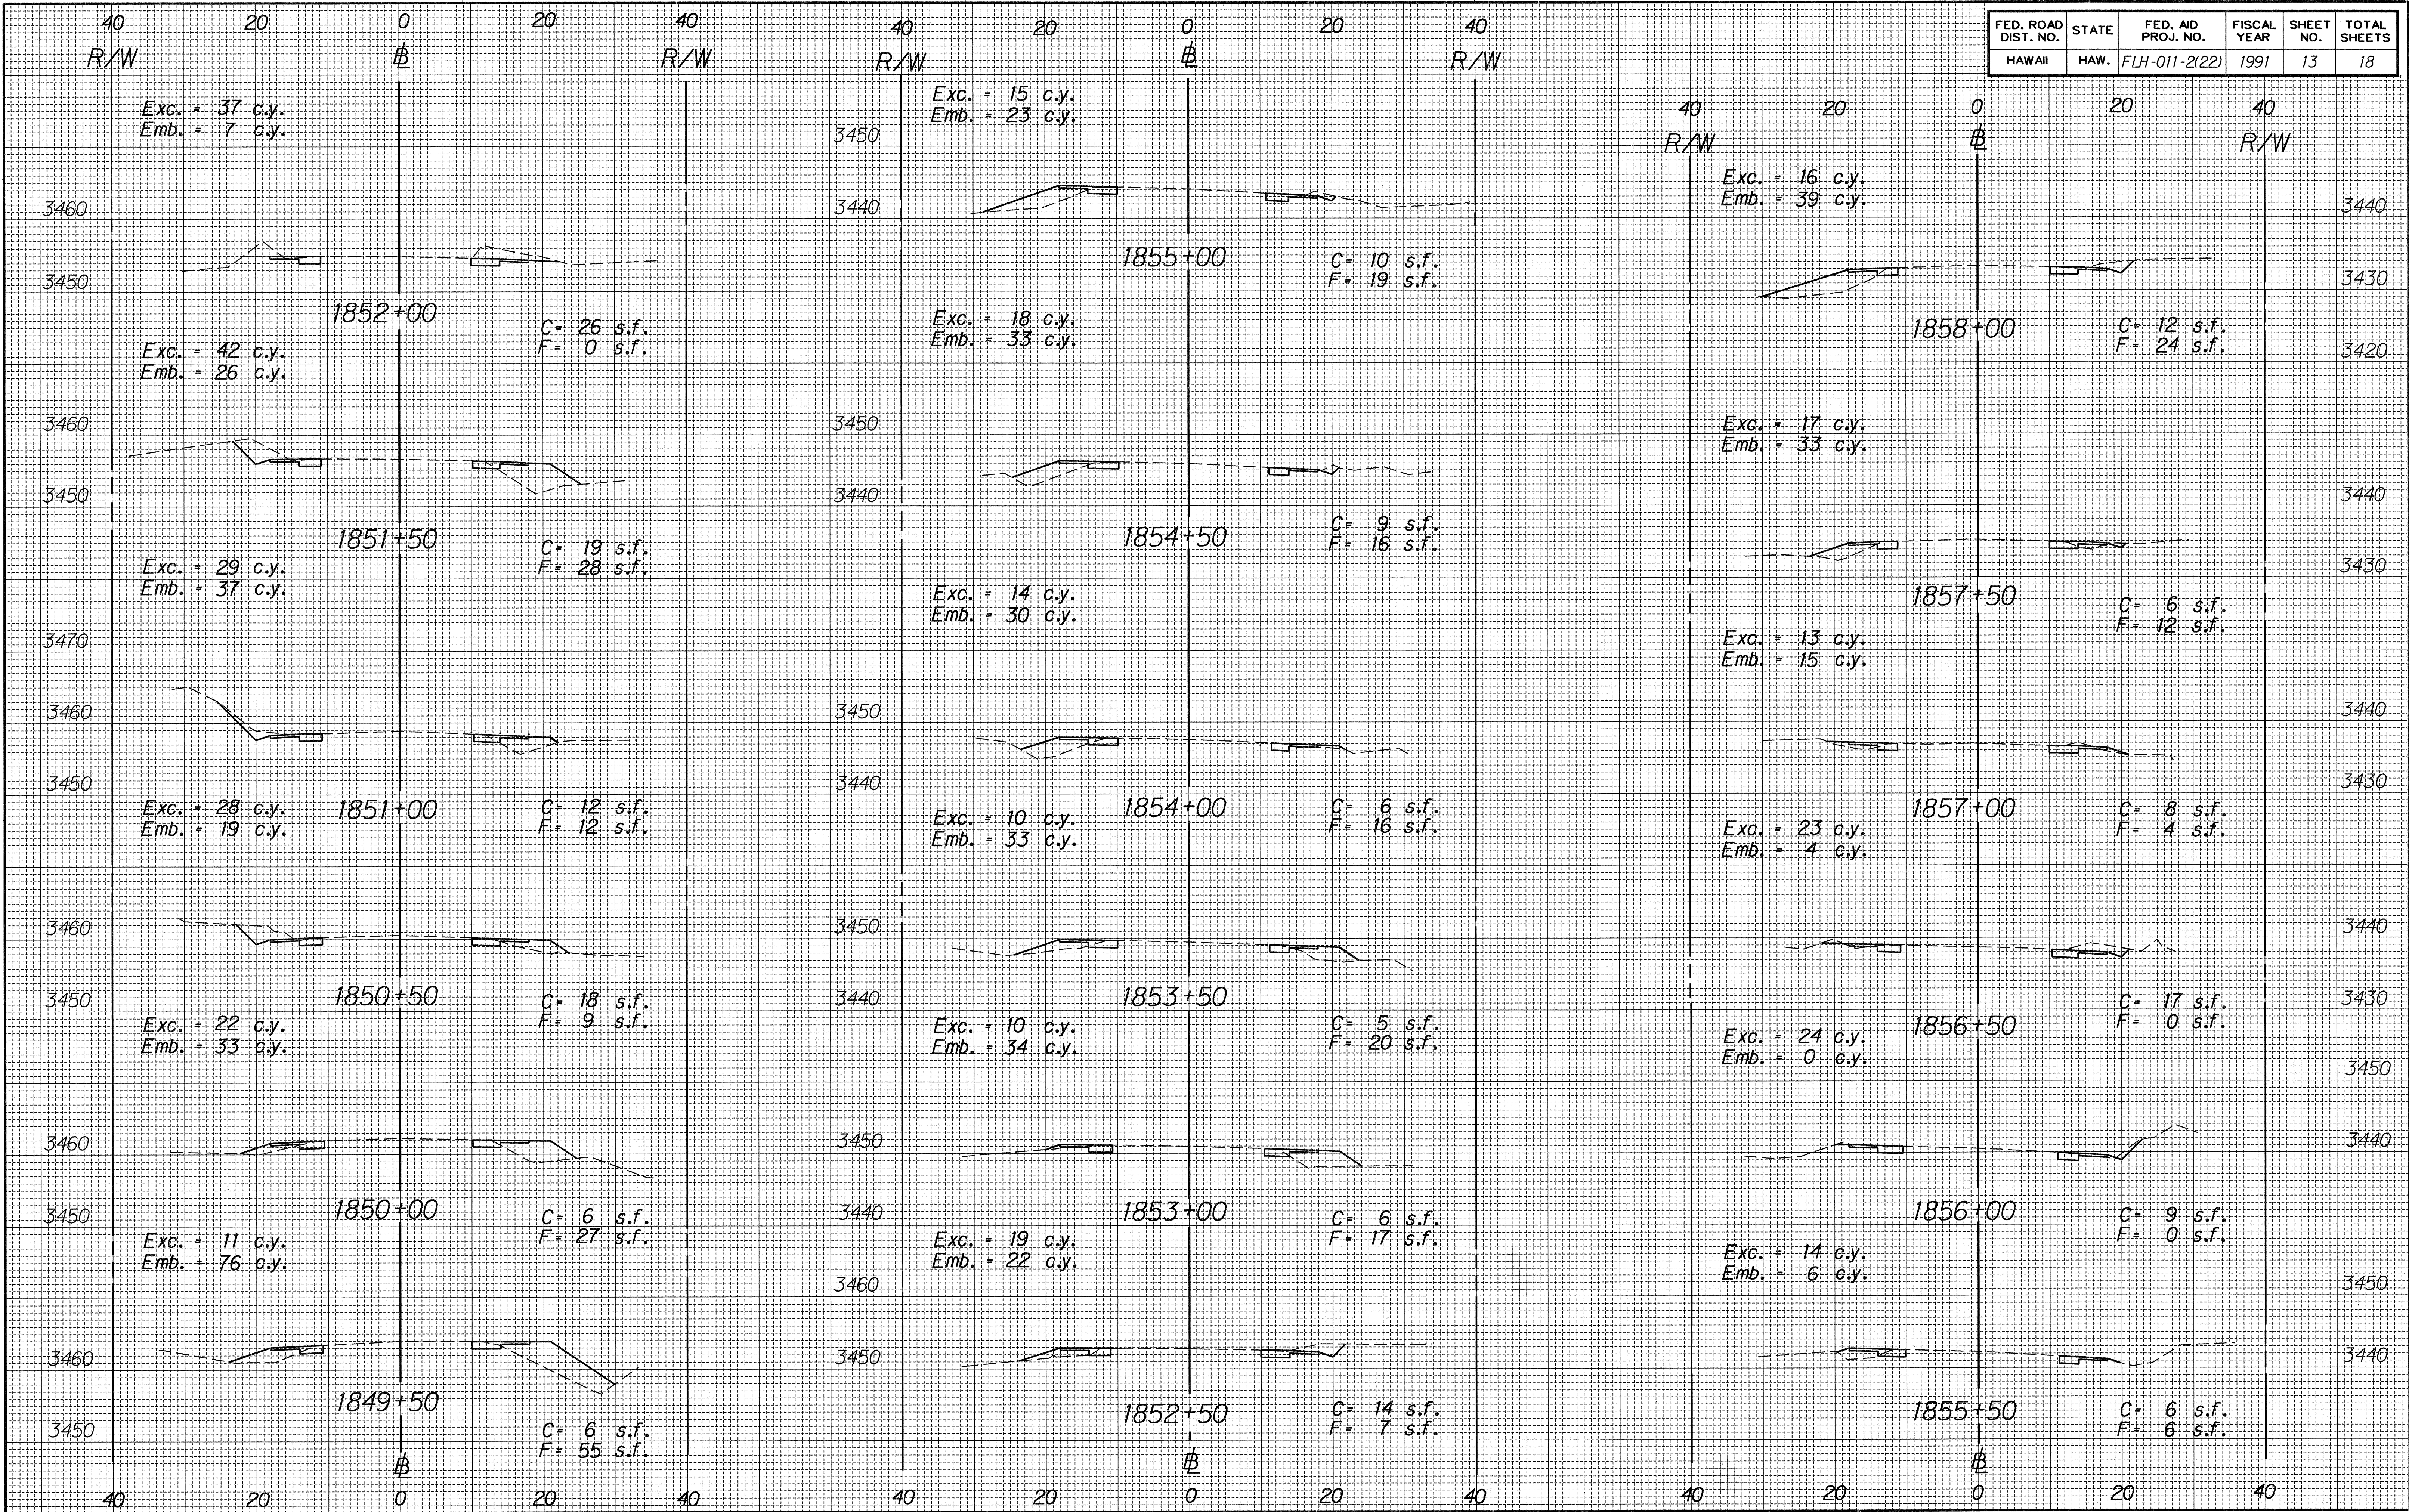


FED. ROAD DIST. NO.	STATE	FED. AID PROJ. NO.	FISCAL YEAR	SHEET NO.	TOTAL SHEETS
HAWAII	HAW.	FLH-011-2(22)	1991	14	18

SURVEY PLOTTED BY _____ DATE _____
 DRAWN BY _____
 DESIGNED BY _____
 NOTE BOOK _____
 QUANTITIES BY _____
 CHECKED BY _____

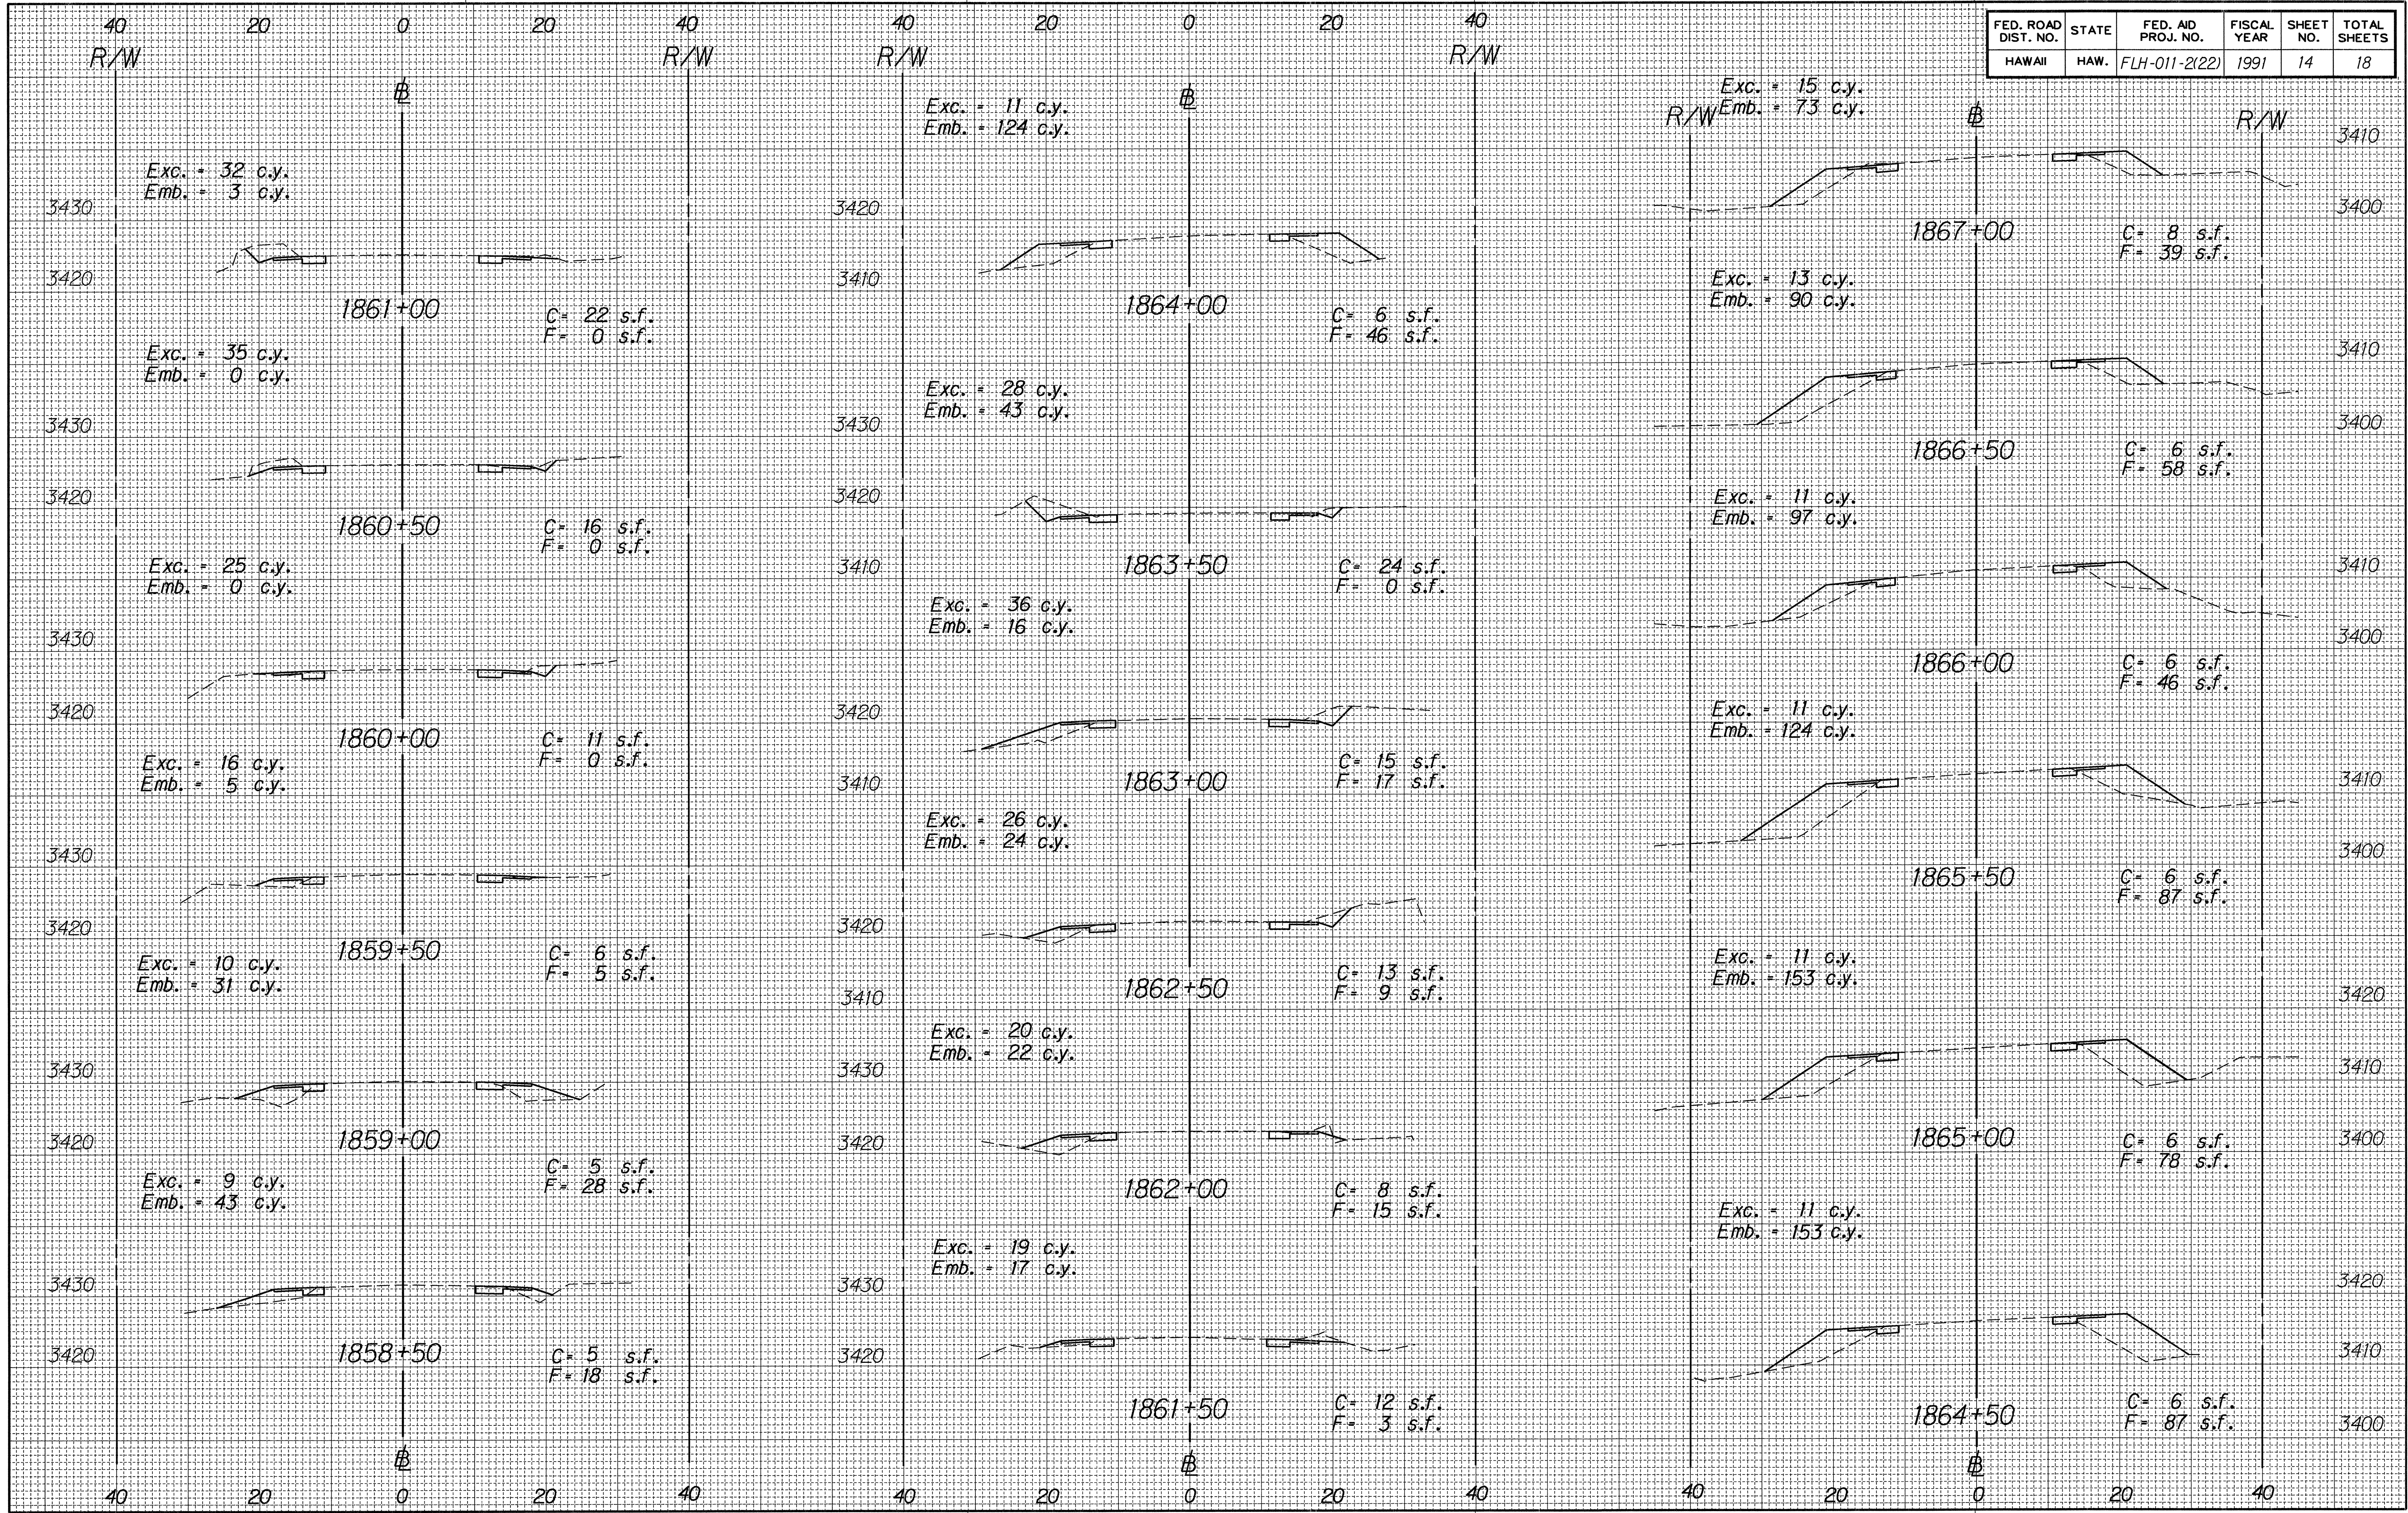


FED. ROAD DIST. NO.	STATE	FED. AID PROJ. NO.	FISCAL YEAR	SHEET NO.	TOTAL SHEETS
HAWAII	HAW.	FLH-011-2(22)	1991	15	18

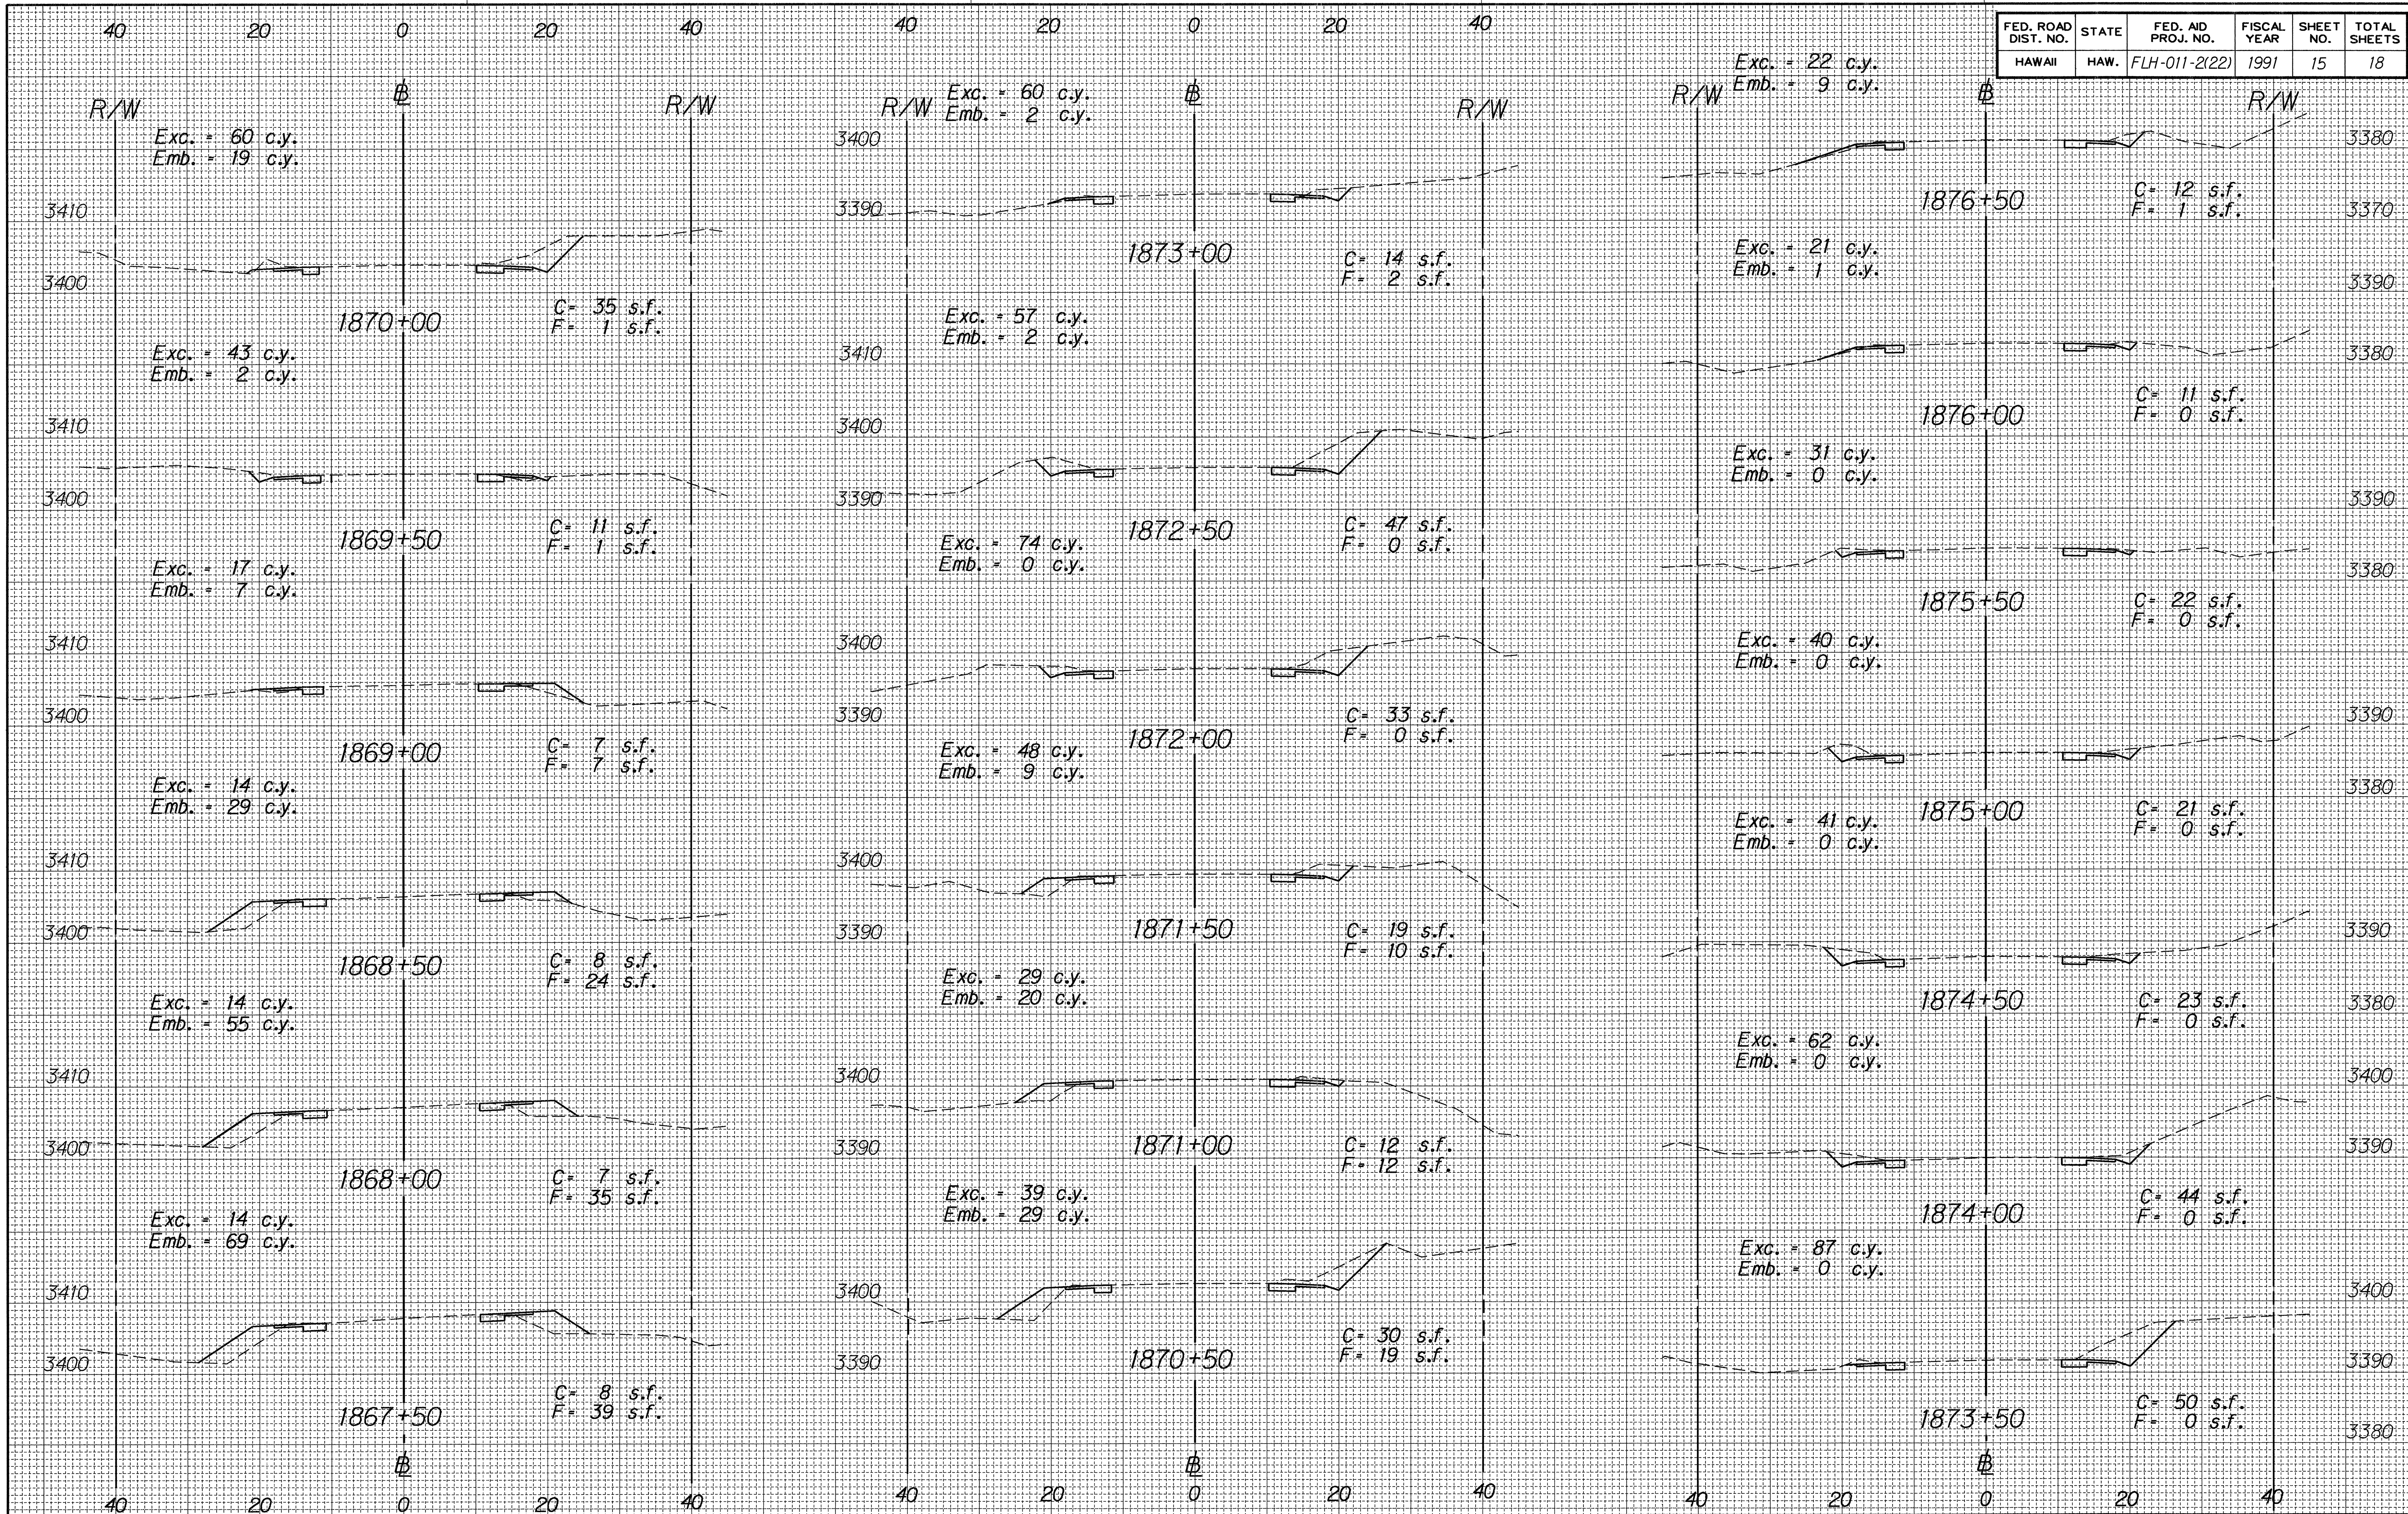


ORIGINAL PLAN
 SURVEY PLOTTED BY
 DRAWN BY
 TRACED BY
 NOTE BOOK
 DESIGNED BY
 CHECKED BY

ORIGINAL
PLAN
DATE
SURVEY PLOTTED BY
DRAWN BY
TRACED BY
NOTED BOOK
DESIGNED BY
CHECKED BY
QUANTITY BY

FED. ROAD DIST. NO.	STATE	FED. AID PROJ. NO.	FISCAL YEAR	SHEET NO.	TOTAL SHEETS
HAWAII	HAW.	FLH-011-2(22)	1991	16	18

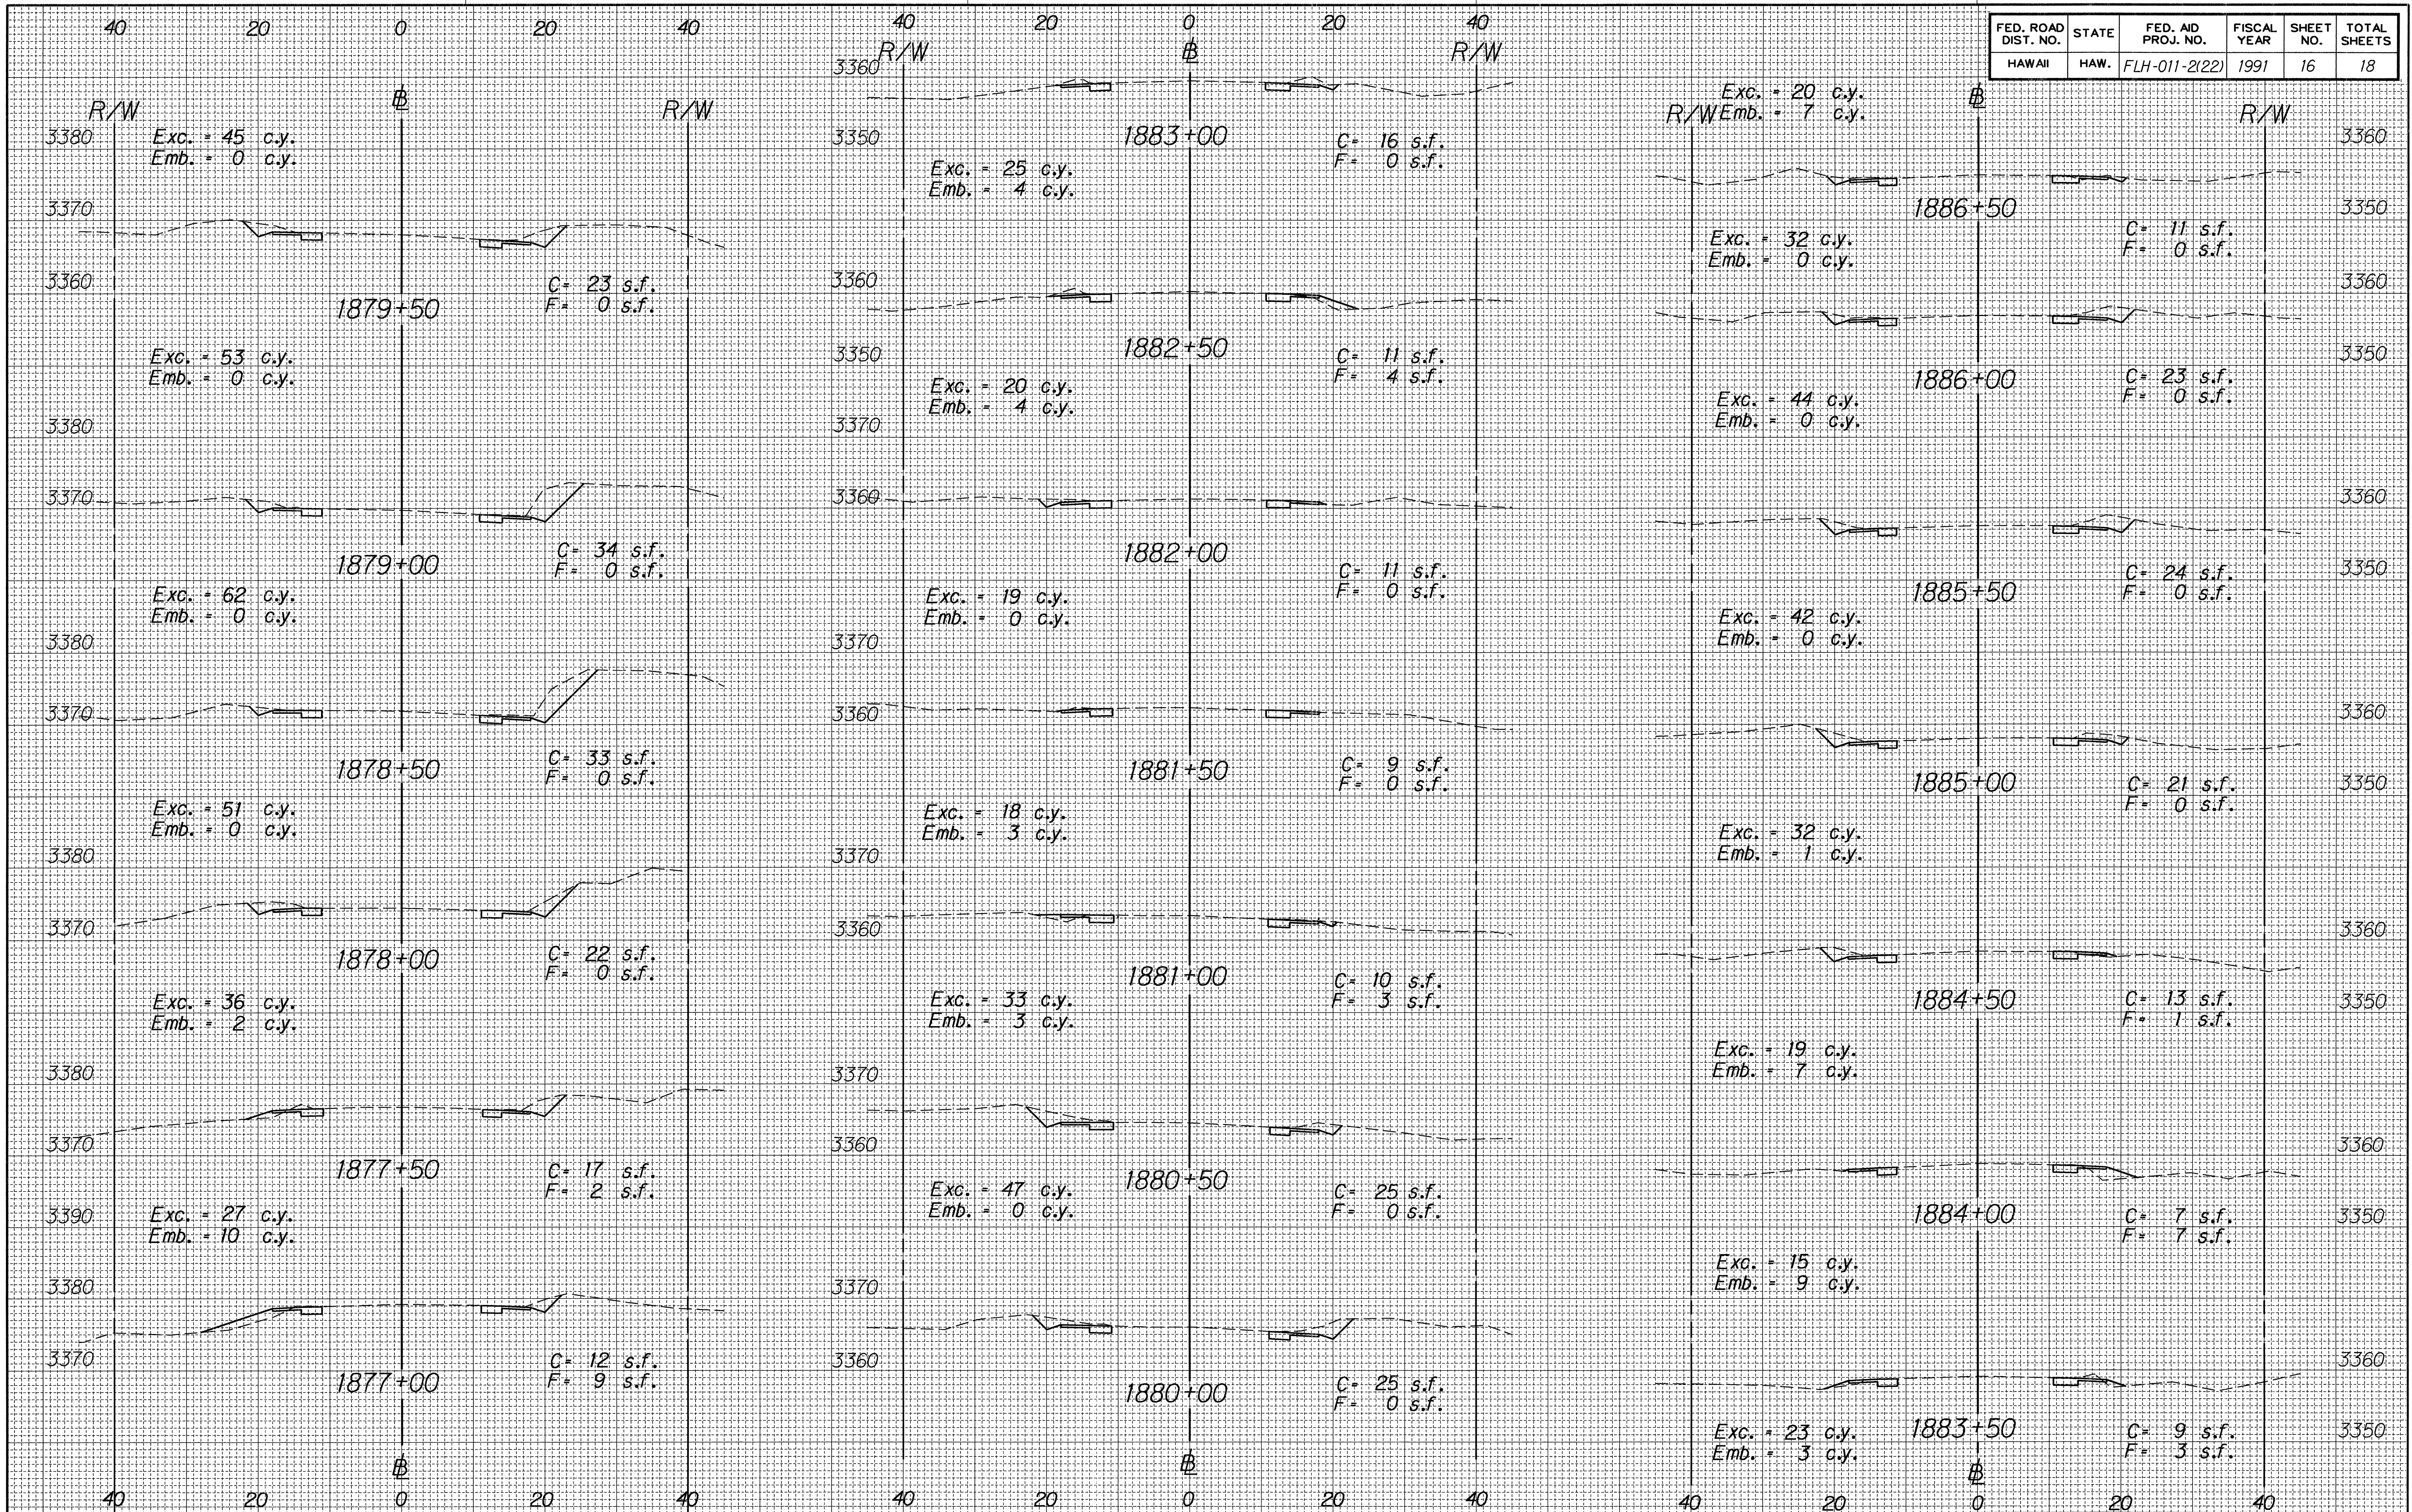

FED. ROAD DIST. NO.	STATE	FED. AID PROJ. NO.	FISCAL YEAR	SHEET NO.	TOTAL SHEETS
HAWAII	HAW.	FLH-011-2(22)	1991	17	18

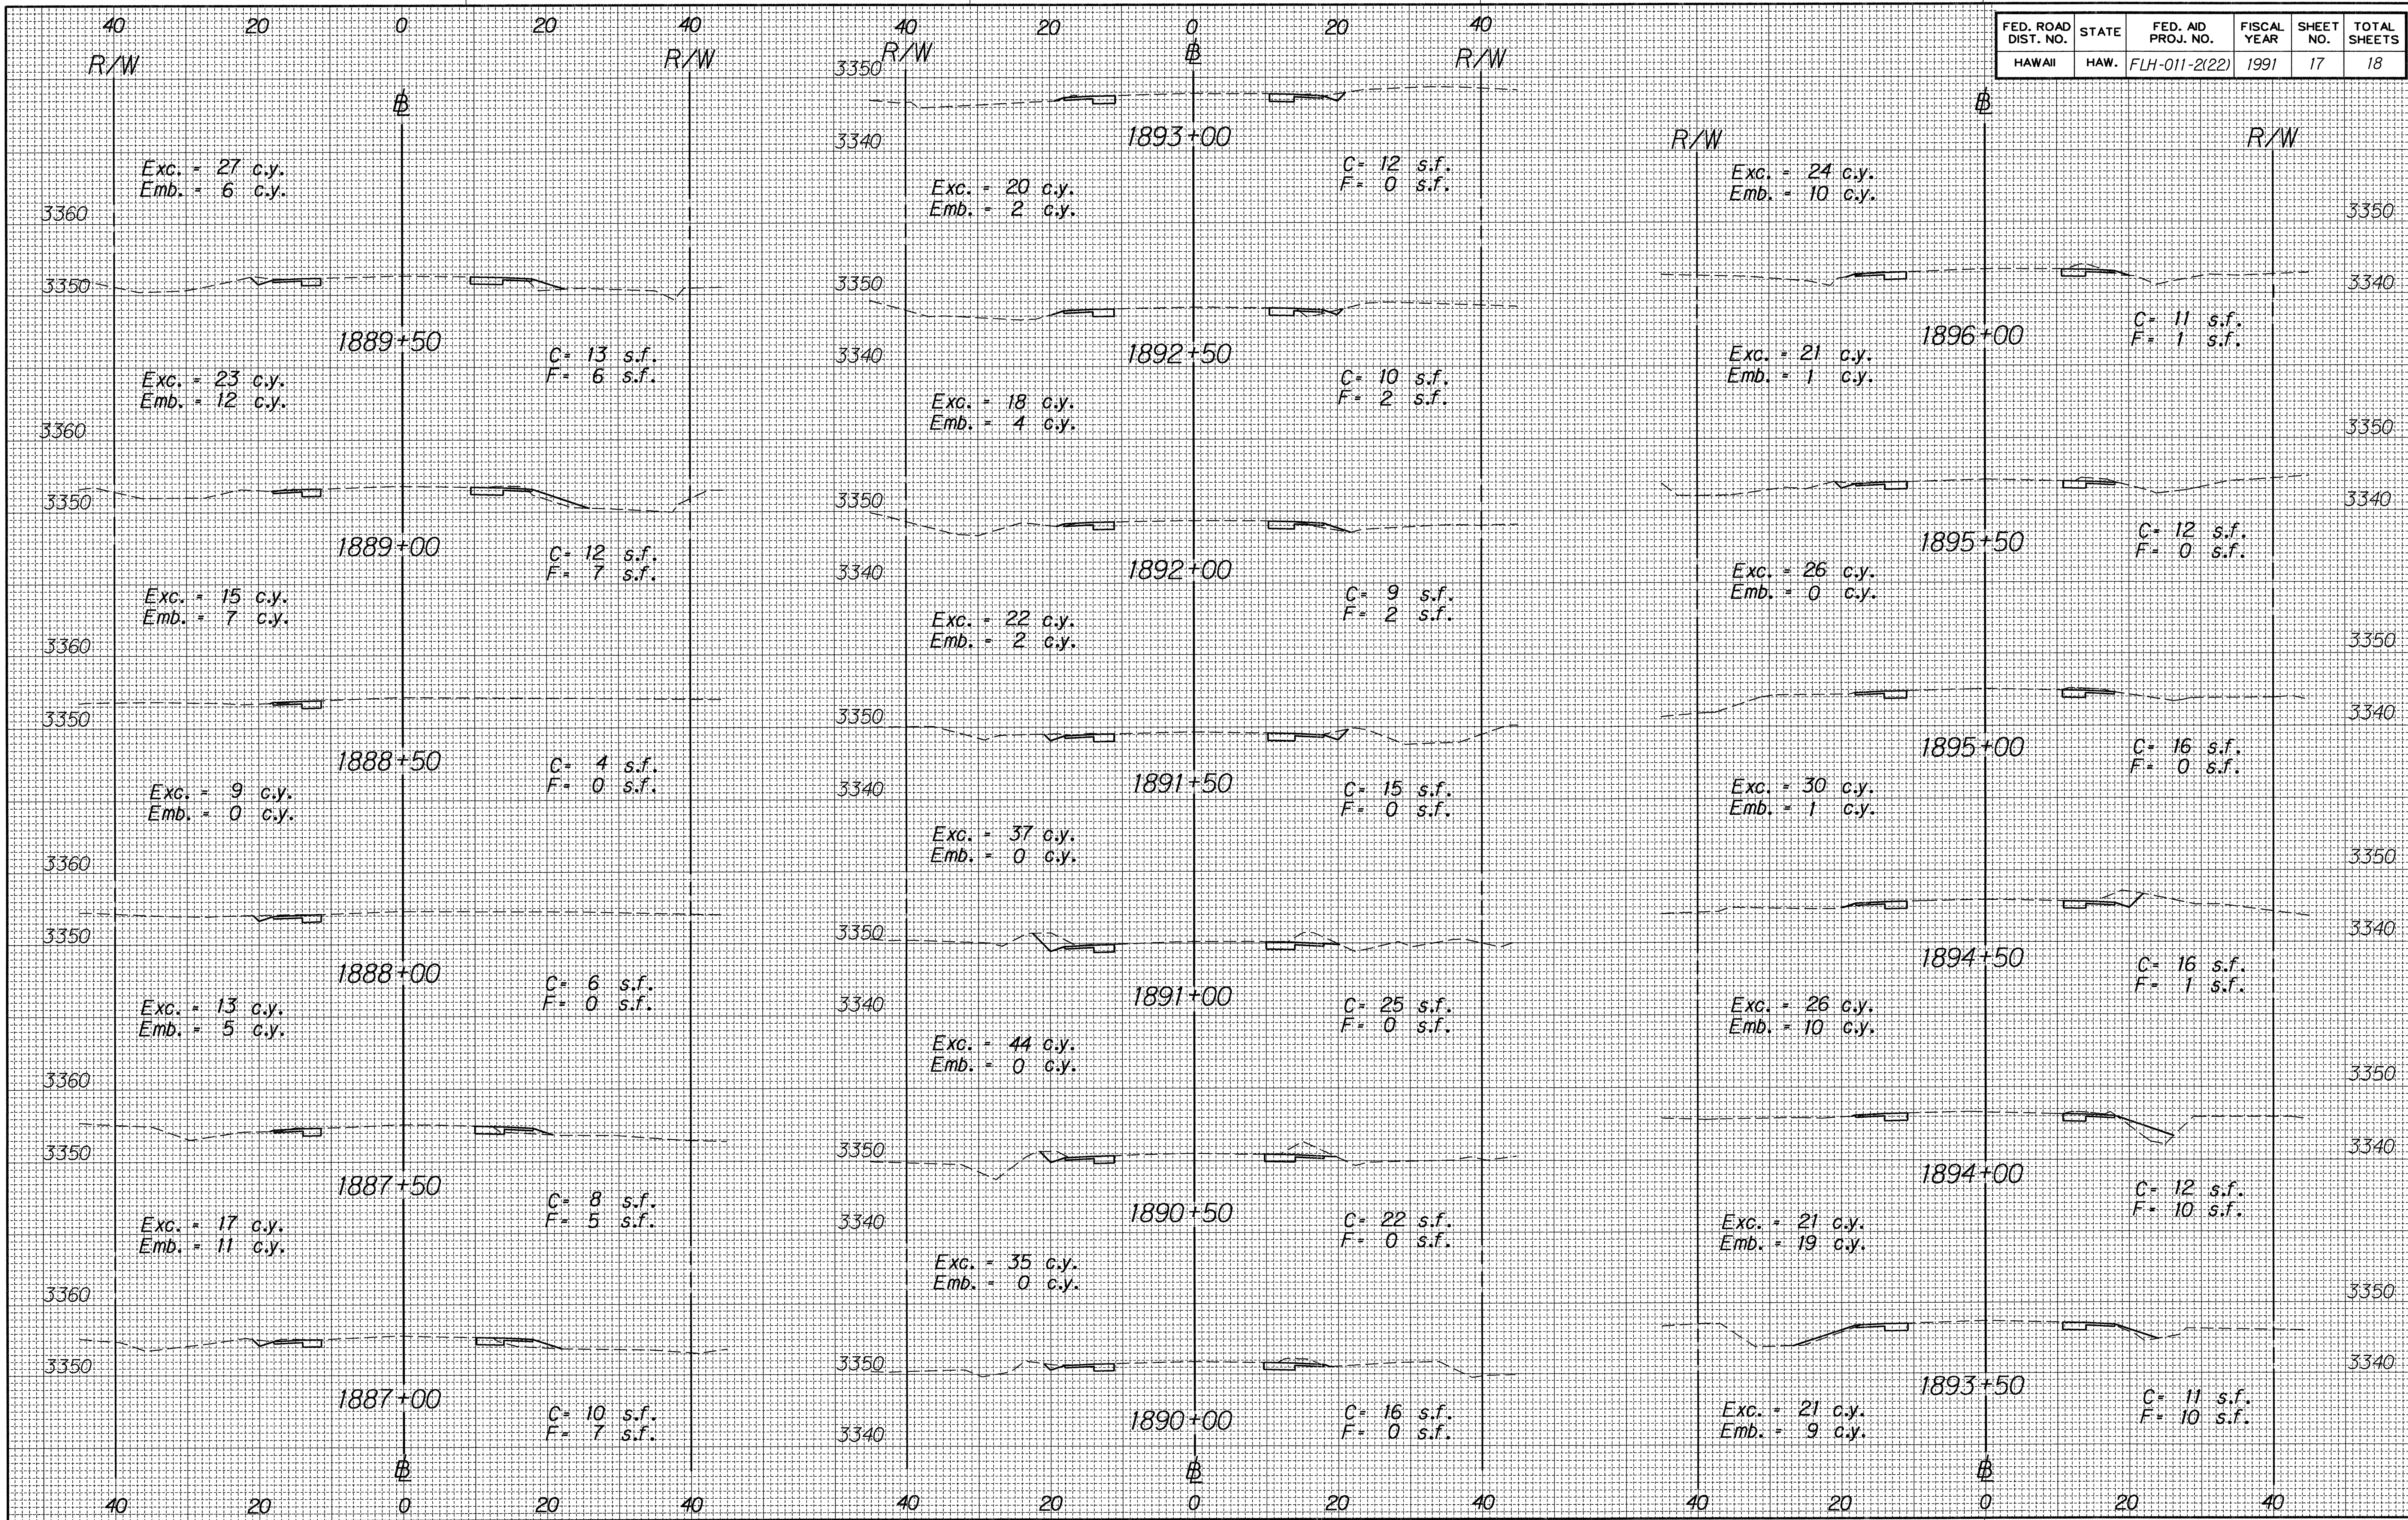

ORIGINAL PLAN
DATE
DRAWN BY
CHECKED BY
DESIGNED BY
NOTED BY
QUANTITIES BY

SURVEY PLOTTED BY _____
DATE _____
DESIGNED BY _____
CHECKED BY _____
NOTE BOOK _____
N. _____

FED. ROAD DIST. NO.	STATE	FED. AID PROJ. NO.	FISCAL YEAR	SHEET NO.	TOTAL SHEETS
HAWAII	HAW.	FLH-011-2(22)	1991	18	18

