



FED. ROAD DIST. NO.	STATE	FED. AID PROJ. NO.	FISCAL YEAR	SHEET NO.	TOTAL SHEETS
HAWAII	HAW.	FLH-011-2(22)	1991	11	18

SCHEDULE OF STRIPING AND PAVEMENT MARKERS									
STATION - STATION	NEW STRIPING			NEW MARKERS				COMMENTS	
	4" YELLOW (L.F.)		4" WHITE @ E.P. (L.F.)	TYPE "CL"	TYPE "DL"	TYPE "HL"	TYPE "J"		
	DOUBLE	SINGLE							
<del>1839+66</del> - <del>1847+00</del> <del>1841+16</del> - <del>1847+40</del>		<del>734</del> <del>624</del>		<del>19</del> <del>16</del>	<del>19</del> <del>16</del>	<del>76</del> <del>64</del>	NO PASS. TO PAHALA, PASS. TO HILO		
<del>1847+00</del> - <del>1876+00</del> <del>1847+40</del> - <del>1863+50</del>	<del>2,900</del> <del>1,610</del>			<del>147</del> <del>81</del>			NO PASSING		
<del>1876+00</del> - <del>1876+50</del> <del>1863+50</del> - <del>1877+20</del>		50 770		<del>1</del> <del>20</del>	<del>2</del> <del>20</del>	<del>8</del> <del>80</del>	NO PASS. TO PAHALA, NO PASS. TO HILO		
<del>1881+50</del> - <del>1884+50</del> <del>1877+20</del> - <del>1900+00</del>		300	STA. 1842+16	<del>7</del> <del>88</del>	8	<del>32</del> <del>352</del>	PASSING TO PAHALA, NO PASS. TO HILO		
<del>1884+50</del> - <del>1900+00</del> <del>1877+20</del> - <del>1900+00</del>		<del>400</del> 300	TO 12,968	326	<del>10</del> 7	<del>11</del> 8	<del>44</del> 36	EDGE STRIPING NO PASS. TO PAHALA, PASS. TO HILO	
<del>1904+00</del> - <del>1907+00</del>			STA. 1907+00	326	<del>205</del>	<del>36</del>	<del>496</del>	PASS. TO PAHALA, NO PASS. TO HILO	
TOTAL	<del>1,610</del> 2,900	<del>1,394</del> 1,784	12,968						
			STA. 1876+50 TO STA. 1881+50	13			48	PASSING	
			STA. 1884+50 TO STA. 1896+00	29			112	PASSING	
			STA. 1900+00 TO STA. 1904+00	10			36	PASSING	
			TOTAL	243	48	392			

TRAFFIC SIGN SUMMARY					
SIGN NO.	MESSAGE	QUANTITY			
		10 SQ. FT. OR LESS		GREATER THAN 10 SQ. FT.	
		W/POST	W/O POST	W/POST	W/O POST
R2-1(45)	SPEED LIMIT 45	2			
	TOTAL	2	0	0	0


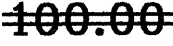
CONSTRUCTION SIGN SUMMARY				
SIGN NO.	LOCATION	MESSAGE	W/POST	W/O POST
CW20-1d	Sta. 1831+16 ± Rt.	ROAD CONSTRUCTION AHEAD	1	
CW20-1c	Sta. 1836+16 ± Rt.	ROAD CONSTRUCTION 500 FT.	1	
CG20-2	Sta. 1836+16 ± Lt.	END CONSTRUCTION	1	
CW20-1c	Sta. 1911+00 ± Rt.	ROAD CONSTRUCTION 500 FT.	1	
CG20-2	Sta. 1911+00 ± Lt.	END CONSTRUCTION	1	
CW20-1d	Sta. 1916+00 ± Rt.	ROAD CONSTRUCTION AHEAD	1	
	TOTAL		6	0

MILEPOST MARKER SUMMARY			
M.P. NO.	LOCATION	QUANTITY	
		w/Post	w/o Post
35	Sta. 1859+90 ± Rt. (BI-Directional)	1	
	TOTAL	1	0

REFLECTOR MARKER SUMMARY		
TYPE	QUANTITY	
	w/Steel Post	
RM-1	Yellow	White
BI-Directional		<del>41</del> 40

PAVEMENT MARKING SUMMARY	
DESCRIPTION	QUANTITY
PAVEMENT MARKERS	
TYPE A	
TYPE CL	326 EA.
TYPE DL	243 EA.
TYPE HL	48 EA.
TYPE J	392 EA.
TAPE - <del>TYPE I OR</del> THERMOPLASTIC EXTRUSION	
4-INCH PAVEMENT STRIPE (WHITE)	1,784
4-INCH PAVEMENT STRIPE (YELLOW)	<del>1,394</del> L.F.
8-INCH PAVEMENT STRIPE (WHITE)	
12-INCH PAVEMENT STRIPE (WHITE)	
12-INCH PAVEMENT STRIPE (YELLOW)	2,900
DOUBLE 4-INCH PAVEMENT STRIPE (YELLOW)	<del>1,610</del> L.F.
PAVEMENT ARROW	
PAVEMENT WORD	
TAPE - <del>TYPE II OR</del> THERMOPLASTIC EXTRUSION	
4-INCH PAVEMENT STRIPE (WHITE)	
4-INCH PAVEMENT STRIPE (YELLOW)	
8-INCH PAVEMENT STRIPE (WHITE)	
12-INCH PAVEMENT STRIPE (WHITE)	
12-INCH PAVEMENT STRIPE (YELLOW)	12,968 L.F.
THERMOPLASTIC EXTRUSION	
4-INCH PAVEMENT STRIPE (WHITE)	
8-INCH PAVEMENT STRIPE (WHITE)	
12-INCH PAVEMENT STRIPE (WHITE)	
CROSSWALK MARKINGS	

SURVEY PLOTTED BY	DATE
DRAWN BY	
TRACED BY	
NOTED BY	
CHECKED BY	
ORIGINAL PLAN	
NOTE BOOK	
No.	

LEGEND FOR AS-BUILT POSTINGS	
	squiggly line for as-built deletion
	double line for as-built deletion
Roadway	text for as-built posting

STATE OF HAWAII DEPARTMENT OF TRANSPORTATION HIGHWAYS DIVISION
MISCELLANEOUS SUMMARIES
HAWAII BELT ROAD WIDENING Hawaii Volcanoes National Park Mile Post 34.7 to Mile Post 35.9 F.A. Proj. No. FLH-011-2(22)
Date: August 1990
SHEET No. T2 OF 2 SHEETS