INDEX TO DRAWINGS					
DESCRIPTION  TITLE SHEET  STANDARD PLANS SUMMARY  TYPICAL SECTION & GENERAL					
			NOTES		
			PLAN & PROFILE		
			PAVEMENT MARKING LEGEND &		
SUMMARY CROSS SECTION					

STATE OF HAWAII

DEPARTMENT OF TRANSPORTATION
HIGHWAYS DIVISION
HONOLULU, HAWAII

"AS-BUILT"

PLANS FOR

## HAWAII BELT ROAD WIDENING

HAWAII VOLCANOES NATIONAL PARK
M.P. 34.7 TO M.P. 35.9


F.A. PROJECT NO. FLH-011-2(22)


DISTRICT OF KAU
ISLAND OF HAWAII

BEEN INCORPORATED ON THESE PLANS EXCEPT CHANGES IN THE ORIGINAL THEORETICAL QUANTITIES, REFER TO PROJECT LEDGER AND/OR COMPUTATION BOOK.

Howard Home 2-19-93
RESIDENT ENGINEER DATE

CHANGES MADE DURING CONSTRUCTION HAVE

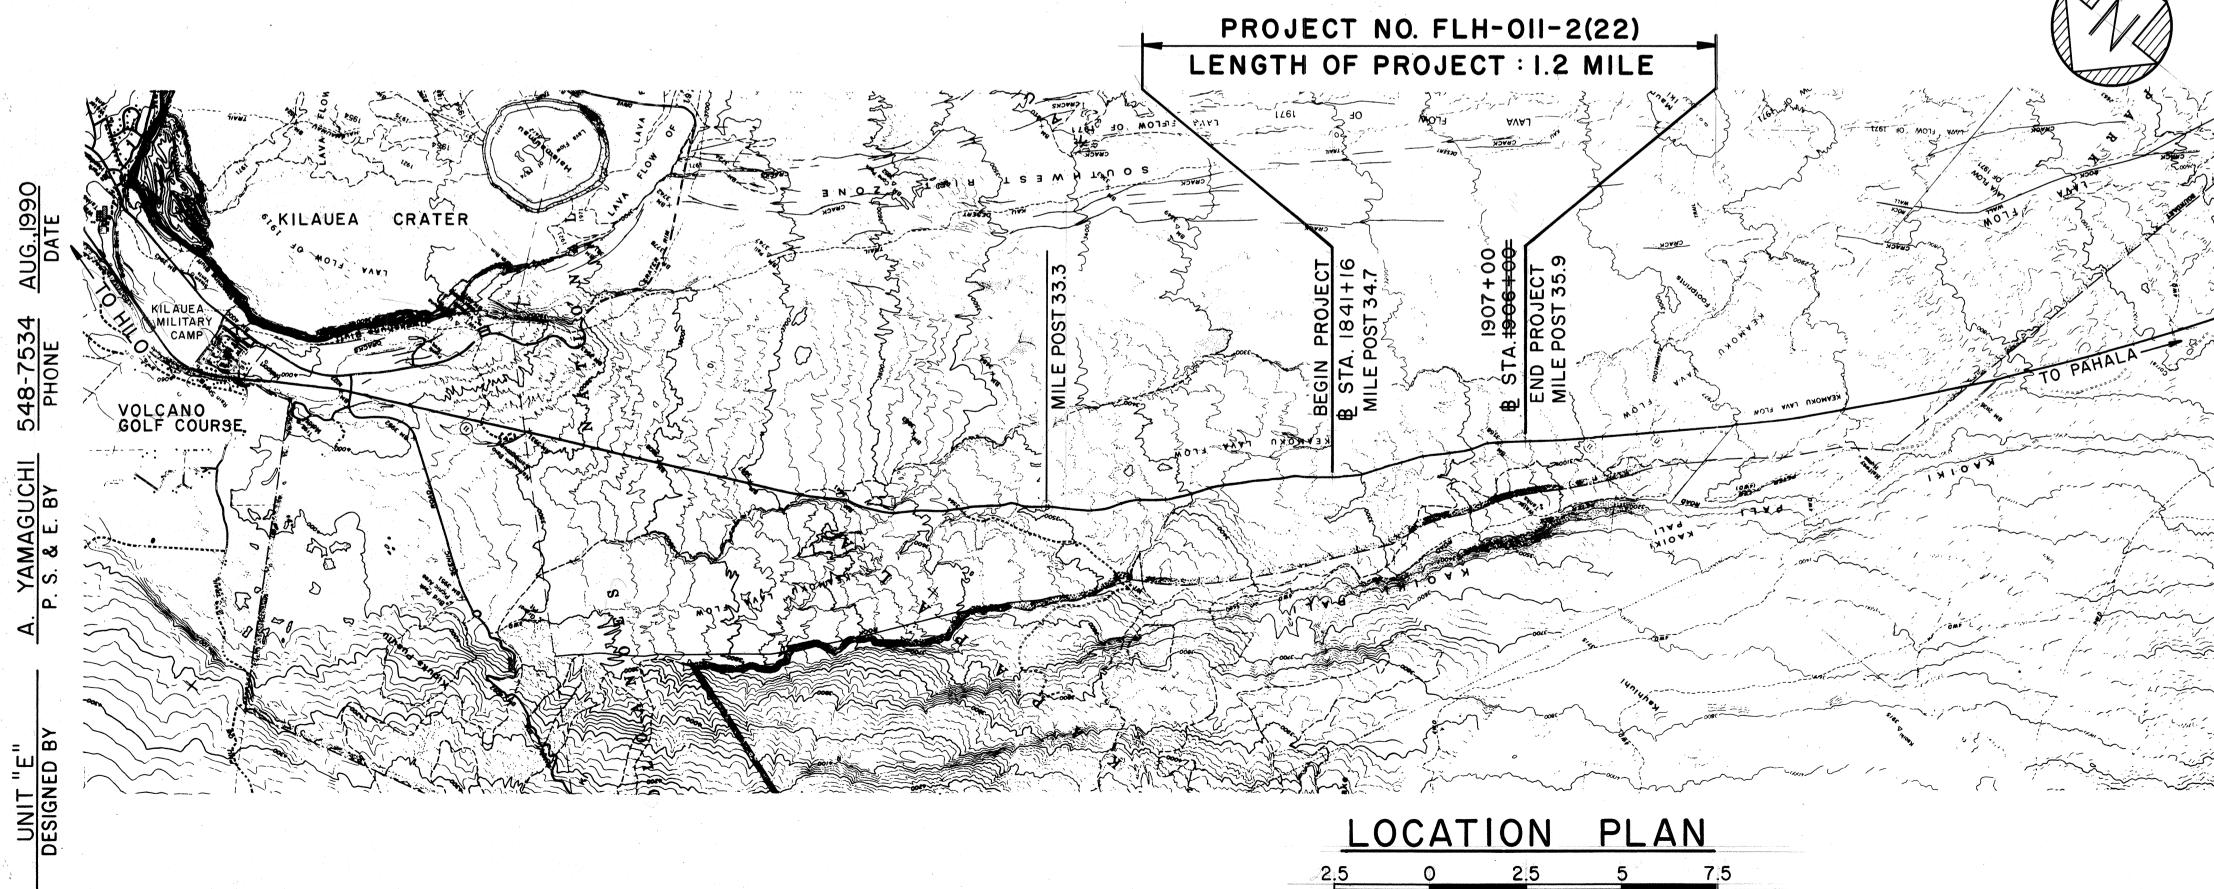

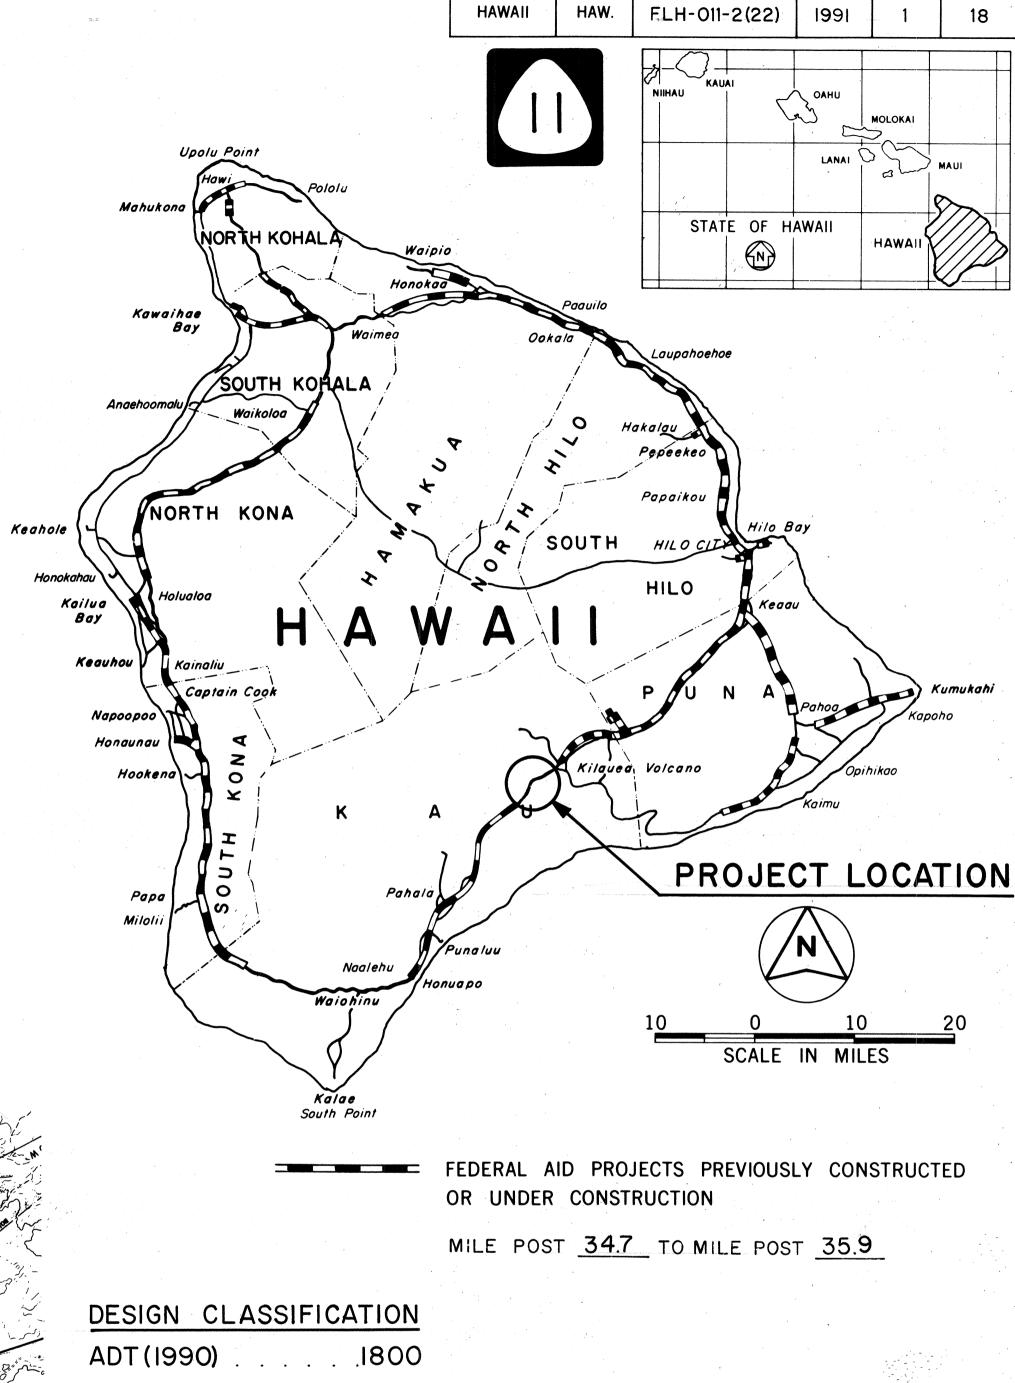

FED. ROAD DIST. NO. FISCAL SHEET TOTAL YEAR NO. SHEETS

FED. AID PROJ. NO.

DESIGN CLASSIFICATION
ADT (1990)
ADT (2010) 2600
DHV 260
D 60/40
T 8.5%
K 10.0%
V

1. 1. 1		
<b>*</b> -	DEPARTMENT OF TRANSPOR	RTATION
؞ آخر	FEDERAL HIGHWAY ADMINIS	TRATION
	APPROVED:	
	Weather	10/18/90
	DIVISION ADMINISTRATOR	DATE

