

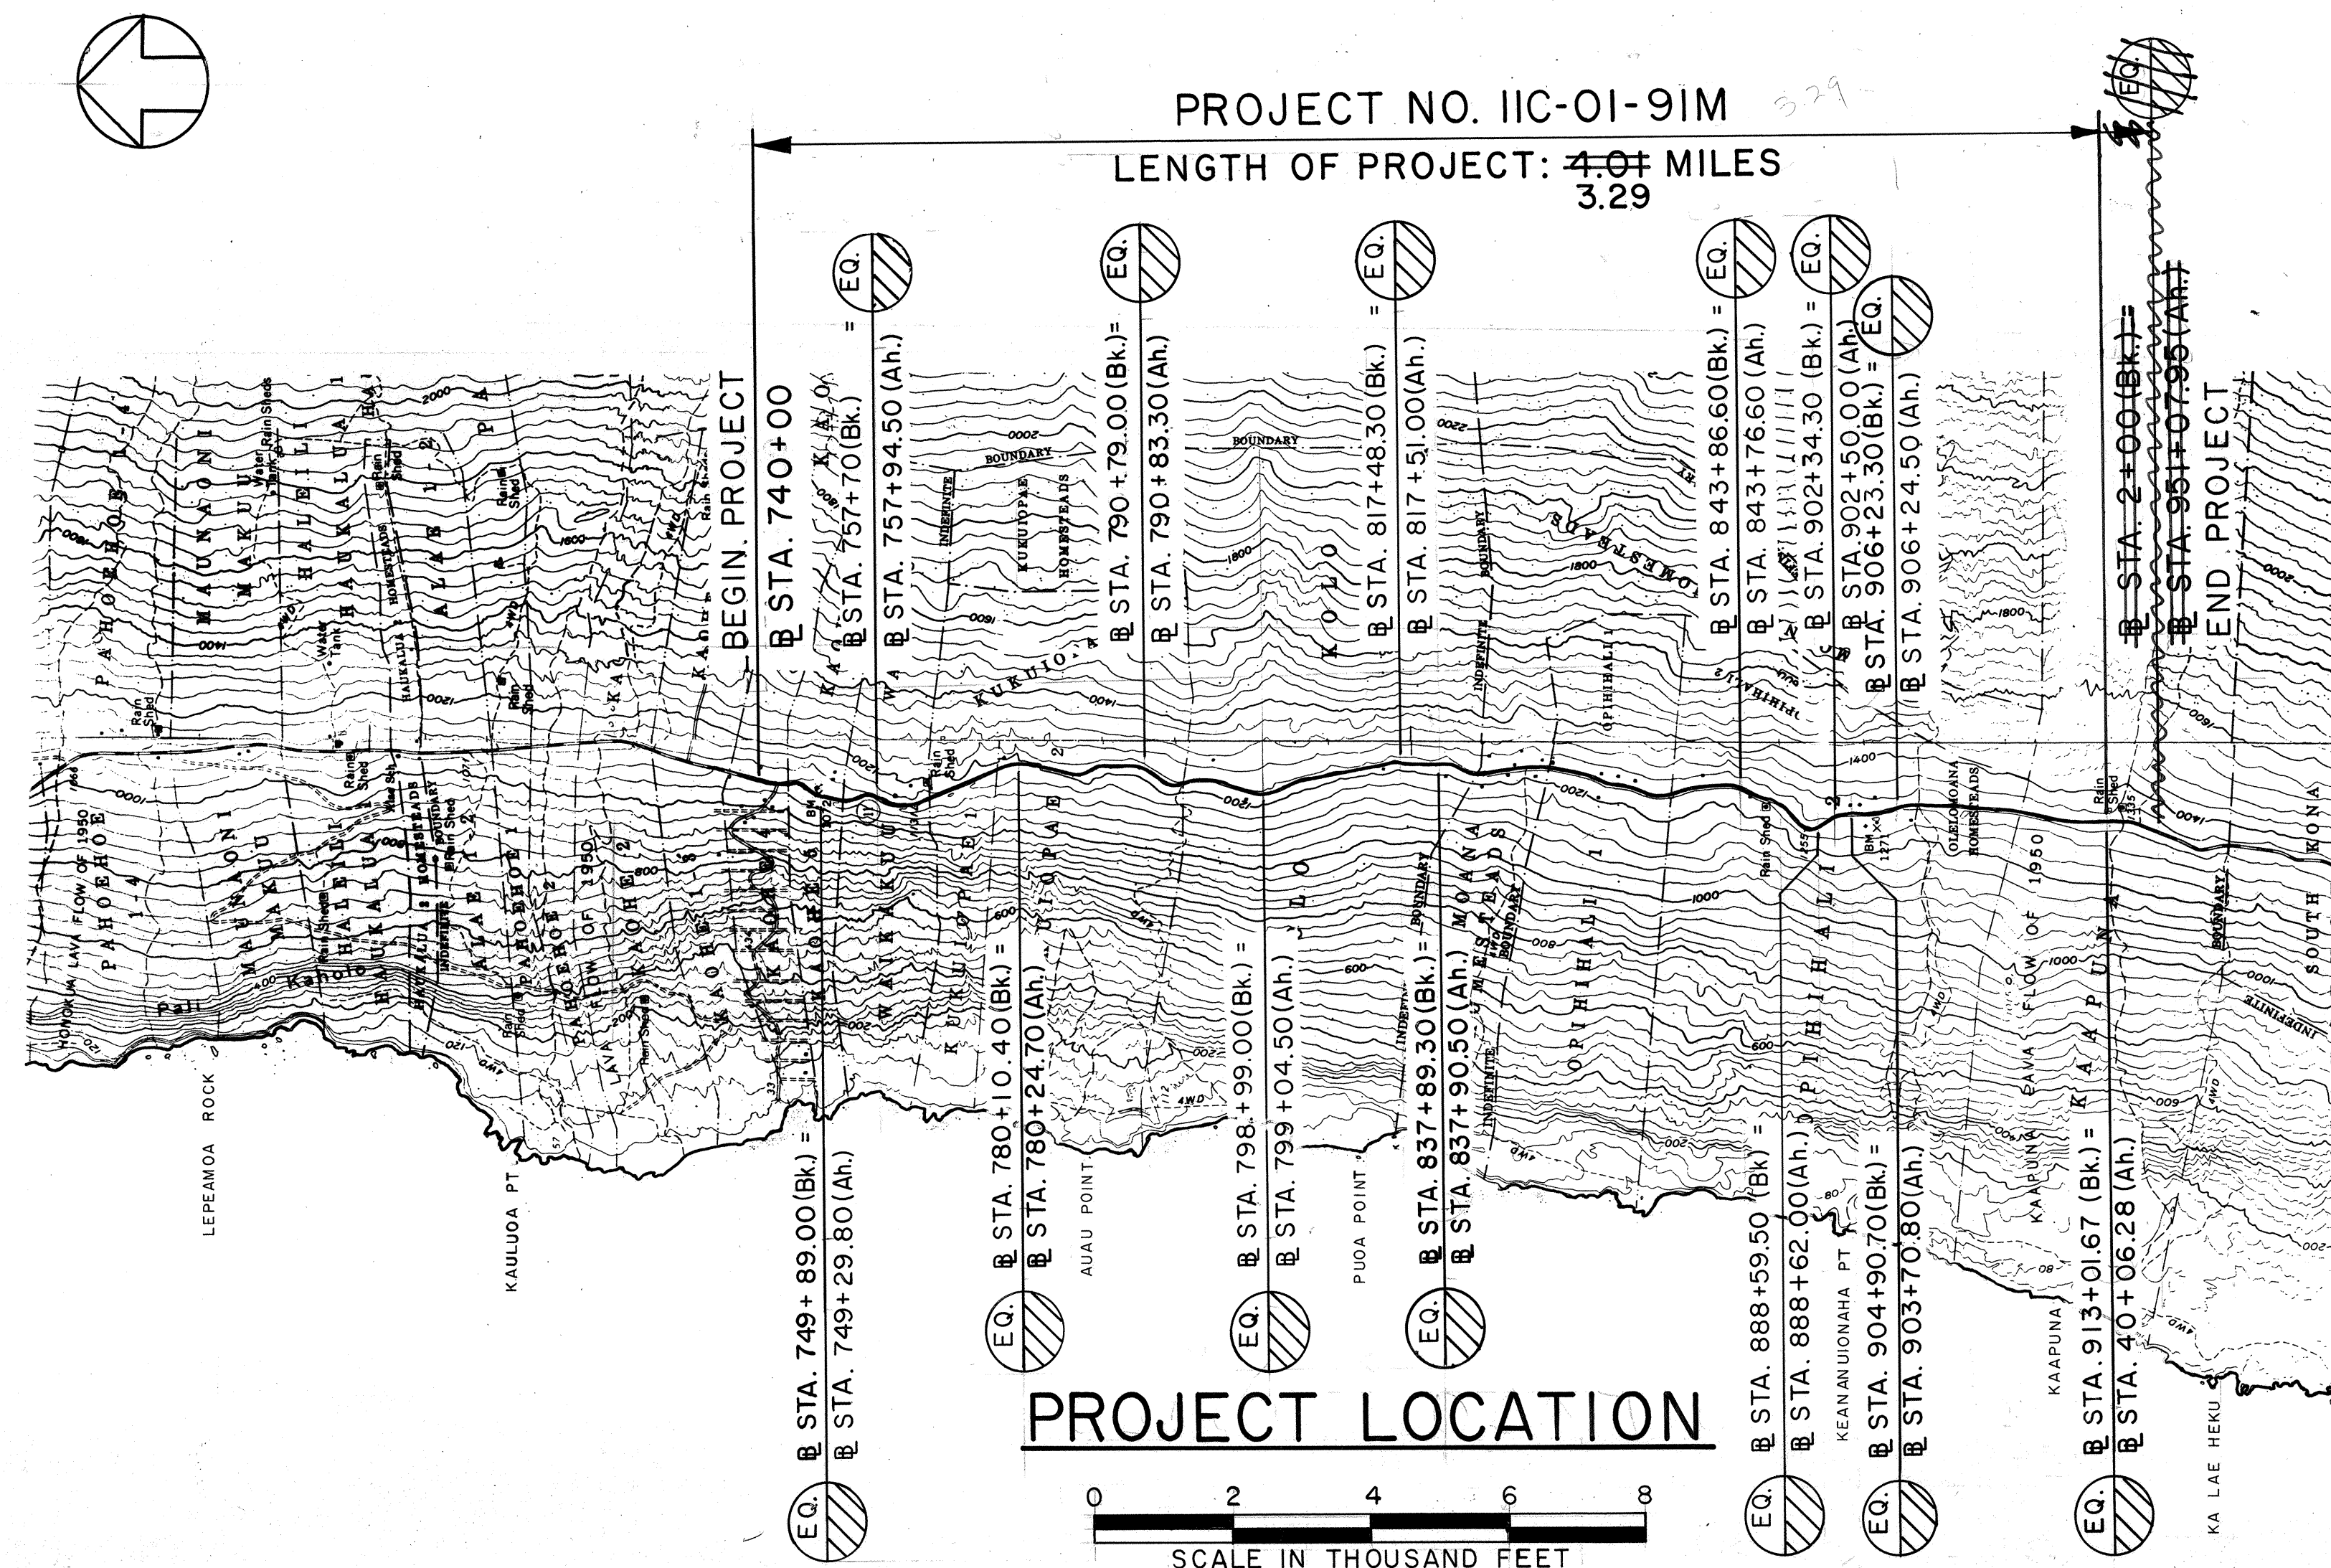
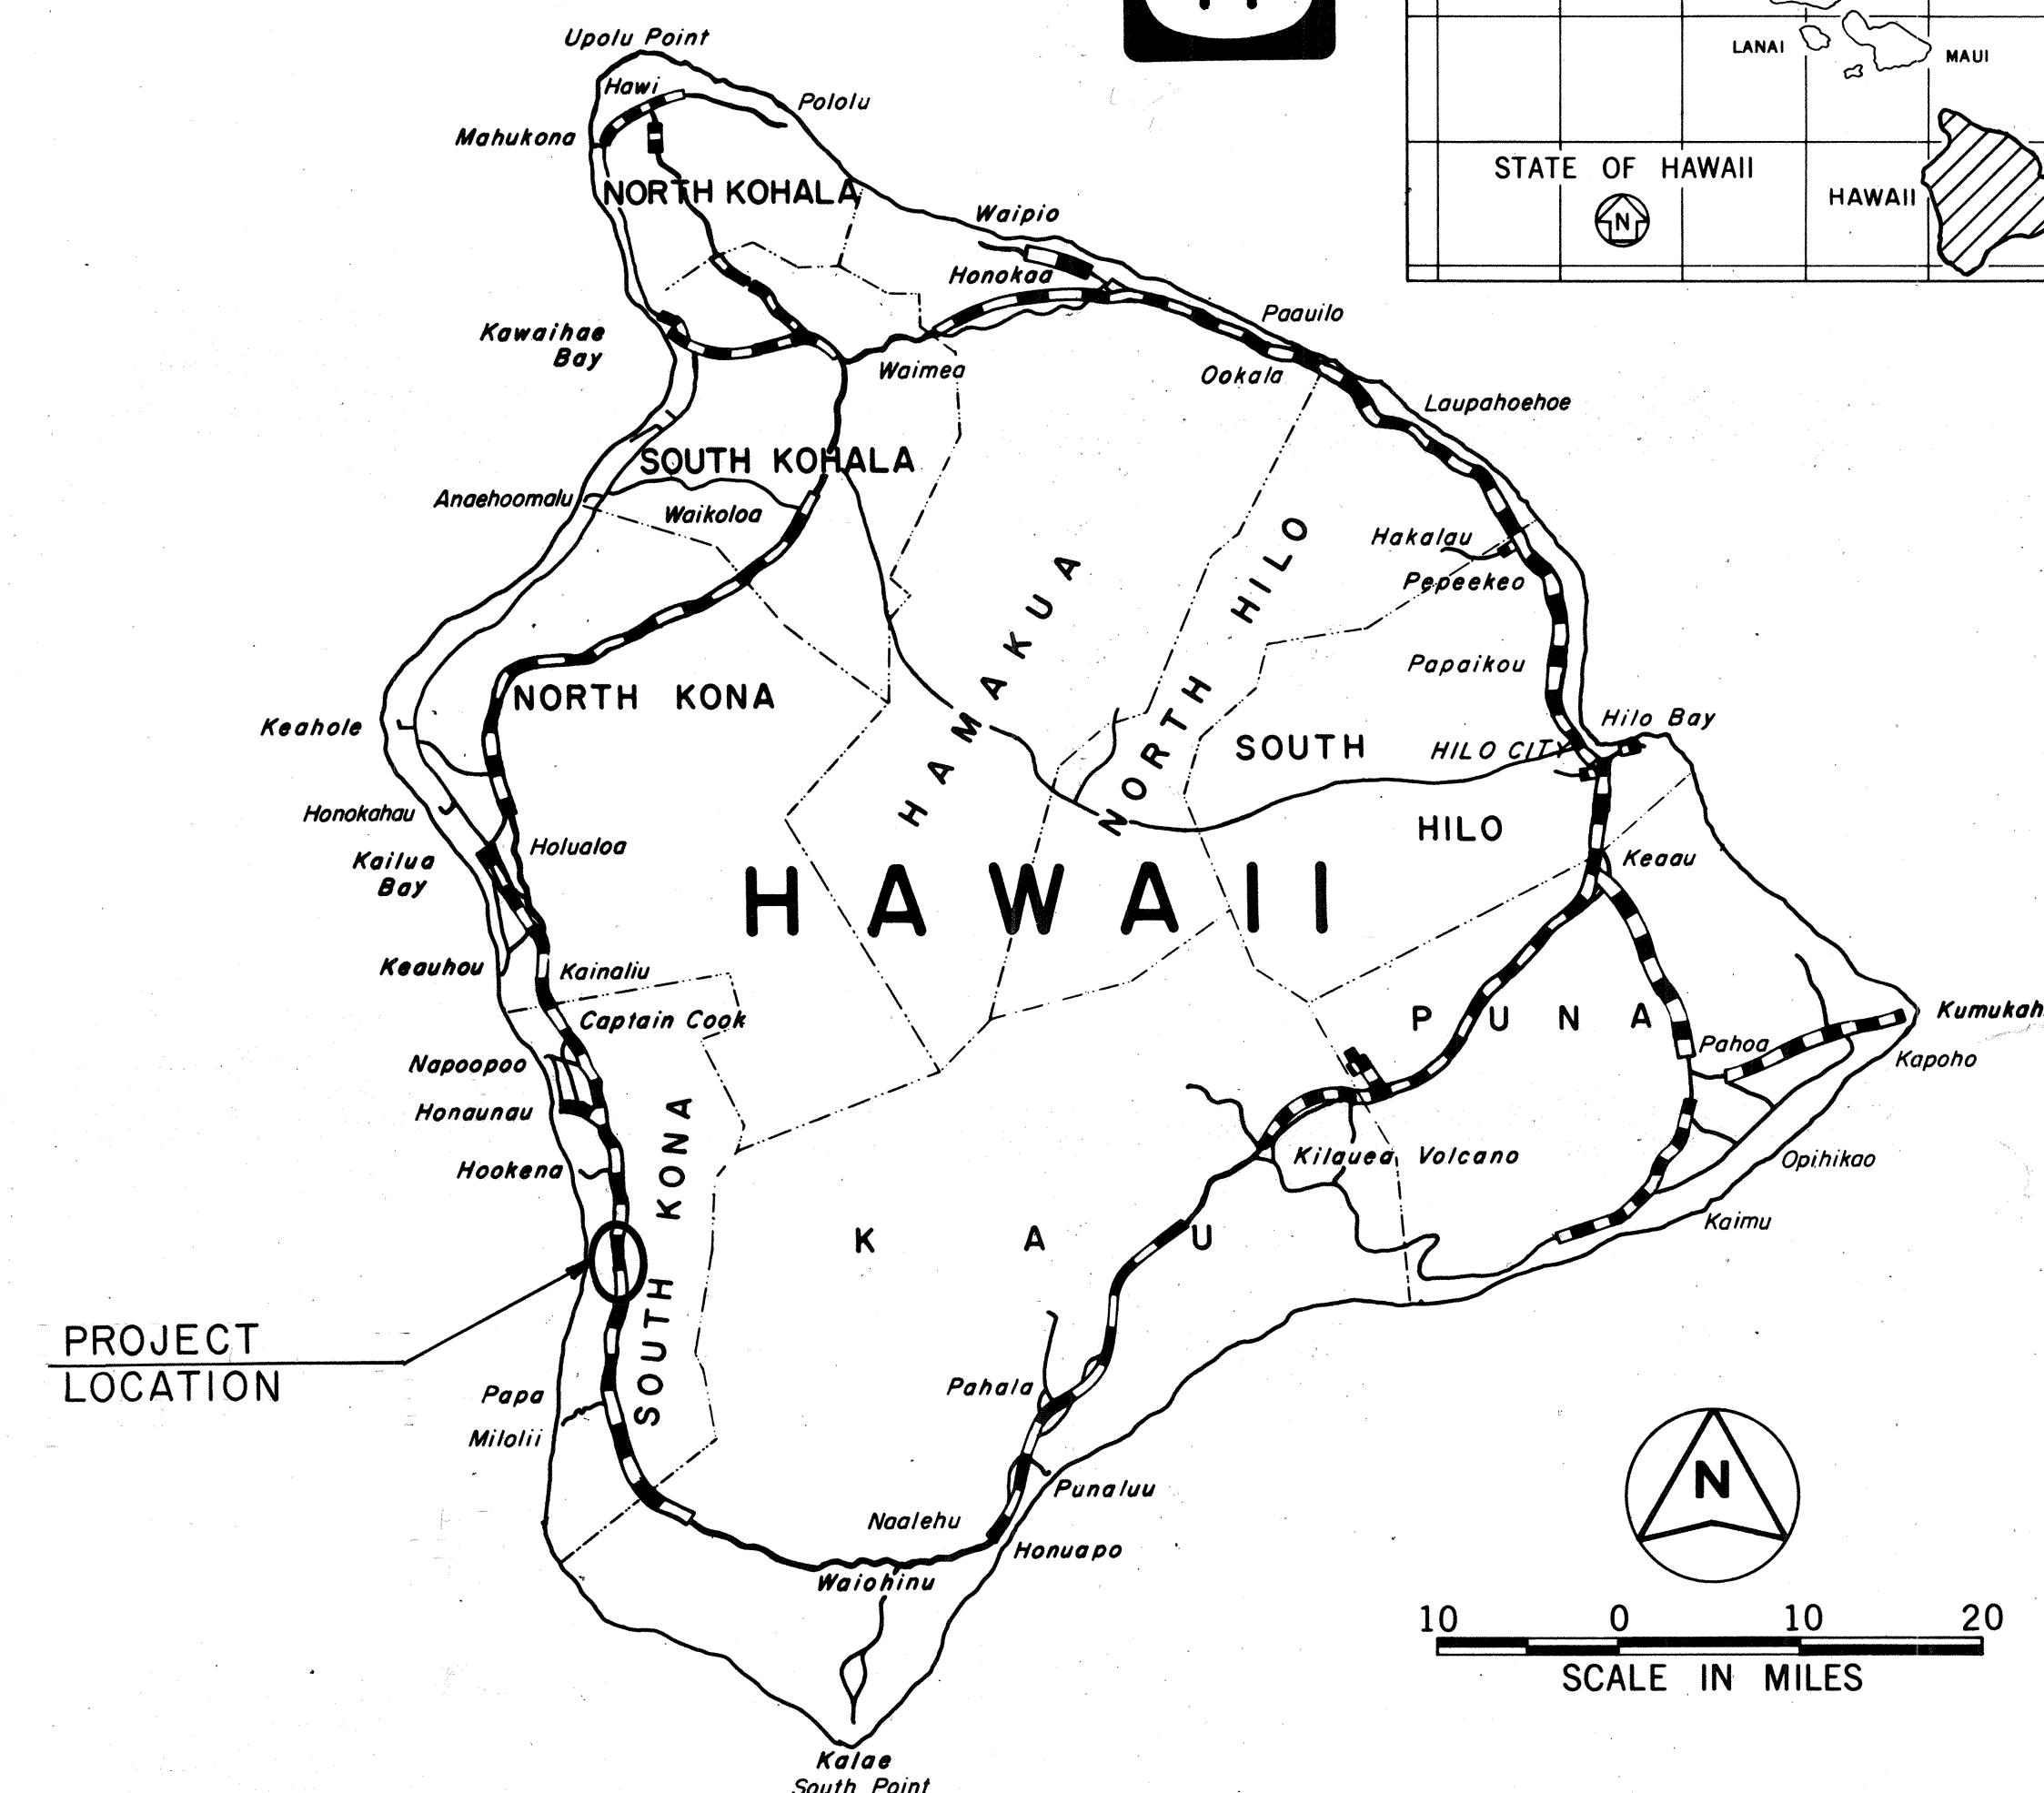


[illegible]

STATE OF HAWAII
DEPARTMENT OF TRANSPORTATION
HIGHWAYS DIVISION
HONOLULU, HAWAII
"AS-BUILT"
PLANS FOR
HAWAII BELT ROAD RESURFACING
KAOHE TO KAAPUNA
PROJECT NO. IIC-01-91M
DISTRICT OF SOUTH KONA
ISLAND OF HAWAII

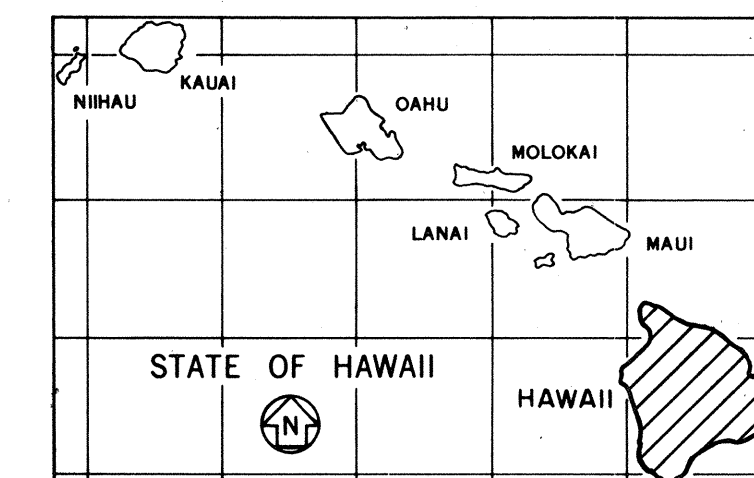

FED. ROAD DIST. NO.	STATE	PROJ. NO.	FISCAL YEAR	SHEET NO.	TOTAL SHEETS
HAWAII	HAW.	11C-01-91M	1991	1	23

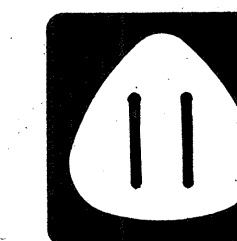

— FEDERAL AID PROJECTS PREVIOUSLY CONSTRUCTED
- - - OR UNDER CONSTRUCTION

MILE POST 92.49 TO MILE POST 96.50

CHANGES MADE DURING CONSTRUCTION HAVE
BEEN INCORPORATED ON THESE PLANS EXCEPT
CHANGES IN THE ORIGINAL THEORETICAL
QUANTITIES. FOR ACTUAL QUANTITIES, REFER TO
PROJECT LEDGER AND/OR COMPUTATION BOOK.

Harold Payne
RESIDENT ENGINEER

11-24-93
DATE

DEPARTMENT OF TRANSPORTATION
STATE OF HAWAII

APPROVED:

Edward J. ... 4/18/80

DIR. OF TRANSPORTATION DATE